

DATE: 9-18-70 10-2-70 FINAL

INDEX TO DRAWINGS

WIDENING OF AUSTIN BISHOP GRADE SEPARATION

1. BRIDGE LAYOUT.
2. CROSS SECTION & FOUNDATION PLAN.
3. FRAMING PLAN & LONGITUDINAL SECTION.
4. NORMAL DECK SECTION & DETAILS.
5. TOP SLAB REINFORCING PLAN.
6. BOTTOM SLAB REINFORCING PLAN.
7. PIER CAP & PIER FOOTING REINFORCEMENT.
8. PLAN & ELEVATION OF ABUTMENT#1.
9. PLAN & ELEVATION OF ABUTMENT#1.
10. PLAN & ELEVATION OF ABUTMENT#2.
11. ABUTMENT SECTIONS & DETAILS.
12. CONCRETE MEDIAN BARRIER DETAILS.
13. BORING LOGS.
14. ELECTRICAL PLAN & DETAILS.

NOTES FOR CONSTRUCTION WITHIN STATE HIGHWAY RIGHT-OF-WAY


1. THE CONTRACTOR SHALL OBTAIN A CONSTRUCTION PERMIT FROM THE STATE'S HIGHWAY DISTRICT ENGINEER AT PRIOR TO THE COMMENCEMENT OF WORK WITHIN STATE HIGHWAY RIGHT-OF-WAY.
2. CONSTRUCTION AND RESTORATION OF ALL EXISTING HIGHWAY FACILITIES WITHIN STATE HIGHWAY RIGHT-OF-WAY SHALL BE DONE IN ACCORDANCE WITH ALL APPLICABLE SECTIONS OF THE STANDARD SPECIFICATIONS FOR ROAD & BRIDGE CONSTRUCTION, DATED 1969, AND THE SPECIFICATION FOR INSTALLATION OF MISCELLANEOUS IMPROVEMENTS WITHIN STATE HIGHWAYS, DATED JULY 1, 1970, OF THE STATE HIGHWAYS DIVISION.
3. THE CONTRACTOR SHALL PROVIDE, INSTALL, AND MAINTAIN ALL NECESSARY SIGNS, LIGHTS, FLARES, BARRICADES, MARKERS, CONES, AND OTHER PROTECTIVE FACILITIES AND SHALL TAKE ALL NECESSARY PRECAUTIONS FOR THE PROTECTION AND FOR THE CONVENIENCE AND SAFETY OF PUBLIC TRAFFIC. ALL SUCH PROTECTIVE FACILITIES & PRECAUTIONS TO BE TAKEN SHALL CONFORM WITH THE "RULES AND REGULATIONS GOVERNING THE USE OF TRAFFIC CONTROL DEVICES AT WORK SITES ON OR ADJACENT TO PUBLIC STREETS AND HIGHWAYS" ADOPTED BY THE HIGHWAY SAFETY COORDINATOR, AND THE U.S. BUREAU OF PUBLIC ROADS' MANUAL ON UNIFORM TRAFFIC CONTROL DEVICES FOR STREETS AND HIGHWAYS, PART - V TRAFFIC CONTROLS FOR HIGHWAY CONSTRUCTION AND MAINTENANCE OPERATIONS", AS AMENDED.

STANDARD BRIDGE DETAIL DRAWINGS

STATE OF HAWAII
DEPARTMENT OF TRANSPORTATION
HIGHWAYS DIVISION

- S1. STANDARD BRIDGE DETAILS.
- S2. CONCRETE BOX GIRDER.
- S3. CONCRETE BOX GIRDER.
- S4. CONCRETE BOX GIRDER.
- S5. METAL BRIDGE RAILING.
- S6. METAL BRIDGE RAILING.
- S7. RETAINING WALL TYPE T-I.
- S8. RETAINING WALL TYPE T-I.
- S9. METAL CURB RAIL CONCRETE TO CONCRETE BARRIER.

SYMBOLS & ABBREVIATIONS

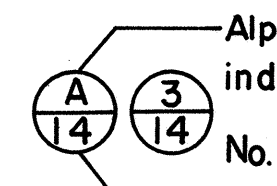	Alphabet (A) or numeral (3) indicate sec. or det. designation.	(A) ABUT. Abutment.	CG. Center of gravity.	(E) EA. Each.	(G) GALV. Galvanized.	LOC. Location.	Q.R. Outer ring. (col. bars.)	SPC. Spaces.
	No. (14) indicates sht. no. where sec. or detail is drawn on.	ADJ. Adjacent.	CH. Change of grade.	EF. Each face.	(H) HOR. Horizontal.	LONGIT. Longitudinal.	(P) Plate. Point.	SPCG. Spacing.
		ALT. Alternate.	CL. Clear or closed.	EP. Edge of paving.	(I) I.B. Inbound.	LT.WT. Light weight.	(R) R. Radius.	STA. Station.
B5	Boring no. and designation.	AZ. Azimuth.	COL. Column.	EL,ELEV. Elevation.	(INCLU. Inclusive.	(M) MAX. Maximum.	REF. Reference.	STR. Straight.
B-A,B-B	Beam designations.	(B) BAL. Balance.	CONN. Connection.	E.V.C. End vertical curve.	I.R. Inner ring. (col. bars.)	MIN. Minimum.	REINF. Reinforcement.	STIRR. Stirrup.
G-1,G-2	Girder designations.	B.F. Both face.	CONST. Construction.	EQ. Equal.	INT. Interior.	(N) N.F. Near face.	R.C. Reinforced concrete.	STD. Standard.
P-1,P-2	Pier designations.	BM. Beam.	CONT. Continuous.	EXP. Expansion.	(J) JT. Joint.	NO. Number.	REQ'D. Required.	SYMM. Symmetrical.
PG-2	Prestressed girder type 2.	B.V.C. Begin vertical curve.	DET. Detail.	EXT. Exterior.	(L) LG. Long.	(O) O.C. On center.	SEC. SECT. Section.	T. Top.
		B,BOT,BOTT. Bottom.	DIA. Diameter.	EXIST. Existing.		OPNG. Opening.	SHT. Sheet.	TYP. Typical.
		(C) CL. Center line.	DIAG. Diagonal.	FF. Far face.		O.B. Outbound.		VERT. Vertical.
			DRWG. Drawing.	FTG. Footing.		O TO O. Out to out.		V.C. Vertical curve.

GENERAL NOTES

SPECIFICATIONS AASHO:

STANDARD SPECIFICATION FOR HIGHWAY BRIDGES (9th EDITION) WITH SUBSEQUENT ADDITIONS & MODIFICATIONS

DESIGN LOADS

HS-20-44 OR INTERSTATE LOADING

DESIGN STRESSES

REINFORCED CONCRETE: SEE AASHO SPECIFICATIONS AND GENERAL PROVISIONS, EXCEPT AS OTHERWISE NOTED ON PLAN.

CLASS A	CLASS E (FOR BRIDGE COLUMNS ONLY)	fs = 24,000 psi (FOR CLASS E ONLY)
fc' = 3,000 psi, fc = 1,200 psi, n = 10	fc' = 5,000 psi, fc = 2,000 psi, n = 6	fs = 20,000 psi

MATERIALS

1. CONCRETE: ALL CONCRETE SHALL BE CLASS A, EXCEPT AS OTHERWISE NOTED ON PLANS OR INDICATED IN SPECIFICATIONS.

2. REINFORCING STEEL: ALL REINFORCING STEEL TO BE ASTM DESIGNATION A-615 GRADE 40, EXCEPT AS OTHERWISE NOTED. FOR PIER VERT. REINFORCING STEEL TO BE ASTM DESIGNATION A-615 GRADE 60.

3. ITEMS INCIDENTAL TO CONCRETE WILL NOT BE PAID FOR SEPARATELY

- A. ALL PREMOLDED JOINT FILLER AND SEALANT.
 - B. ALL PREMOLDED ASPHALTIC FILLER AROUND UTILITY LINE THROUGH CONCRETE SECTIONS
 - C. WIDENING OF EXISTING SIDEWALK
 - D. JOINTS DOWELS & SLEEVES BETWEEN NEW & EXISTING FOOTING
 - E. REMOVAL OF EXISTING WING WALLS & ABUTMENT PIERS & REWORK ON TOP OF ABUT. PIERS.
4. ADMIXTURE IN CONCRETE: SEE SPECIAL PROVISIONS

CONSTRUCTION METHODS


1. SEE STANDARD SPECIFICATIONS & SPECIAL PROVISIONS
2. SIDE OF SPREAD FOOTINGS SHALL BE EXCAVATED AND POURED TO NEAT LINES FOR EXCAVATION OF BOTTOM OF FOOTINGS, SEE STANDARD SPECIFICATIONS. IN CASE OF OVER EXCAVATION, SPACE BETWEEN FOOTING & GROUND SHALL BE FILLED WITH CONCRETE AT THE CONTRACTORS EXPENSE & AS DIRECTED BY THE ENGINEER. THE FILL CONCRETE SHALL HAVE A MINIMUM QUALITY OF CLASS D-1.
3. THE CONTRACTOR SHALL VERIFY THE LOCATION OF ALL UTILITY LINES & NOTIFY THE RESPECTIVE OWNERS BEFORE COMMENCING EXCAVATION WORK.
4. BACKFILL BELOW ABUTMENT ROCKER SHALL BE IN PLACE BEFORE ROCKER IS POURED. REMAINDER OF BACK FILL TO BE PLACED SIMULTANEOUSLY AT EACH ABUTMENT AFTER SUPER STRUCTURE FALSE WORK IS RELEASED.
5. IN GENERAL, TOP & EDGE OF CONCRETE DECK OF SUPER STRUCTURE SHALL BE CONSTRUCTED TO FOLLOW THE FINISH ROADWAY VERTICAL & OR HORIZONTAL CURVES, GRADES SLOPES & ELEVATIONS.
6. OPERATION OF CONSTRUCTION SHALL BE LIMITED WITHIN THE STATE RIGHT-OF-WAY.
7. VERTICAL PIER COL. BARS SHALL BE ARRANGED IN SUCH A MANNER AS TO MISS PIER CAP REINF. BARS ABOVE.
8. WING WALLS ON FILL SHALL BE CONSTRUCTED AFTER THE ROADWAY FILL IS COMPLETED TO REQ'D. FIN. GRADE.
9. FOR CONCRETE FINISHES SEE SPECIAL PROVISIONS.
10. CONTRACTOR SHALL HAVE THE SOLE RESPONSIBILITY FOR ANY DAMAGE TO THE REMAINING EXISTING STRUCTURAL MEMBERS DURING CONSTRUCTION OF NEW BRIDGE, REMOVAL OF EXISTING BRIDGE RAIL, SIDEWALK, WING WALLS, ETC.

CAMBER

OBTAIN DEAD LOAD CAMBER BY FORMING & SHORING CONCRETE SURFACES ABOVE THE PROFILE GRADES WITH AMOUNT AS SHOWN IN DEAD LOAD CAMBER DIAGRAM.

REFERENCE

1. REFER TO STANDARD DETAIL DRAWINGS SHTS # SI-S9 INCL., FOR DETAILS NOT COVERED BY THESE DWGS.
2. REPORT ON STRUCTURE FOUNDATIONS INTERSTATE PROJECT I-HI-1(9) WAI'AU TO AIEA STREAM BY HIGHWAYS DIVISION, MATERIALS, TESTING & RESEARCH BRANCH (APRIL 1968)

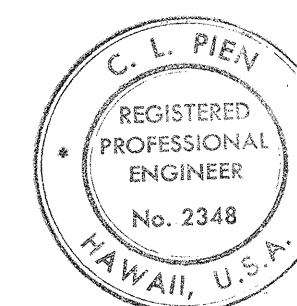

THIS WORK WAS PREPARED BY ME OR UNDER MY SUPERVISION

APPROVED:



CHIEF, HIGHWAYS DIVISION
DEPT. OF TRANSPORTATION

12/2/70
DATE

REVISION DATE	DESCRIPTION	MADE BY	APPROVED
COMMUNITY PLANNING INCORPORATED CIVIL ENGINEERS - SURVEYORS - CONSULTANT PLANNERS			
PETER HSI ASSOCIATES INC. STRUCTURAL ENGINEERS			
WAI'AU - WAIMALU ACCESS ROAD WAI'AU, OAHU, HAWAII OWNER: B.P. BISHOP ESTATE DEVELOPERS: AMFAC-THROSDALE OCEANVIEW VENTURES TAX MAP KEY: 9-8-02: 2&3			
WIDENING OF AUSTIN BISHOP GRADE SEPARATION INDEX TO DRWGS. ABBREVIATIONS & NOTES			
APPROVED:			
CHIEF, DIVISION OF ENGINEERING			
REG. ENGR. CERT. NO. 470-E			
FILE	POCKET	FOLDER	NO.

185-S1 AS BUILT

SHEET A OF 1 SHEETS

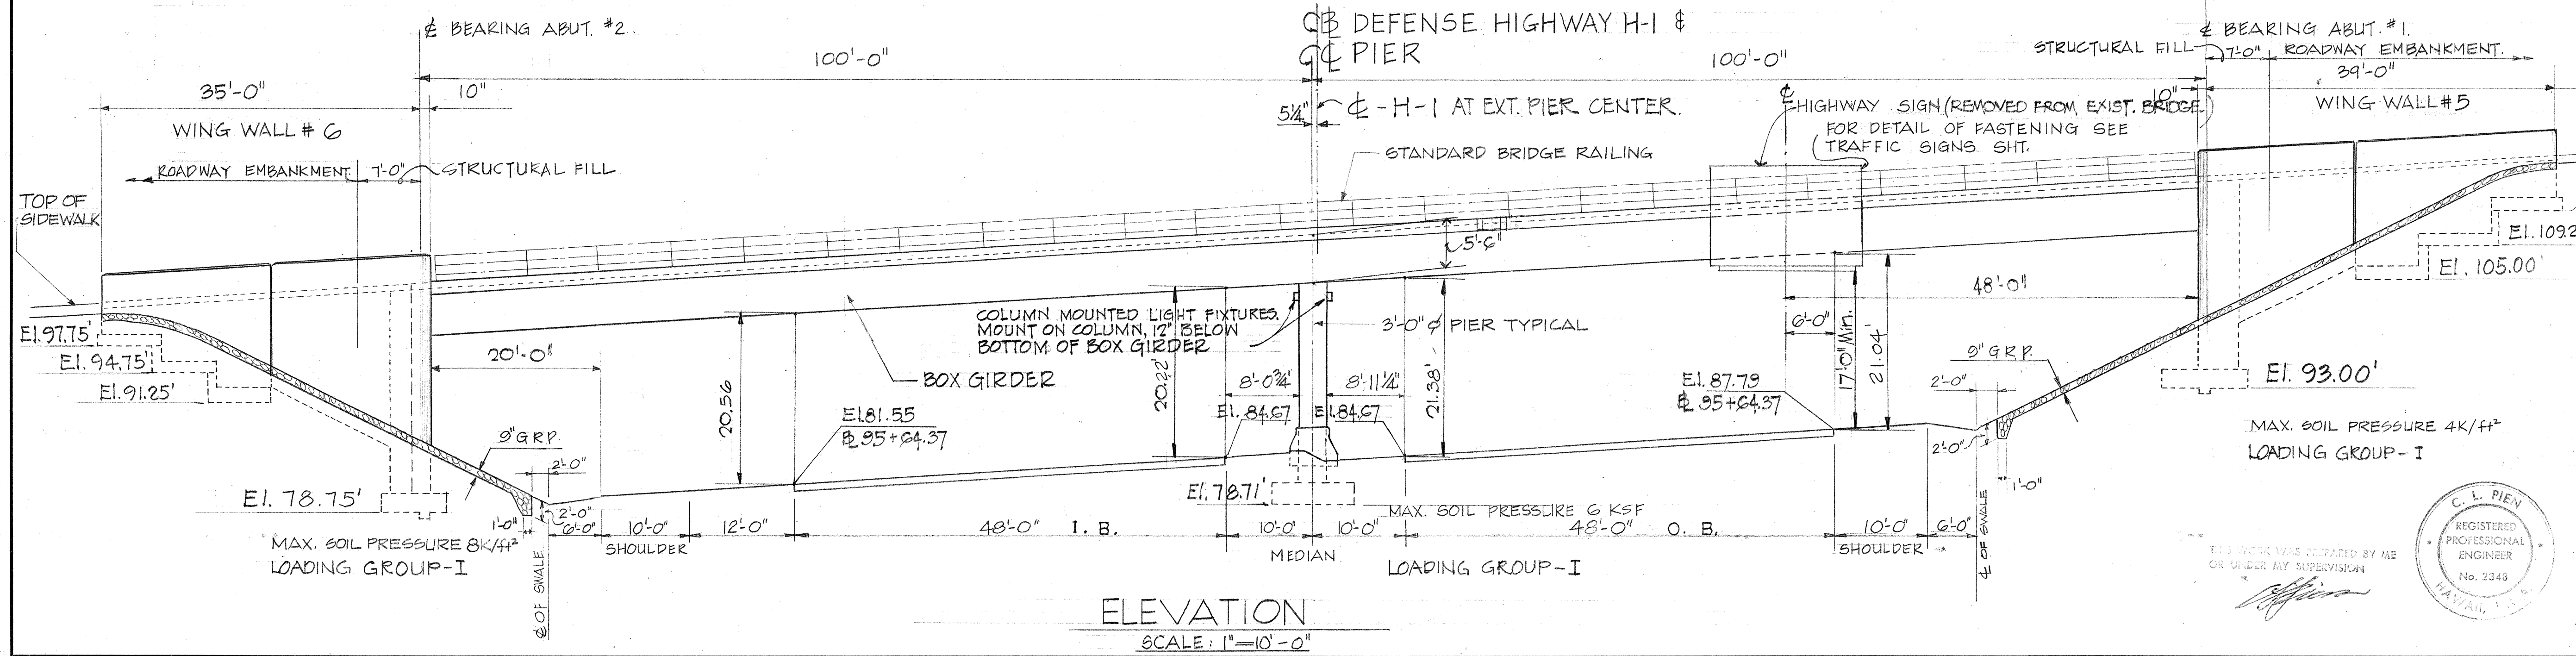
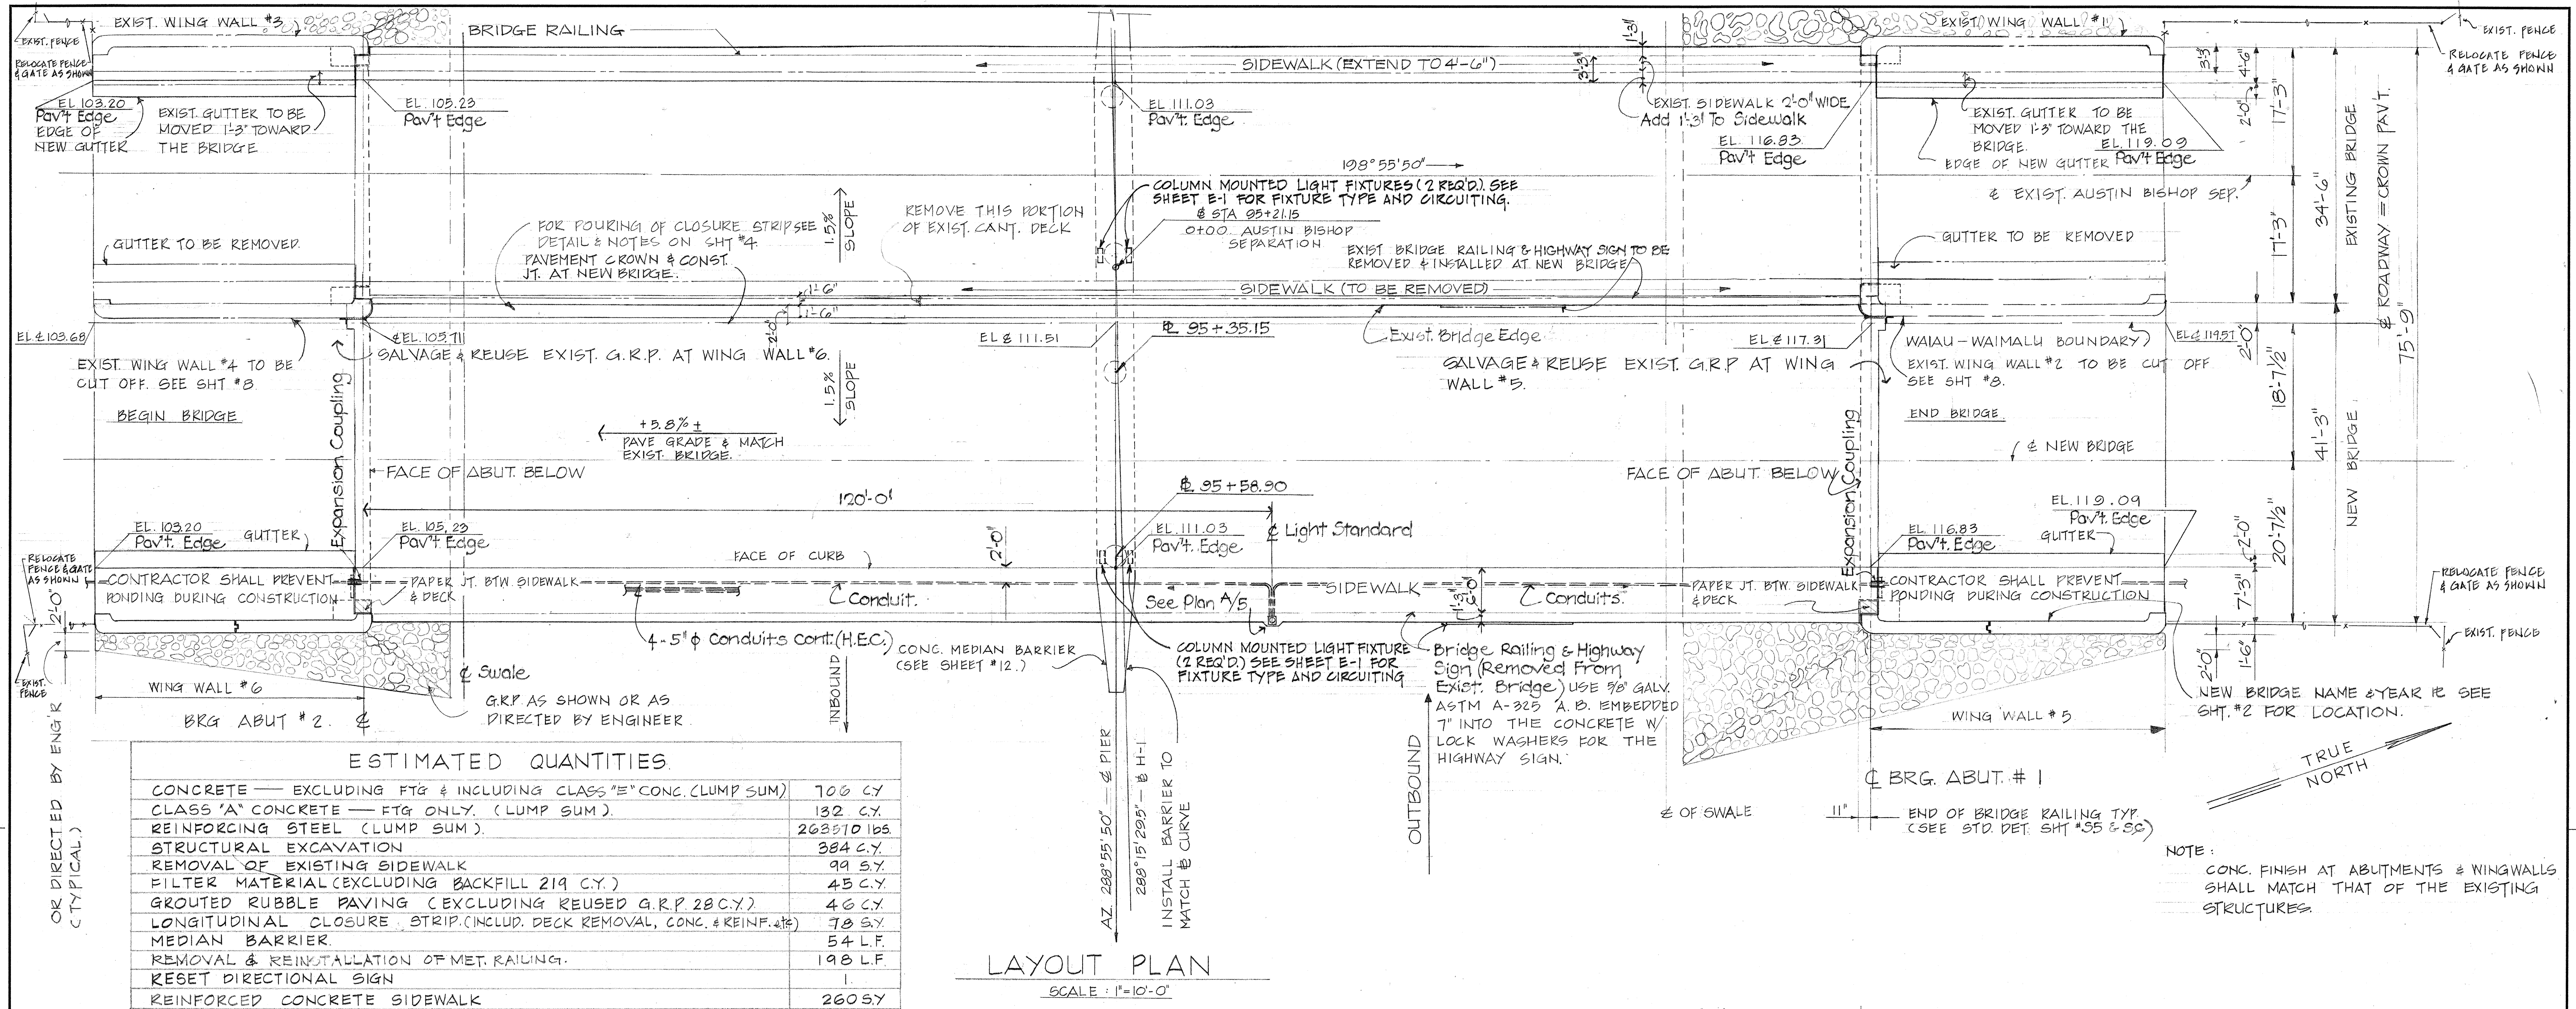


REVISION DATE	DESCRIPTION	MADE BY	APPROVED
COMMUNITY PLANNING INCORPORATED CIVIL ENGINEERS — SURVEYORS — CONSULTANT PLANNERS PETER HSI ASSOCIATES INC. STRUCTURAL ENGINEERS WAI'AU-WAIMALU ACCESS ROAD WAI'AU, OAHU, HAWAII OWNER: B.B. BISHOP ESTATE DEVELOPERS: AMFAC-TROUSDALE OCEANVIEW VENTURES TAX MAP KEY: 9-8-02:263 WIDENING OF AUSTIN BISHOP GRADE SEPARATION BRIDGE LAYOUT			
APPROVED: _____ CHIEF, DIVISION OF ENGINEERING REG. ENGR. CERT. NO. 475-E			

DATE: 9-18-17

185-S2 AS BUILT

SHEET 1 OF 12 SHEETS

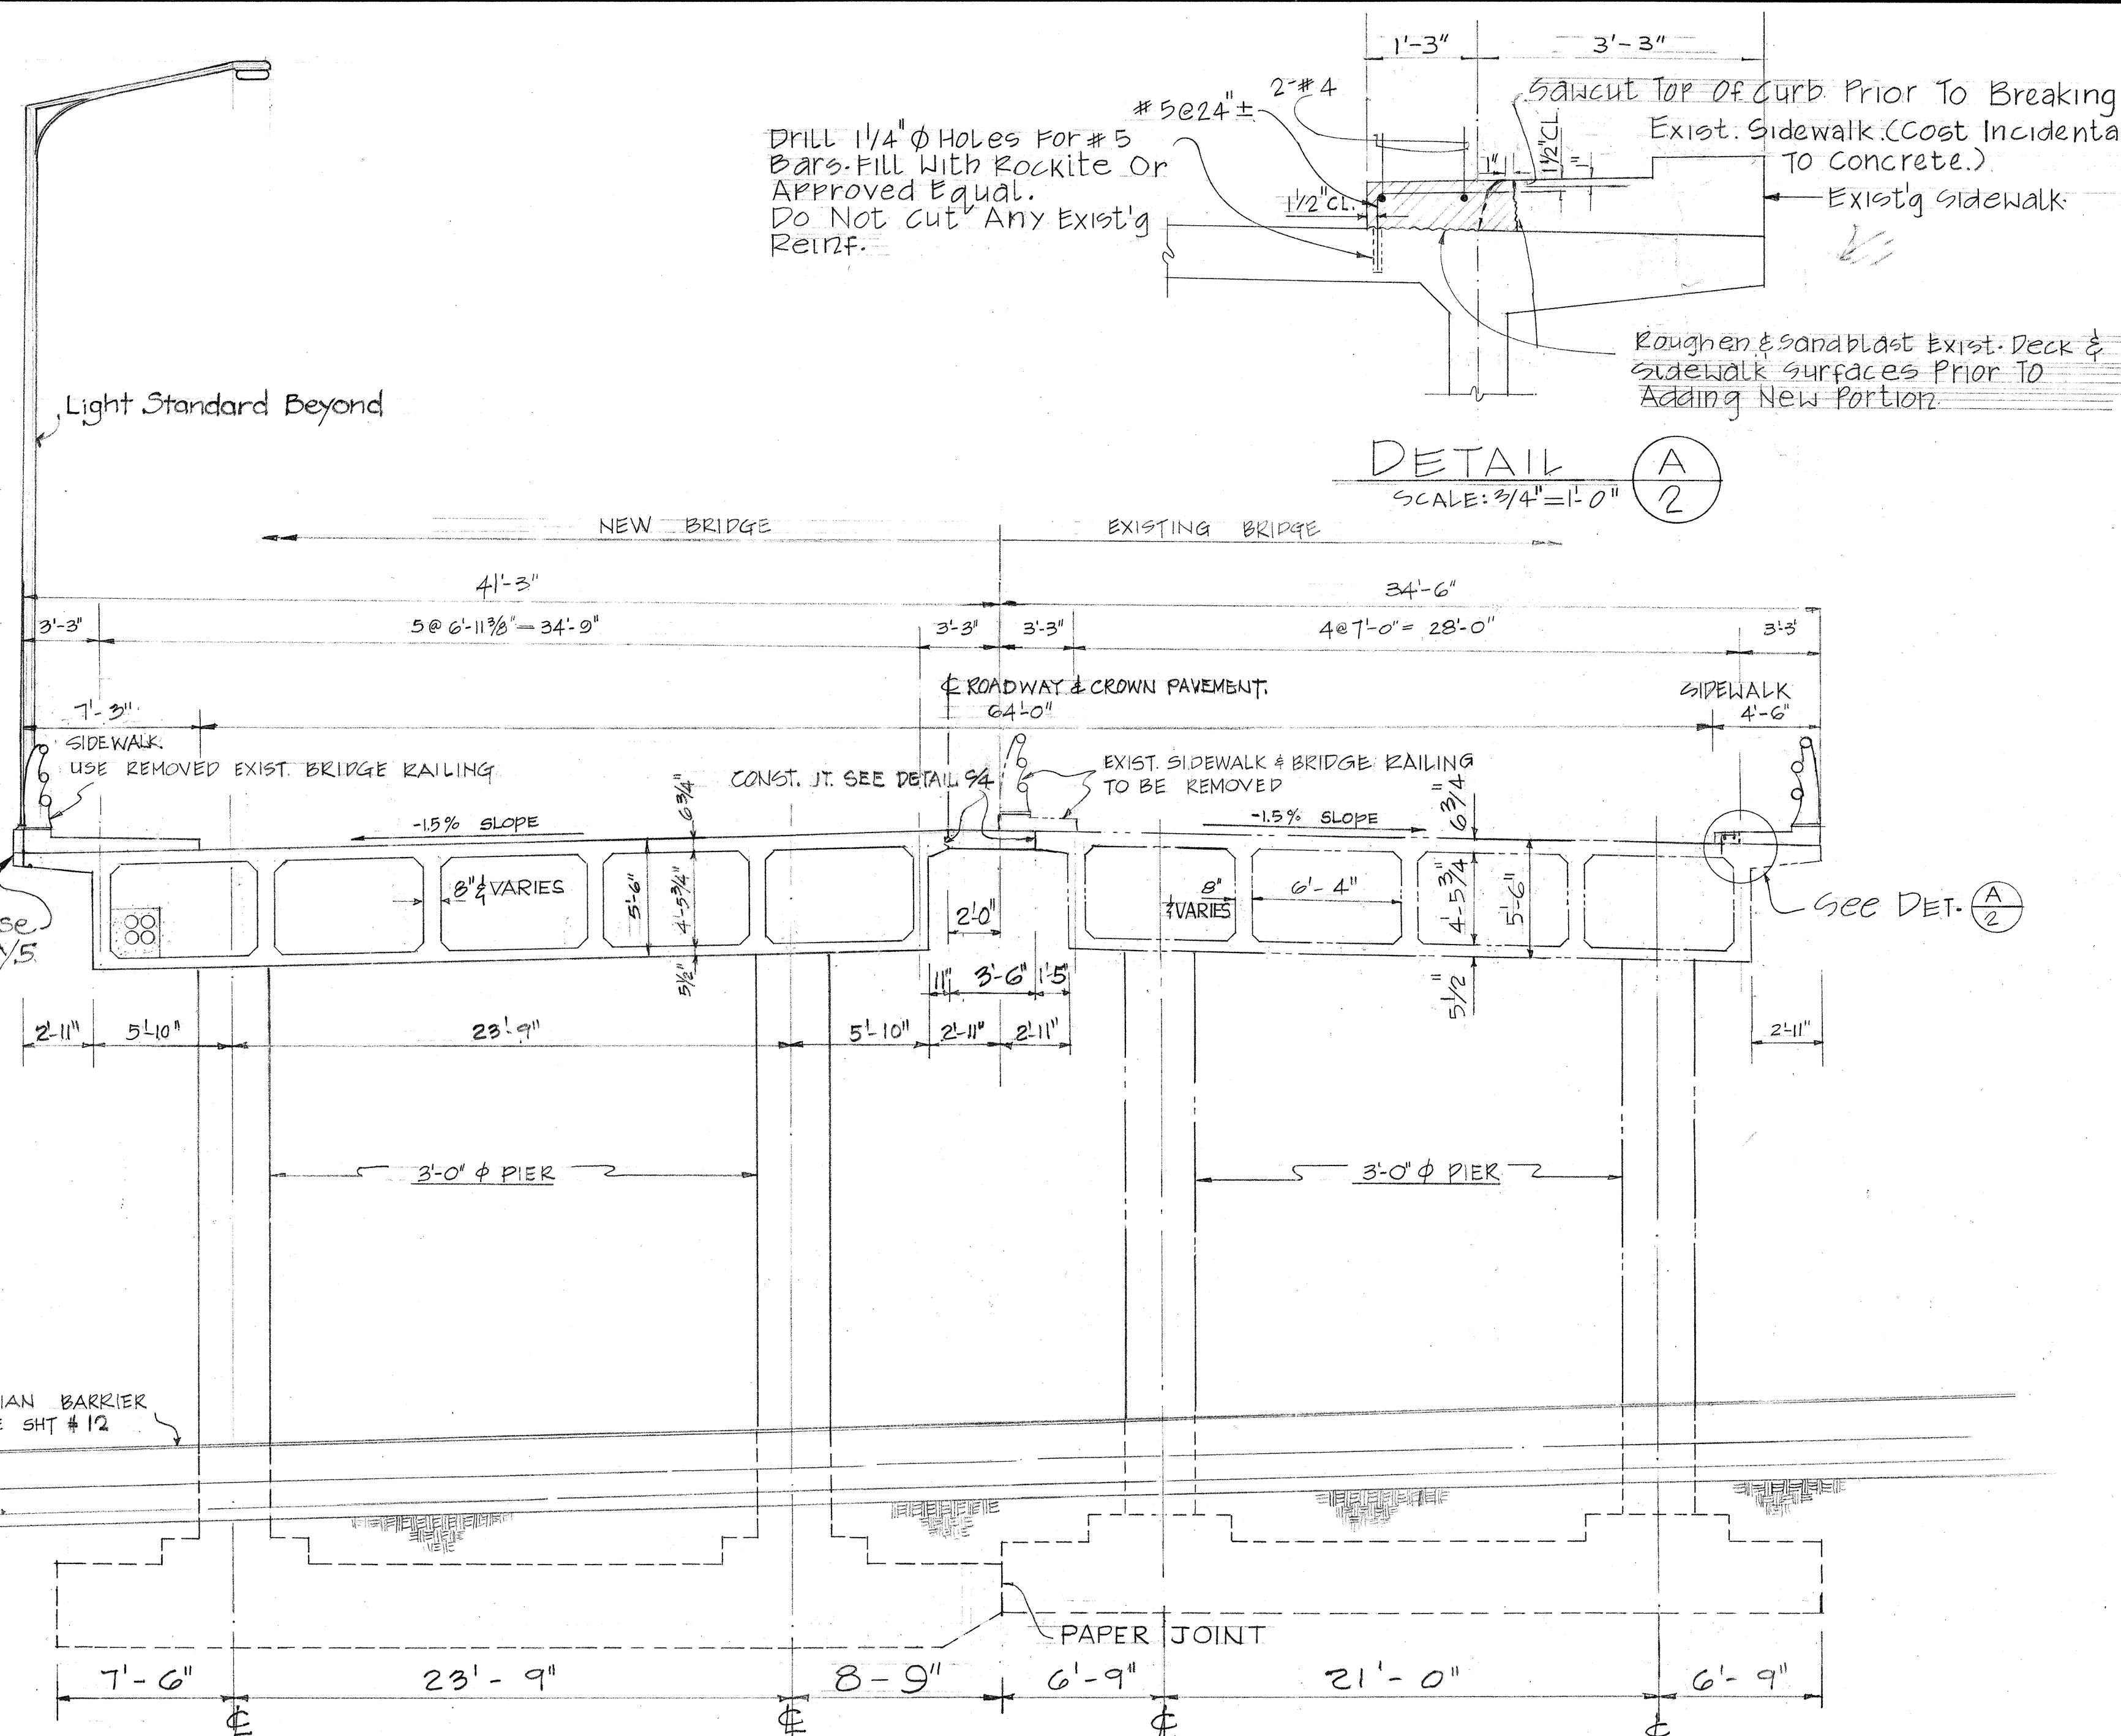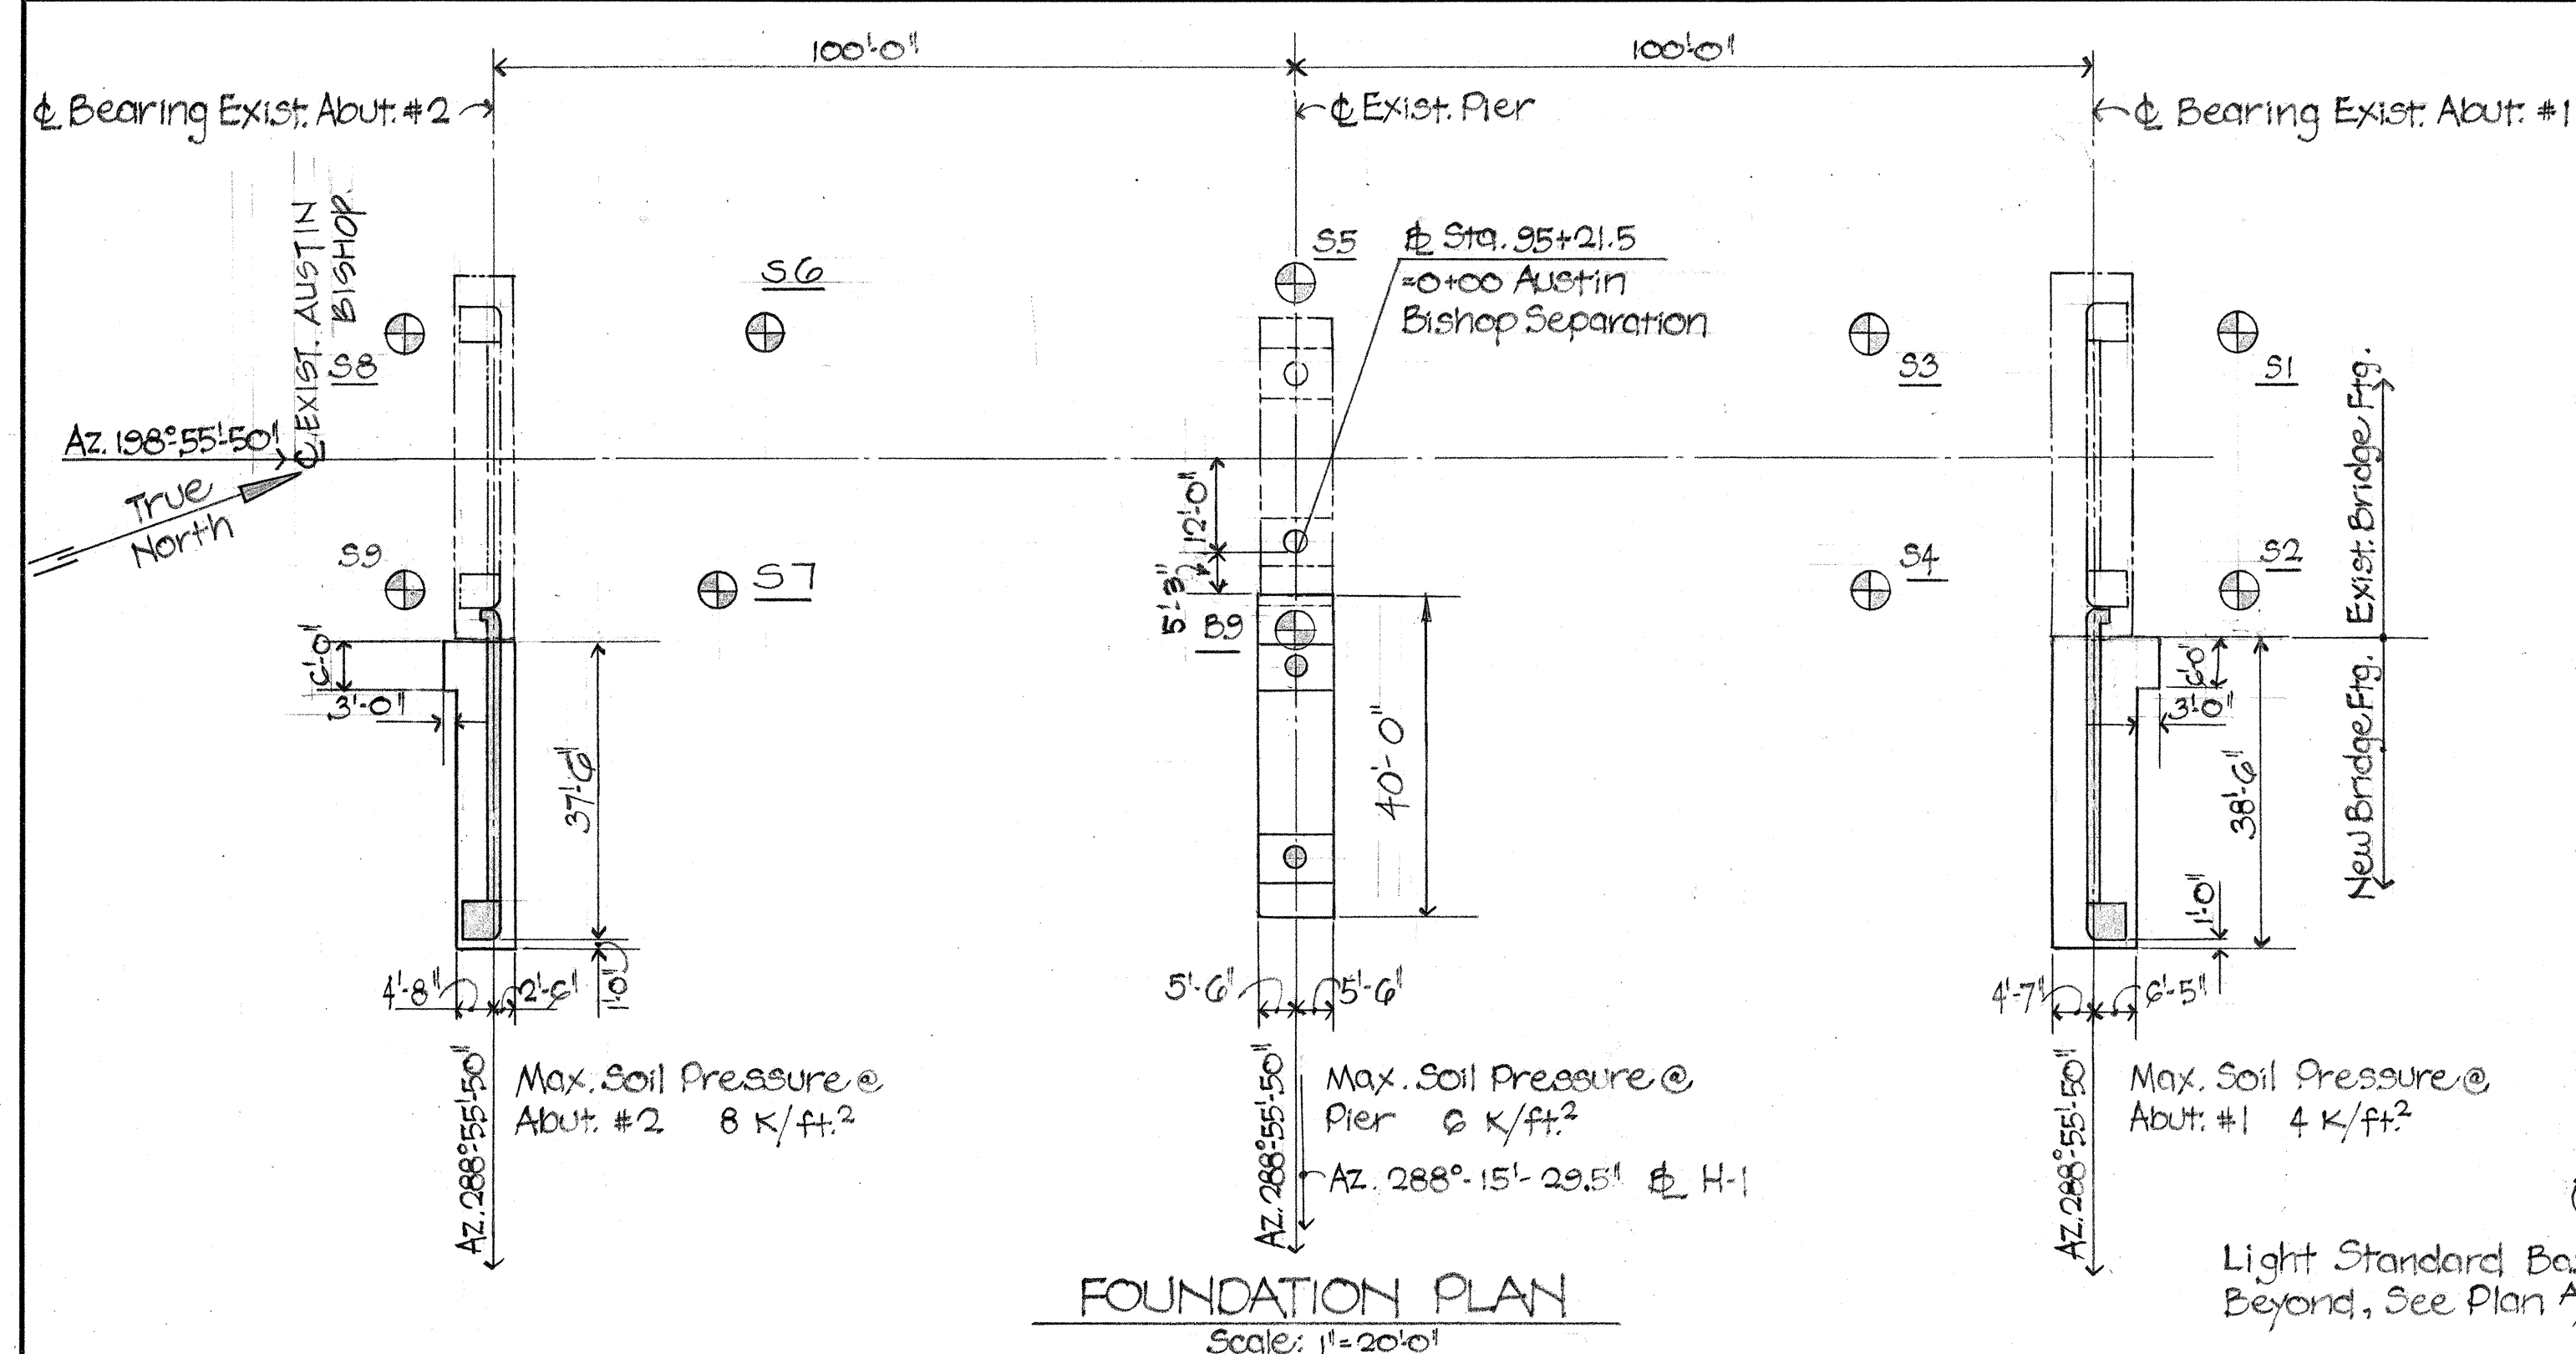

GENERAL NOTES

SPECIFICATIONS: AASHTO
Standard Specifications For Highway Bridges (9th edition)
With Subsequent Additions And Modifications.

DESIGN LOADS: HS 20-44

DESIGN STRESSES:

	A Concrete	E Concrete
$f'_c = 3,000$ psi	5,000 psi	
$f_c = 1,200$ psi	2,000 psi	
$n = 10$	6	
$f_s = 20,000$ psi	24,000 psi	

MATERIALS

1. All Concrete Shall Be Class A. Unless Otherwise Noted On Plans

2. All Reinforced Steel To Be ASTM Designation A-15 Billet Steel, Intermediate Grade Except Otherwise Noted.

CONSTRUCTION METHODS

1. Sides Of Footing Shall Be Excavated & Poured To Neat Lines. For Excavation Of Bottom Of Footings See Standard Specifications. Over Excavation Beyond Neat Lines For Sides Of Footings & The Excavations Indicated On The Plans For The Bottom Of Footings Shall Be Backfilled With A Minimum Of Class "D" Concrete At The Contractors Expense And As Directed By The Engineer.

2. Backfill Behind Abutments Shall Not Be Placed Until Release Of Superstructure False Work. Backfill Behind

Abutments Shall Be Brought Up Simultaneously So As To Prevent Unbalanced Earth Pressure.

3. Vertical Pier Column Bars Shall Be Arranged In Such A Manner As To Miss Pier Cap Reinforcing Above.


4. Top Of Concrete Deck Of Structure Shall Be Constructed To Follow The Finish Roadway Grades.

CAMBER

1. Obtain Camber By Forming & Shoring Concrete Surfaces Above Profile Grades As Shown In Camber Diagram, Sht #4

REFERENCE

1. Refer To Standard Detail Drawings Shts. S-1 - S-9

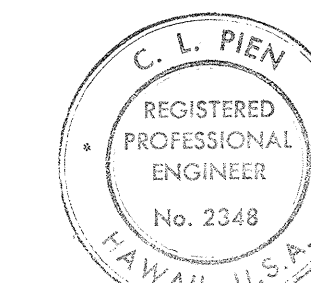

THIS WORK WAS PREPARED BY ME OR UNDER MY SUPERVISION

Office

REVISION	DATE	DESCRIPTION	MADE BY	APPROVED
COMMUNITY PLANNING INCORPORATED CIVIL ENGINEERS - SURVEYORS - CONSULTANT PLANNERS PETER HSI ASSOCIATES INC. STRUCTURAL ENGINEERS WAIKUAU - WAIMALU ACCESS ROAD WAIKUAU, OAHU, HAWAII OWNER : B. P. BISHOP ESTATE OCEANVIEW VENTURES DEVELOPERS : AMFAC - TROUSDALE OCEANVIEW VENTURES TAX MAP KEY: 9-8-02: 2&3 WIDENING OF AUSTIN BISHOP GRADE SEPARATION CROSS SECTION & FOUNDATION PLAN				
APPROVED: _____ CHIEF, DIVISION OF ENGINEERING REG. ENGR. CERT. NO. 470-E				

185-S3 AS BUILT




SHEET 2 OF 14 SHEETS

FILE	POCKET	FOLDER	NO.

DATE: 9-18-70

DATE: 9-18-17

K&E CRYSTALINE® LA 3681
TRADE PAPER

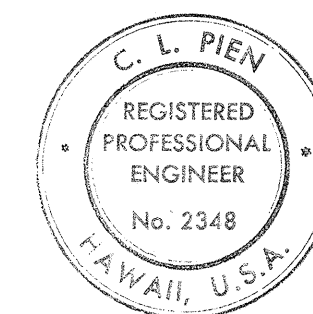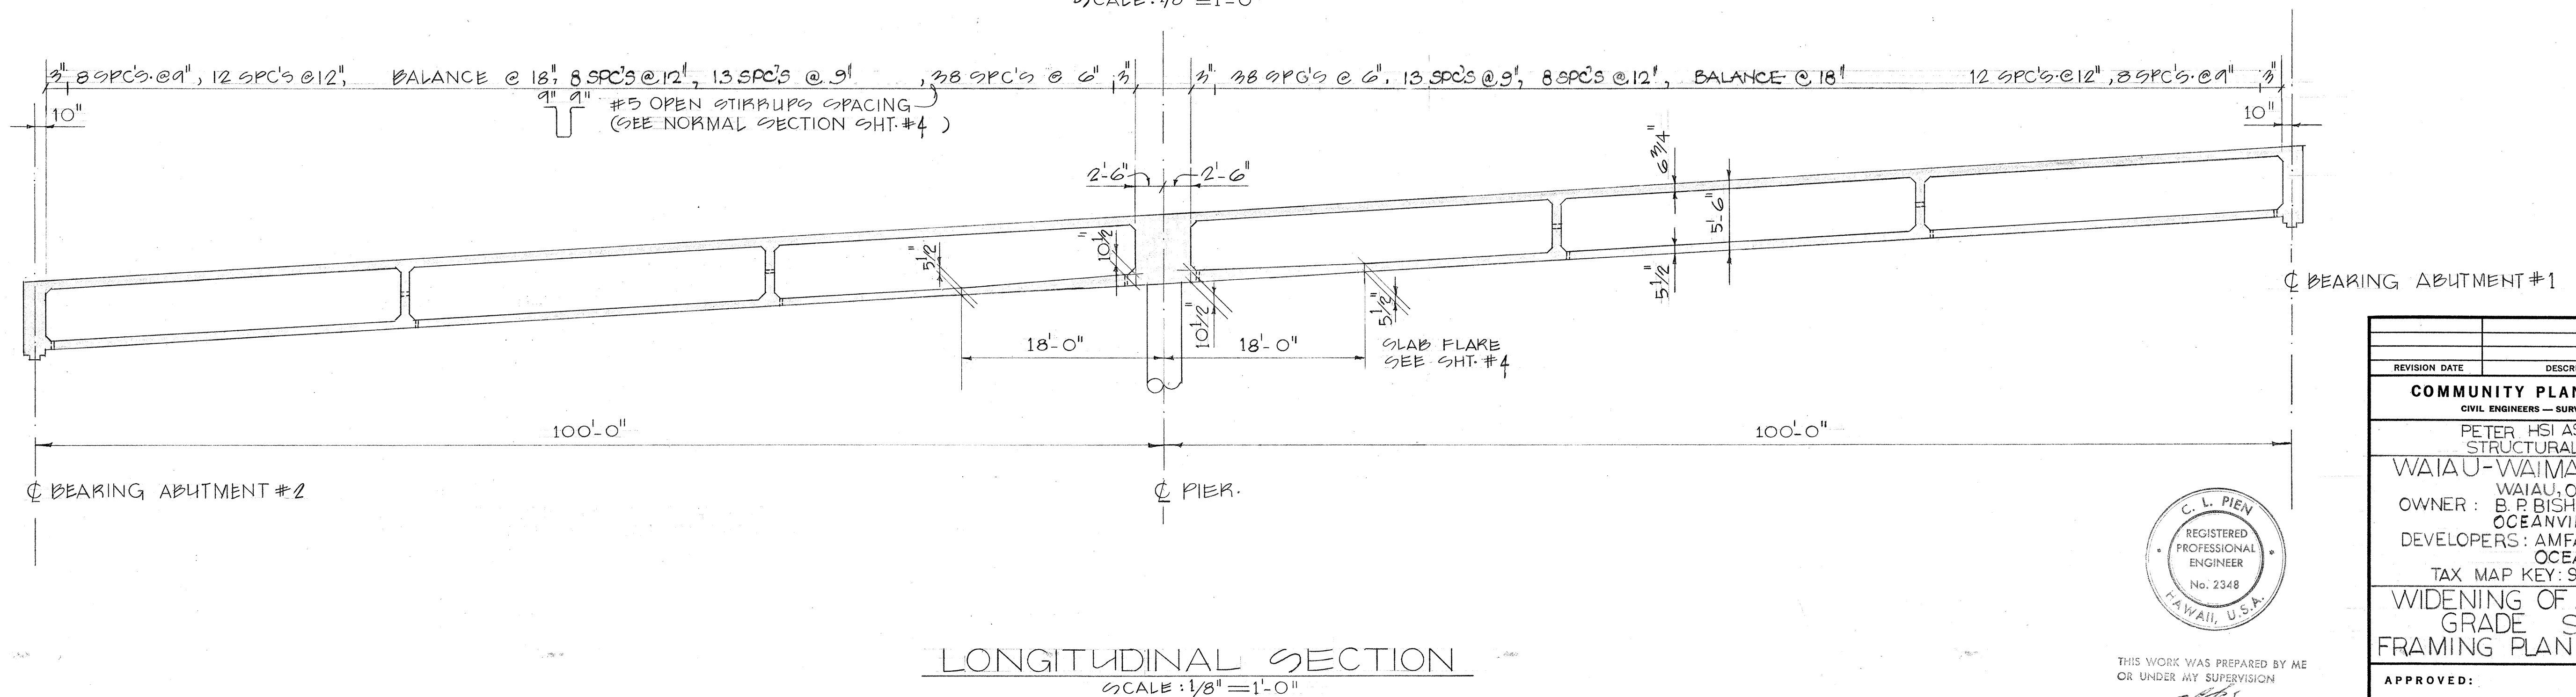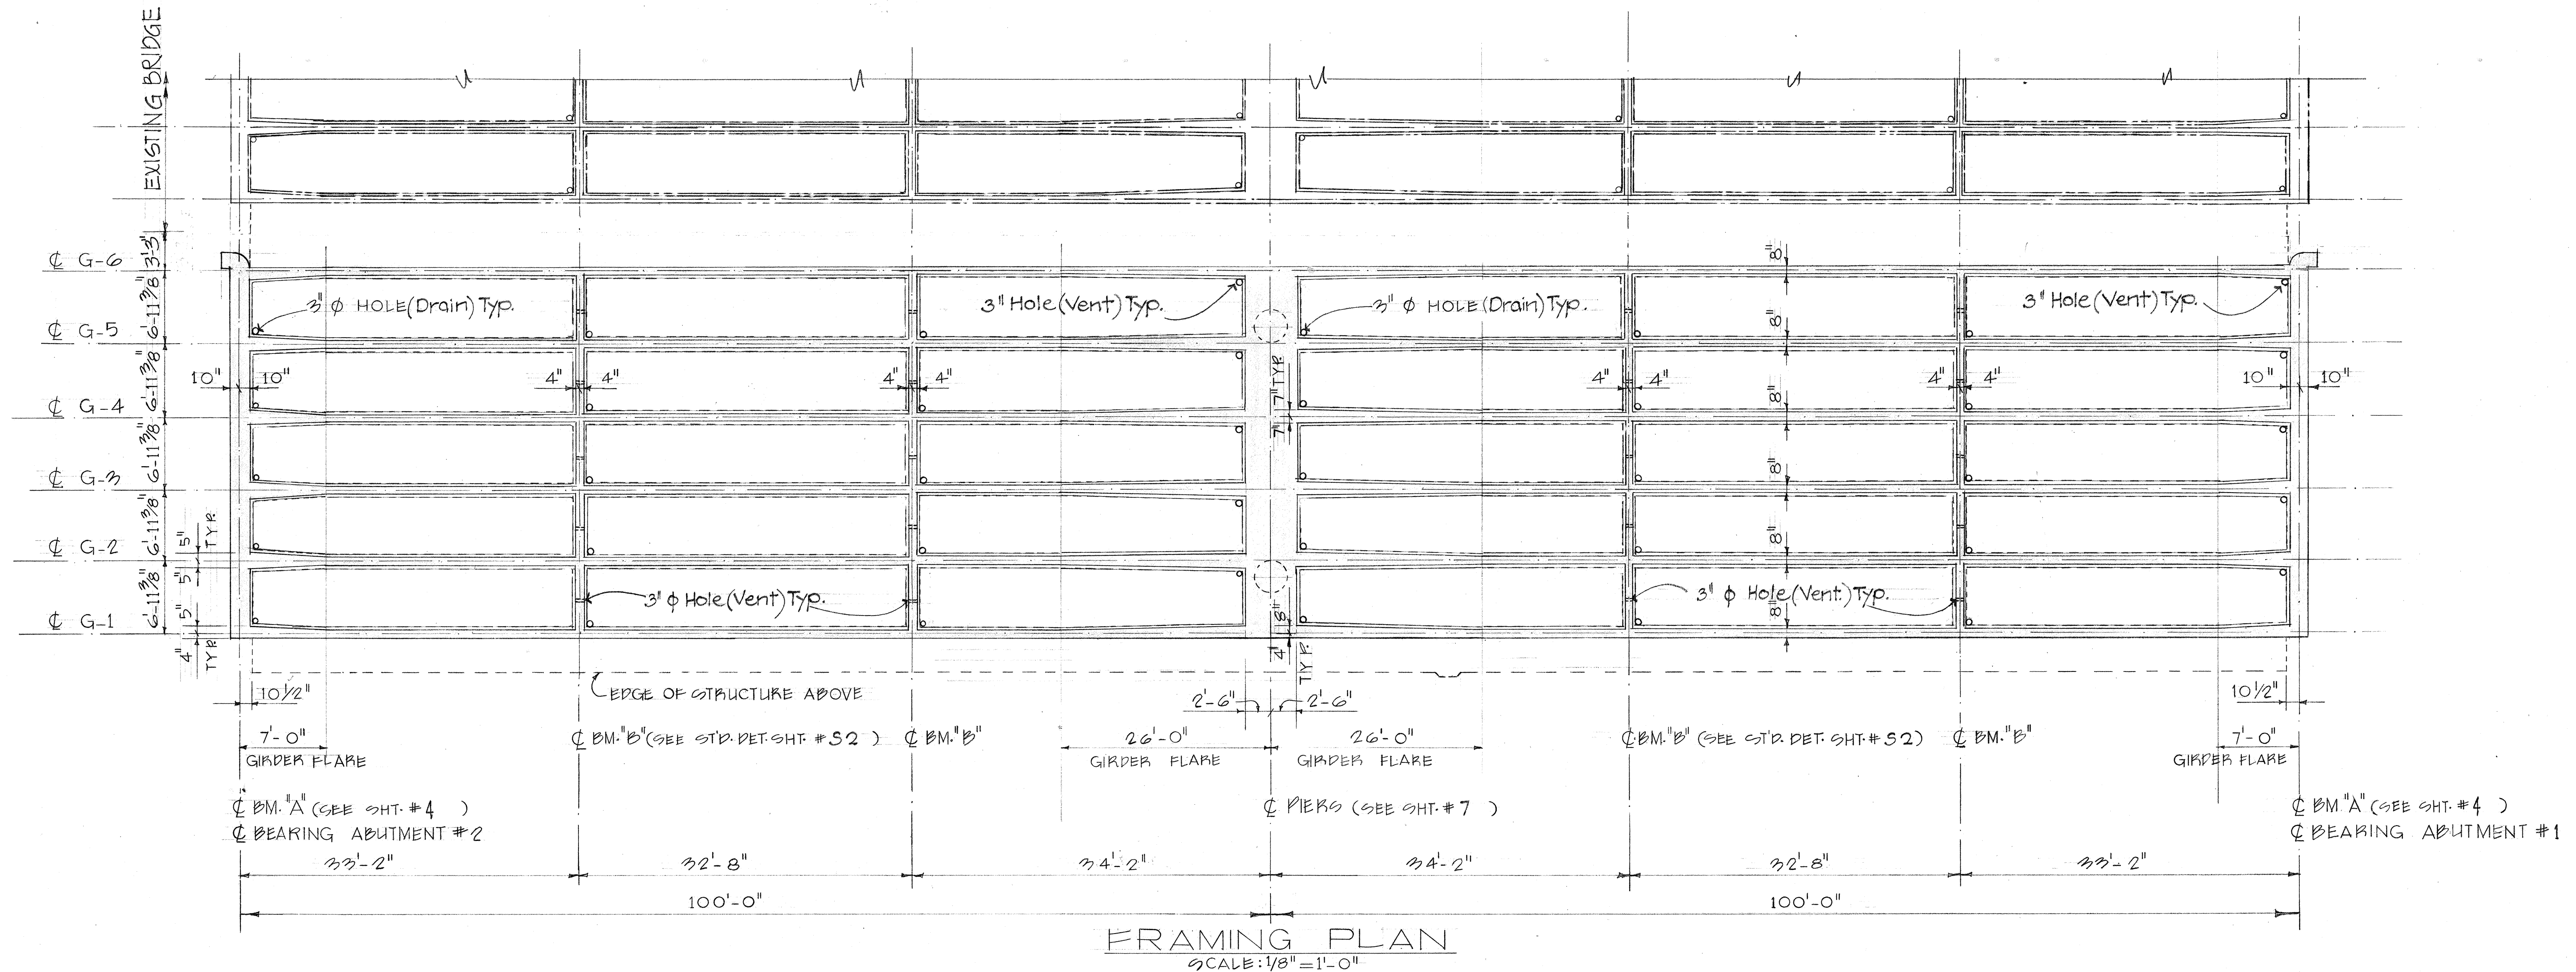

THIS WORK WAS PREPARED BY ME
OR UNDER MY SUPERVISION

C. L. PIEN

REVISION DATE	DESCRIPTION	MADE BY	APPROVED
COMMUNITY PLANNING INCORPORATED CIVIL ENGINEERS — SURVEYORS — CONSULTANT PLANNERS			
PETER HSI ASSOCIATES INC. STRUCTURAL ENGINEERS			
WAI'AU-WAIMALU ACCESS ROAD WAI'AU, OAHU, HAWAII			
OWNER: B. P. BISHOP ESTATE			
DEVELOPERS: AMFAC-TROUSDALE			
OCEANVIEW VENTURES			
TAX MAP KEY: 9-8-C2: 2 & 3			
WIDENING OF AUSTIN BISHOP GRADE SEPARATION FRAMING PLAN & LONGIT. SECTION			
APPROVED: _____			
CHIEF, DIVISION OF ENGINEERING			
REG. ENGR. CERT. NO. 470-E			

185-S4 AS BUILT

SHEET 3 OF 14 SHEETS

FILE	POCKET	FOLDER	NO.

DATE: 9-18-70

SYM. ABUT. & BRIDGE

SYM. ABOUT & PIER


BEARING ABUT. #1

NOTE:
EXCEPT AS OTHERWISE NOTED ALL SLAB BARS SHALL BE OF #11.
ALL #5 BARS SHALL BE LAPPED 2'-0" WITH THE ADJACENT #11 BARS.
BEND & PLACE ALL LONGITUDINAL BARS ALONG HORIZONTAL PLAN.


TOP SLAB REINFORCING PLAN

SCALE: HORIZ: 1/8"=1'-0"
VERT: 1/4"=1'-0"


THIS WORK WAS PREPARED BY ME
OR UNDER MY SUPERVISION

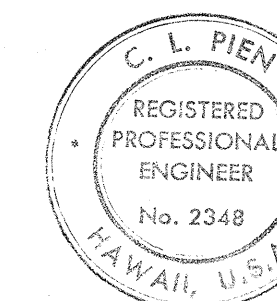

REVISION DATE	DESCRIPTION	MADE BY	APPROVED
COMMUNITY PLANNING INCORPORATED CIVIL ENGINEERS — SURVEYORS — CONSULTANT PLANNERS PETER HSI ASSOCIATES INC. STRUCTURAL ENGINEERS WAIALU-WAIMALLU ACCESS ROAD WAIALU, OAHU, HAWAII OWNER: B.P. BISHOP ESTATE OCEANVIEW VENTURES DEVELOPERS: AMFAC-TROUSDALE OCEANVIEW VENTURES TAX MAP KEY: 9-B-02: 2&3 WIDENING OF AUSTIN BISHOP GRADE SEPARATION TOP SLAB REINFORCING PLAN			
APPROVED: _____ CHIEF, DIVISION OF ENGINEERING			
REG. ENGR. CERT. NO. 470-E			
FILE	POCKET	FOLDER	NO.

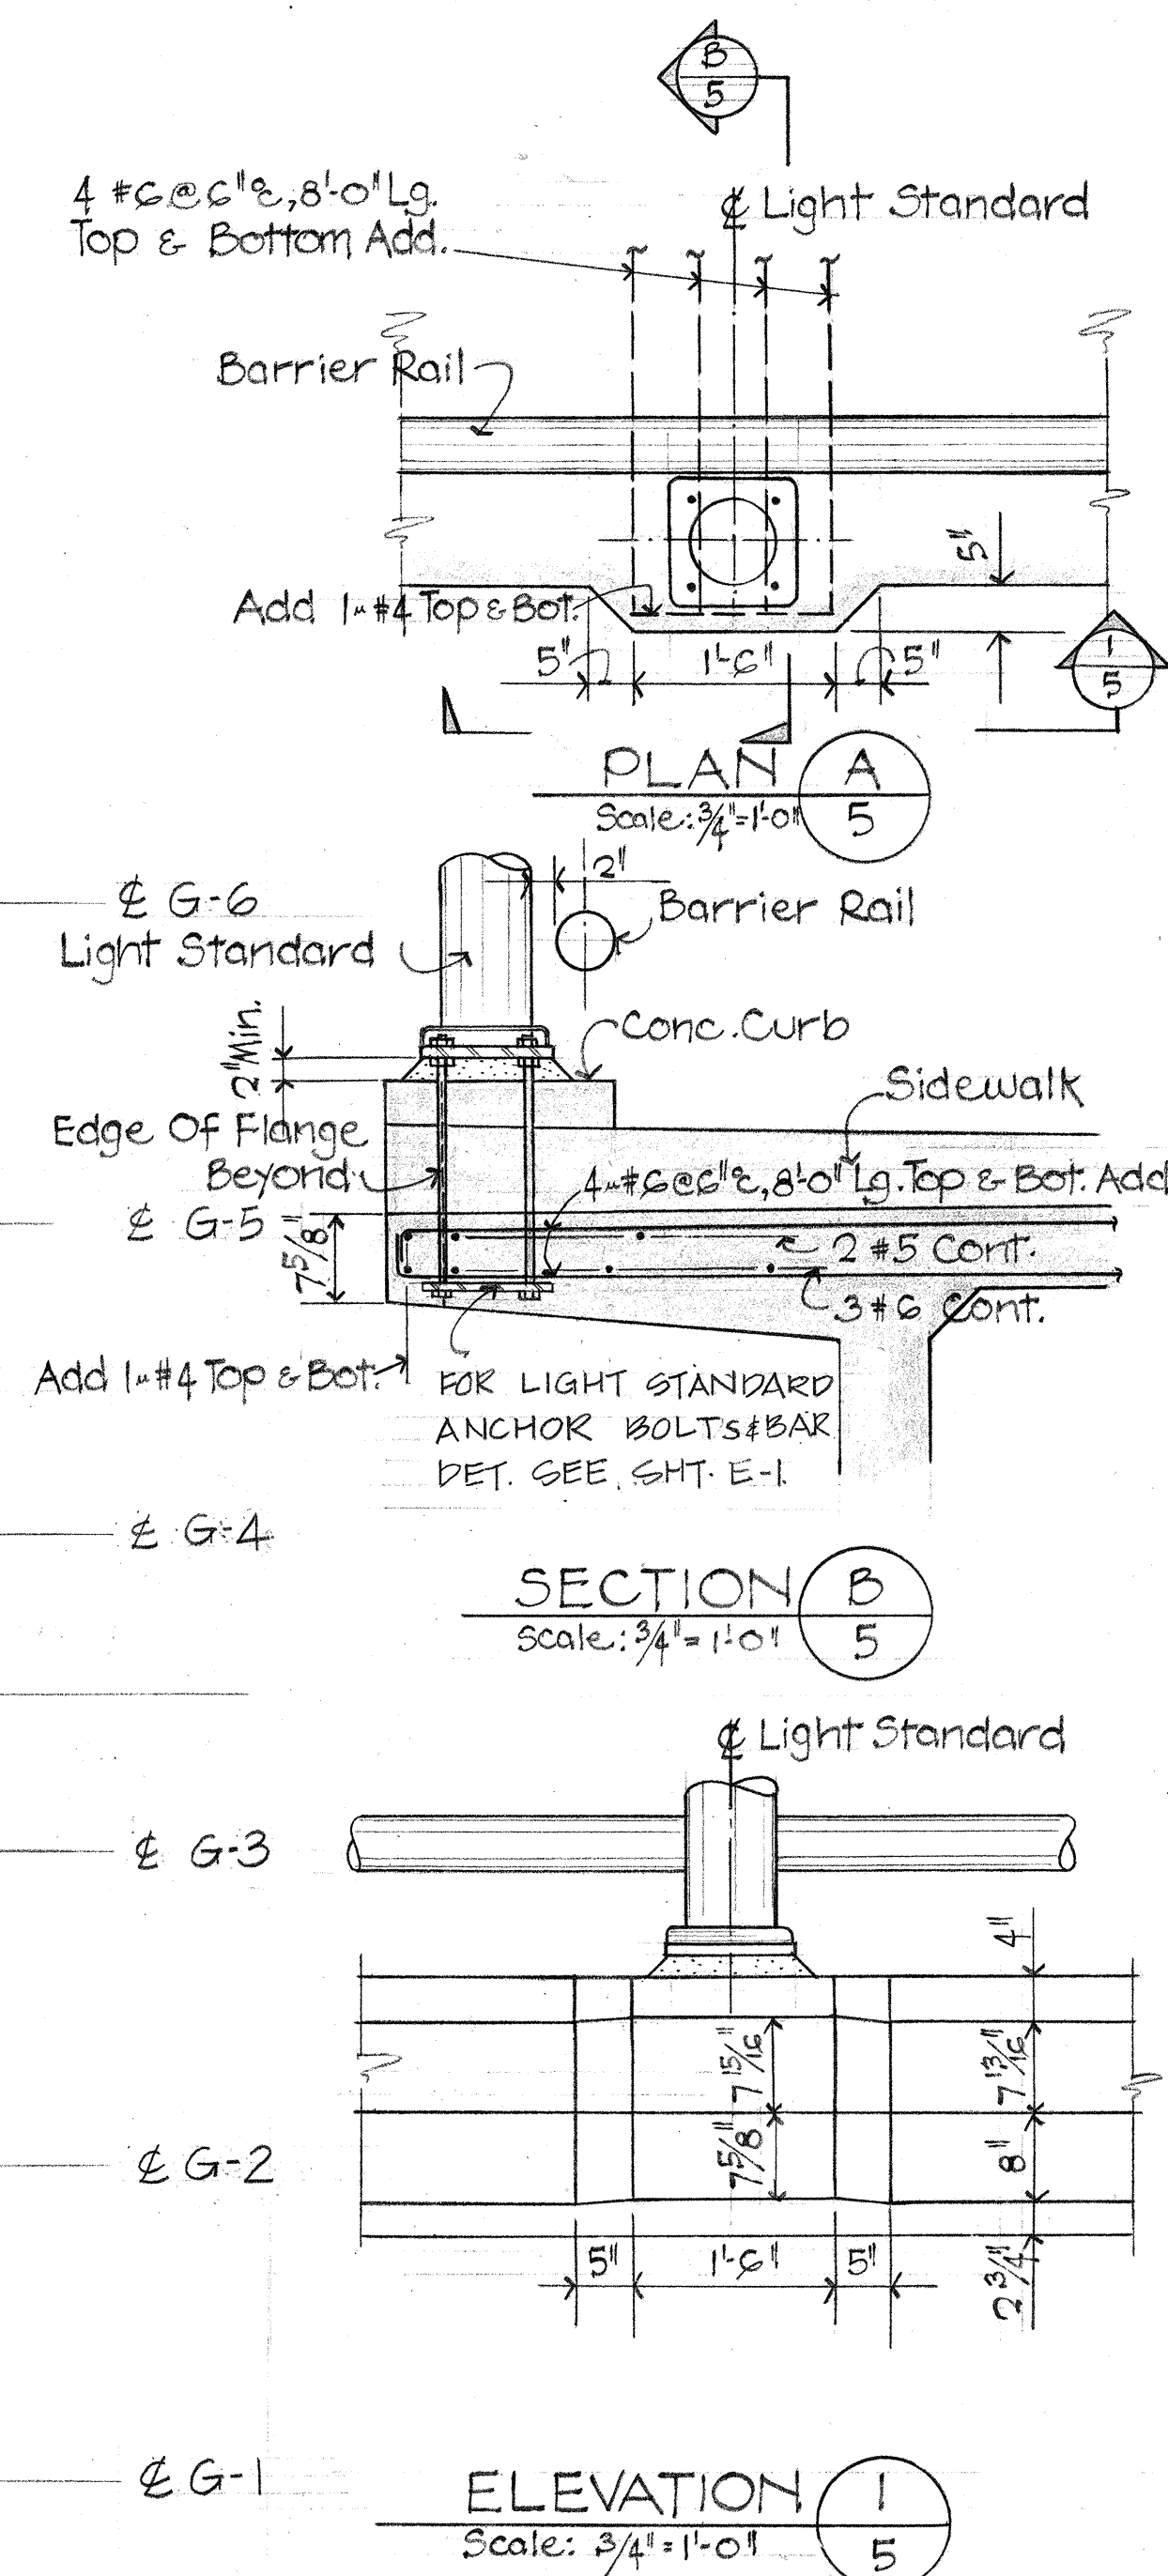


DATE: 9-18-10

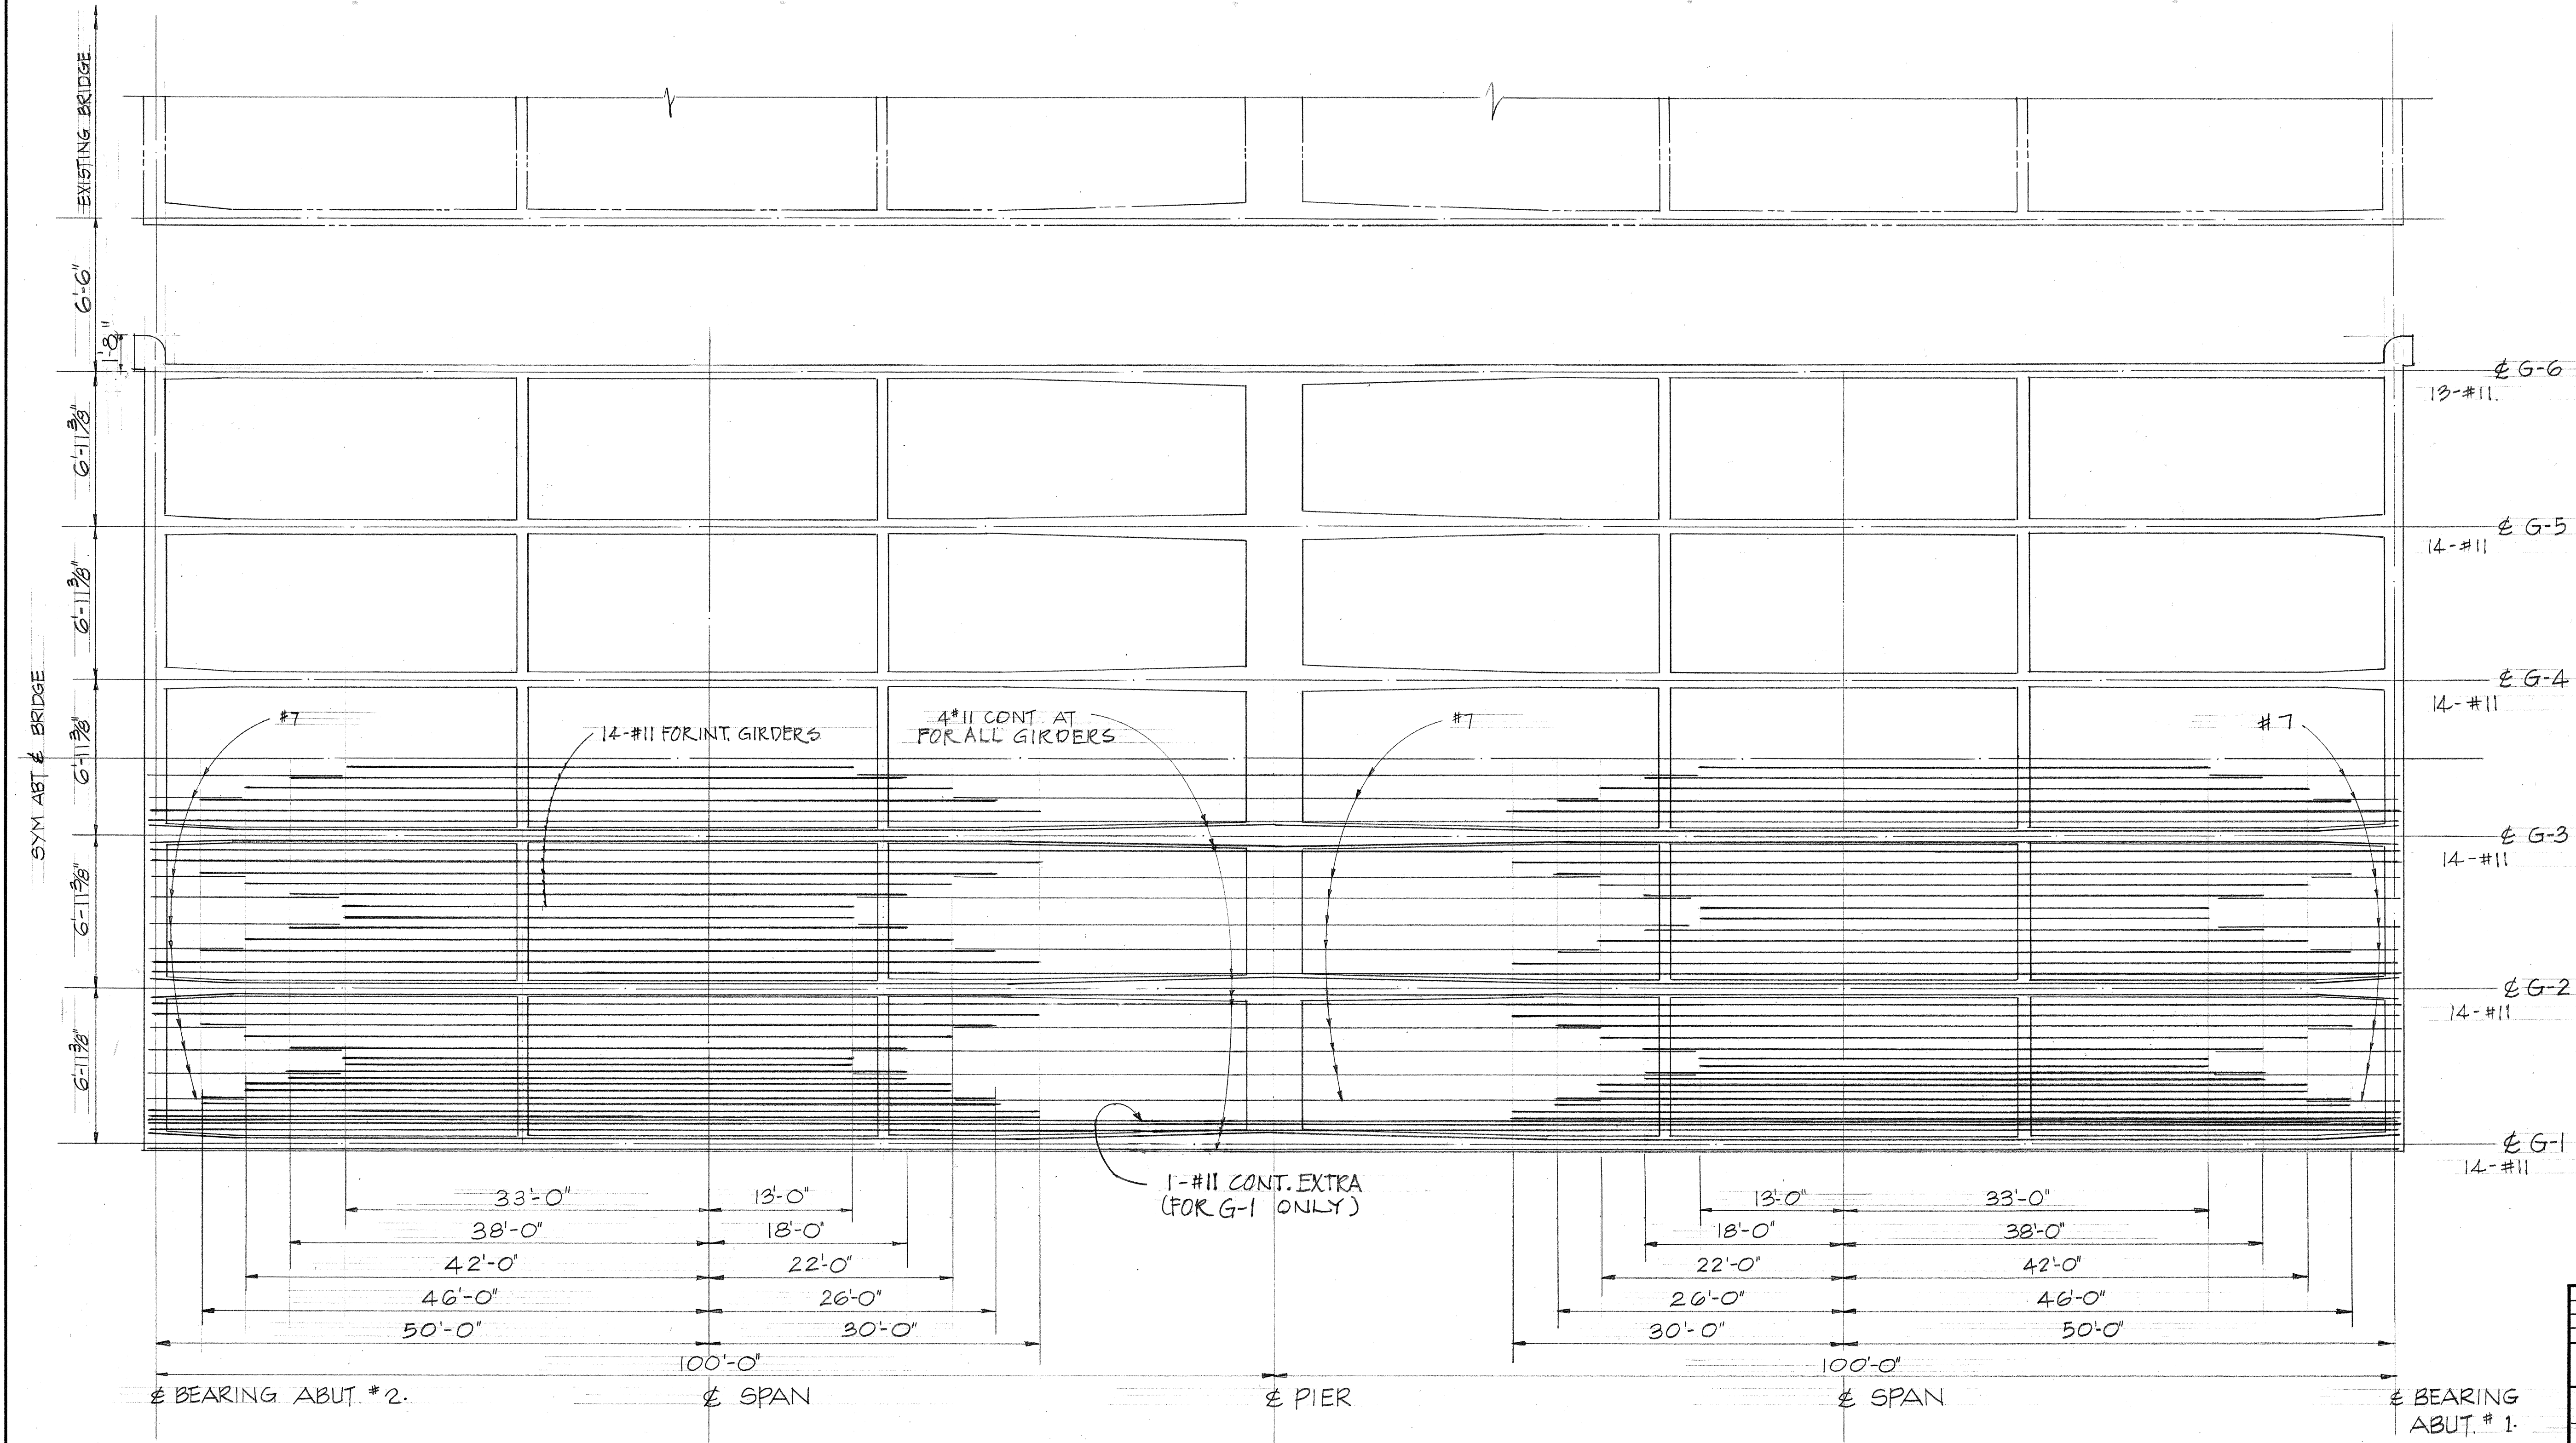

NOTE:
EXCEPT AS OTHERWISE NOTED ALL SLAB BARS SHALL BE OF #11.
ALL #7 BARS SHALL BE LAPPED 2'-6" WITH ADJACENT #11 BARS.
WHEREVER THE CLEARANCE BETWEEN MAIN REINFORCING BARS LESS THAN MIN. ALLOWABLE CLEARANCES BUNDLED BARS IN GROUP SHALL BE USED.

BOTTOM SLAB REINFORCING PLAN

SCALE: HORIZ: 1/8"=1'-0"
VERT: 1/4"=1'-0"

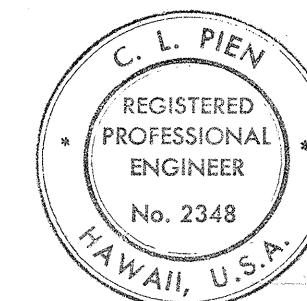


THIS WORK WAS PREPARED BY ME OR UNDER MY SUPERVISION

REVISION DATE	DESCRIPTION	MADE BY	APPROVED
COMMUNITY PLANNING INCORPORATED CIVIL ENGINEERS - SURVEYORS - CONSULTANT PLANNERS			
PETER HSI ASSOCIATES INC. STRUCTURAL ENGINEERS			
WAIKUA-WAIALAE ACCESS ROAD			
OWNER: B.P. BISHOP ESTATE			
DEVELOPERS: AMFAC-THROUSDALE			
OCEANVIEW VENTURES			
TAX MAP KEY: 9-8-02:283			
WIDENING OF AUSTIN BISHOP			
GRADE SEPARATION			
BOTTOM SLAB REINFORCING PLAN			
APPROVED:			
CHIEF, DIVISION OF ENGINEERING			
REG. ENGR. CERT. NO. 470-E			
FILE	POCKET	FOLDER	NO.


SHEET 6 OF 14 SHEETS

185-S7 AS BUILT


PIERS SYM.

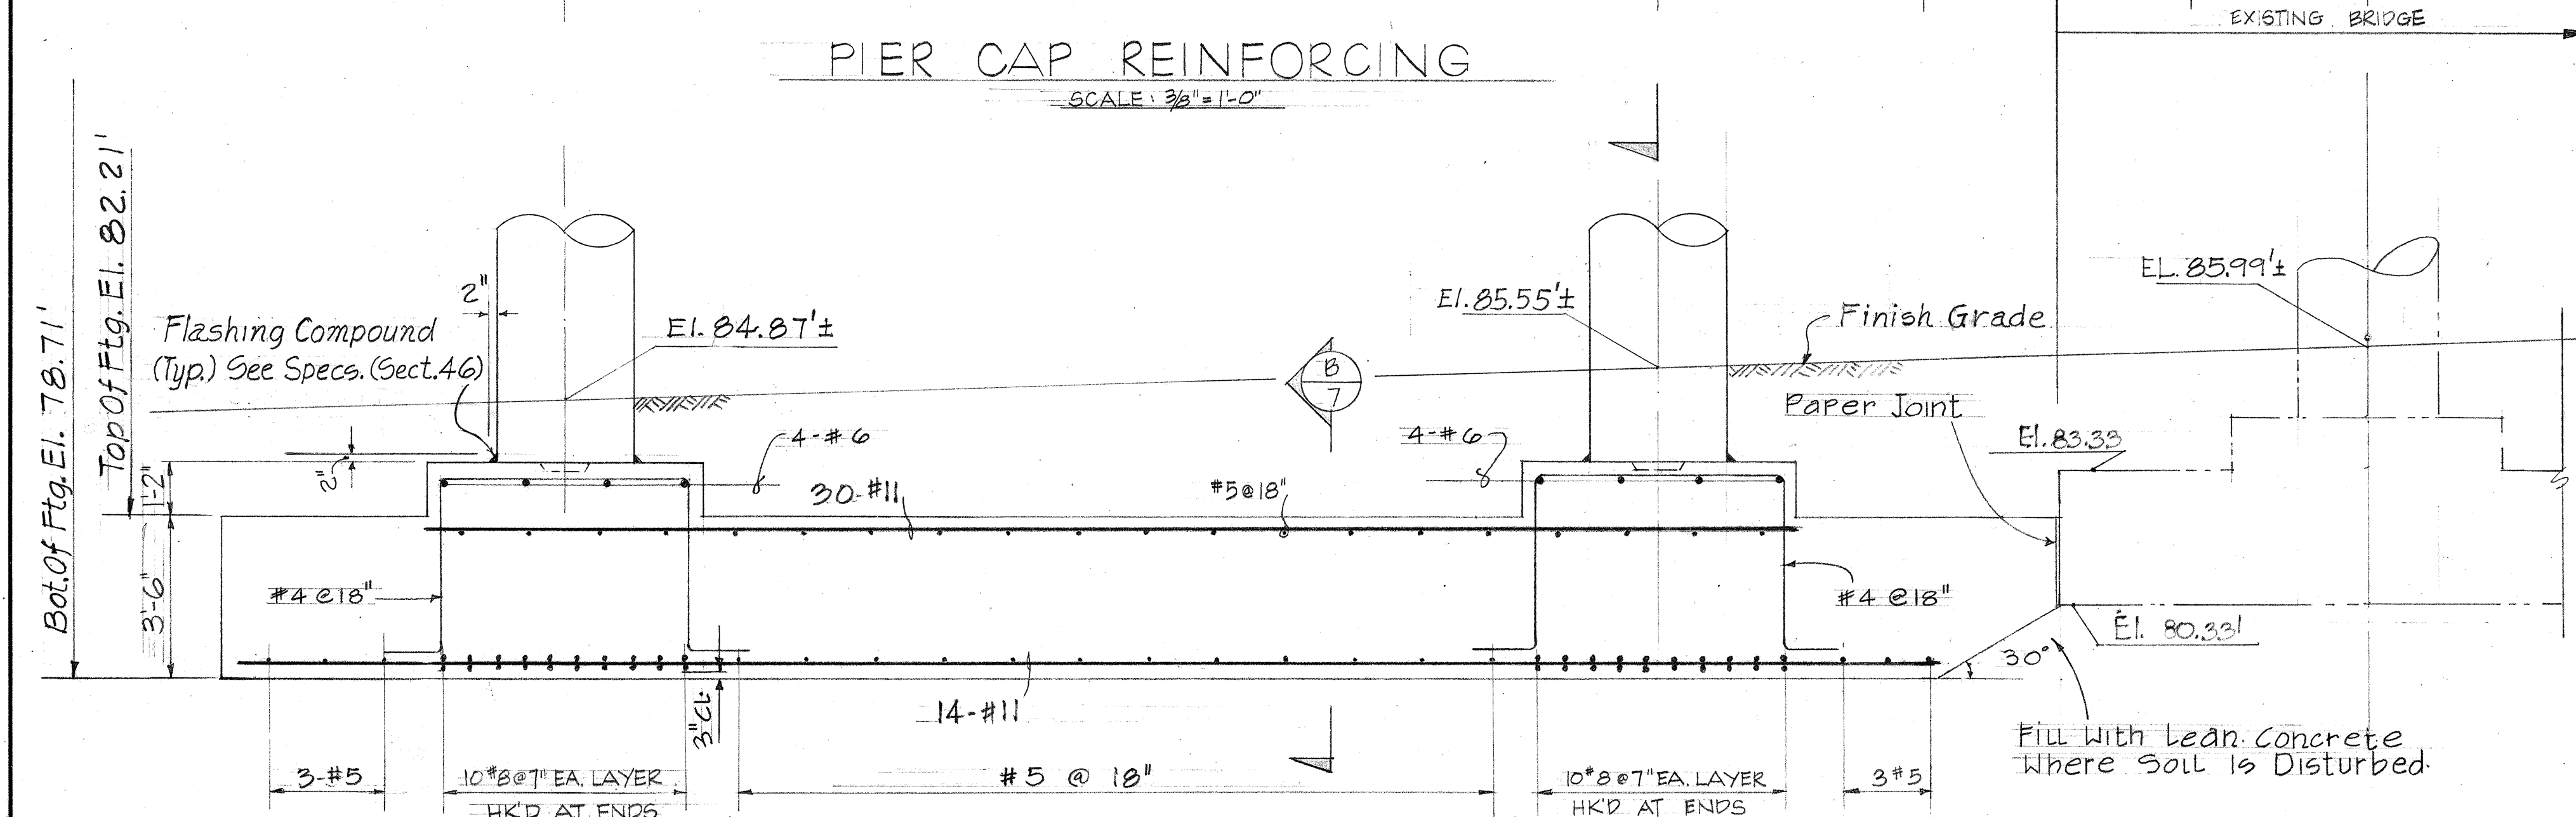


SCALE: $3/8" = 1'-0"$

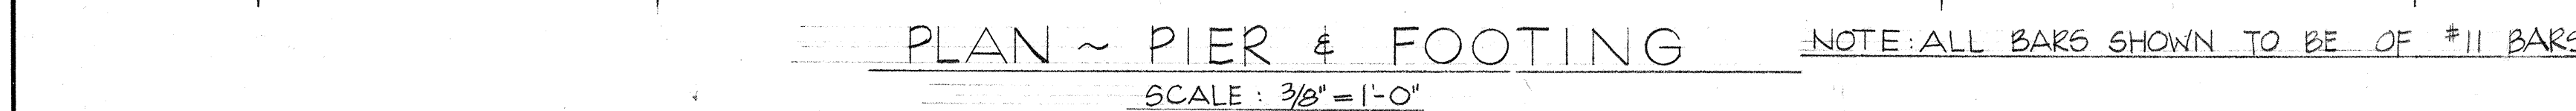

SCALE : $\frac{3}{8}" = 1'-0"$

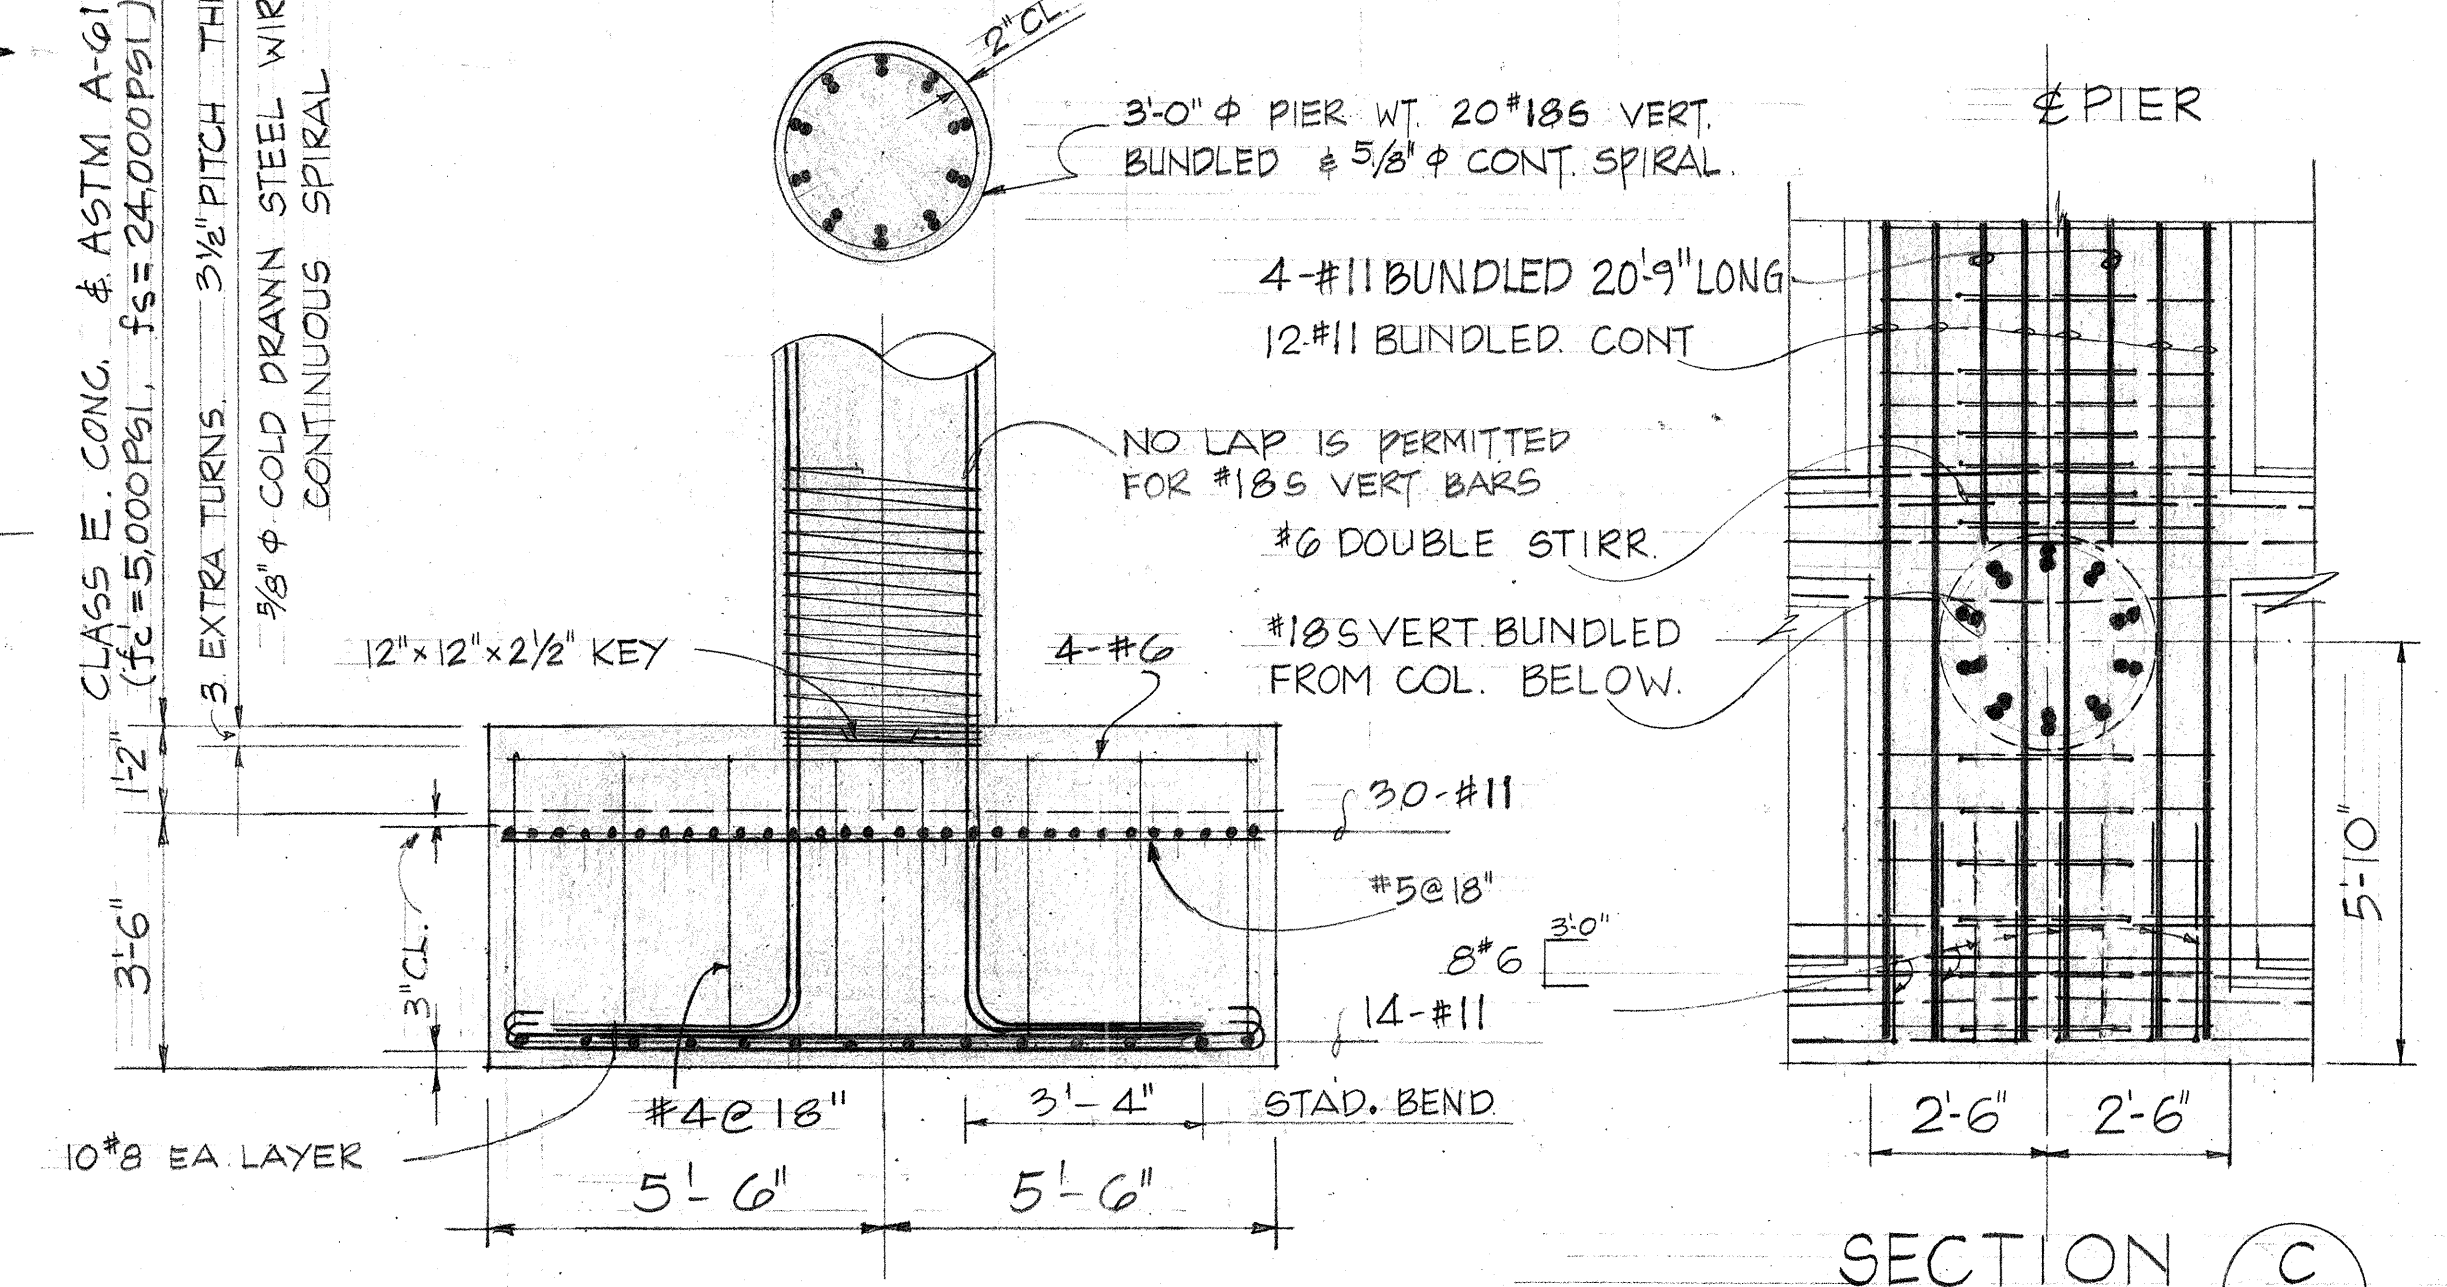

SCALE: $\frac{3}{8}'' = 1'-0''$

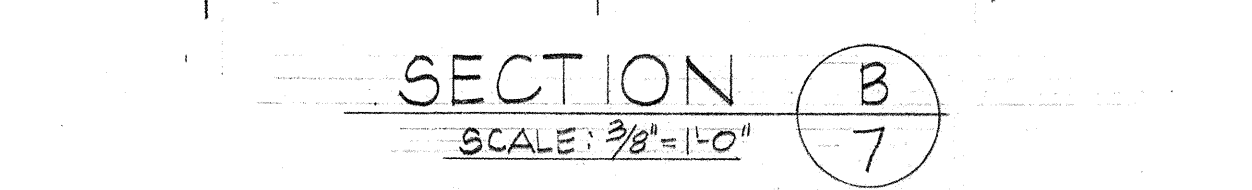

SCALE: 7/8" = 1'-0"





SHEET 7 OF 14 SHEETS

FILE	POCKET	FOLDER	NO.


SHEET 7 OF 14 SHEETS

185-S8


DATE = 9-18-170

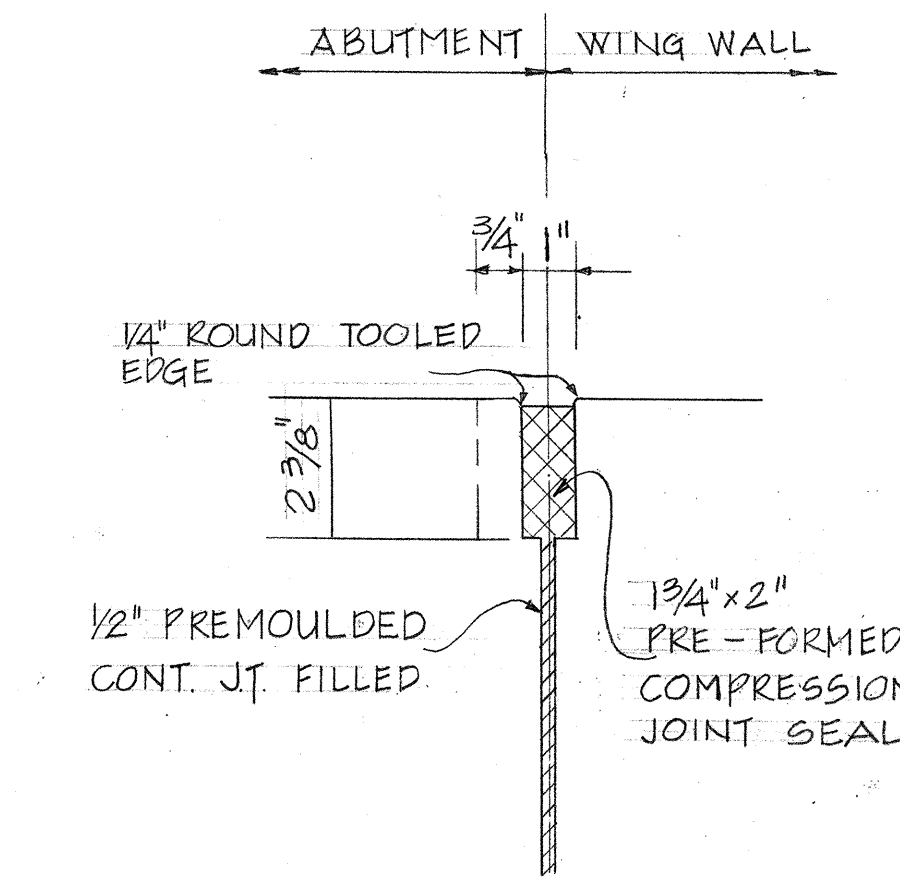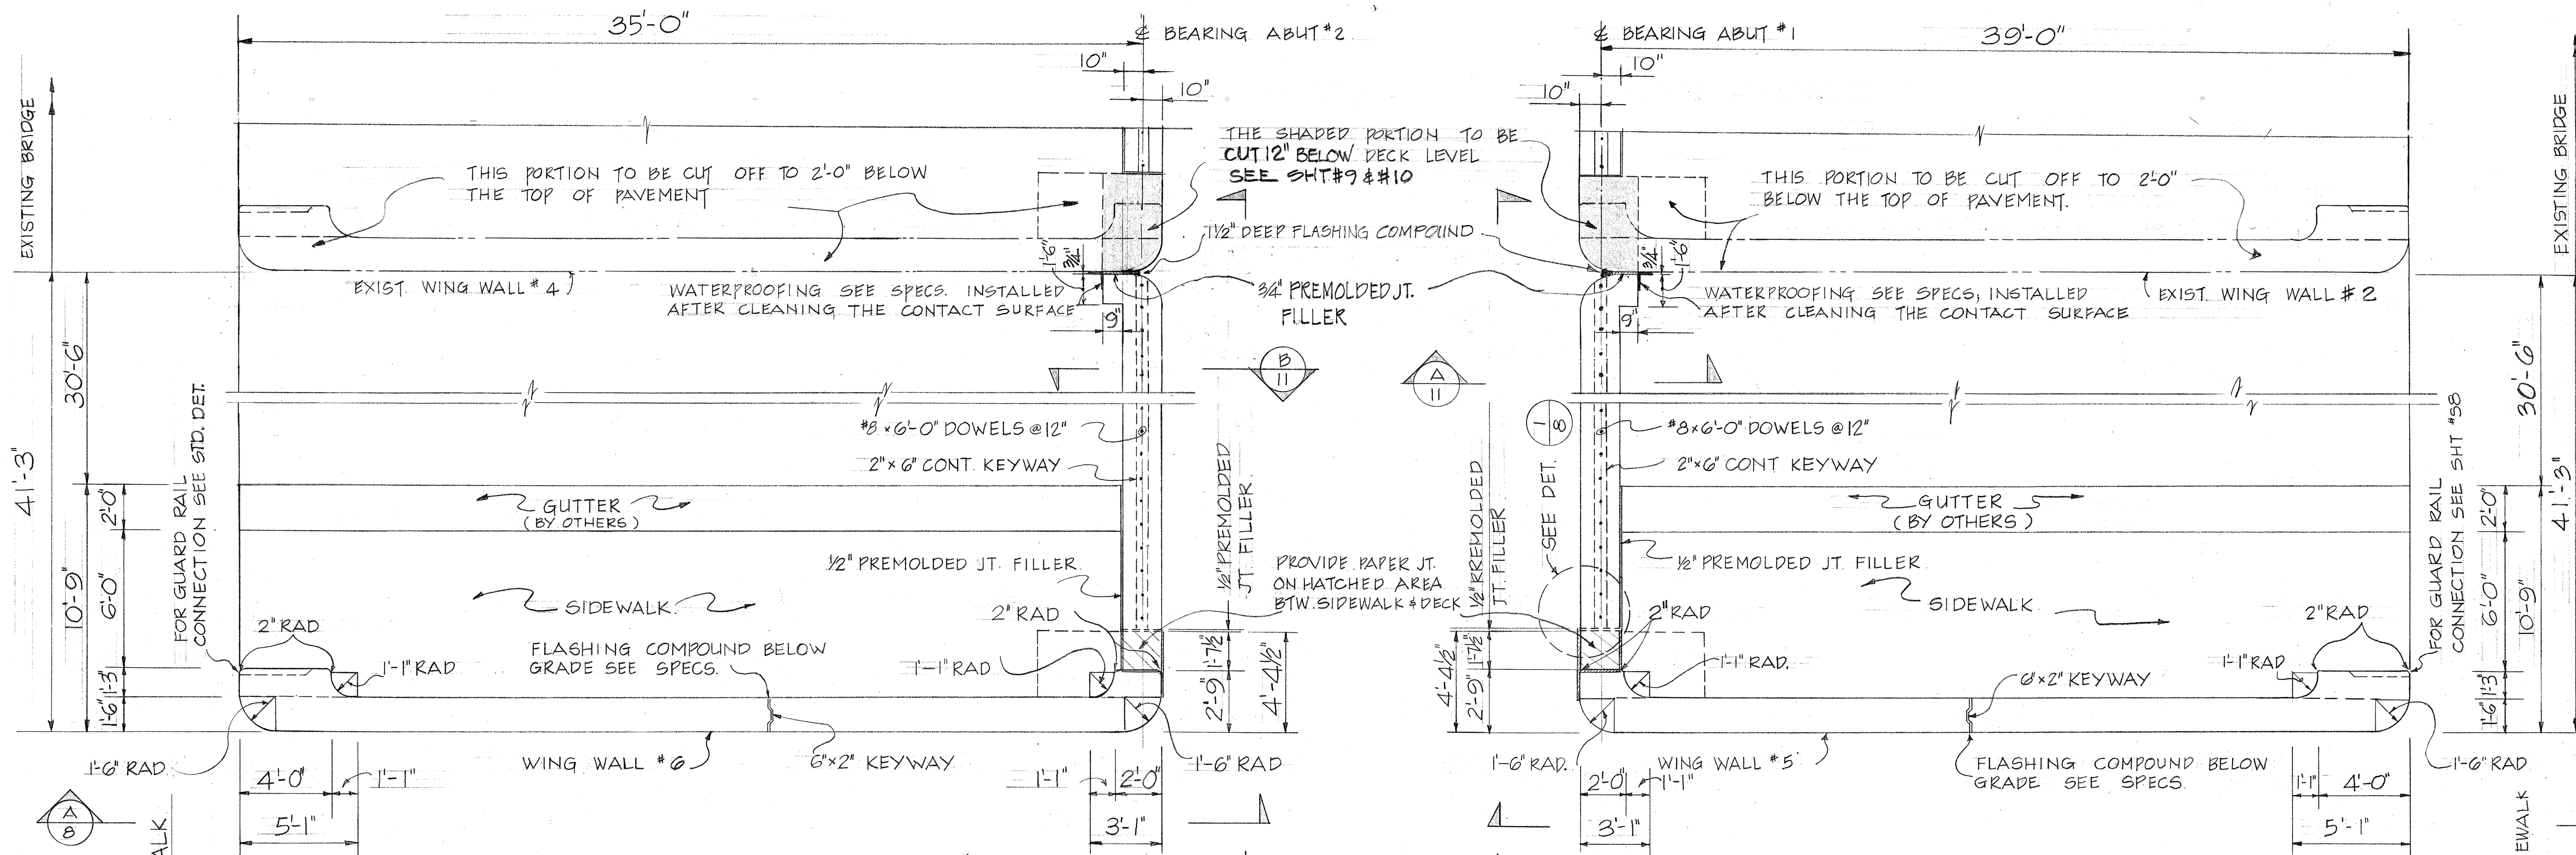


DETAIL 1
SCALE: 3/4" = 1'-0"

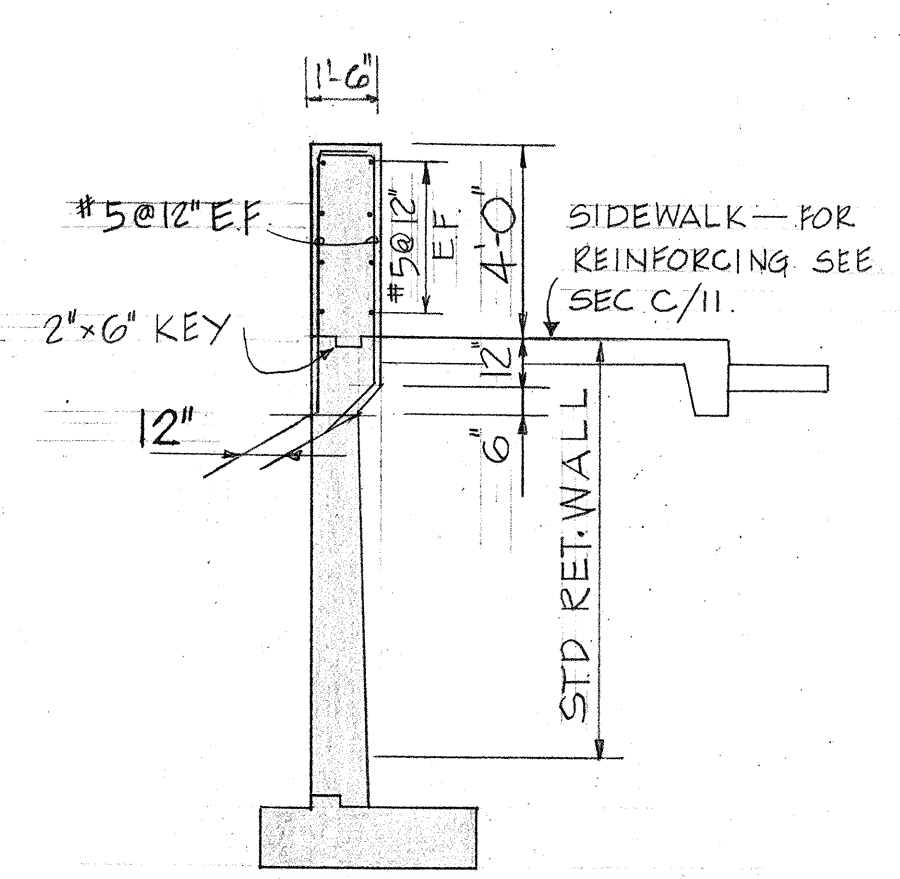


SECTION C
SCALE: 1/4" = 1'-0"

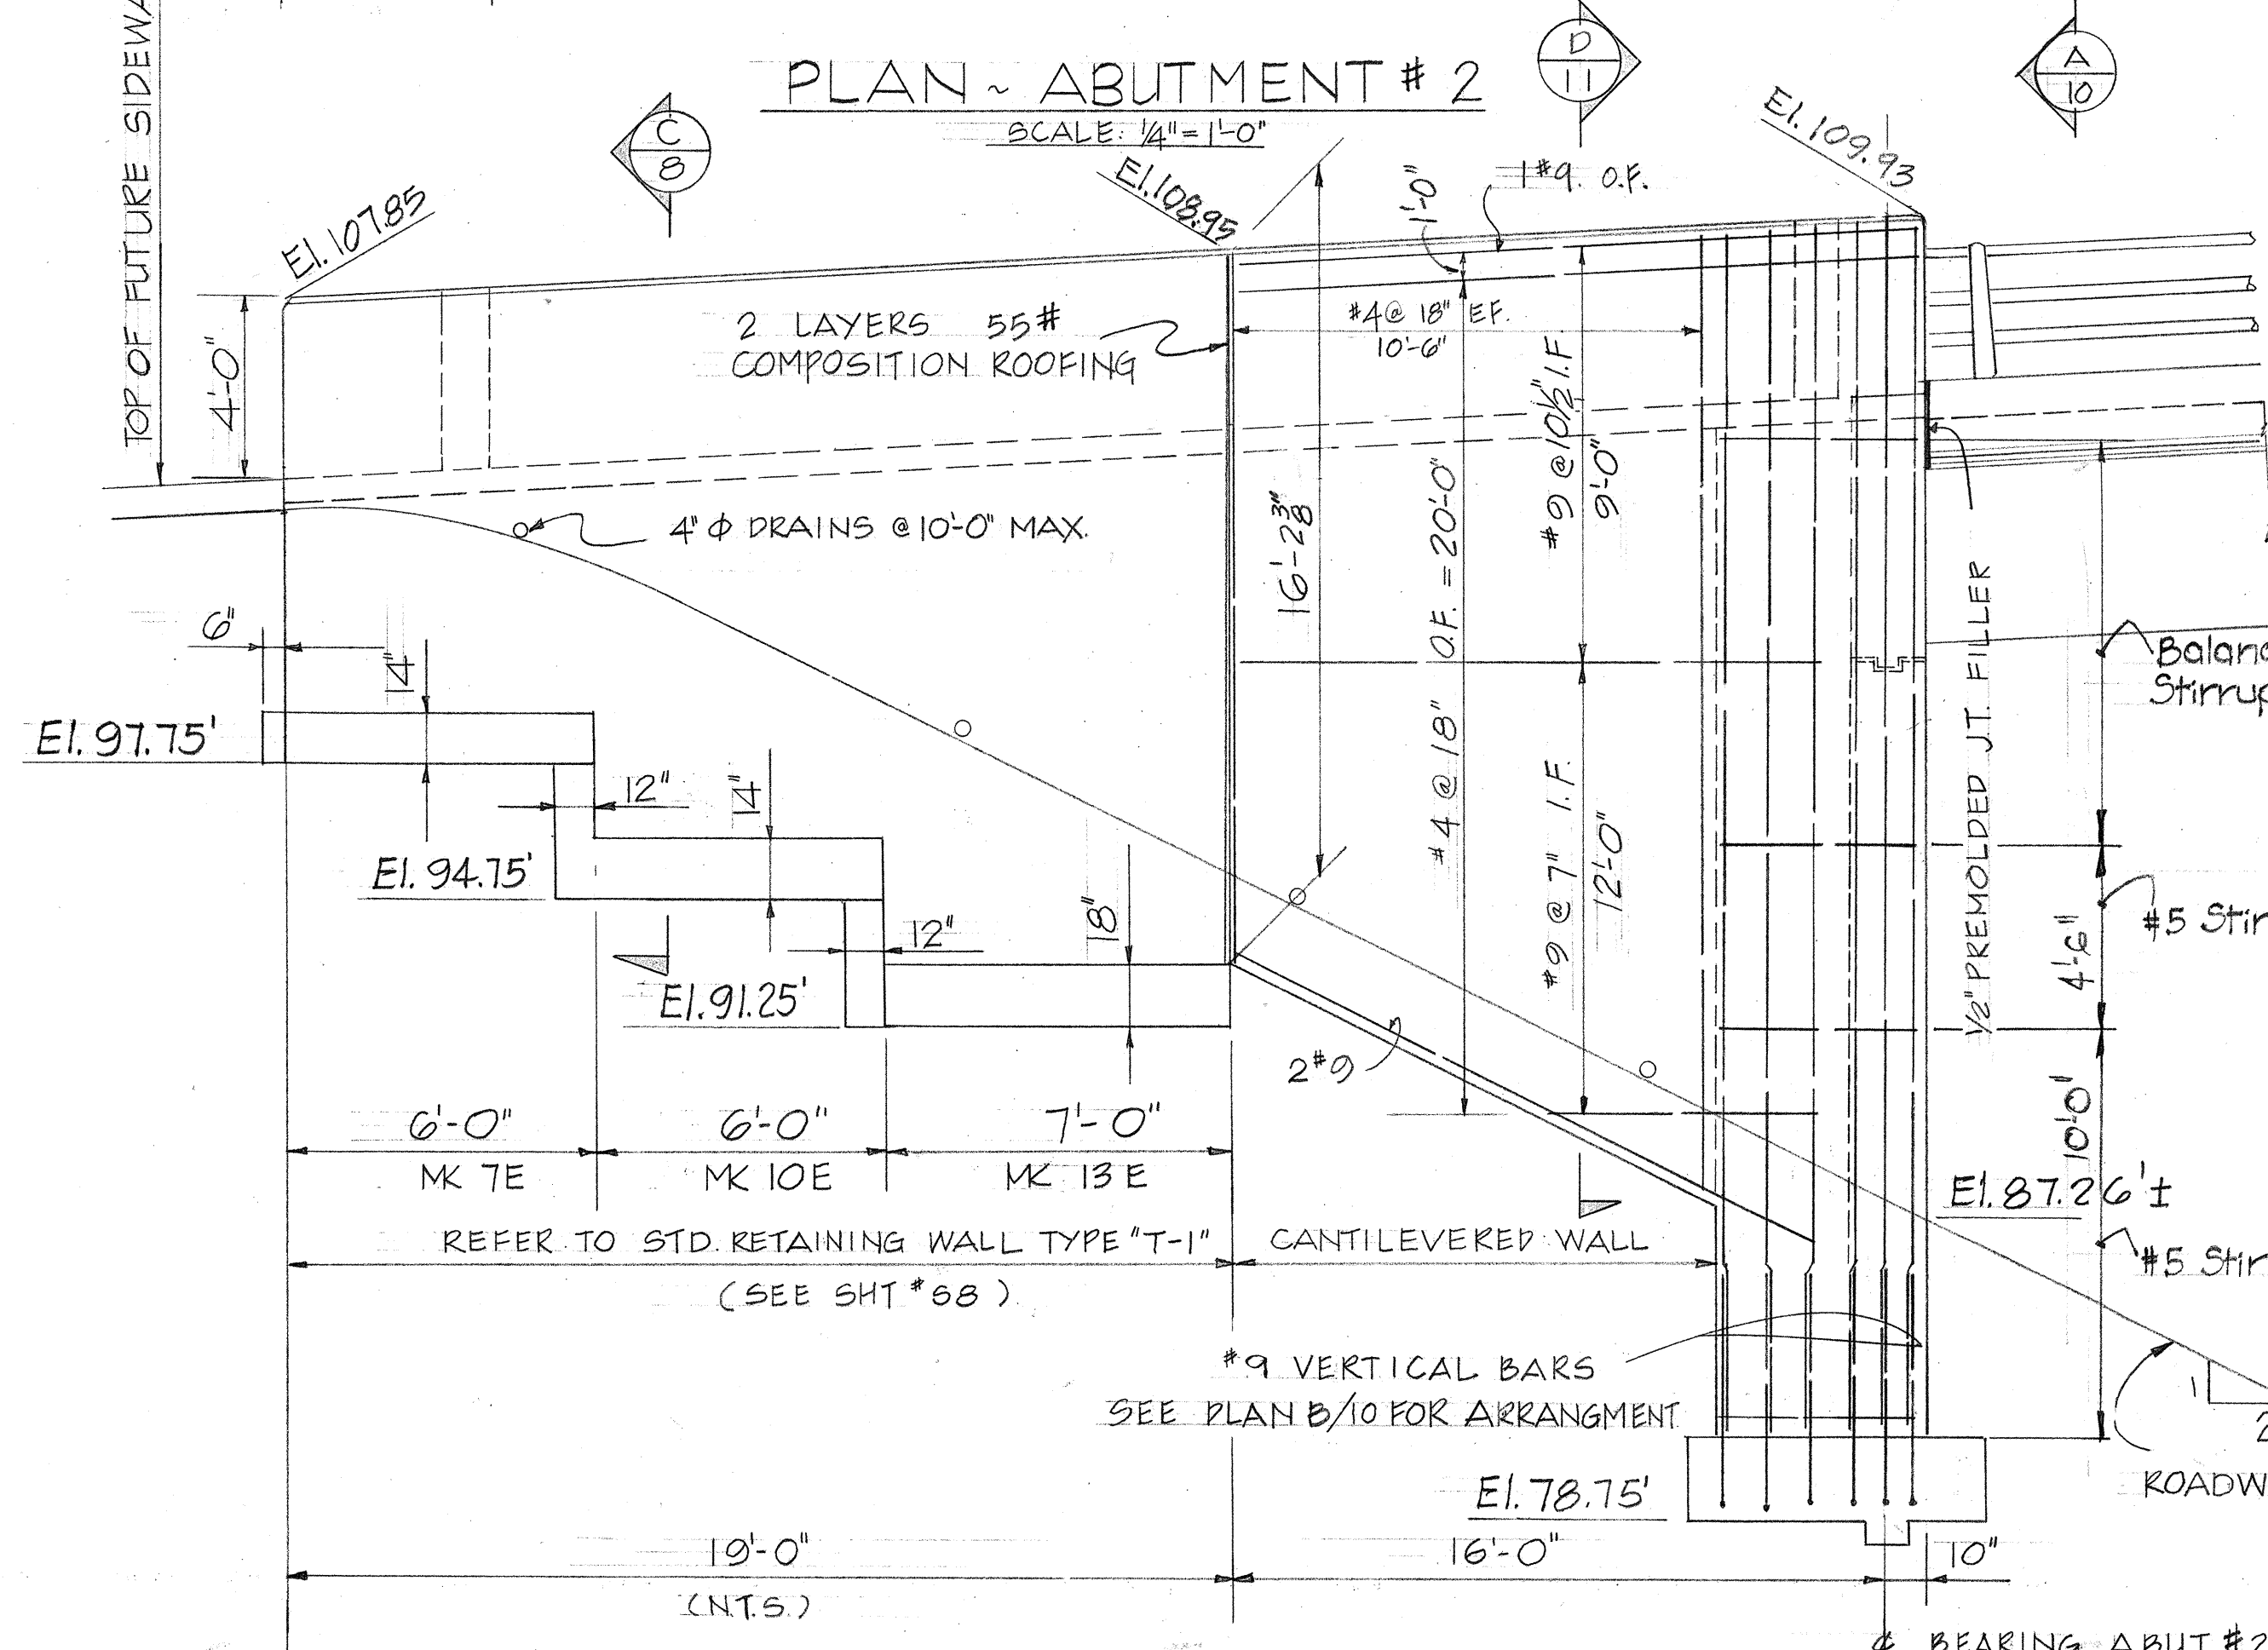

ELEVATION ~ WING WALL #6
SCALE: 1/4" = 1'-0"
(FOR LOCATION SEE PLAN SHT #1)

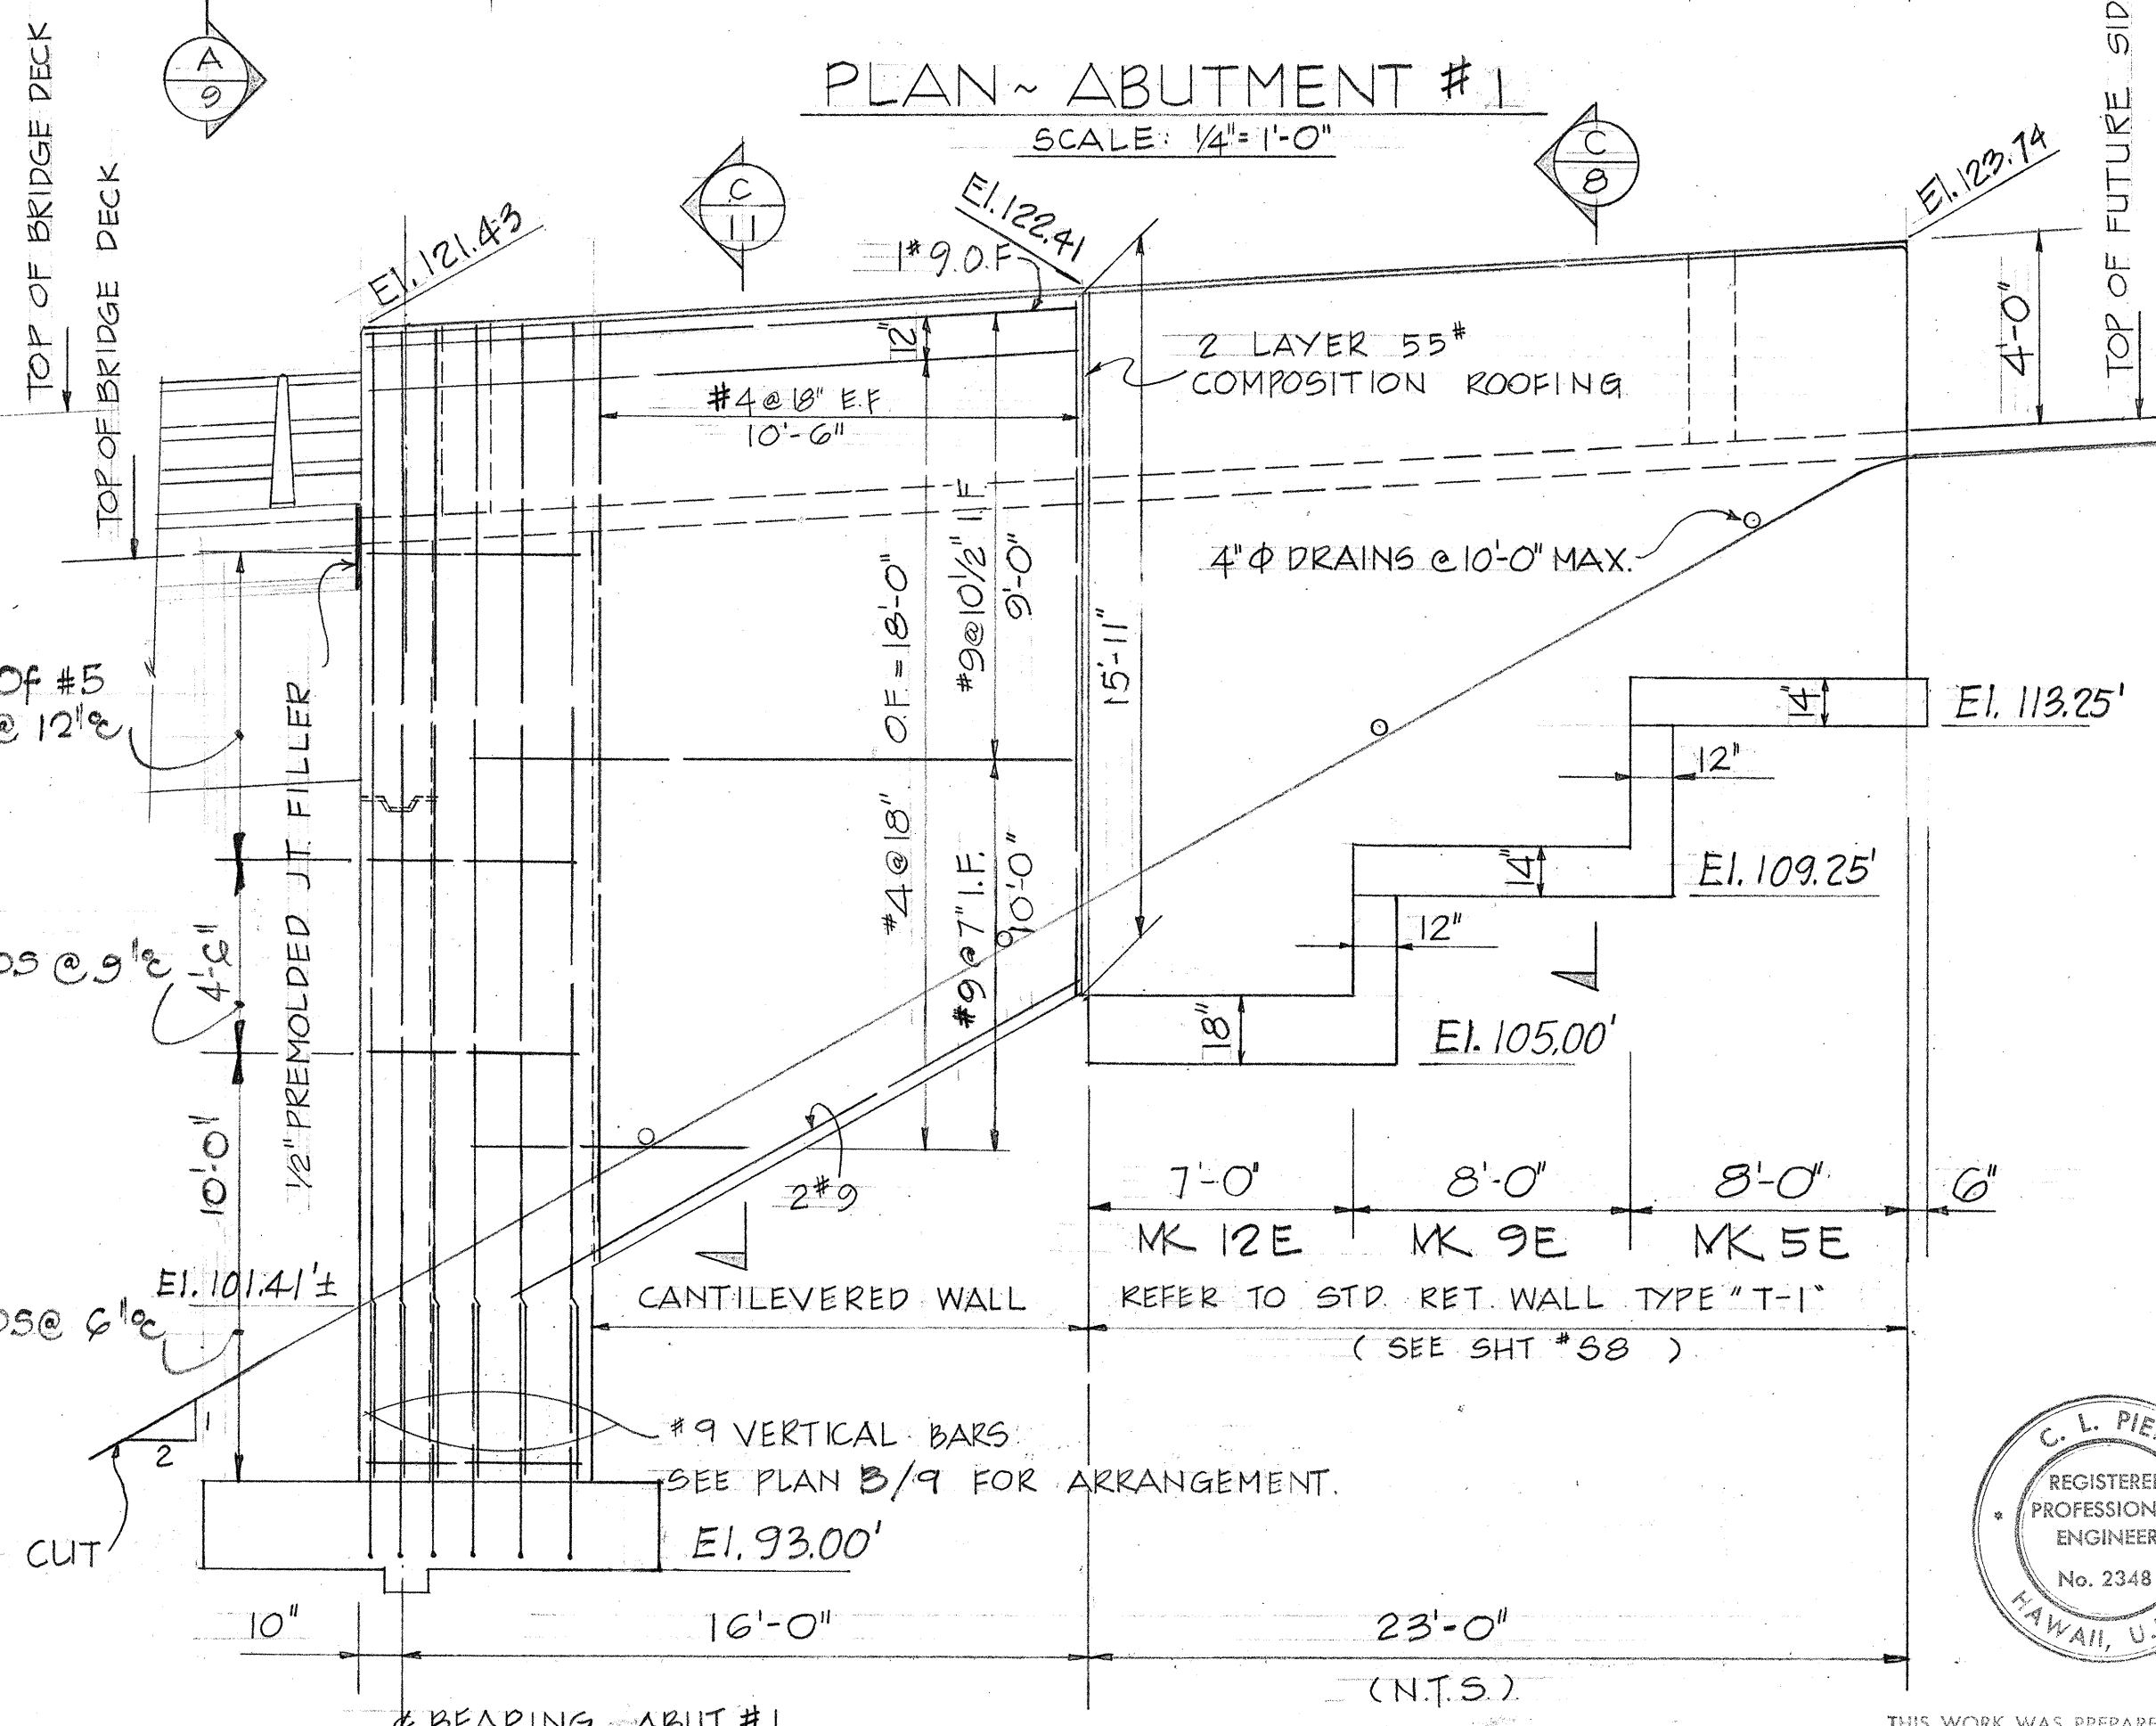

ELEVATION ~ WING WALL #5
SCALE: 1/4" = 1'-0"
(FOR LOCATION SEE PLAN SHT #1)

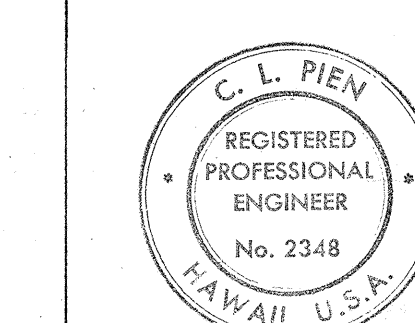




THIS WORK WAS PREPARED BY ME OR UNDER MY SUPERVISION

REVISION DATE	DESCRIPTION	MADE BY	APPROVED
COMMUNITY PLANNING INCORPORATED			
CIVIL ENGINEERS - SURVEYORS - CONSULTANT PLANNERS			
PETER HSI ASSOCIATES INC.			
STRUCTURAL ENGINEERS			
WAIKUA-WAIMALU ACCESS ROAD			
WAIKUA, OAHU, HAWAII			
OWNER: B.P. BISHOP ESTATE			
DEVELOPERS: OCEANVIEW VENTURES			
TAX MAP KEY: 9-8-02:2&3			
WIDENING OF AUSTIN BISHOP			
GRADE SEPARATION			
PLAN & ELEV. ABUTMENT #1 & #2			
APPROVED:			
CHIEF, DIVISION OF ENGINEERING			
REG. ENGR. CERT. NO. 470-E			
FILE	POCKET	FOLDER	NO.

185-S9 AS BUILT

SHEET 8 OF 14 SHEETS

K+E CRYSTALEND® LA 3681
TEACHING PAPER

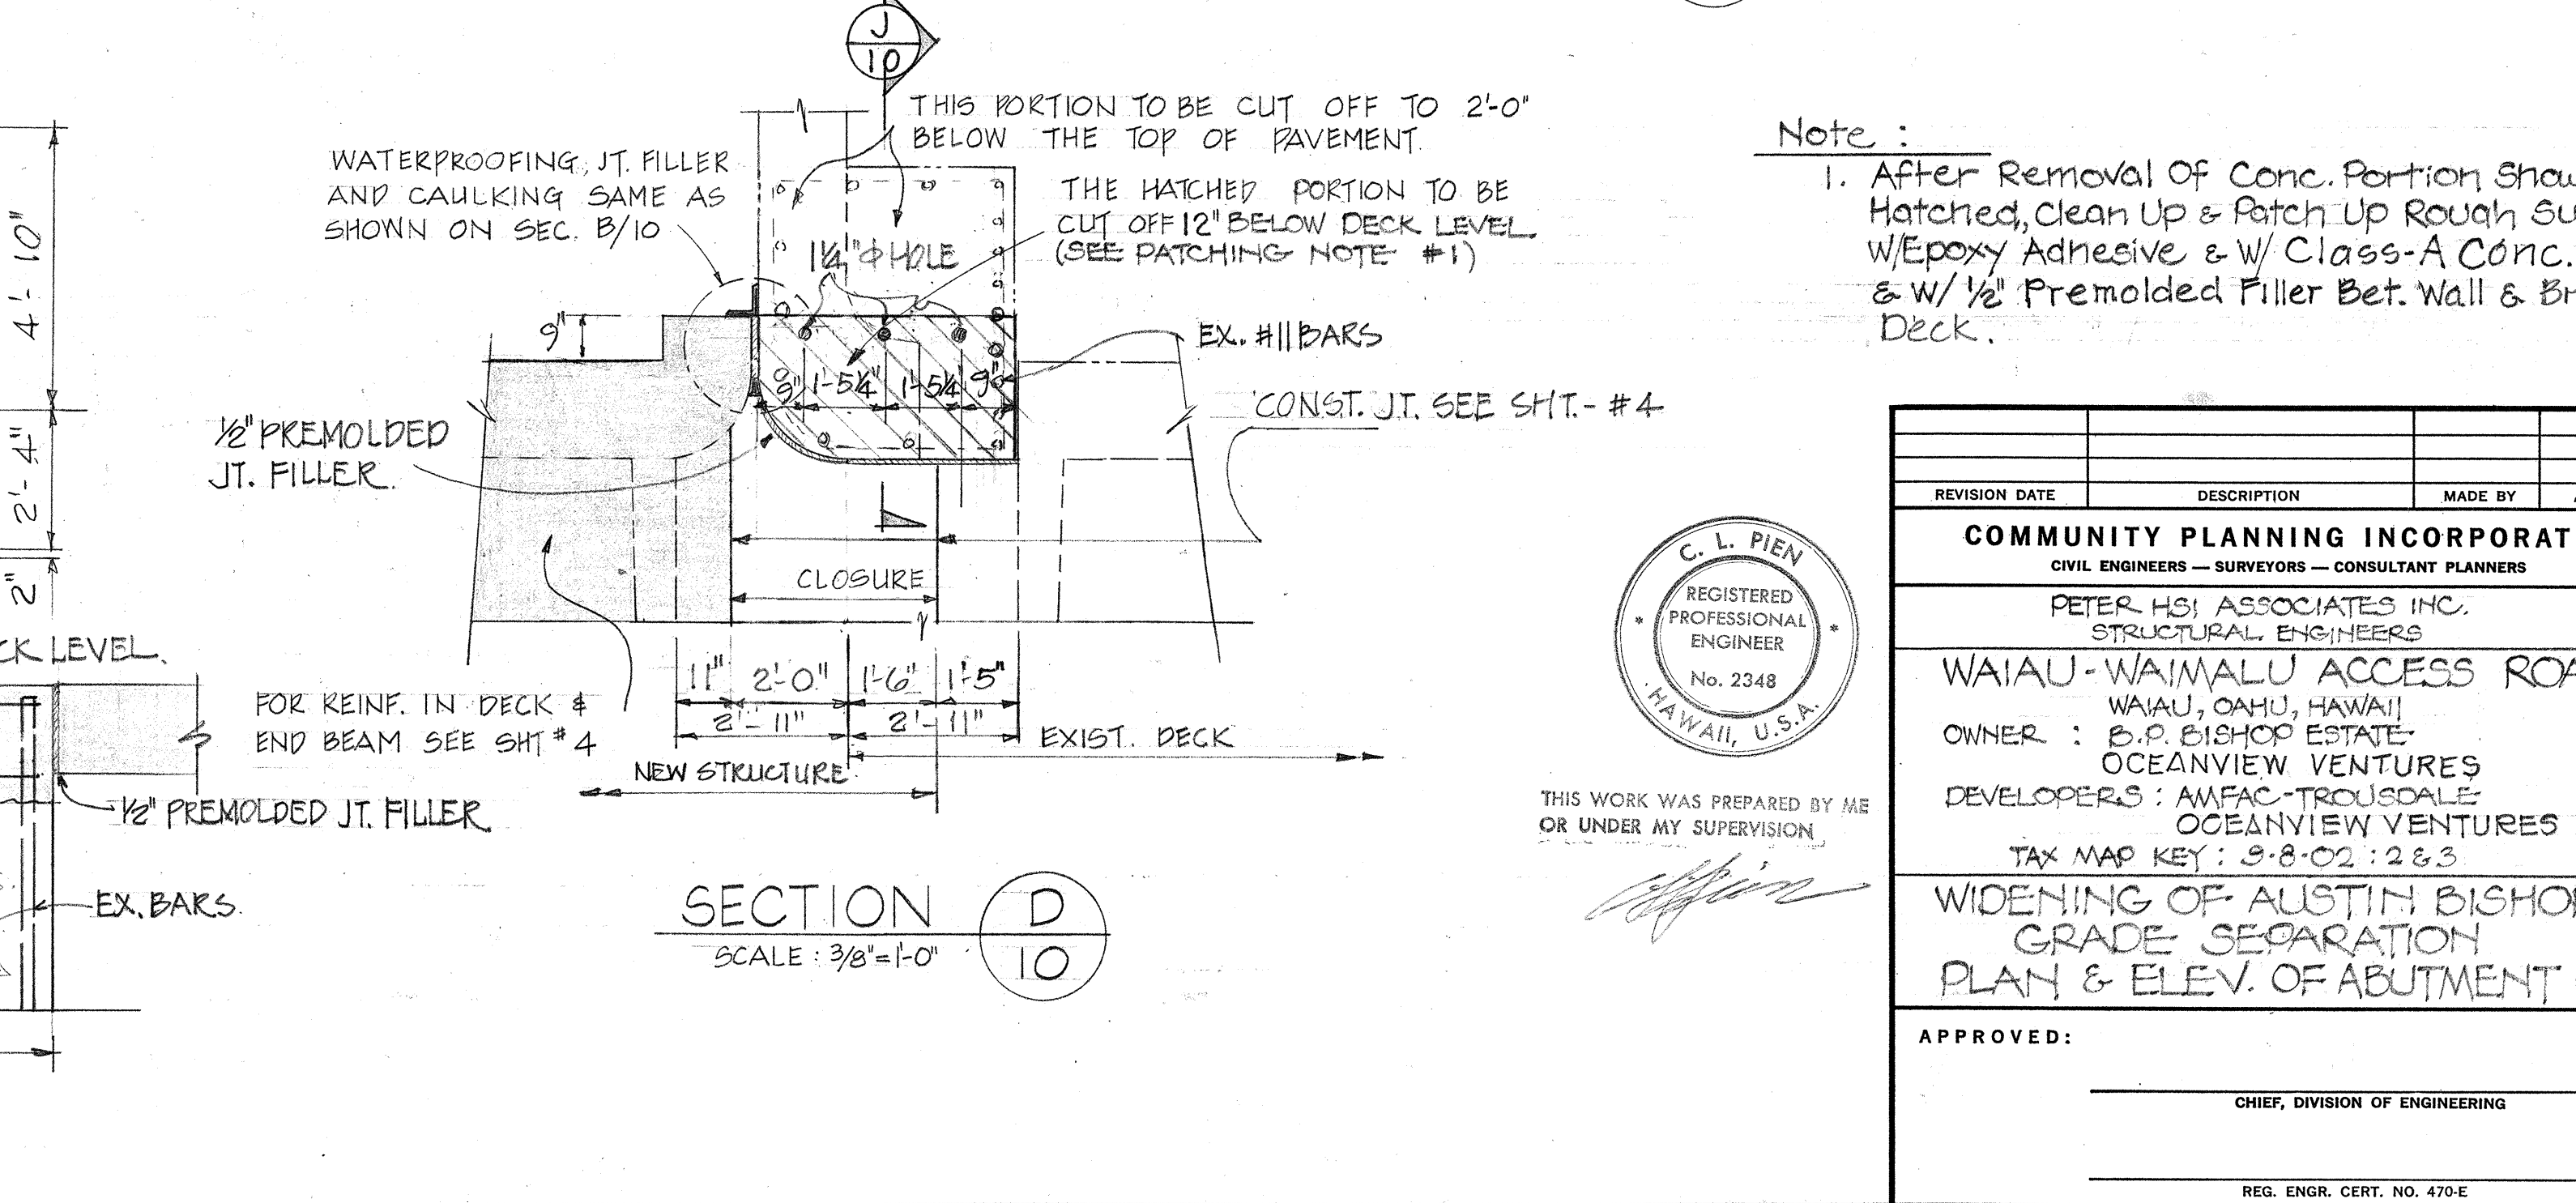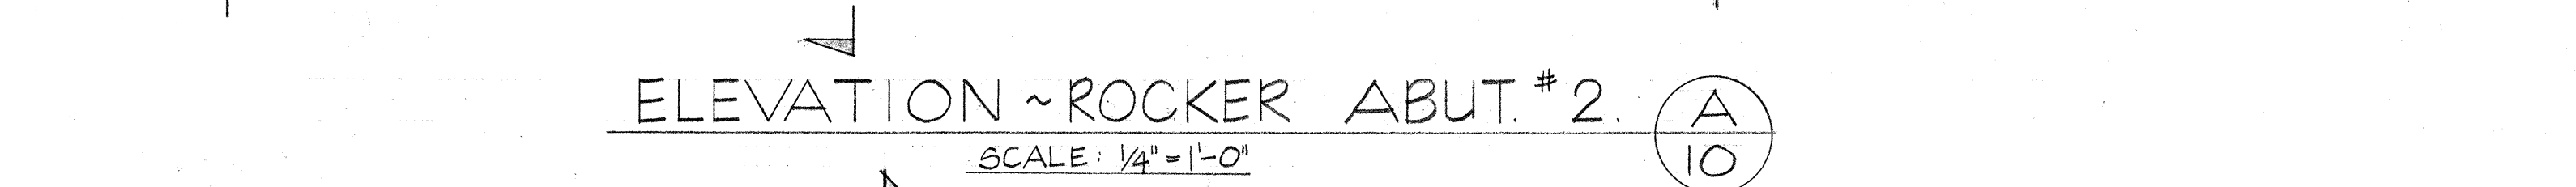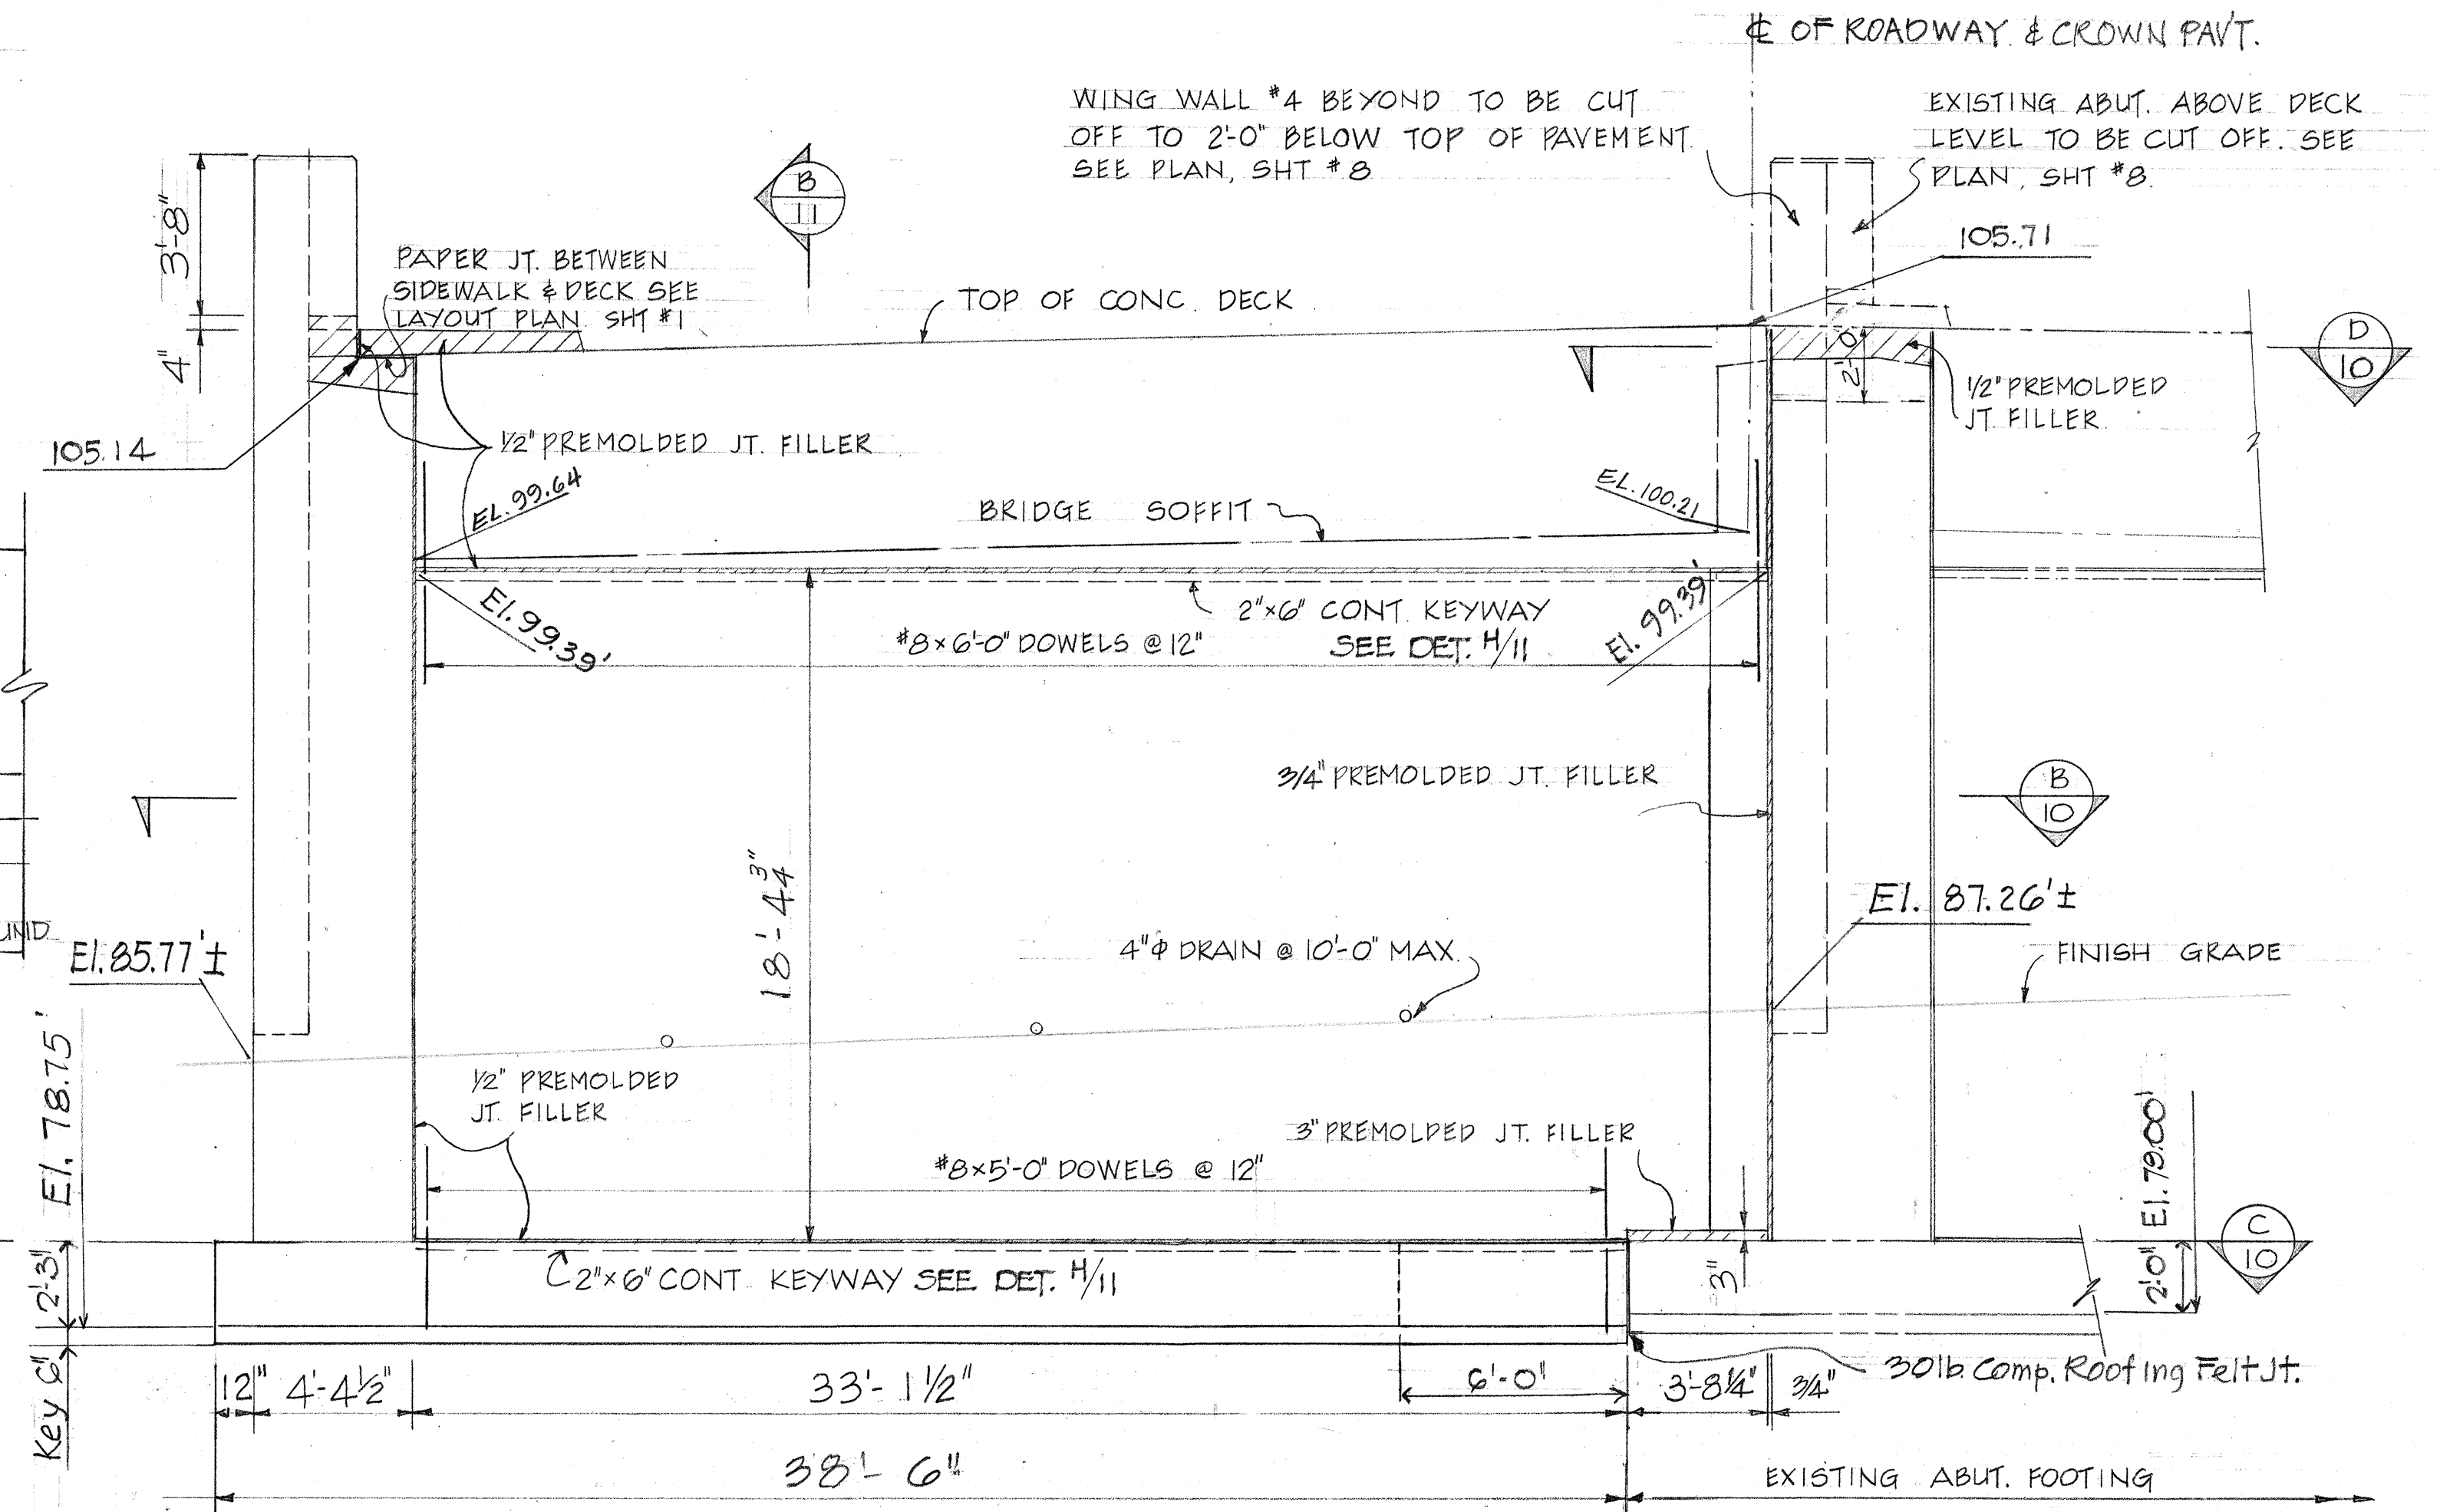

Note:


1. After Removal Of Conc. Portion Shown Hatched, Clean Up & Patch Up Rough Surface w/Epoxy Adhesive & w/ Class-A Conc. & w/ 1/2" Premolded Filler Bet. Wall & Bridge Deck.

REVISION DATE	DESCRIPTION	MADE BY	APPROVED
COMMUNITY PLANNING INCORPORATED CIVIL ENGINEERS - SURVEYORS - CONSULTANT PLANNERS PETER HOI ASSOCIATES INC. STRUCTURAL ENGINEERS WAI'AU - WAIMALU ACCESS ROAD WAI'AU, OAHU, HAWAII OWNER : B.B. BISHOP ESTATE OCEANVIEW VENTURES DEVELOPERS : AMFAC-TROUSDALE OCEANVIEW VENTURES TAX MAP KEY: 3-8-02:263 WIDENING OF AUSTIN BISHOP GRADE SEPARATION PLAN & ELEV. OF ABUTMENT #2 APPROVED: _____ CHIEF, DIVISION OF ENGINEERING _____ REG. ENGR. CERT. NO. 470-E			


85-S	AS BUILT
------	----------

SHEET 10 OF 14 SHEETS


DATE: 9-18-70

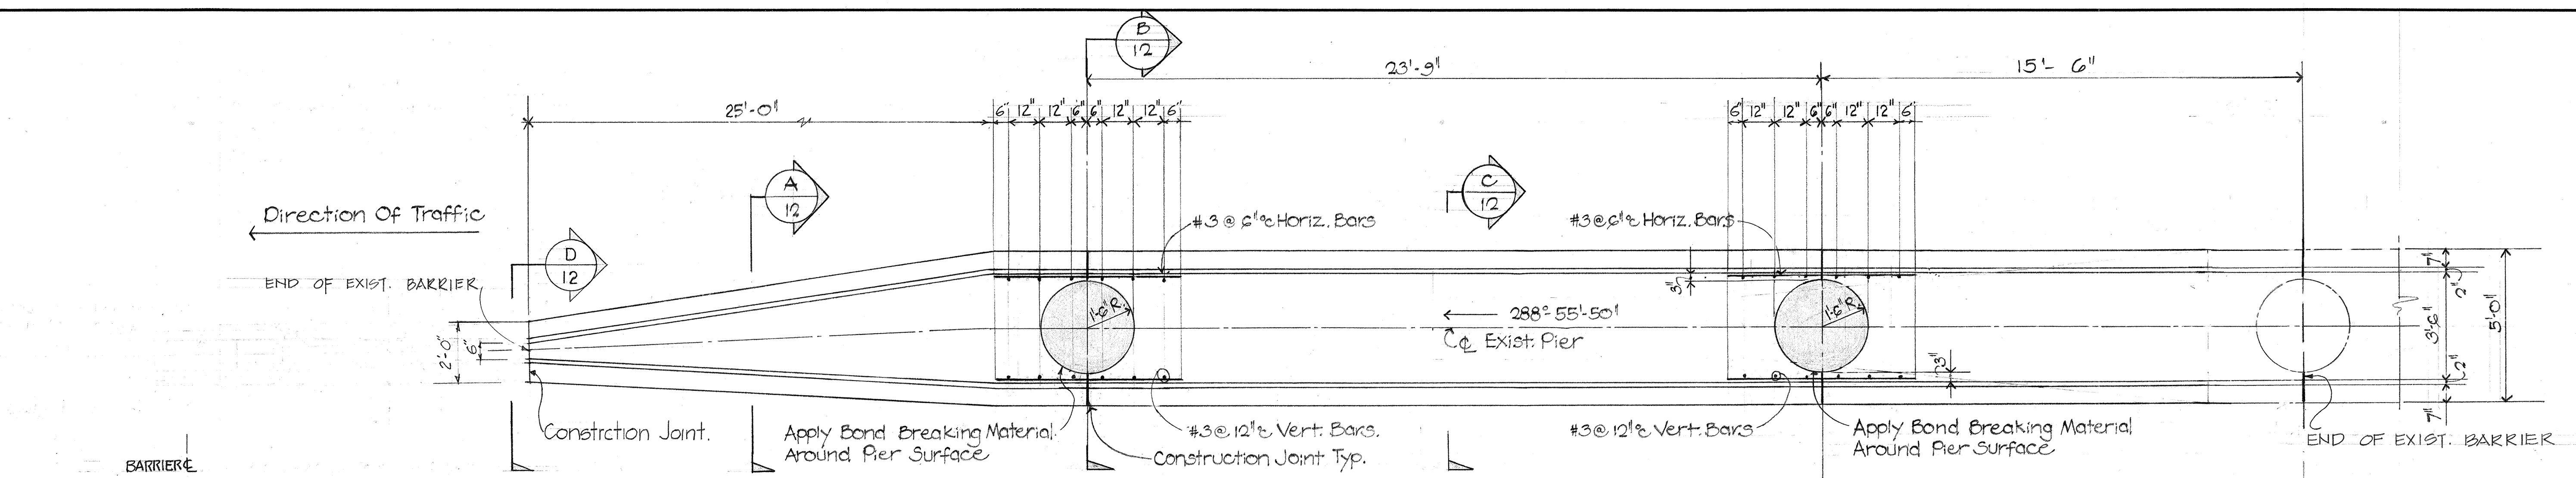


PLAN
Scale: 3/8" = 1'-0"

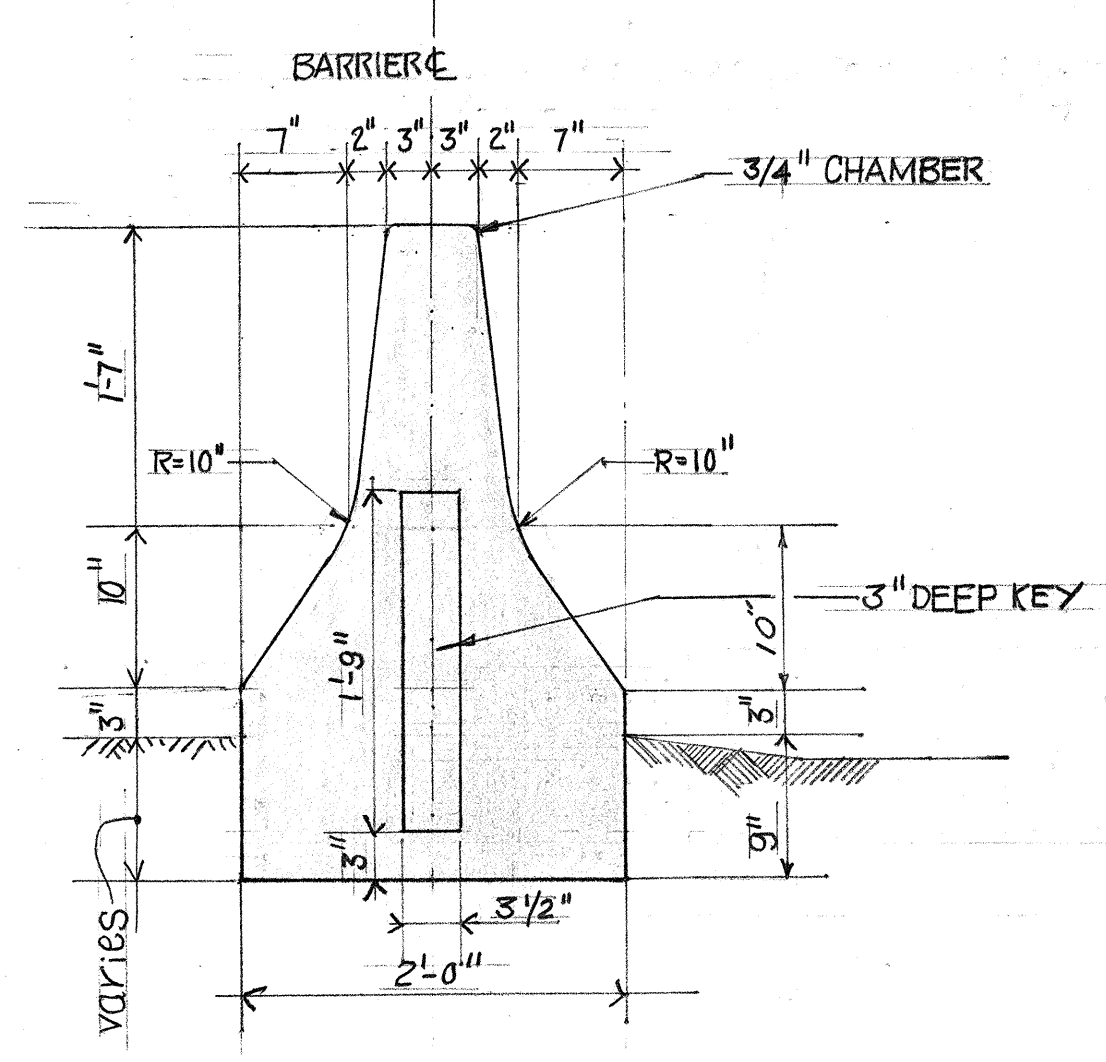


SECTION D
Scale: 1" = 1'-0"

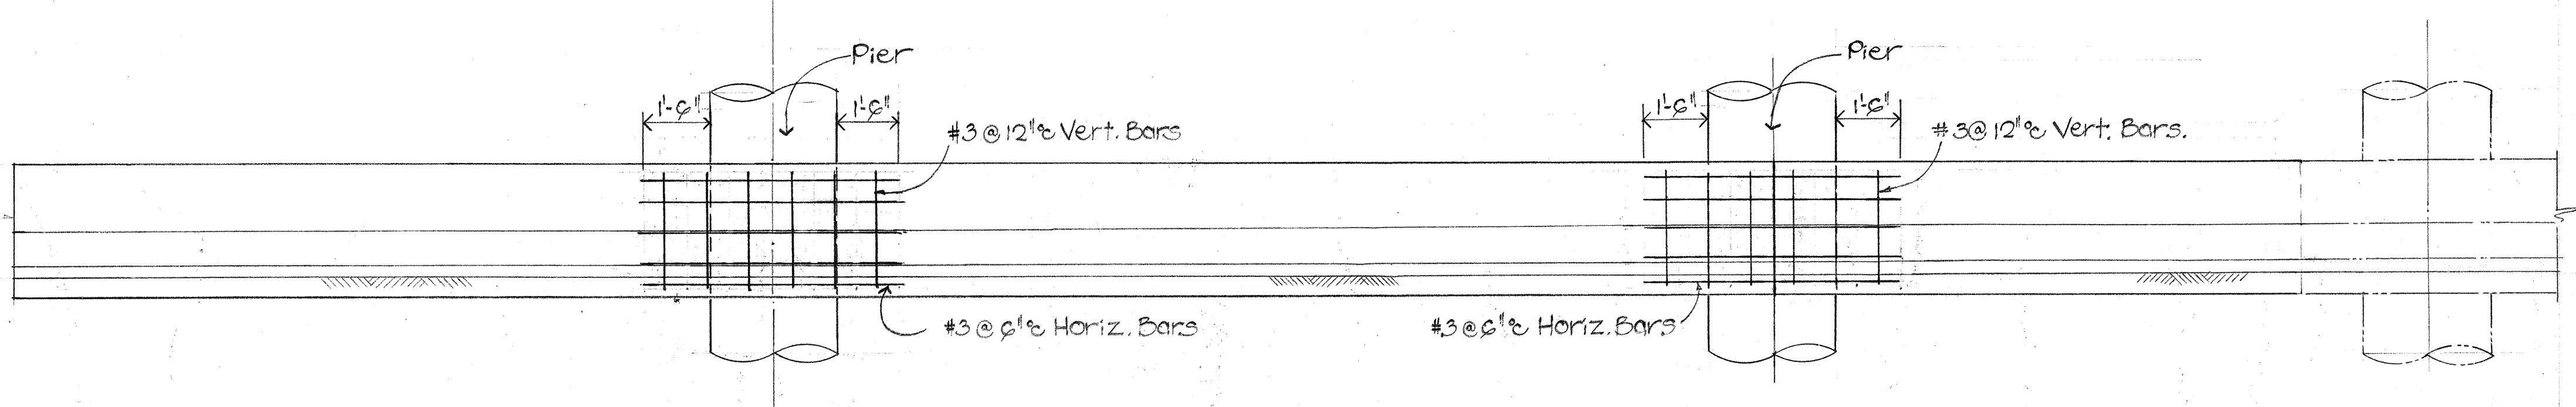


ELEVATION
Scale: 3/8" = 1'-0"

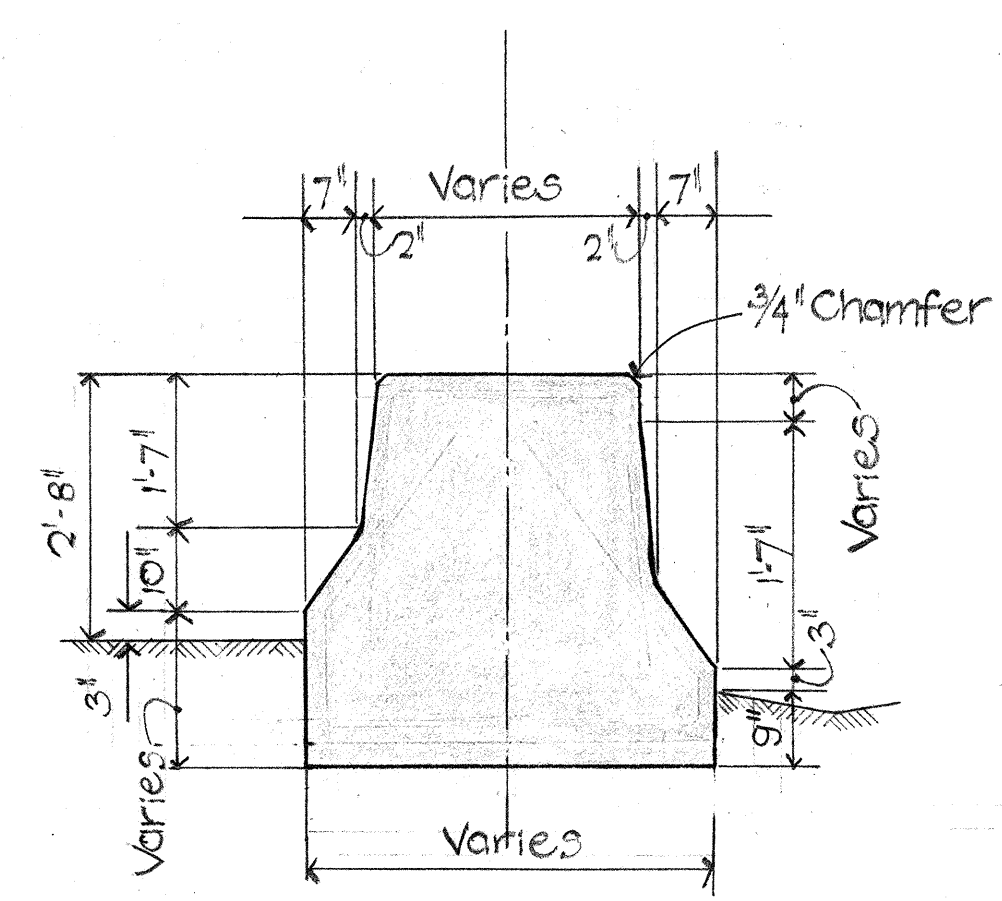


SECTION A
Scale: N.T.S.

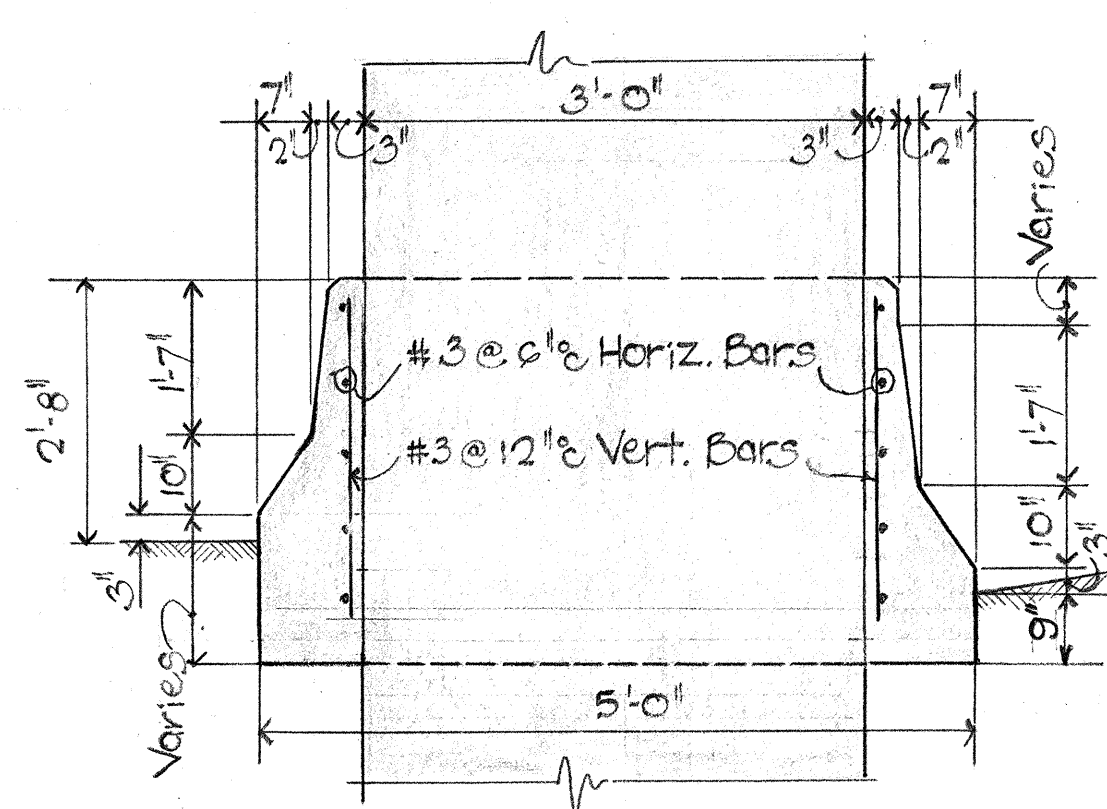

SECTION B
Scale: N.T.S.

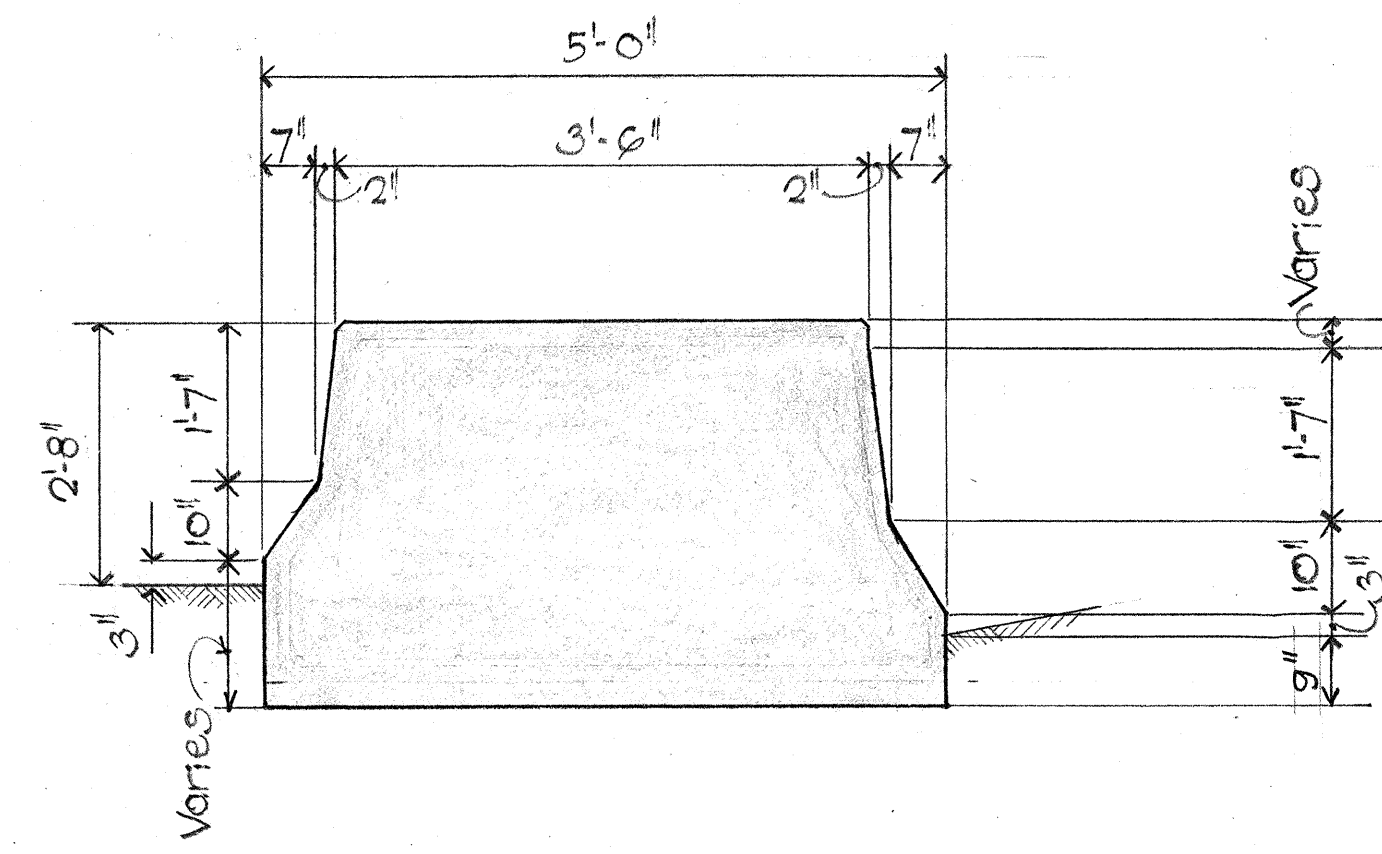

SECTION C
Scale: N.T.S.

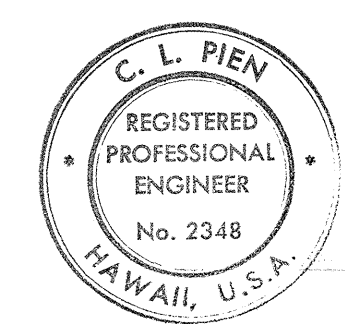


THIS WORK WAS PREPARED BY ME
OR UNDER MY SUPERVISION


REVISION DATE	DESCRIPTION	MADE BY	APPROVED
COMMUNITY PLANNING INCORPORATED			
CIVIL ENGINEERS - SURVEYORS - CONSULTANT PLANNERS			
PETER HSI ASSOCIATES INC.			
STRUCTURAL ENGINEERS			
WAI'AU-WAIMALU ACCESS ROAD			
WAI'AU, OAHU, HAWAII			
OWNER: B. P. BISHOP ESTATE			
OCEANVIEW VENTURES			
DEVELOPERS: AMFAC-TROUSDALE			
OCEANVIEW VENTURES			
TAX MAP KEY: 9-8-02: 2&3			
WIDENING OF AUSTIN BISHOP			
GRADE SEPARATION			
CONC. MEDIAN BARRIER DETAILS			
APPROVED:			
CHIEF, DIVISION OF ENGINEERING			
REG. ENGR. CERT. NO. 470-E			

DATE: 9-18-70


S-1
STA. 94+93
118' OFFSET LEFT
EL. = 118.52

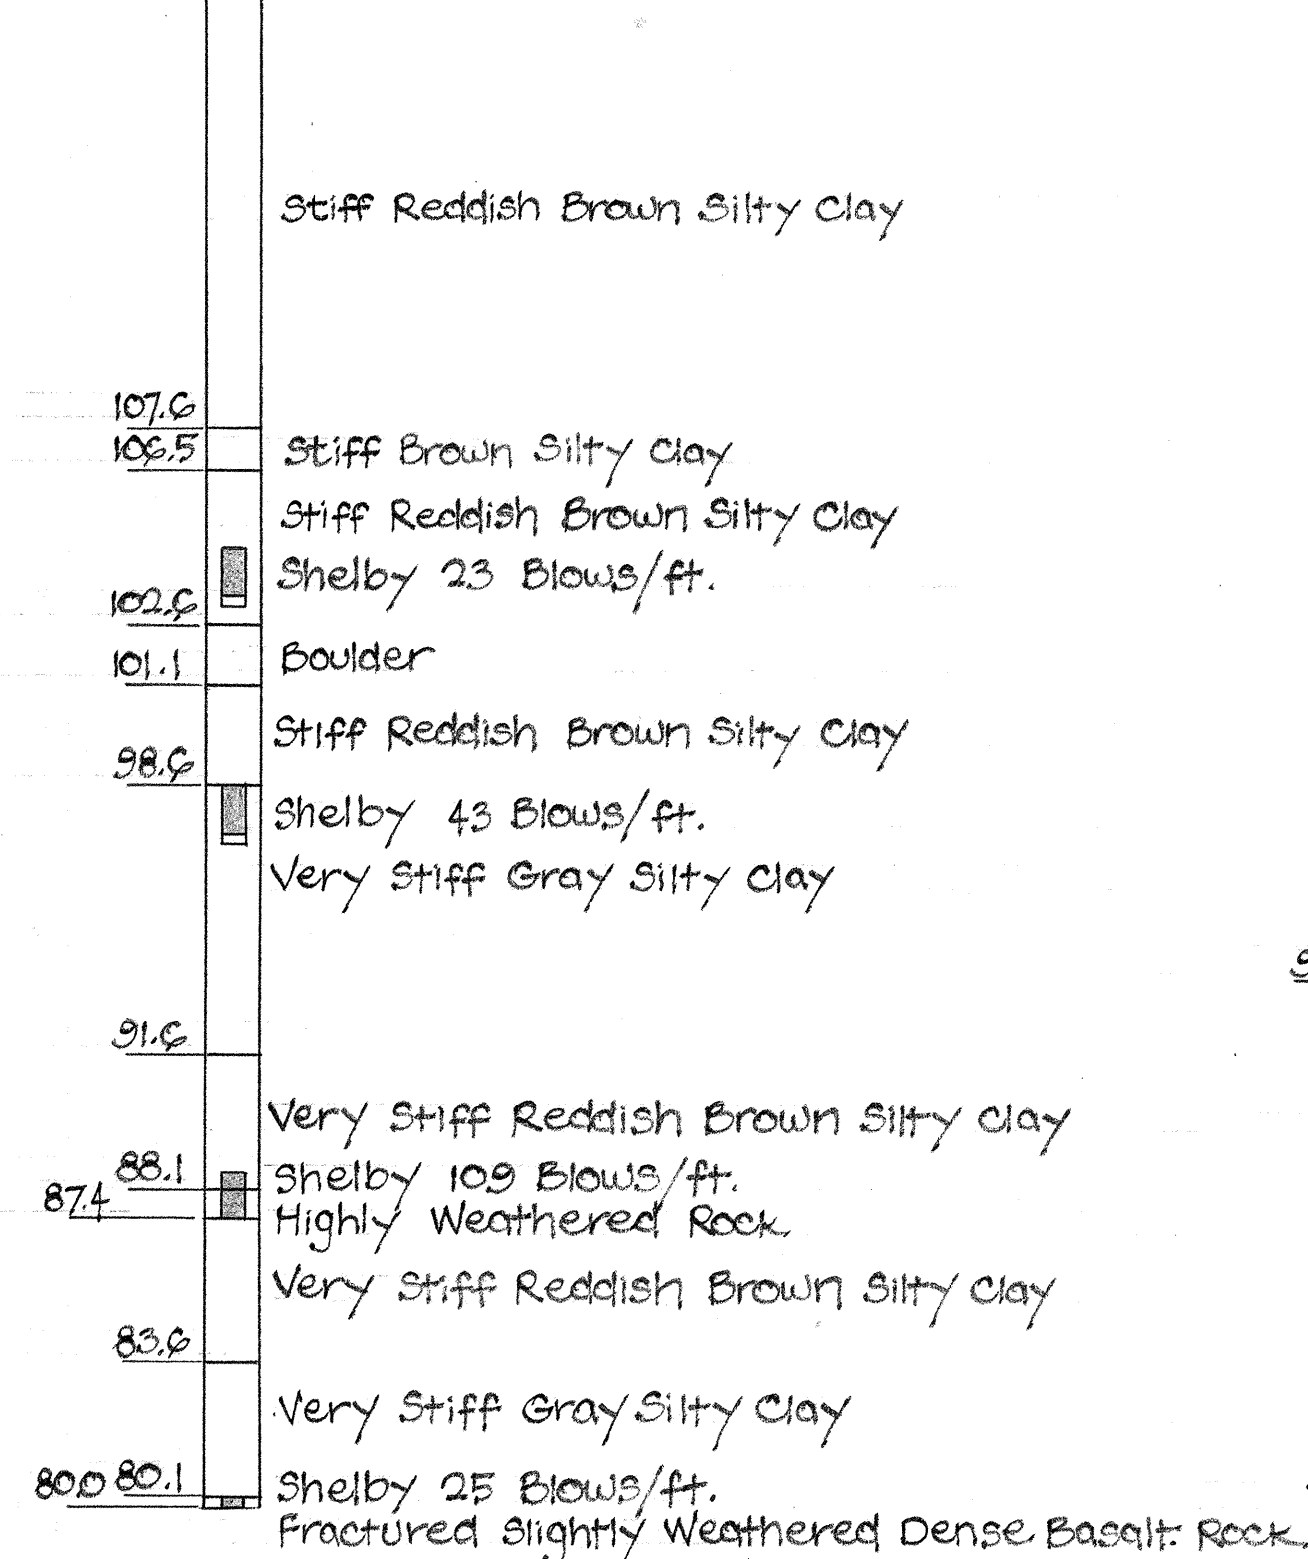


S-2
STA. 95+25
118' OFFSET LEFT
EL. = 115.76

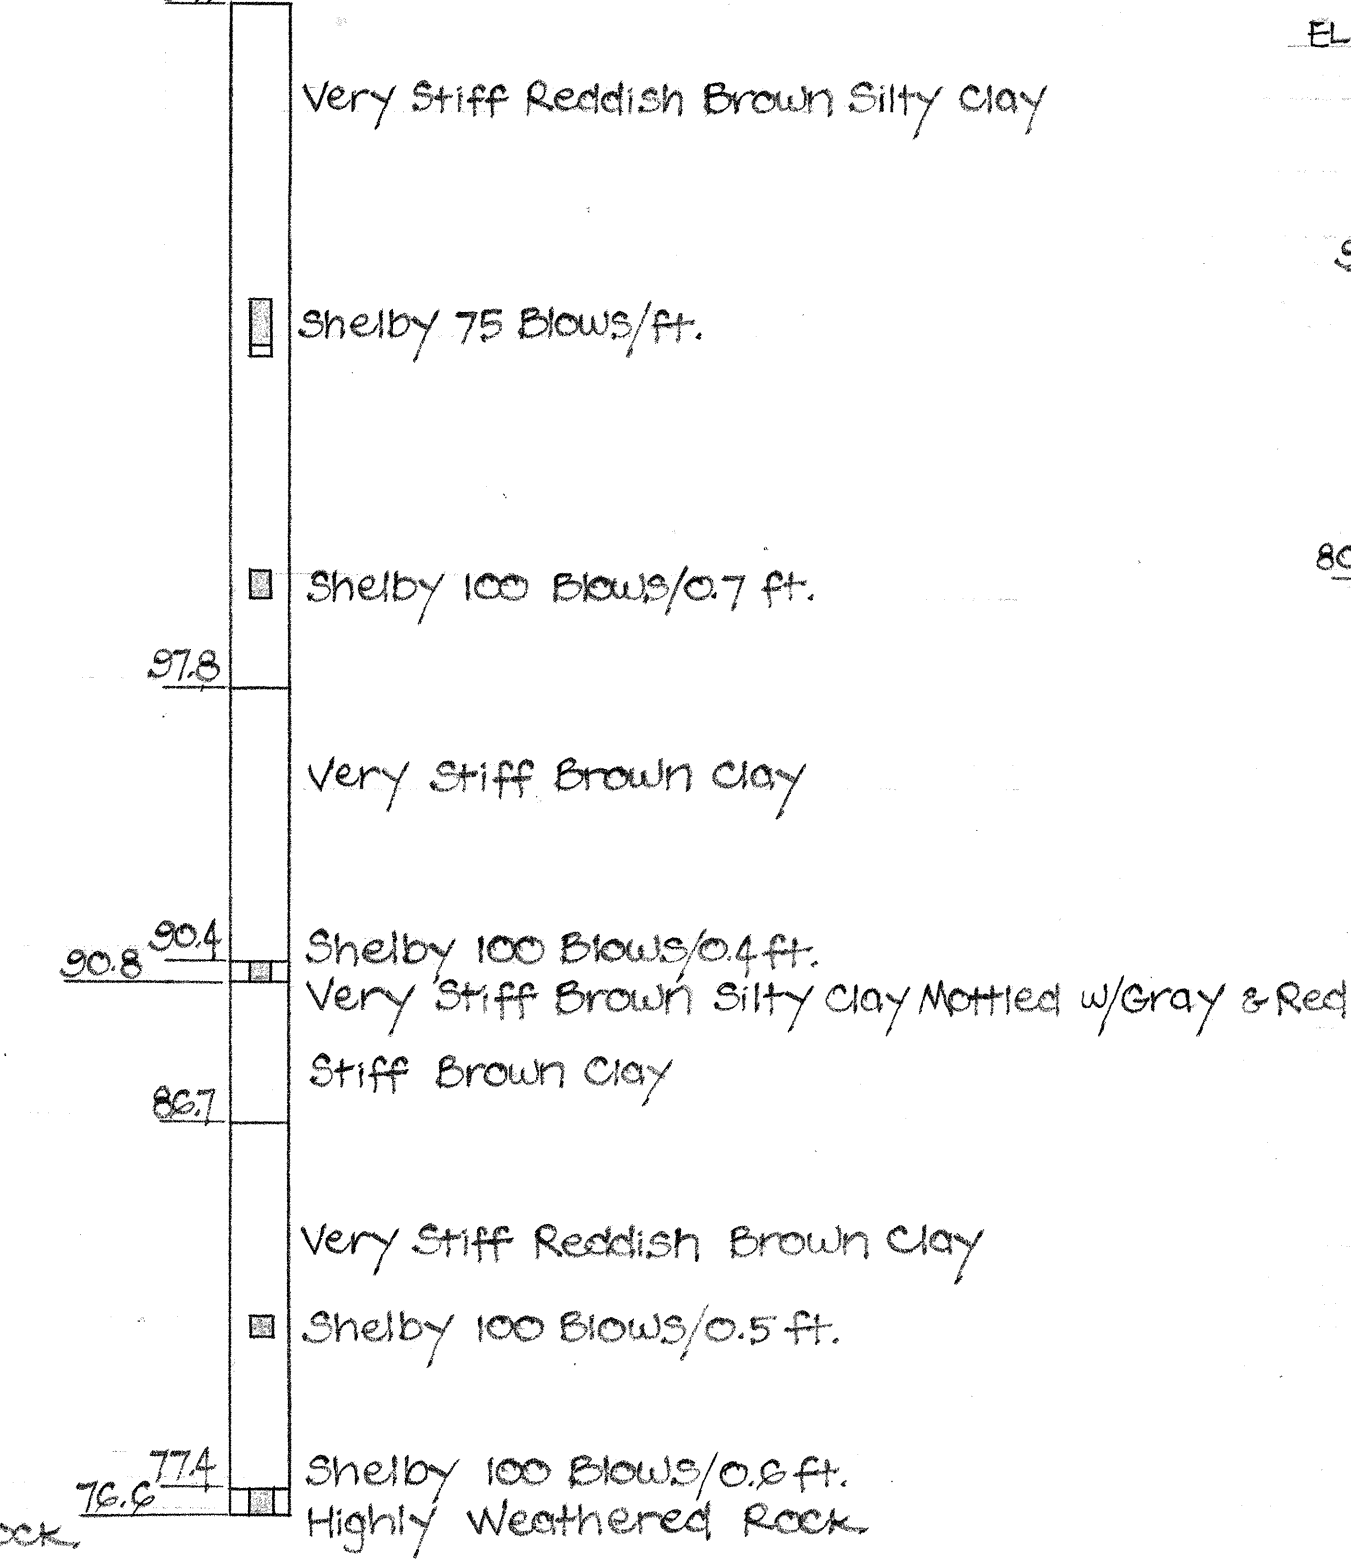


S-3
STA. 94+93
72' OFFSET LEFT
EL. = 112.54

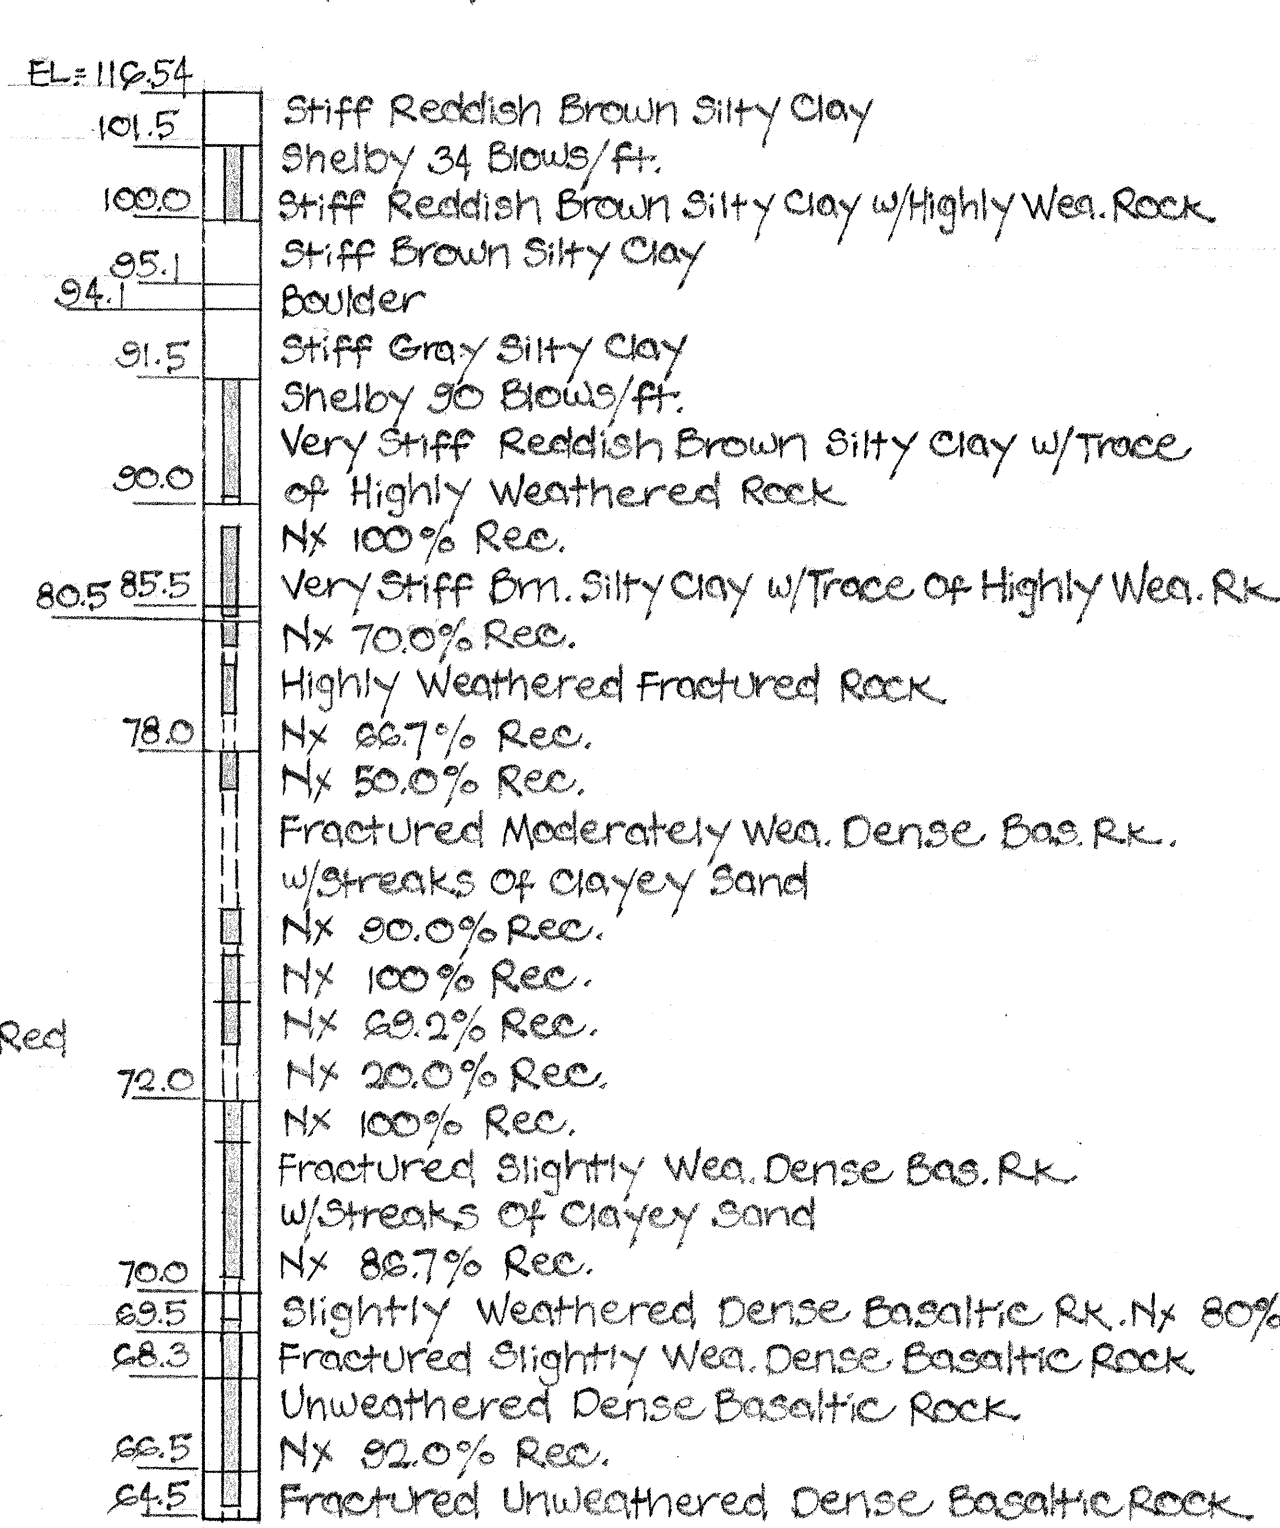


S-4
STA. 95+25
72' OFFSET LEFT
EL. = 113.21

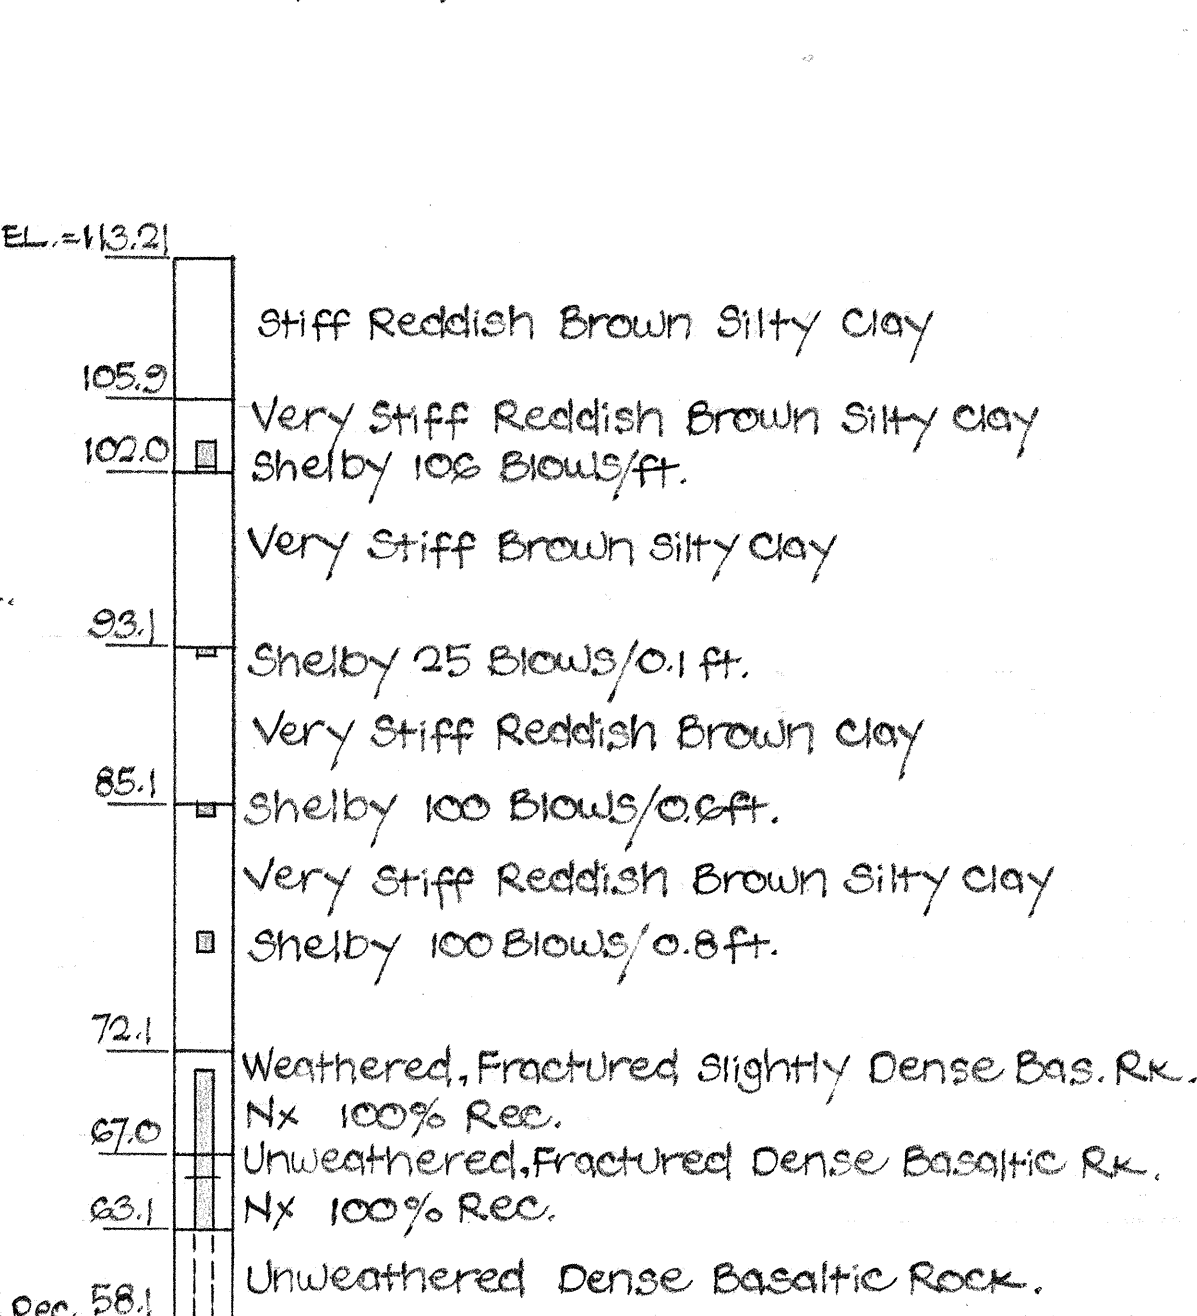


S-5
STA. 94+93
EL. = 112.65

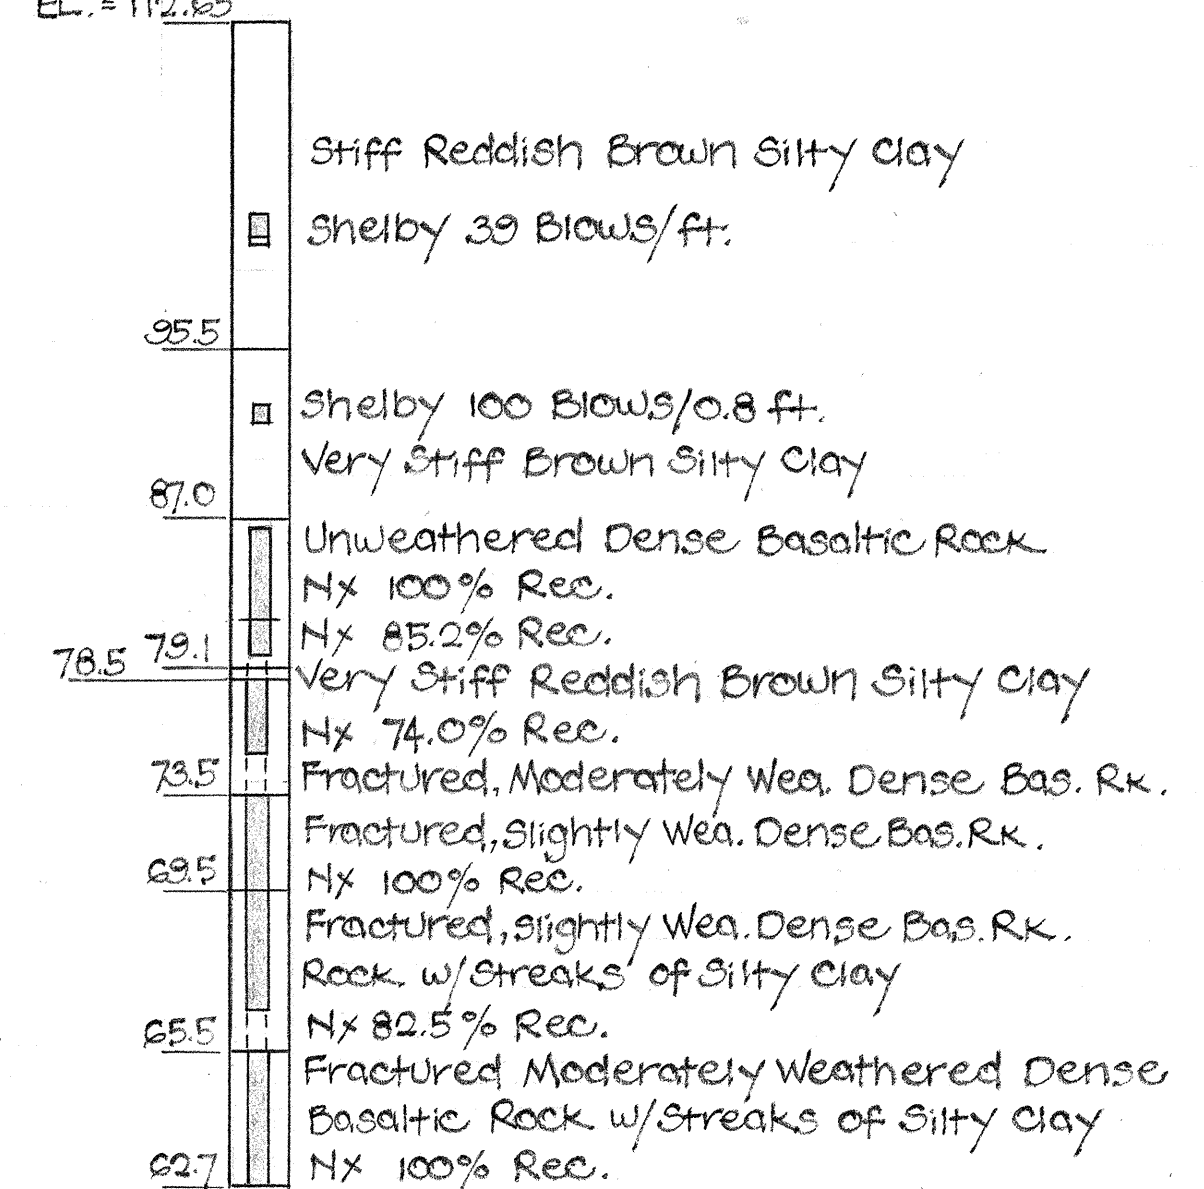


B-9
STA. 95+25

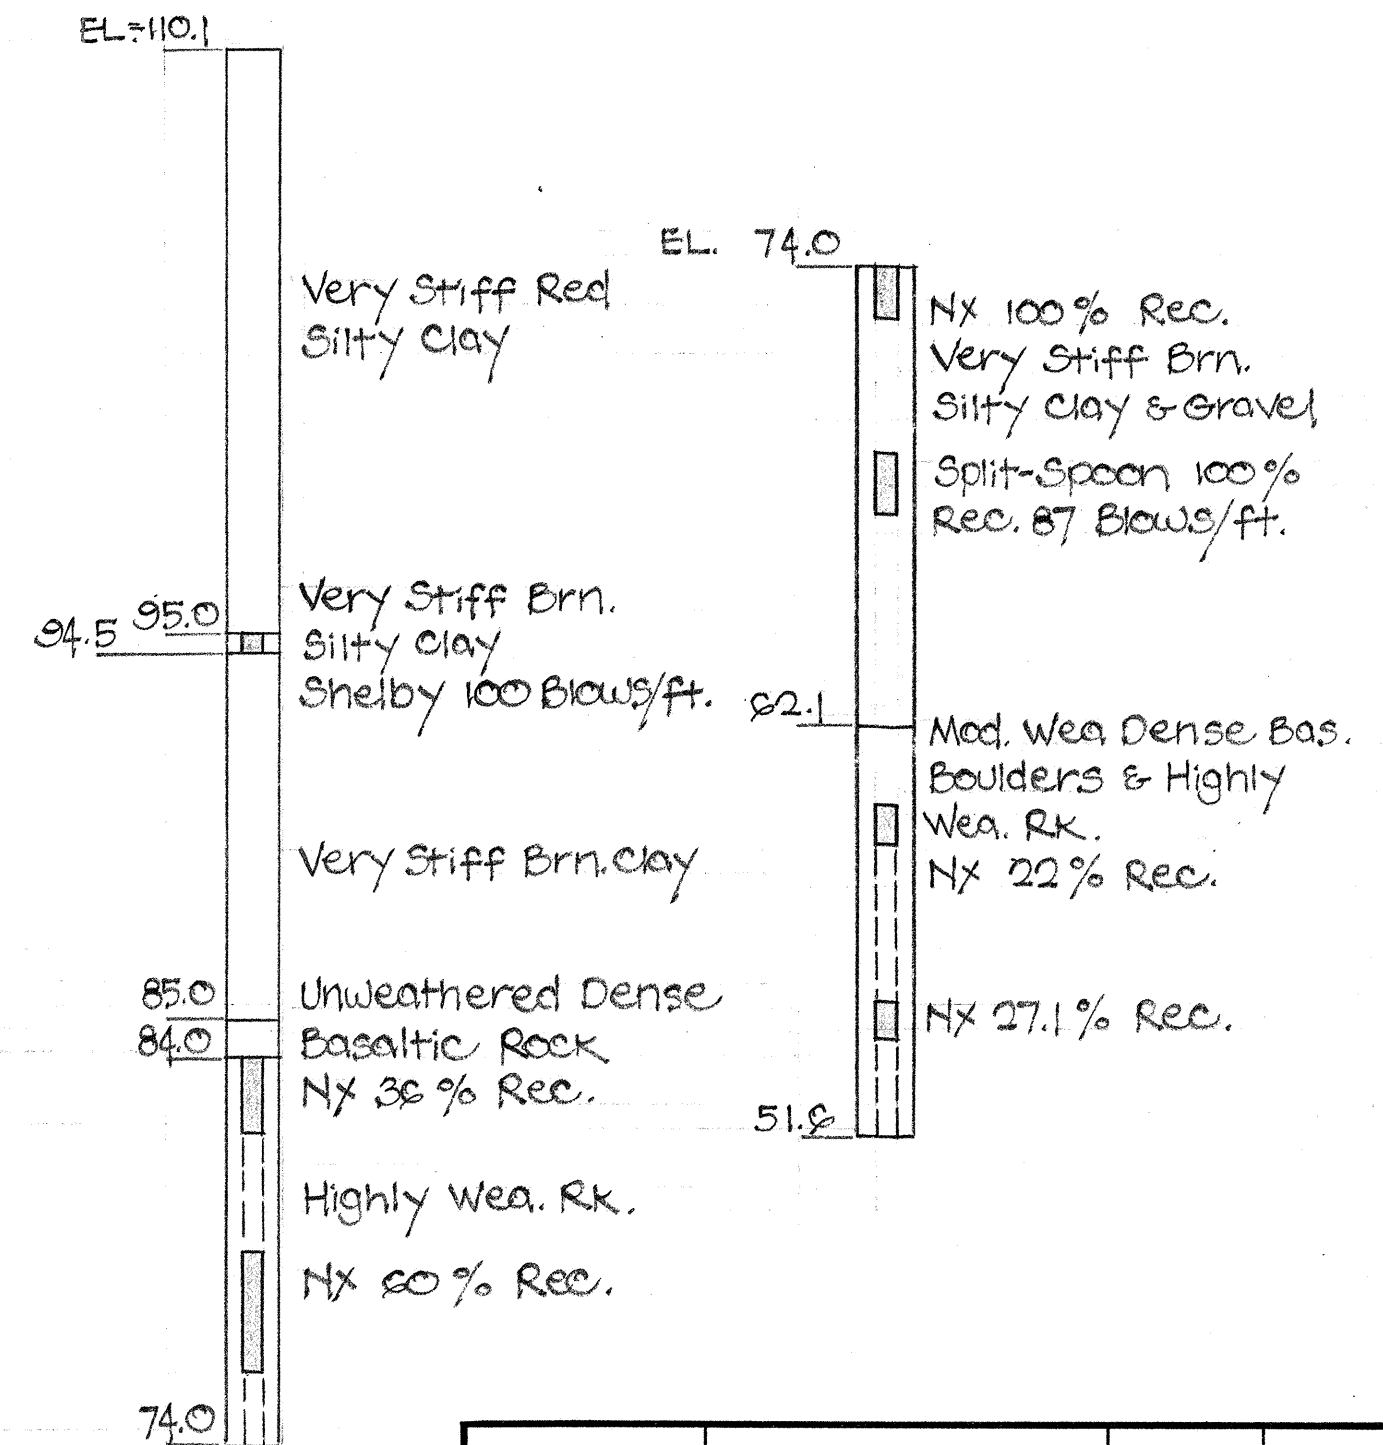


S-6
STA. 94+93
66' OFFSET RIGHT
EL. = 107.45

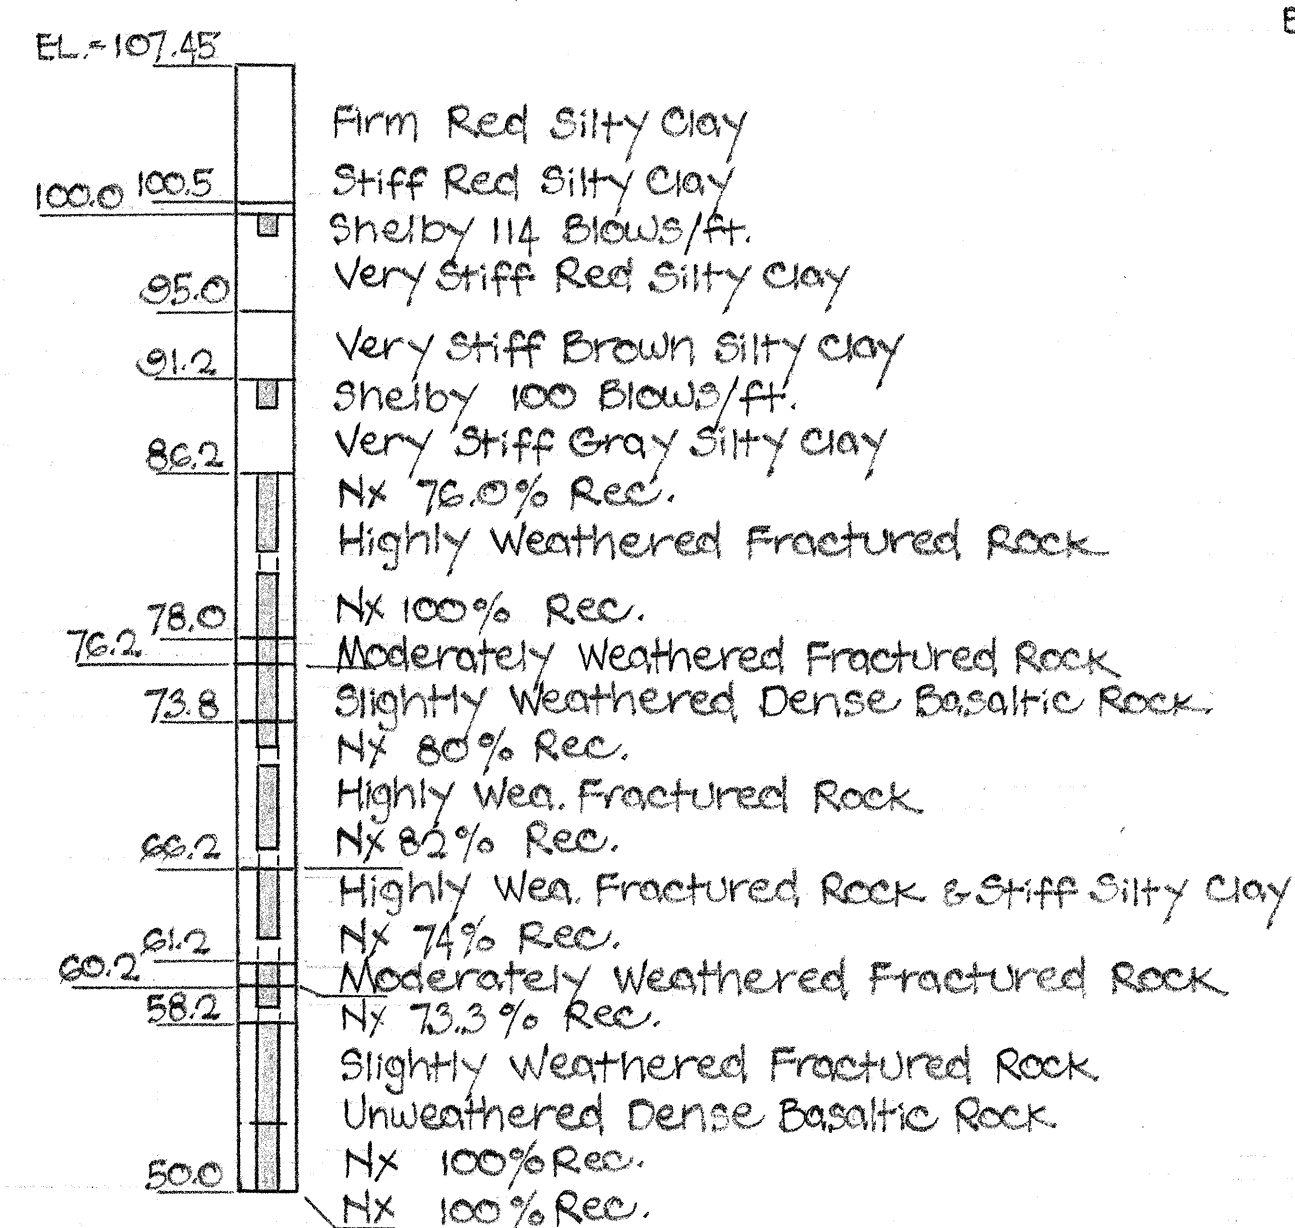



S-7
STA. 95+25
72' OFFSET RIGHT
EL. = 105.9

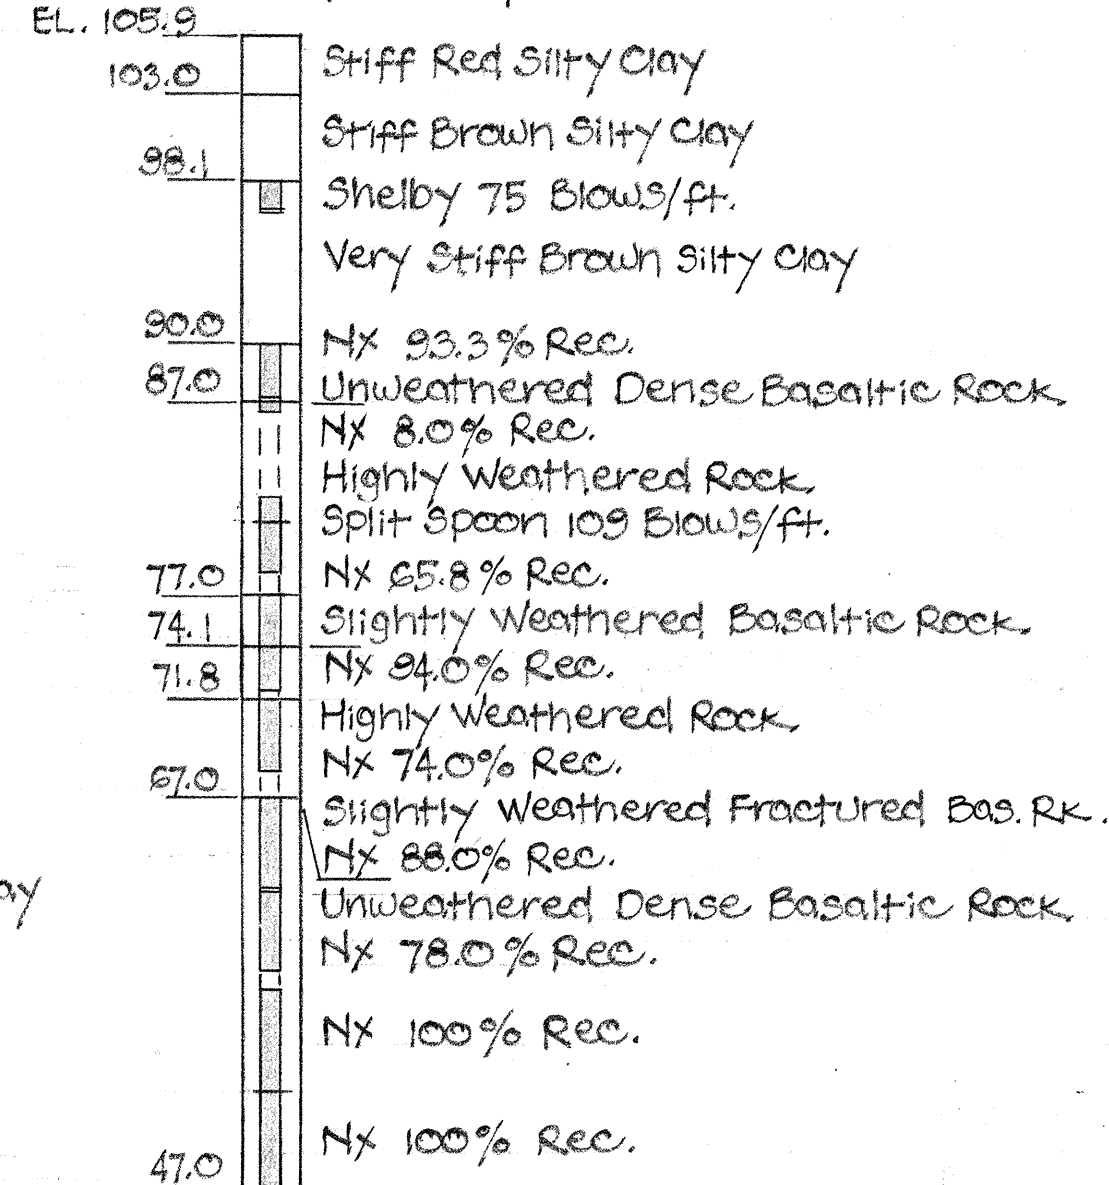

S-8
STA. 94+93
111' OFFSET RIGHT
EL. = 105.06

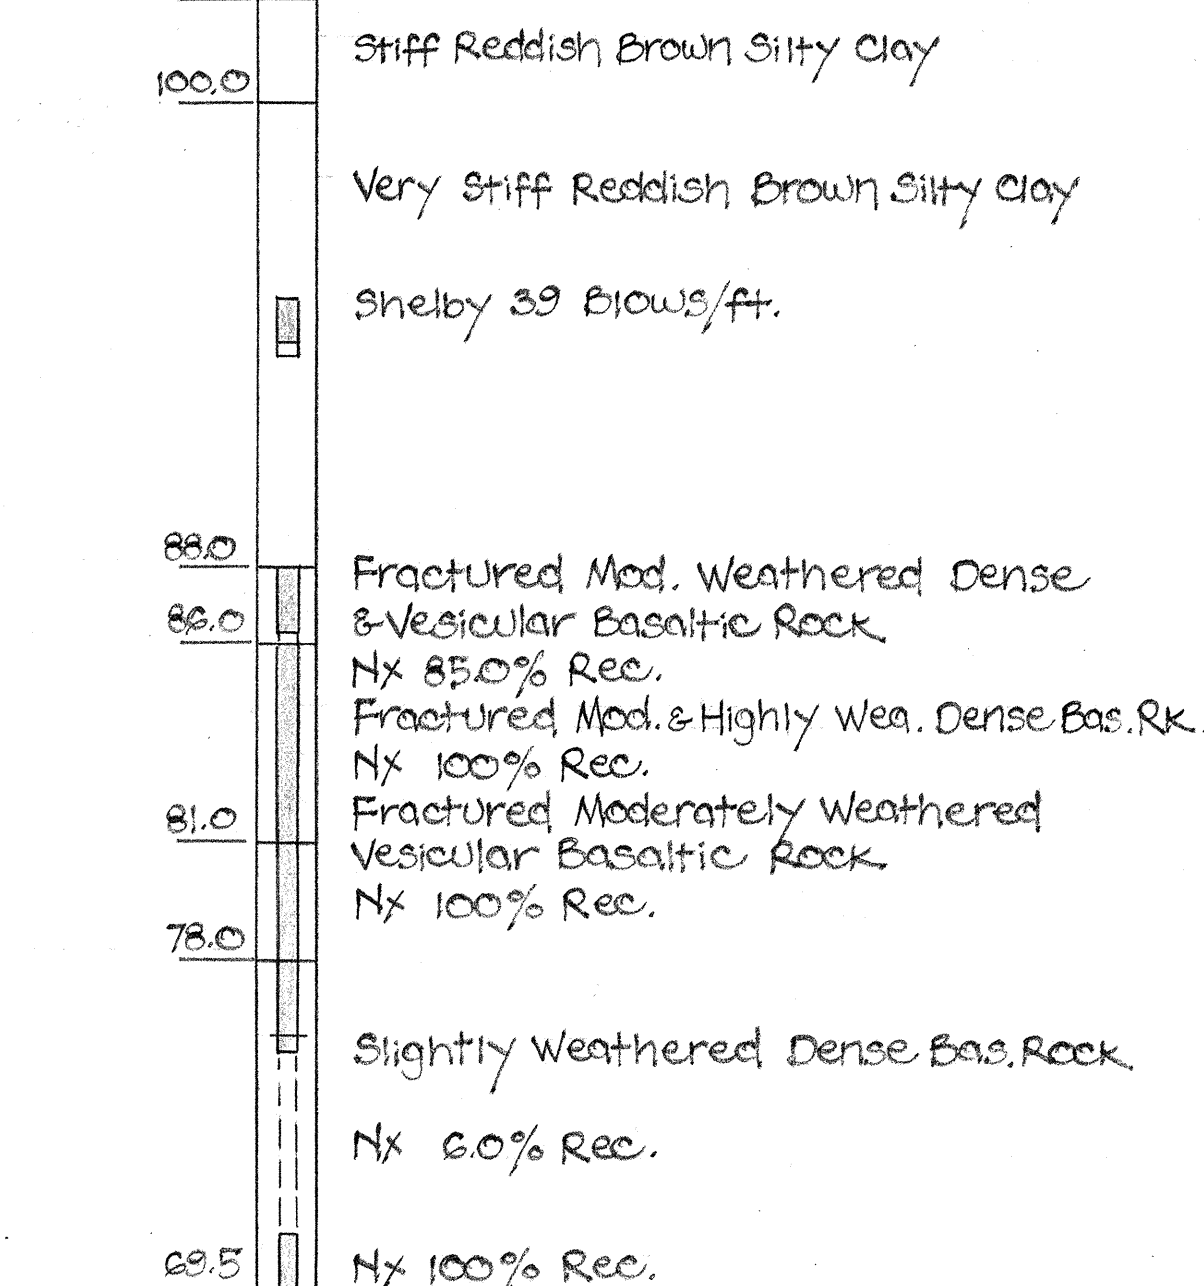

S-9
STA. 95+25
111' OFFSET RIGHT
EL. = 104.88

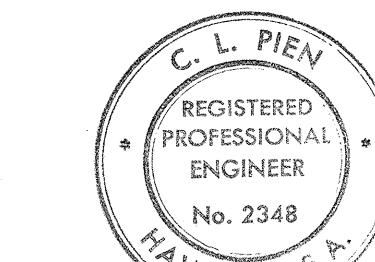
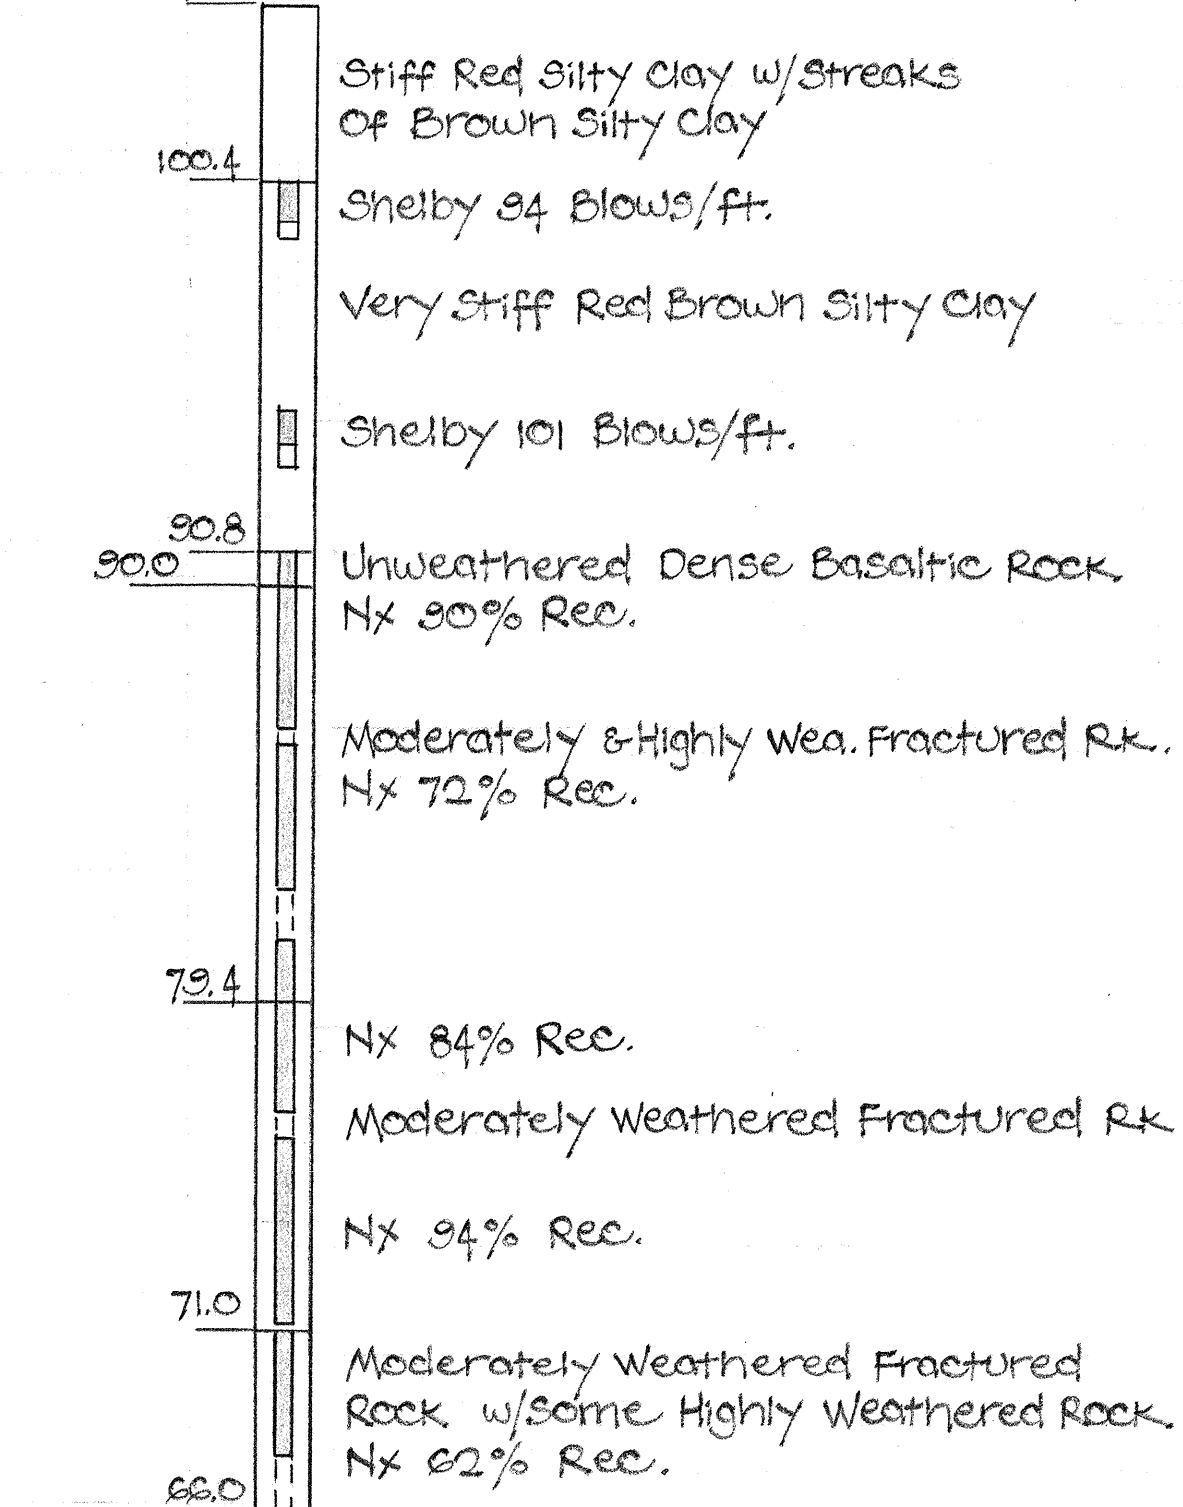


THIS WORK WAS PREPARED BY ME
OR UNDER MY SUPERVISION


REVISION	DATE	DESCRIPTION	MADE BY	APPROVED
COMMUNITY PLANNING INCORPORATED CIVIL ENGINEERS - SURVEYORS - CONSULTANT PLANNERS				
PETER HSI ASSOCIATES INC. STRUCTURAL ENGINEERS				
WAI'AU-WAIMALU ACCESS ROAD WAI'AU, OAHU, HAWAII				
OWNER: B. P. BISHOP ESTATE				
DEVELOPERS: AMFAC - TROUSDALE				
OCEANVIEW VENTURES				
TAX MAP KEY: 9-8-02: 2 & 3				
WIDENING OF AUSTIN BISHOP GRADE SEPARATION BORING LOGS				
APPROVED:				
CHIEF, DIVISION OF ENGINEERING				
REG. ENGR. CERT. NO. 470-E				

SHEET 13 OF 14 SHEETS



185-S14 AS BUILT

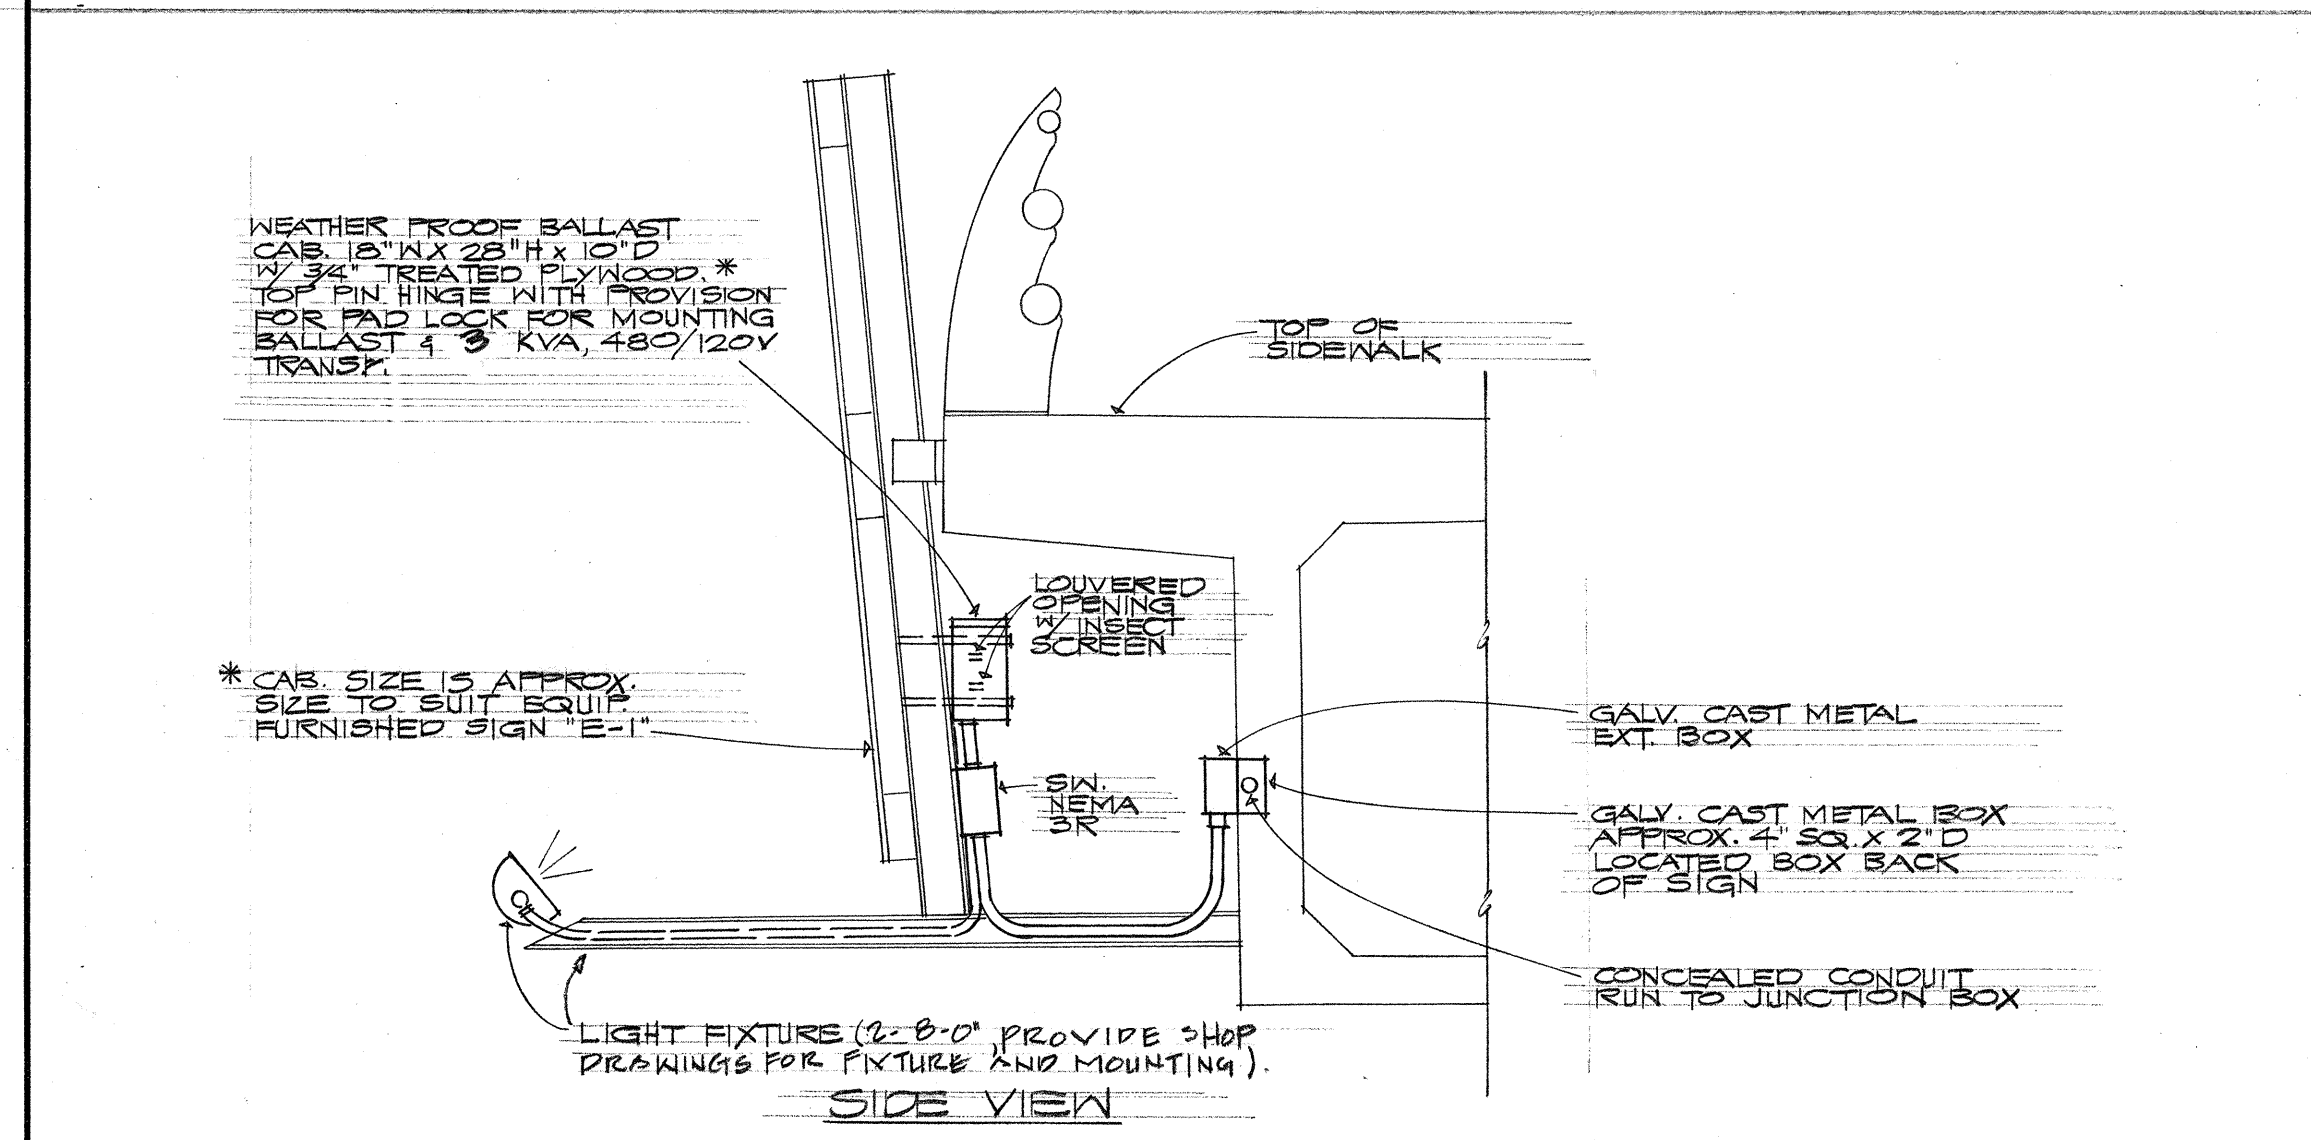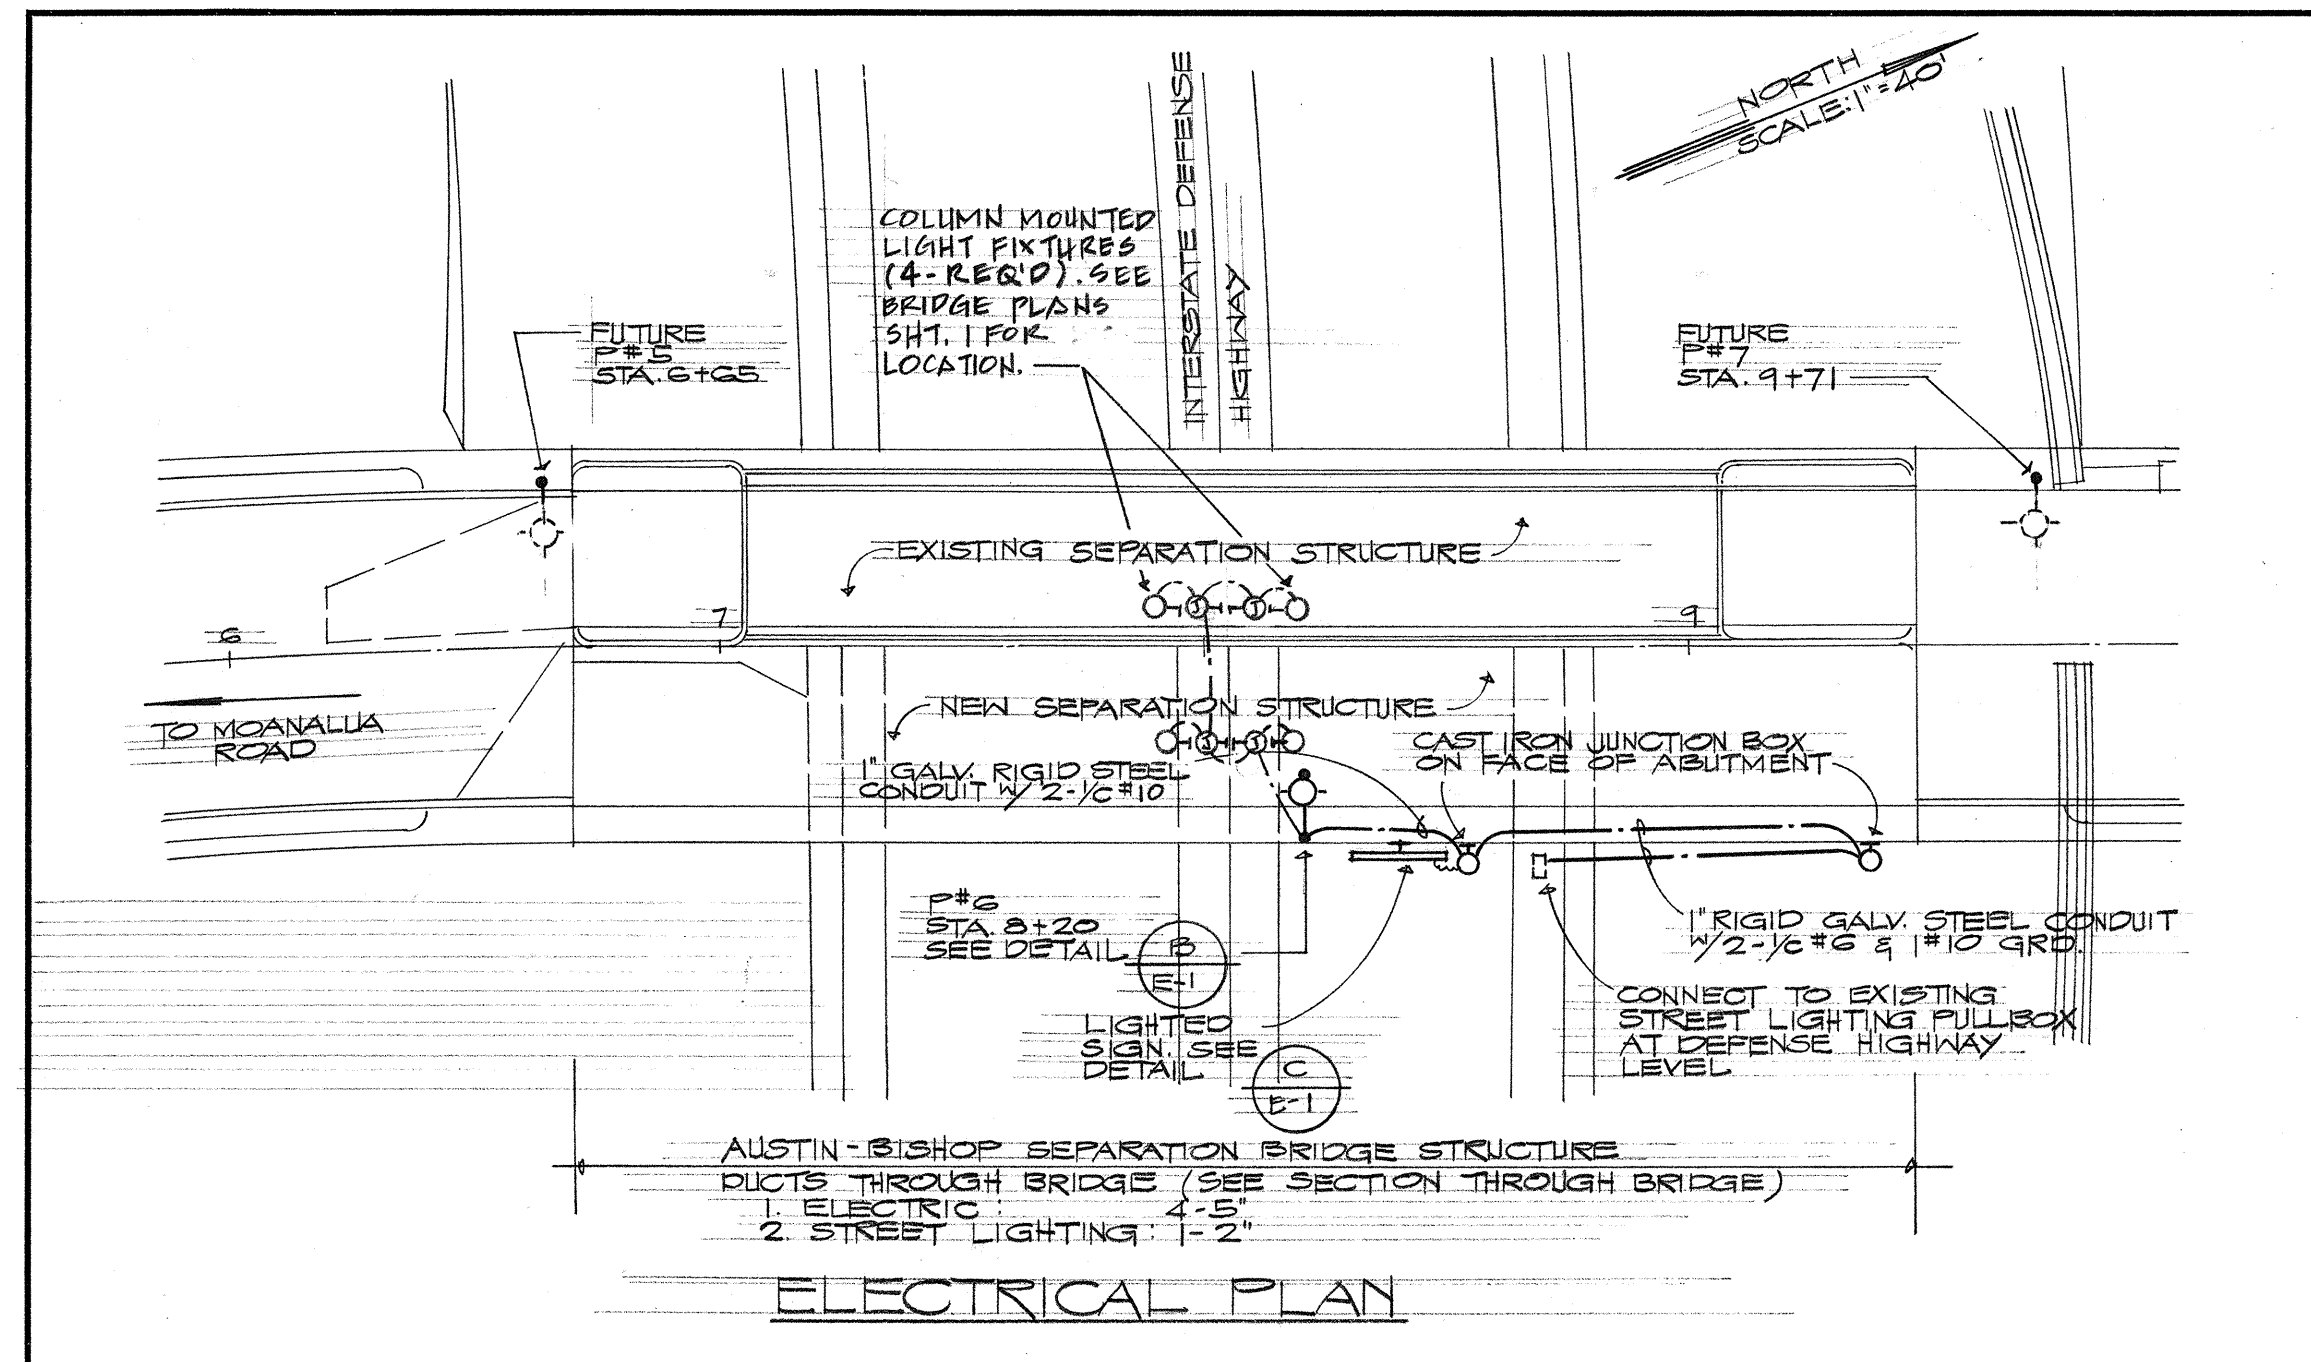


A SIGN "E-1" BISHOP-AUSTIN SEPARATION
E-1 NOT TO SCALE

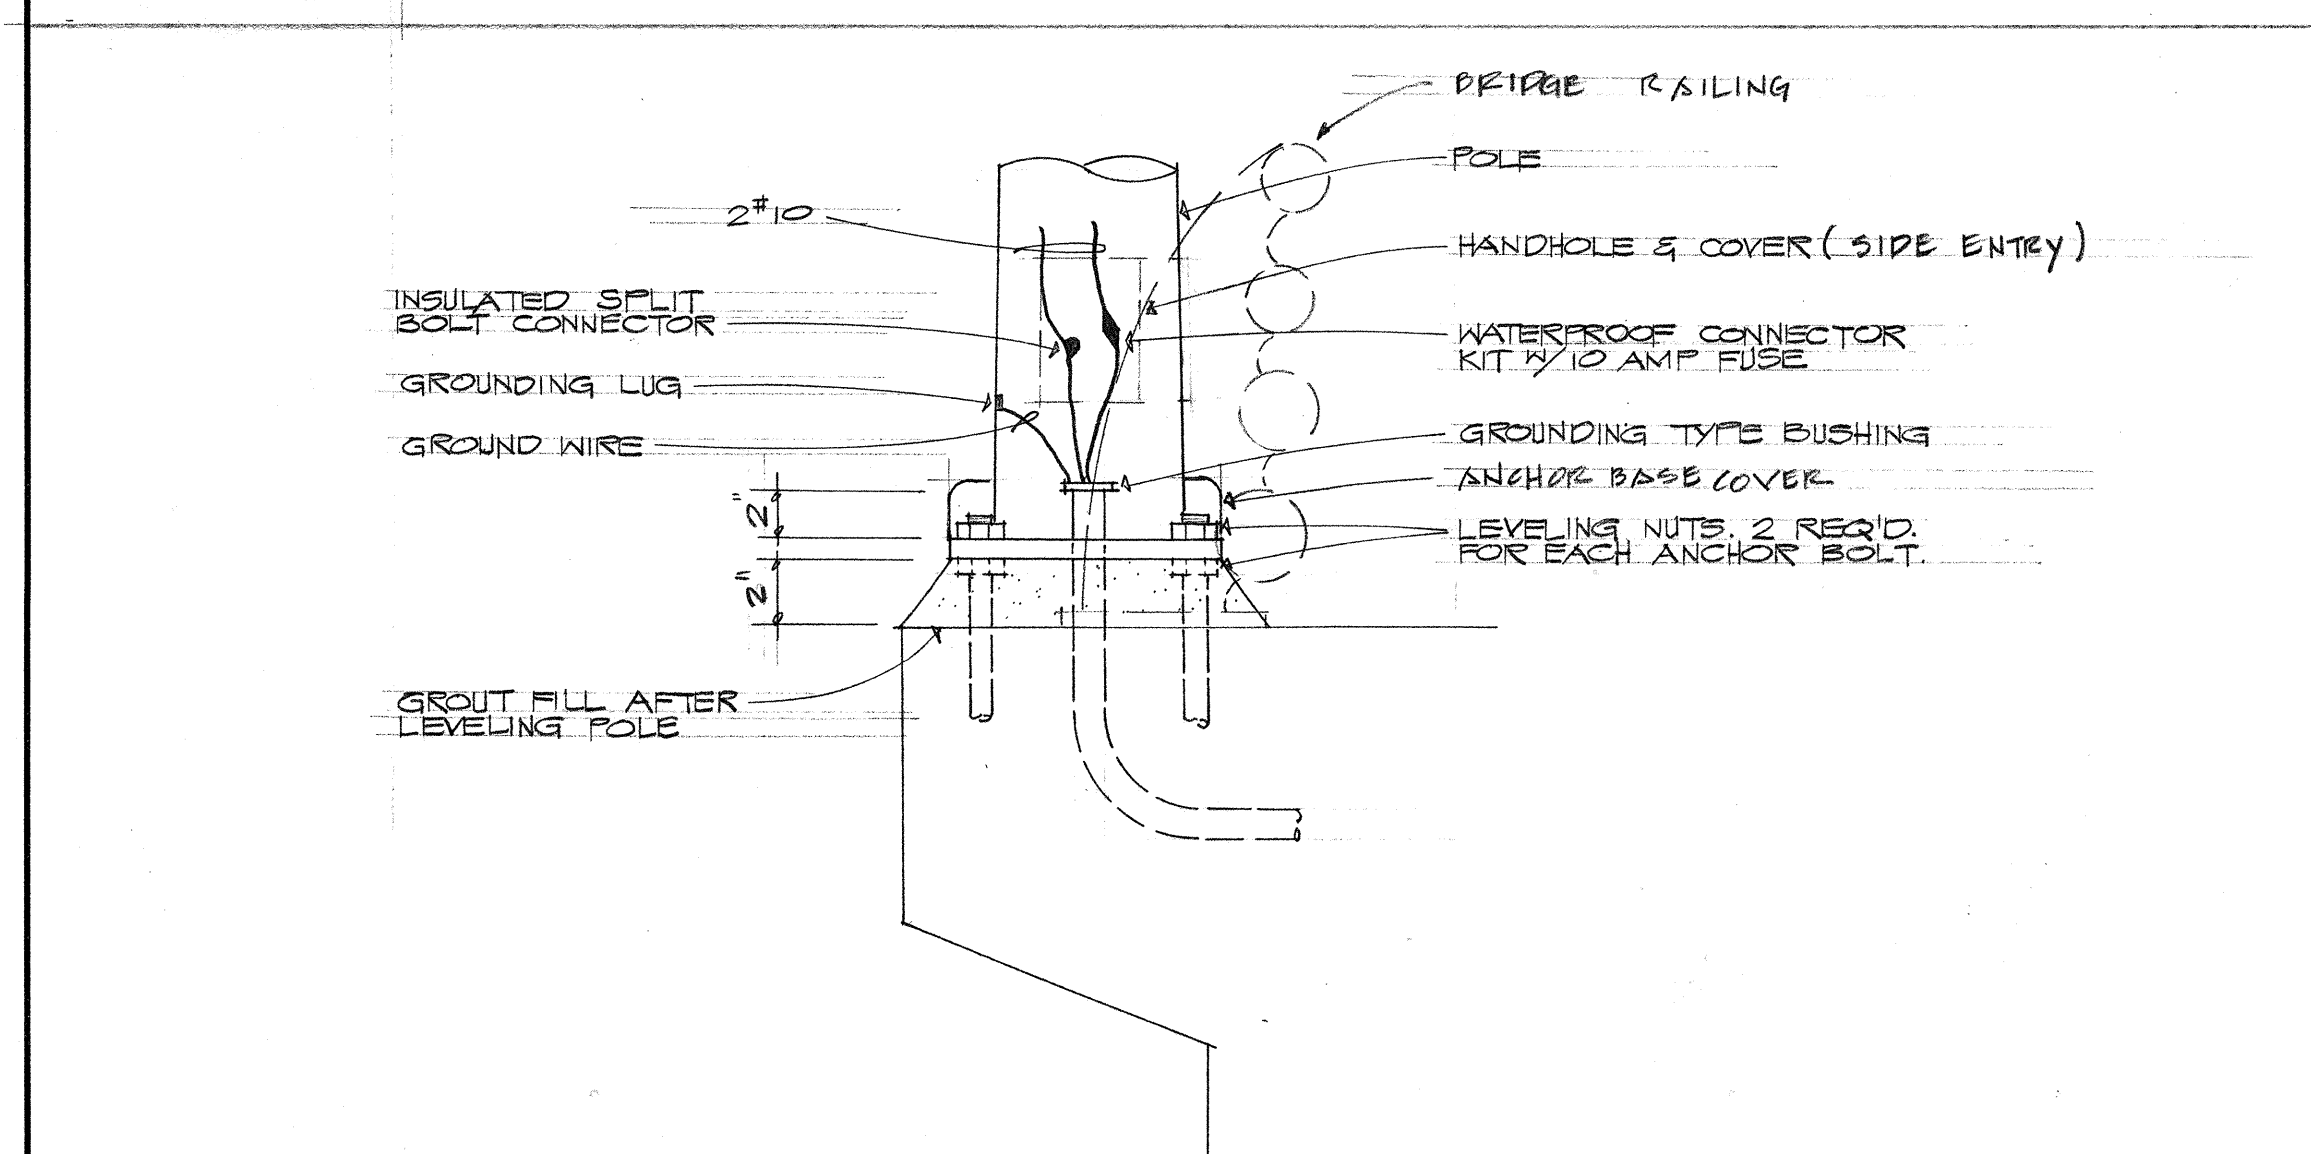


B ANCHOR BASE DETAIL
E-1 NOT TO SCALE

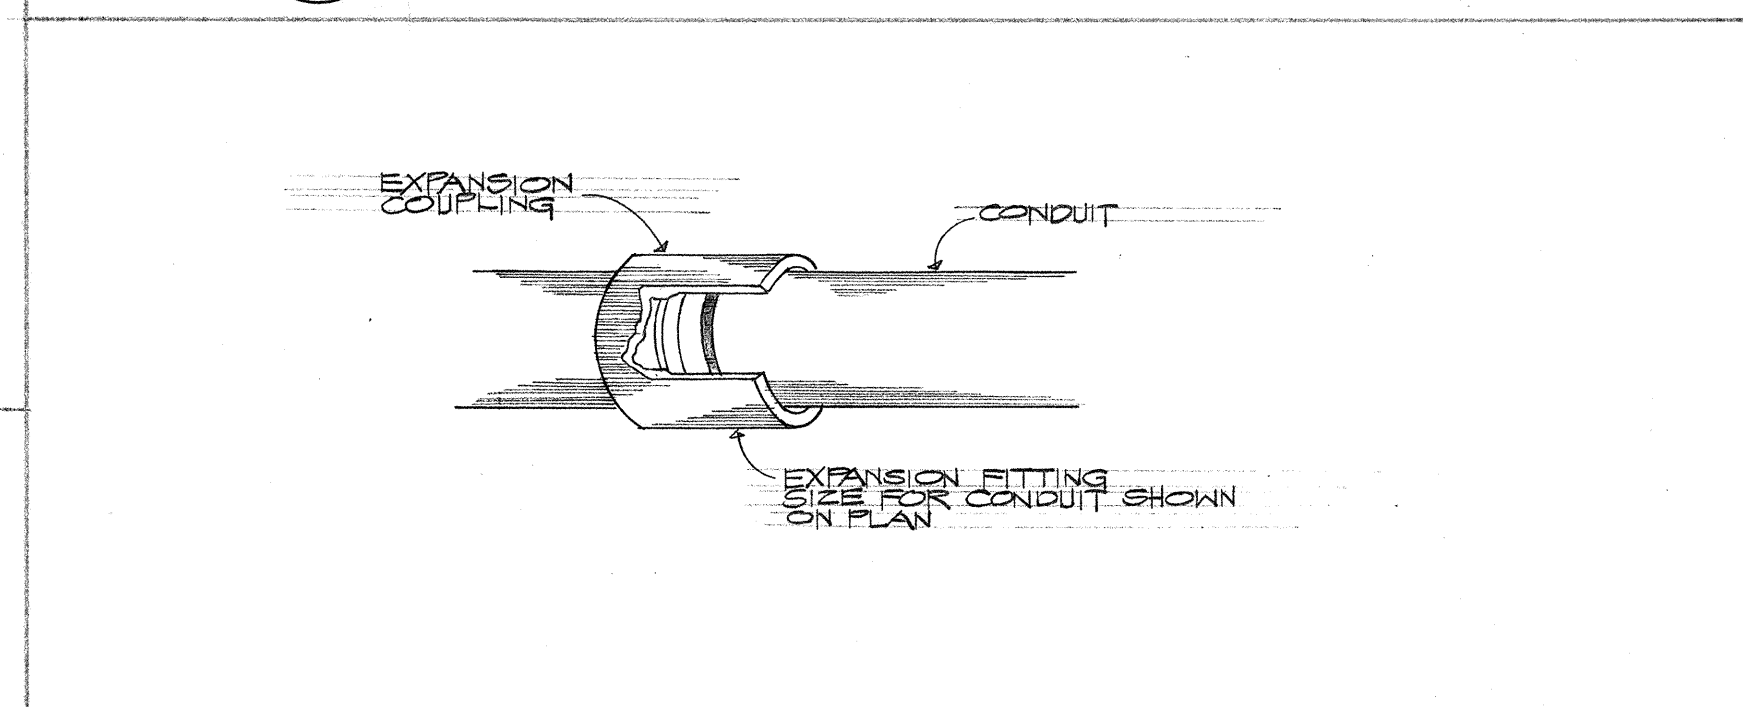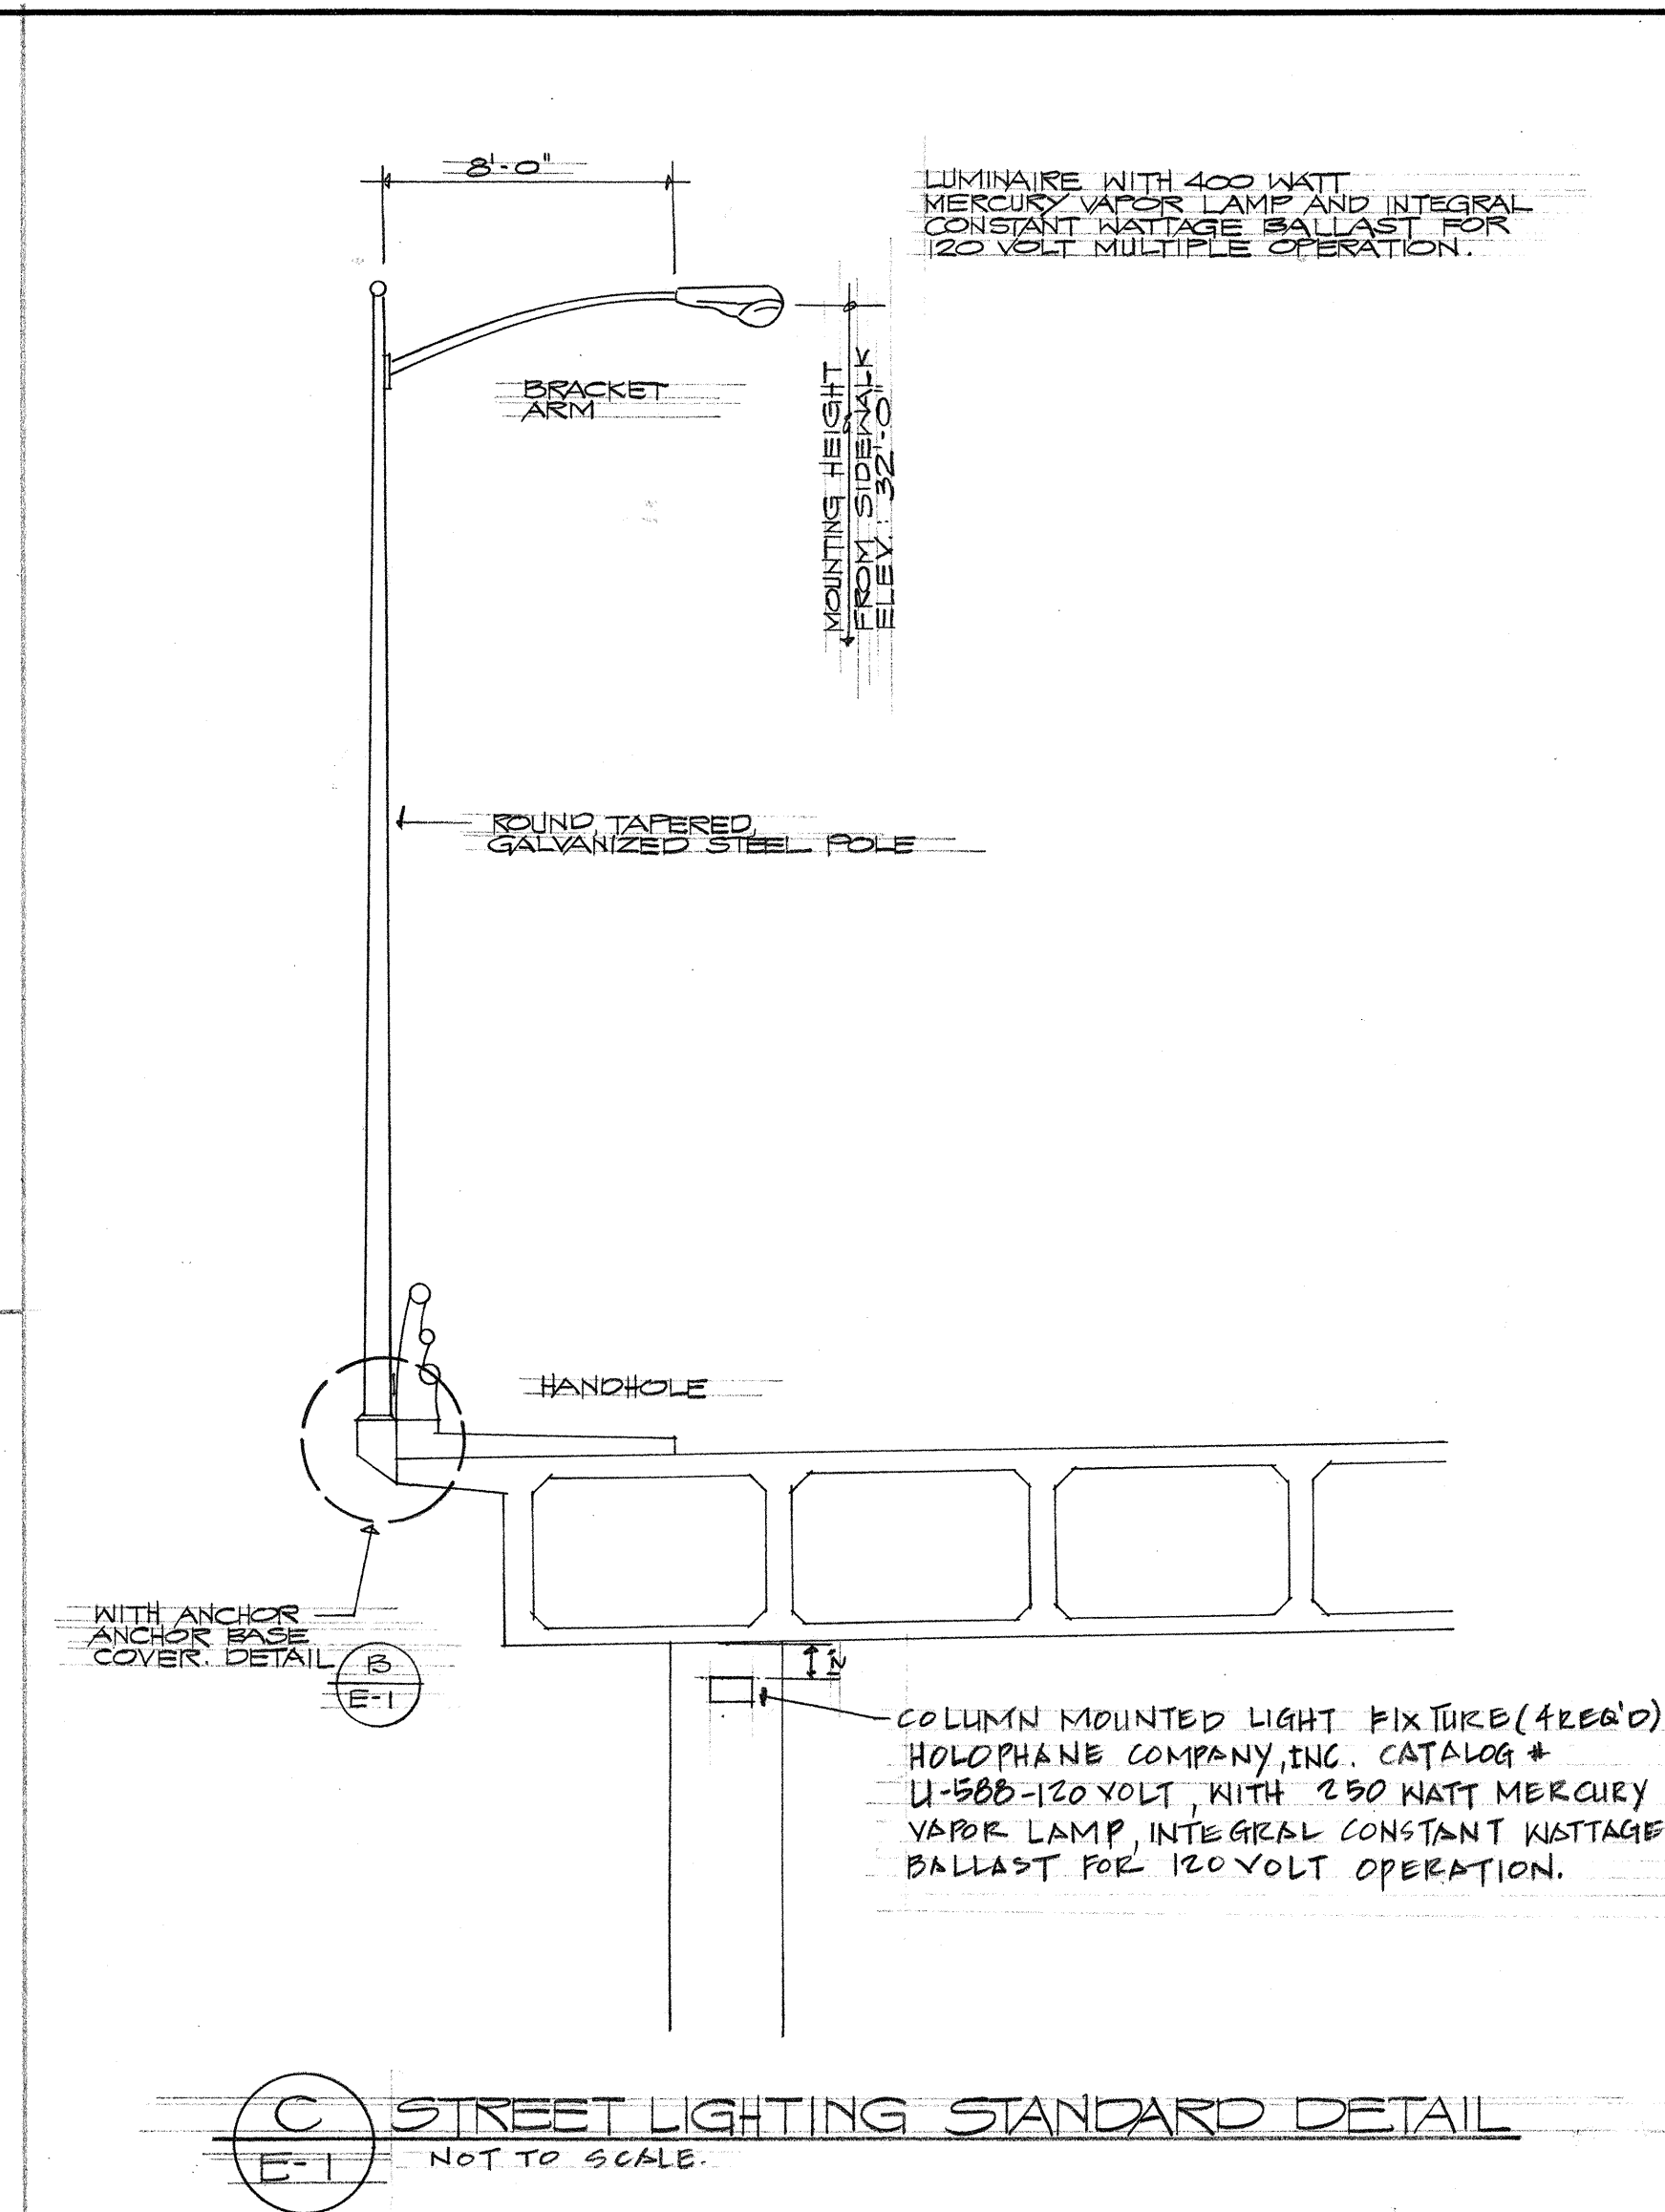

C EXPANSION COUPLING DETAIL
E-1 NOT TO SCALE

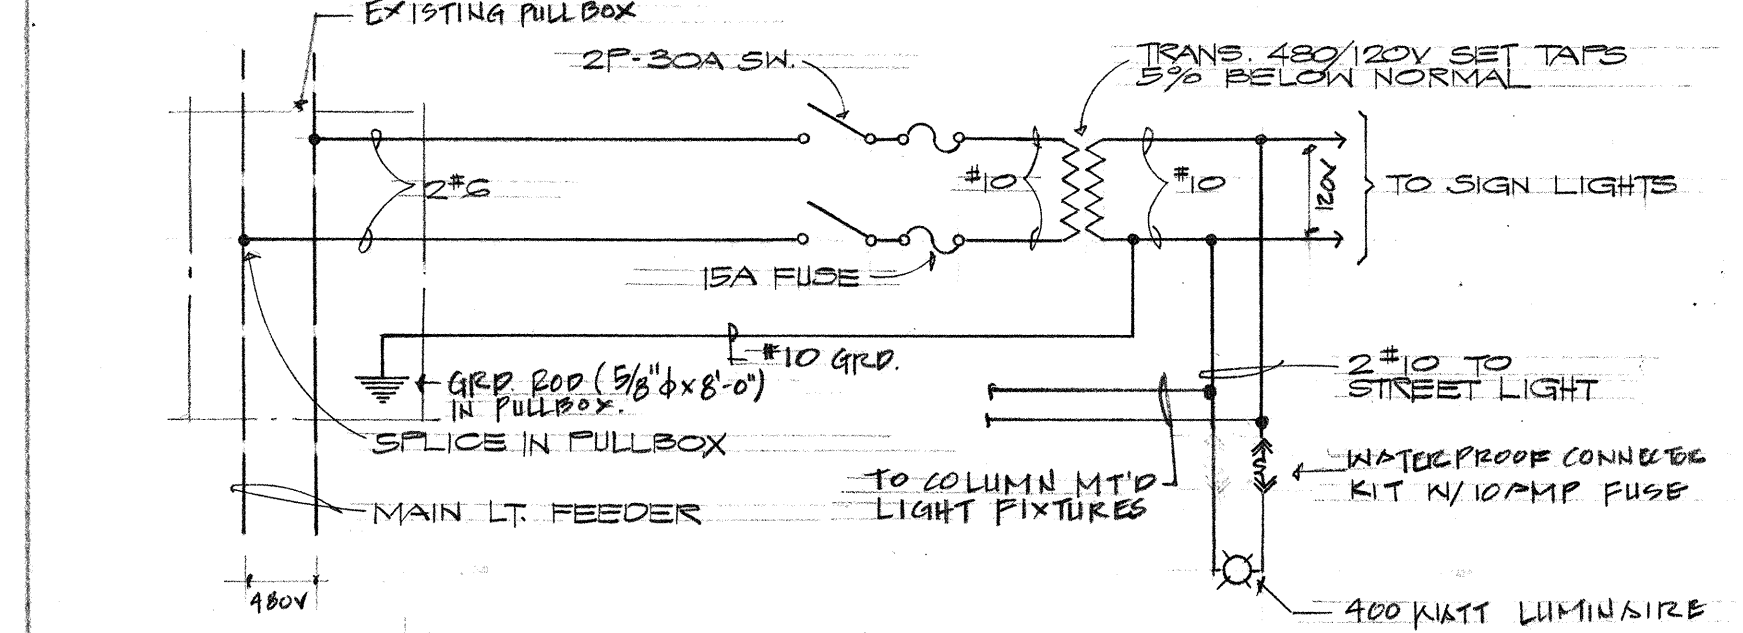

D WIRING DIAGRAM FOR SIGN
NOT TO SCALE

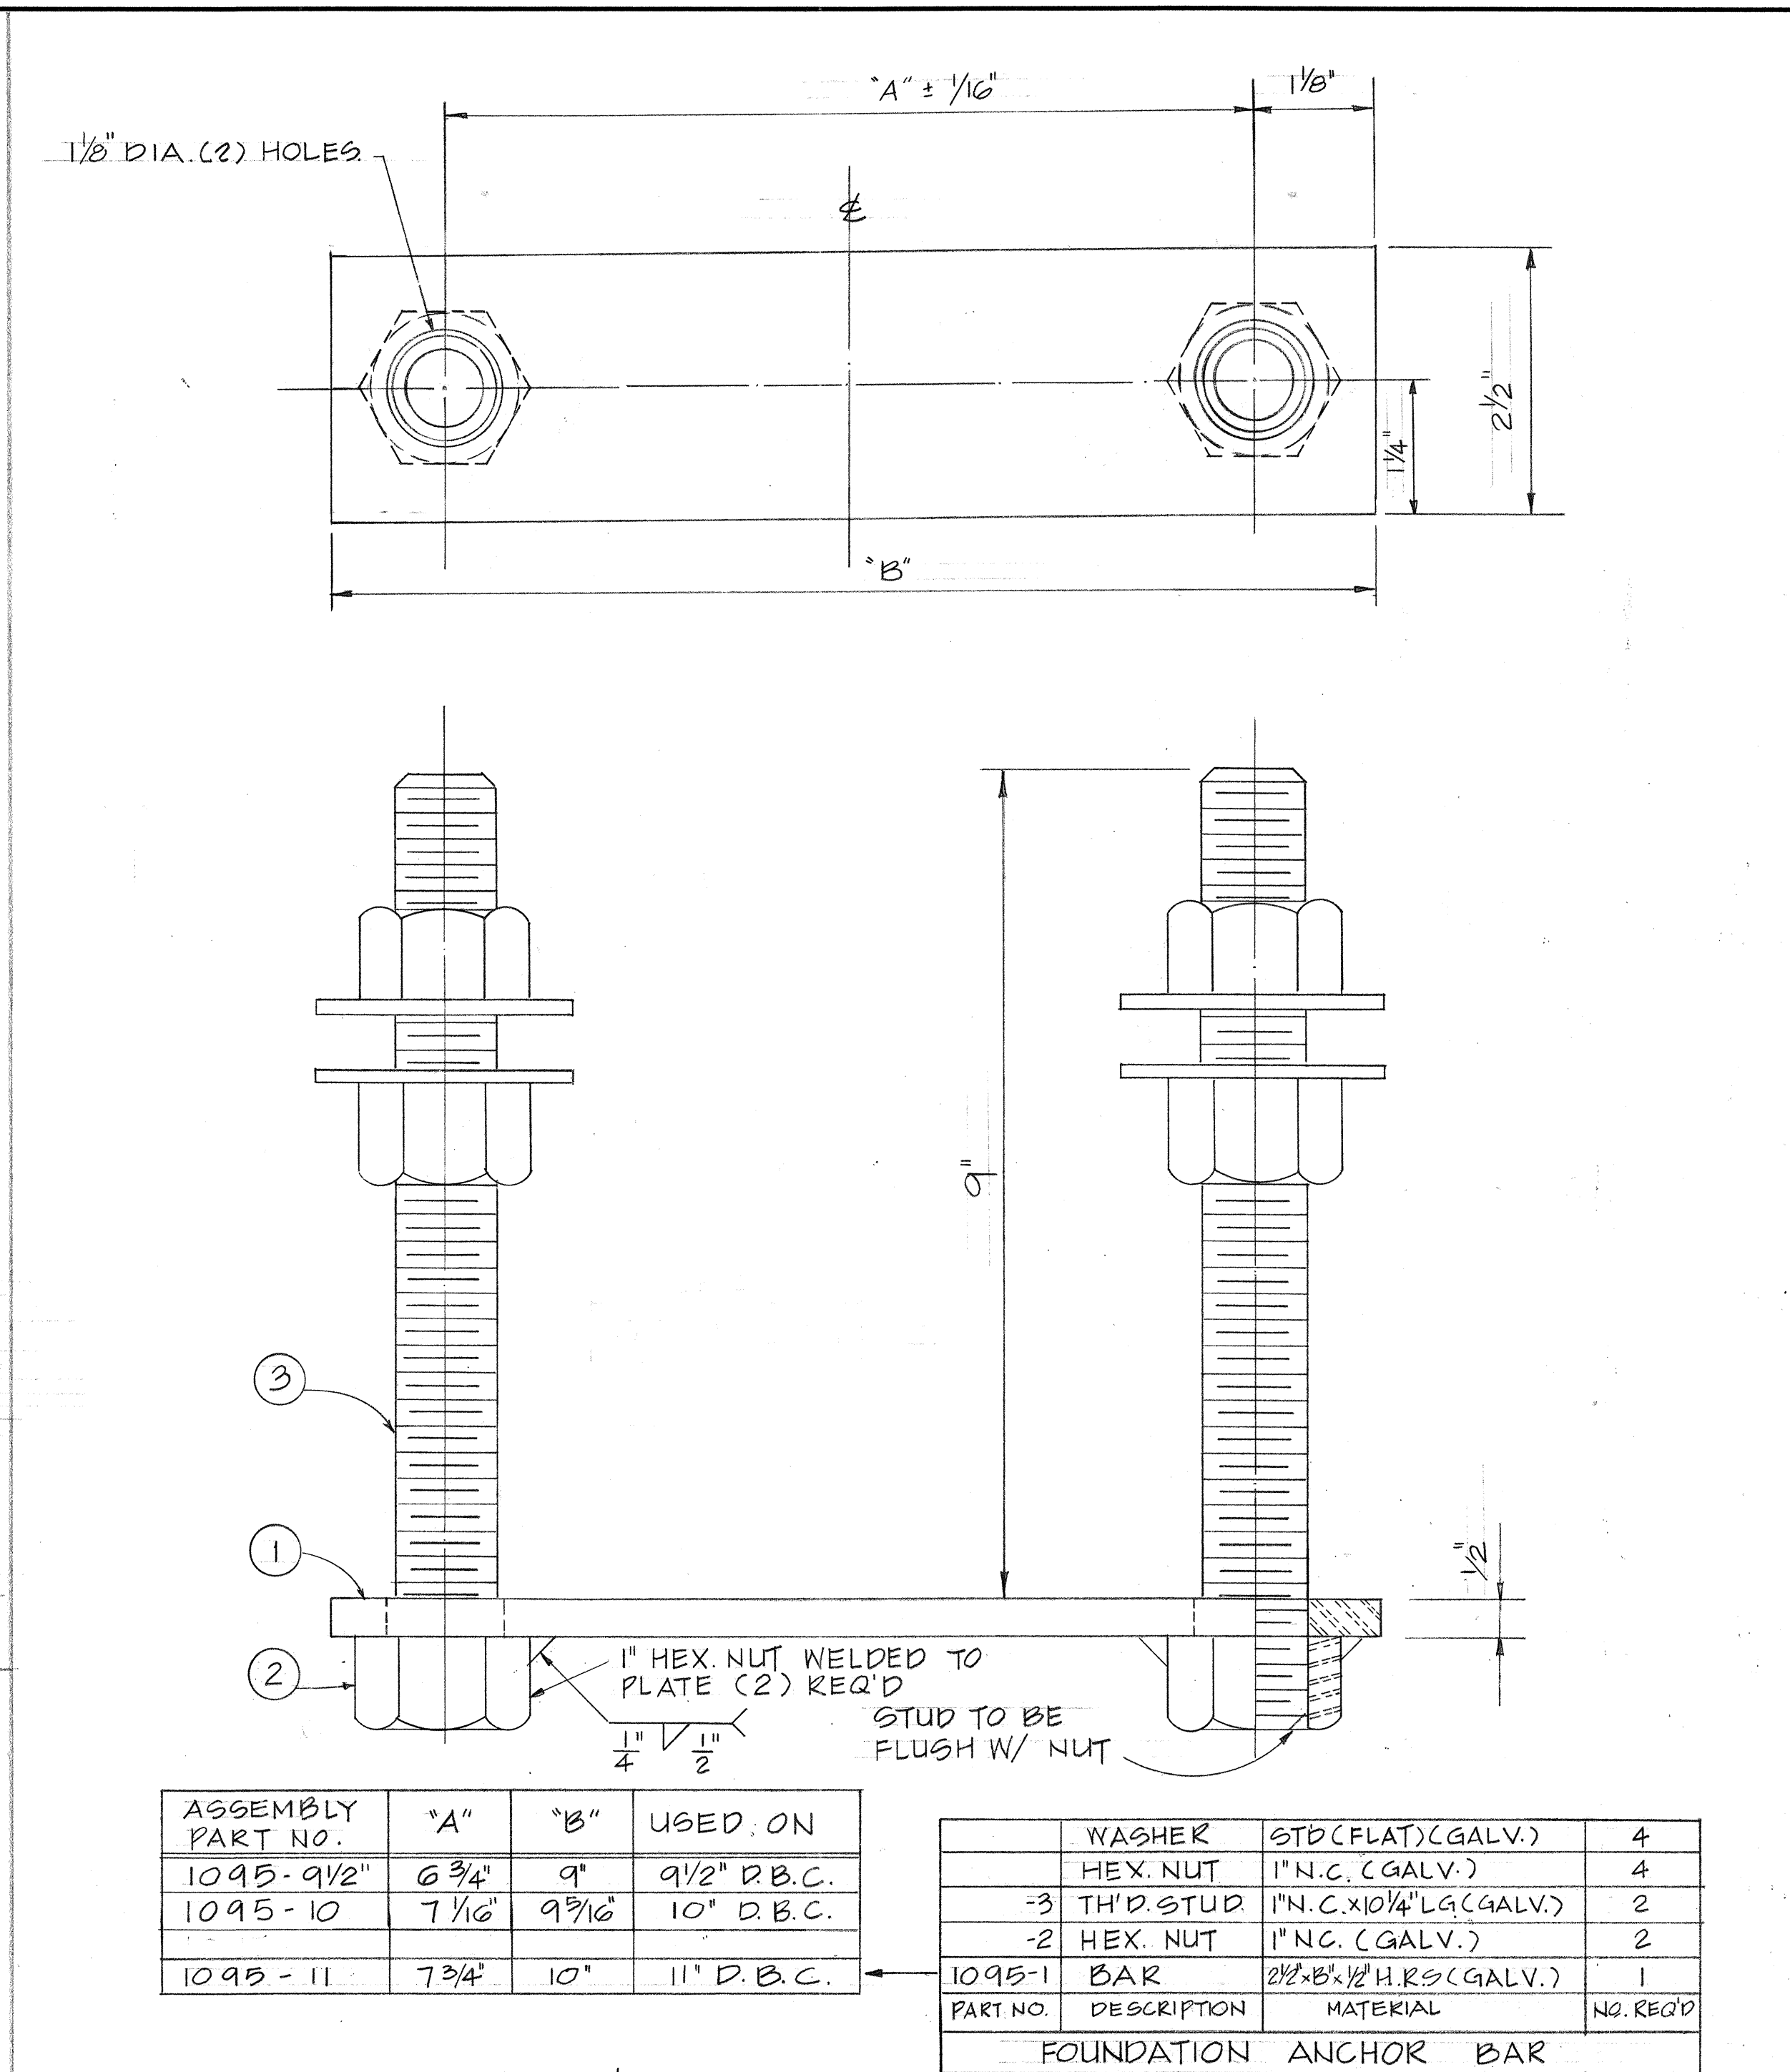

NOTE: ASSEM. TO BE GALV'D. AFTER FABRICATION.

DETAIL OF LIGHT STANDARD ANCHOR BOLDS & BAR
SCALE: 3/4" = 1'-0"

DESIGN
THIS WORK WAS PREPARED BY
ME OR UNDER MY SUPERVISION.

RICHARD Y. OKITA
REGISTERED
PROFESSIONAL
ENGINEER
No. 1590
HAWAII, U.S.A.


REVISION DATE	DESCRIPTION	MADE BY	APPROVED
COMMUNITY PLANNING INCORPORATED CIVIL ENGINEERS - SURVEYORS - CONSULTANT PLANNERS			
PETER HET ASSOCIATES INC. STRUCTURAL ENGINEERS			
WAIKAI - WAIMALU ACCESS ROAD WAIKAI, OAHU, HAWAII			
OWNER: B.P. BISHOP ESTATE OCEANVIEW VENTURES			
DEVELOPERS: AMFAC - TROISSELES OCEANVIEW VENTURES			
TAX MAP KEY: 9-8-02: 2 & 3			
WIDENING OF AUSTIN BISHOP GRADE SEPARATION ELECTRICAL PLAN AND DETAILS			
APPROVED: _____			
CHIEF, DIVISION OF ENGINEERING			
REG. ENGR. CERT. NO. 470-E			

GENERAL NOTES

- All concrete shall be Class A unless otherwise noted.
- Reinforcing shall be detailed in accordance with A.C.I. Manual of Standard Practice for Detailing Reinforced Concrete Highway Structures unless otherwise noted.
- Clearance for reinforcing bars shall be as follows, unless otherwise noted:
 - 1/2" for stirrups of beams & pier caps.
 - 2" for ties of columns.
 - 2" for formed walls.
 - 3" for footings.
- Minimum spacing between parallel bars shall be 2 1/2 times the diameter of bars, but in no case shall the clear distance between the bars be less than 1 1/2 times the maximum size of the coarse aggregate.
- All dimensions relating to reinforcing are to centers of bars unless otherwise noted.
- Reinforcing bars shall be securely tied at all intersections & lap splices & shall be held in place during pouring to maintain their proper locations as shown on plans.
- Vertical column bars shall be arranged in such a manner as to miss pier cap bars above as directed by the Engineer.
- Except as otherwise noted on drawings, all exterior corners & re-entrant angles in concrete work shall be chamfered 3/4" x 3/4".
- Concrete seats receiving steel plates, lead plates or neoprene pads shall be poured monolithically with supporting structures & top of concrete seats shall be finished with a steel trowel to a smooth level surface at the elevation shown on the plans.
- Elastomeric Pads: Bottom of bridge bearing pads shall be secured against displacement with adhesives approved by the Engineer. Pads shall be incidental to concrete and will not be paid for separately.
- Forms for all exposed surfaces of separation structures and surfaces of retaining walls visible from a traveled way or from a populated area shall be plywood except that metal forms may be permitted provided a surface finish satisfactory to the Engineer can be obtained and the use of such forms is approved in writing by the Engineer. Forms for round columns shall be made of materials that will give a smooth finish and true dimensions as given in the plans. Forms for prestressed concrete members shall be either metal or plywood.
- Gothic letters and figures approximating dimensions shown will be acceptable if approved by the Engineer.
- The contractor shall verify the location of all existing utility lines and notify the respective owners before commencing work of excavation or driving of piles.
- Standard Detail Drawings refer to all structures in general, except for modifications as may be required for special conditions. For such modifications refer to the corresponding detailed drawings.

TYPICAL CONCRETE GROOVE DETAIL


DRIP DETAIL

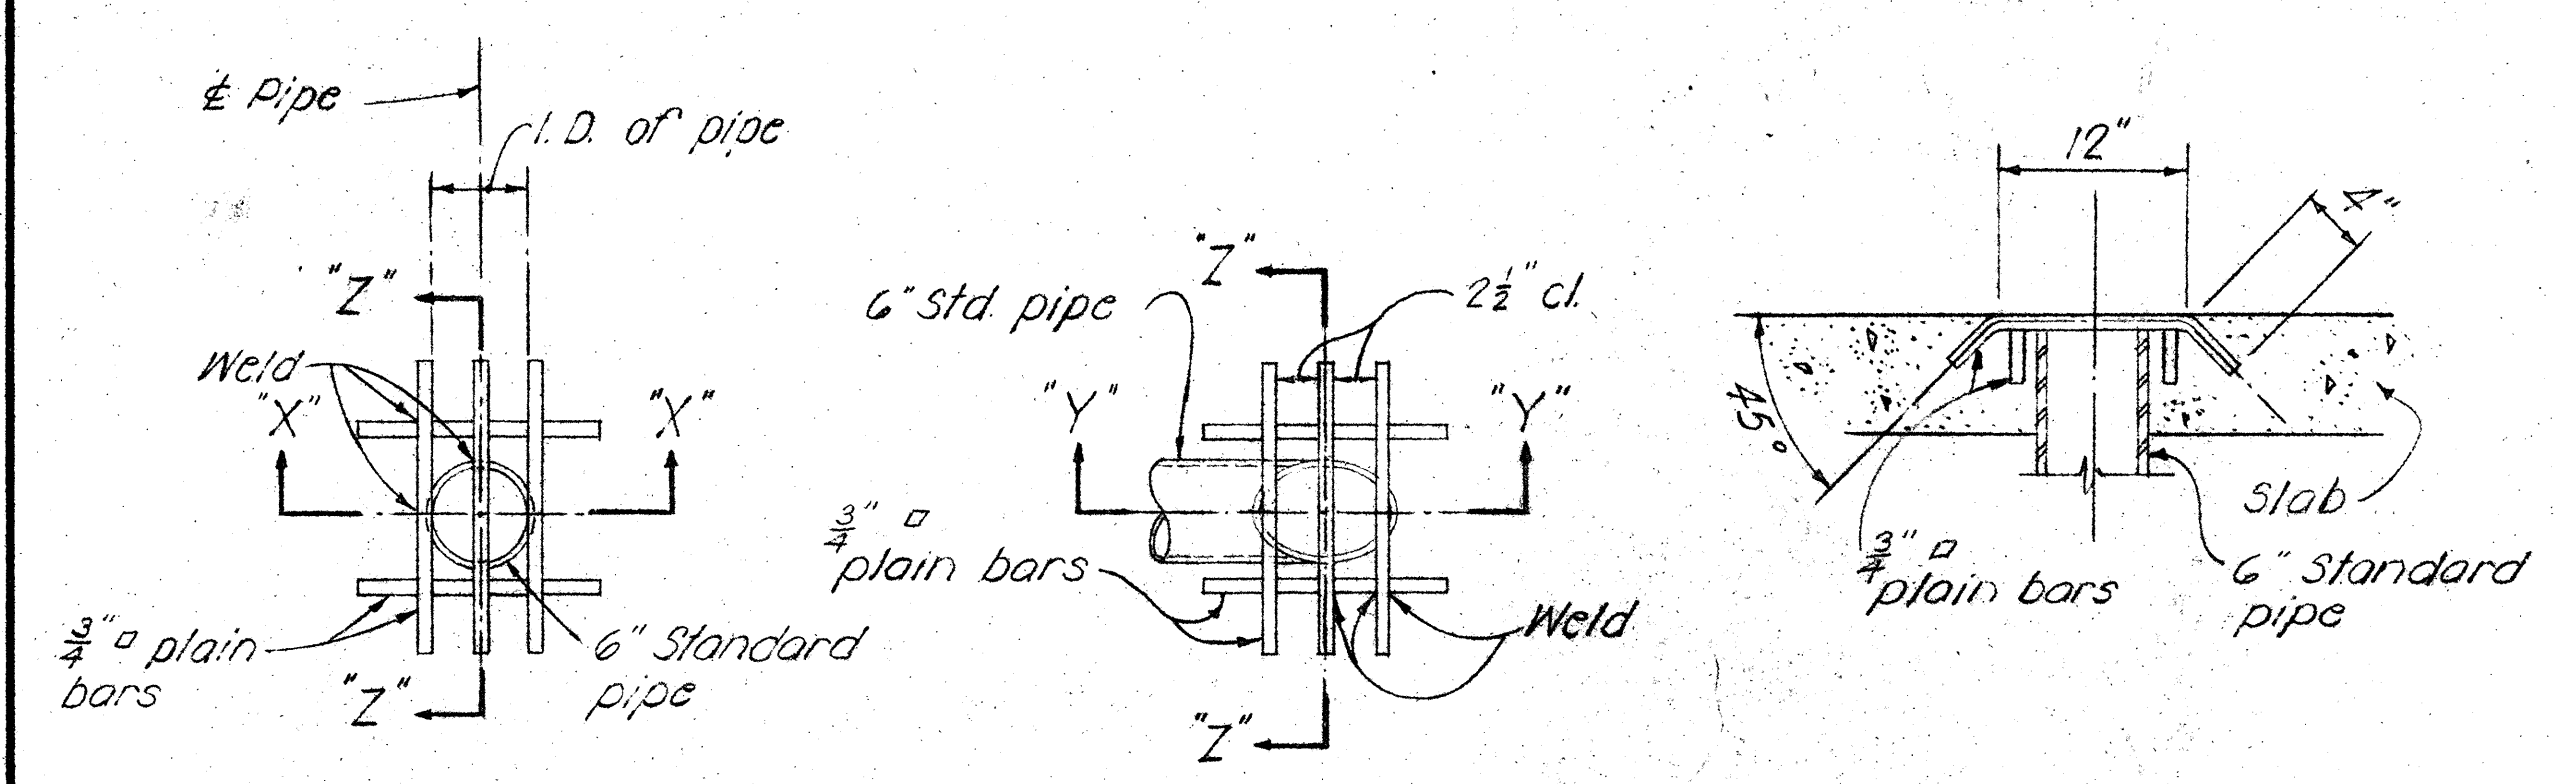

PLAN

PLAN

SECTION "Z-Z"

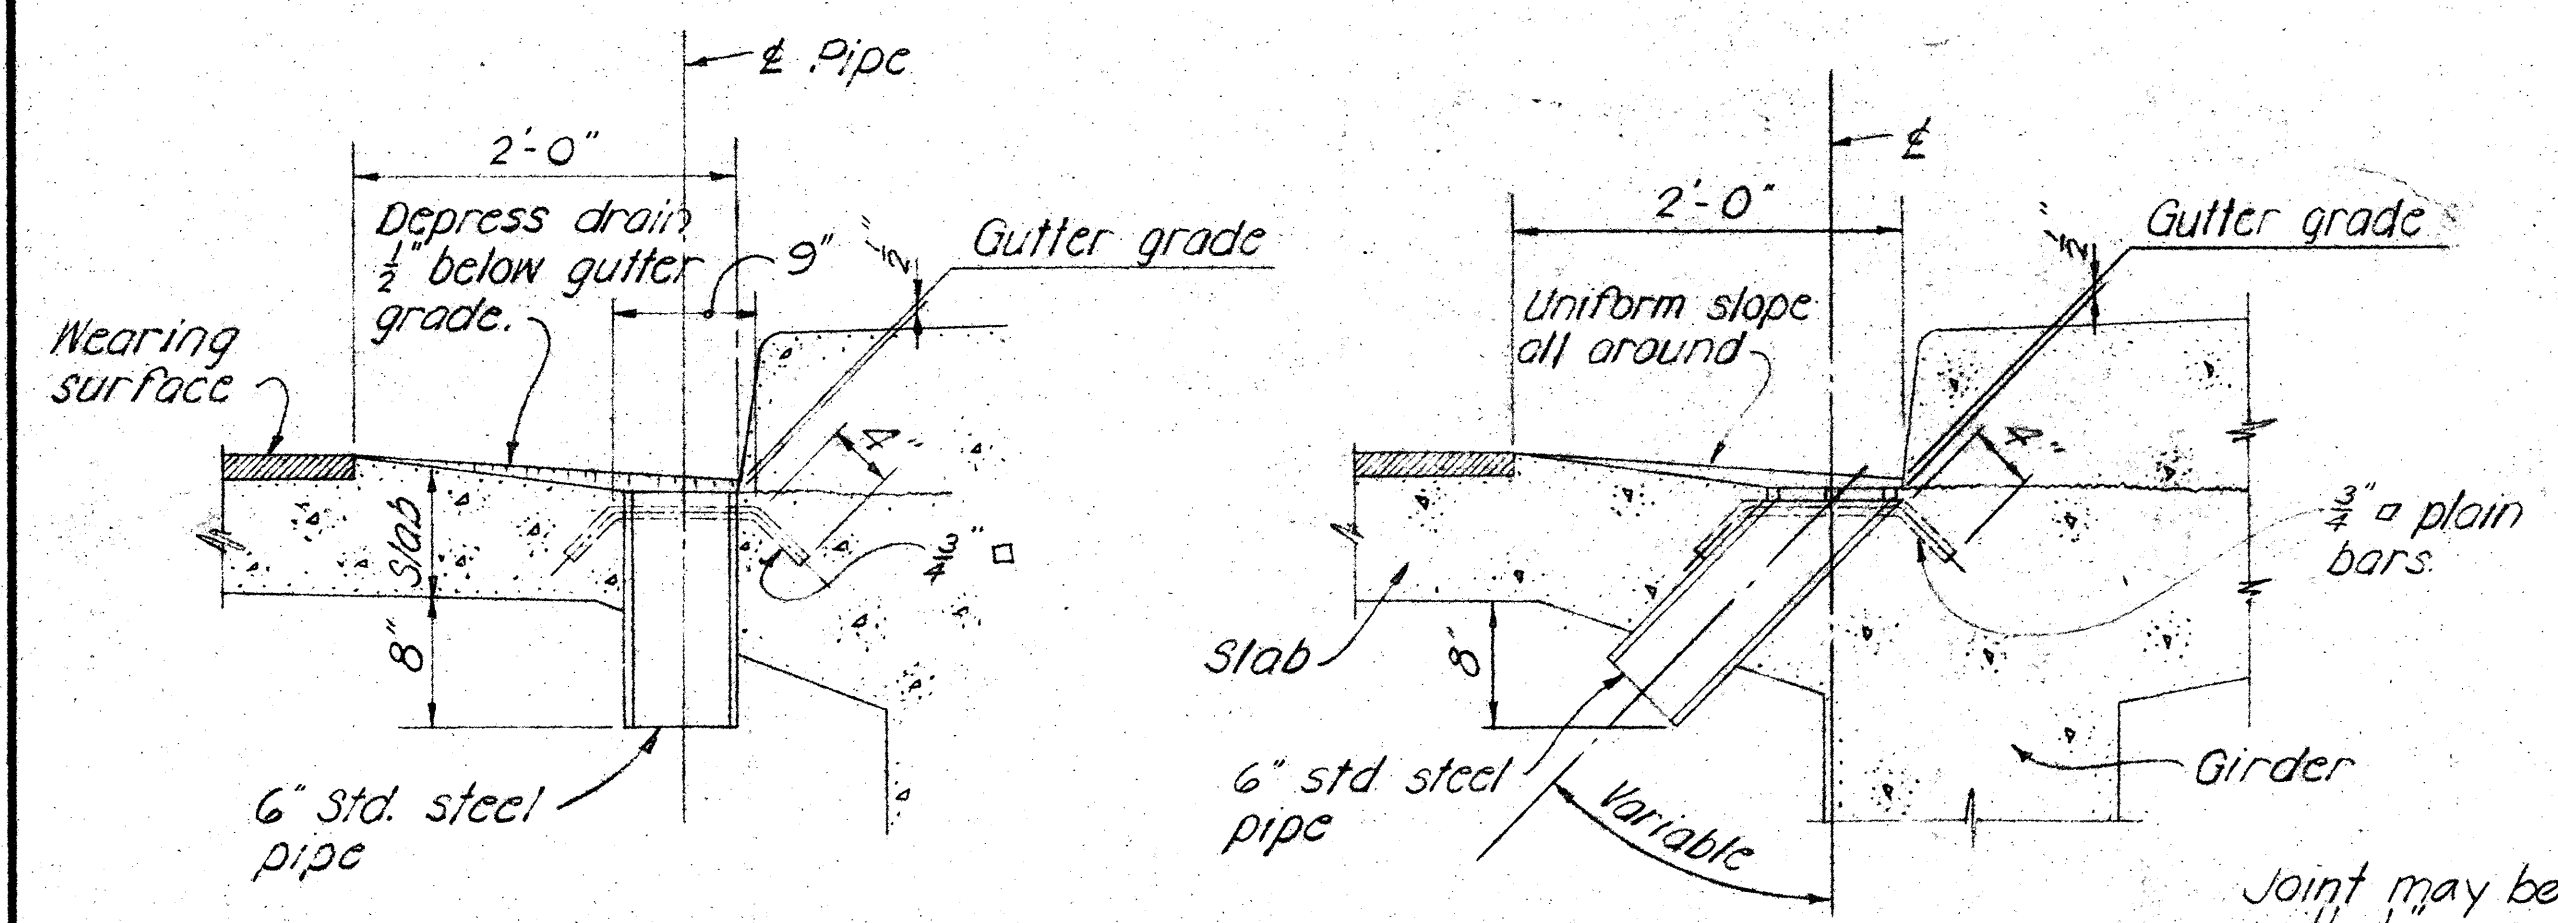


SECTION "X-X"

SECTION "Y-Y"

NOTE: Metal drains shall be considered incidental to Class A Concrete in both concrete and steel bridges and will not be paid for separately. Assemblage of grillage and pipe shall be hot-dip galvanized after all welding is completed.



TYPICAL DRAINAGE DETAILS

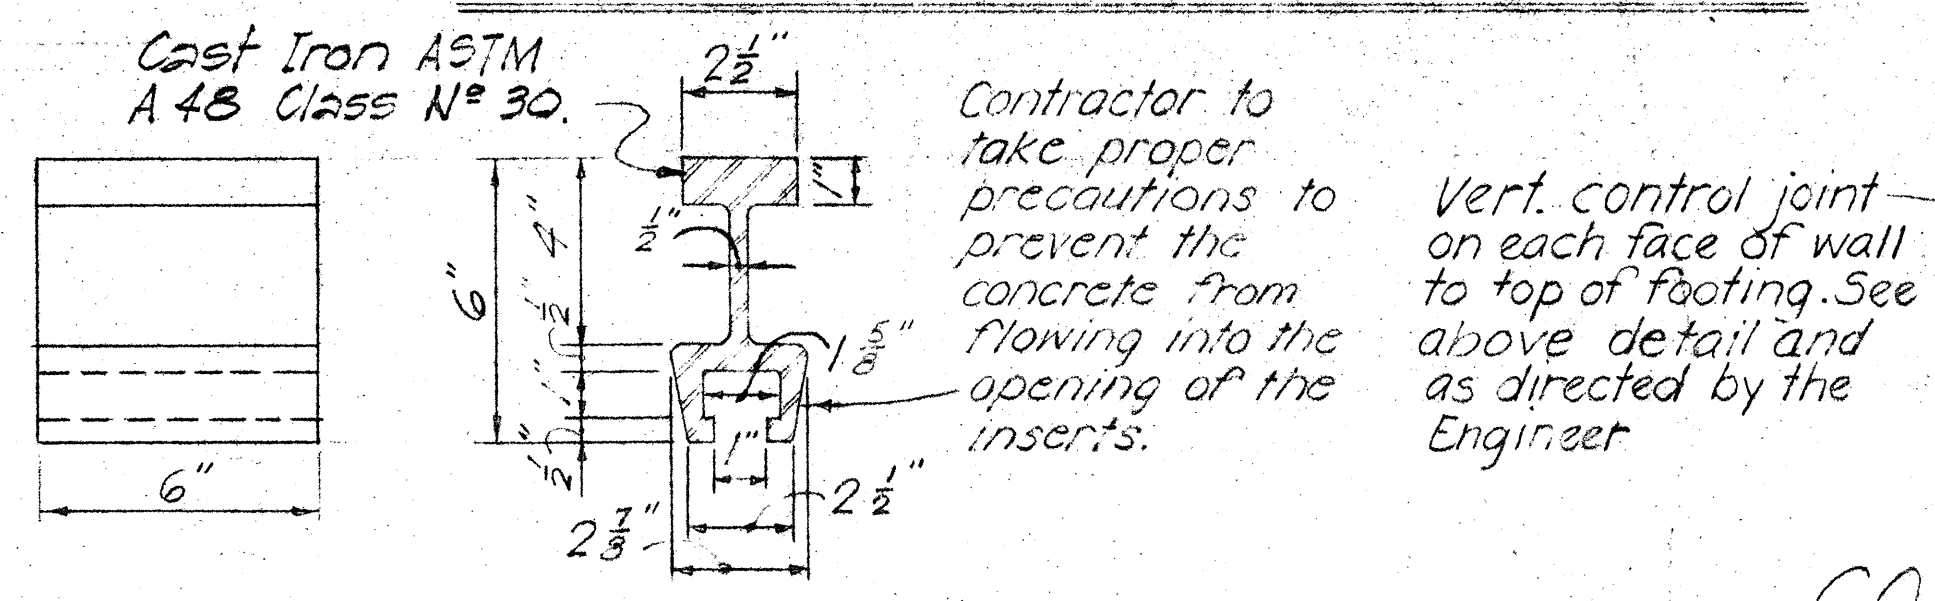

INSERT DETAIL

CONTROL JOINT DETAILS

TYP FLASHING COMPOUND WATERPROOFING DETAIL

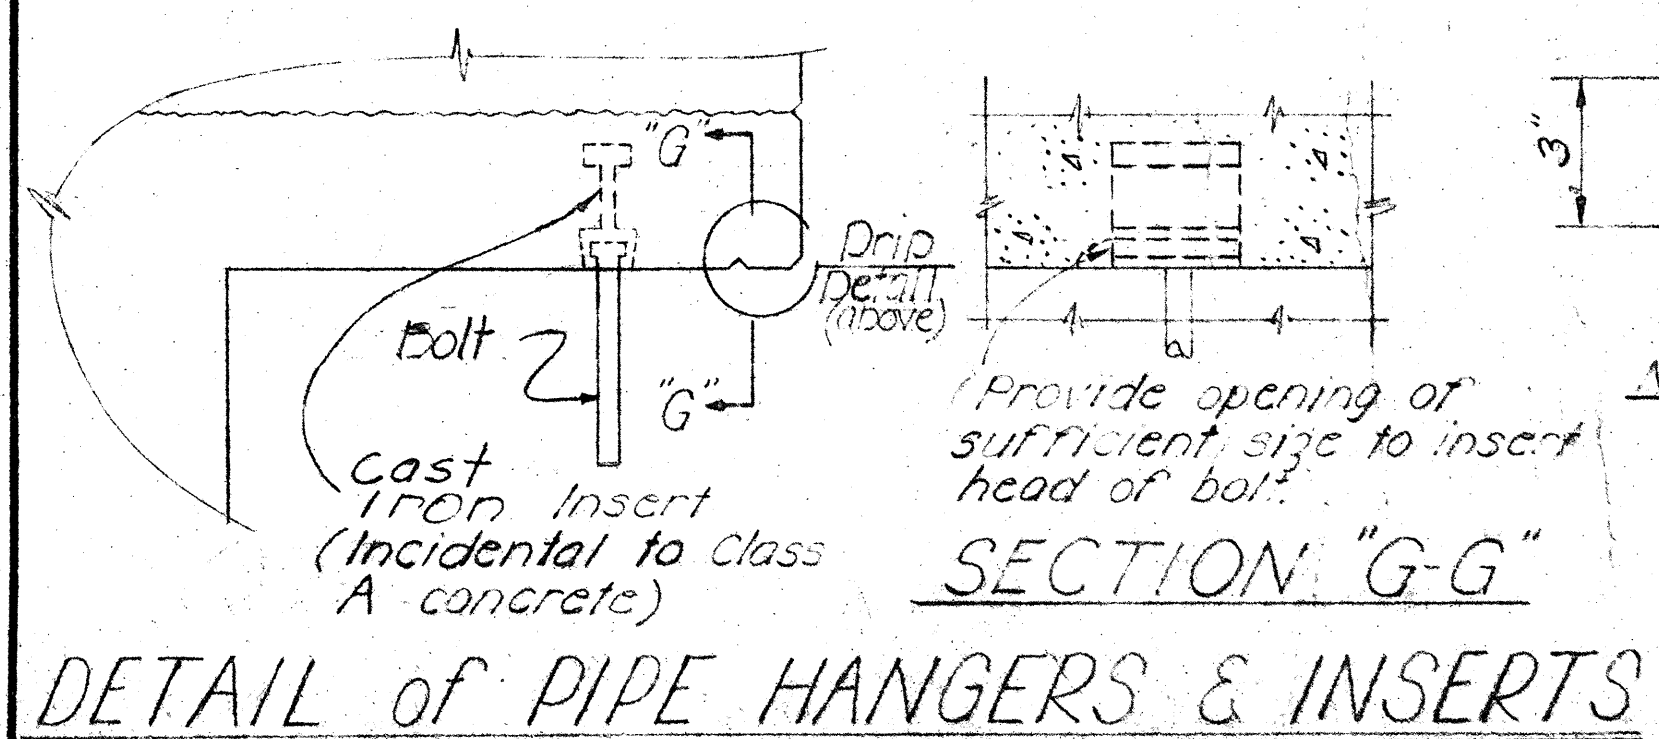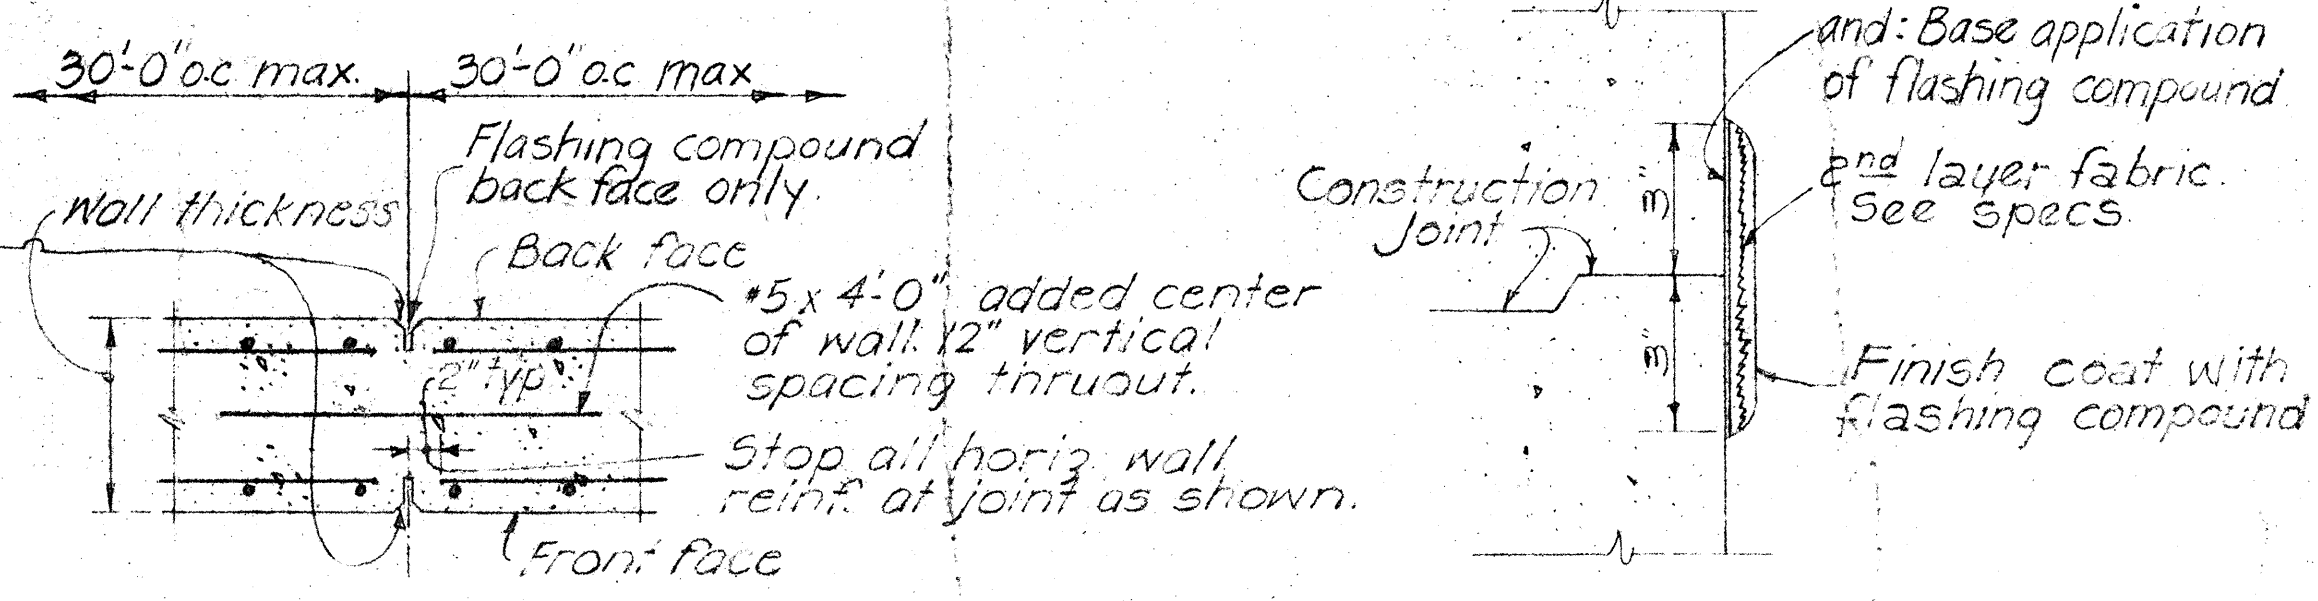


SECTION "G-G"

NAME DATE

Use correct name of bridge Date of Year built
NOTE: Refer to corresponding detail drawings for placement of such names & dates at end post. Exact details & spacing of letters & figures shall be as directed by the Engineer. See Note #12.

TYPICAL DETAIL OF LETTERS & FIGURES AT CONCRETE END POST

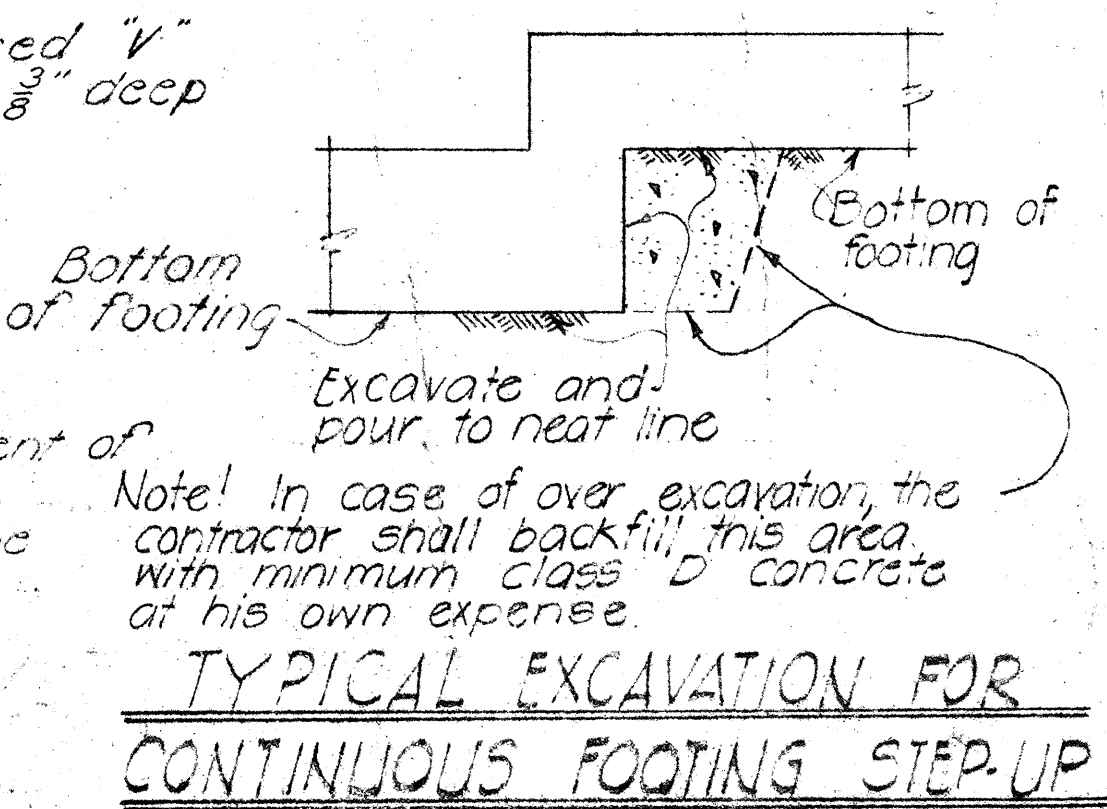

TYPICAL EXCAVATION FOR CONTINUOUS FOOTING STEP-UP


APPROVAL RECOMMENDED:
 Paul T. Yamashita
 BRIDGE DESIGN ENGINEER 1-23-70
 DATE

APPROVED
 Paul T. Yamashita
 ASSISTANT CHIEF, ENGINEERING 1-28-70
 DATE

NO.	REVISION	APPROVED BY	DATE


STATE OF HAWAII
 DEPARTMENT OF TRANSPORTATION
 HIGHWAYS DIVISION
STANDARD DETAILS
 NOTES AND MISCELLANEOUS
 DETAILS
 Date: October 1969
 SHEET No. 51 OF 58 SHEETS DB-100

FED. ROAD DIST. NO.	STATE	FED. AID PROJ. NO.	FISCAL YEAR	SHEET NO.	TOTAL SHEETS
HAWAII	HAW.				

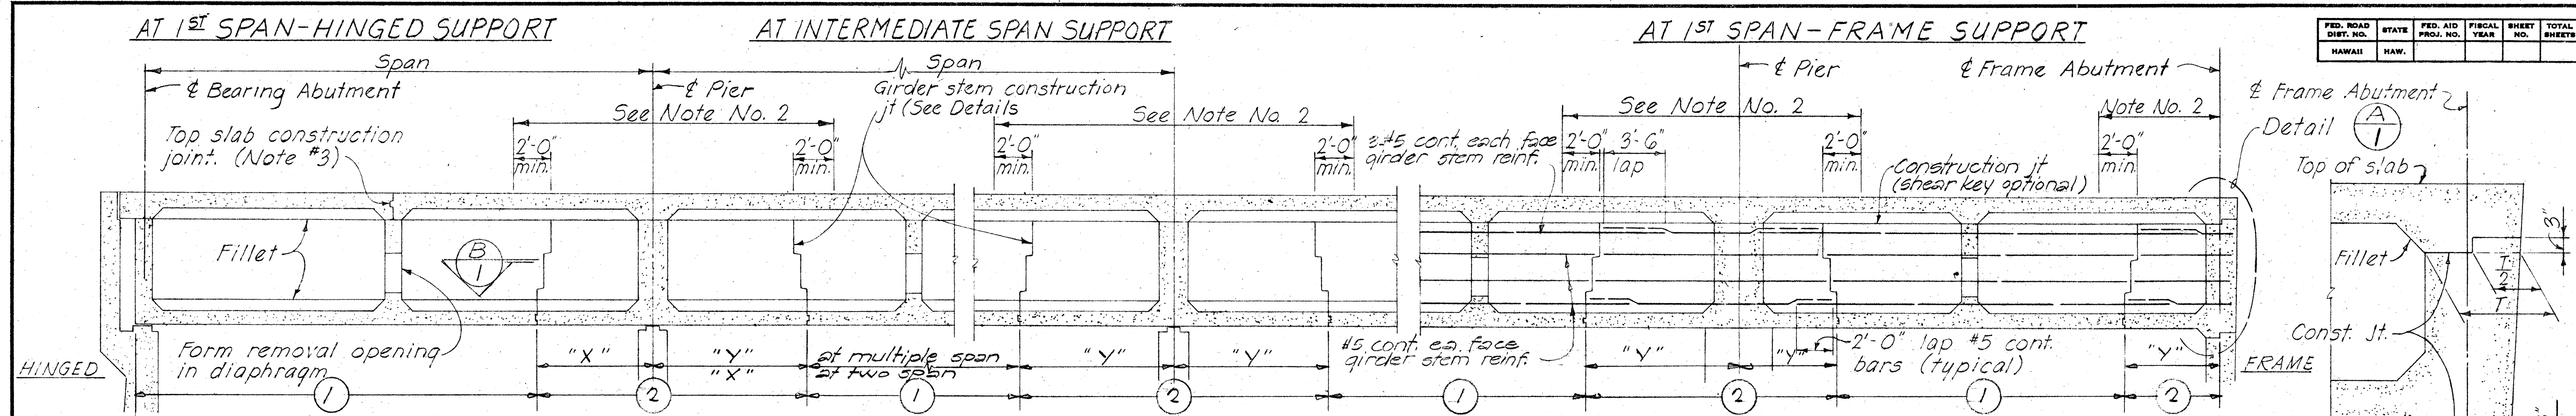


PLACING DIAGRAM FOR SUPERSTRUCTURE CONCRETE

- NOTE:**
- Numbers ① & ② indicate sequence of placing bottom slab & girder stem concrete. ② may be placed with ① when approved by the Engineer provided that the ① sections adjoining the ② sections are placed in this pour. For any deviation from the above the Contractor shall submit a diagram to the Engineer for approval.
 - No top slab construction joint or form removal opening shall be located in the region over the piers as noted, nor in the supporting section of a hinged span.
 - When top slab is not poured continuously, and top slab forms are not removed, construction joint in top slab shall be located over an intermediate diaphragm.
 - Top slab concrete shall be placed separately from the stem. Top slab concrete may be placed continuously or in parts as approved by the Engineer, providing pour is not in conflict with the above notes.
 - Dimension "X" = $\frac{1}{4}$ span. "Y" = $\frac{1}{5}$ span.
 - No lapping of main bars shall be permitted at construction joints.

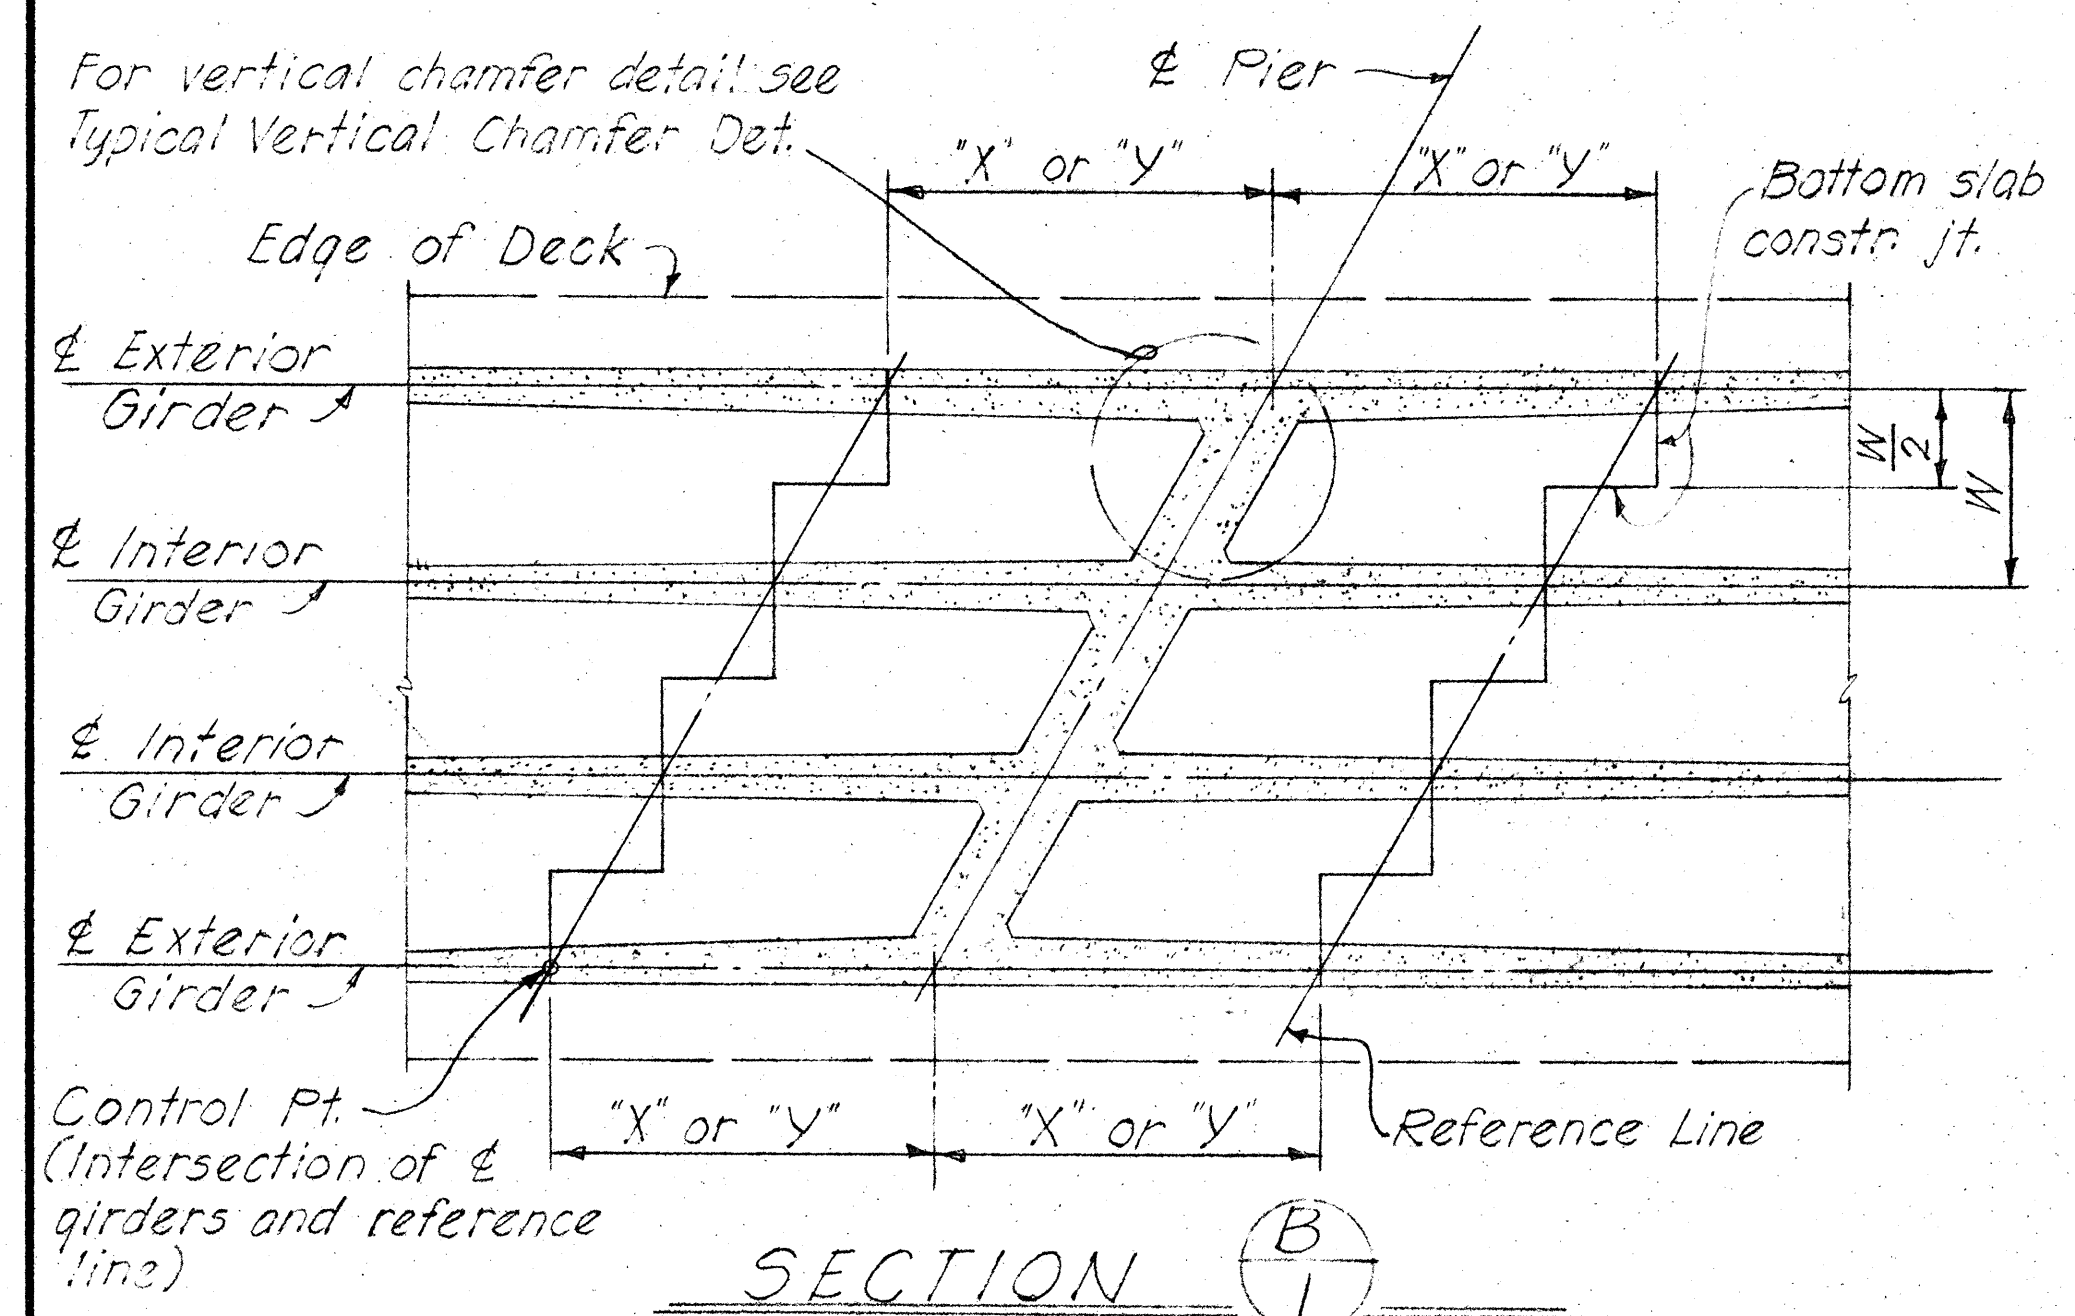


SECTION B

TREATMENT OF CONSTRUCTION JOINT BRIDGES ON SKEW

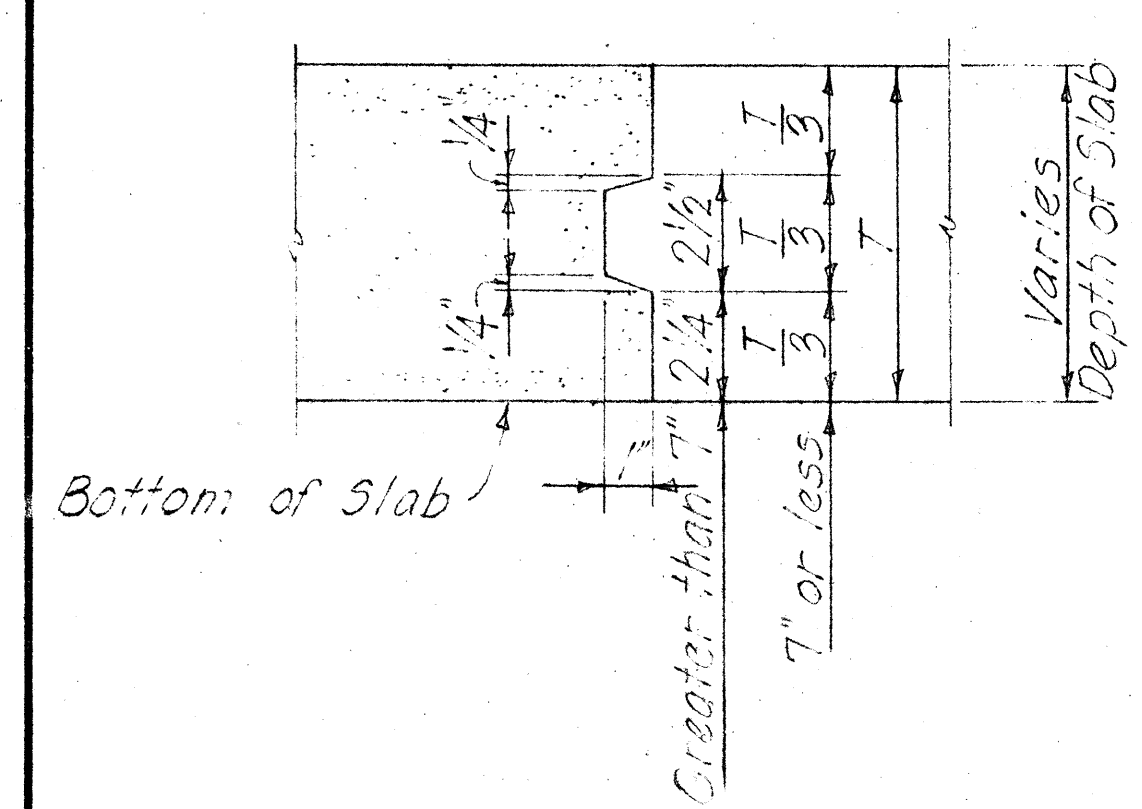


TYPICAL SLAB CONSTRUCTION JOINT DETAIL

- NOTE:**
- If the Contractor elects to leave top slab forms in place, form removal opening shall be omitted and replaced by 3" vent.
- No vertical shoring shall be placed in the center half of top slab span W.

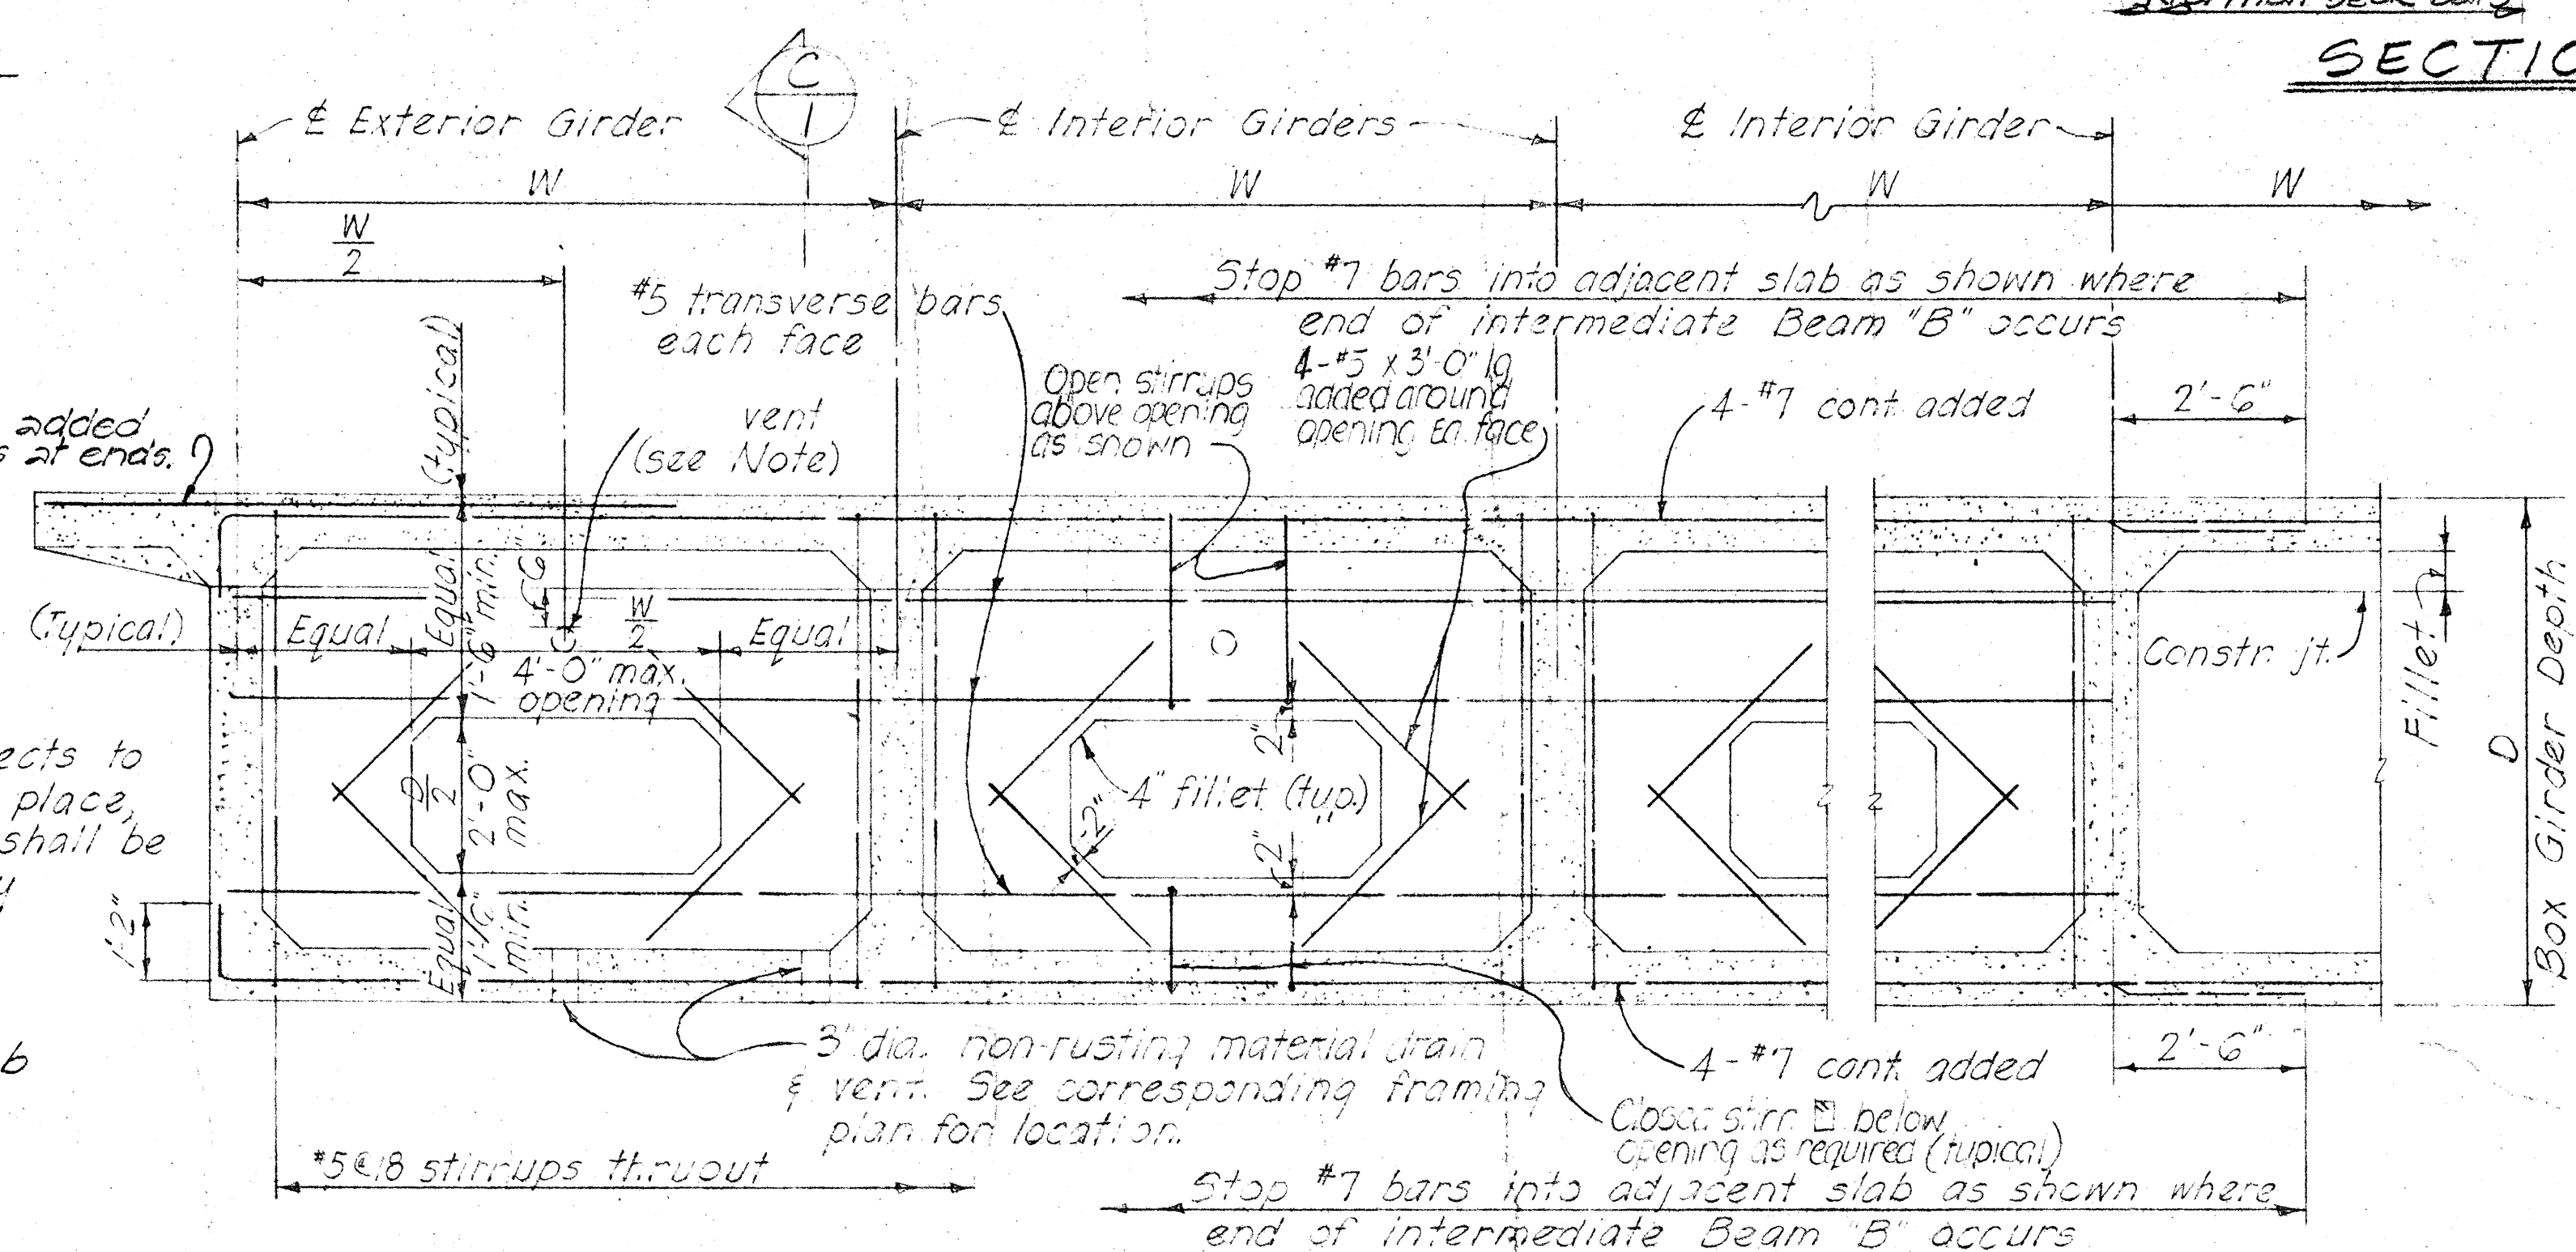

AT NON-CONTINUOUS ENDS TYPICAL INTERIOR SPAN

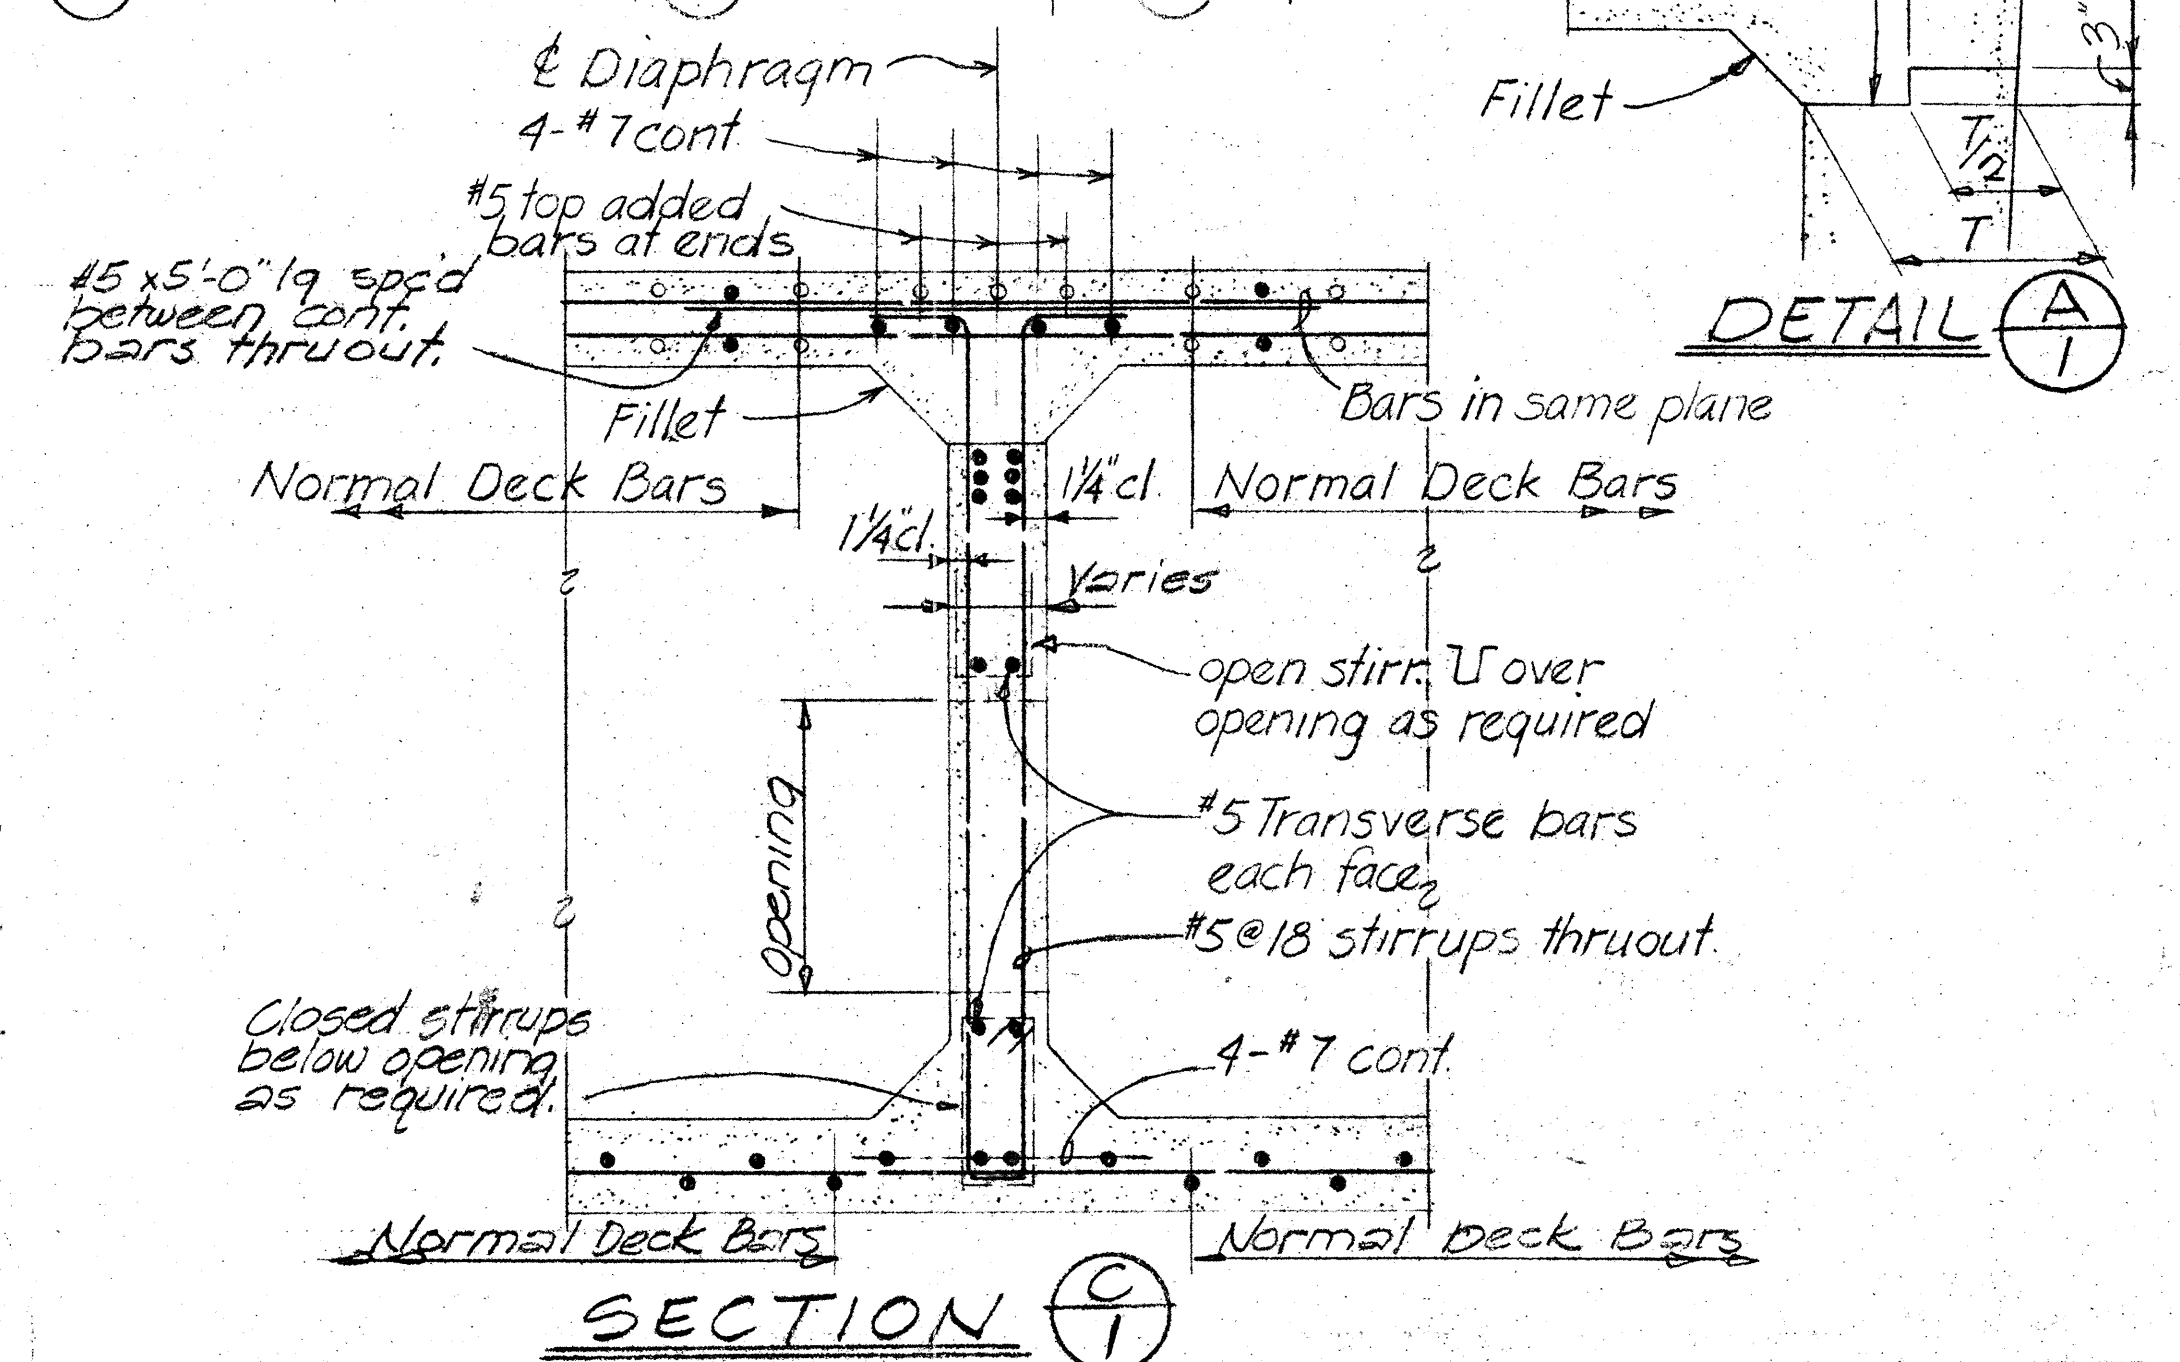

SECTION C

NO.	REVISION	APPROVED BY	DATE


APPROVAL RECOMMENDED:
Paul T. Vamvakis 1-23-70
 BRIDGE DESIGN ENGINEER DATE

APPROVED:
Paul T. Vamvakis 1-28-70
 ASSISTANT CHIEF, ENGINEERING DATE



STATE OF HAWAII
 DEPARTMENT OF TRANSPORTATION
 HIGHWAYS DIVISION

STANDARD DETAILS
CONCRETE BOX GIRDER

Date
 SHEET No. 5-2 OF 5-8 SHEETS DB-101-I

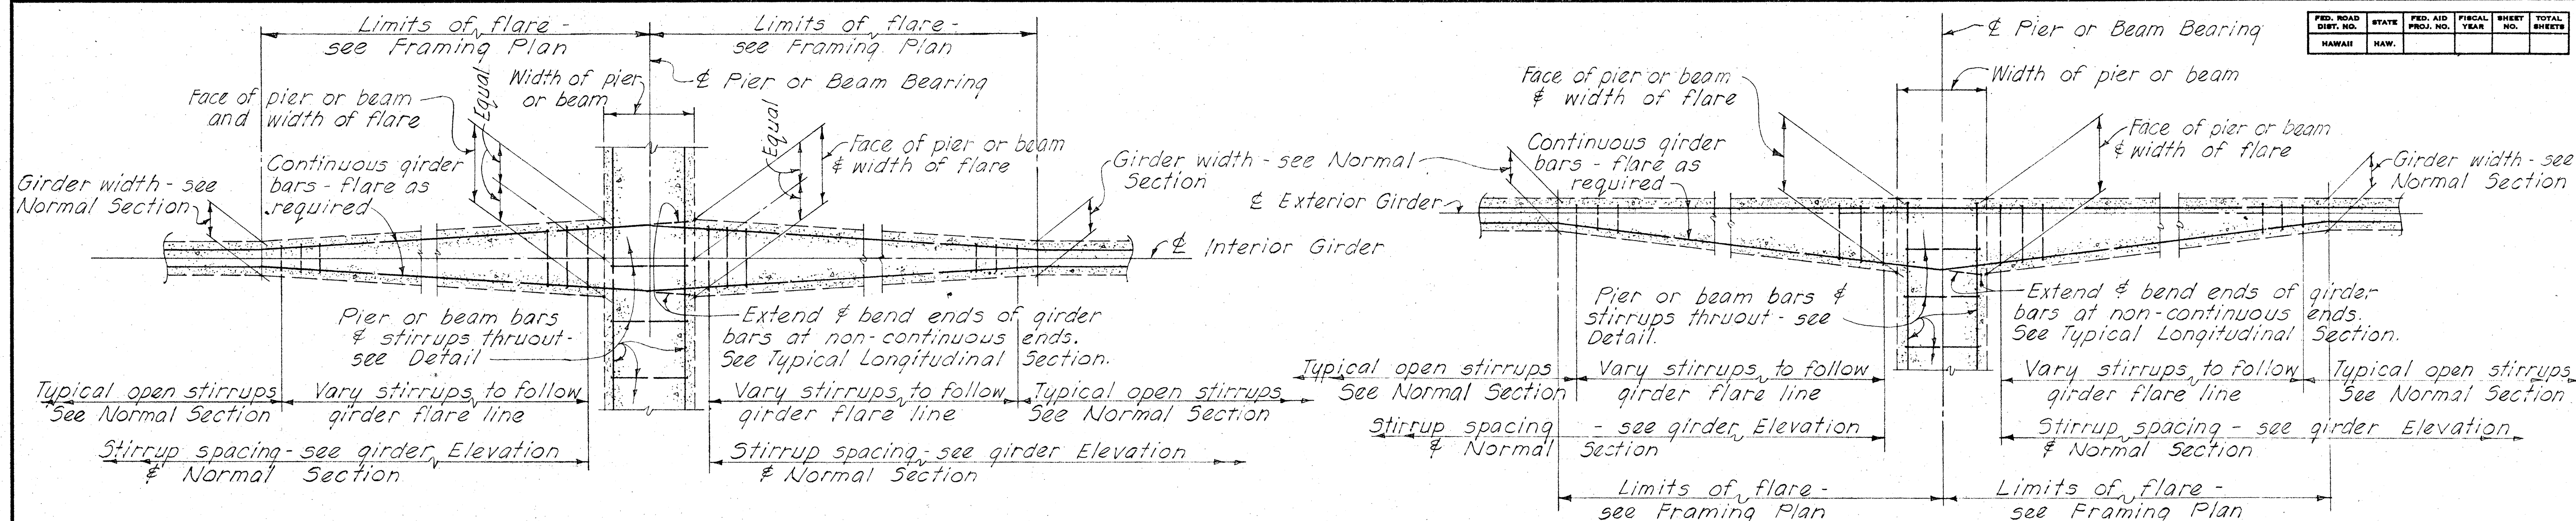

INTERIOR GIRDER EXTERIOR GIRDER
TYPICAL DETAILS OF GIRDER FLARE AT NORMAL OR RADIAL SUPPORTS - CONTINUOUS ENDS AS SHOWN
(NON-CONTINUOUS ENDS SIMILAR EXCEPT AS OTHERWISE NOTED) ϕ Girder $\sim$ 1/2

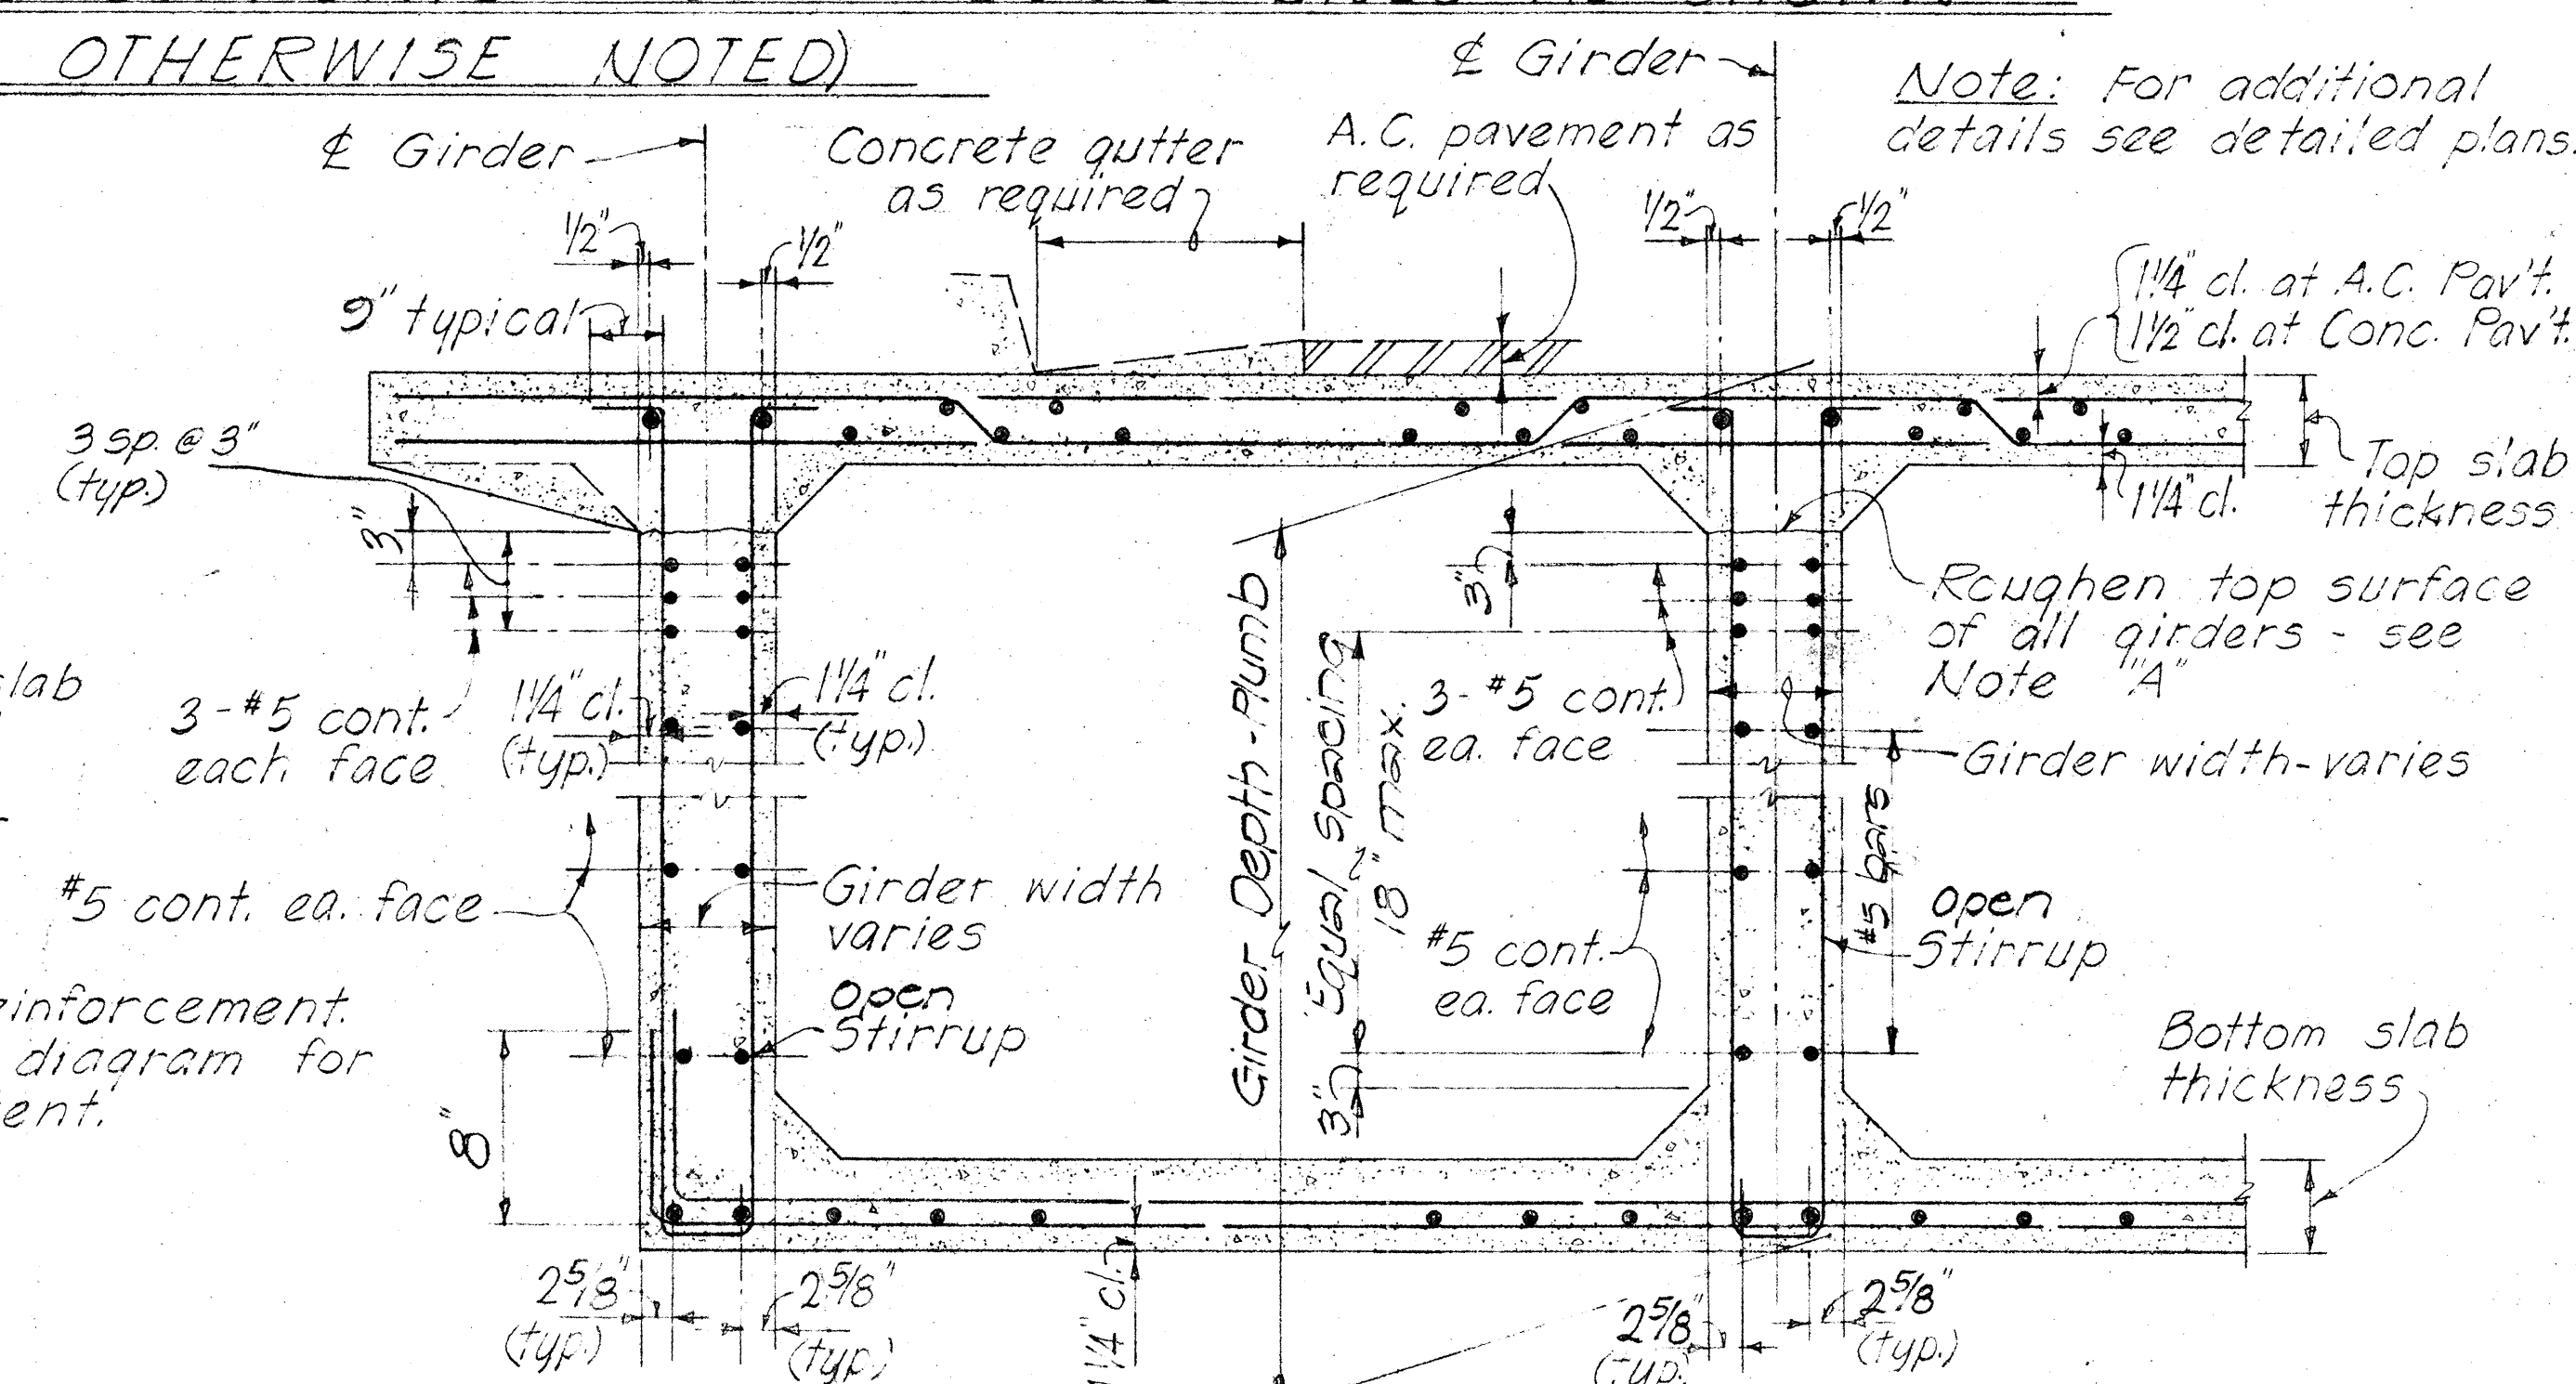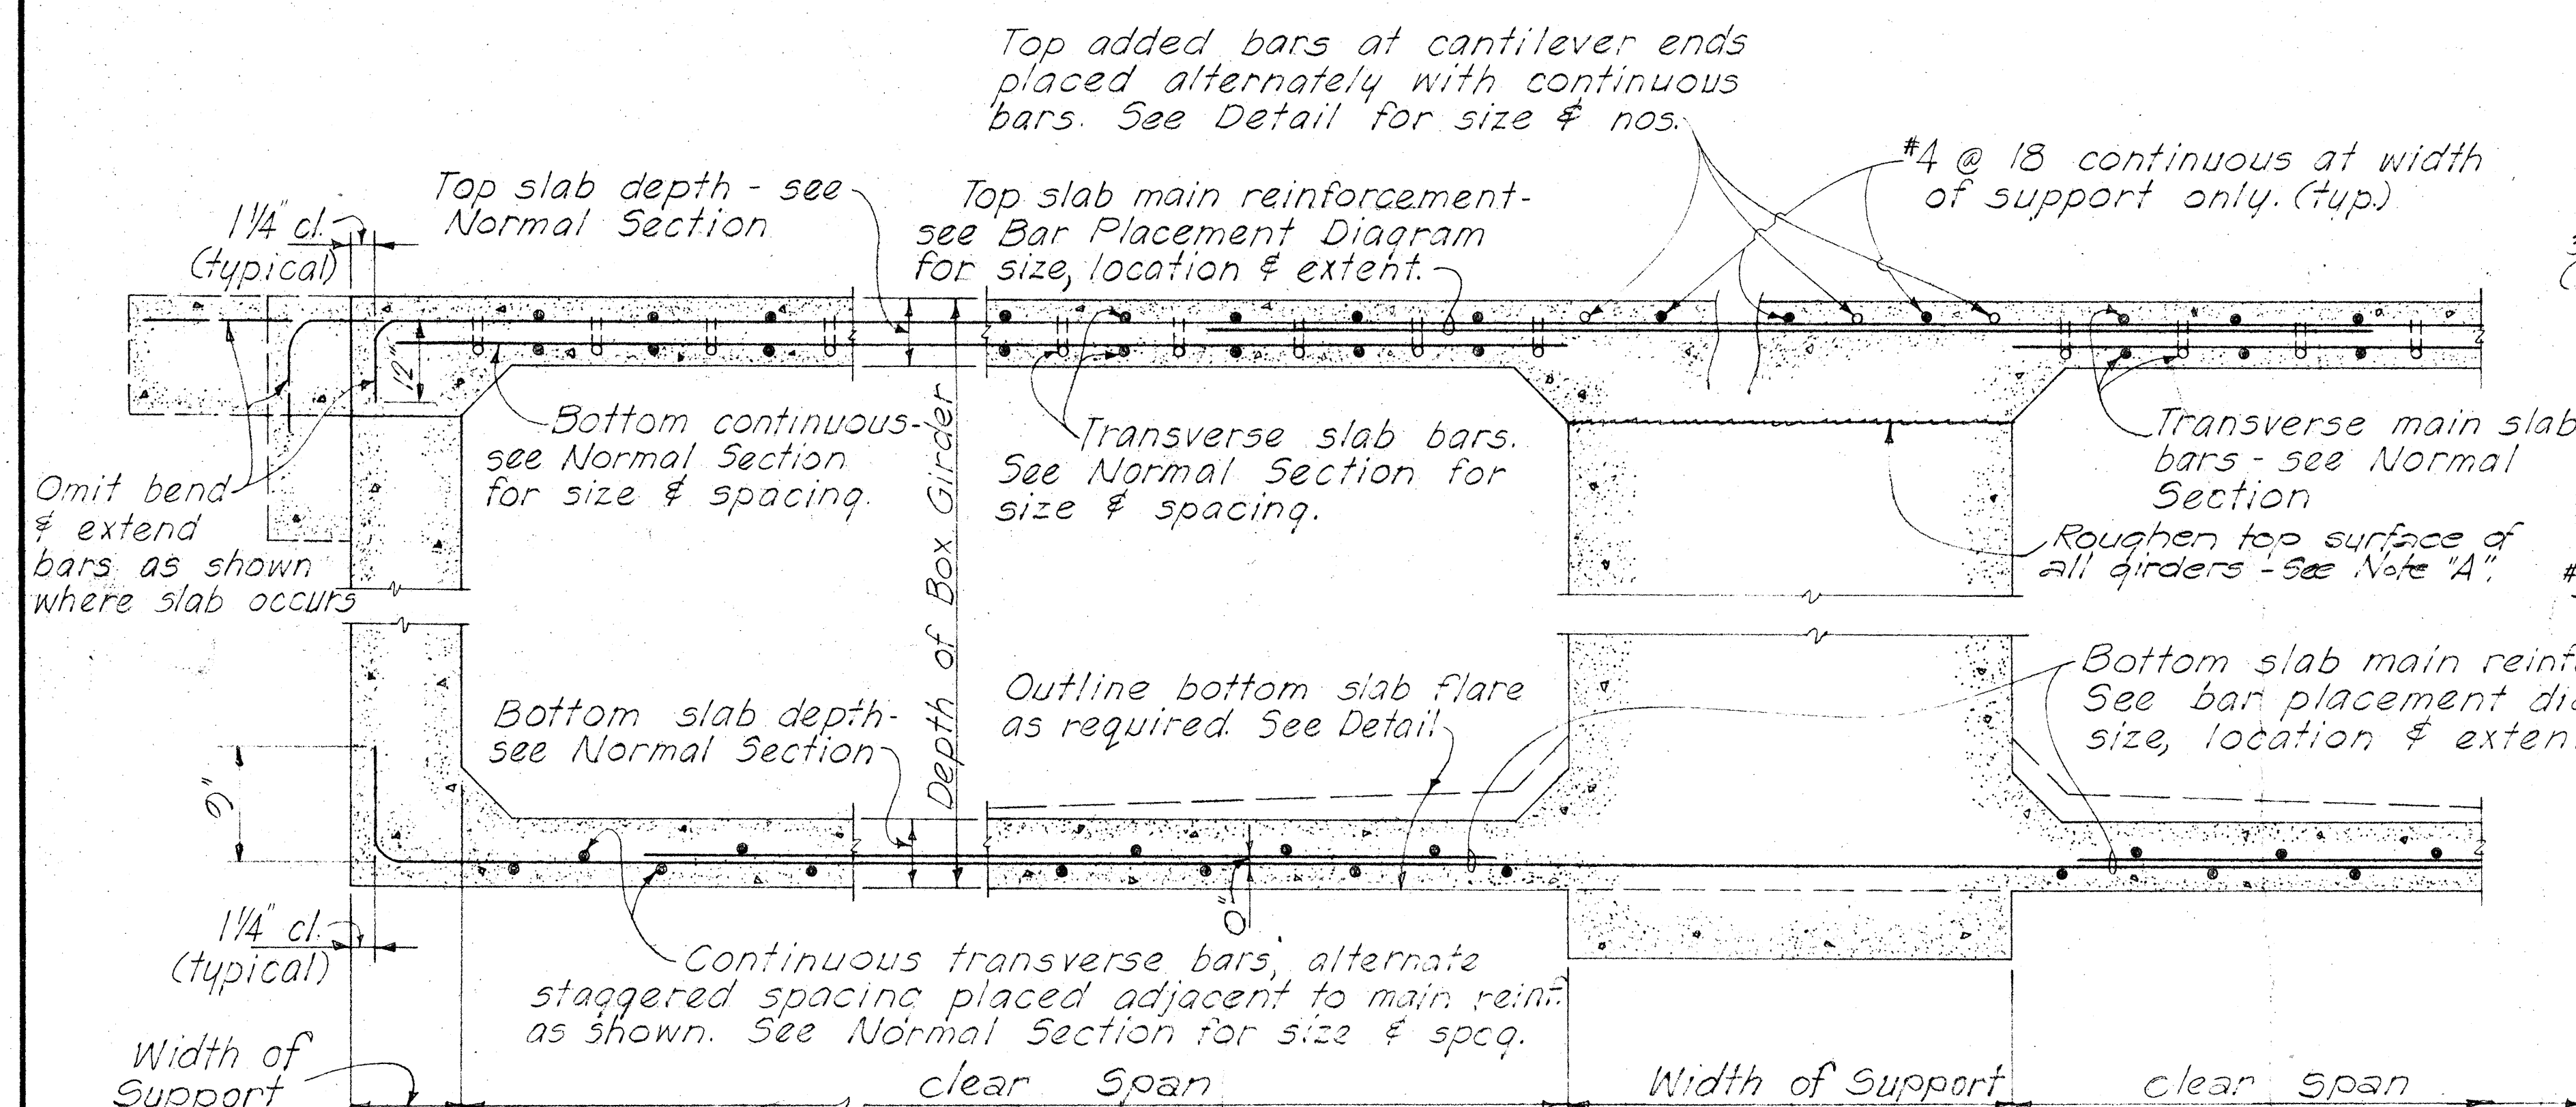

EXTERIOR GIRDER INTERIOR GIRDER
TYPICAL NORMAL BOX GIRDER SECTION

AT NON-CONTINUOUS END

AT CONTINUOUS SUPPORT

TYPICAL LONGITUDINAL DECK SECTION
ALONG GIRDER AT NORMAL OR RADIAL SUPPORTS

Note "A" The entire surface of the joint shall be thoroughly cleaned of surface laitance, curing compound, and other material foreign to the concrete and clean aggregate be exposed by abrasive blast cleaning after the curing period or immediately before placing concrete at the joint.

NO.	REVISION	APPROVED BY	DATE

APPROVAL RECOMMENDED
Paul T. Yamashita
BRIDGE DESIGN ENGINEER

1-23-76
DATE

APPROVED *Paul T. Vamachita*
 For ASSISTANT CHIEF, ENGINEERING

1-28-76
DATE

STATE OF HAWAII
DEPARTMENT OF TRANSPORTATION
HIGHWAYS DIVISION

STANDARD DETAILS CONCRETE BOX GIRDER

Date _____

SHEET No. 5-3 OF 5-8 SHEETS DB-101-2

AS BUILT

85	S	8
----	---	---

[illegible]

Depth "T"	"a"
4'-11" & smaller	1'-9"
5'-0" to 5'-11"	2'-0"
6'-0" to 6'-11"	2'-3"
7'-0" & greater	3'-0"

2-#5 x 3'-0" lg.
 top & bottom
 added @ each
 corner.

2'-6"
 2'-6"
 2'-6"

Girder
 Span
 Girder

8-#4 truss bars
 4 ea. side of opening,
 placed between cont.
 bars. See Section

Top & bott. cont.
 slab bars. Lap
 as shown. See
 Section

Note: Final location of opening shall be determined by the Engineer. Form removal opening may extend from edge of deck to edge of deck with approval of the Engineer. Lap small longitudinal deck bars as shown on Section 

[illegible]

Diagram illustrating a continuous construction joint key in a slab. The joint is 2'-6" x 2'-6" opening. The top of the slab is shown. The joint key is 2" wide. The hatched area is to be poured after form removal. The top & bottom continuous bars are shown. The lap deck bars (main girder bars) are continuous.

SECTION

Note: Form removal opening at top slab shall not be located where main girder bars occur.

2'-6" x 2'-6"

opening

Continuous construction joint key (See Detail)

Top & bottom continuous bars (lap not shown)

#4 truss bars 1'-6" 1'-6" each side (See Plan)

SECTION

BRIDGE DESIGN ENGINEER _____ DATE _____

ASSISTANT CHIEF, ENGINEERING DATE

STATE OF HAWAII
DEPARTMENT OF TRANSPORTATION
HIGHWAYS DIVISION


STANDARD DETAILS
CONCRETE BOX GIRDER

Date

SHEET No. 54 OF 58 SHEETS DB-101-3

AS BUILT

85-S-9

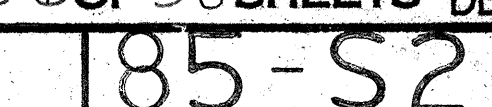

END ELEVATION

TYPICAL RAIL POST DETAILS

SCALE: 3" = 1'-0"

SECTION $\left(\frac{C}{2} \right)$

SCALE: 3" = 1'-0"




SECTION 

SCALE: 3" = 1' - 0"

SECTION $\frac{A}{2}$

SCALE: 3" = 1'-0"

FED. ROAD DIST. NO.	STATE	FED. AID PROJ. NO.	FISCAL YEAR	SHEET NO.	TOTAL SHEETS
HAWAII	HAW.				

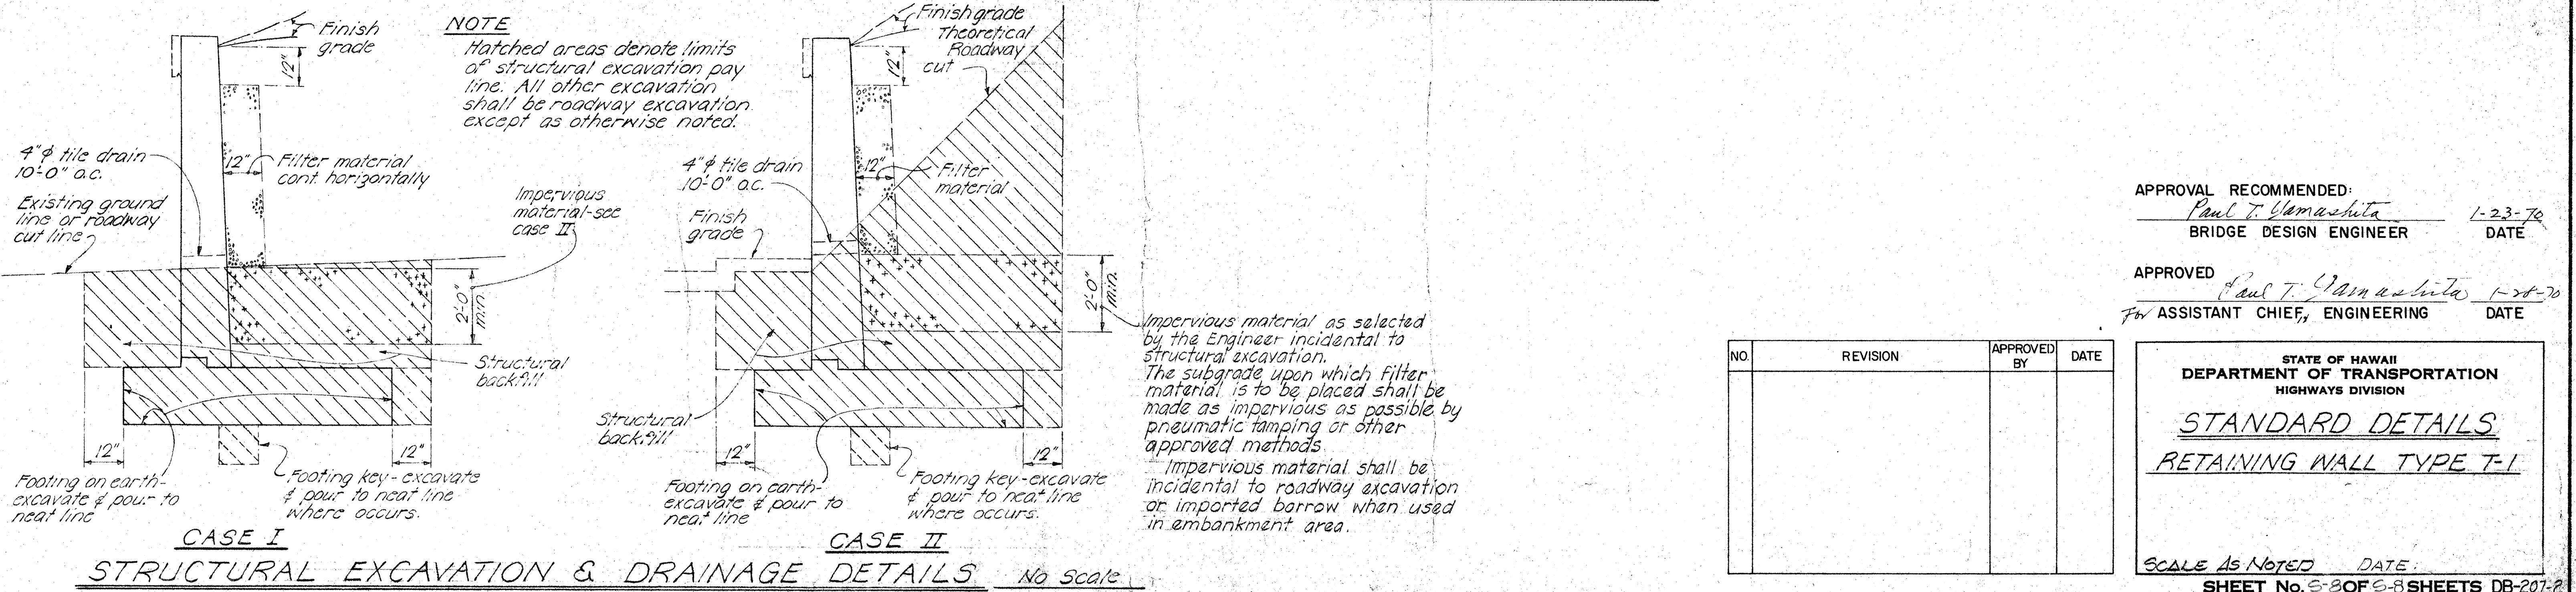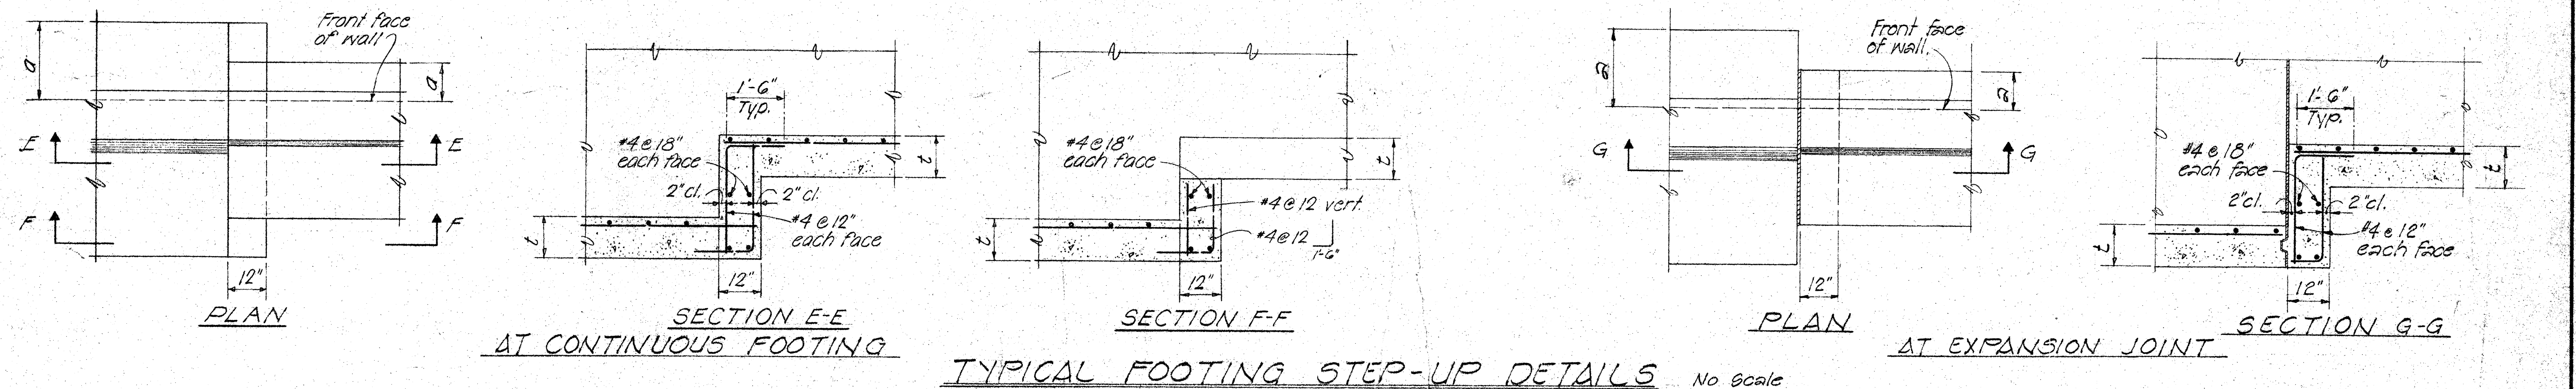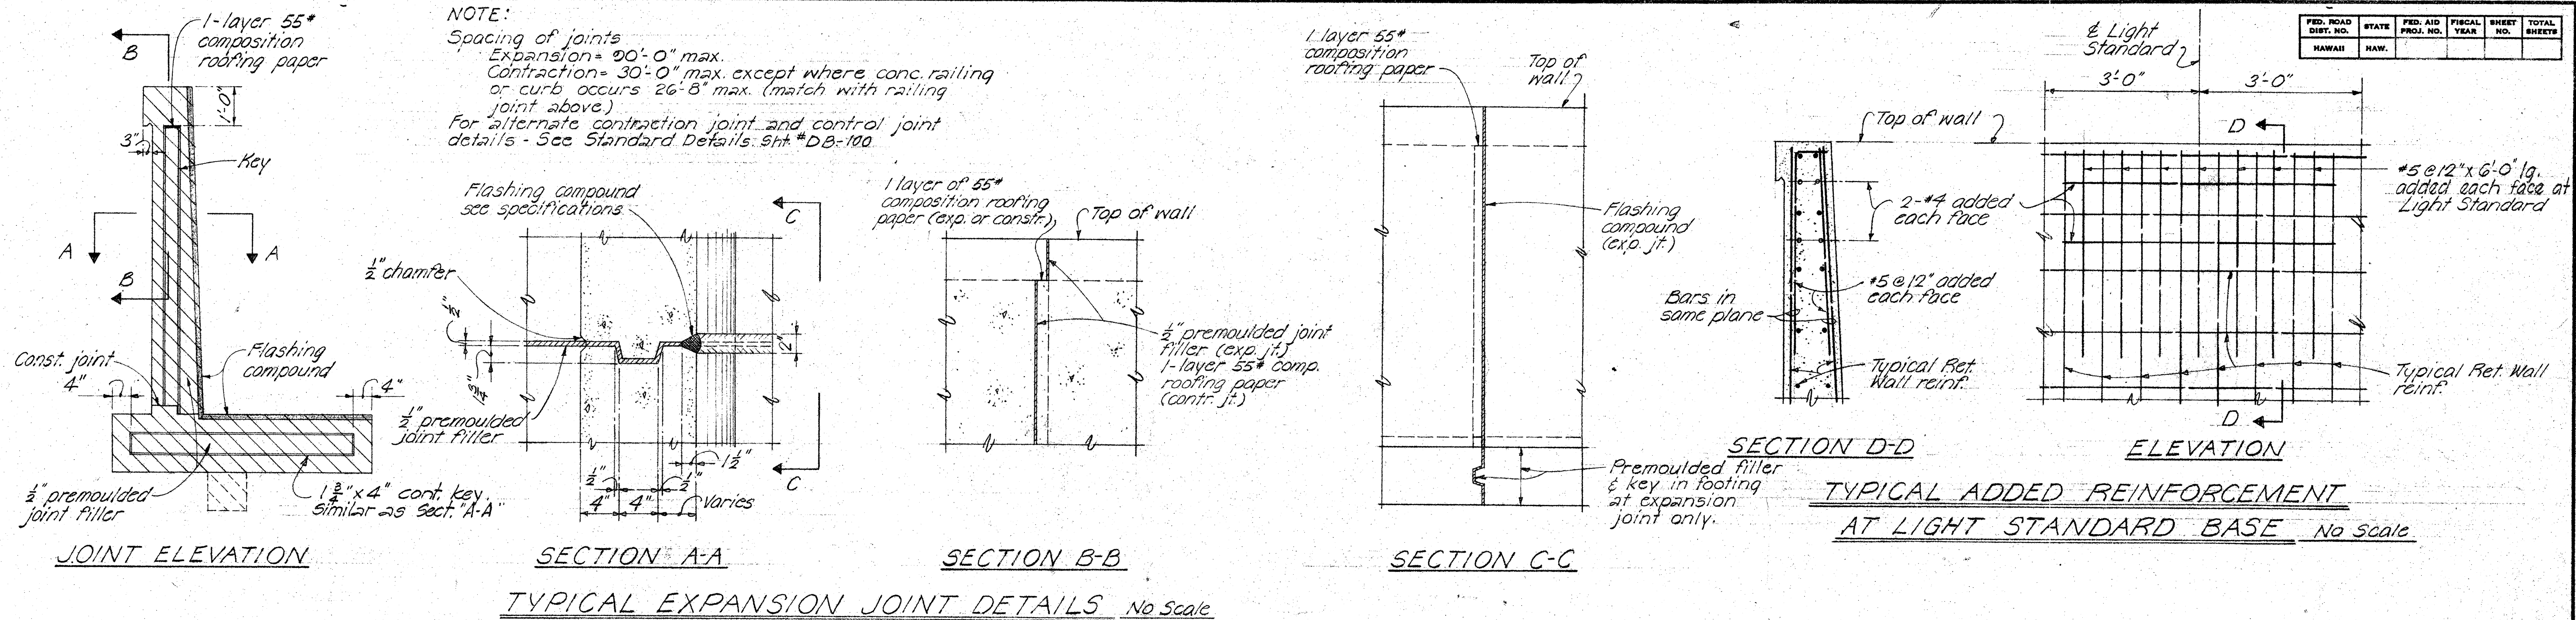

APPROVAL RECOMMENDED:
 Paul T. Yamashita
 BRIDGE DESIGN ENGINEER 1-23-70 DATE

APPROVED
 Paul T. Yamashita
 For ASSISTANT CHIEF, ENGINEERING 1-24-70 DATE

NO.	REVISION	APPROVED BY	DATE

STATE OF HAWAII
 DEPARTMENT OF TRANSPORTATION
 HIGHWAYS DIVISION
STANDARD DETAILS
RETAINING WALL TYPE T-1
 SCALE AS NOTED DATE
 SHEET No. 58 OF 98 SHEETS DB-207-2

DATE	
SURVEY PLOTTED BY	
DRAWN BY	
CHECKED BY	
ORIGINAL PLAN	
NOTE BOOK	
NO.	