

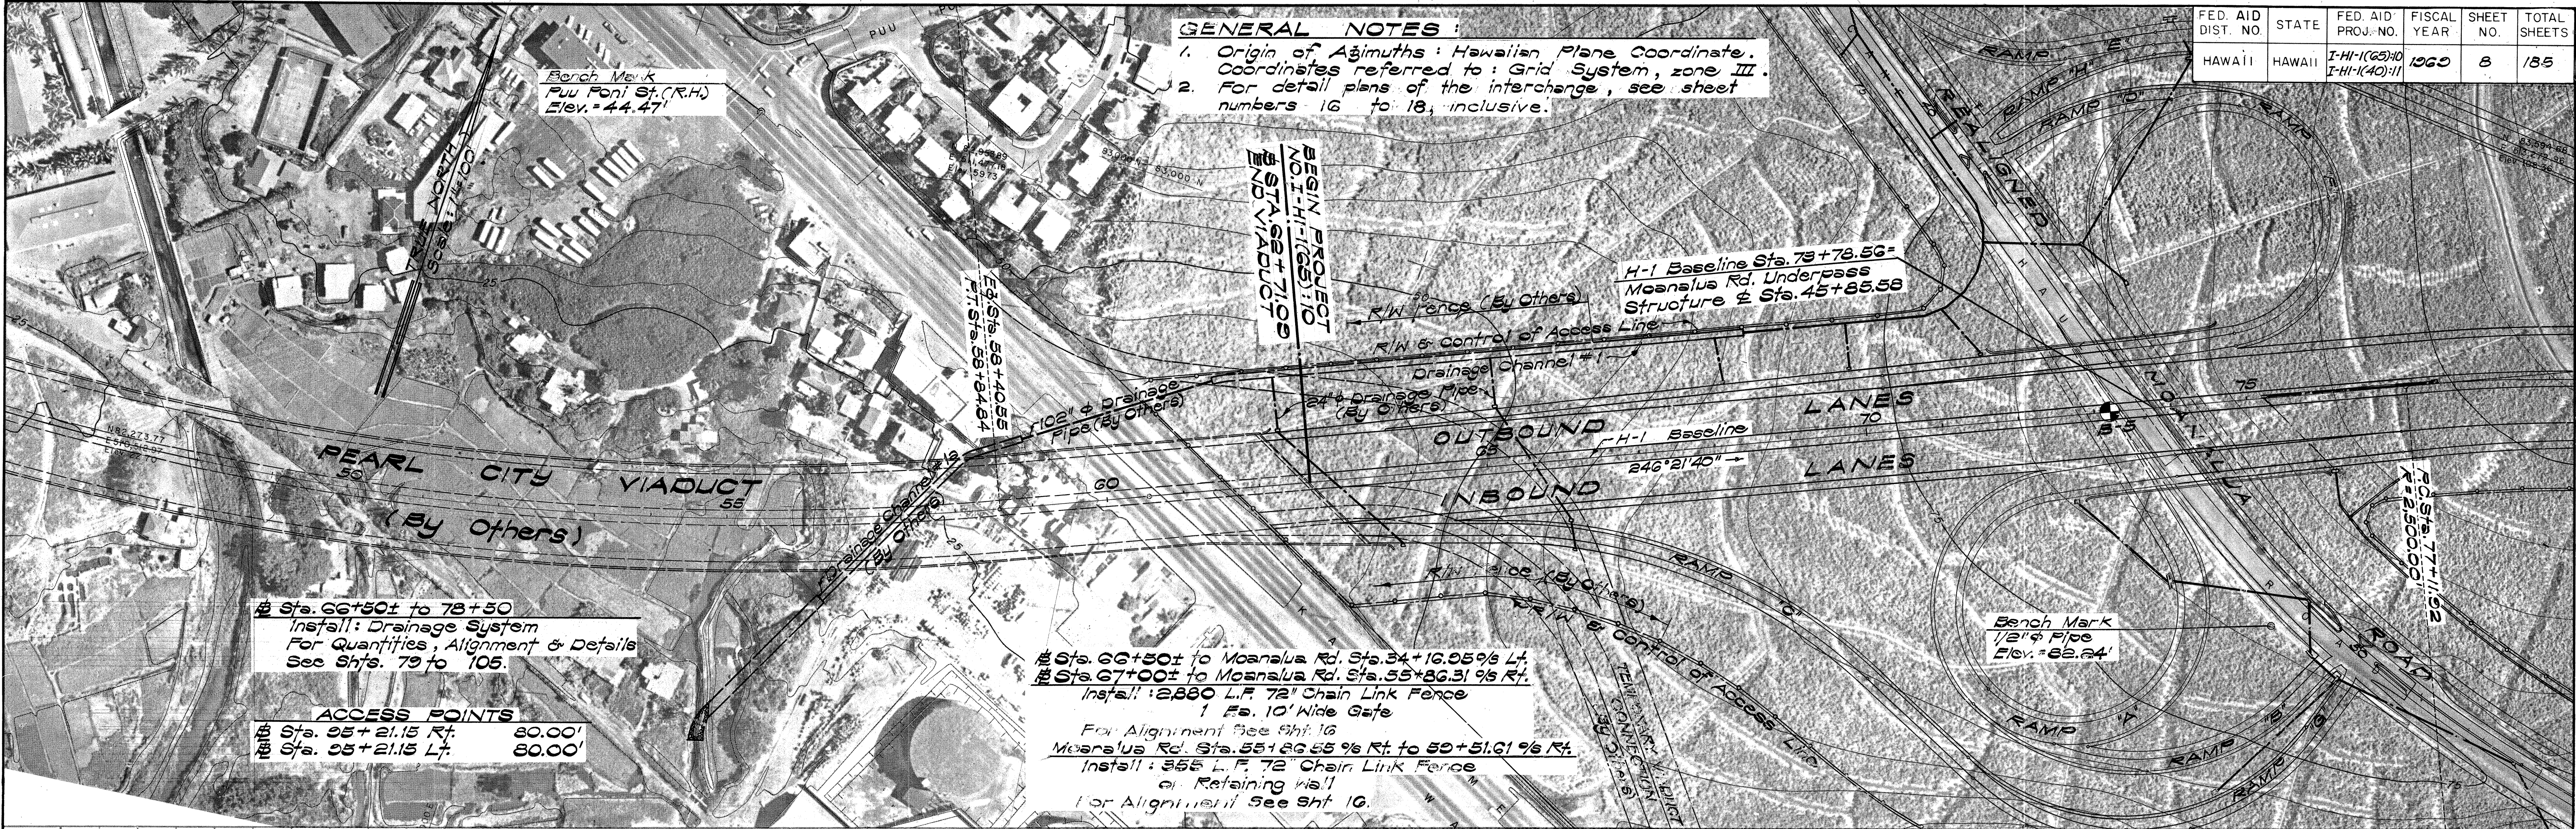


PLAN	SURVEYED	DATE
NOTE BOOK	BY	
NO.		

PROFILE	SURVEYED	DATE
NOTE BOOK	BY	
NO.		

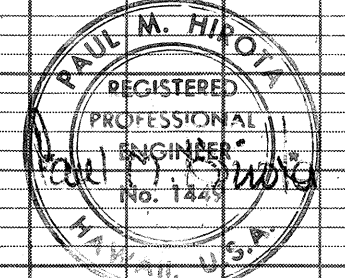


FED. AID DIST. NO.	STATE	FED. AID PROJ. NO.	FISCAL YEAR	SHEET NO.	TOTAL SHEETS
HAWAII	HAWAII	I-H-I (65) 110	1965	8	185

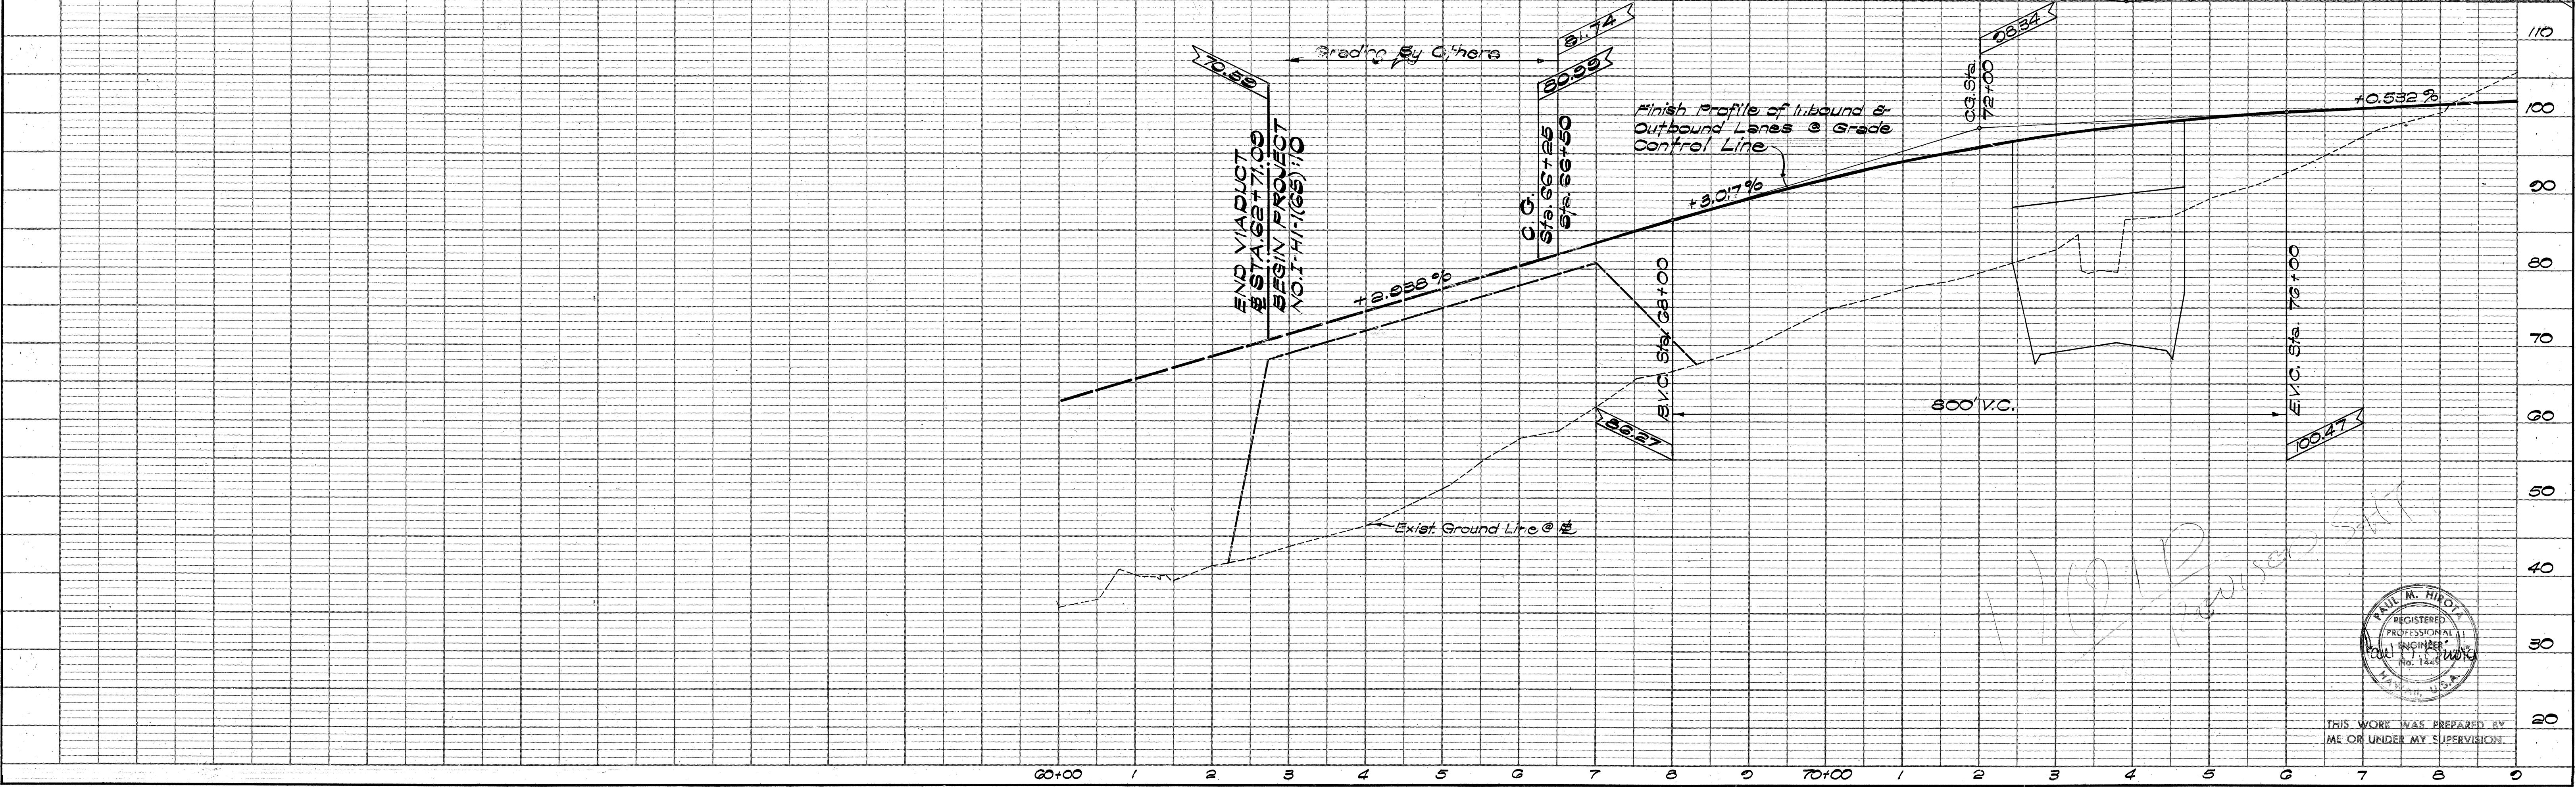


THIS WORK WAS PREPARED BY ME OR UNDER MY SUPERVISION.

PLAN	SURVEYED	DATE
	BY	
	PLOTTED	
	ALIGNMENT CHECKED	
	RT. OF WAY CHECKED	
	NO.	

PROFILE	SURVEYED	DATE
	BY	
	PLOTTED	
	NOTE BOOK & MS NOTED	
	STRUCTURE NOTATIONS CHK'D	
	NO.	

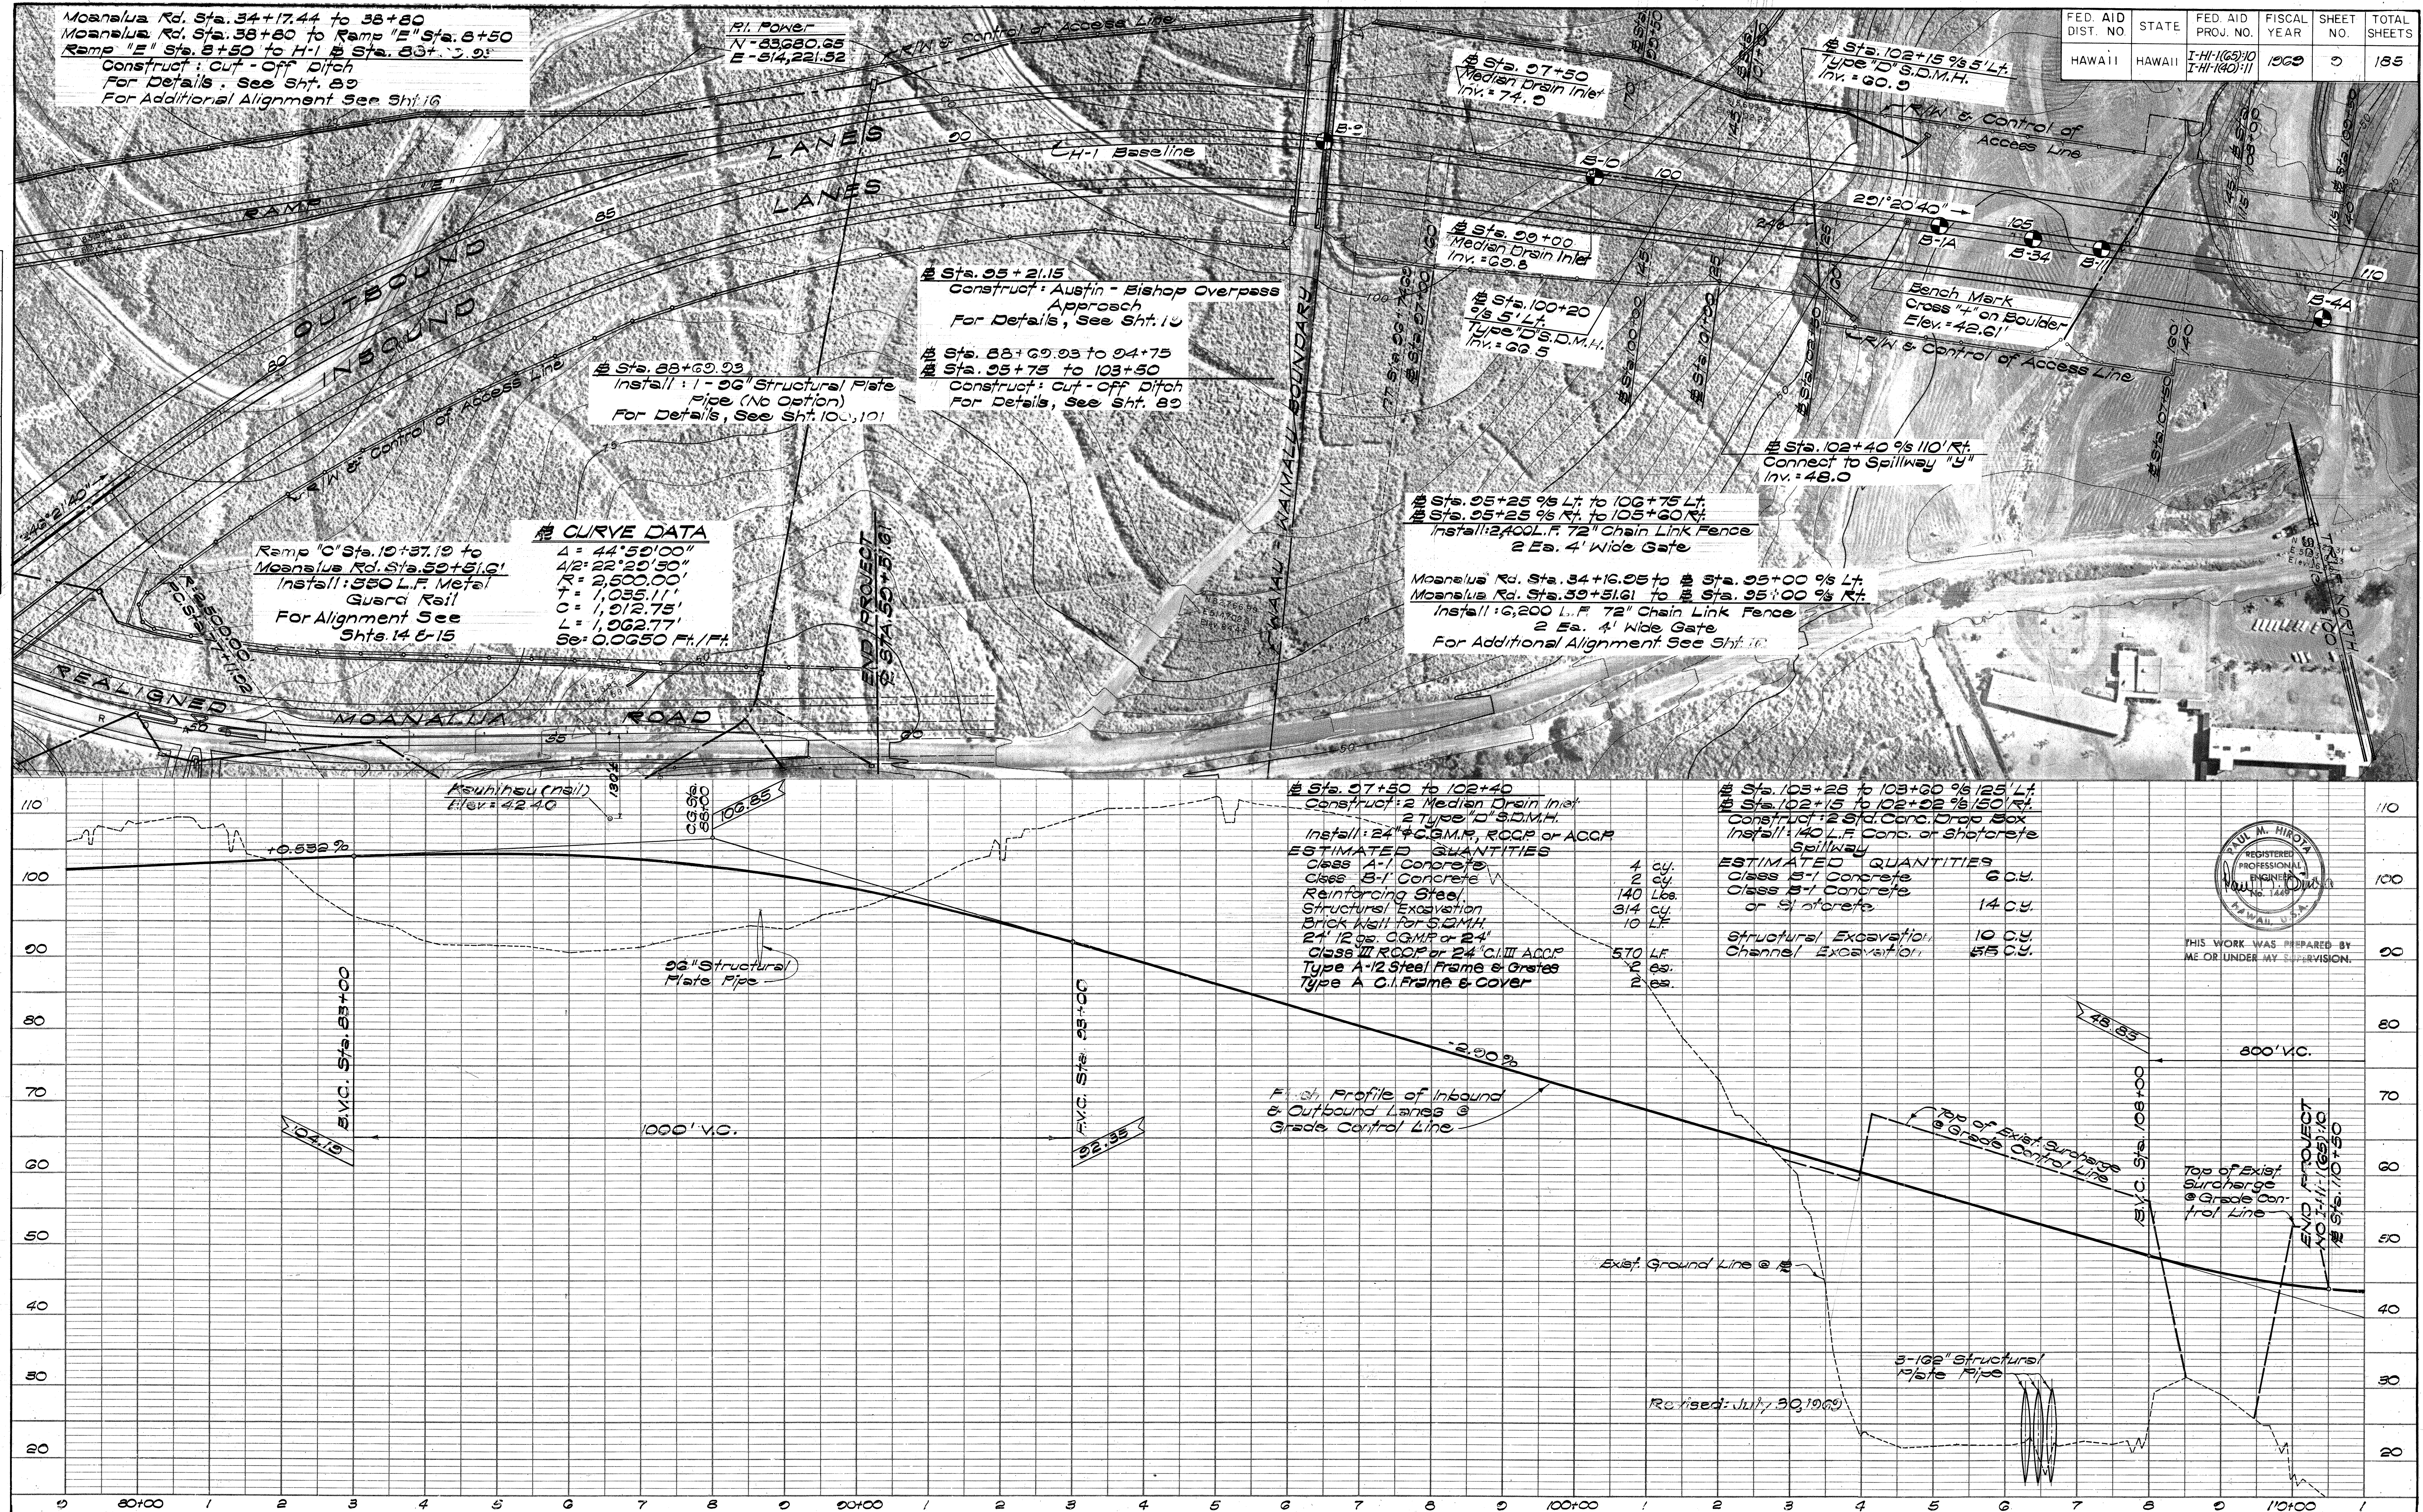

FED. AID DIST. NO.	STATE	FED. AID PROJ. NO.	FISCAL YEAR	SHEET NO.	TOTAL SHEETS
HAWAII	HAWAII	I-H-1(65)10 I-H-1(60)11	1969	9	185

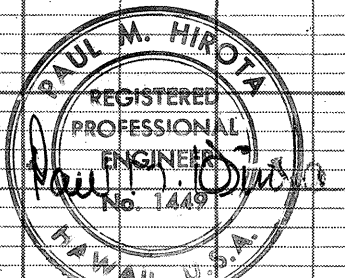

THIS WORK WAS PREPARED BY ME OR UNDER MY SUPERVISION.

