



FED. ROAD DIST. NO.	STATE	FED. AID PROJ. NO.	FISCAL YEAR	SHEET NO.	TOTAL SHEETS
HAWAII	HAW.	I-HI-1(65):10 I-HI-1(40):11	1969	20	185

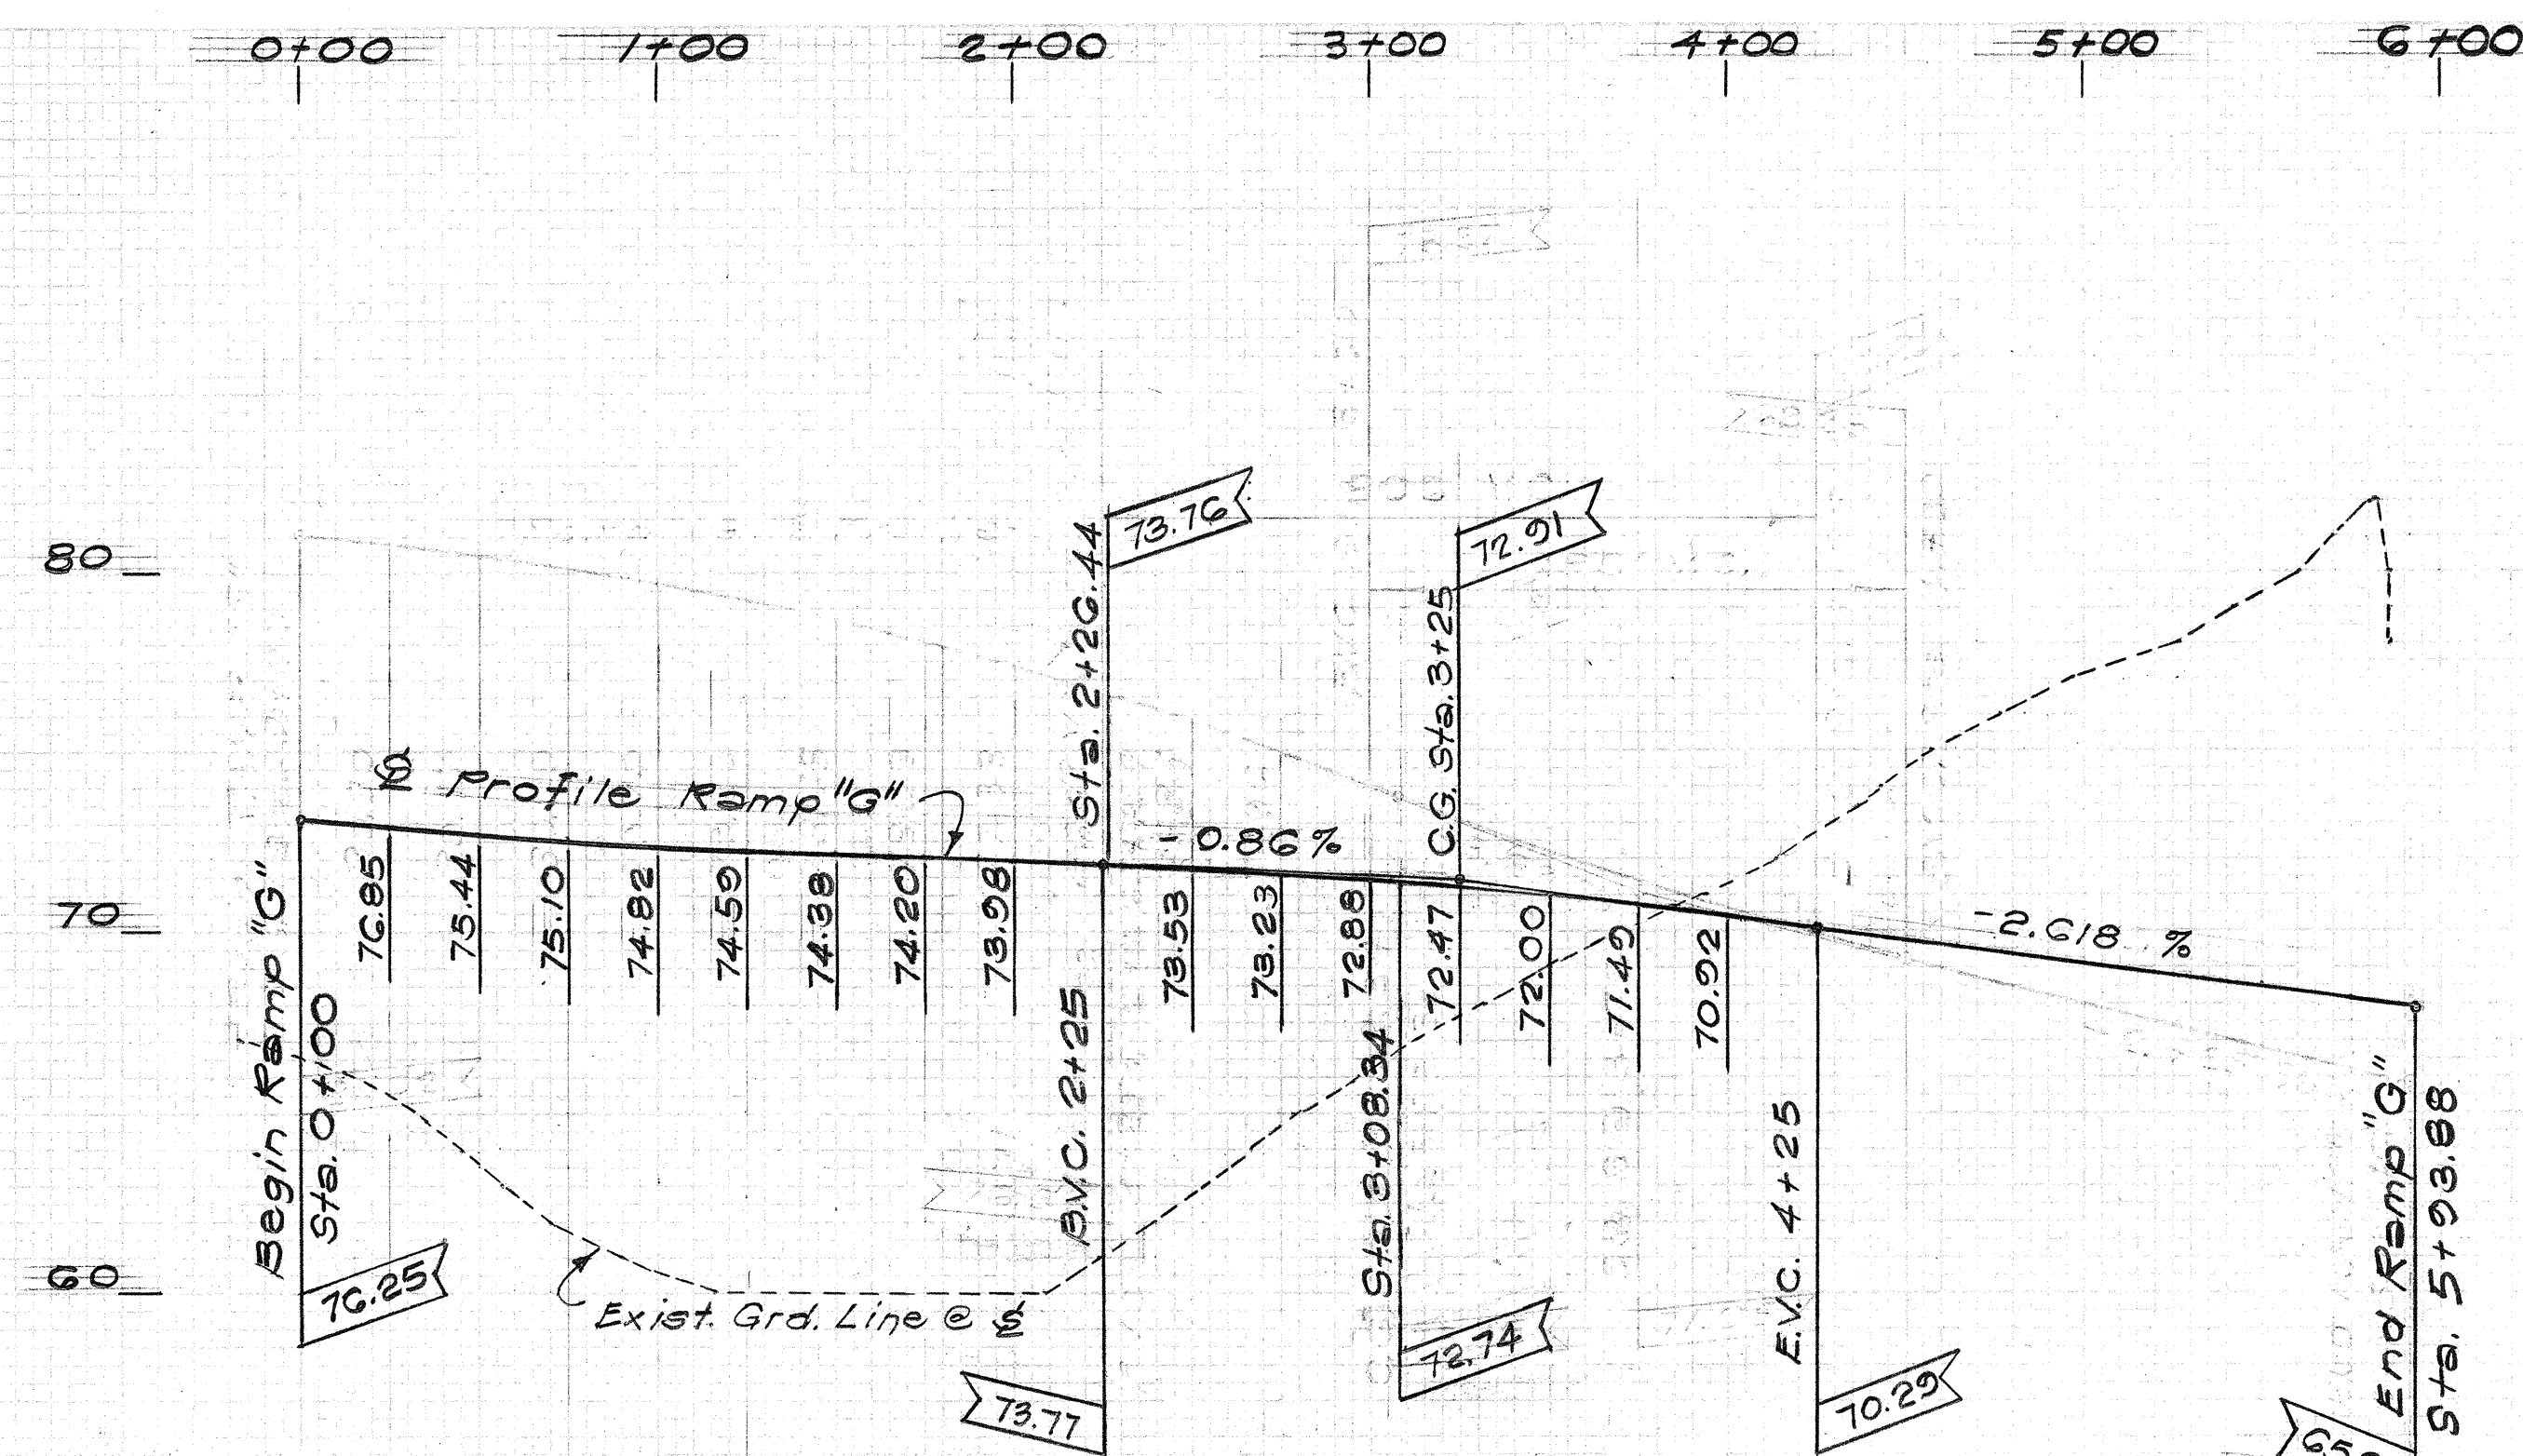


PROFILE RAMP "G"

Scale: Horizontal: 1" = 50'
Vertical: 1" = 5'

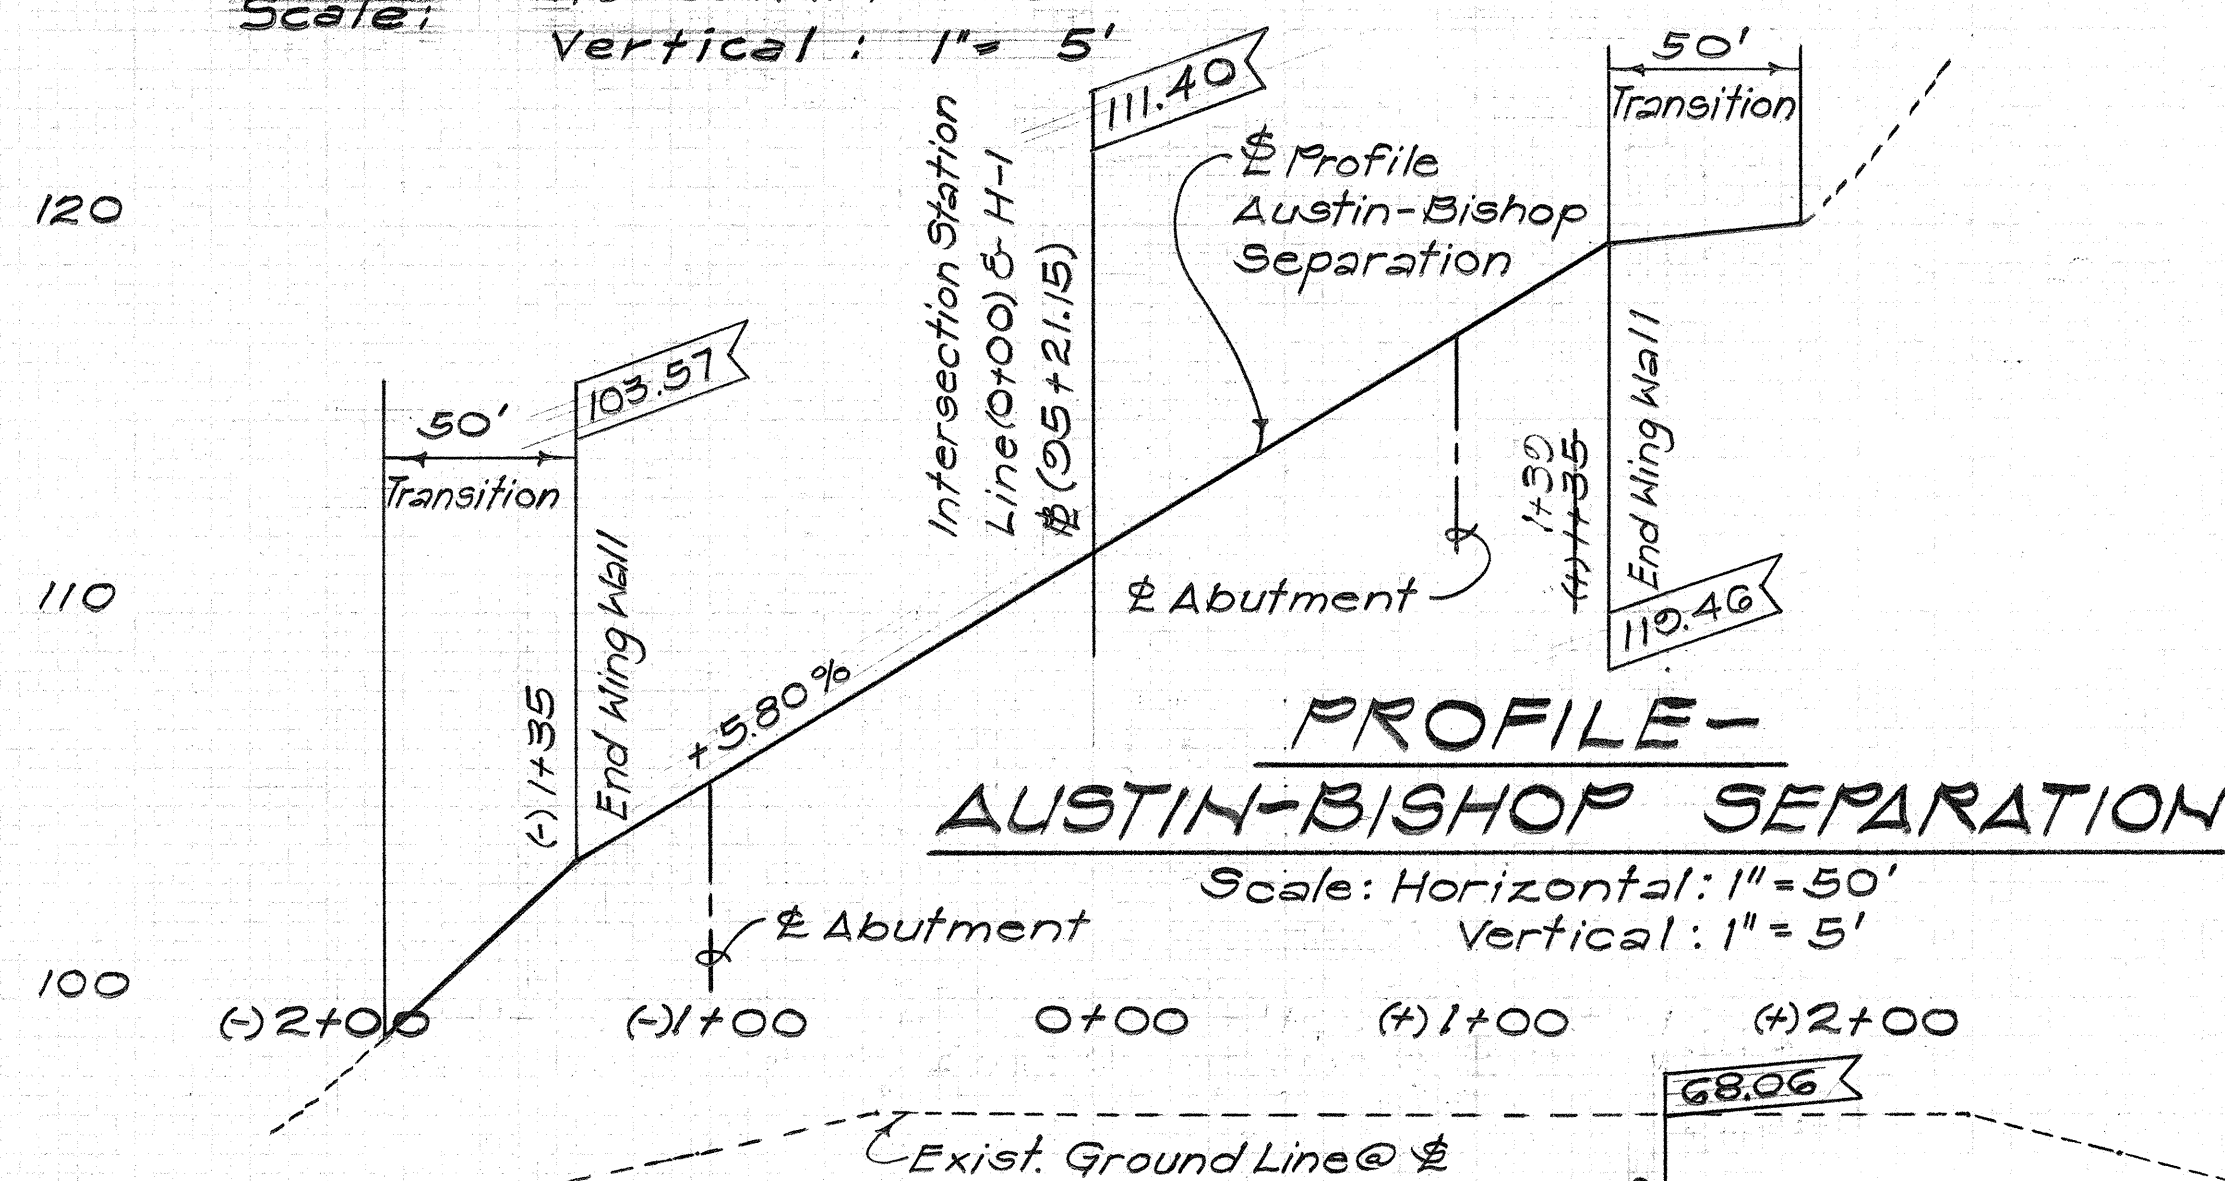



PROFILE-AUSTIN-BISHOP SEPARATION

Scale: Horizontal: 1" = 50'
Vertical: 1" = 5'

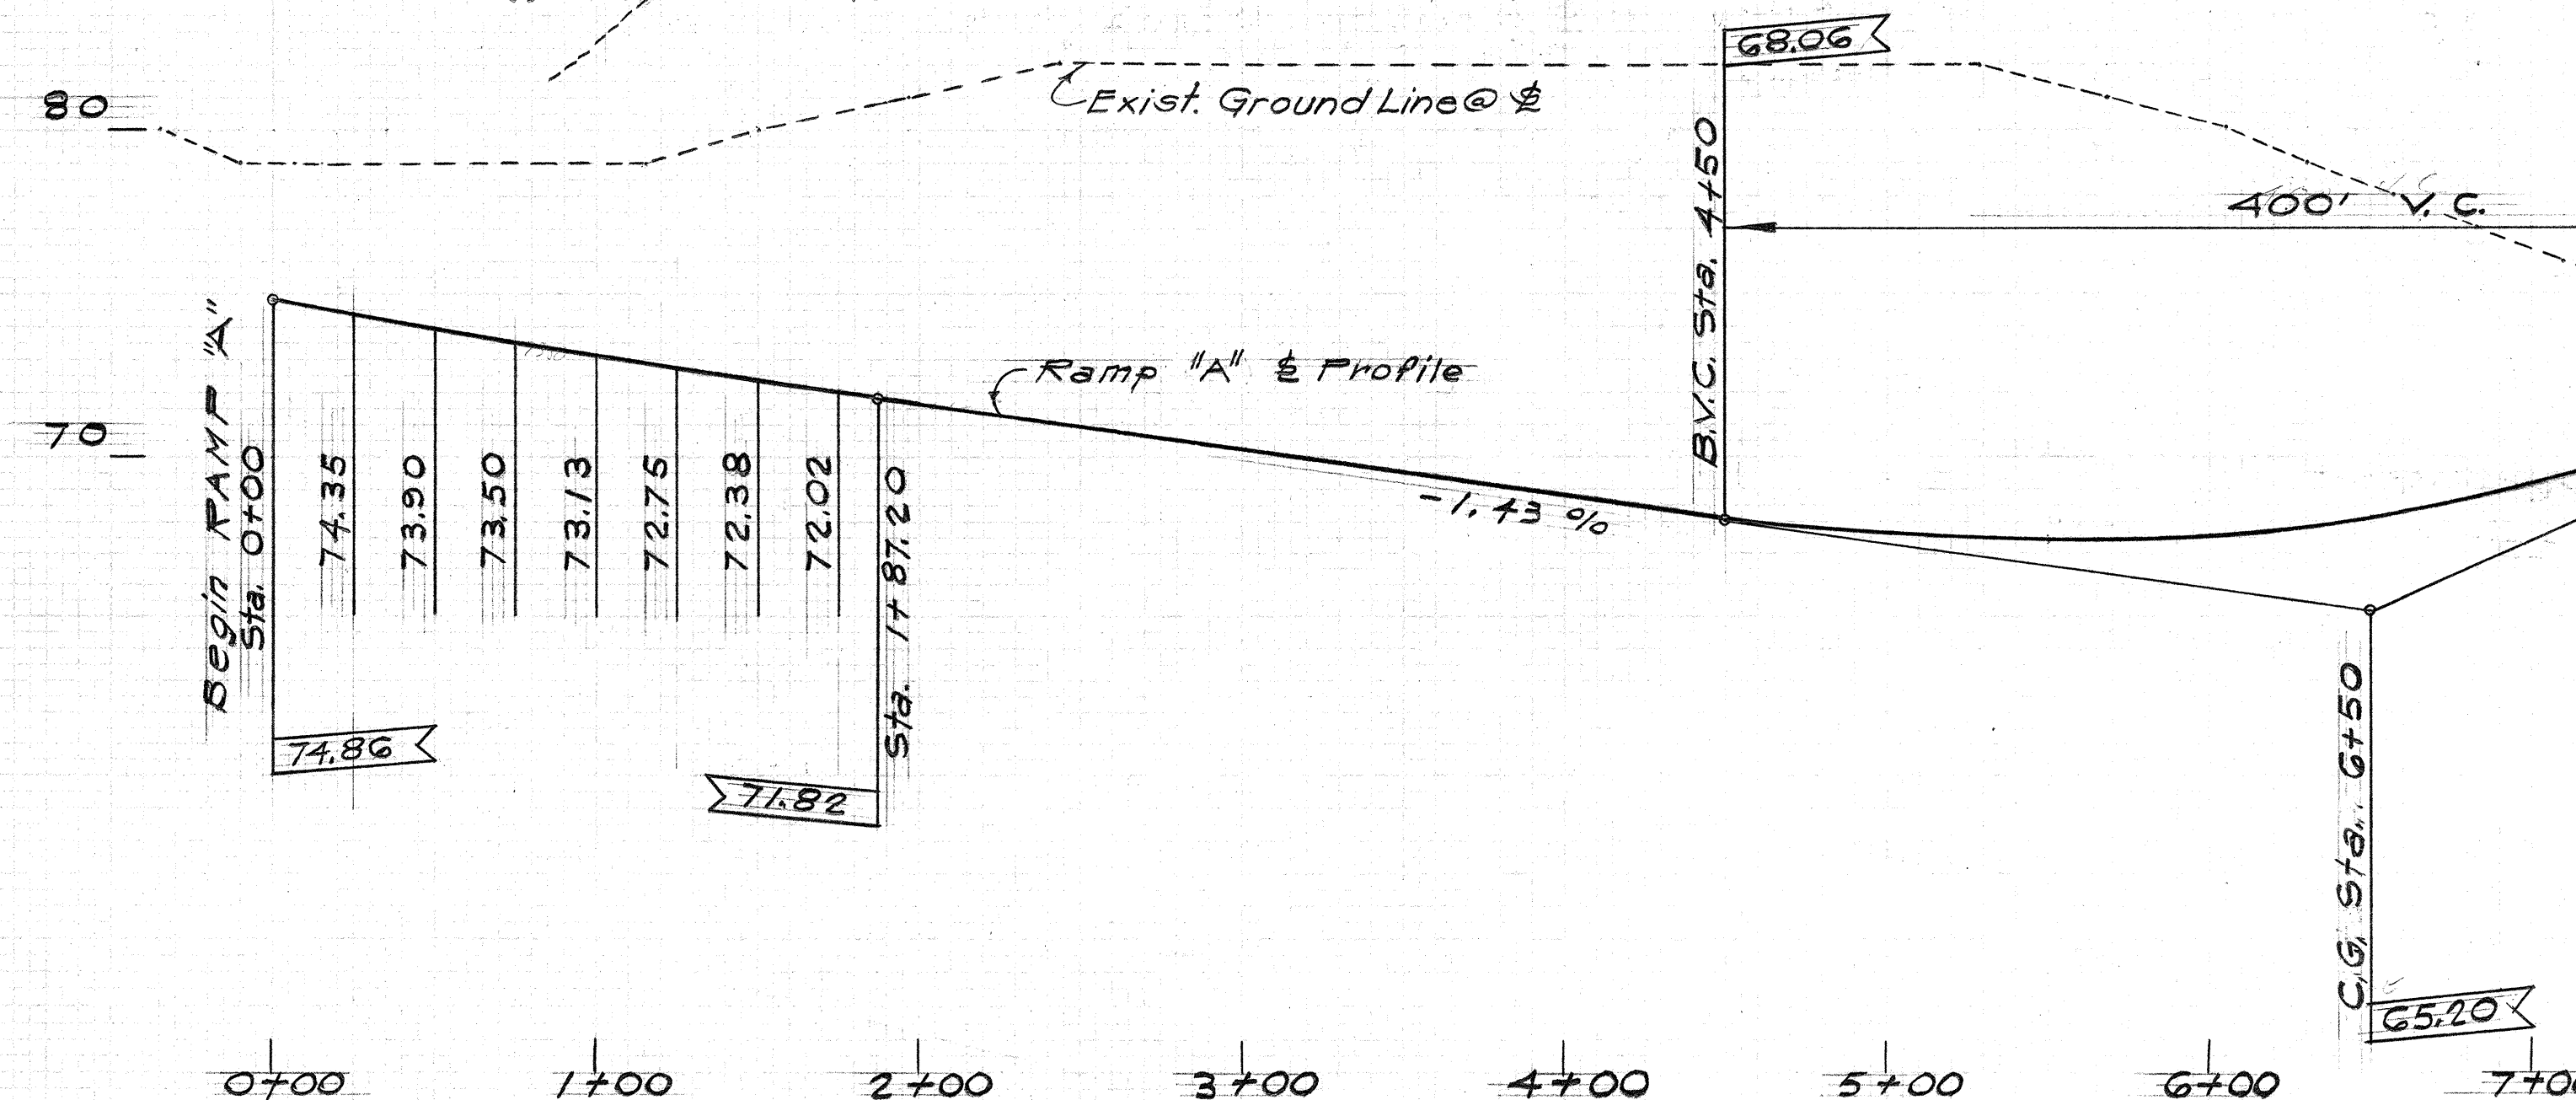

PROFILE RAMP "A"

Scale: Horizontal: 1" = 50'
Vertical: 1" = 5'

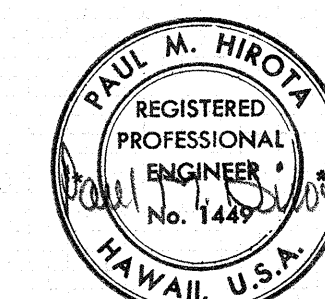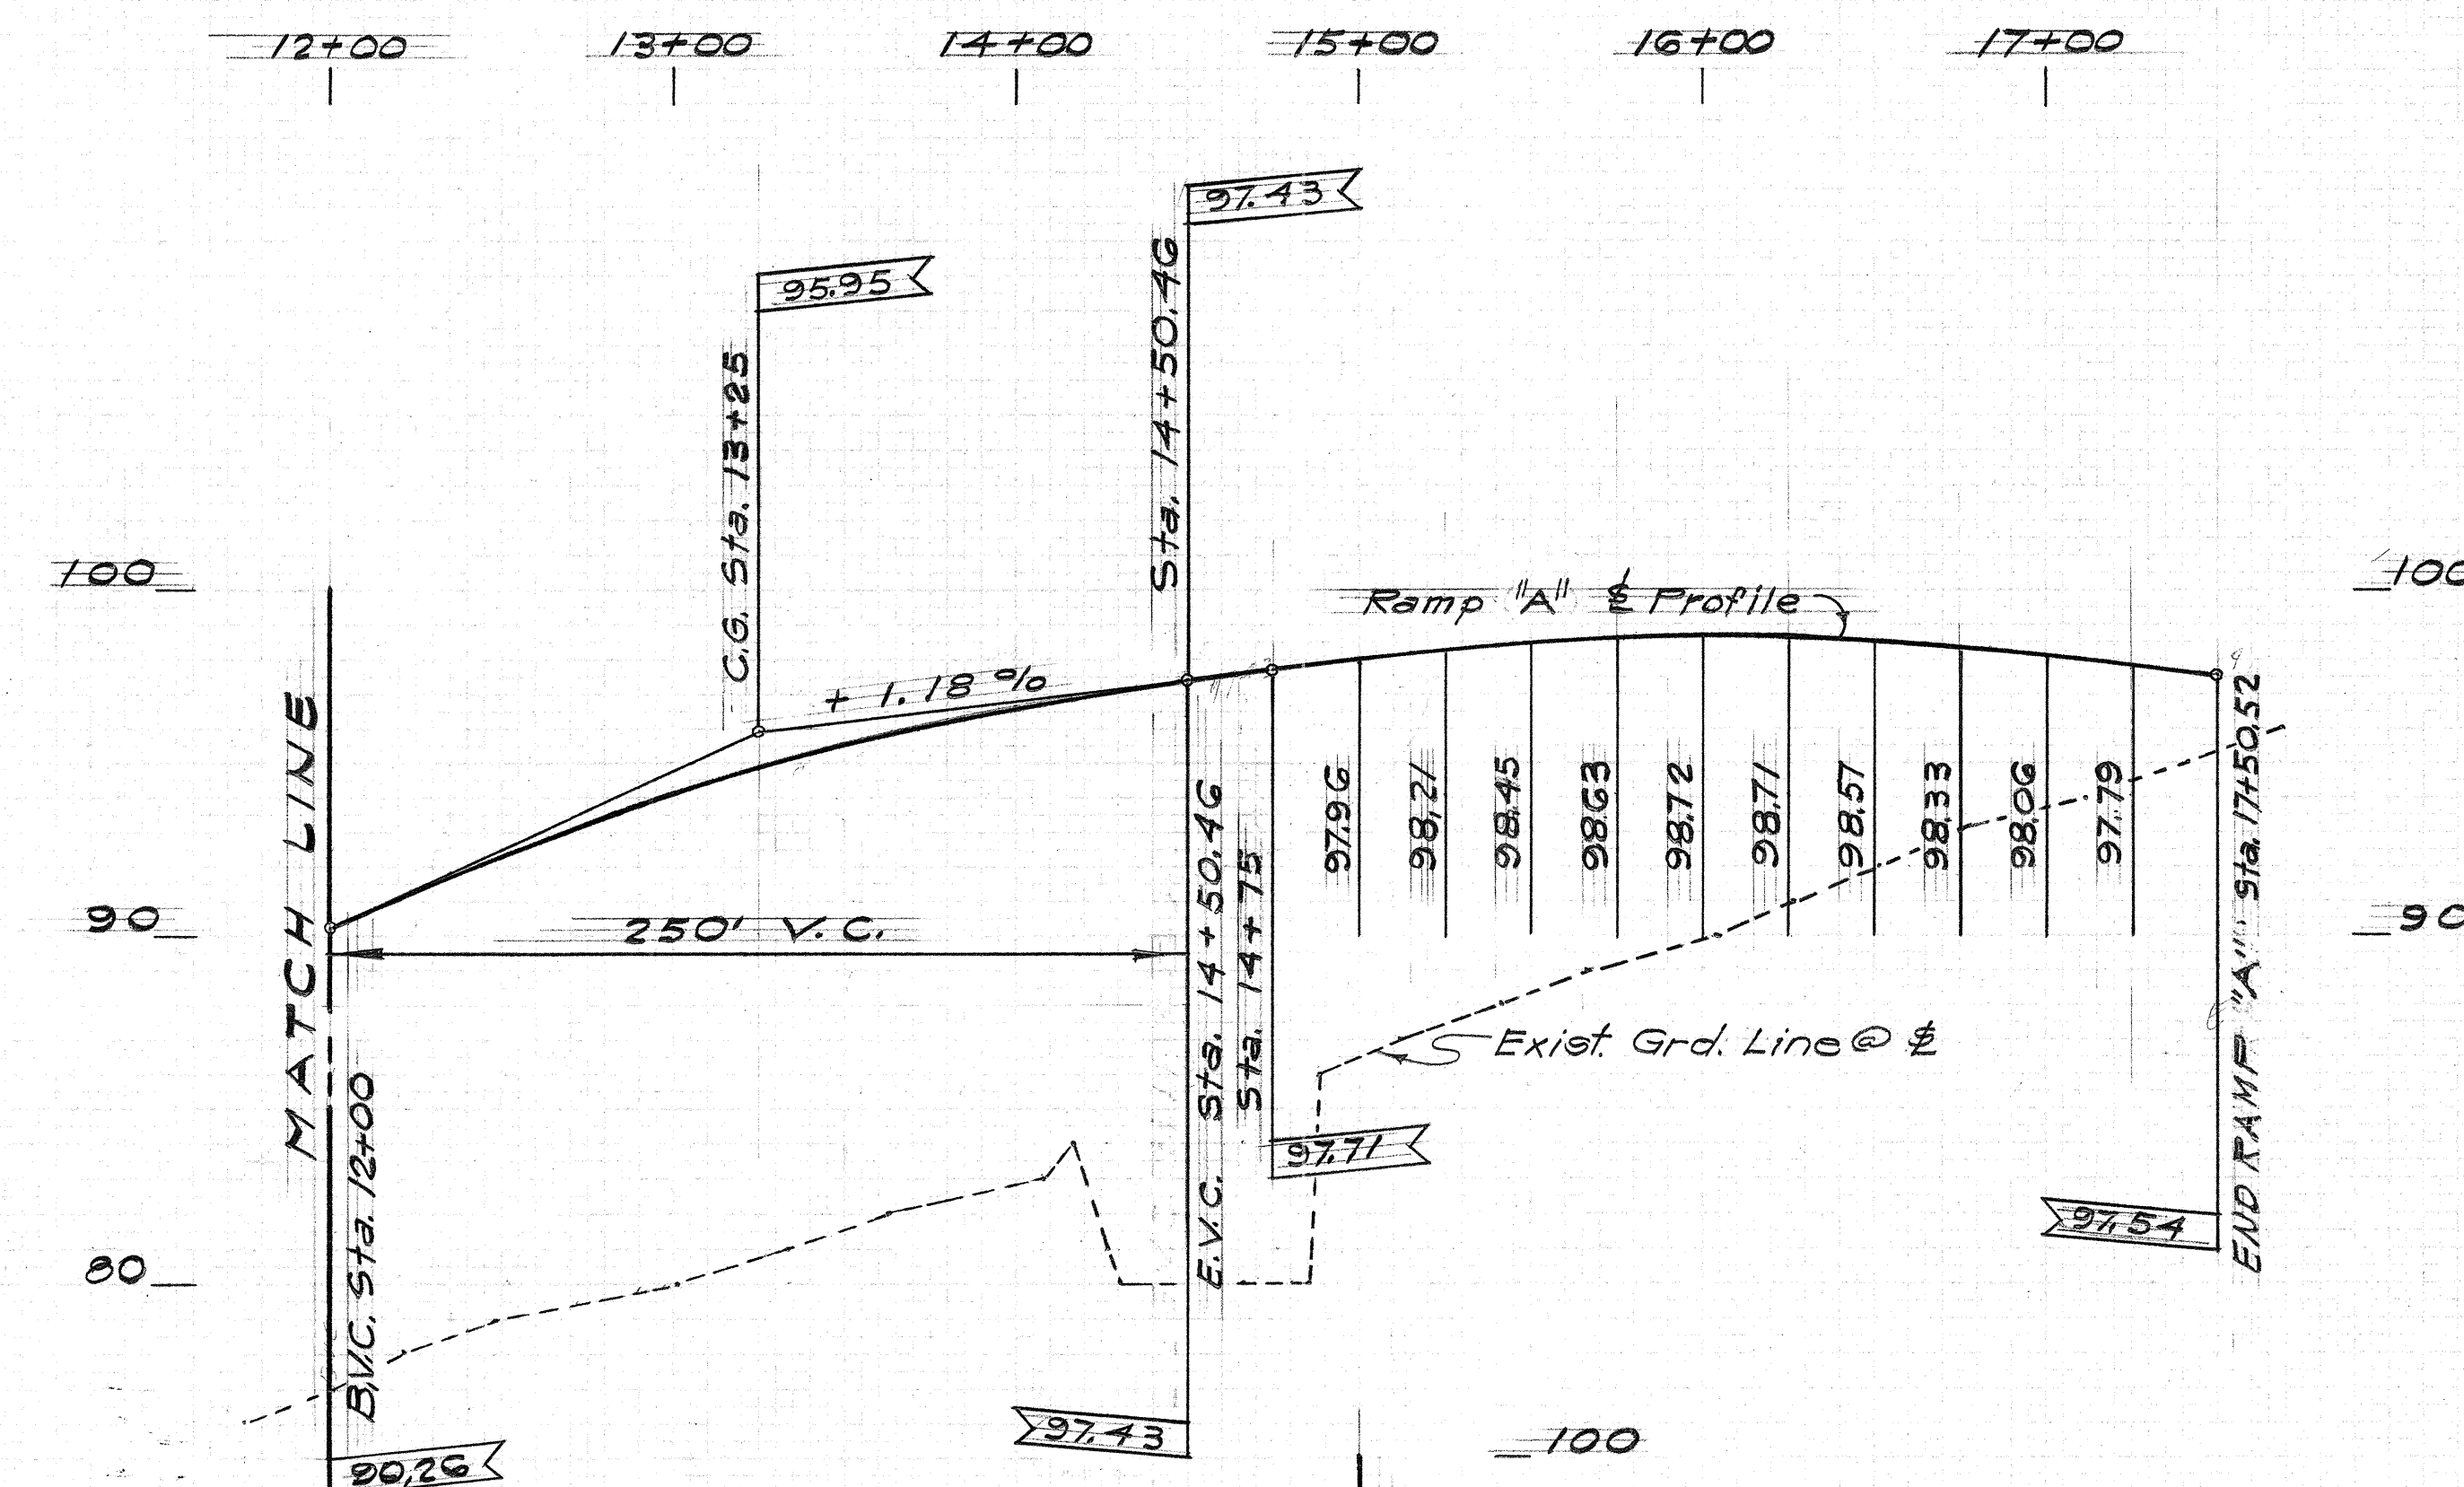

THIS WORK WAS PREPARED BY
ME OR UNDER MY SUPERVISION.

STATE OF HAWAII
DEPARTMENT OF TRANSPORTATION
HIGHWAYS DIVISION

RAMP PROFILES


INTERSTATE ROUTE H-1
PROJ. NO. I-HI-1(65):10

Scale: As Shown Date: 4-24-69


SHEET No. 1 OF 3 SHEETS

2 (1)

FED. ROAD DIST. NO.	STATE	FED. AID PROJ. NO.	FISCAL YEAR	SHEET NO.	TOTAL SHEETS
HAWAII	HAW.	I-HI-1(65)10 I-HI-1(40)10	1969	21	185

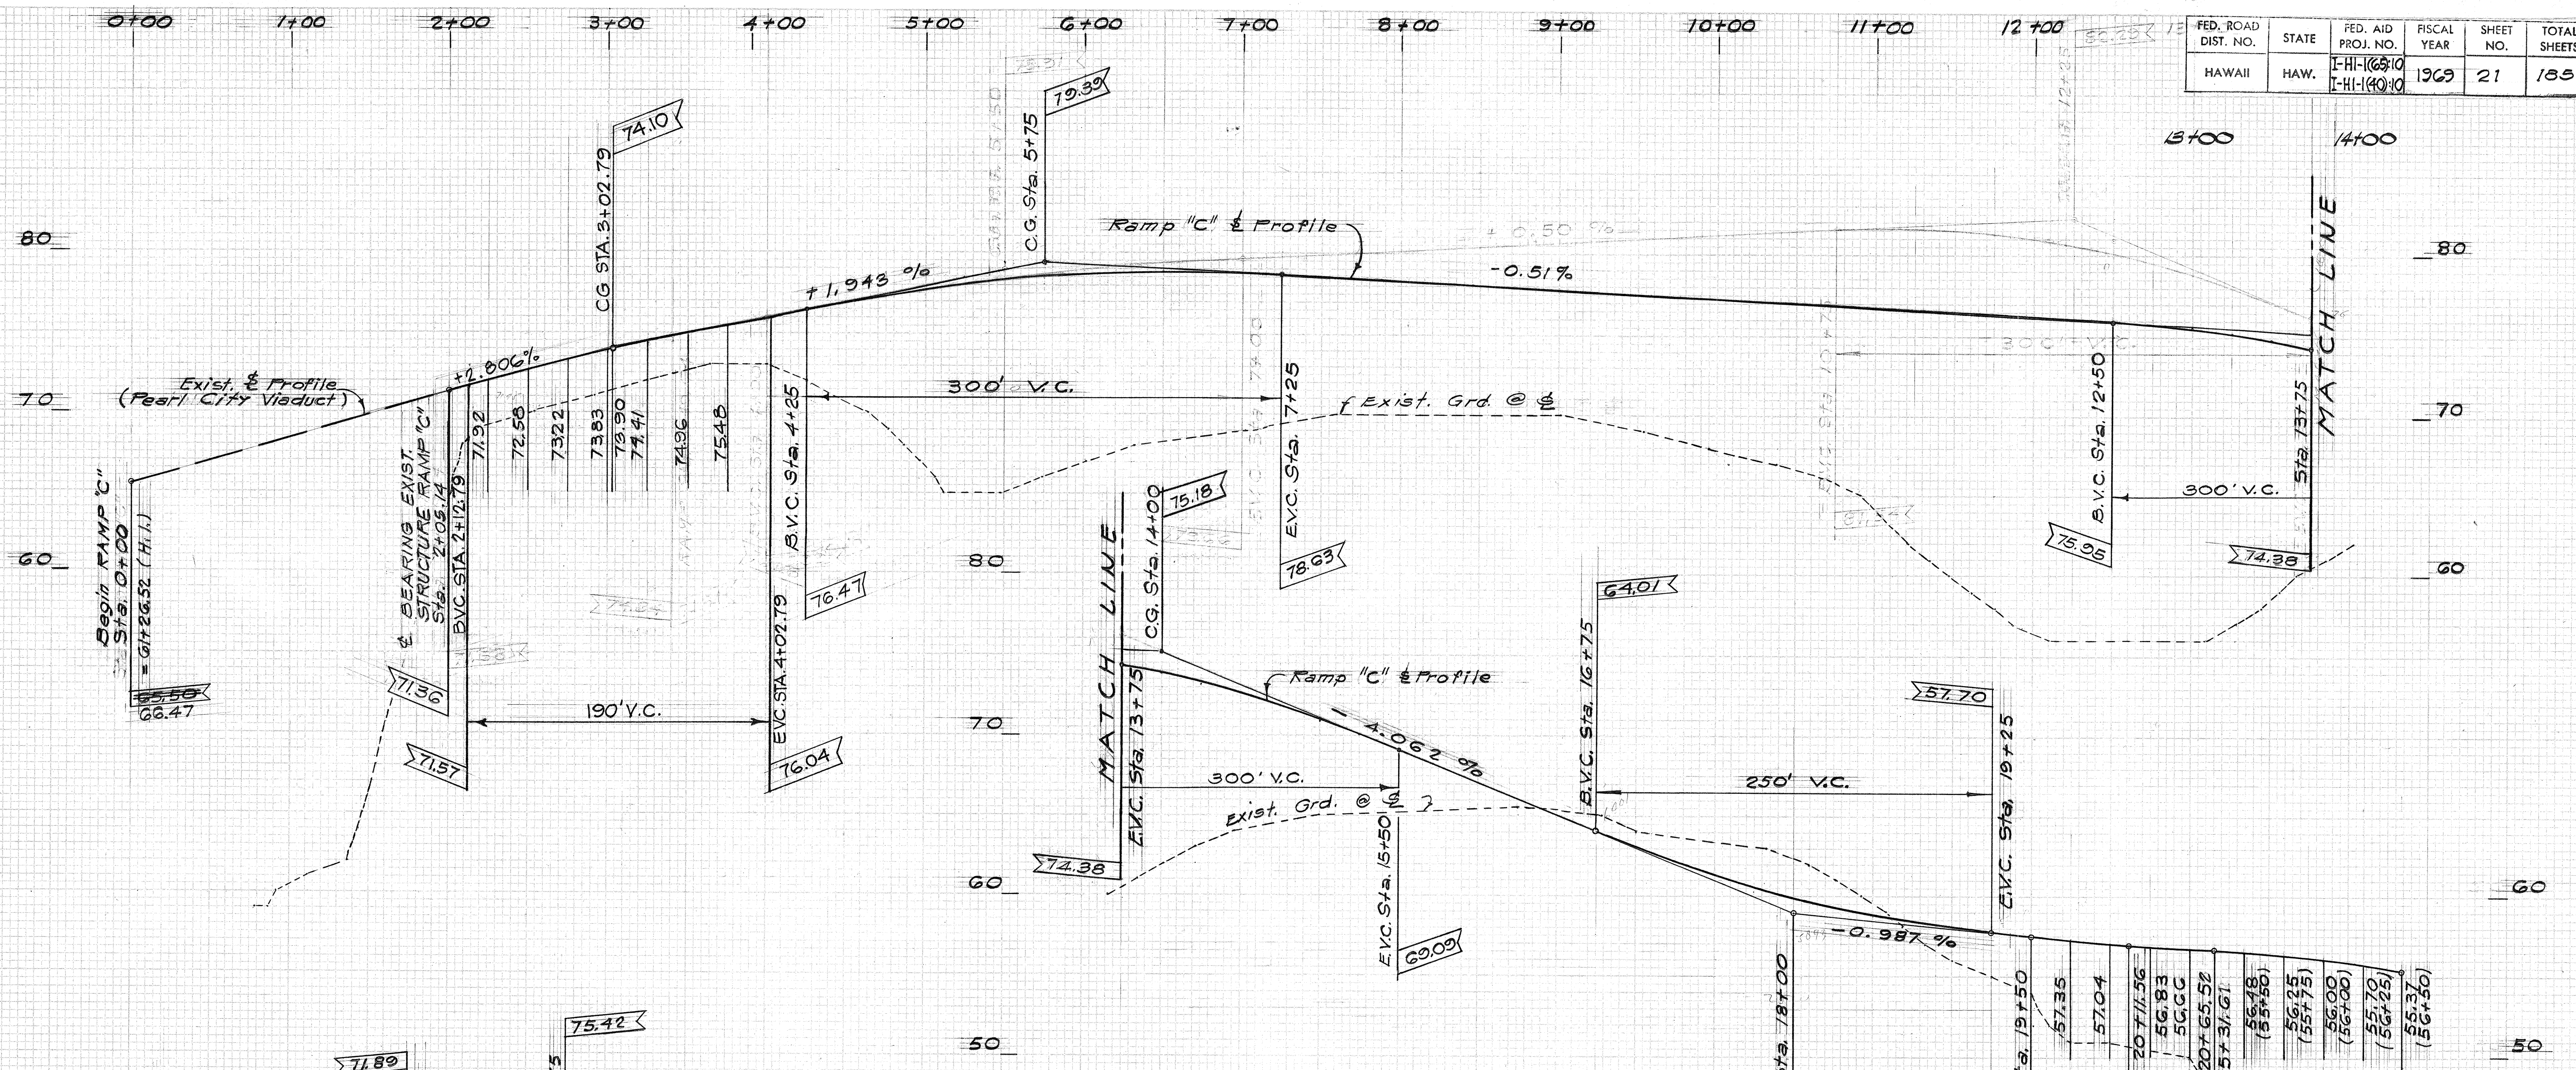


PROFILE RAMP "C"
 Scale: Horizontal: 1" = 50'
 Vertical: 1" = 5'

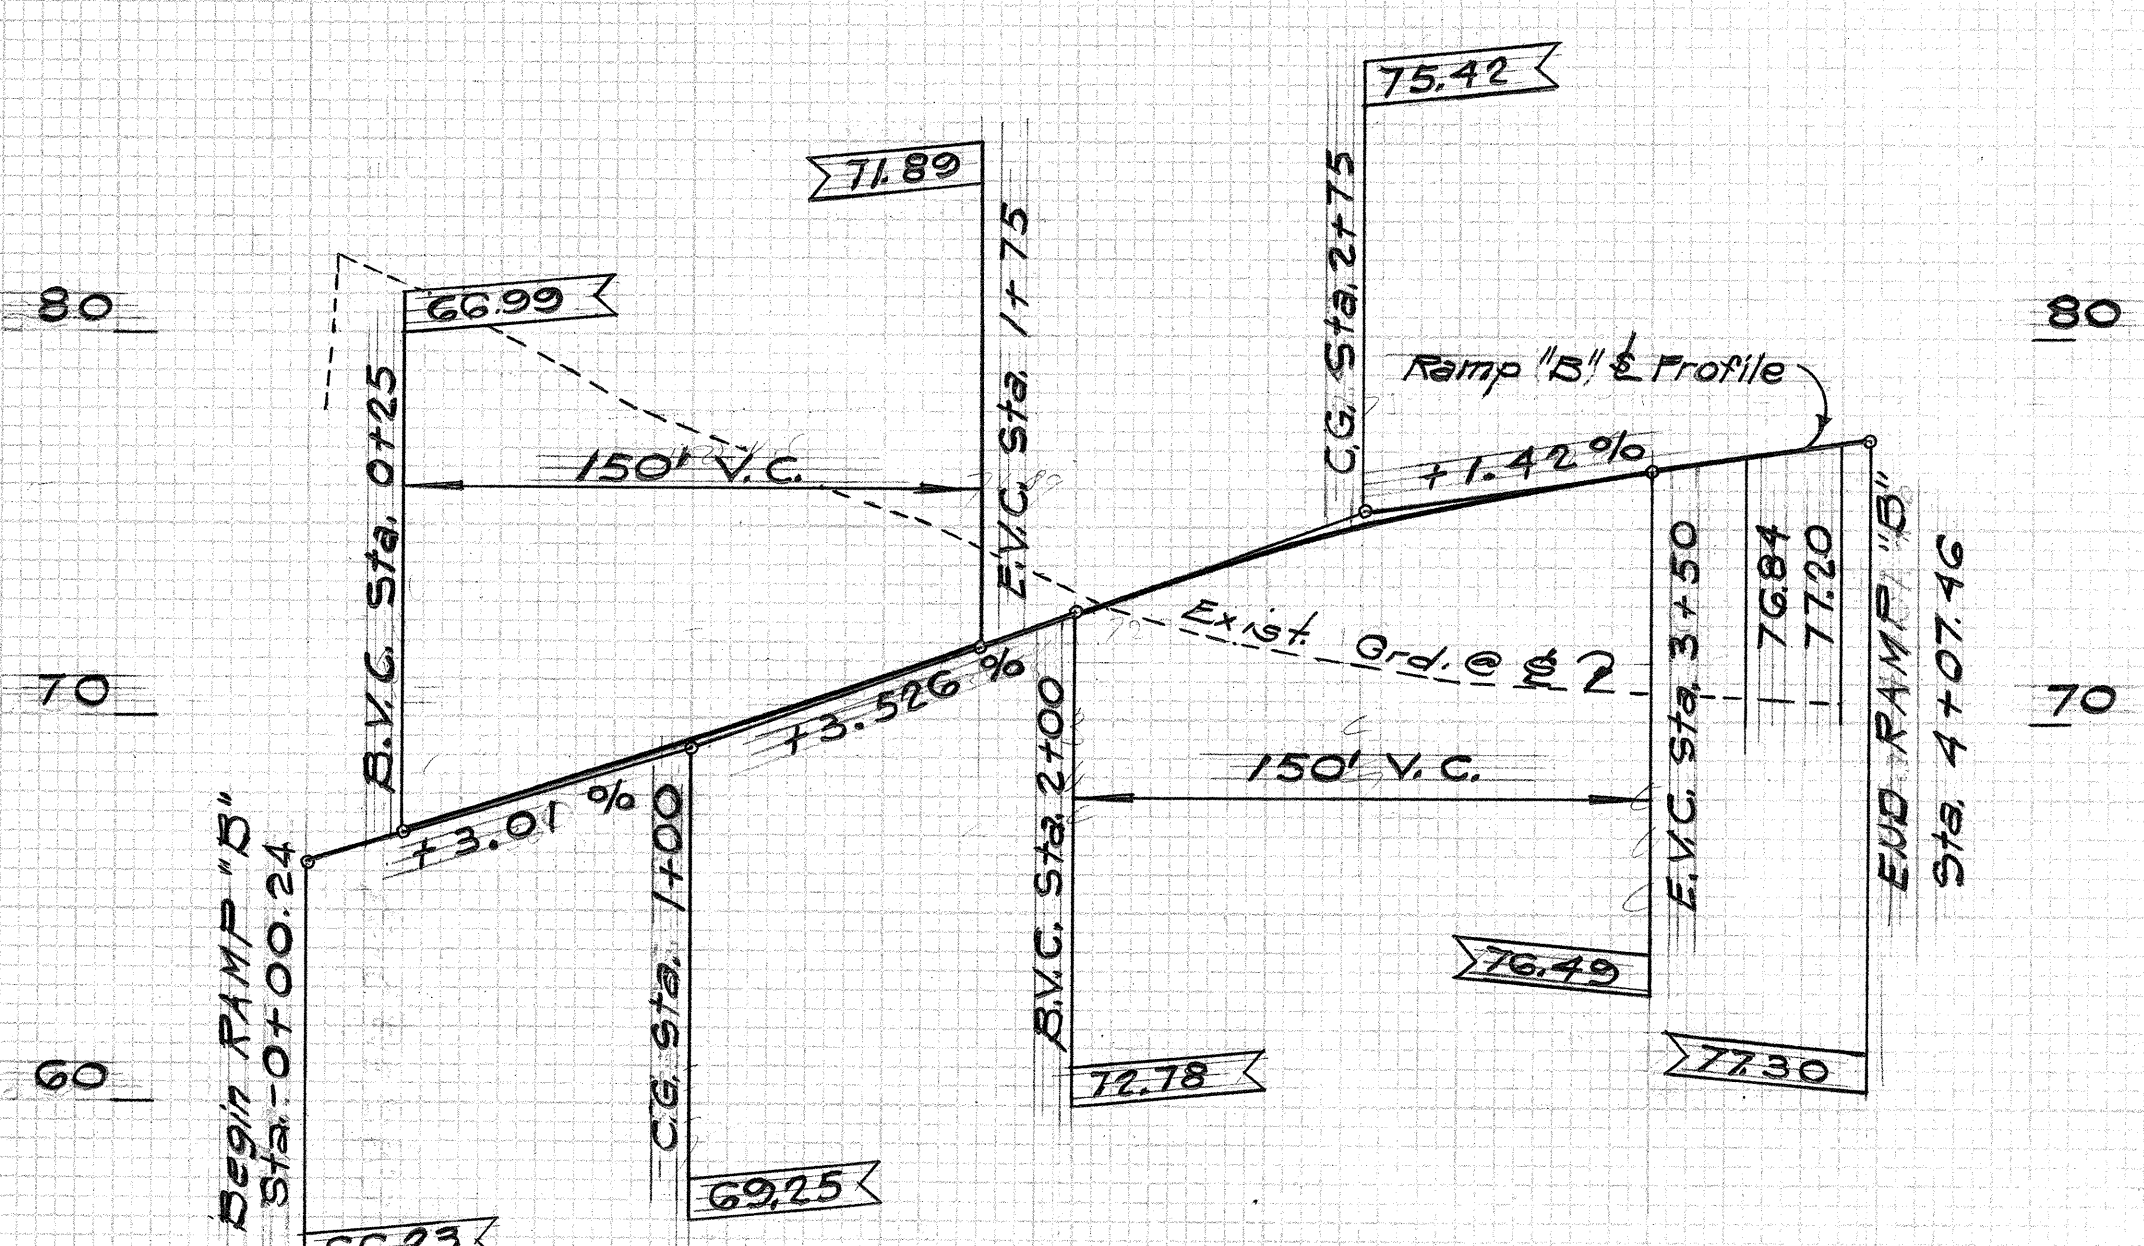

PROFILE RAMP "B"
 Scale: Horizontal: 1" = 50'
 Vertical: 1" = 5'

For continuation
 see MOAUALUA
 Typ. Rdwy. sections

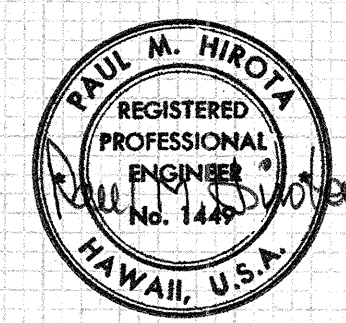

THIS WORK WAS PREPARED BY
 ME OR UNDER MY SUPERVISION.

STATE OF HAWAII
 DEPARTMENT OF TRANSPORTATION
 HIGHWAYS DIVISION


RAMP PROFILES

INTERSTATE ROUTE H-1
 PROJ. NO. I-HI-1(65)10

Scale: As Shown Date: 4-24-69

SHEET No. 2 OF 3 SHEETS

FED. ROAD DIST. NO.	STATE	FED. AID PROJ. NO.	FISCAL YEAR	SHEET NO.	TOTAL SHEETS
HAWAII	HAW.	I-HI-(65)10 I-HI-(40)11	1969	22	185

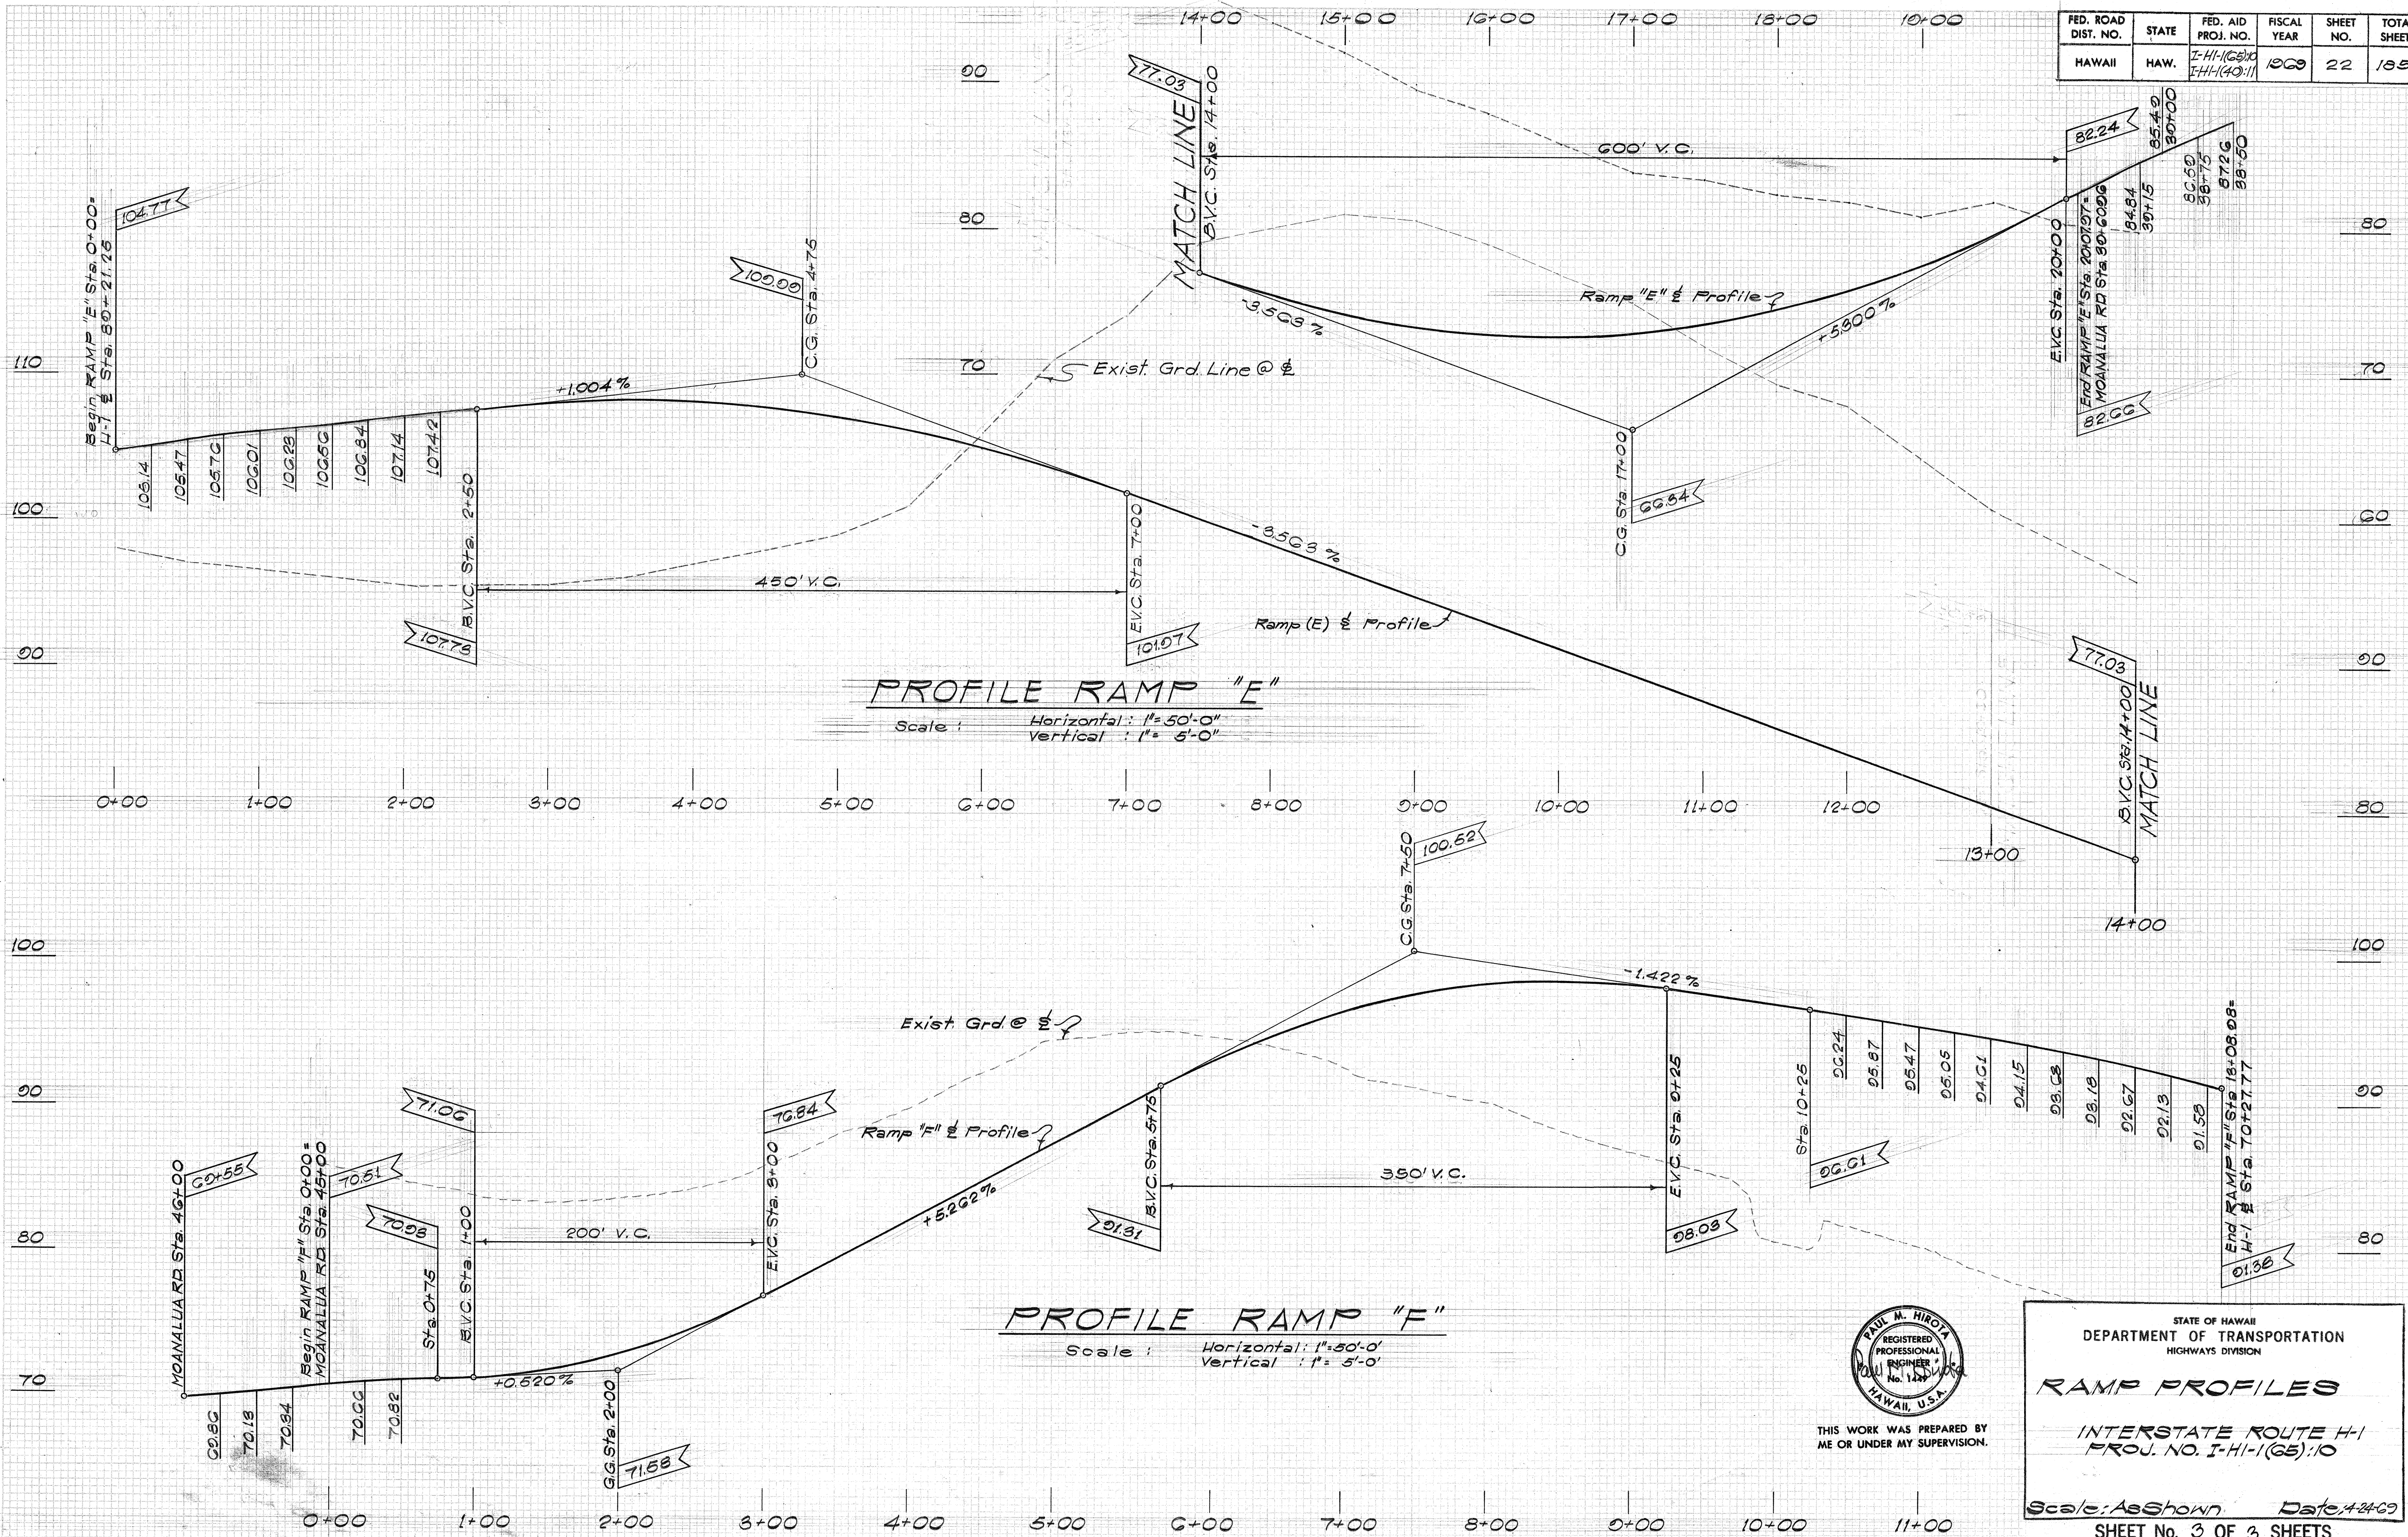

THIS WORK WAS PREPARED BY ME OR UNDER MY SUPERVISION.

STATE OF HAWAII
DEPARTMENT OF TRANSPORTATION
HIGHWAYS DIVISION

RAMP PROFILES

INTERSTATE ROUTE H-1
PROJ. NO. I-HI-(65)10

Scale: As Shown Date: 4-24-69

SHEET No. 3 OF 3 SHEETS