

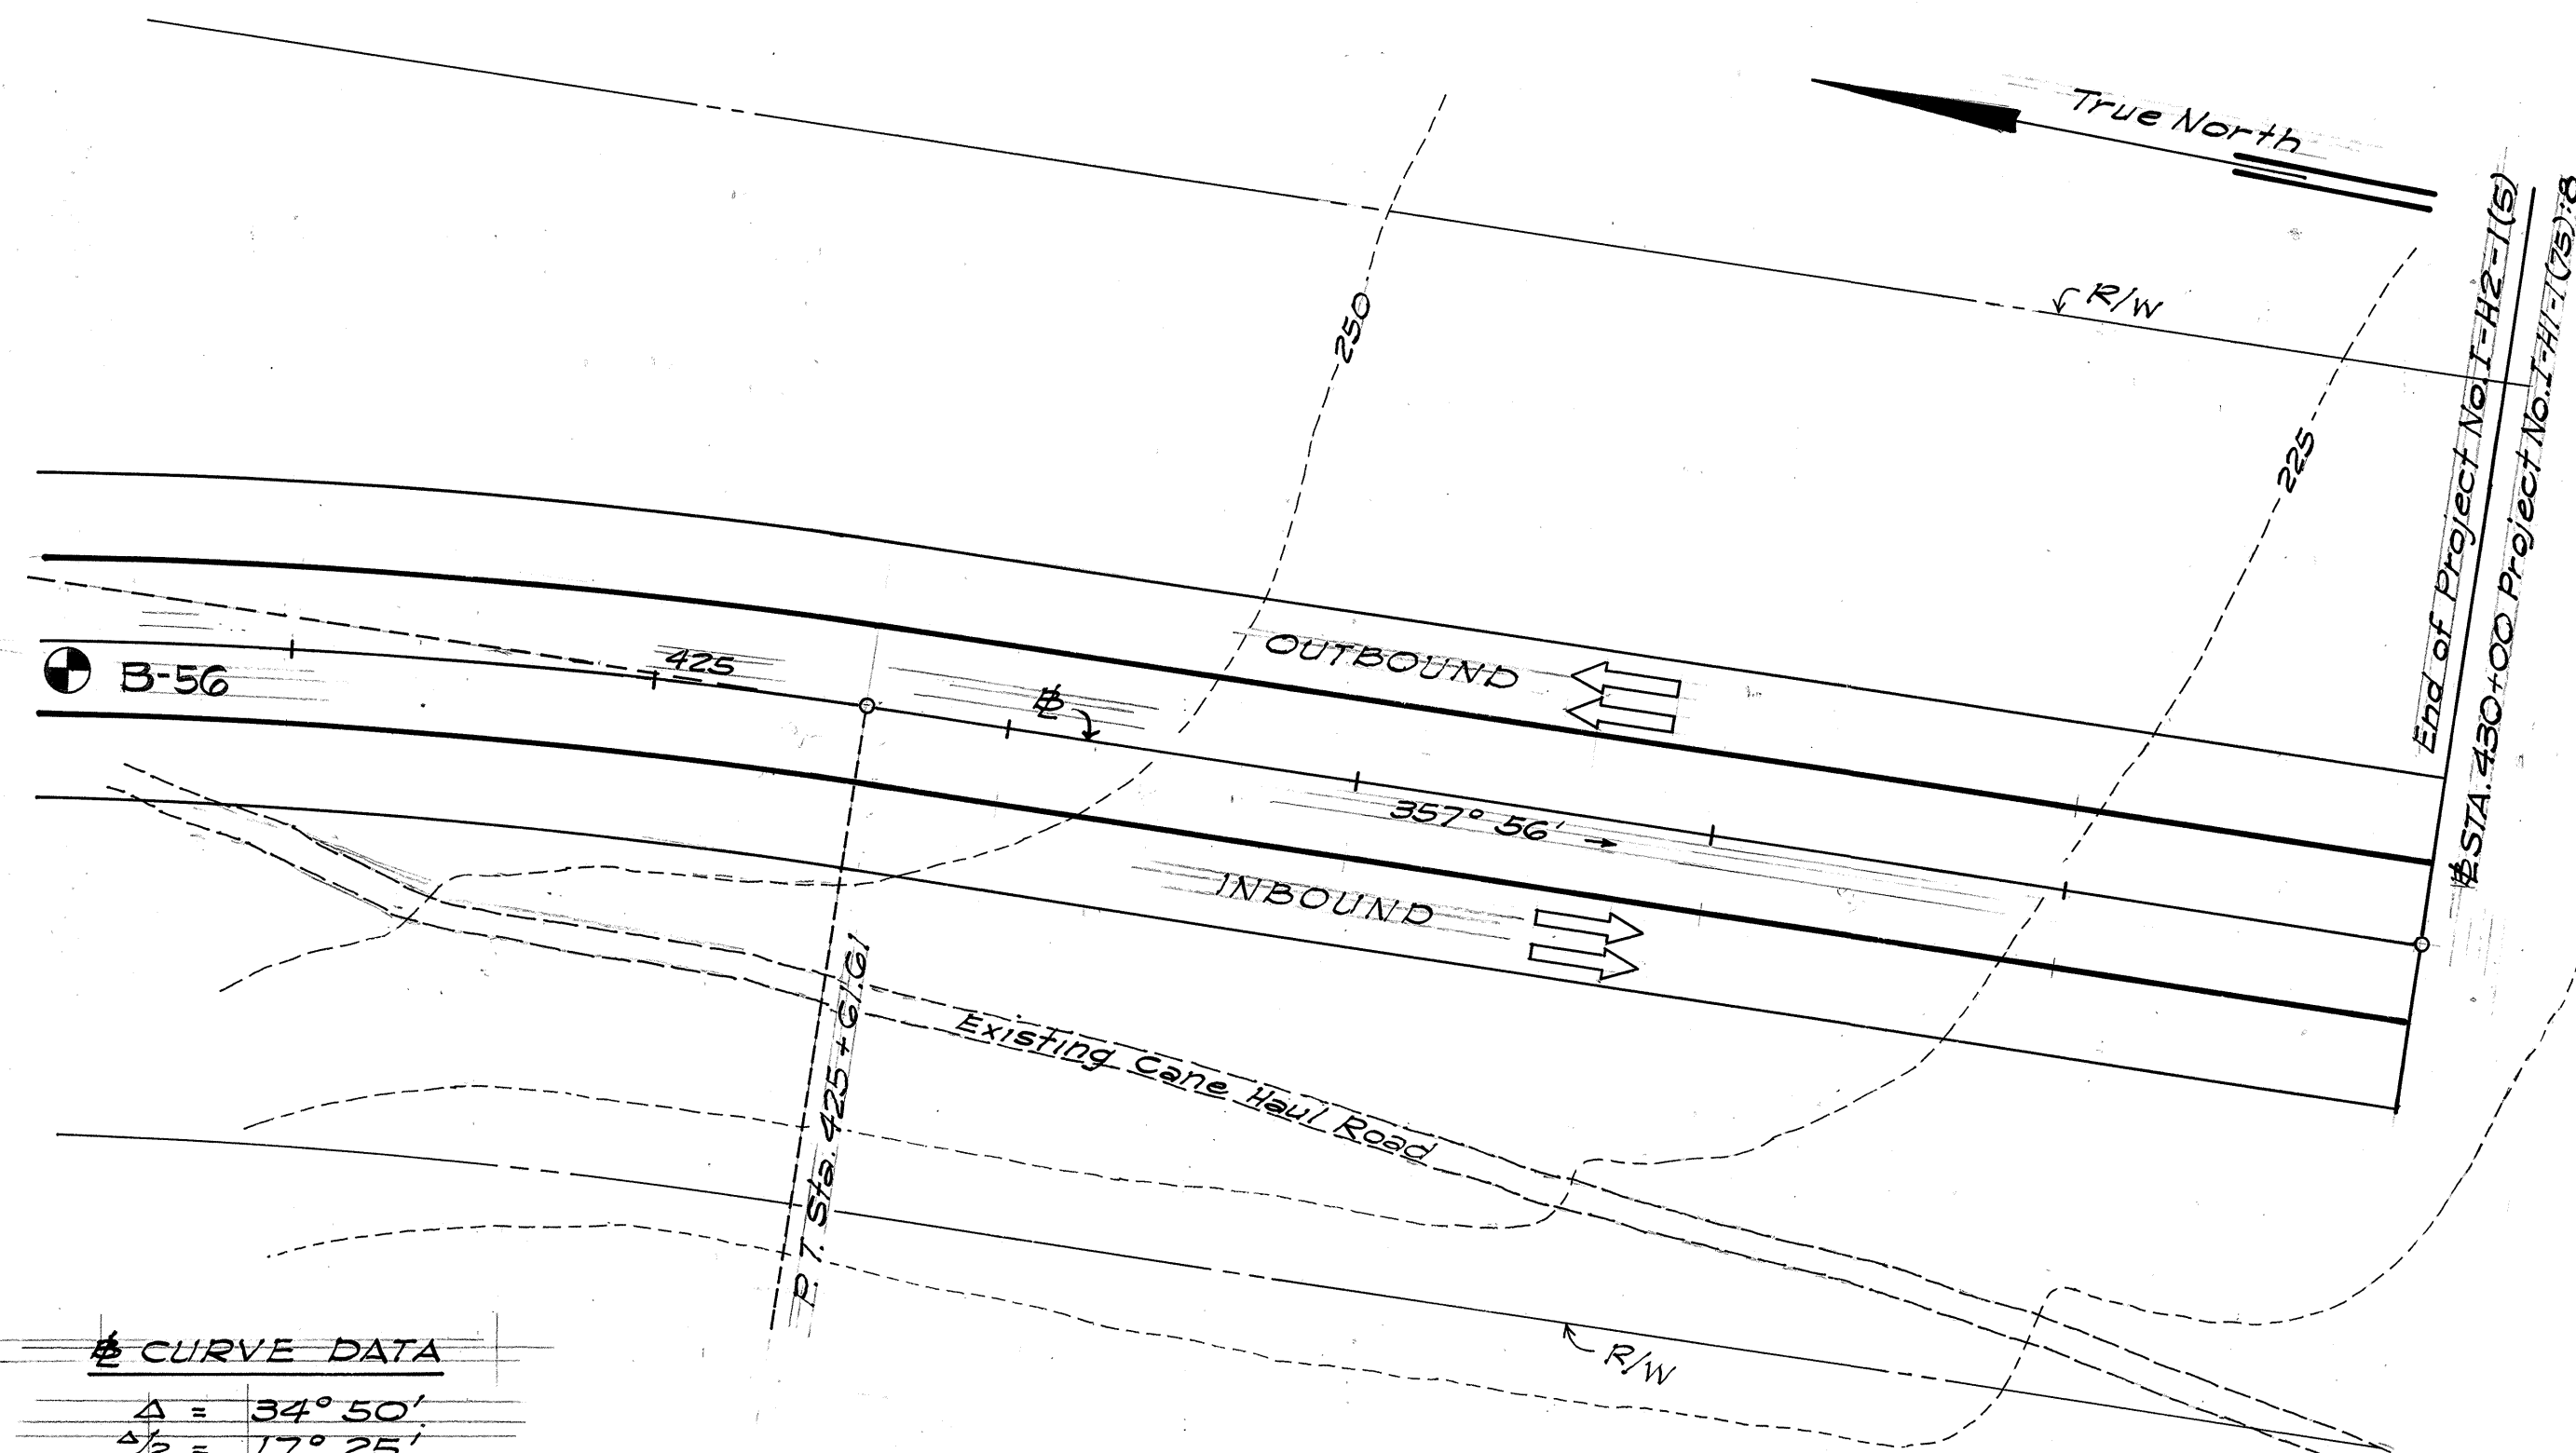


FED. ROAD DIST. NO.	STATE	FED. AID PROJ. NO.	FISCAL YEAR	SHEET NO.	TOTAL SHEETS
HAWAII	HAW.	1-HI-1758	1969	179	181




Revised: February 18, 1970

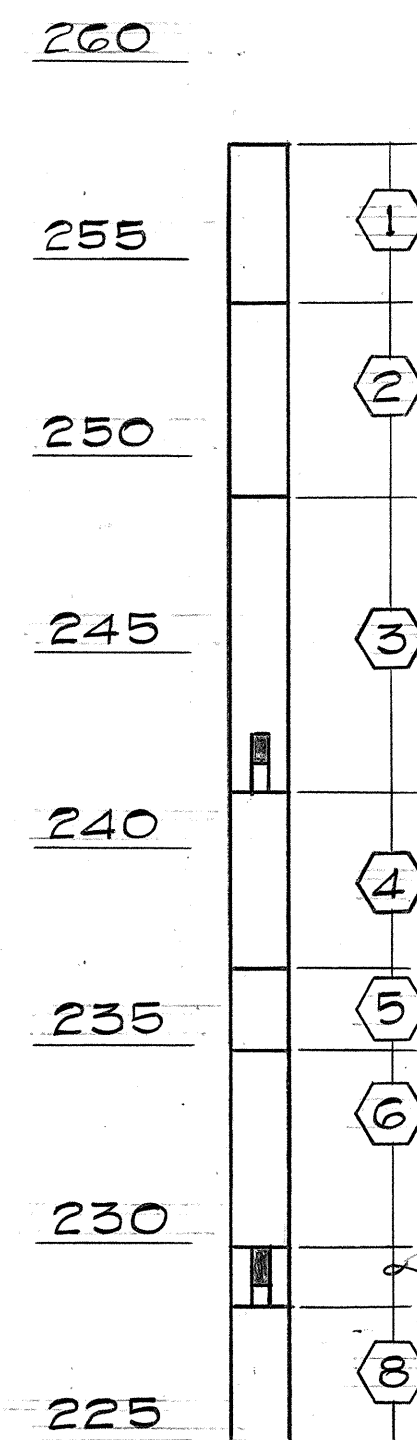

PLAN
SCALE - 1" = 50'

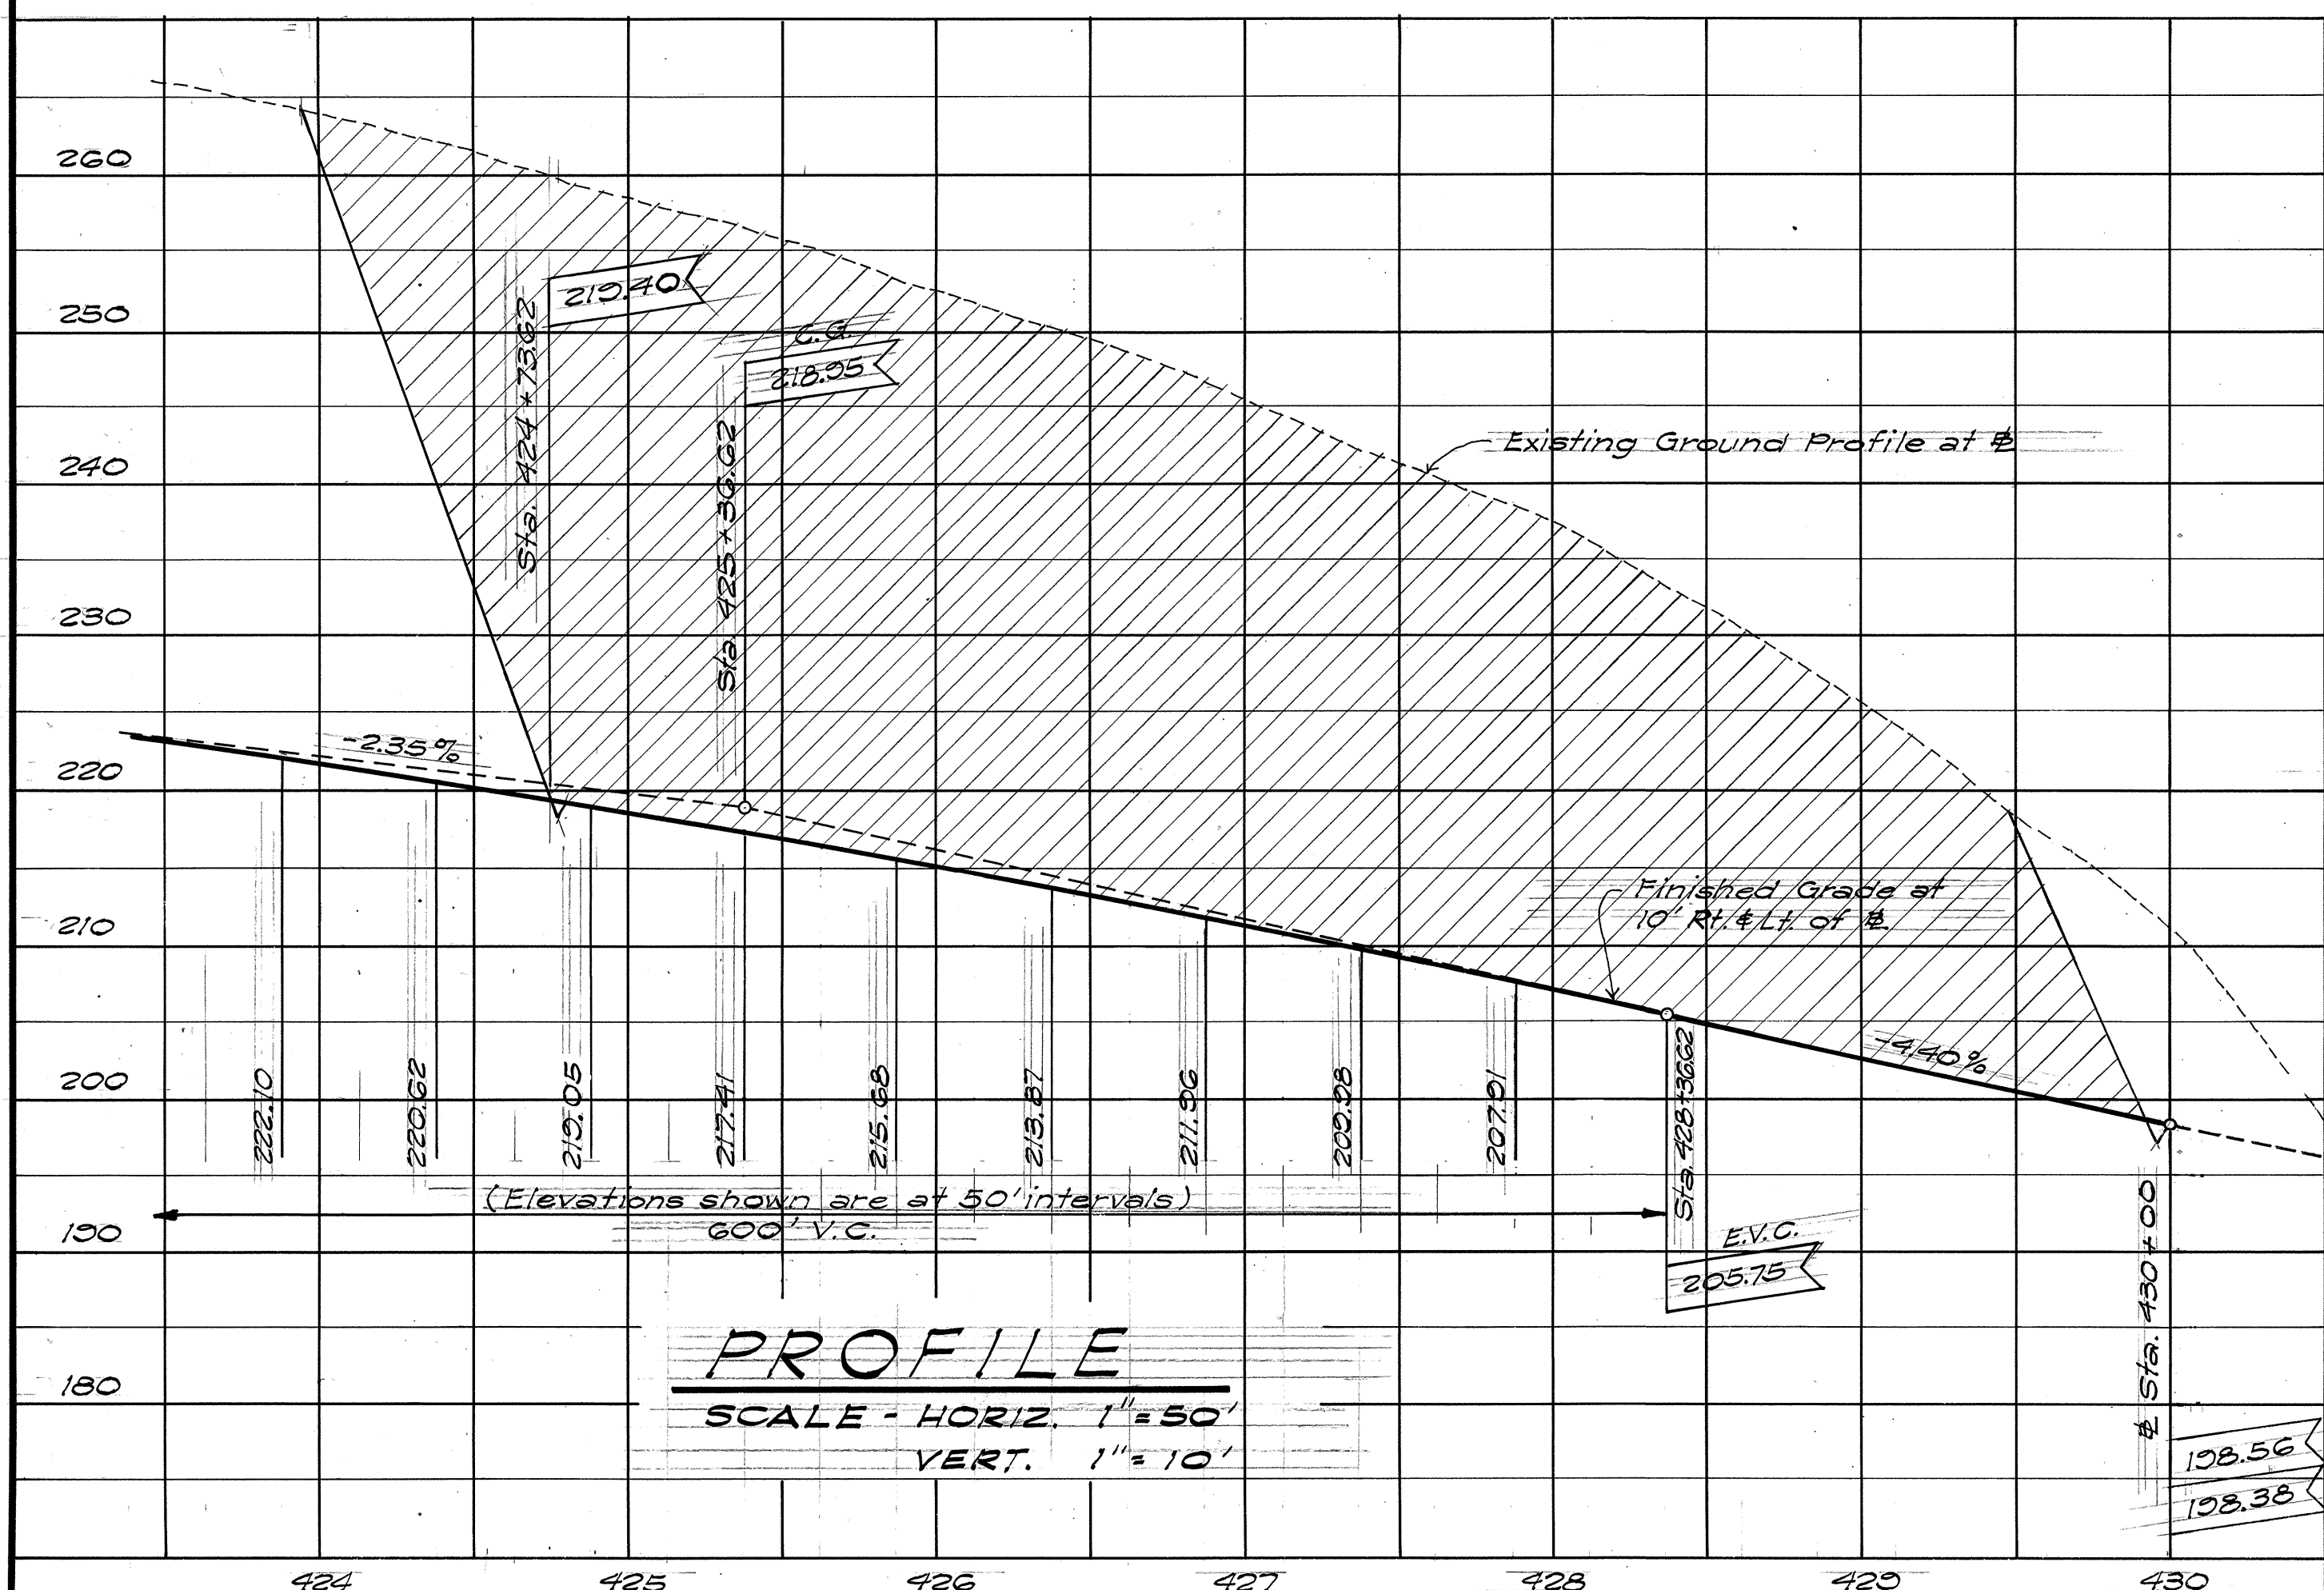

- ① Firm brown silty clay
- ② Firm reddish brown clay & soft rock
- ③ Firm red clay & vesicular basaltic rock
Shelby - 0.83' recovery - 127 blows/Ft.
- ④ Vesicular basaltic rock
- ⑤ Vesicular basaltic rock & soft gray rock
- ⑥ Soft gray rock
- ⑦ Split spoon - 1.0' recovery - 70 blows/Ft.
Firm gray clay & soft gray rocks
- ⑧ Firm light brown clay & soft gray rocks

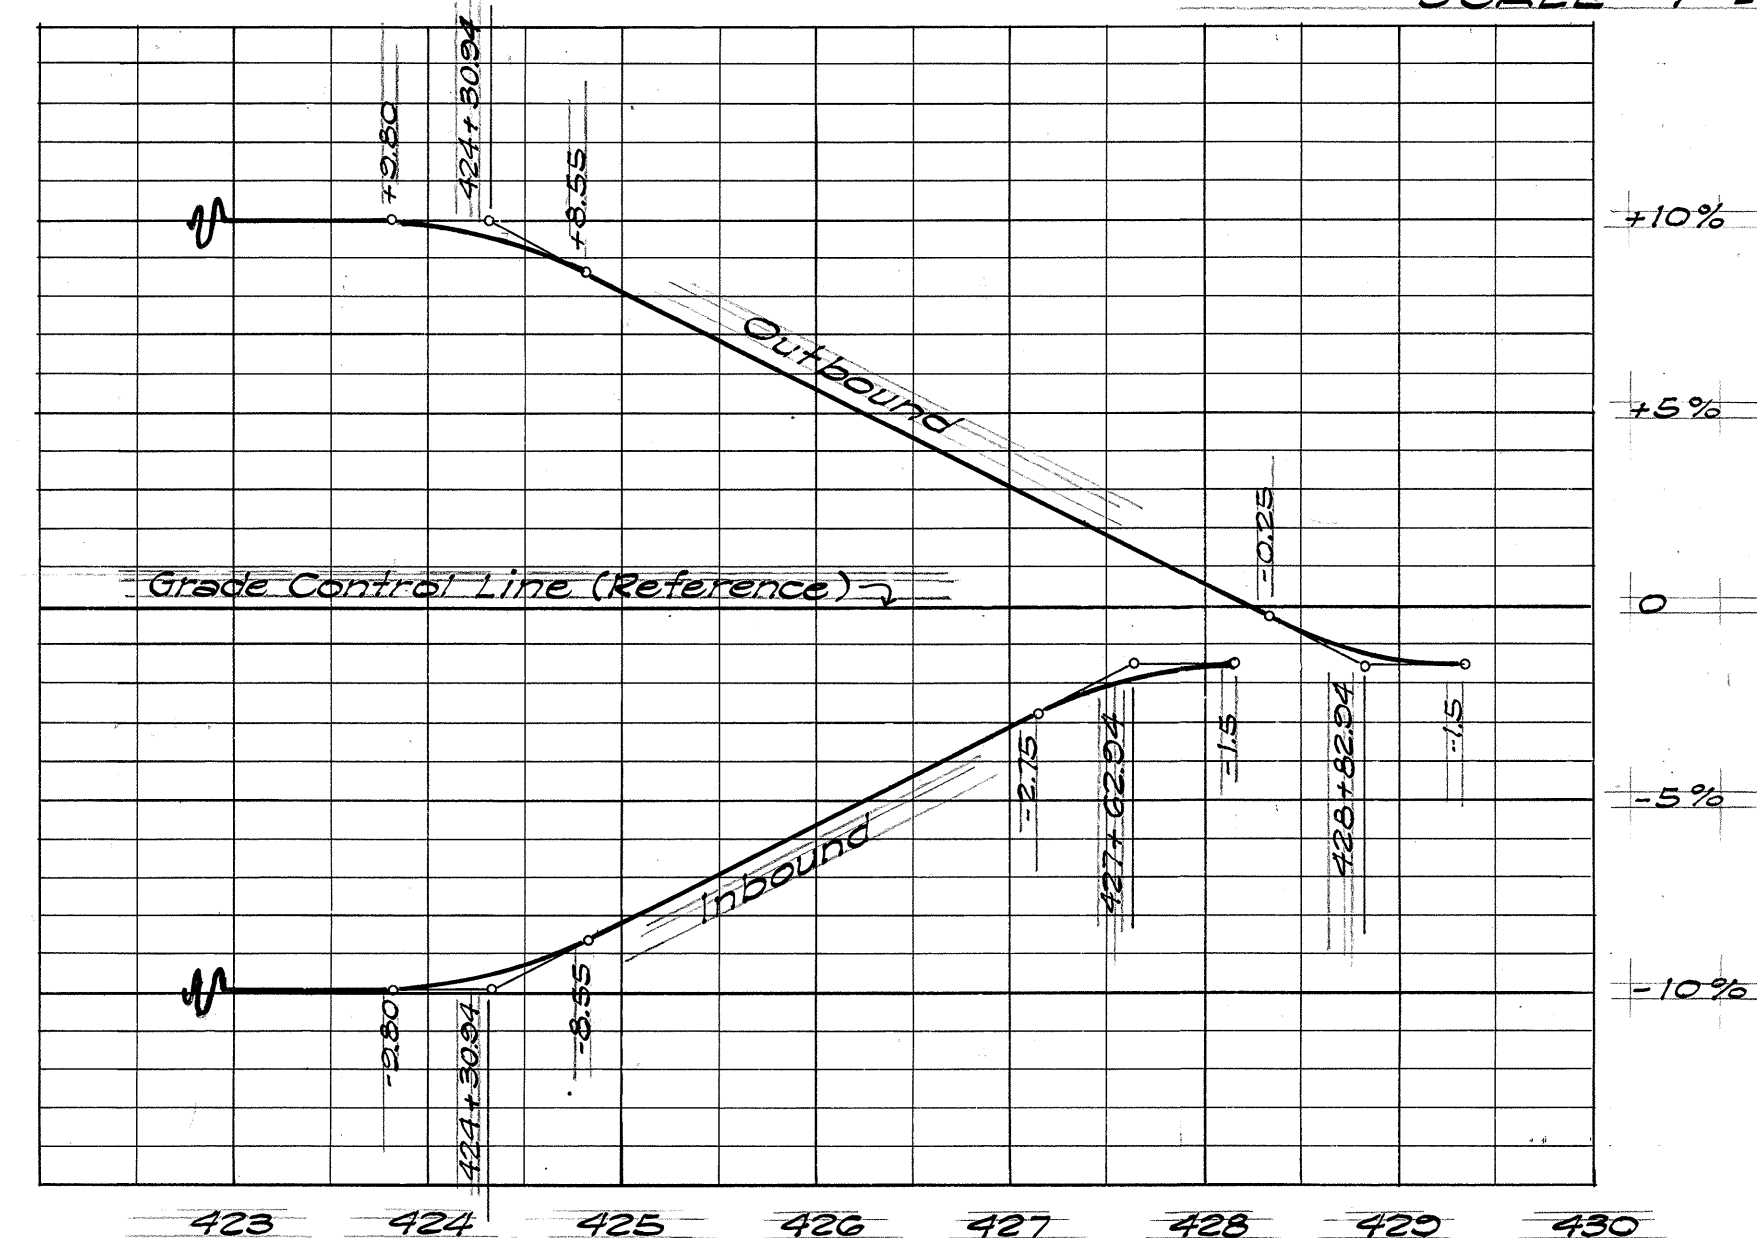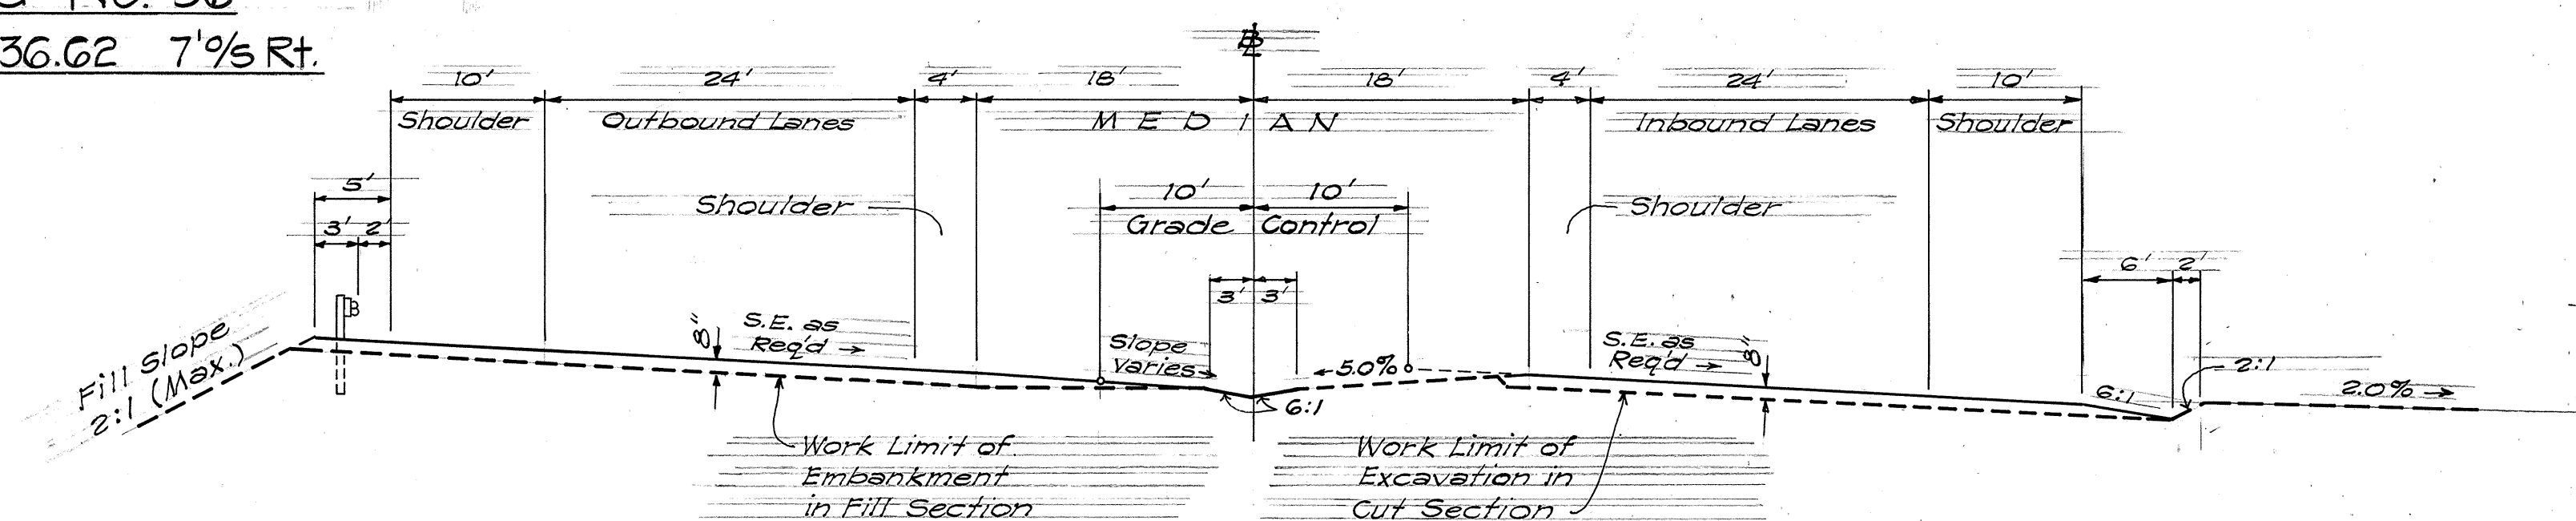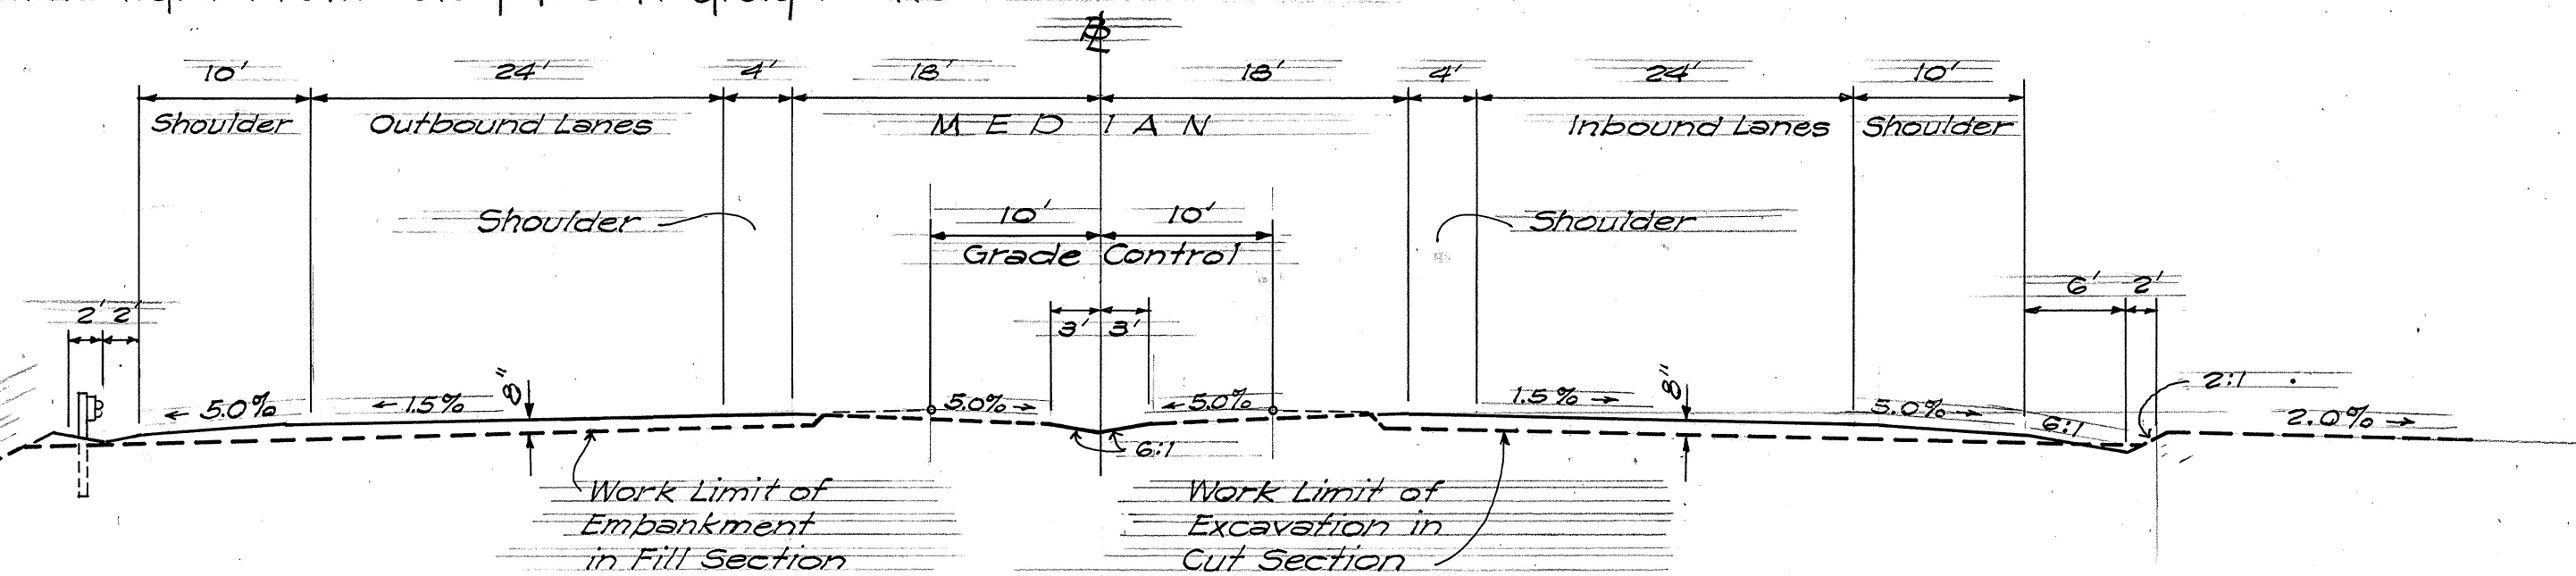

NOTE: See Sheets 180 & 181 for Cross Sections.

THIS SHEET SUPERSEDES SHEET NO. 52

STATE OF HAWAII
DEPARTMENT OF TRANSPORTATION
HIGHWAYS DIVISION

BORROW SITE PLAN

WAIAWA INTERCHANGE
F.A.I. Proj. No. I-HI-1(75):8

Scale: As shown Date: Jan. 1970
SHEET NO. 1 OF 3 SHEETS

ADD. 179

FED. ROAD DIST. NO.	STATE	FED. AID PROJ. NO.	FISCAL YEAR	SHEET NO.	TOTAL SHEETS
HAWAII	HAW.	I-H-1(75)8	1965	181	181

FINAL SURVEY	SURVEYED	DATE
NOTE BOOK	PLOTTED	BY
NO.	TEMPLATE	
	AREAS CHECKED	

ORIGINAL SURVEY	SURVEYED	DATE
NOTE BOOK	PLOTTED	BY
NO.	TEMPLATE	
	AREAS CHECKED	

