
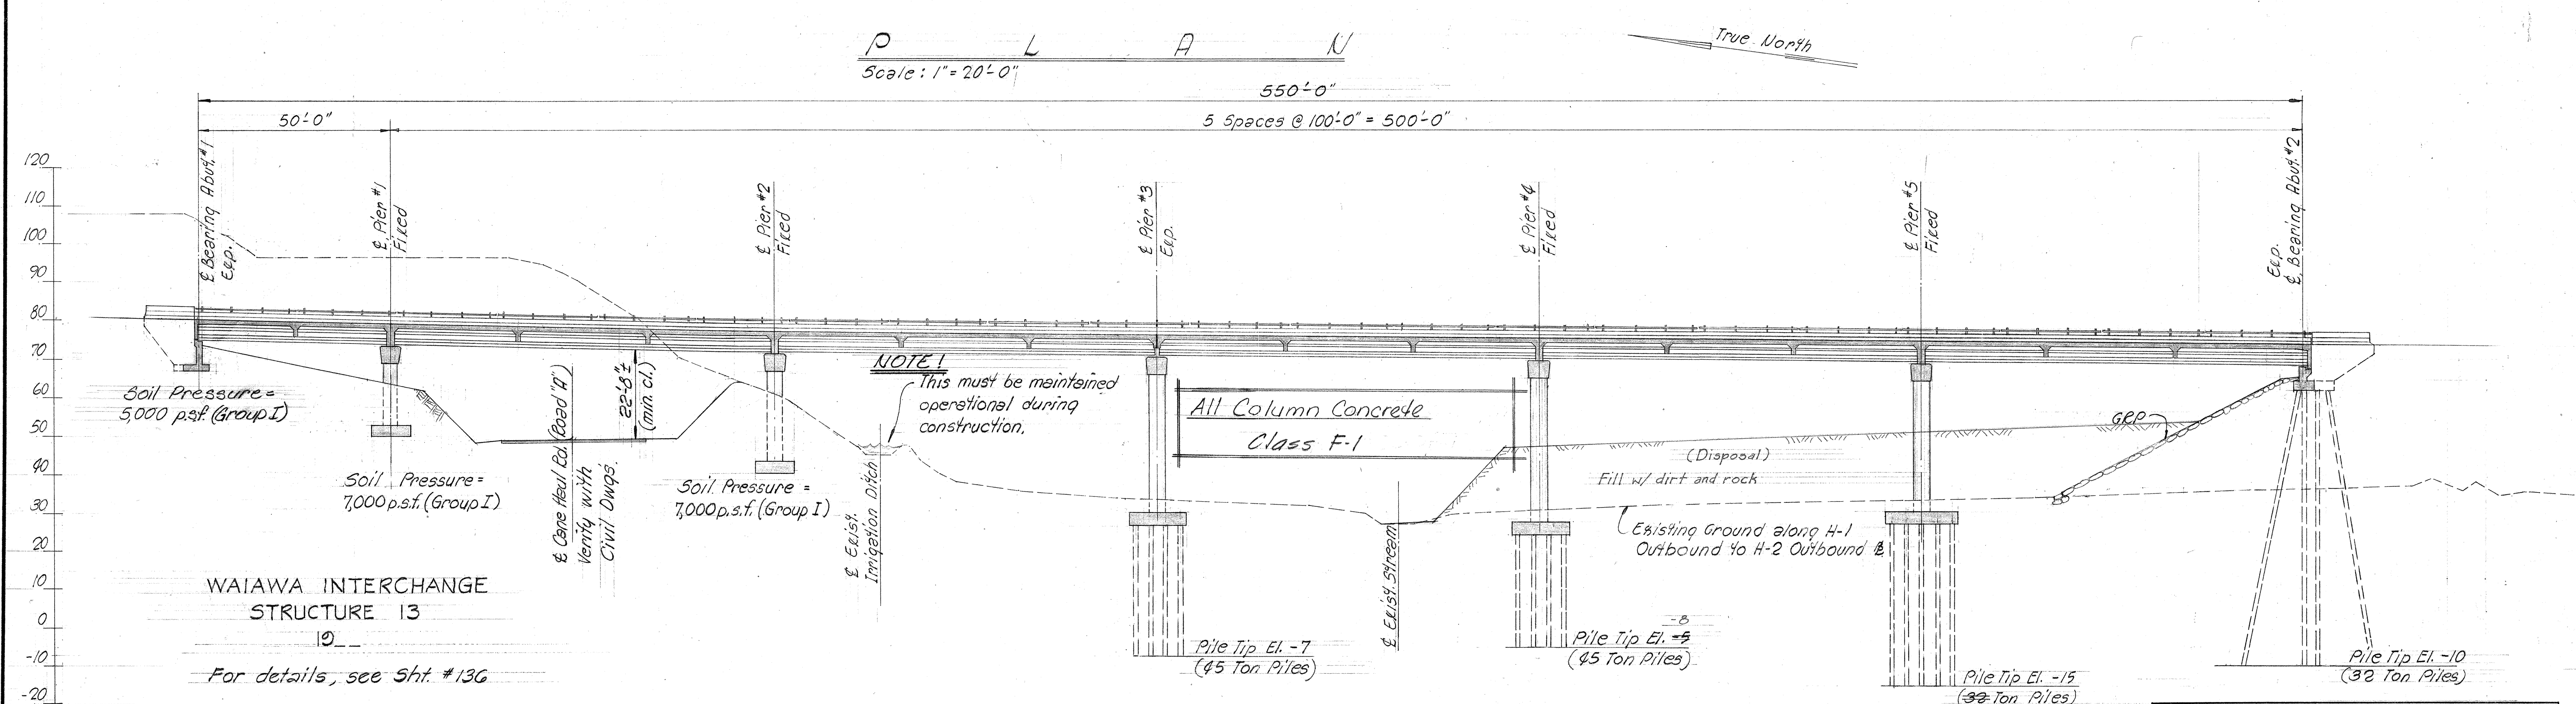


FED. ROAD DIST. NO.	STATE	FED. AID PROJ. NO.	FISCAL YEAR	SHEET NO.	TOTAL SHEETS
HAWAII	HAW.	I-HI-(75):8	1969	68	181

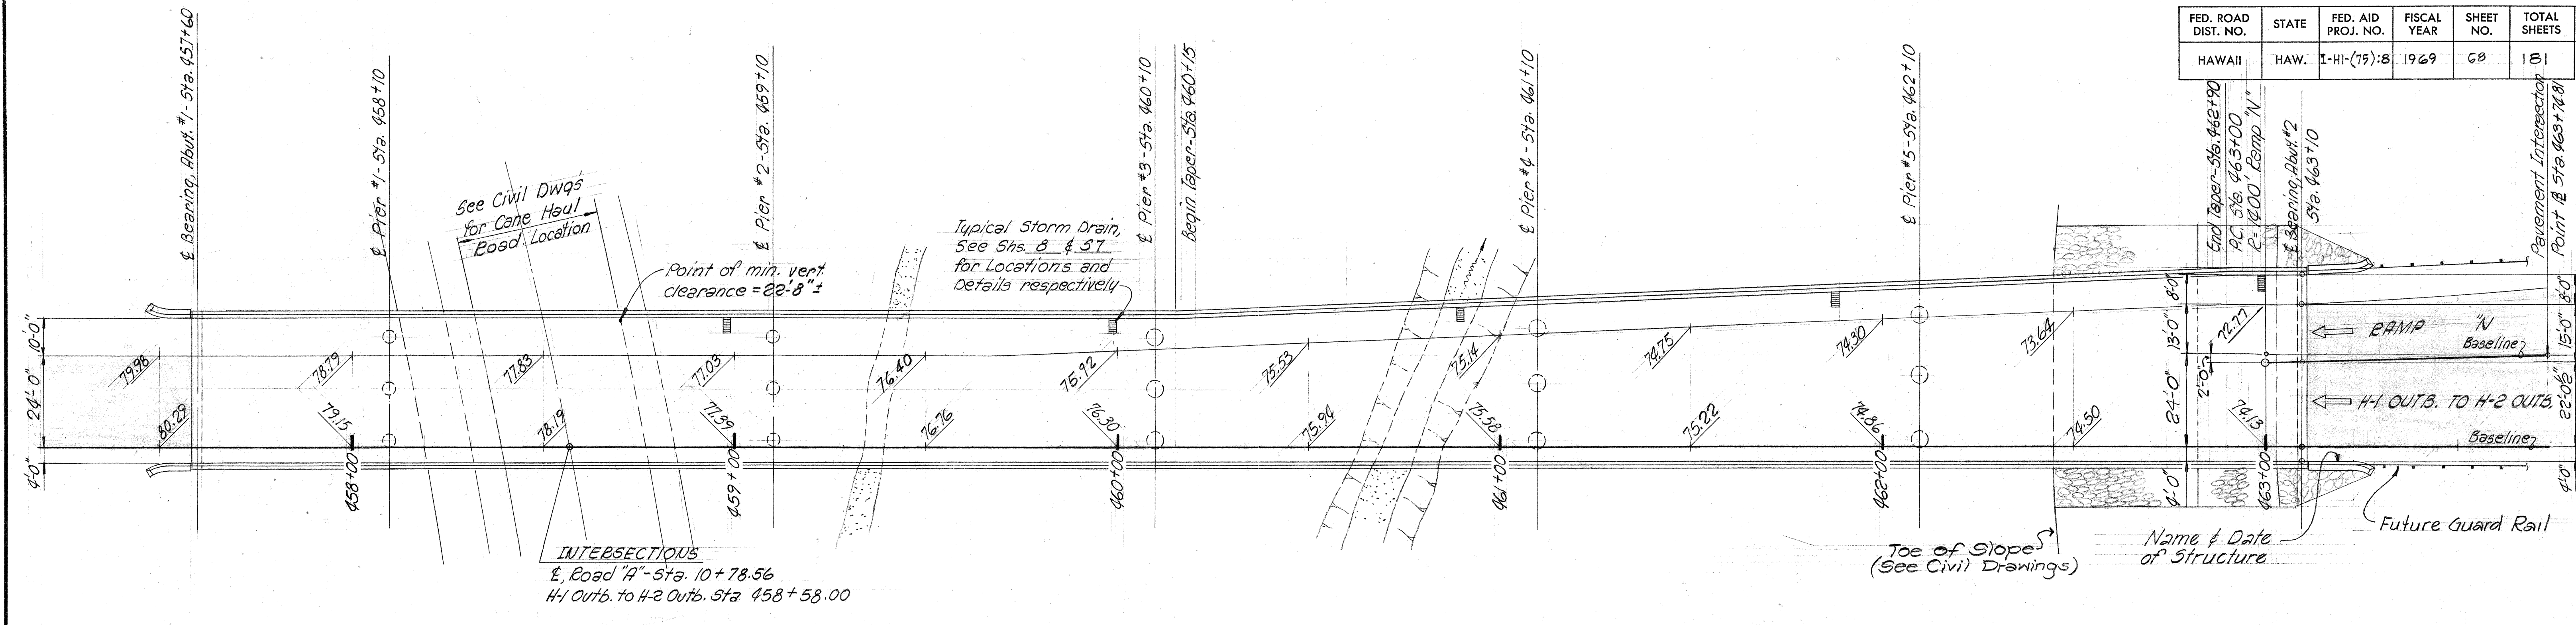

NAME & DATE OF STRUCTURE
Not to Scale

LONGITUDINAL SECTION ALONG B OF STRUCTURE Scale: 1" = 20'-0"

SHIMAZU SHIMADUKURO & FUKUDA, INC.
Consulting Structural Engineers
1210 Ward Ave., Honolulu, HI 96814

REGISTERED PROFESSIONAL ENGINEER
No. 1343
HAWAII, U.S.A.


This work was prepared by me or under my supervision.
Howard Y. Fukuda

STATE OF HAWAII
DEPARTMENT OF TRANSPORTATION
HIGHWAYS DIVISION

STRUCTURE No. 13
LAYOUT - PLAN
& LONGITUDINAL SECTION

WAIAWA INTERCHANGE
F.A.I. Proj. No. I-HI-1 (75):8

Scale: As shown Date: JUNE, 1969
SHEET No. 1 OF 12 SHEETS

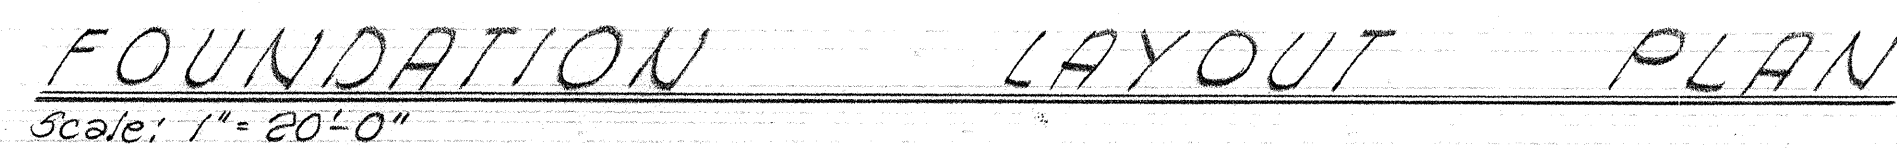

ITEM#	ITEM	UNIT	QUANTITY
14.60	Structure Excavation for Bridges	C.Y.	1500
46.061	Concrete in Structure #13 (Except in Footings)	L.S.	1130 C.Y.
46.062	Concrete in Footings for Structure #13	L.S.	466 C.Y.
46P15	Type II Prestressed Concrete Girders for Structure #13	L.S.	4240 L.F.
48.61	Reinforcing Steel in Structure #13	L.S.	434,500 LB
51.03	Pile Load Test for Structure #13	EA.	one (1)
51.92	Furnishing Conc. Piles for Structure #13	L.F.	6,826
51.93	Driving Conc. Piles for Structure #13	L.F.	5,968
52.10	Filter Material for Structures	C.Y.	131
55.10	Metal Bridge Rail	L.F.	1110
55.50	Concrete Bridge Parapet, Including End Post	L.F.	1170
65.04	Grouted Rubble Paving for Bridges	C.Y.	215
51.07	Driving Test Piles for Structure #13	L.F.	338

1. See civil drawings for extent of area to be surcharged.
2. No work shall be permitted over surcharged area for 12 months after placement of surcharge.
3. Work permitted on 3-continuous spans adjacent to surcharged area shall not include placing deck slab during period of surcharge application.
4. Work on all other 3 continuous spans shall be permitted.

1. Load test one pile in Pier #5 (as directed by Engineer) for 45 ton capacity before driving balance of piles. If load test show that 45 Ton piles should be used foundation for Pier #5 will be redesigned (See Specs.).
2. Driving two test piles ea. in Pier #3, Pier #4 and in Abutment #2 (indicated by arrows) for length determination.
3. Test piles for load carrying capacity and for length determination shall be driven before casting balance of piles.

- A. Loads = HS20-44 or Interstate Loading.
- B. Specifications = Standard Specifications for Highway Bridges, AASHTO, 9th Edition.
- C. Design Stresses
 1. Reinforced Concrete Beams & Slabs (See, also, AASHTO Specifications & Special Provisions).
 - a) $f_c' = 3,000$ p.s.i. Concrete unless otherwise noted.
 - b) $f_s = 20,000$ p.s.i. reinforcing steel.
 2. Prestressed Girders, See Sh. 58
 3. Pile Capacity - See Longitudinal Section, Sh. 1.
 4. Allowable Foundation Pressure - See Longitudinal Section, Sh. 1.

- 1 - Abutment #1 Foundation-- Sh. 3
- 2 - Abutment #2 Foundation-- Sh. 4
3. Pier Foundations ----- Sh. 52
4. Pier Columns ----- Sh. 51
5. General Notes ----- Sh. 59



This work was prepared by
me or under my supervision.
Howard G. Fukuda


STRUCTURE No. 13
FOUNDATION LAYOUT PLAN

WAIAWA INTERCHANGE
F.A.I. Proj. No. I-HI-1 (75):8


Scale: As shown Date: JUNE, 1969

SHEET No. 2 OF 12 SHEETS


FED. ROAD DIST. NO.	STATE	FED. AID PROJ. NO.	FISCAL YEAR	SHEET NO.	TOTAL SHEETS
HAWAII	HAW.	I-HI-1 (75):8	1969	70	181

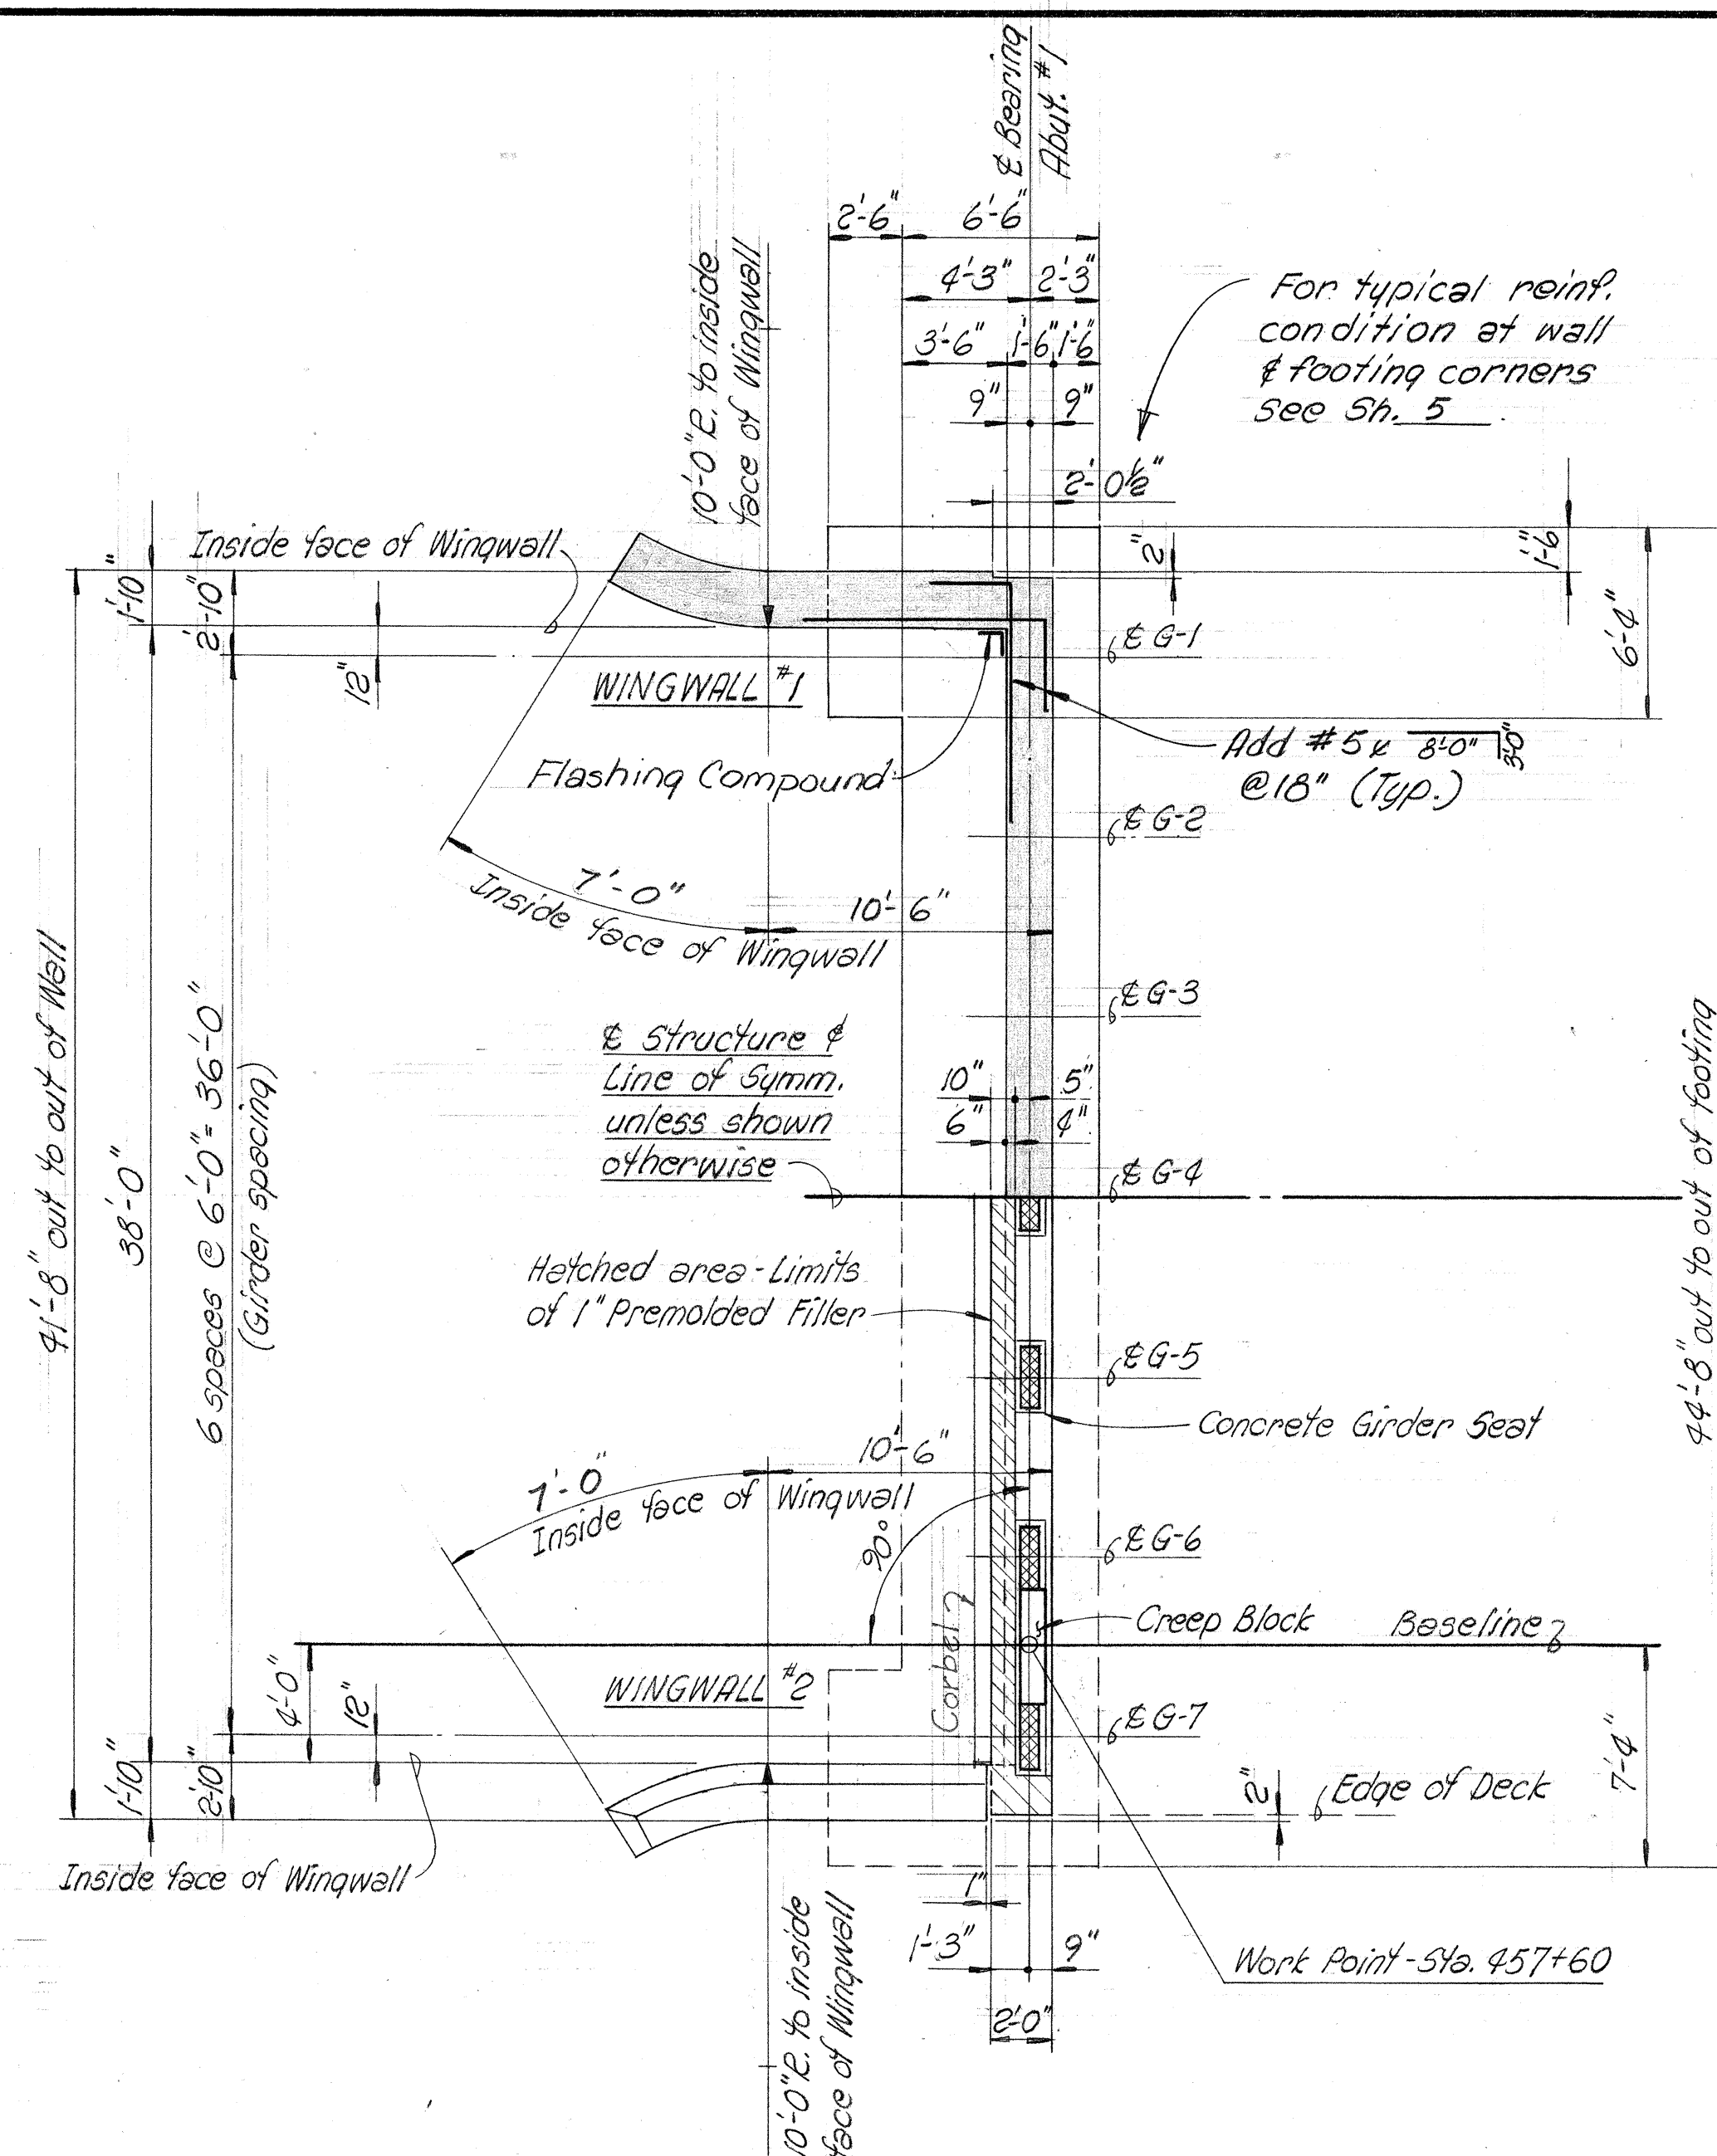


ABUTMENT #1 PLAN
Scale: $\frac{3}{16}" = 1'-0"$

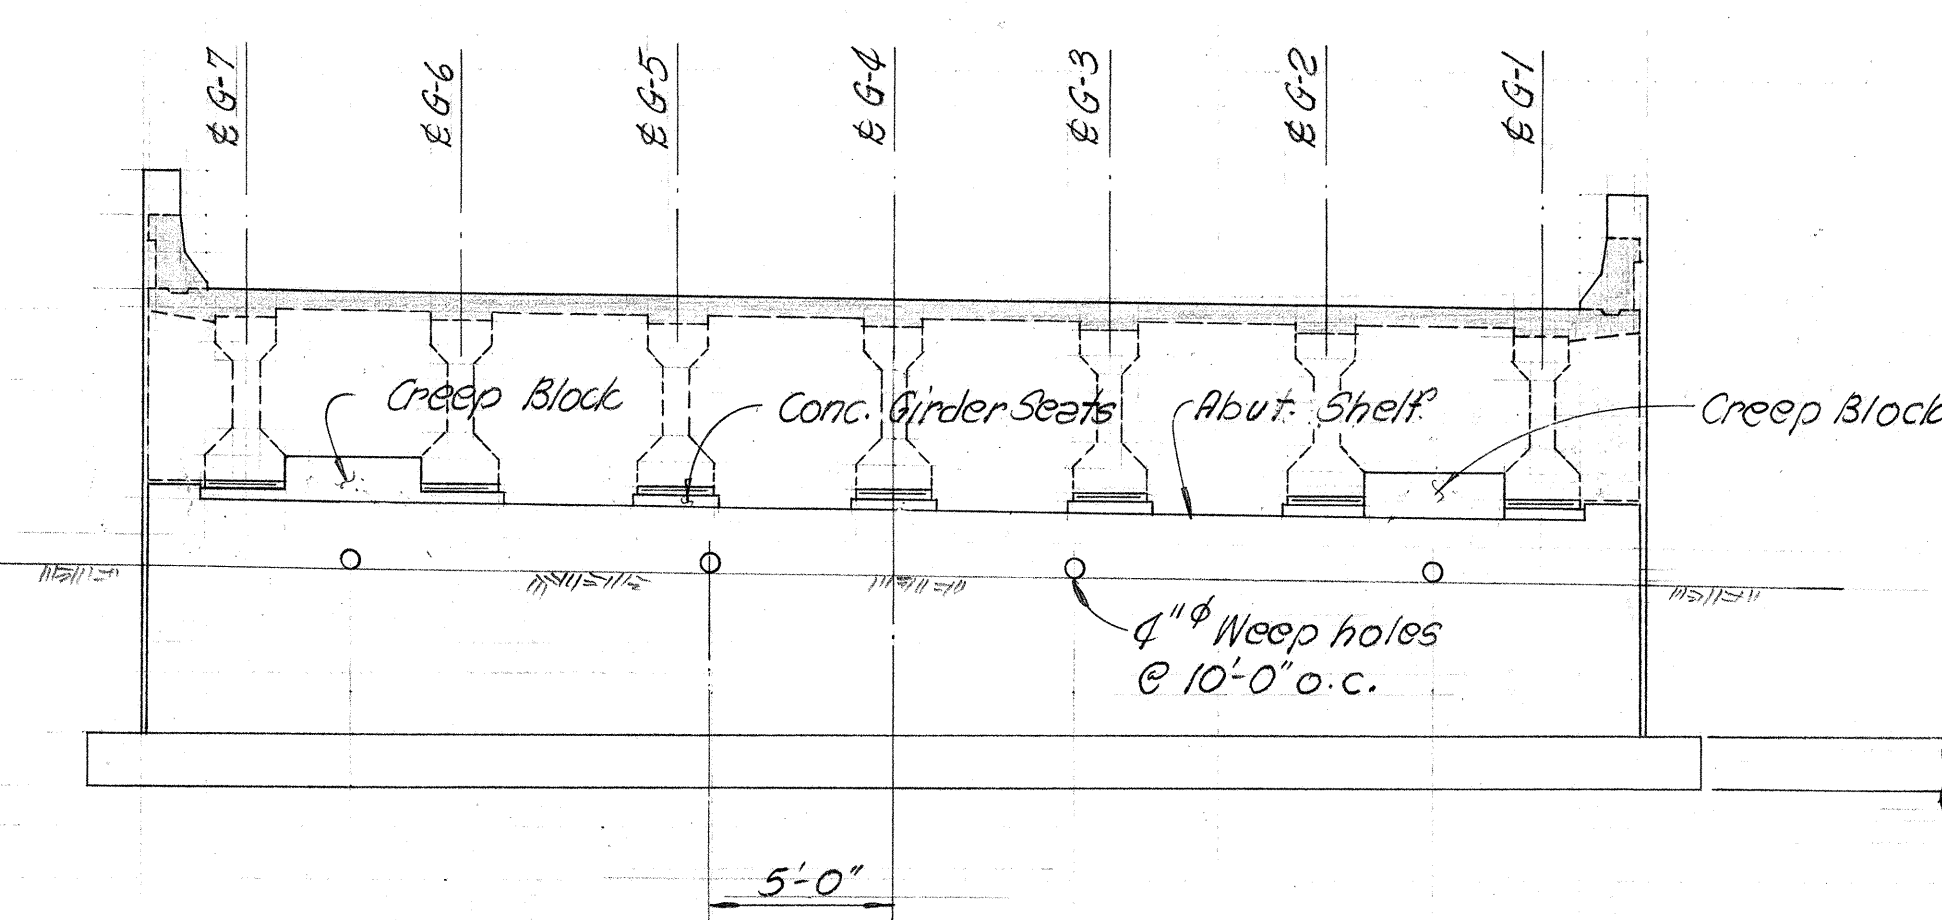


ABUTMENT #1 - ELEVATION "A" - "A"
Scale: 3/16" = 1'-0"

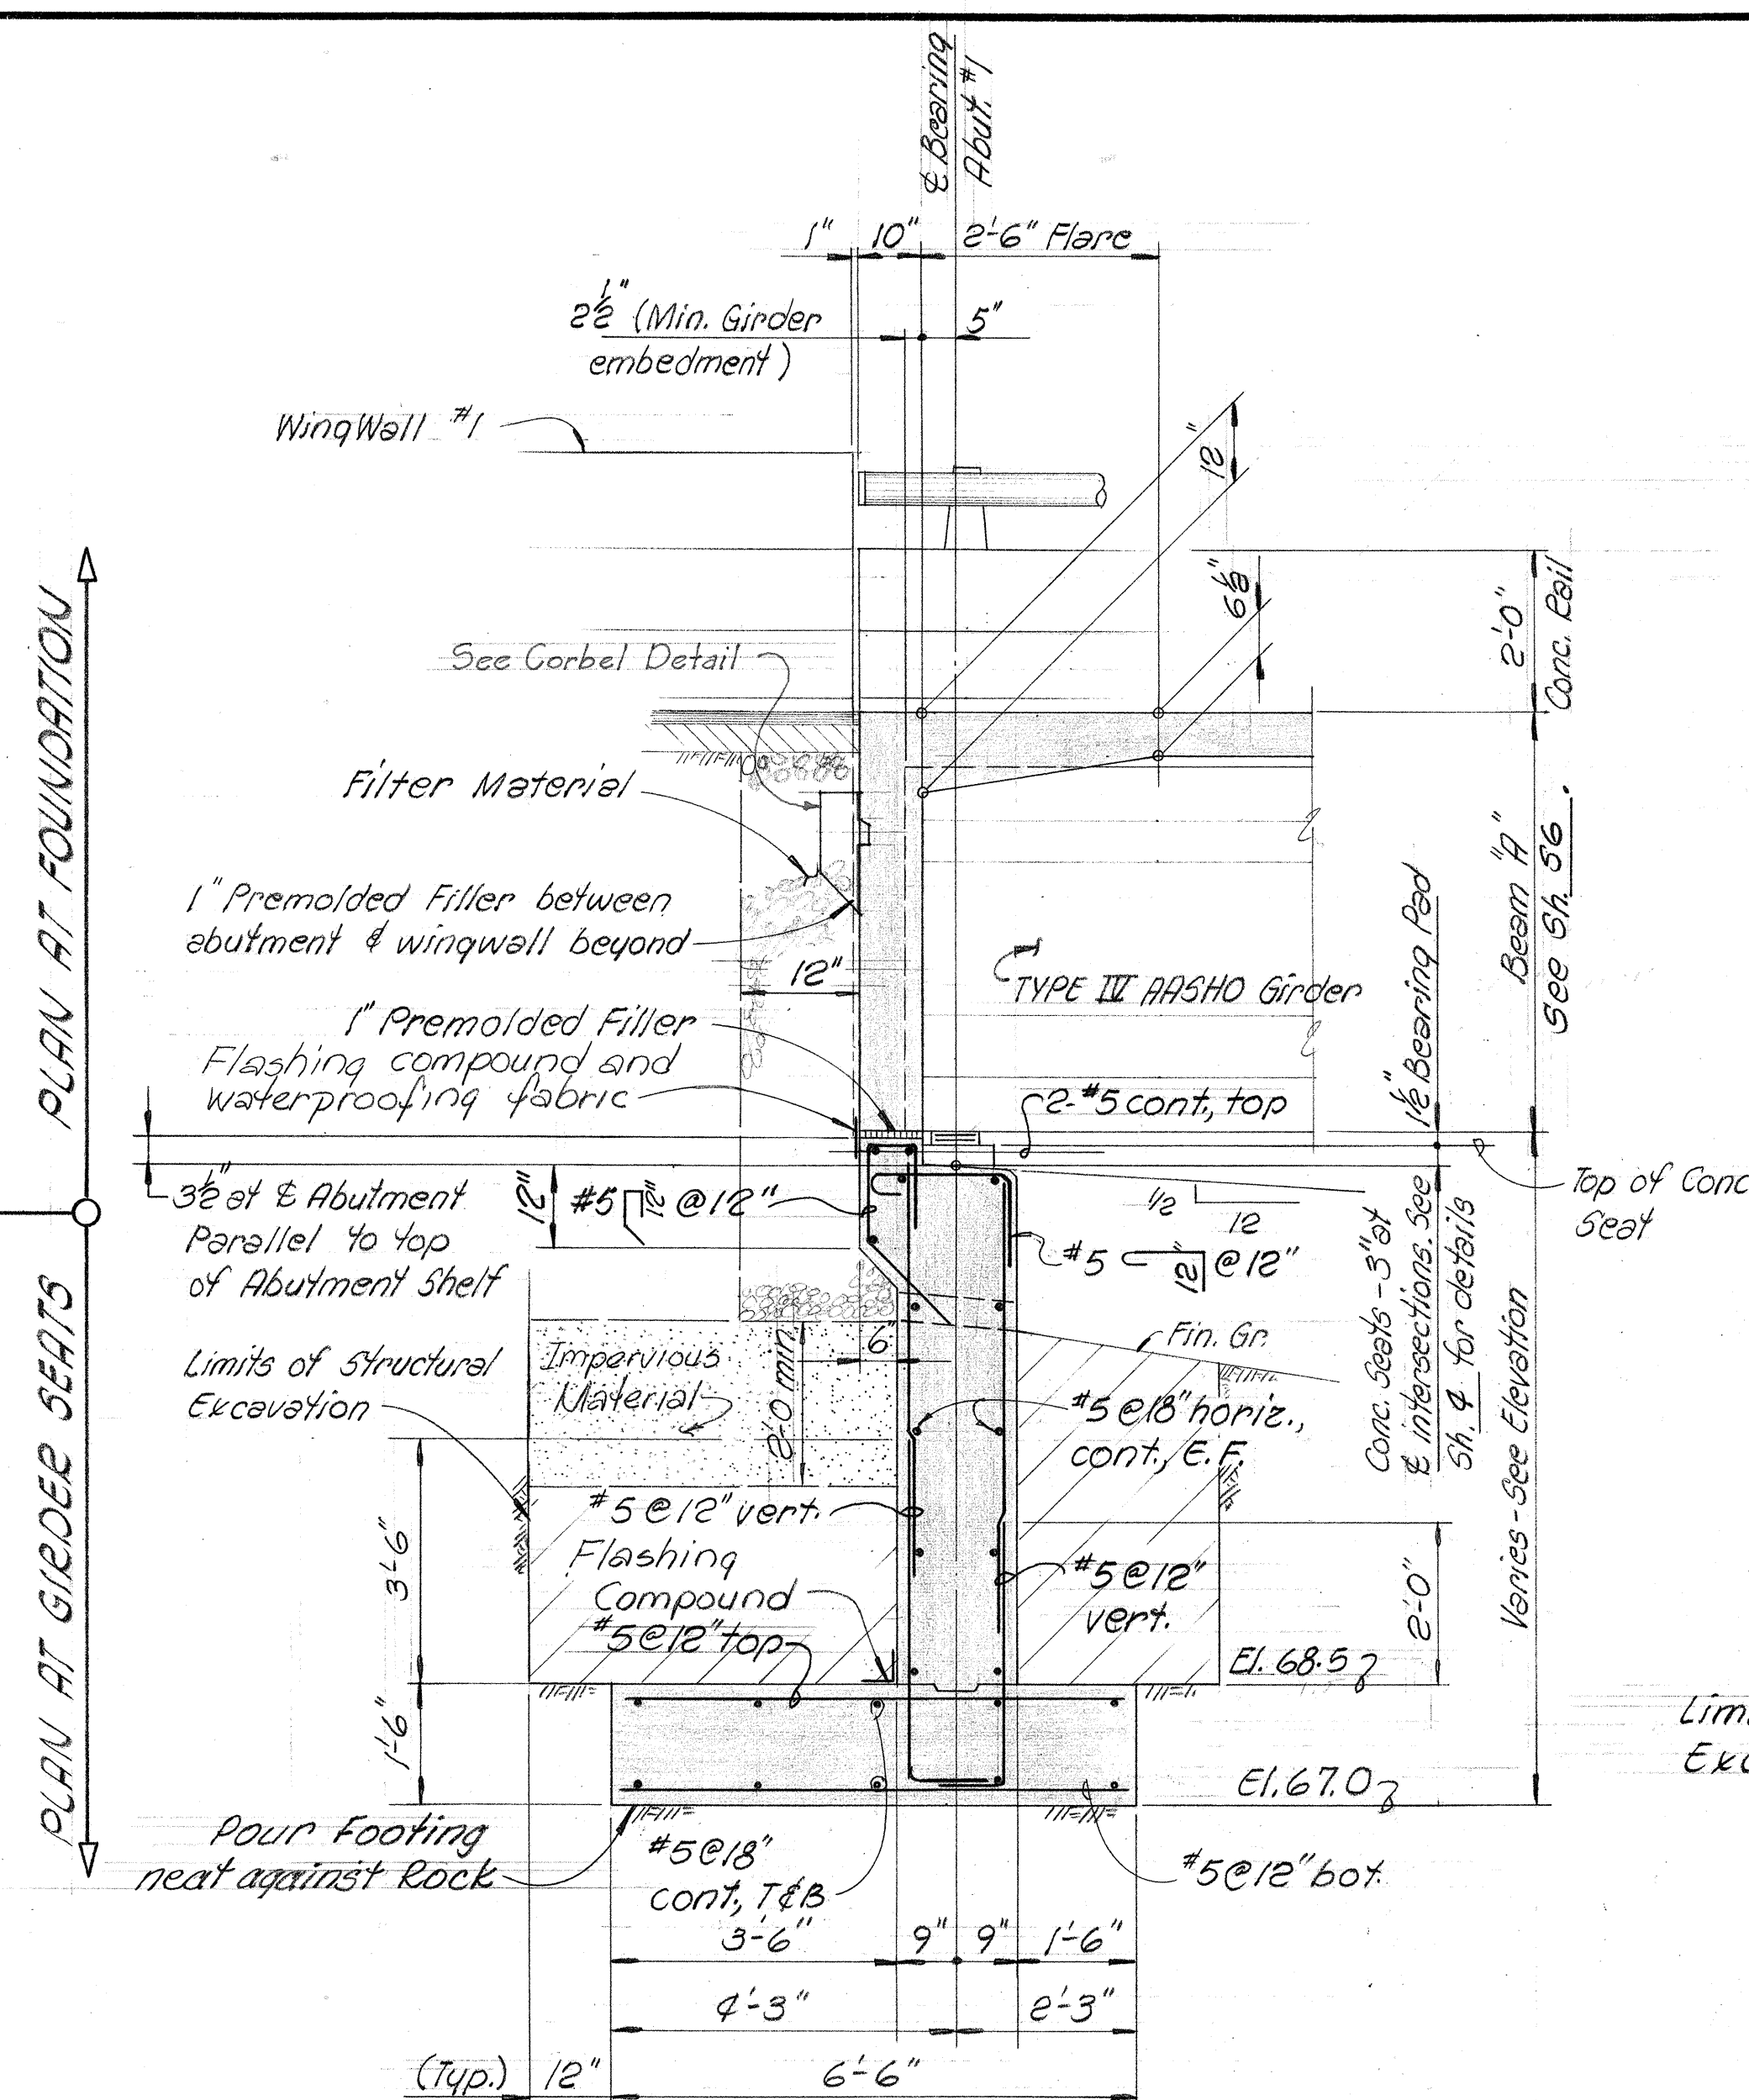


ABUTMENT #1 TYPICAL SECTION
Scale: 1/2" = 1'-0"

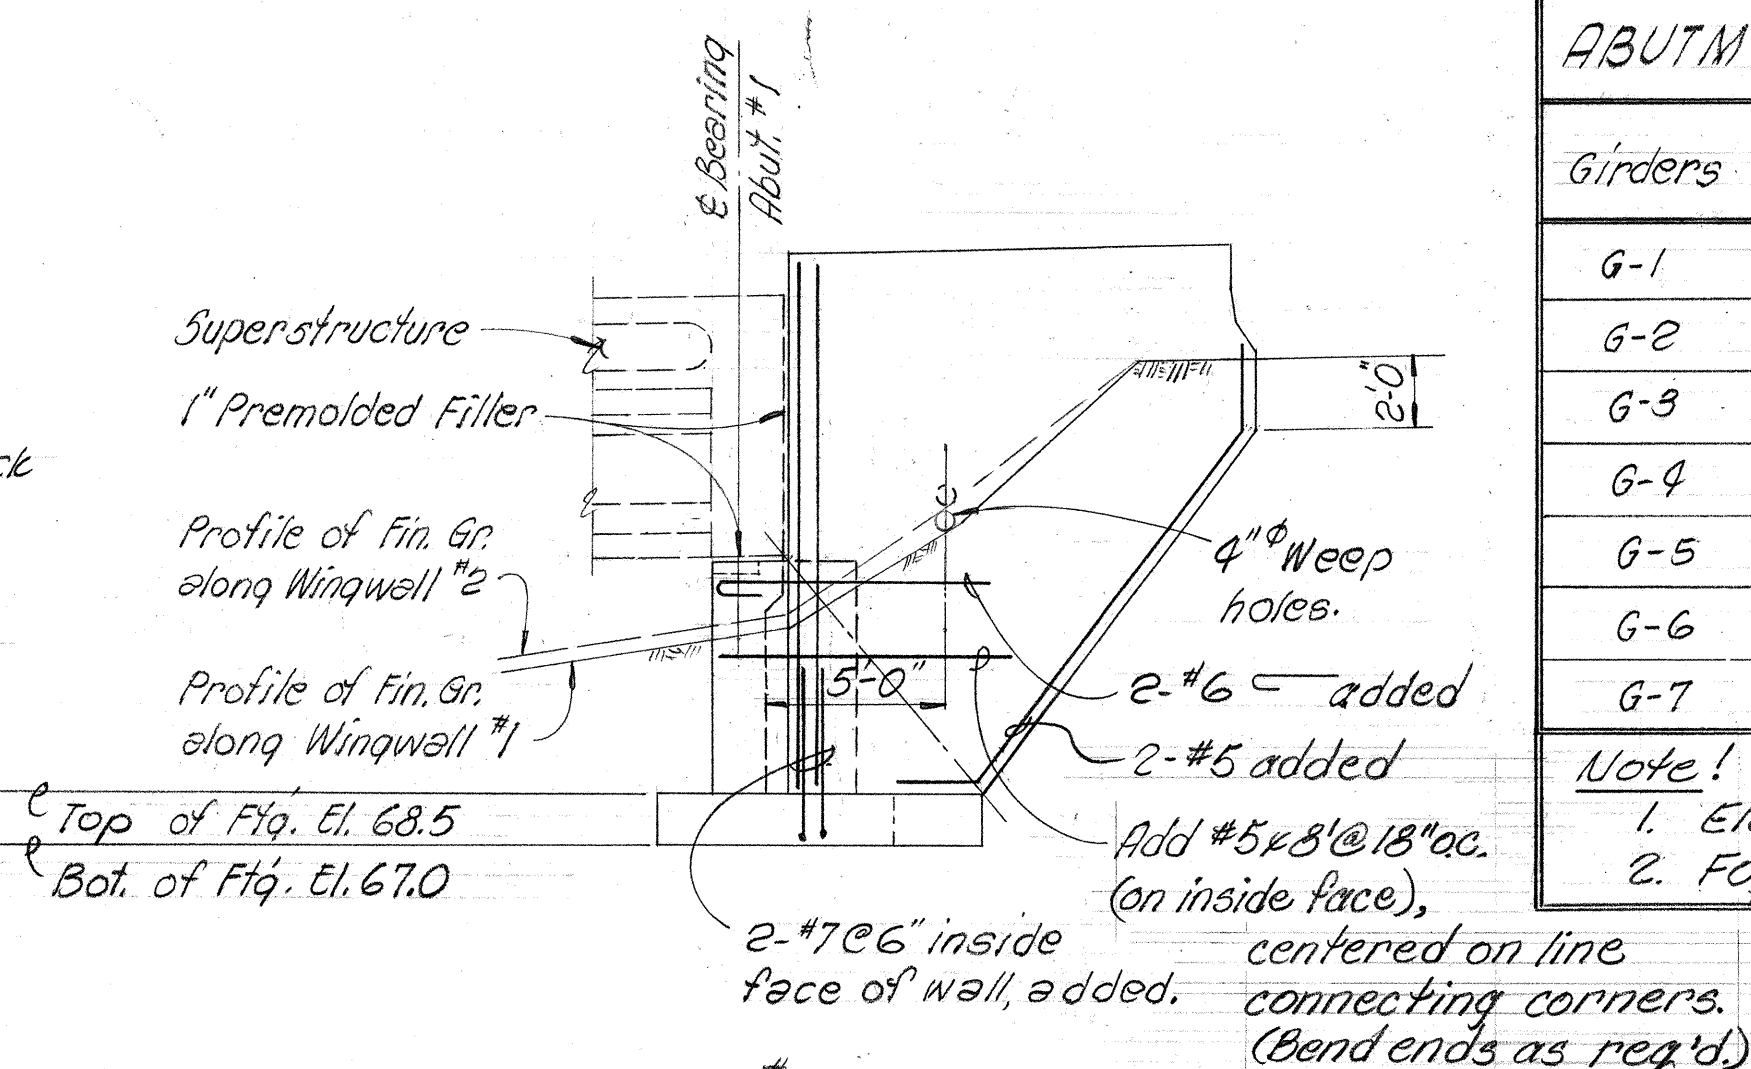

WINGWALL #1 ELEVATION
Scale: $\frac{3}{16}'' = 1'-0''$ (Wingwall #2 similar)

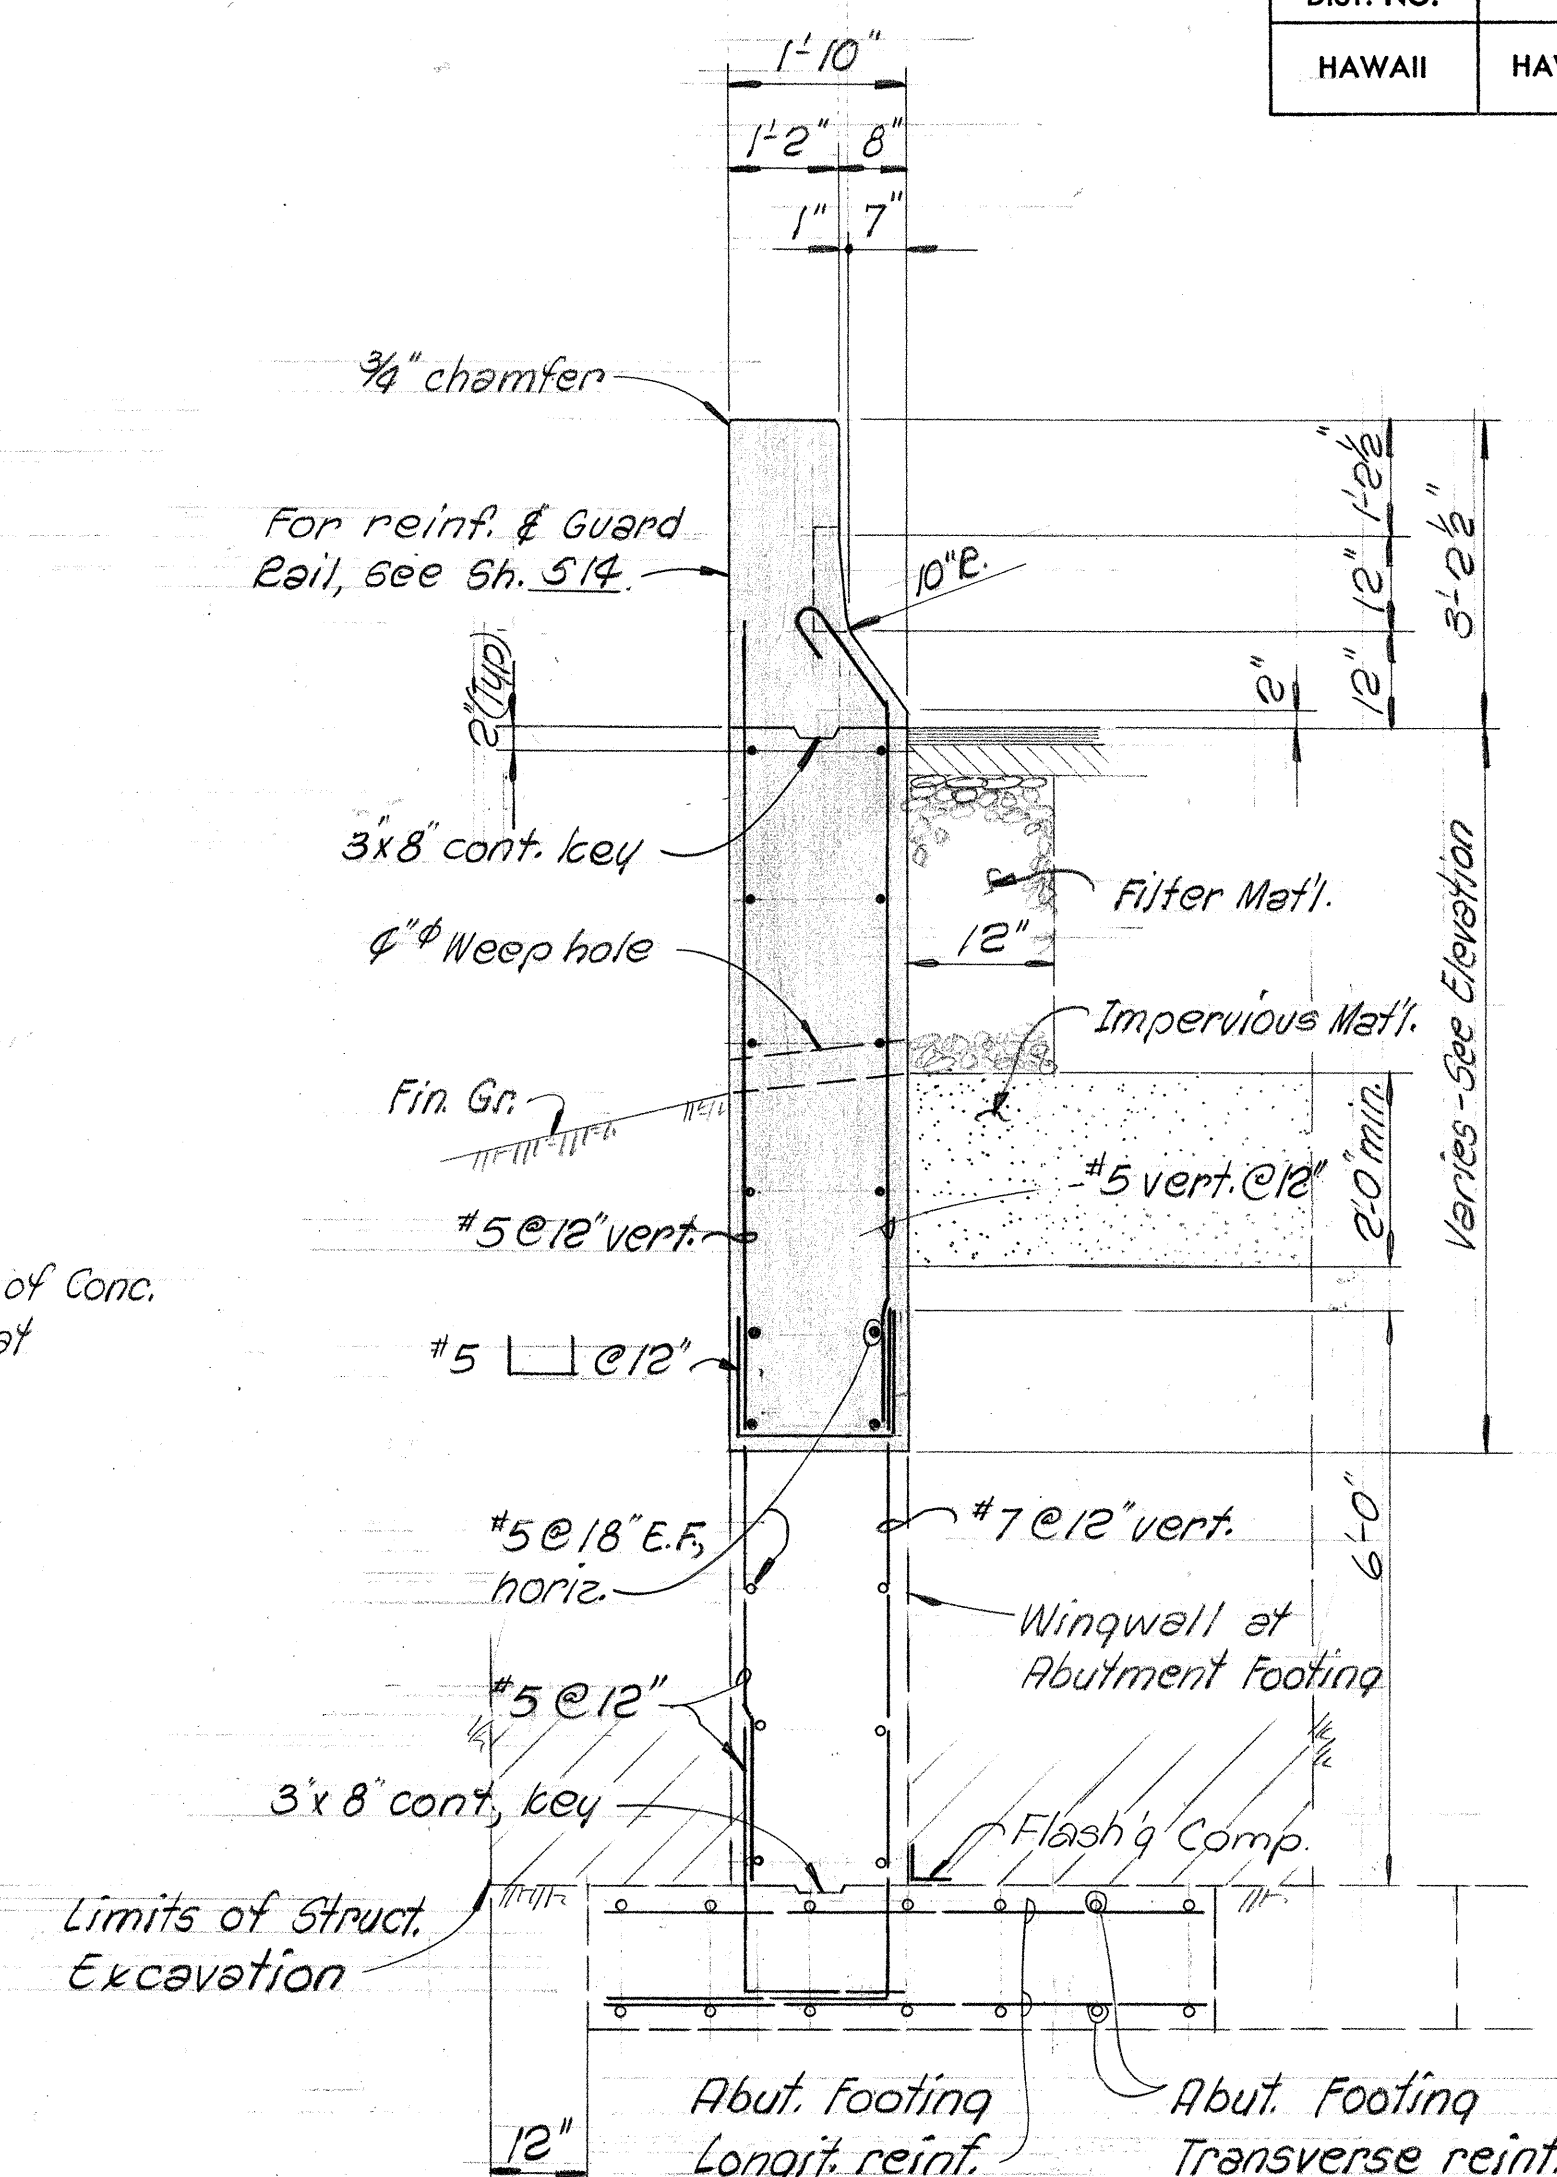

WINGWALL #1 TYPICAL SECTION
Scale: $\frac{1}{8}" = 1'-0"$ (Wingwall #2 similar) $\frac{1}{4}"$ seal (N.T.C.)

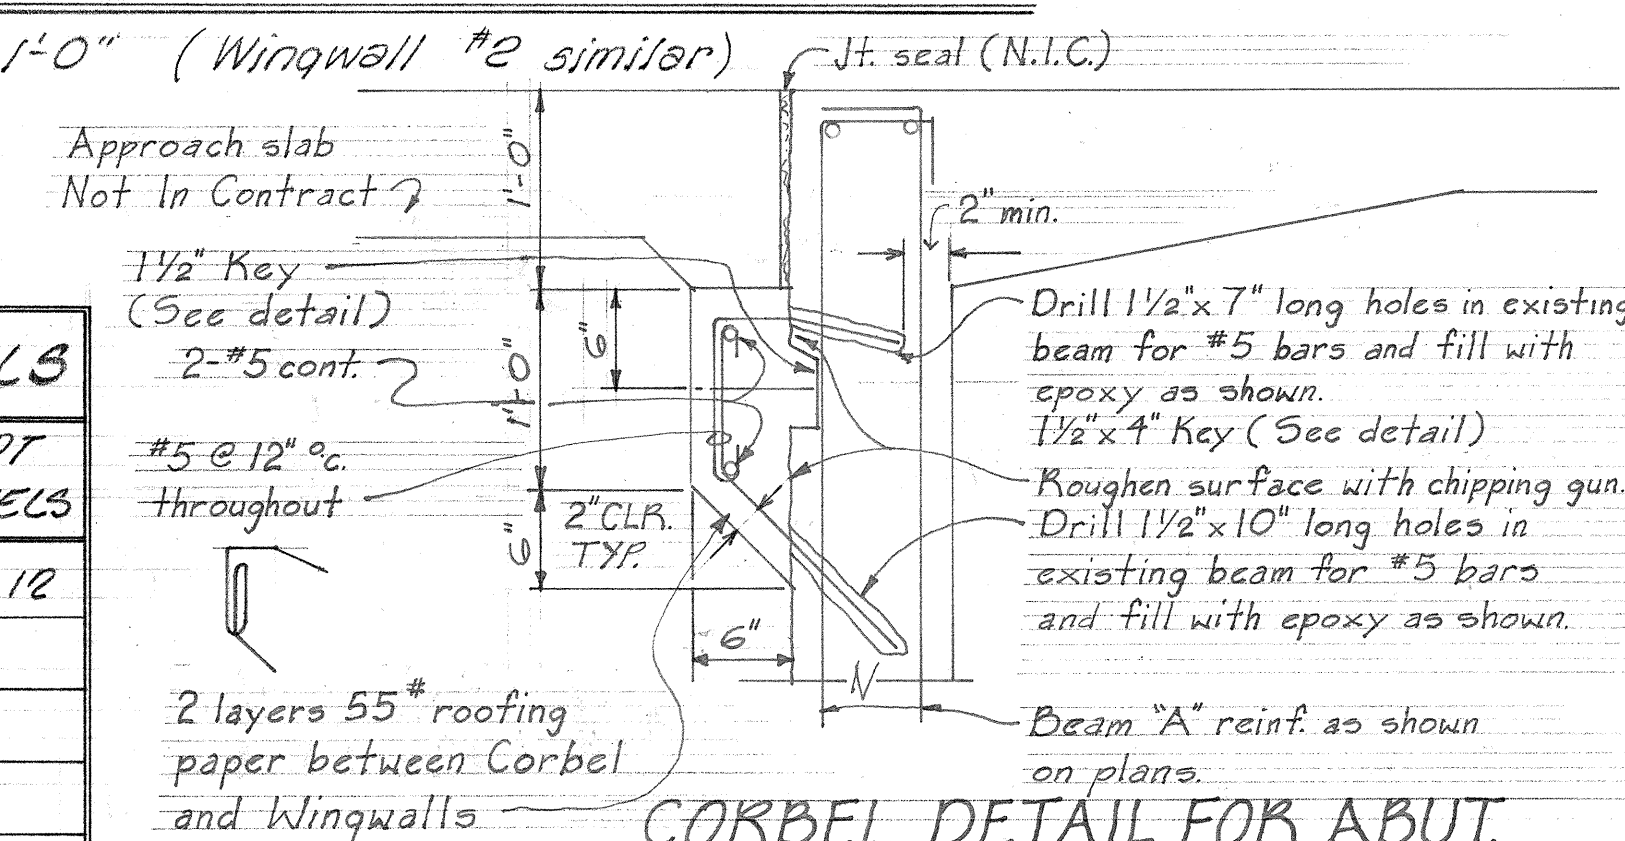


CORBEL DETAIL FOR ABUT.
Abut. No. 1 - Str. No. 13 / Abut. No. 2 - Str. No.

Girders	Top of Slab	Bot. of Girder	Top of Seat	SEAT BEVEL
G-1	79.62	74.33	74.20	-1/4" : 10
G-2	79.70	74.41	74.28	↑
G-3	79.78	74.49	74.36	
G-4	79.86	74.57	74.44	
G-5	79.94	74.65	74.52	↑
G-6	80.02	74.73	74.60	-1/4" : 10
G-7	80.10	74.81	74.68	-7/8 : 10

Note!

1. Elevations are at $\frac{1}{2}$ intersections
2. For Seat Detail, see Sht. 4.

SHIMAZU SHIMABUKURO & FUKUDA, INC.
Consulting Structural Engineers
1210 Ward Ave., Honolulu, HI 96814

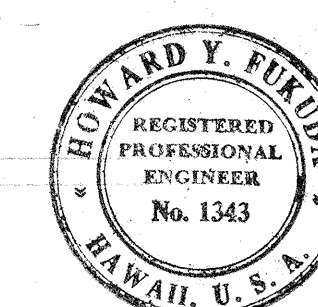

This work was prepared by
me or under my supervision.
Howard G. Fukuda

**STATE OF HAWAII
DEPARTMENT OF TRANSPORTATION
HIGHWAYS DIVISION**


STRUCTURE NO. 13
ABUTMENT #1 & WINGWALLS #1 & #2
PLAN & SECTION

WAIAWA INTERCHANGE
F.A.I. Proj. No. I-HI-1 (75):8


Scale : As shown Date : JUNE, 1966

SHEET No. 3 OF 12 SHEETS


FED. ROAD DIST. NO.	STATE	FED. AID PROJ. NO.	FISCAL YEAR	SHEET NO.	TOTAL SHEETS
HAWAII	HAW.	I-HI-1(75):8	1969	72	181

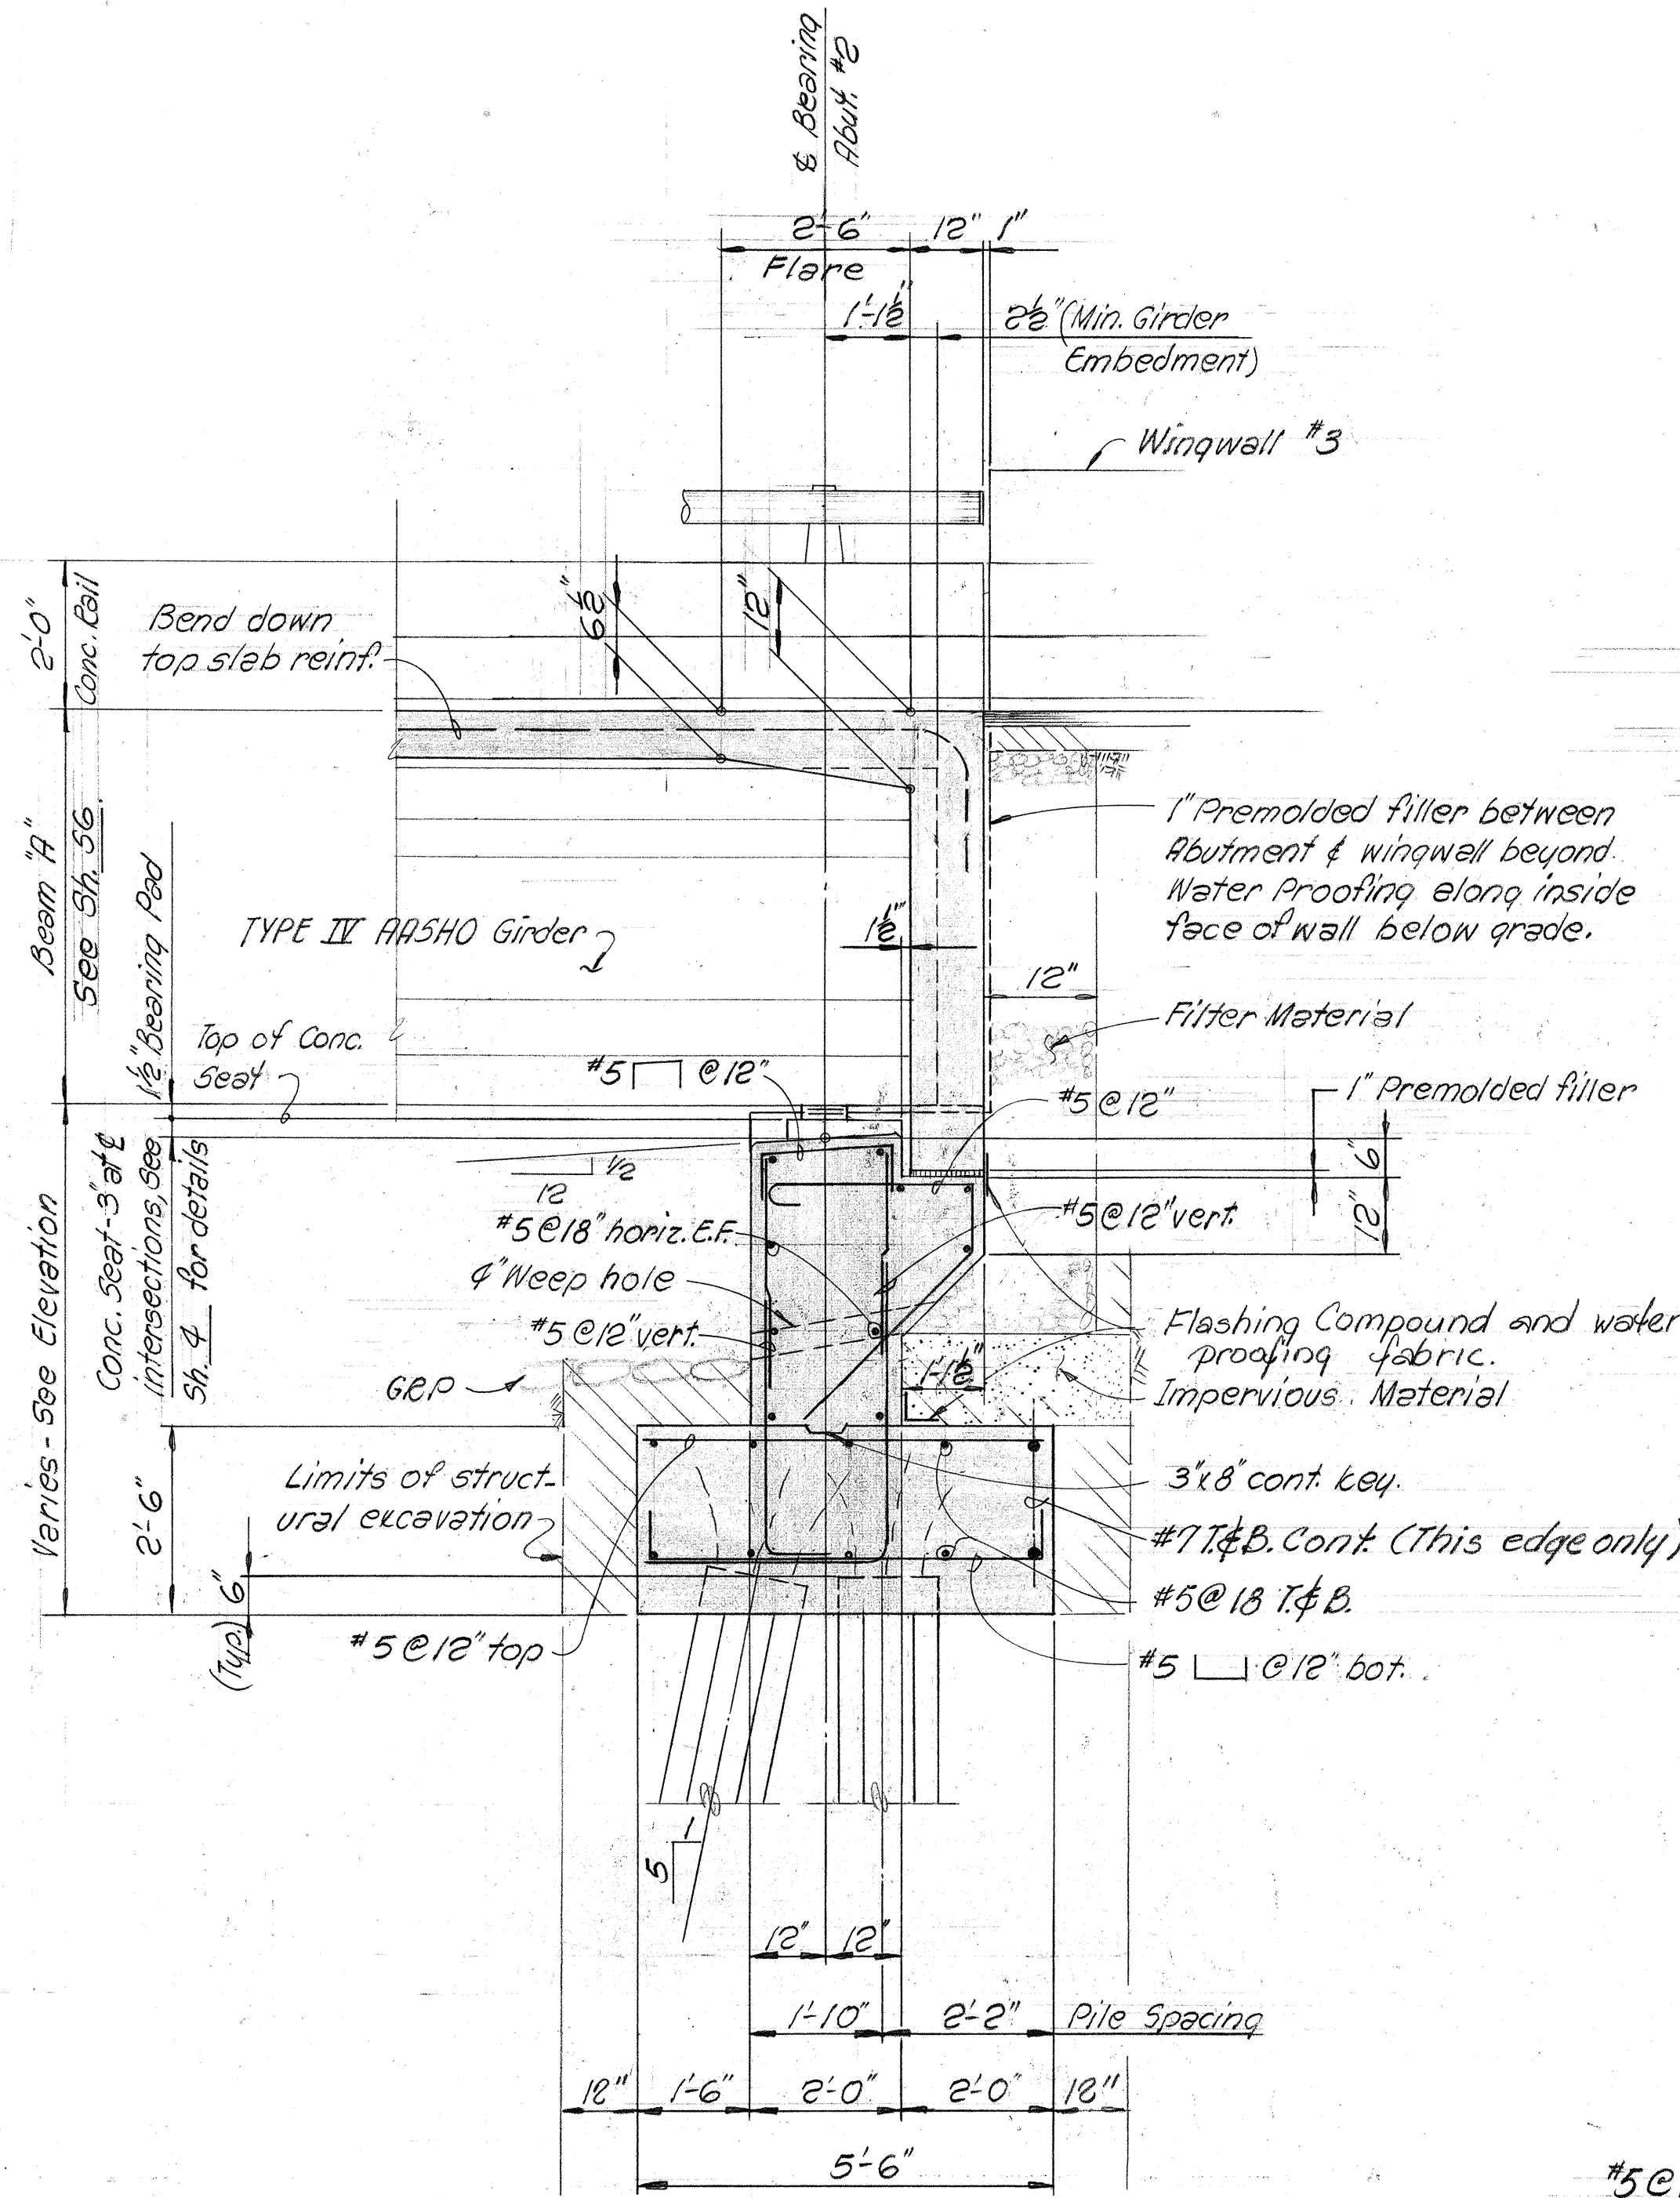


ABUTMENT #2 TYPICAL SECTION
Scale: 1/2" = 1'-0"

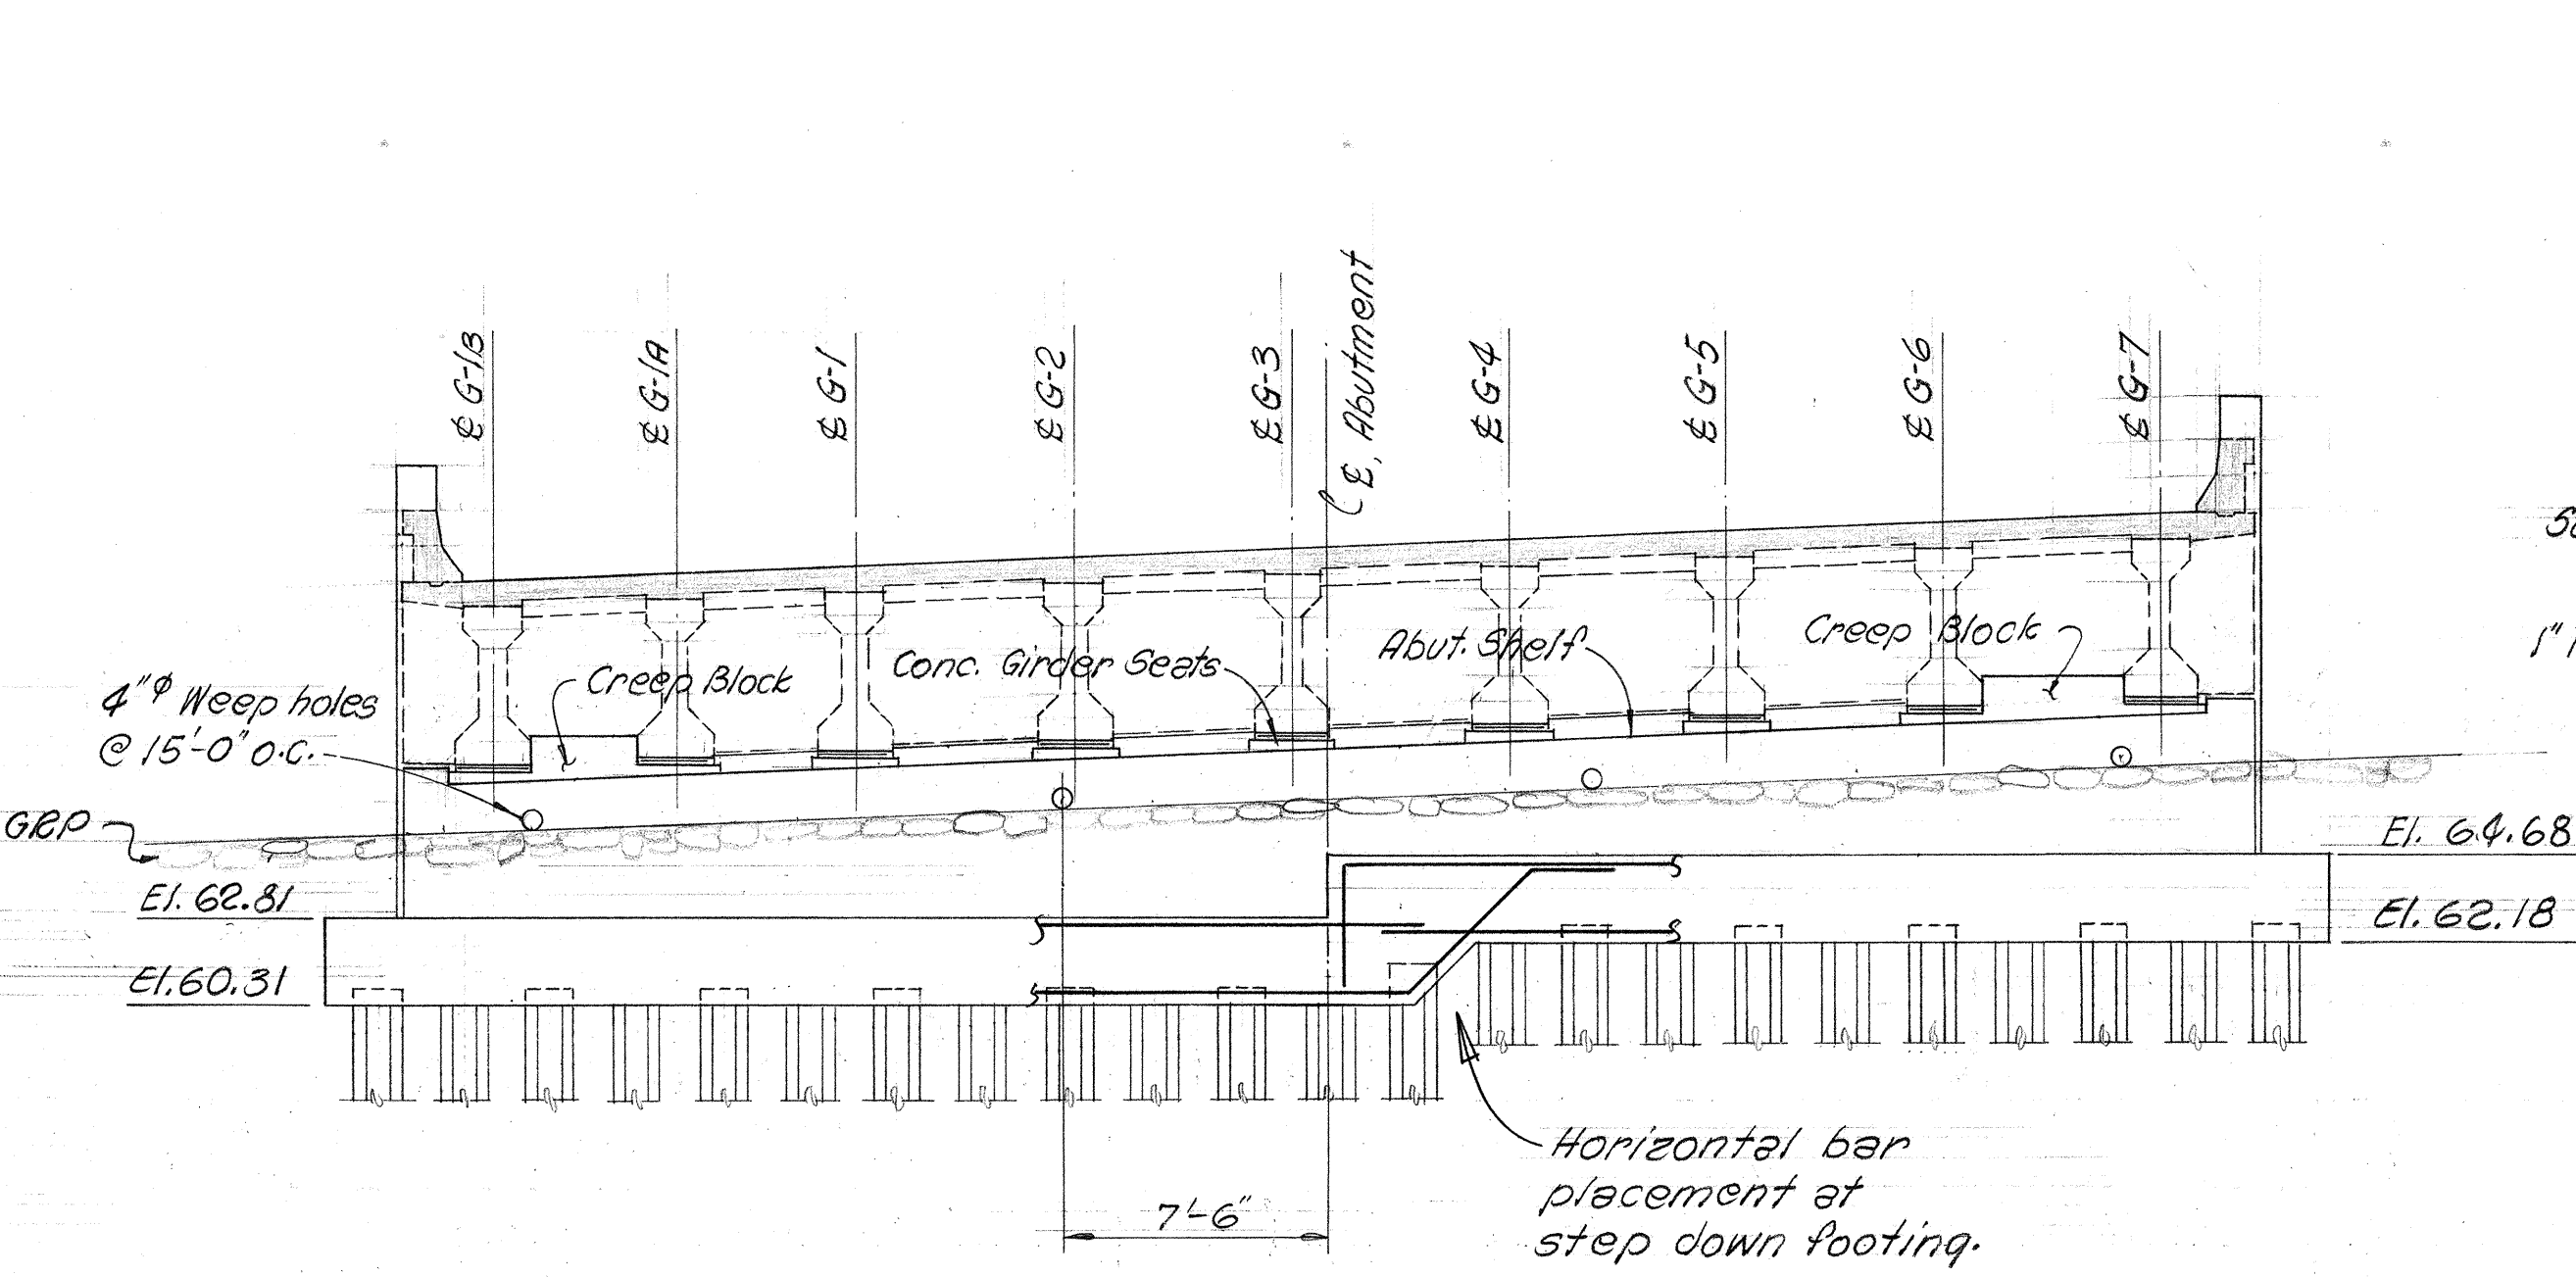


ABUTMENT #2 - ELEVATION "B"-B"
Scale: 3/16" = 1'-0"

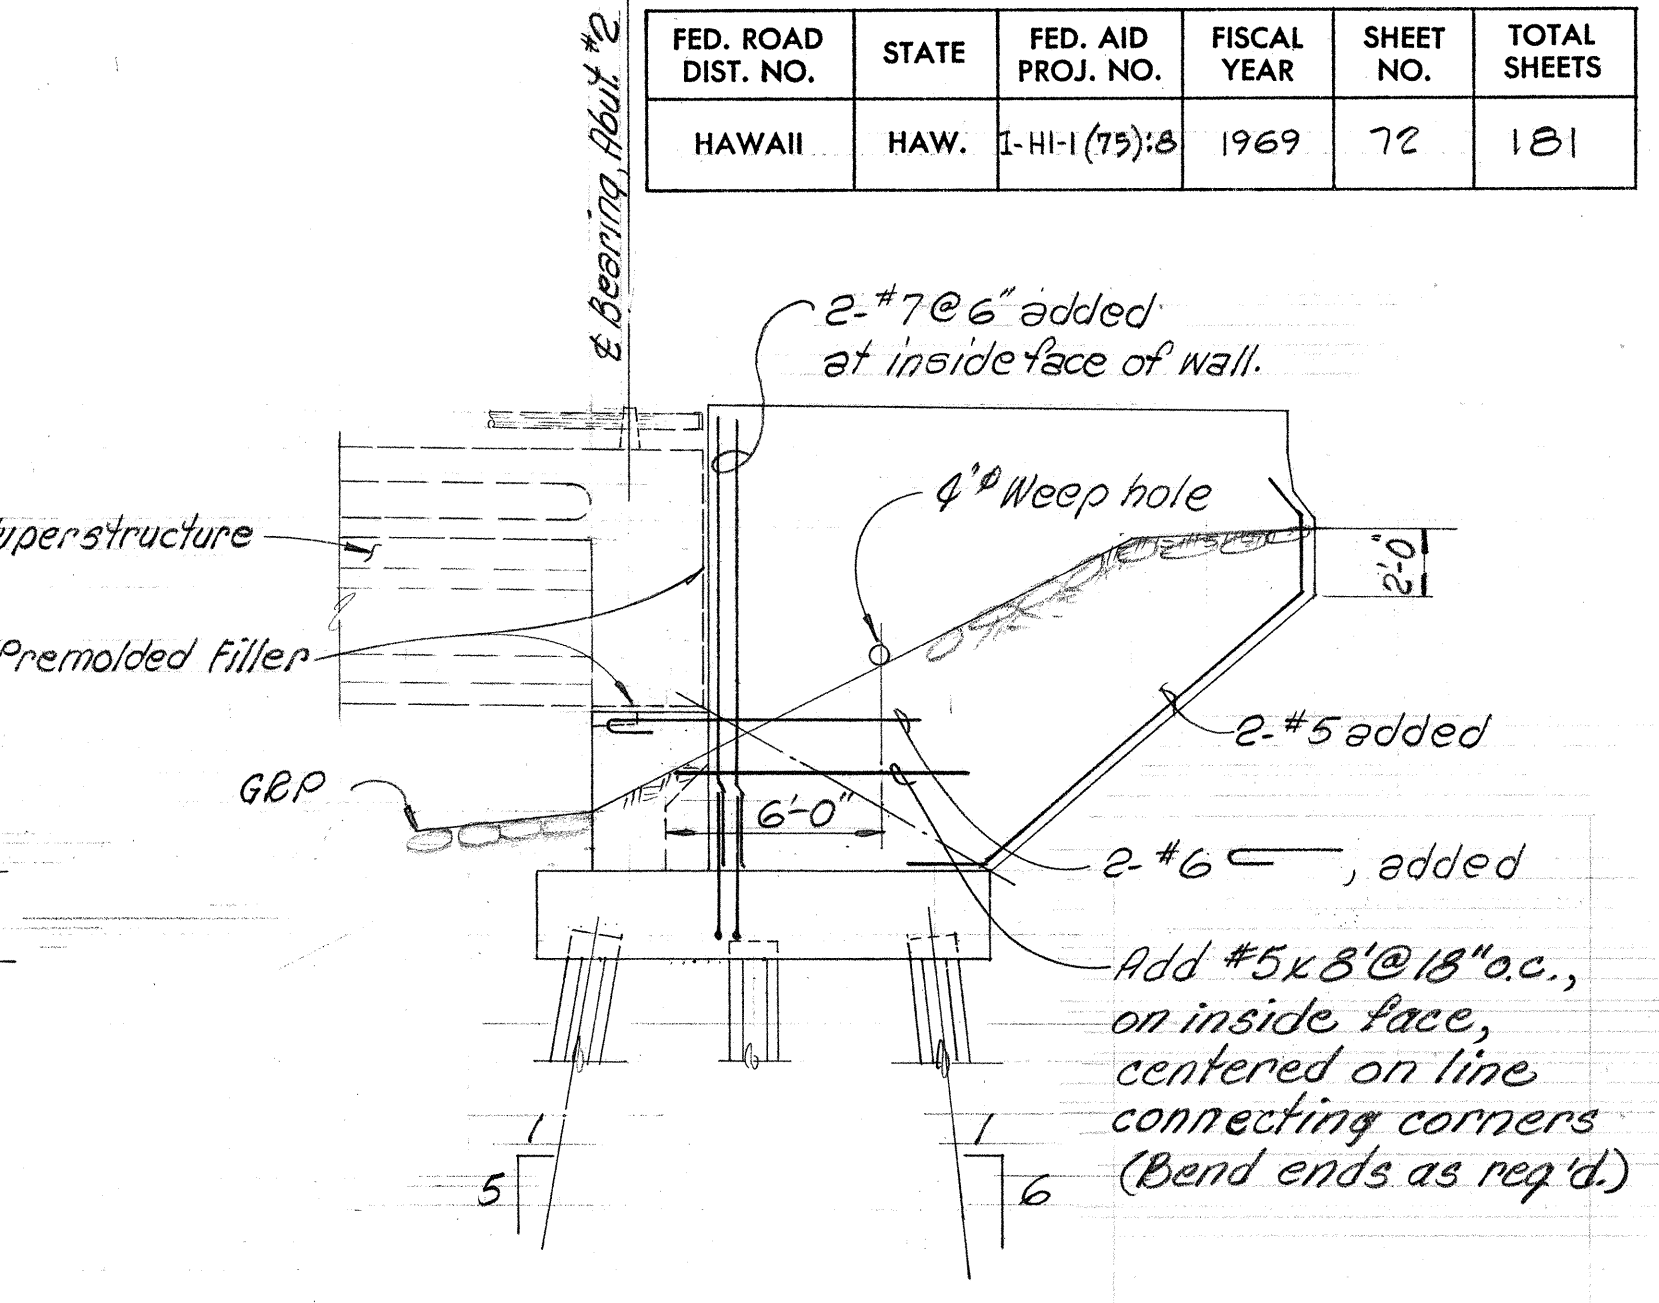


WINGWALL #4 ELEVATION
Scale: 3/16" = 1'-0" (Wingwall #3 similar)

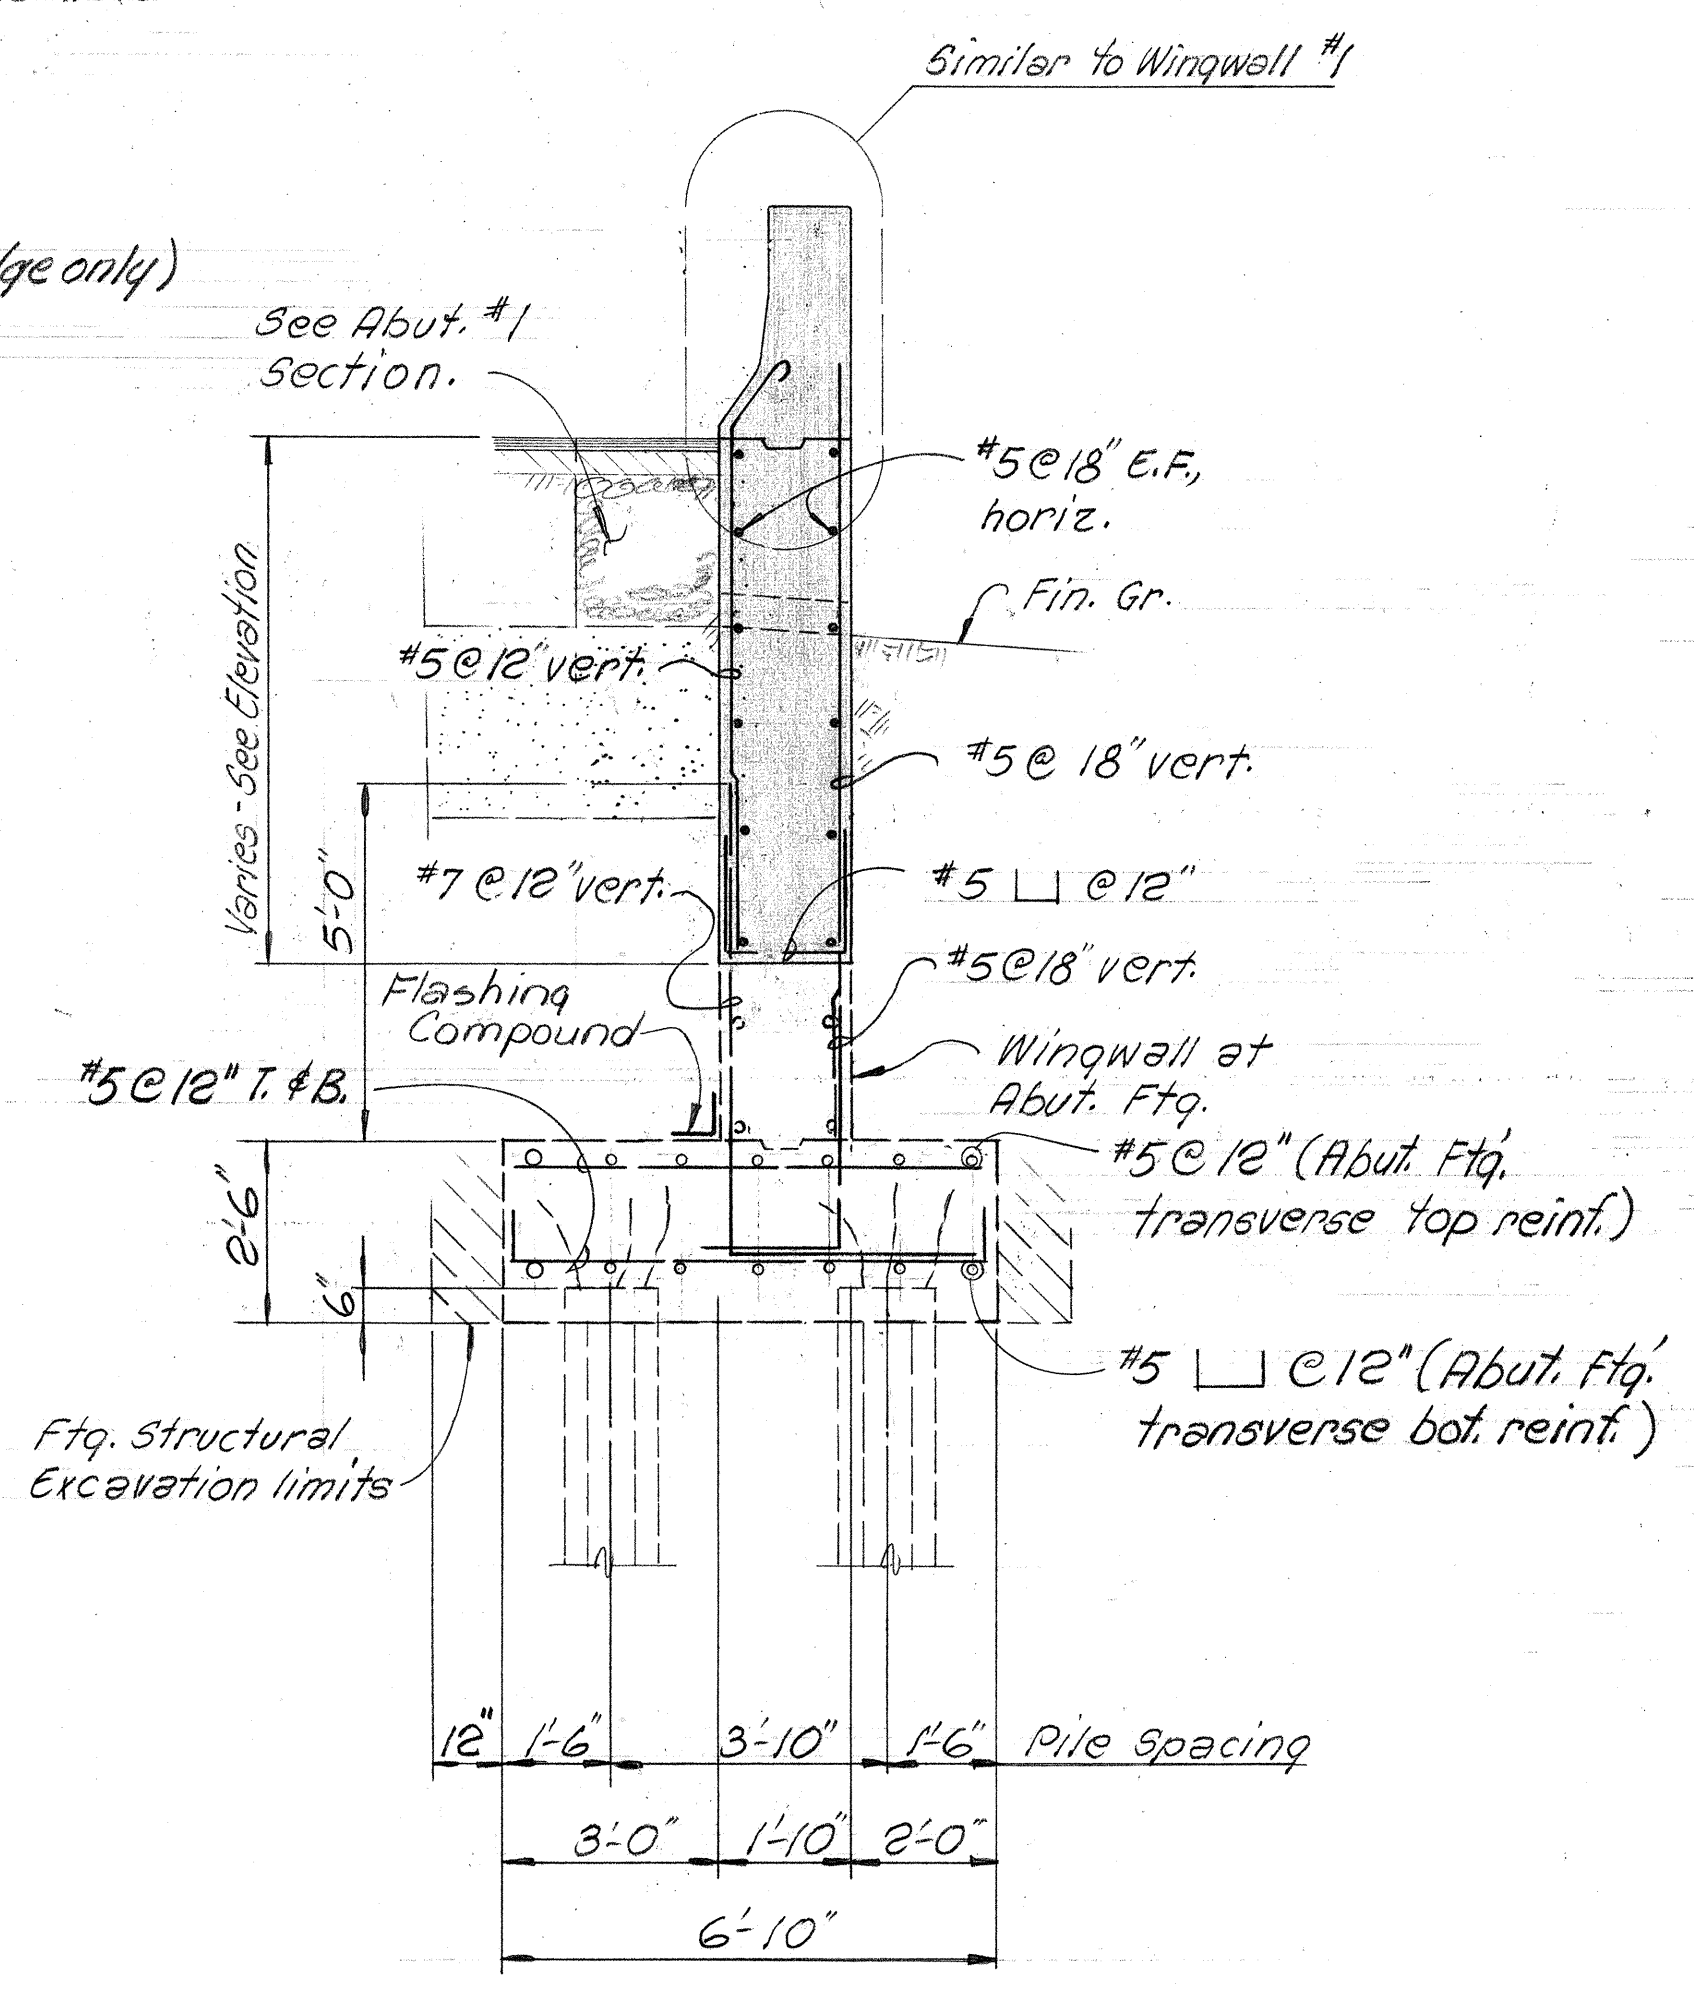

WINGWALL #4 TYPICAL SECTION
Scale: 3/8" = 1'-0" (Wingwall #3 similar)

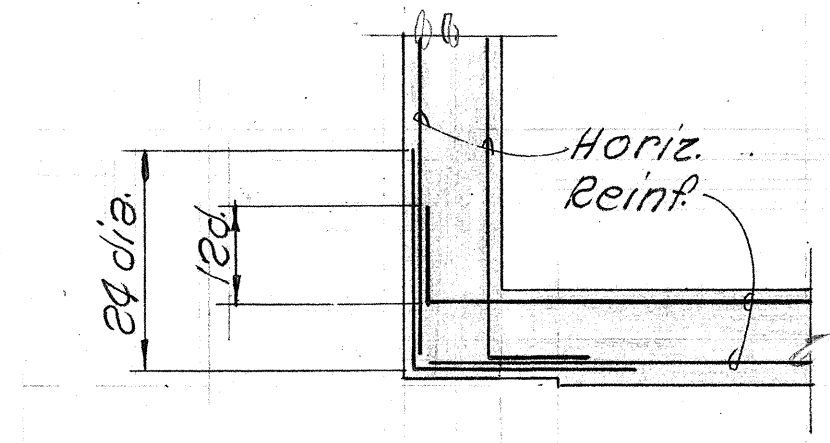

ABUT. WALL CORNER TYPICAL REINF. LAYOUT
N.T.S.

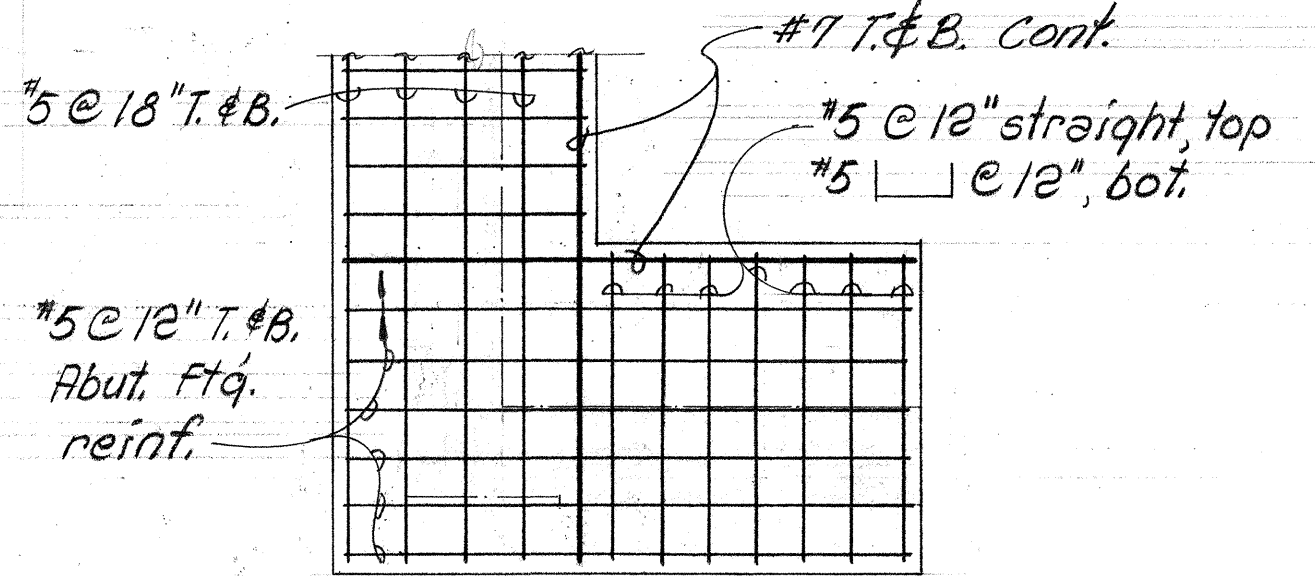


ABUT. #2 FOOTING CORNER REINF. LAYOUT
N.T.S.

ABUTMENT #2 ELEVATIONS & SEAT BEVELS

Girders	Top of Slab	Bot of Girder	Top of Seat	Seat Bevel
G-1B	72.31	67.01	66.89	-1/32:12
G-1A	72.50	67.21	67.09	-1/32:12
G-1	72.70	67.41	67.29	-3/16:12
G-2	72.95	67.66	67.53	-3/16:12
G-3	73.20	67.90	67.78	-5/32:12
G-4	73.44	68.15	68.02	-5/32:12
G-5	73.69	68.39	68.27	-1/8:12
G-6	73.93	68.64	68.52	-1/8:12
G-7	74.18	68.89	68.78	-3/32:12

Note:
1. Elevations are at E intersections.
2. For seat detail, see Sht. 4.

SURVEY PLOTTED BY	DATE
DRAWN BY	
DESIGNED BY	
QUANTITIES BY	
CHECKED BY	
ORIGINAL PLAN	
NOTE BOOK	
No.	

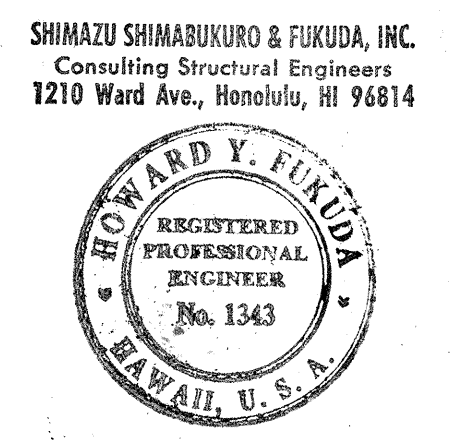

This work was prepared by me or under my supervision.
Howard Y. Fukuda


STATE OF HAWAII
DEPARTMENT OF TRANSPORTATION
HIGHWAYS DIVISION

STRUCTURE No. 13
ABUTMENT #2 & WINGWALL #3 & #4
ELEVATIONS & SECTIONS


WAIKAWA INTERCHANGE
F.A.I. Proj. No. I-HI-1 (75):8

Scale: As shown Date: JUNE, 1969
SHEET No. 5 OF 12 SHEETS

FED. ROAD DIST. NO.	STATE	FED. AID PROJ. NO.	FISCAL YEAR	SHEET NO.	TOTAL SHEETS
HAWAII	HAW.	I-HI-(75)8	1969	73	181

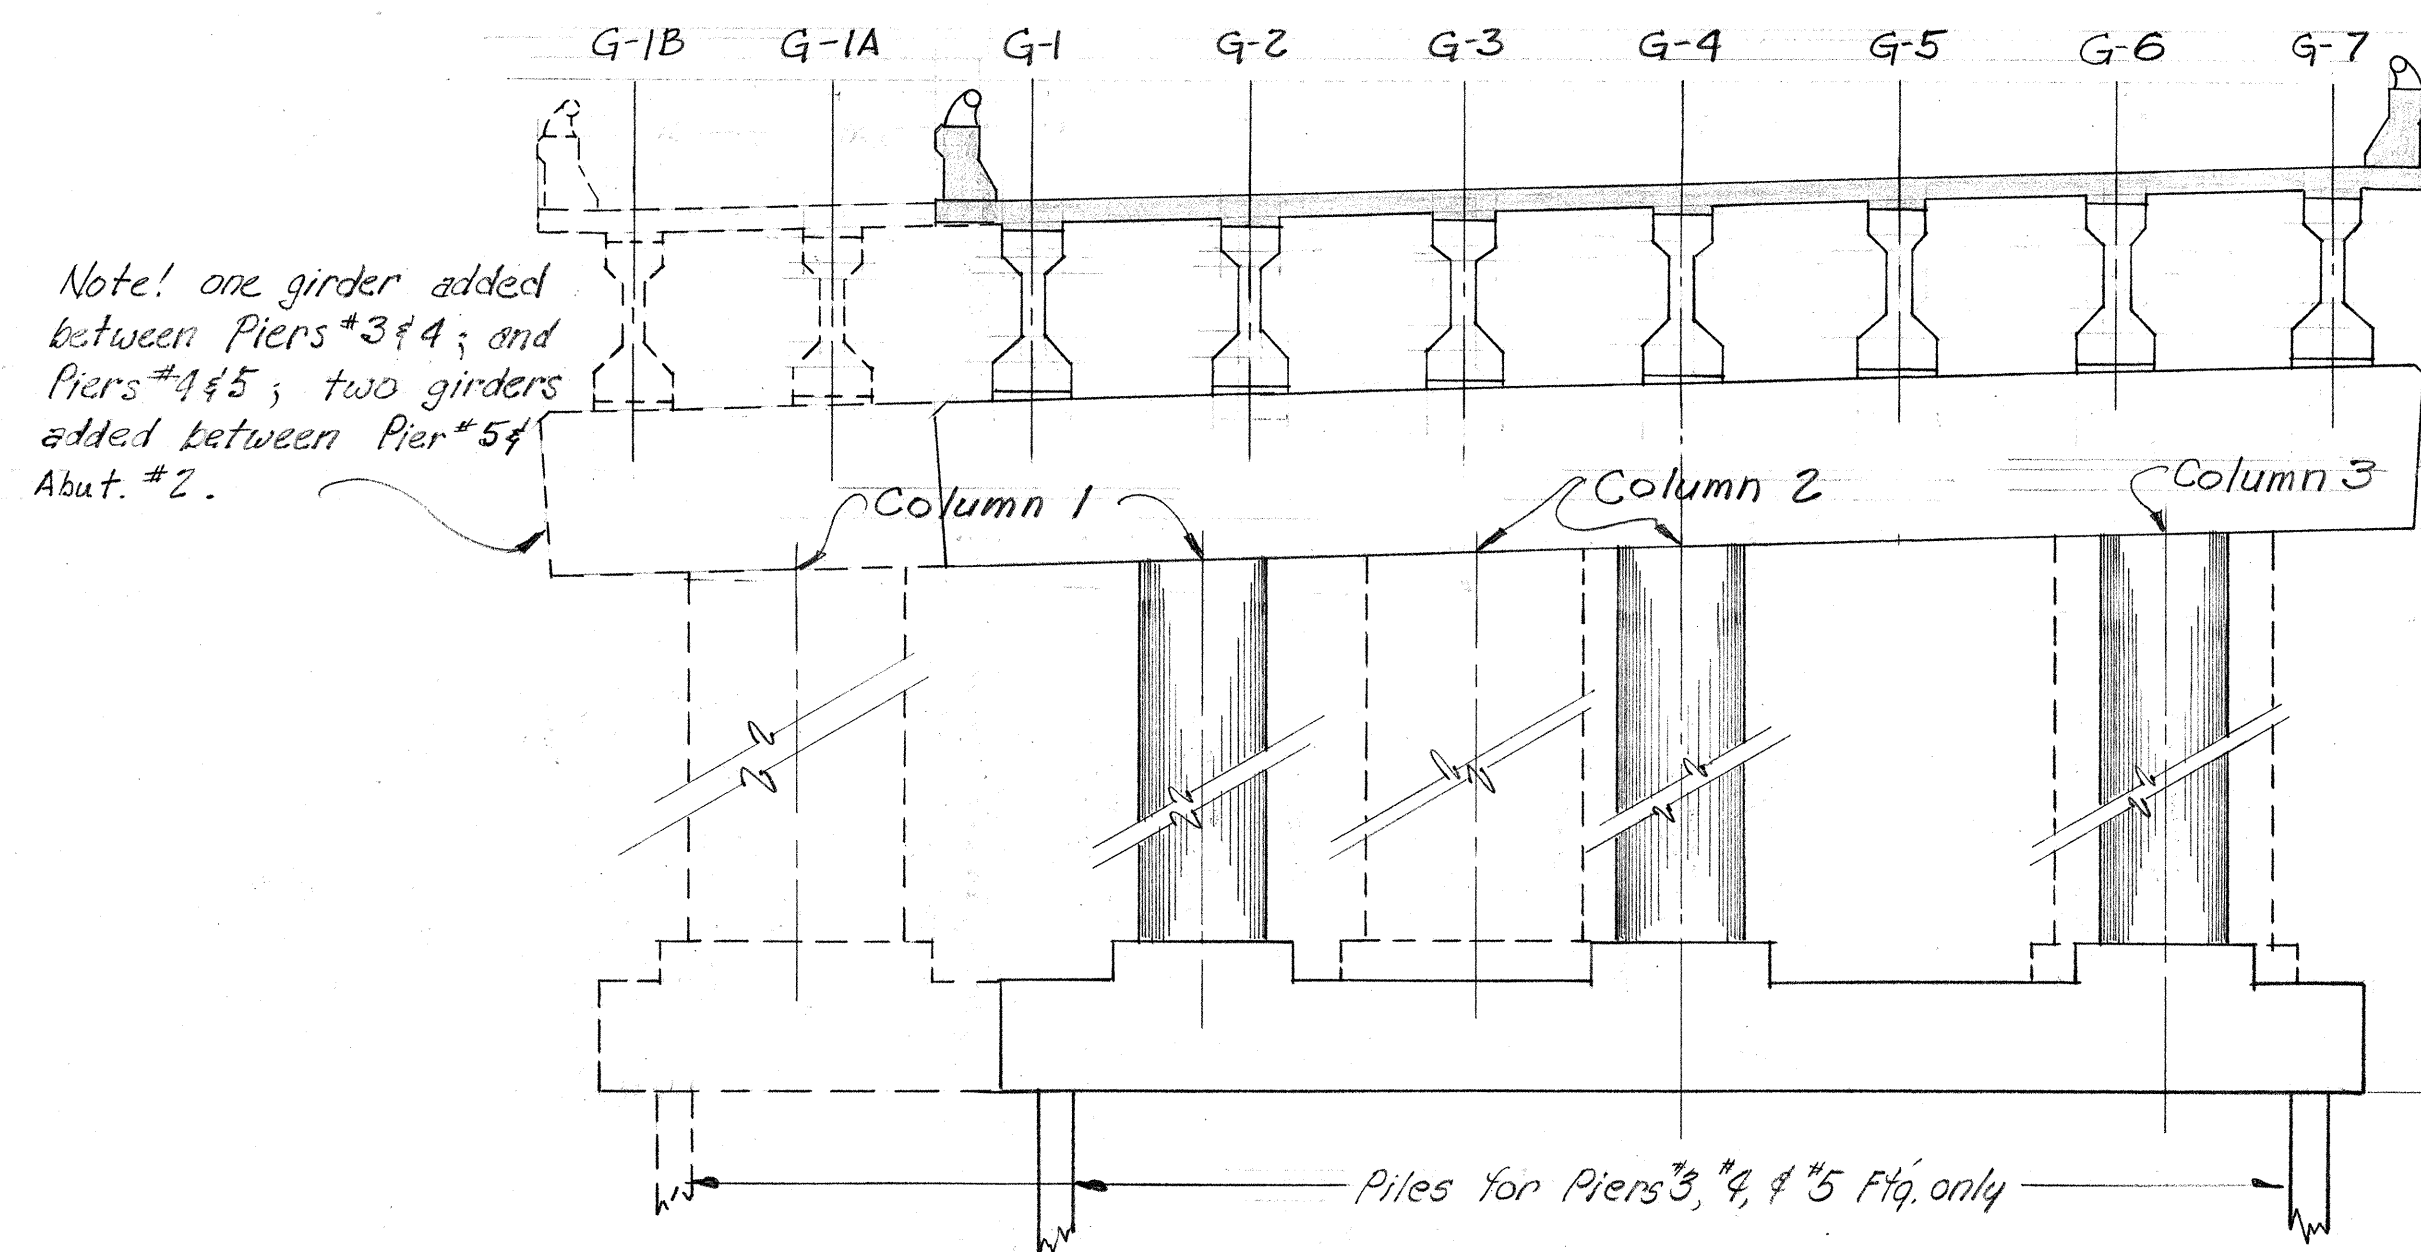

SCHEMATIC PIER ELEVATION "C"-"C"

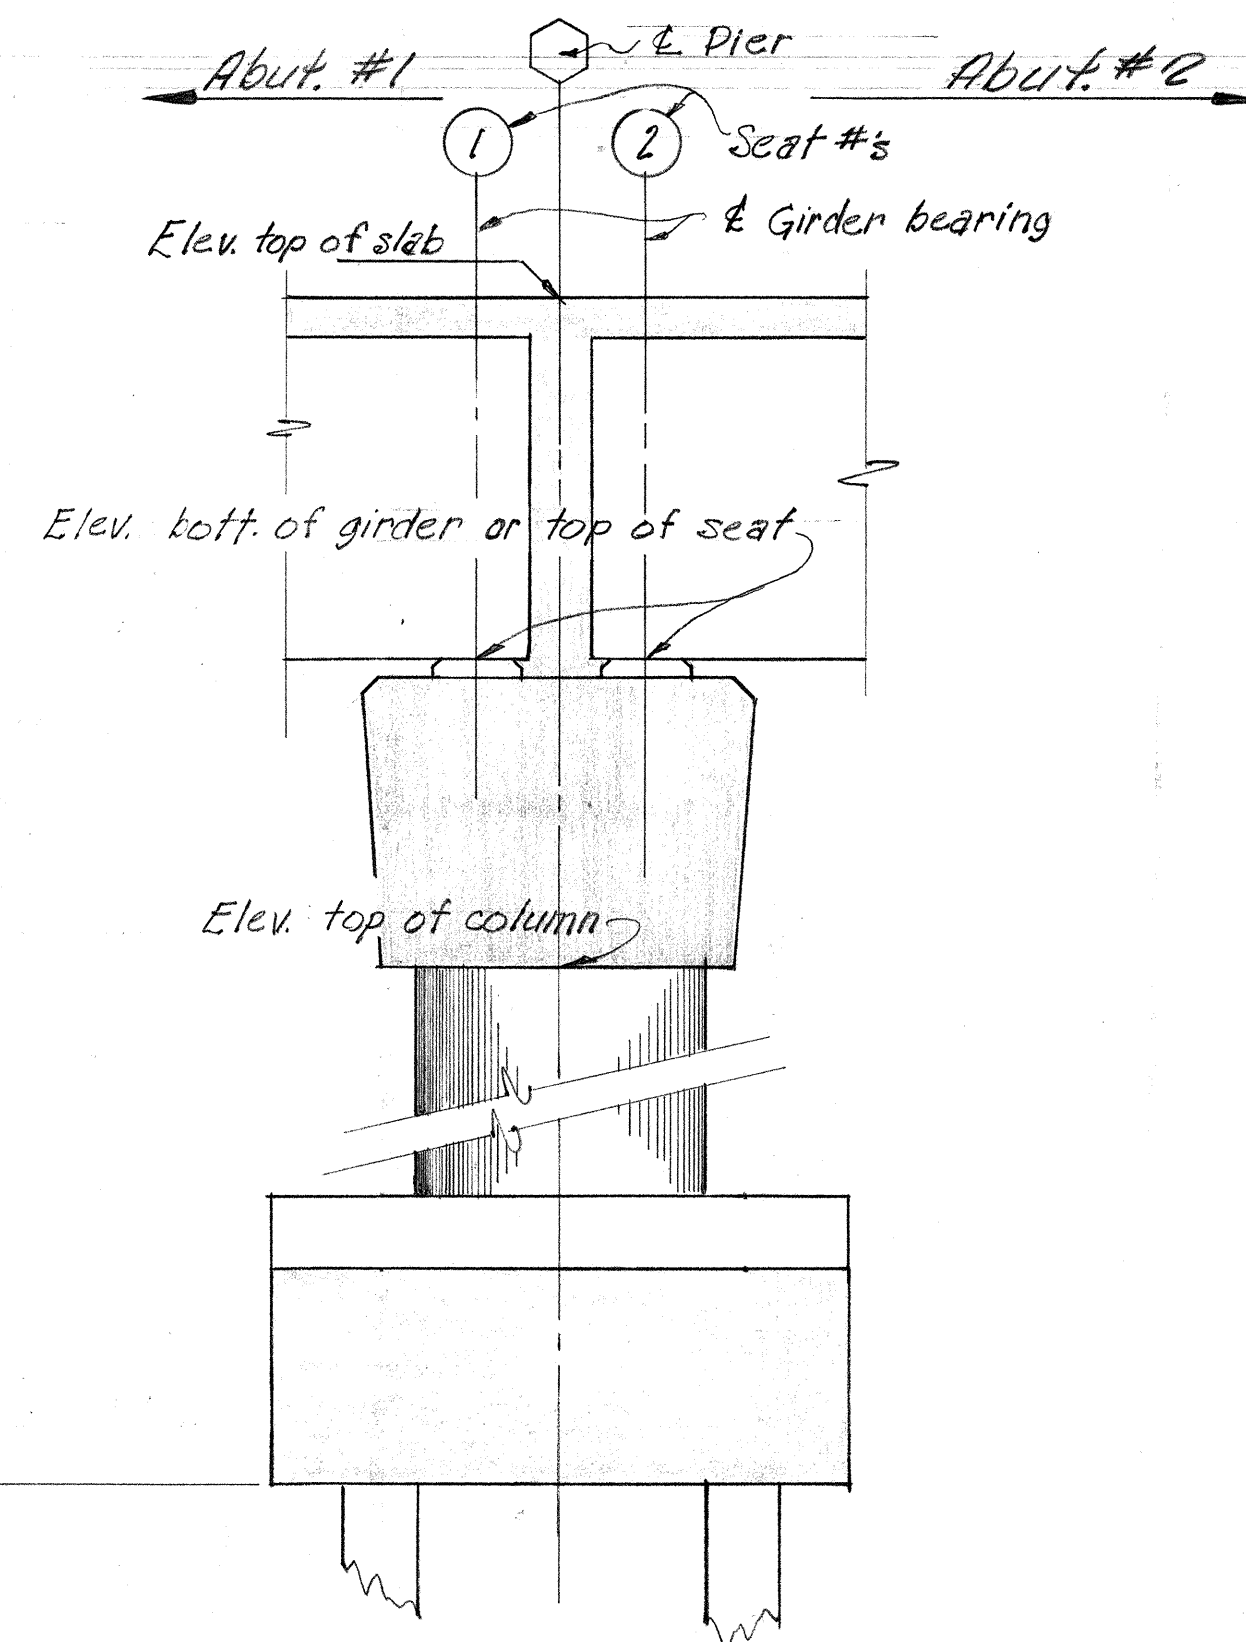

SCHEMATIC PIER SECTION

SCHEDULE OF ELEVATIONS


PIER №	TOP OF SLAB										BOTTOM OF GIRDER														TOP OF SEAT														TOP OF COLUMN			BOTTOM OF FOOTING																																																																																																																																																																																																																																																																																																																																																																																																																																																																																																																																																																																																																																																																																																																																																																																																																																																																																																																																																																																																																																																																																																																																																																																																																																																							
	GIRDER										GIRDER & SEAT														GIRDER & SEAT																																																																																																																																																																																																																																																																																																																																																																																																																																																																																																																																																																																																																																																																																																																																																																																																																																																																																																																																																																																																																																																																																																																																																																																																																																																																								
	G1B	G1A	G1	G2	G3	G4	G5	G6	G7	G1B	G1A	G1	G2	G3	G4	G5	G6	G7	G1B	G1A	G1	G2	G3	G4	G5	G6	G7	COLUMN																																																																																																																																																																																																																																																																																																																																																																																																																																																																																																																																																																																																																																																																																																																																																																																																																																																																																																																																																																																																																																																																																																																																																																																																																																																																					
1	2	1	2	1	2	1	2	1	2	1	2	1	2	1	2	1	2	1	2	1	2	1	2	1	2	1	2	1	2	3																																																																																																																																																																																																																																																																																																																																																																																																																																																																																																																																																																																																																																																																																																																																																																																																																																																																																																																																																																																																																																																																																																																																																																																																																																																																			
1																																																																																																																																																																																																																																																																																																																																																																																																																																																																																																																																																																																																																																																																																																																																																																																																																																																																																																																																																																																																																																																																																																																																																																																																																																																																																																	</

NOTE! Piers 1, 2, 4, & 5 are fixed supports, elevation top of conc. seat same as elevation bot. of girder at these piers. See Sht. 54 for Typical Concrete Seat Details.

* See Top of Pier Cap Plan, Sht. 1 for Top of Slab Elev. loc., Pier #3.

TYPICAL PIER SECTIONS & SCHEDULE OF ELEVATIONS FOR STRUCTURE #13

SHIMAZU SHIMABUKURO & FUKUDA, INC.
Consulting Structural Engineers
1210 Ward Ave., Honolulu, HI 96814

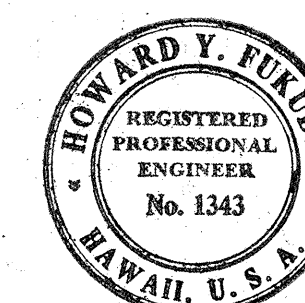

This work was prepared by me or under my supervision.
Howard Y. Fukuda

STATE OF HAWAII
DEPARTMENT OF TRANSPORTATION
HIGHWAYS DIVISION



STRUCTURE No. 13
PIER ELEVATION & SECTION
& SCHEDULE OF ELEVATIONS

WAIAWA INTERCHANGE
F.A.I. Proj. No. I-HI-1(75)8

Scale: As shown Date: JUNE, 1969

SHEET No. 6 OF 12 SHEETS

FED. ROAD DIST. NO.	STATE	FED. AID PROJ. NO.	FISCAL YEAR	SHEET NO.	TOTAL SHEETS
HAWAII	HAW.	I-HI-1(75):8	1969	74	181

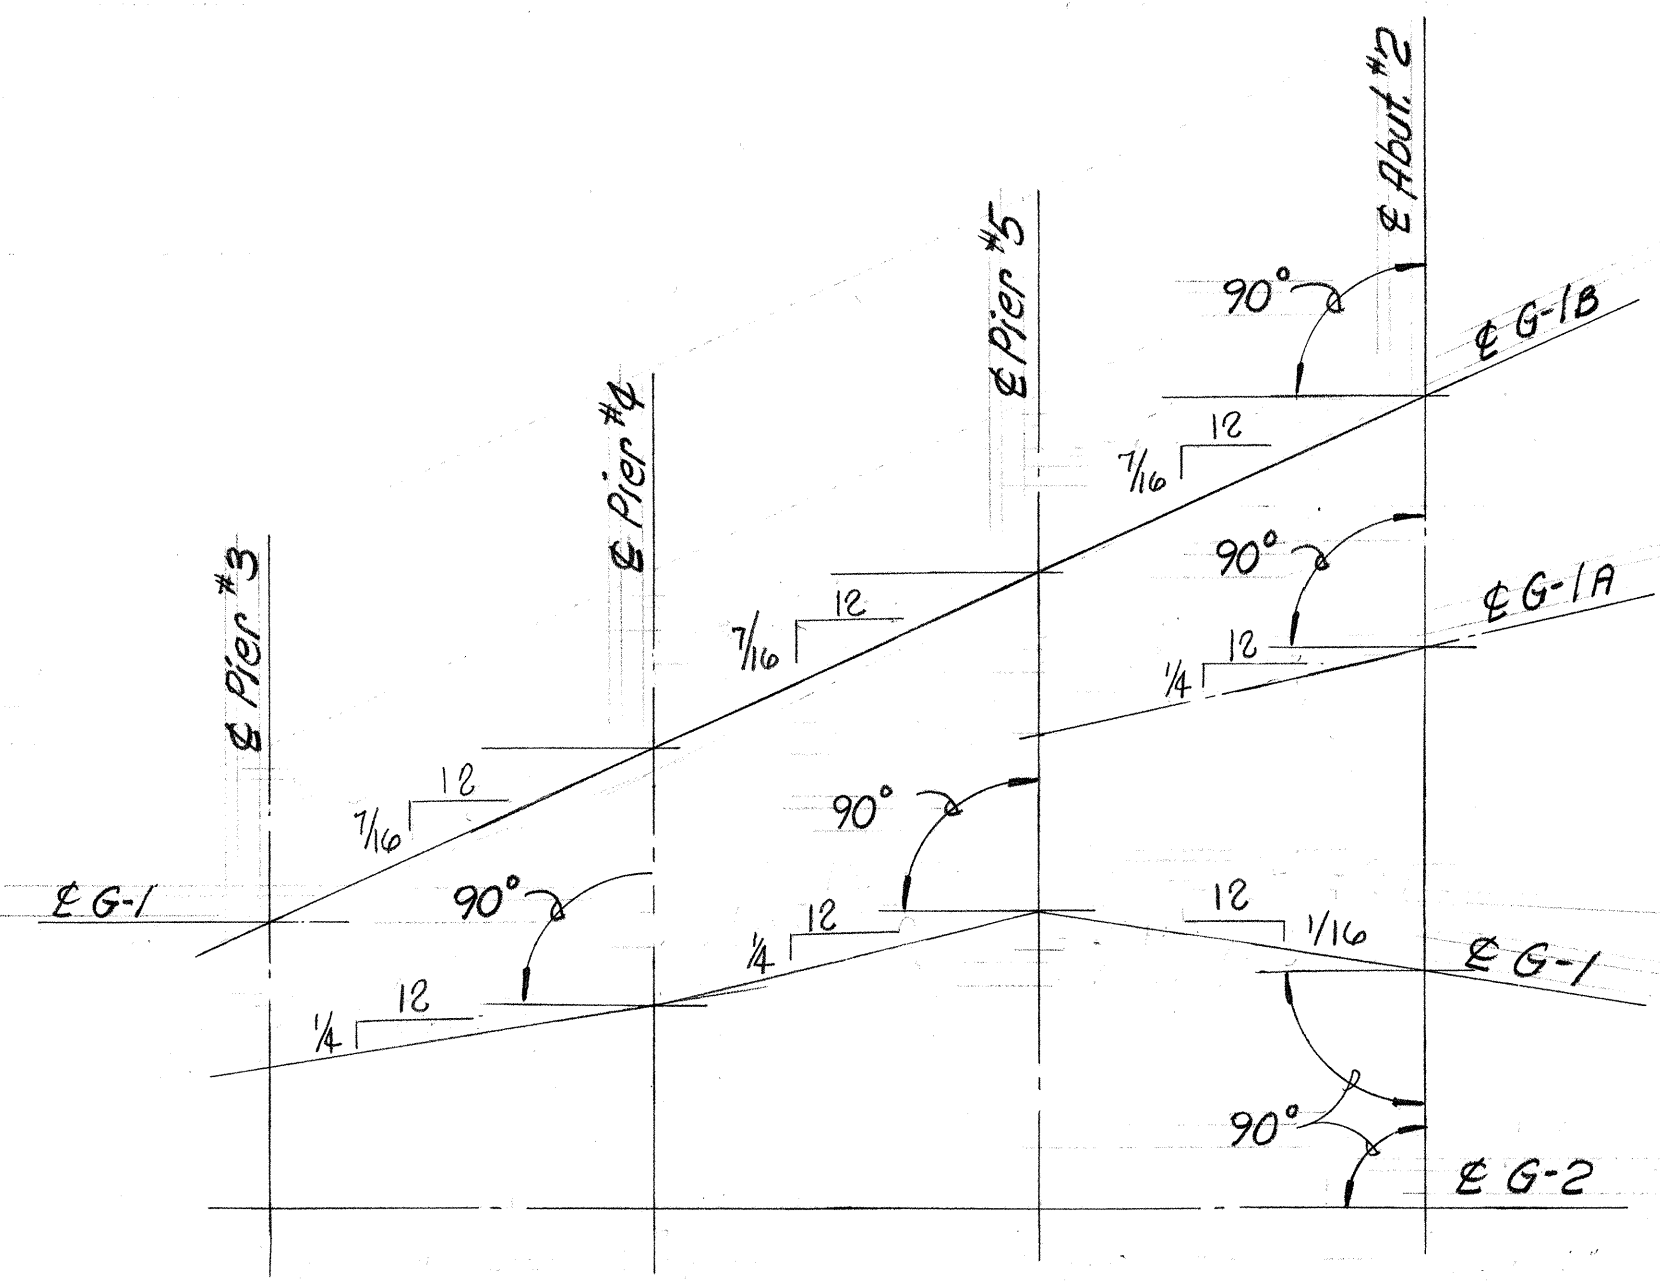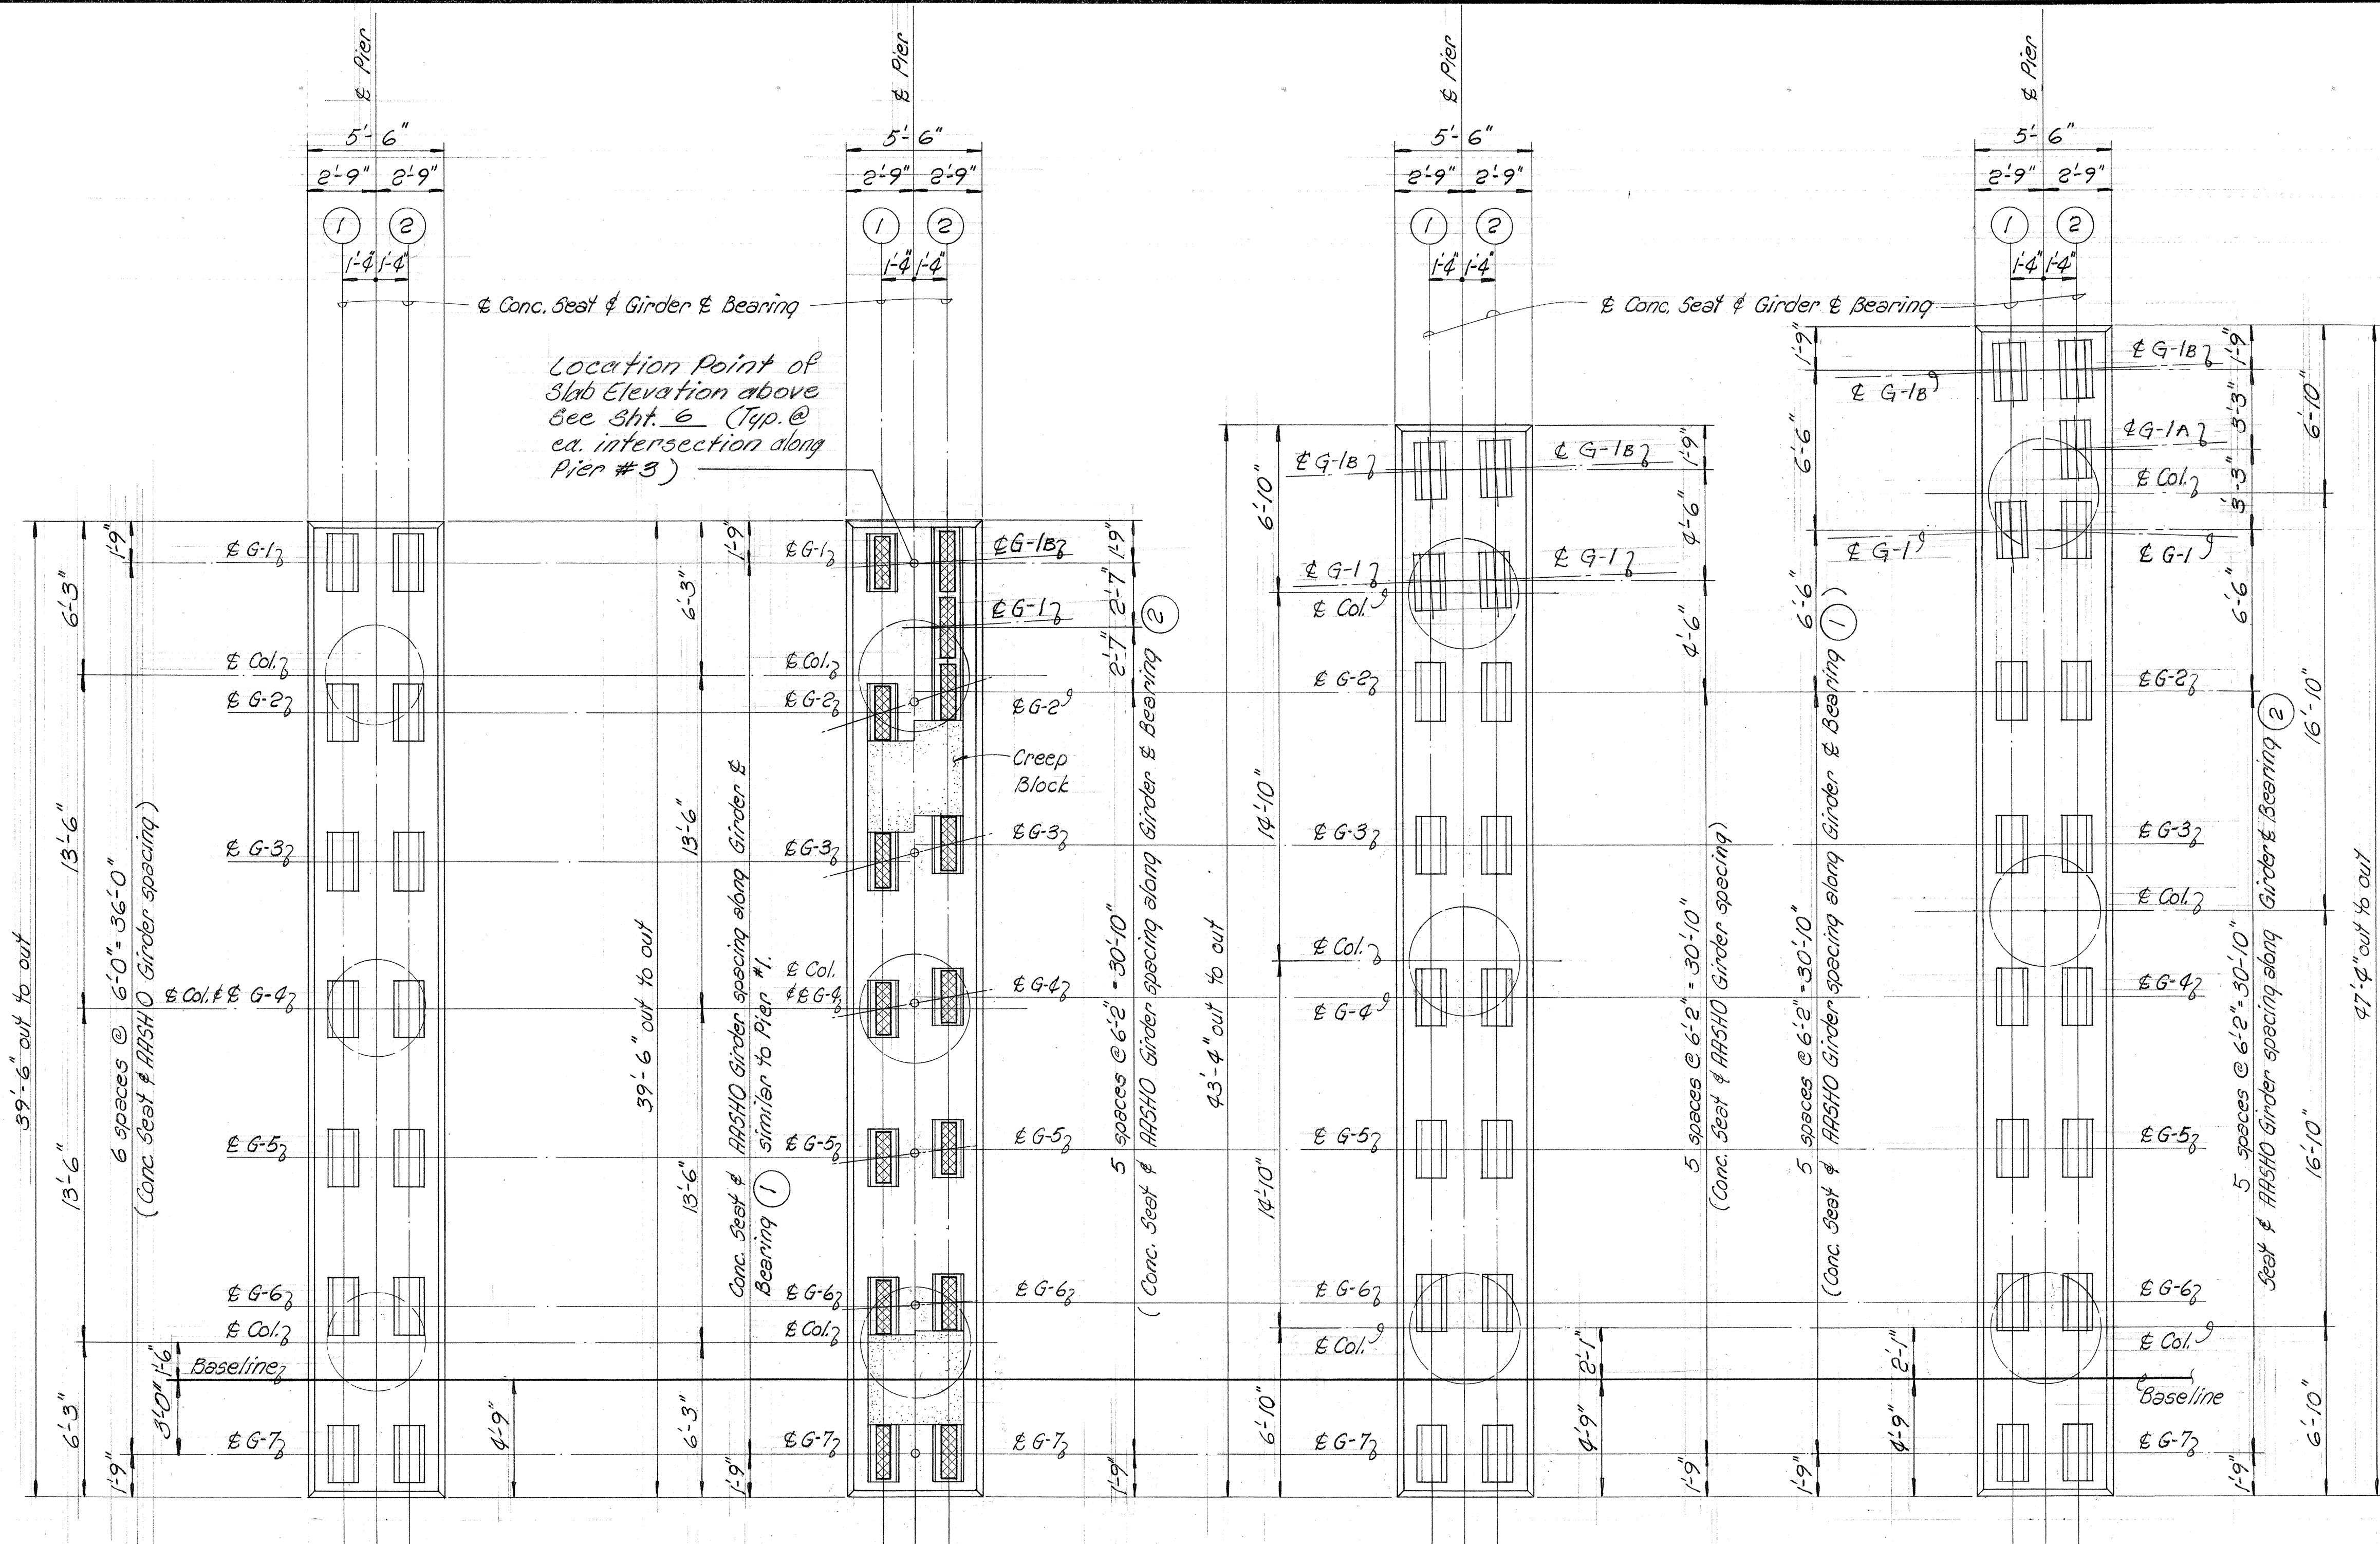

SCHEMATIC
GIRDER & SEAT SKEW DIRECTION
N.T.S.

PIER CONCRETE SEAT BEVELS										
Piers Girders	1		2		3		4		5	
	①	②	①	②	①	②	①	②	①	②
G-1B	—	—	—	—	—	—	—	—	—	—
G-1A	—	—	—	—	—	—	—	—	—	—
G-1	1/4:12	3/32:12	3/32:12	1/8:12	1/8:12	1/16:12	1/16:12	3/32:12	3/32:12	7/32:12
G-2	↑	↑	↑	↑	↑	↑	↑	↑	↑	↑
G-3	↑	↑	↑	↑	↑	↑	↑	↑	↑	↑
G-4	↑	↑	↑	↑	↑	↑	↑	↑	↑	↑
G-5	↑	↑	↑	↑	↑	↑	↑	↑	↑	↑
G-6	1/4:12	—	—	—	—	—	—	—	—	—
G-7	3/32:12	3/32:12	3/32:12	1/8:12	1/8:12	1/16:12	1/16:12	3/32:12	3/32:12	7/32:12

REFERENCE DRAWINGS

- Concrete Seats & Creep Blocks - Sht. 54
- Pier Caps - Sht. 53

PIERS #1 & #2
FIXED BEARING

PIER #3
EXPANSION BEARING


PIER #4
FIXED BEARING

PIER #5
FIXED BEARING

TOP OF PIER CAP PLANS
Scale: 1/4" = 1'-0"

Note: For all fixed-bearing Pier Caps, see Standard Details on Sht. 55 for bonding diaphragms, dowels, and keys which are not shown here.

SHIMAZU SHIMABUKURO & FUKUDA, INC.
Consulting Structural Engineers
1210 Ward Ave., Honolulu, HI 96814

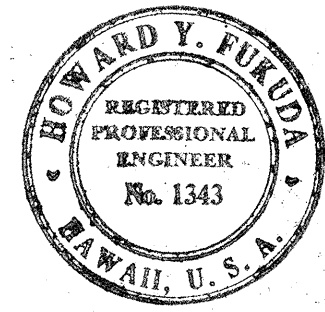

This work was prepared by me or under my supervision.
Howard Y. Fukuda


STATE OF HAWAII
DEPARTMENT OF TRANSPORTATION
HIGHWAYS DIVISION

STRUCTURE No. 13
TOP OF PIER CAP
& CONCRETE SEAT SPACING

WAI'ANA INTERCHANGE
F.A.I. Proj. No. I-HI-1(75):8

Scale: As shown Date: JUNE, 1969


FED. ROAD DIST. NO.	STATE	FED. AID PROJ. NO.	FISCAL YEAR	SHEET NO.	TOTAL SHEETS
HAWAII	HAW.	I-HI-1(75):8	1969	75	181

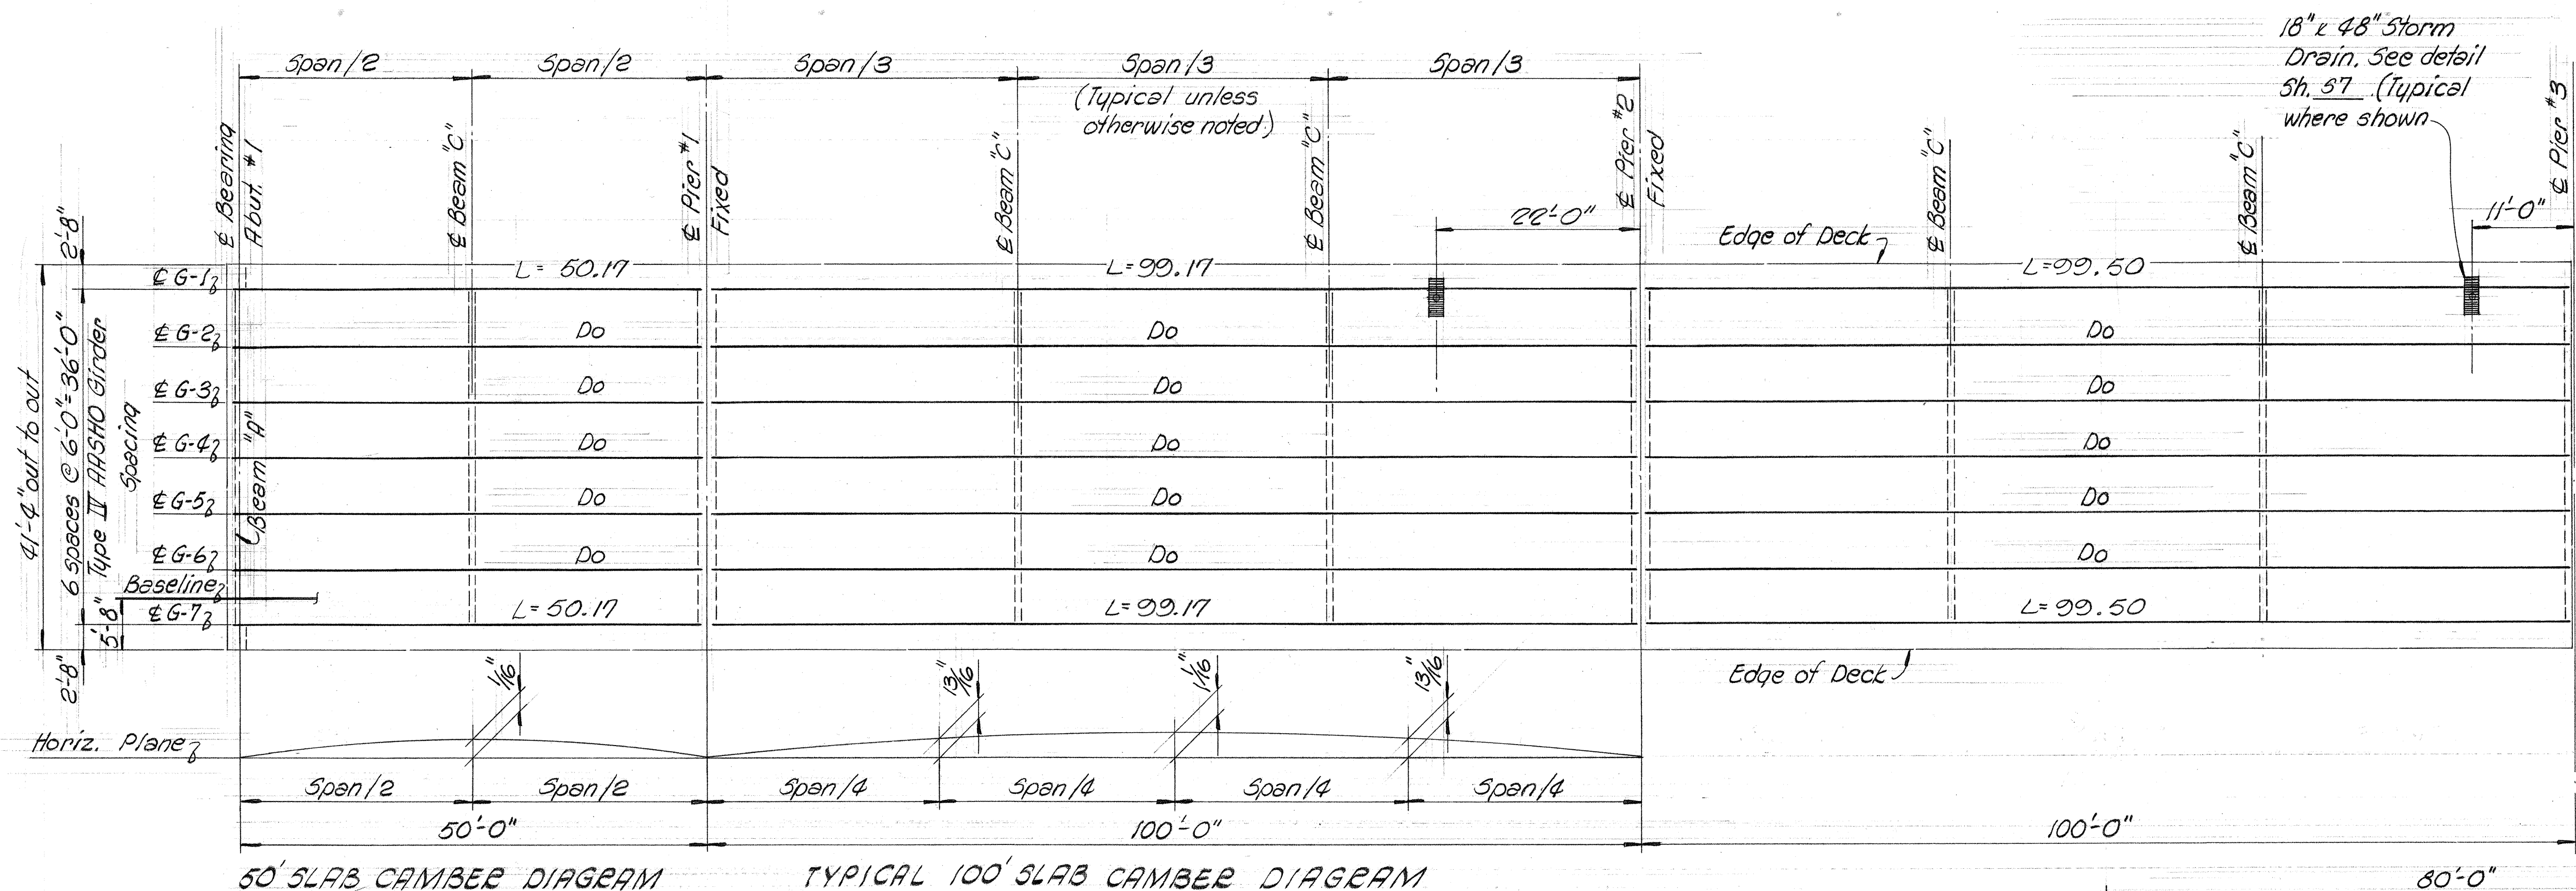

NOTE!
Girder casting lengths given on this sheet are measured at girder E and are horizontal out to out lengths.

REFERENCE DRAWINGS

1. Beam "A" ----- Sh. 56
2. Beam "C" ----- Sh. 56
3. Beam over Fixed & Expansion Pier Supports - Sh. 55

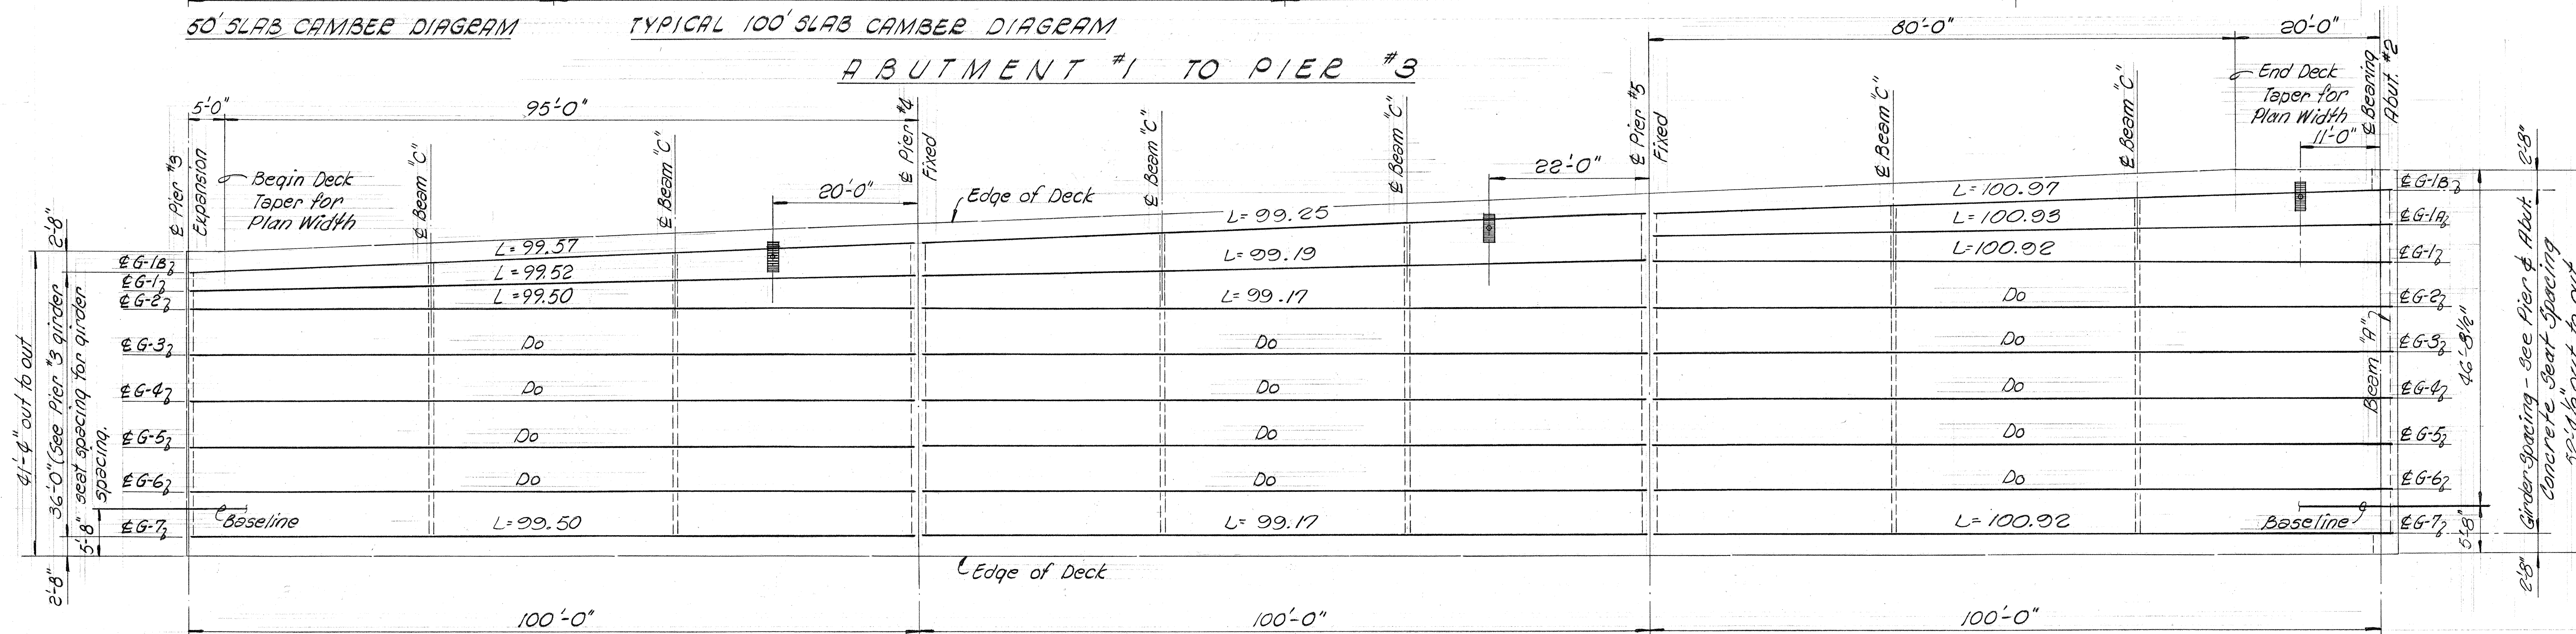


PIER #3 TO ABUTMENT #2

DECK FRAMING PLANS

Scale: 3/32" = 1'-0"

SHIMAZU SHIMABUKURO & FUKUDA, INC.
Consulting Structural Engineers
1210 Ward Ave., Honolulu, HI 96814

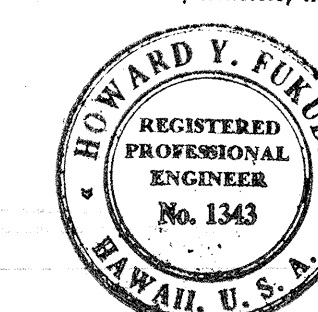

This work was prepared by me or under my supervision.
Howard Y. Fukuda

STATE OF HAWAII
DEPARTMENT OF TRANSPORTATION
HIGHWAYS DIVISION

STRUCTURE NO. 13


DECK FRAMING PLANS

WAIKAWA INTERCHANGE
F.A.I. Proj. No. I-HI-1(75):8

Scale: As shown Date: JUNE, 1969

SHEET No. 8 OF 12 SHEETS

FED. ROAD DIST. NO.	STATE	FED. AID PROJ. NO.	FISCAL YEAR	SHEET NO.	TOTAL SHEETS
HAWAII	HAW.	I-HI-1(75):8	1969	76	181

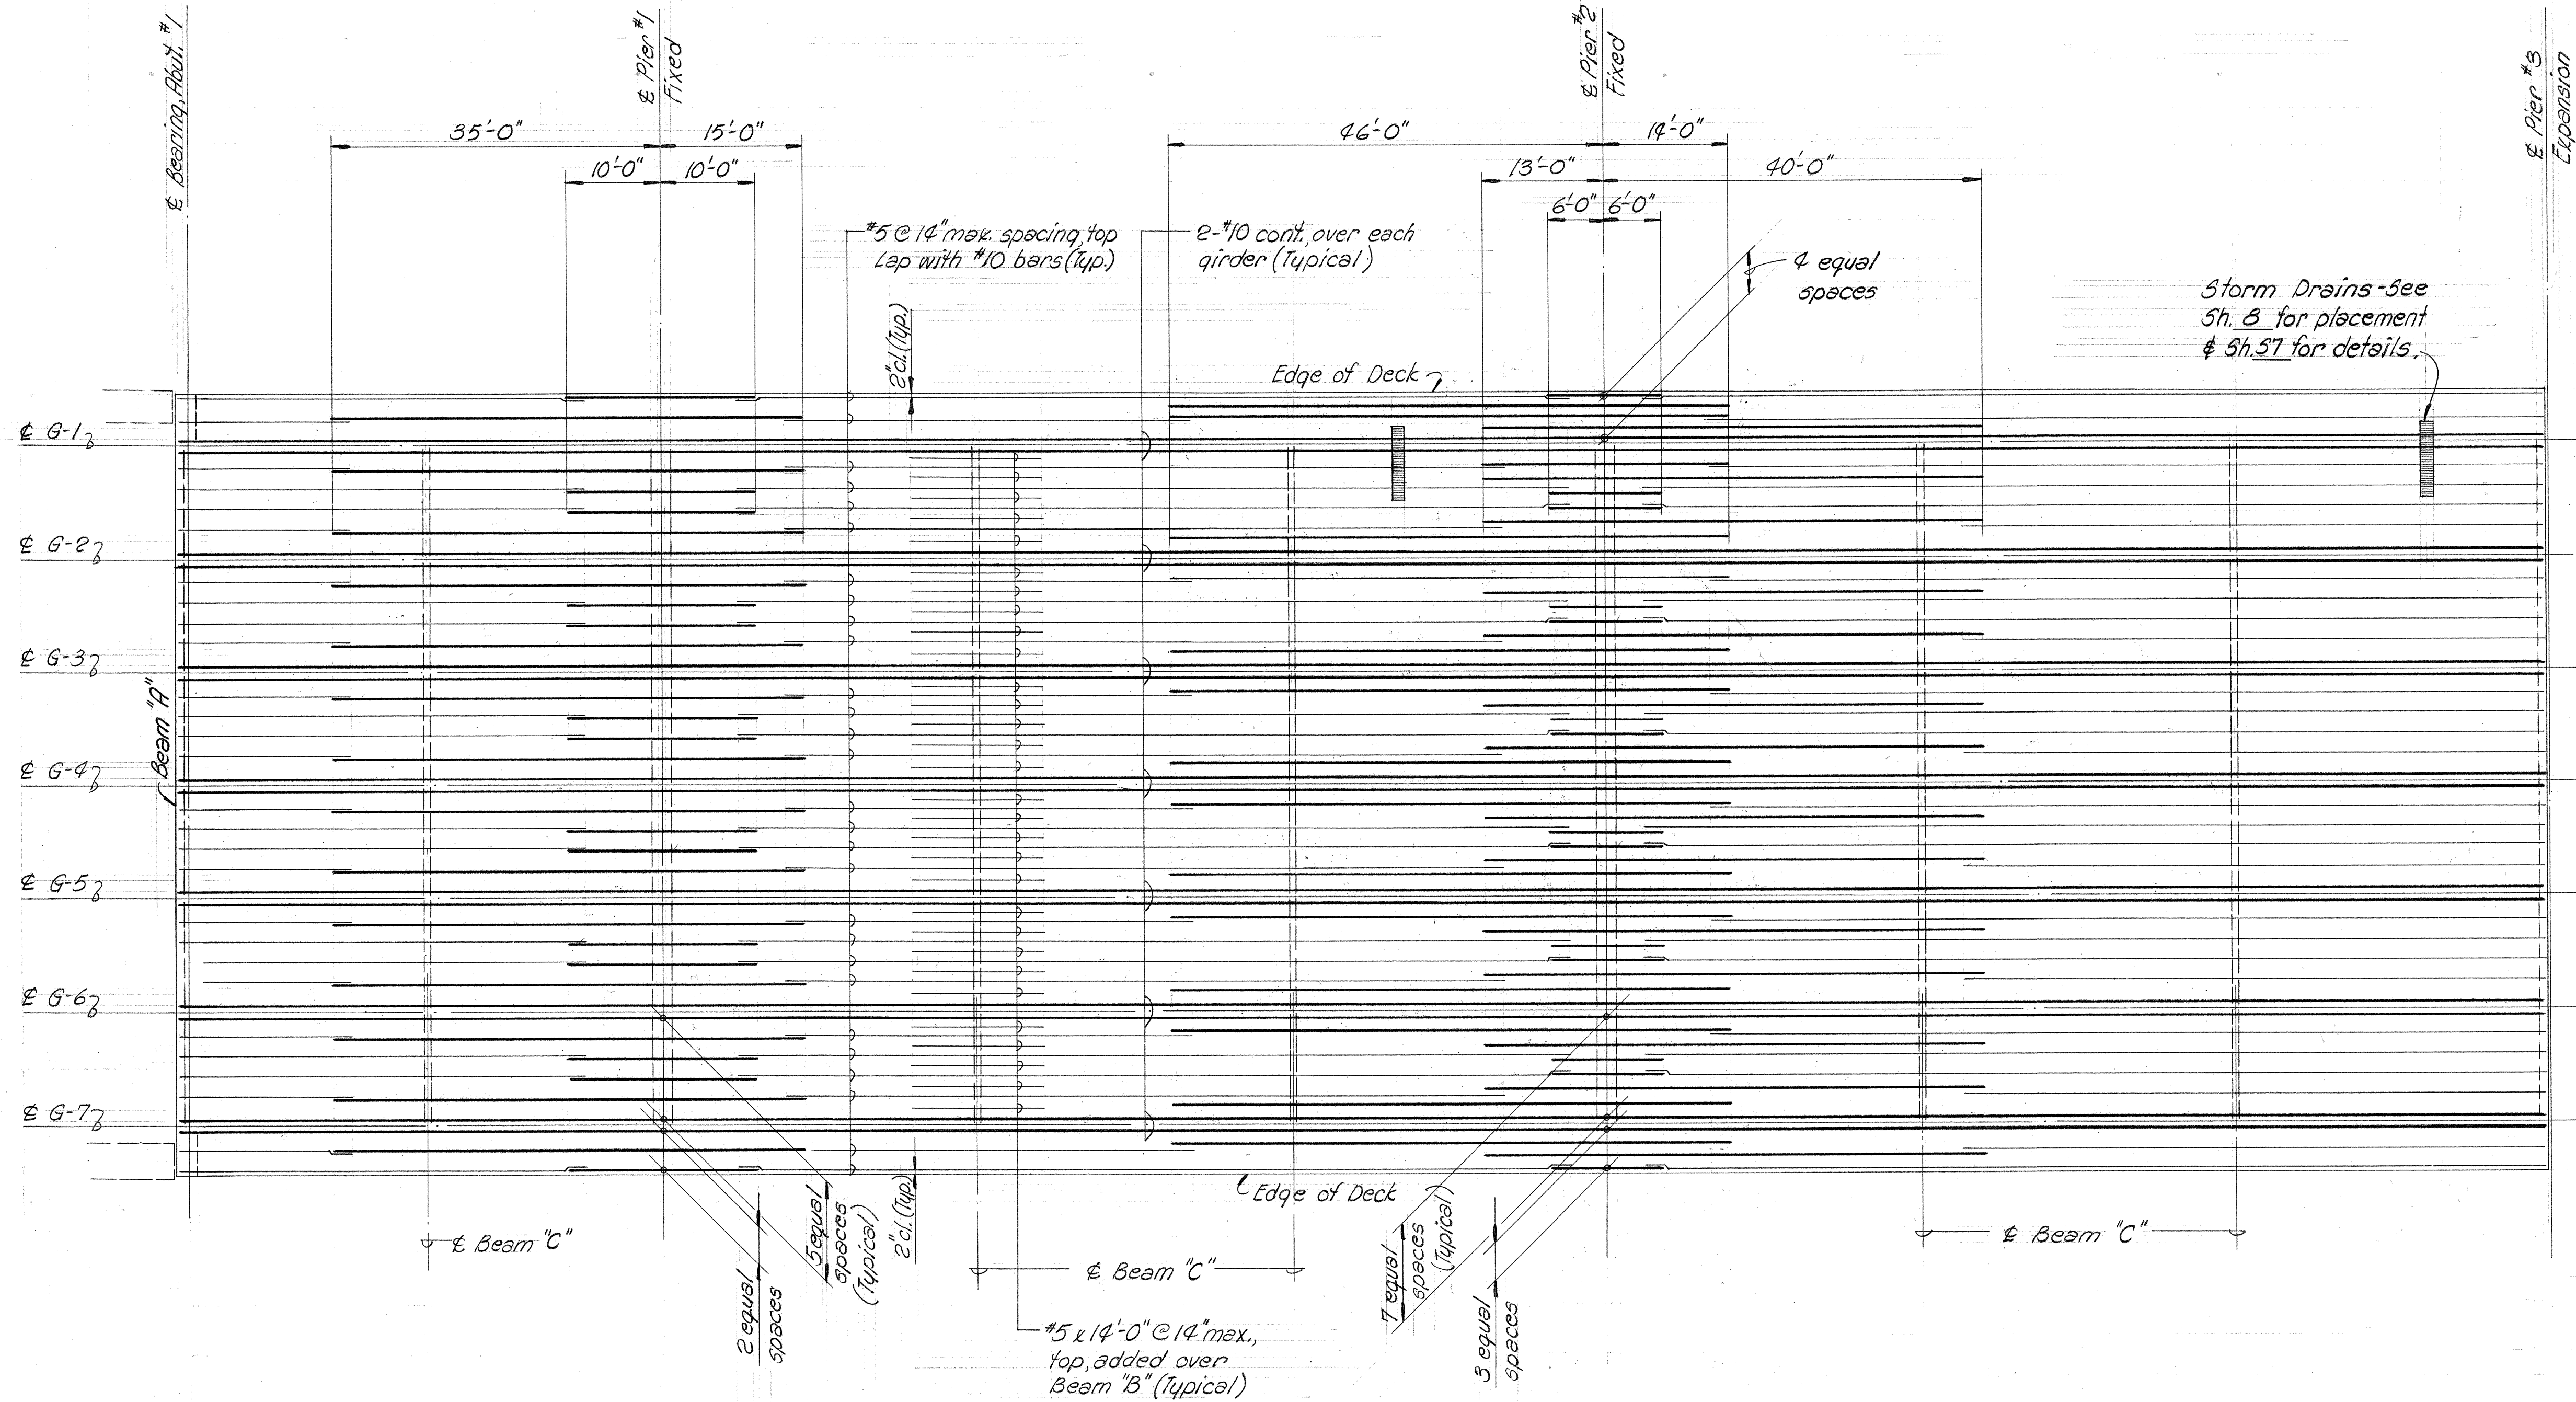

NOTES


1. Except as otherwise noted all slab bars to be #10 bars. (#10 shown dark)
2. All #5 @ 14" max. spacing shall be extended & lapped a min. of 2'-6" with adjacent #10 bars as shown. (#5 shown light)
3. Transverse bars not shown, see typical Deck Section, Sh. 11.
4. All vertical dimensions are measured plumb.
5. Beams "A" & "C" - See Sh. 56.

PLAN BETWEEN ABUTMENT #1 & PIER #3

DECK SLAB TOP LONGITUDINAL REINFORCING PLACEMENT PLAN

Scale: Horiz., $\frac{3}{32}$ " = 1'-0"; Vert., $\frac{3}{16}$ " = 1'-0"

SHIMAZU SHIMABUKURO & FUKUDA, INC.
Consulting Structural Engineers
1210 Ward Ave., Honolulu, HI 96814

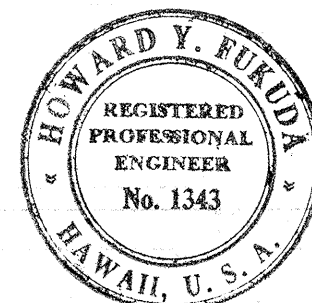

This work was prepared by me or under my supervision.
Howard Y. Fukuda

STATE OF HAWAII
DEPARTMENT OF TRANSPORTATION
HIGHWAYS DIVISION

STRUCTURE No. 13


DECK SLAB TOP
LONGIT. REINF. BETWEEN ABUT. #1 & PIER #3

WAIKAWA INTERCHANGE
P.A.I. Proj. No. I-HI-1(75):8

Scale: As shown Date: JUNE, 1969

SHEET No. 9 OF 12 SHEETS

FED. ROAD DIST. NO.	STATE	FED. AID PROJ. NO.	FISCAL YEAR	SHEET NO.	TOTAL SHEETS
HAWAII	HAW.	I-HI-1(75):8	1969	77	181

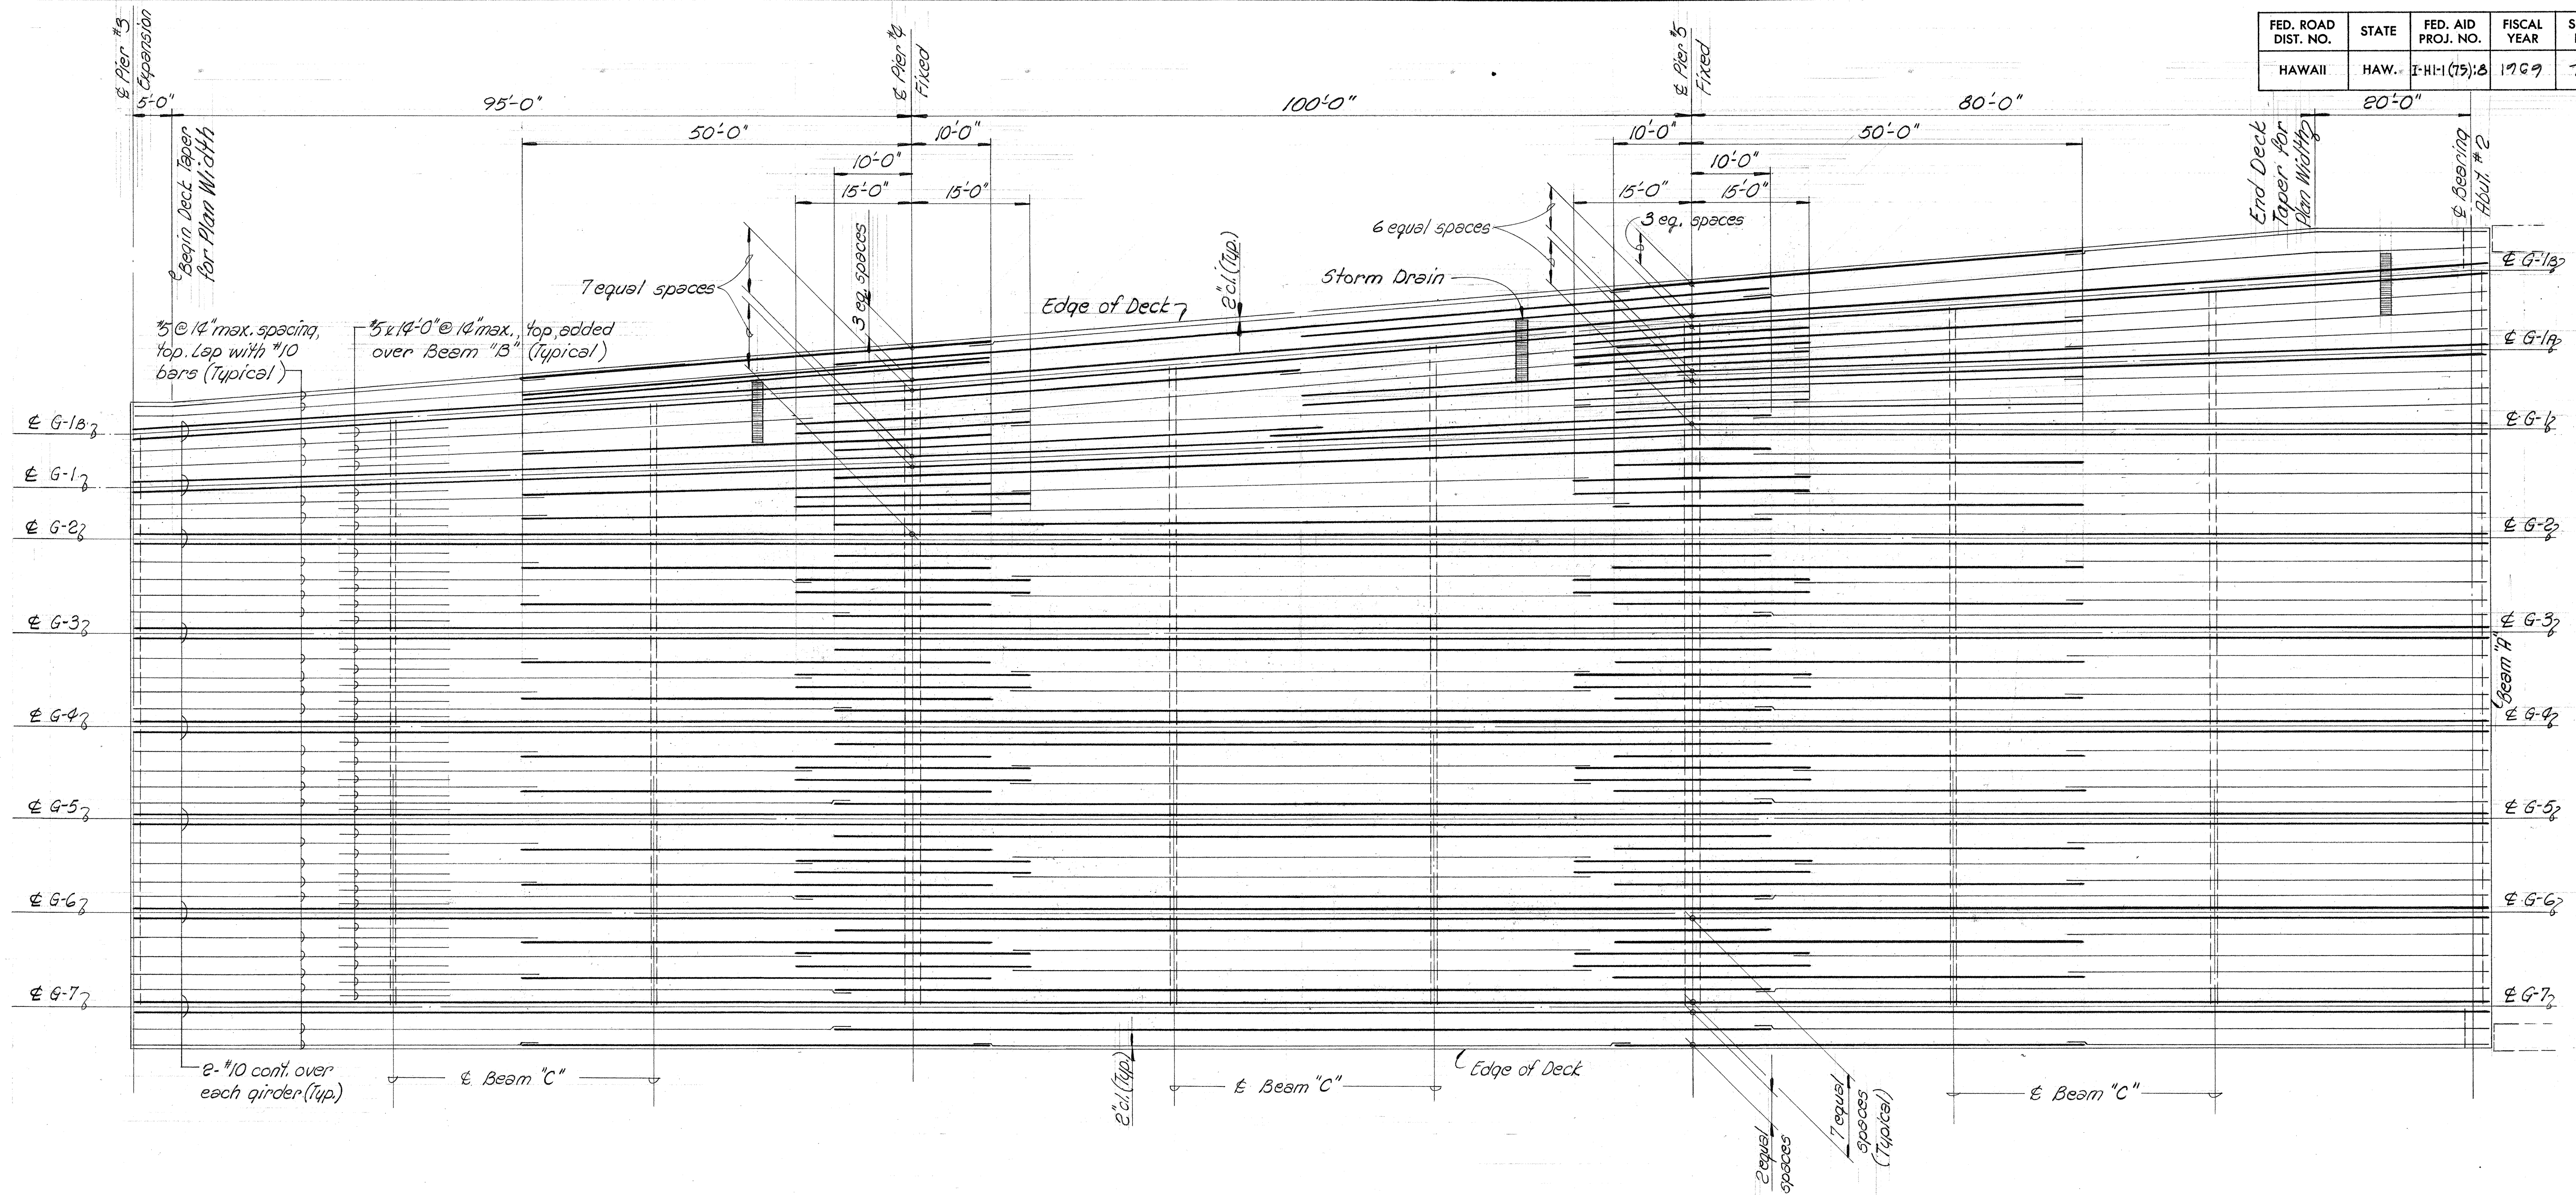

See notes Sh. 9

PLAN BETWEEN PIER #3 & ABUTMENT #2

DECK SLAB TOP LONGITUDINAL REINFORCING PLACEMENT PLAN
 Scale: Horiz., 1/8" = 1'-0"; Vert., 3/16" = 1'-0"

SHIMAZU SHIMABUKURO & FUKUDA, INC.
 Consulting Structural Engineers
 1210 Ward Ave., Honolulu, HI 96814

HOWARD Y. FUKUDA
 REGISTERED PROFESSIONAL ENGINEER
 No. 1343
 HAWAII, U.S.A.

This work was prepared by me or under my supervision.
 Howard Y. Fukuda


STATE OF HAWAII
 DEPARTMENT OF TRANSPORTATION
 HIGHWAYS DIVISION

STRUCTURE No. 13
 DECK SLAB TOP
 LONGIT. REINF. BETWEEN PIER #3 & ABUT. #2


WAIKAWA INTERCHANGE
 F.A.I. Proj. No. I-HI-1 (75):8

Scale: As shown Date: JUNE, 1969
 SHEET No. 10 OF 12 SHEETS

FED. ROAD DIST. NO.	STATE	FED. AID PROJ. NO.	FISCAL YEAR	SHEET NO.	TOTAL SHEETS
HAWAII	HAW.	I-HI-1(75):8	1969	78	181

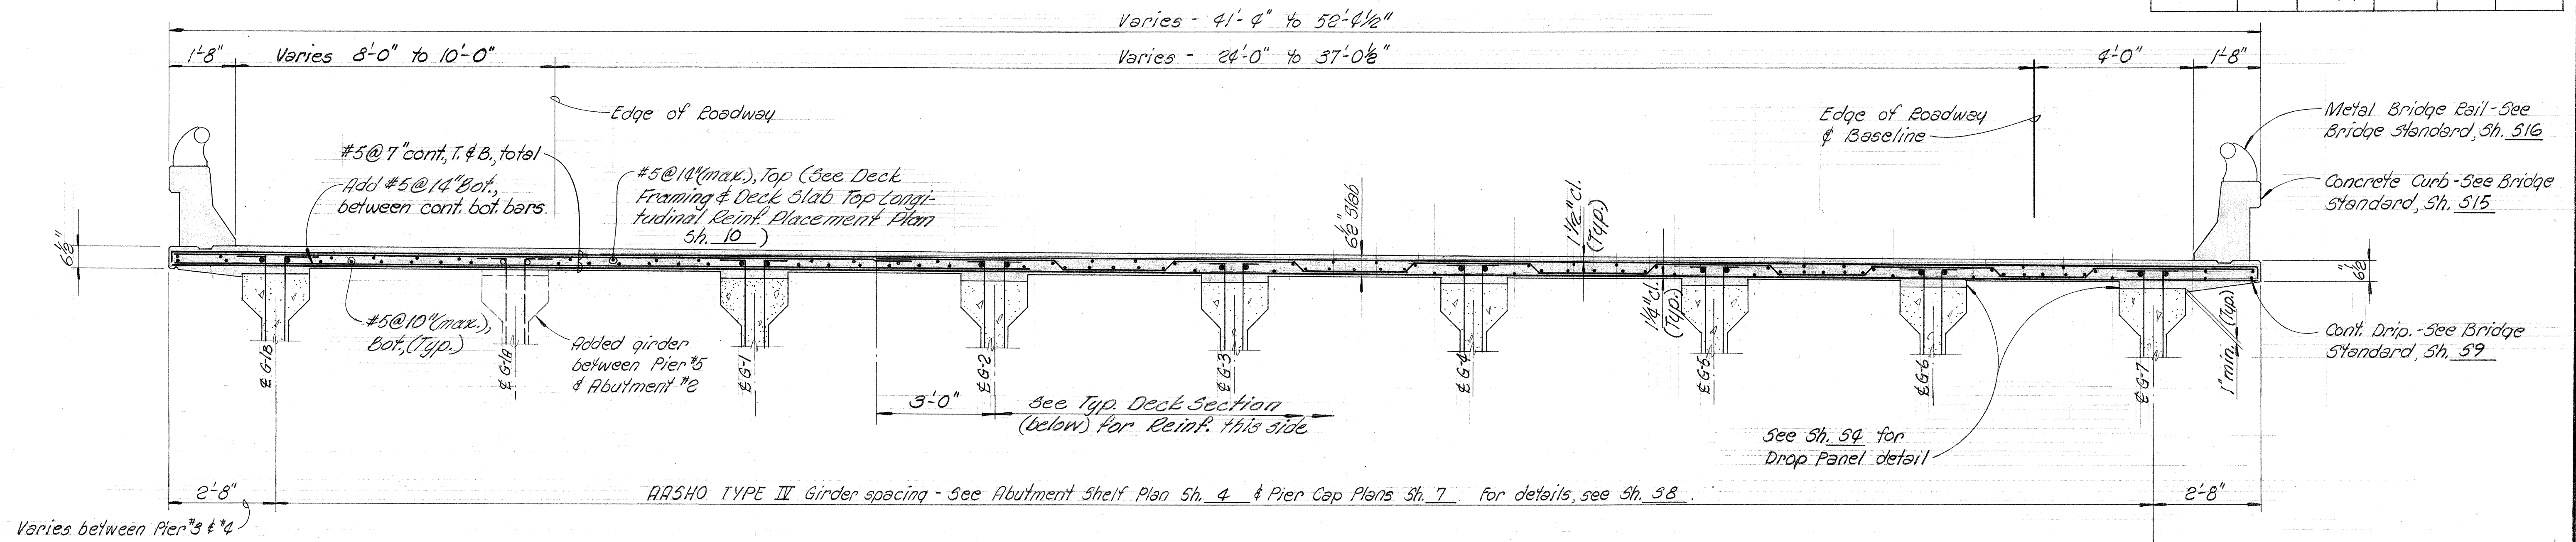


DECK SECTION AT FLARE
Scale: 1/2" = 1'-0"

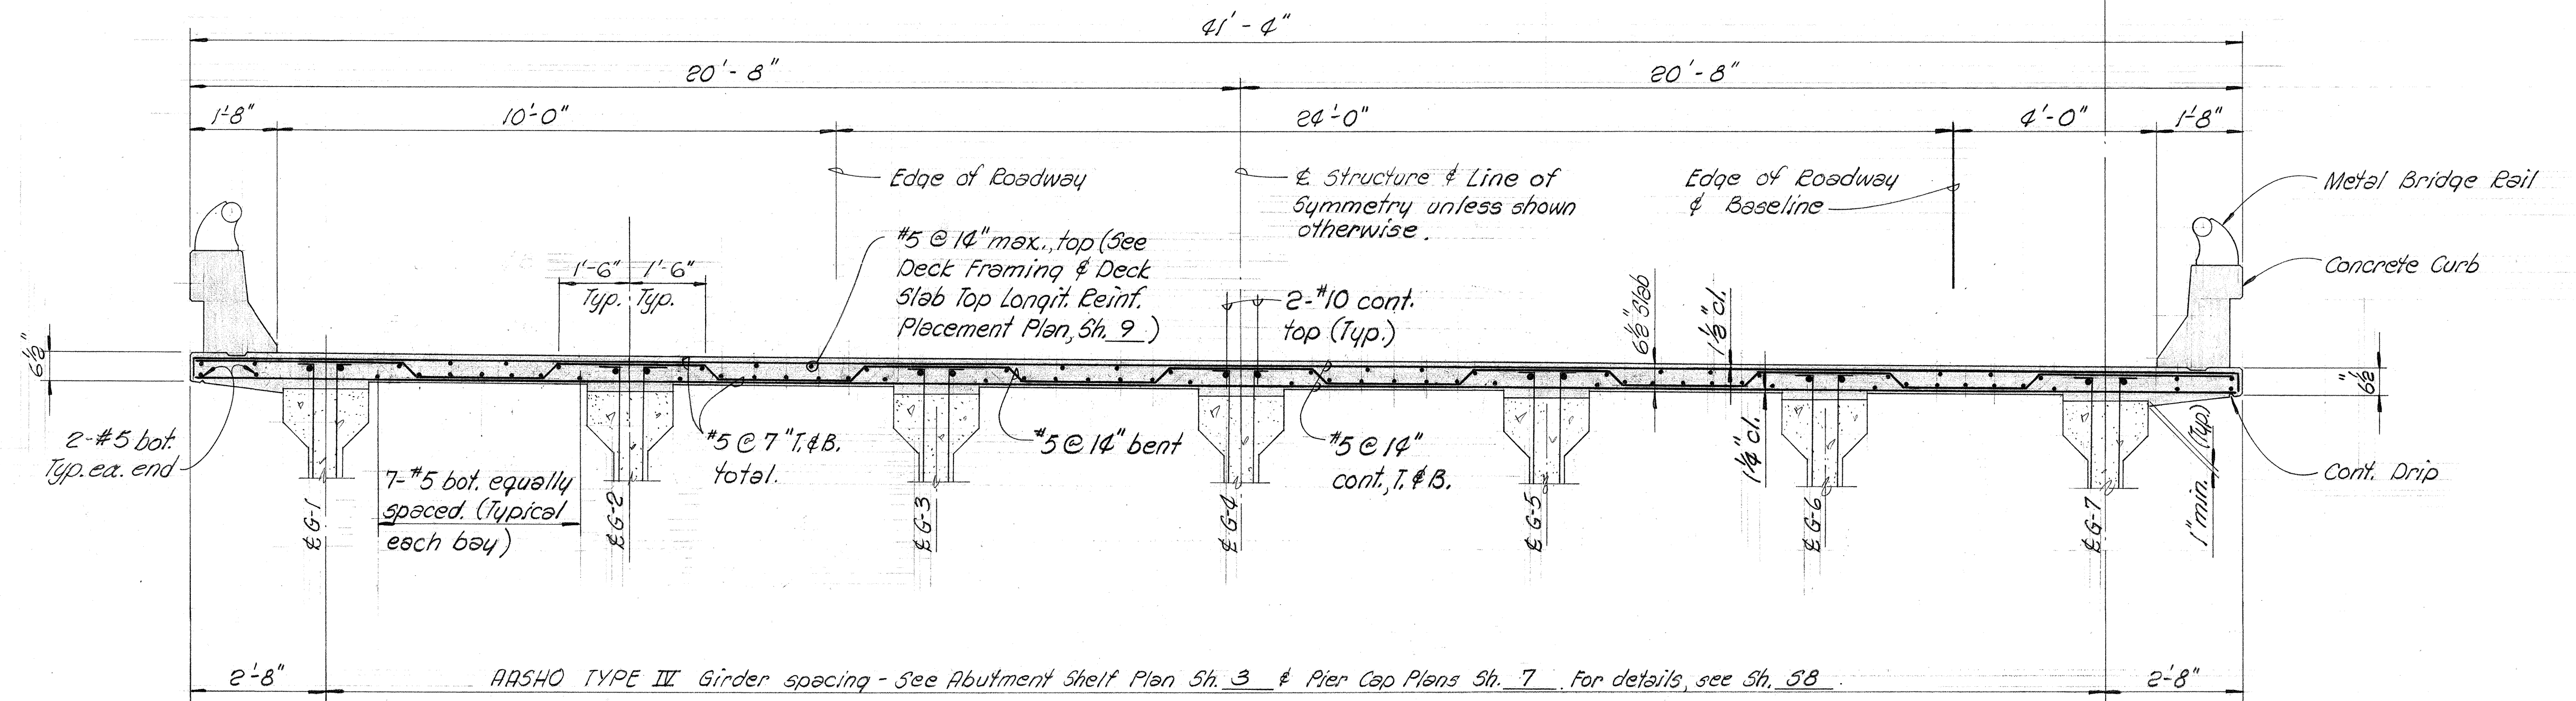

TYPICAL DECK SECTION
Scale: 1/2" = 1'-0"

Note! Longitudinal bars shown here are
for minimum condition only. See
Slab Plan for arrangement else-
where.

SHIMAZU SHIMABUKURO & FUKUDA, INC.
Consulting Structural Engineers
1210 Ward Ave., Honolulu, HI 96814

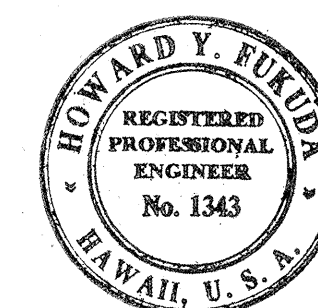

This work was prepared by
me or under my supervision
Howard Y. Fukuda














STATE OF HAWAII
DEPARTMENT OF TRANSPORTATION
HIGHWAYS DIVISION

STRUCTURE NO. 13
DECK SECTIONS


WAIKAWA INTERCHANGE
F.A.I. Proj. No. I-HI-1 (75):8

Scale: As shown Date: June, 1969
SHEET No. 11 OF 12 SHEETS

FED. ROAD DIST. NO.	STATE	FED. AID PROJ. NO.	FISCAL YEAR	SHEET NO.	TOTAL SHEETS
HAWAII	HAW.	I-HI-1(75):8	1969	77	181

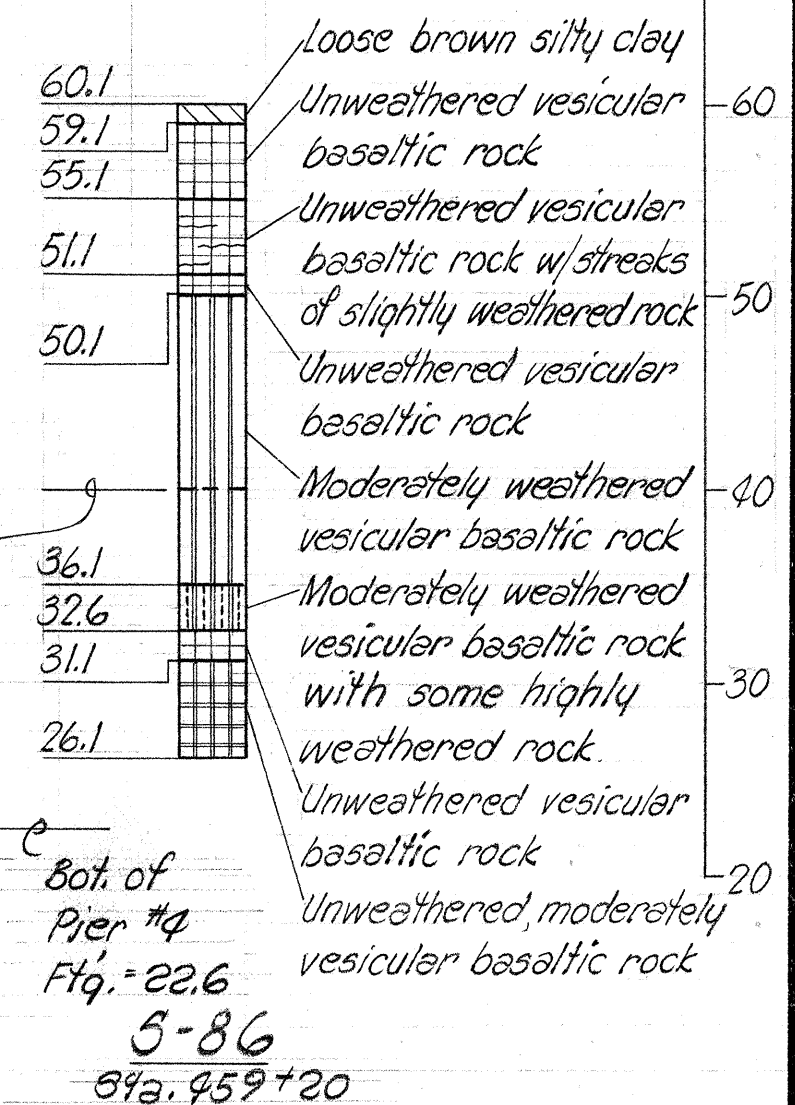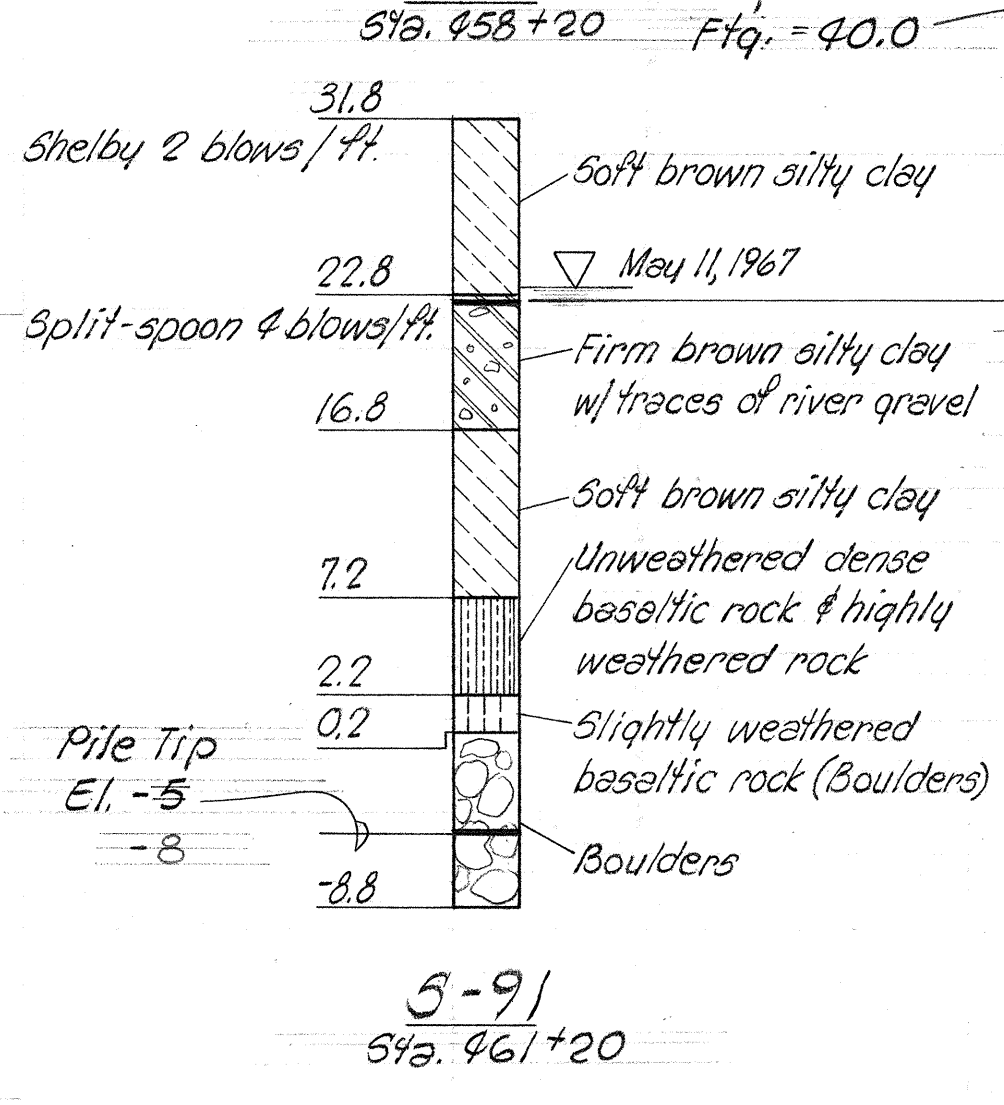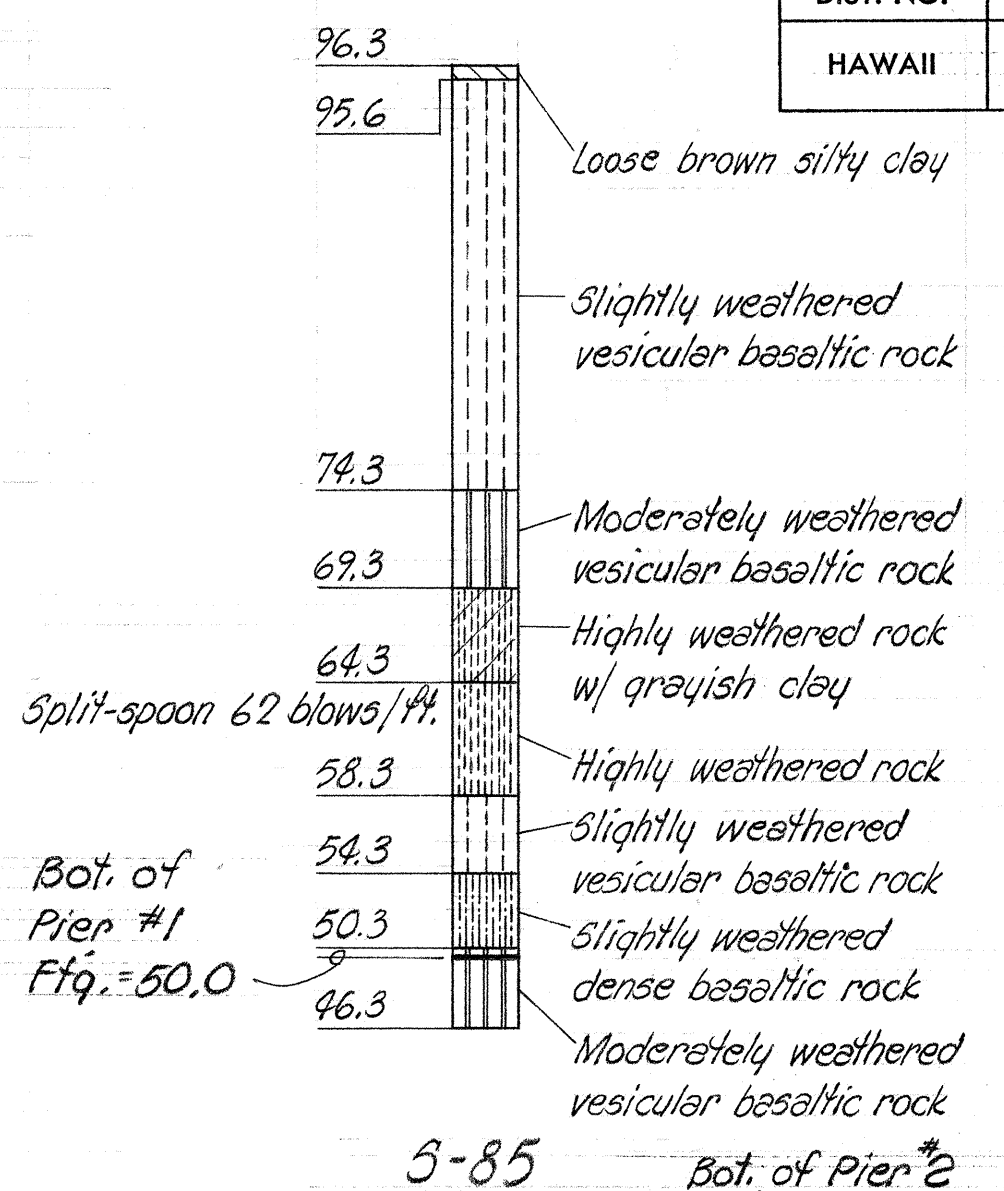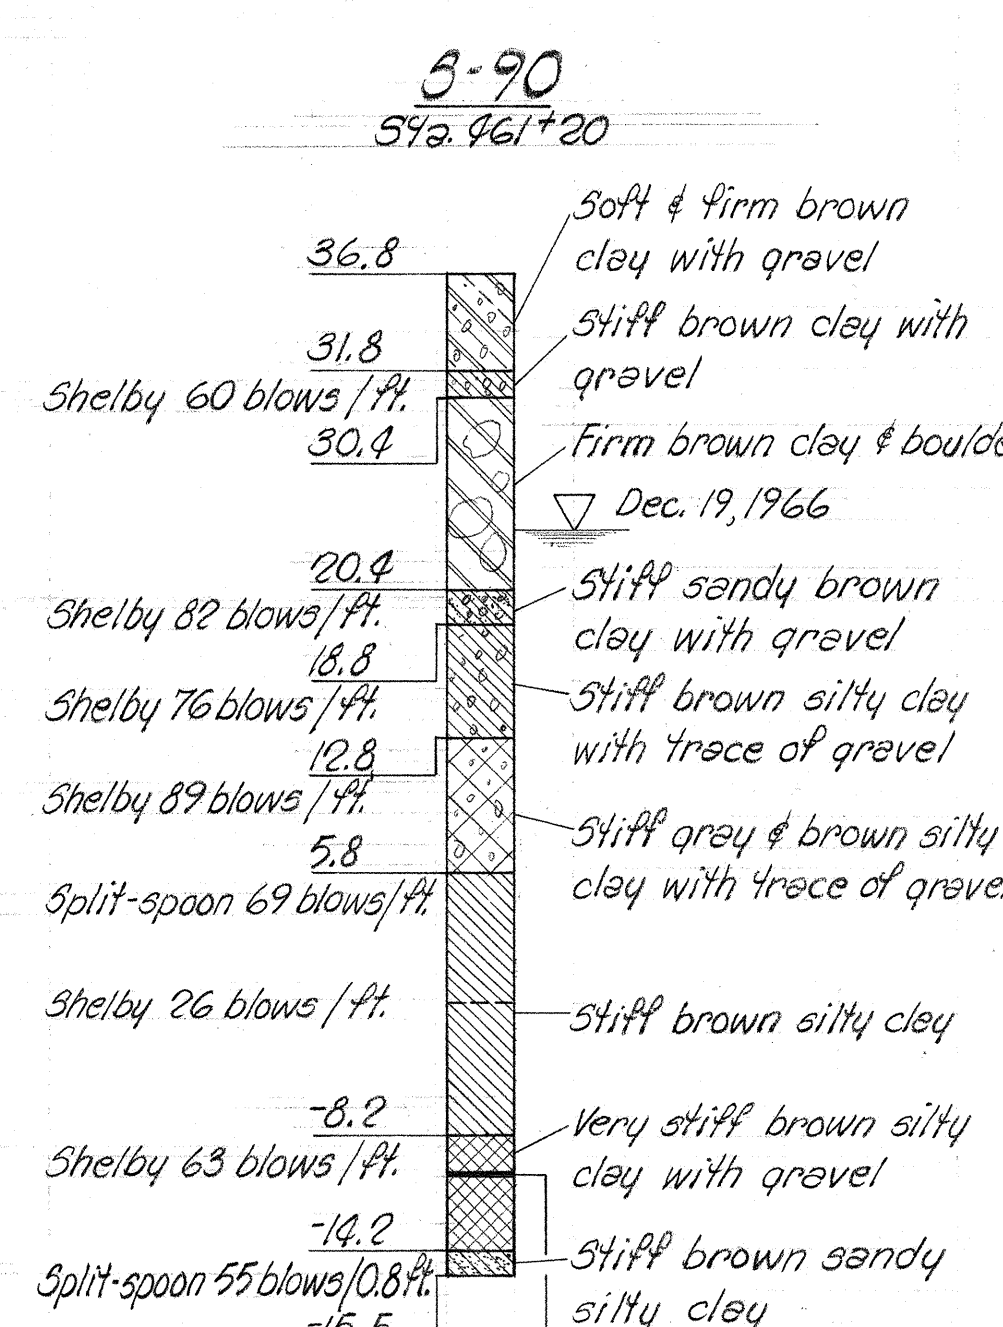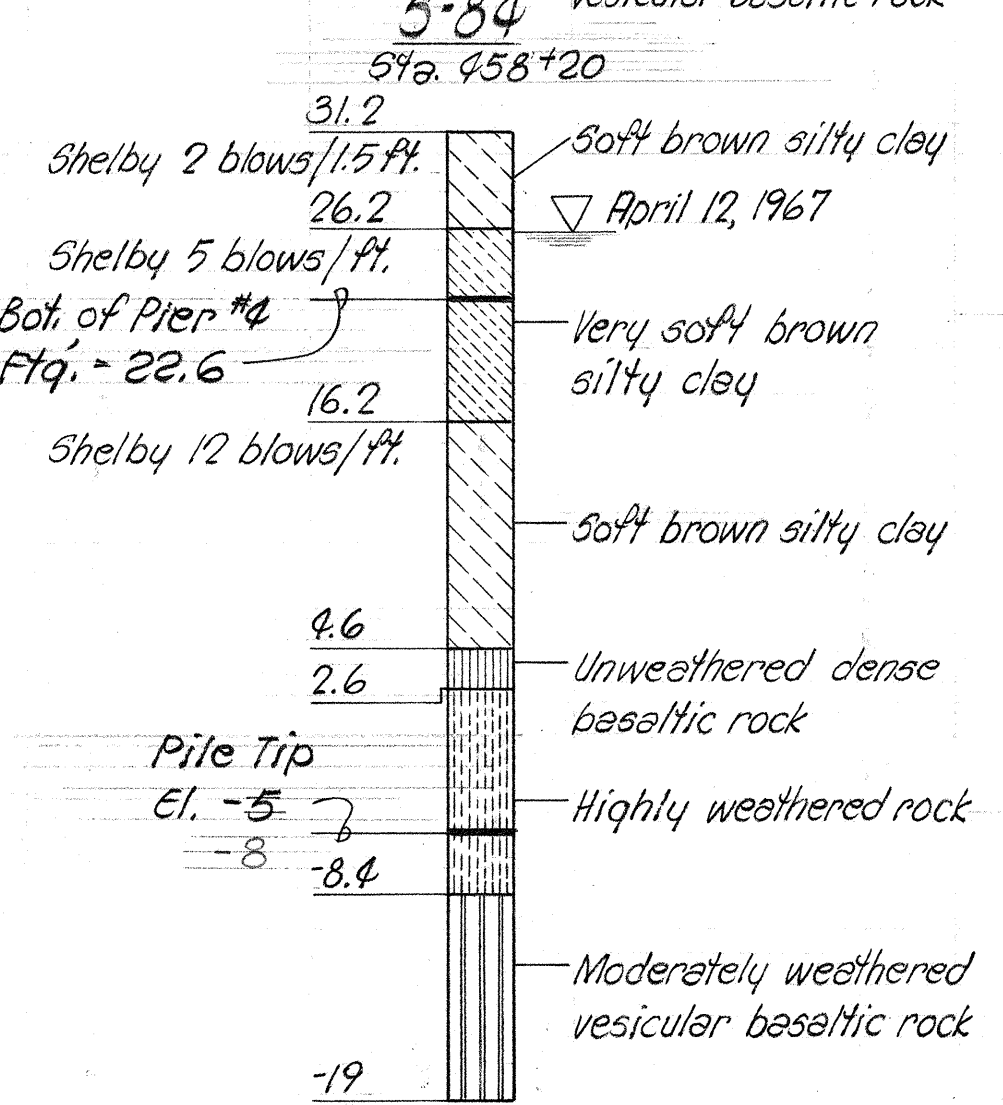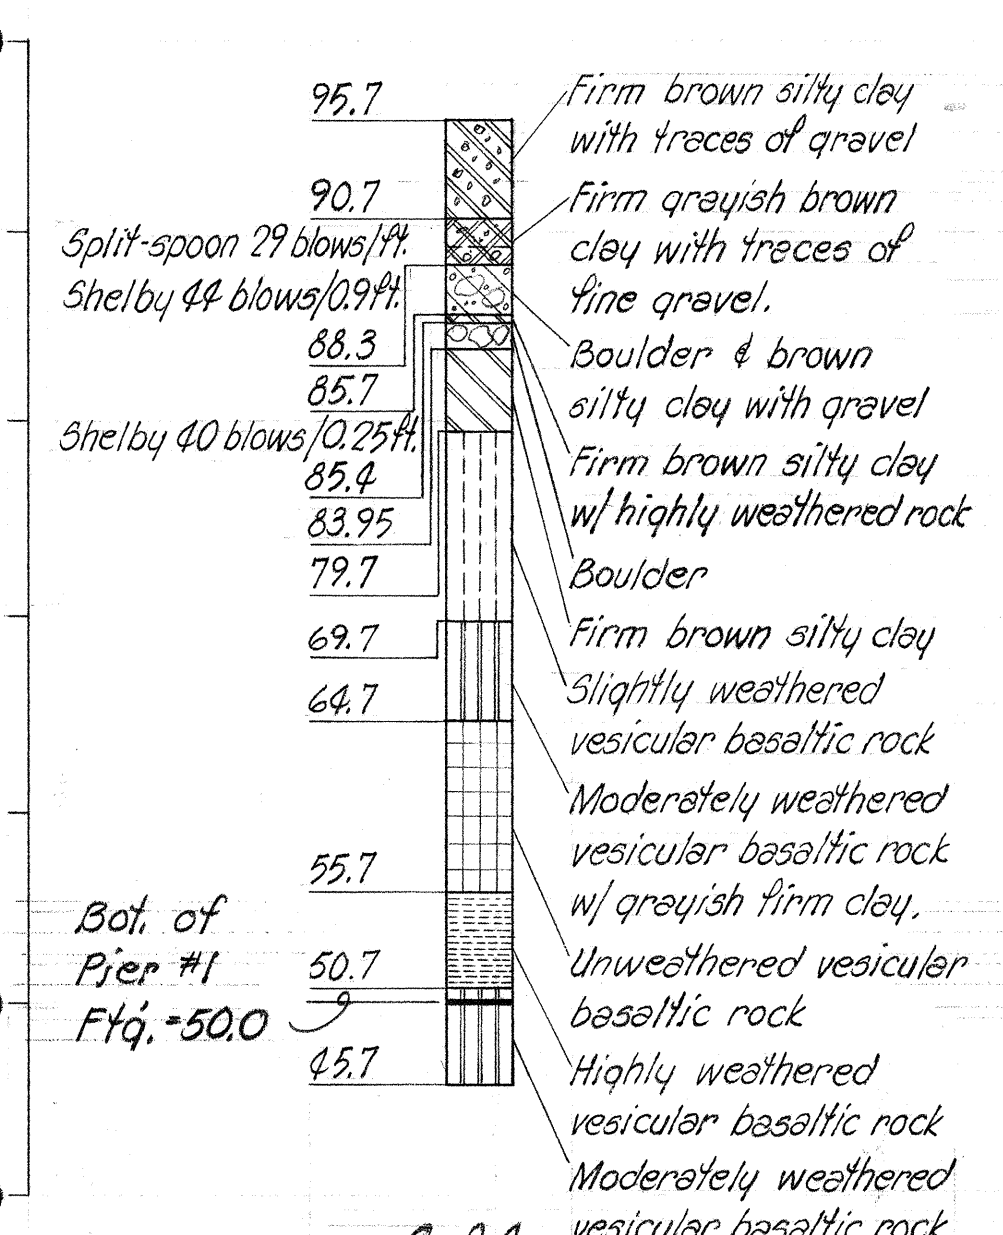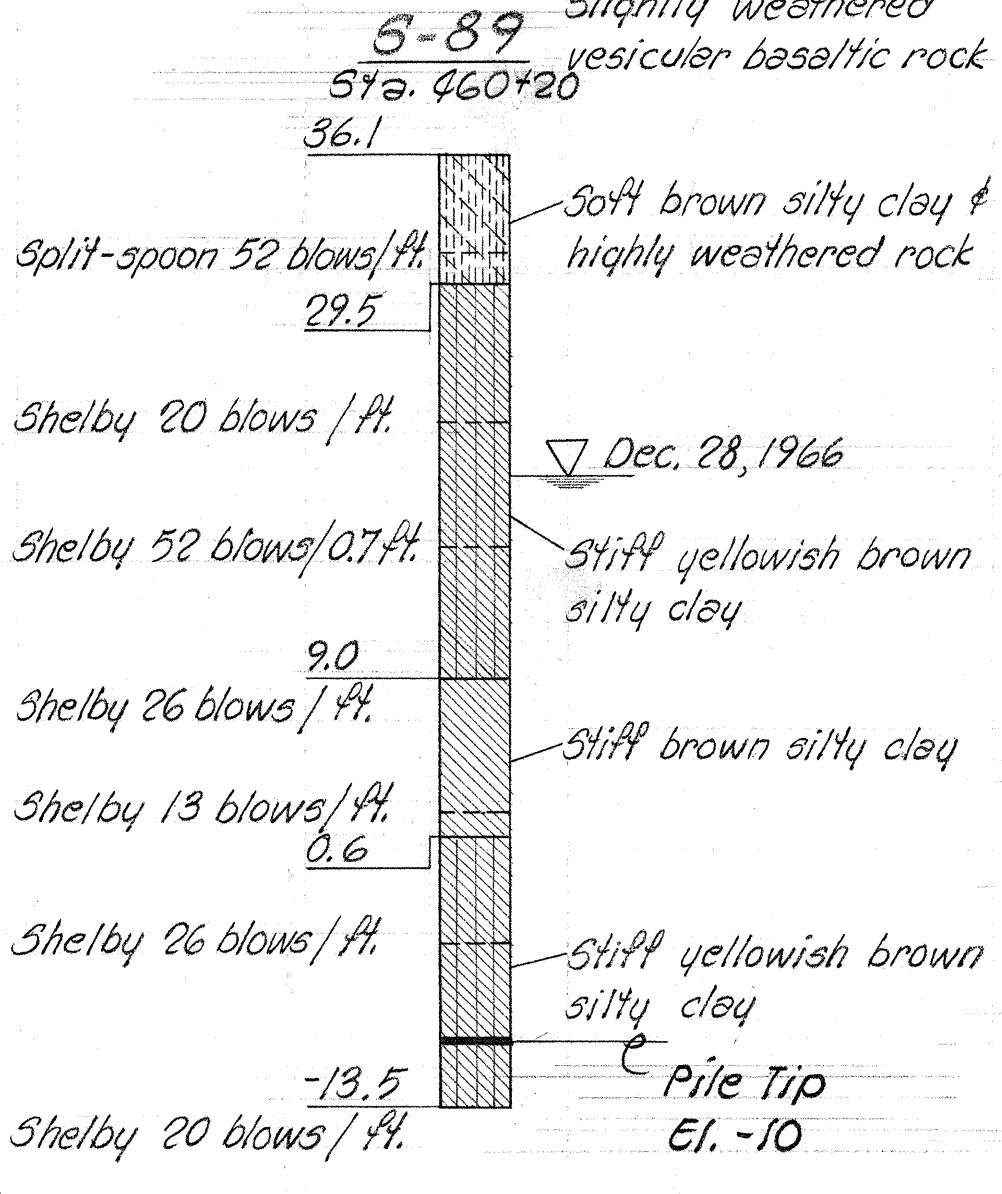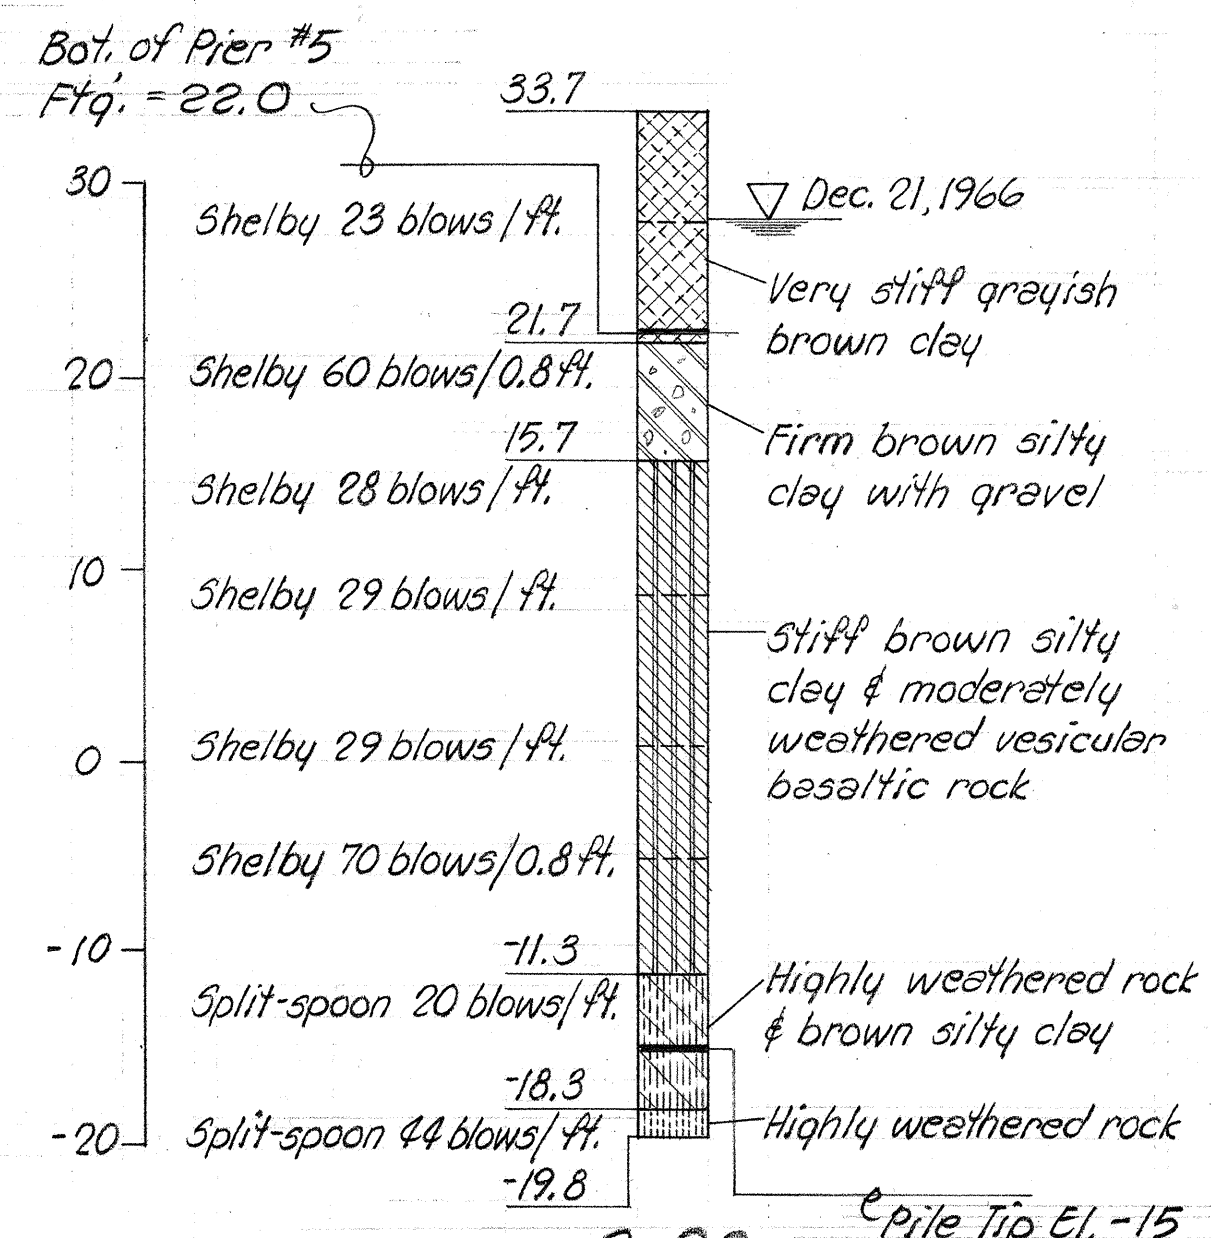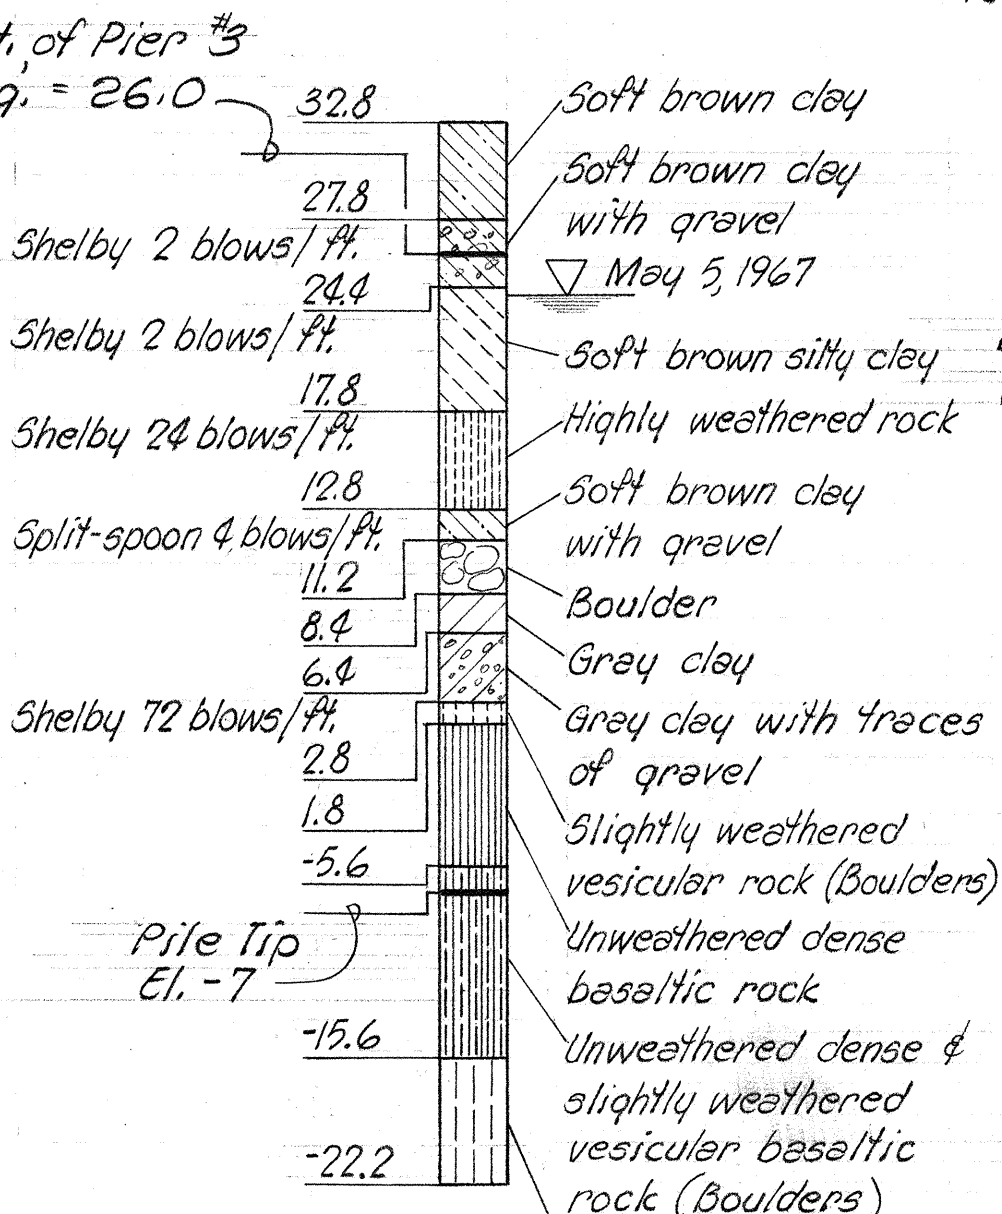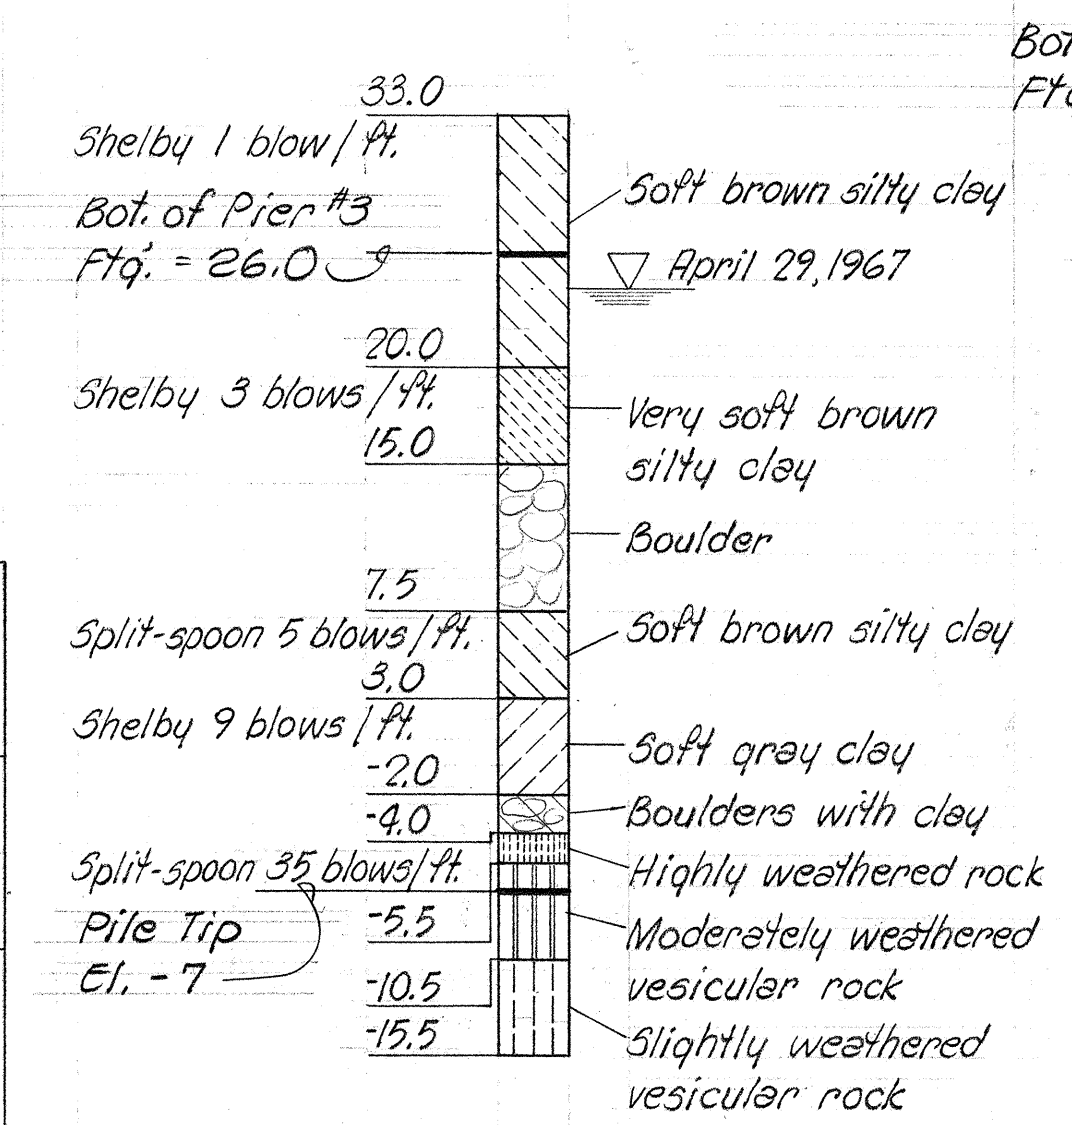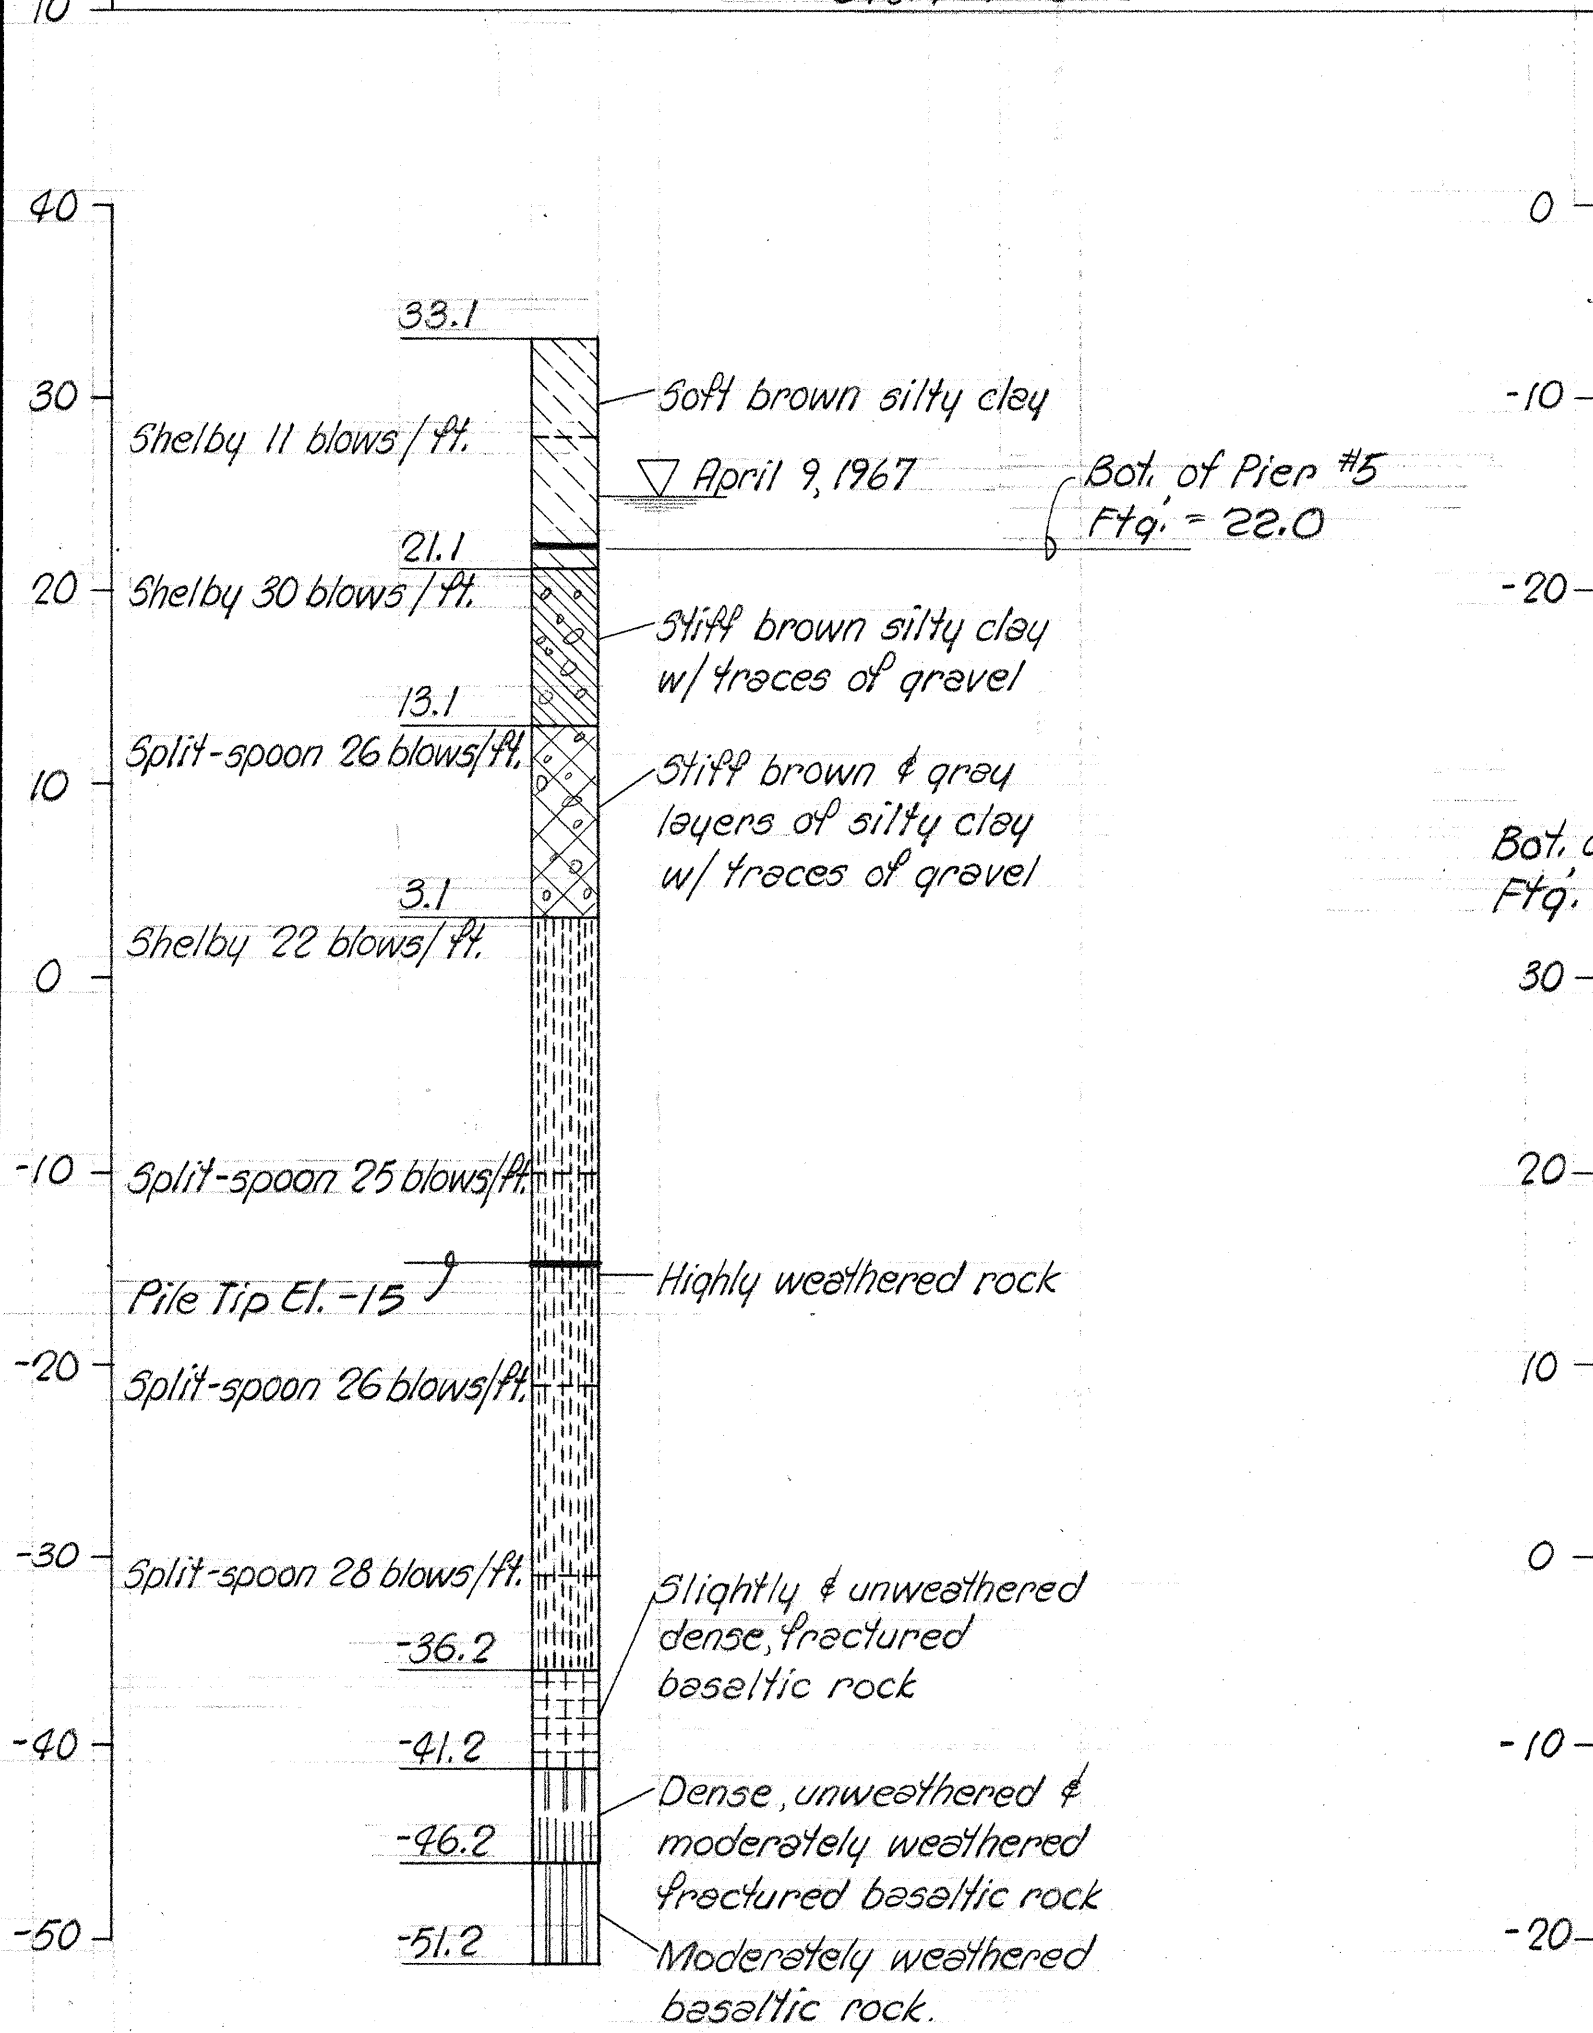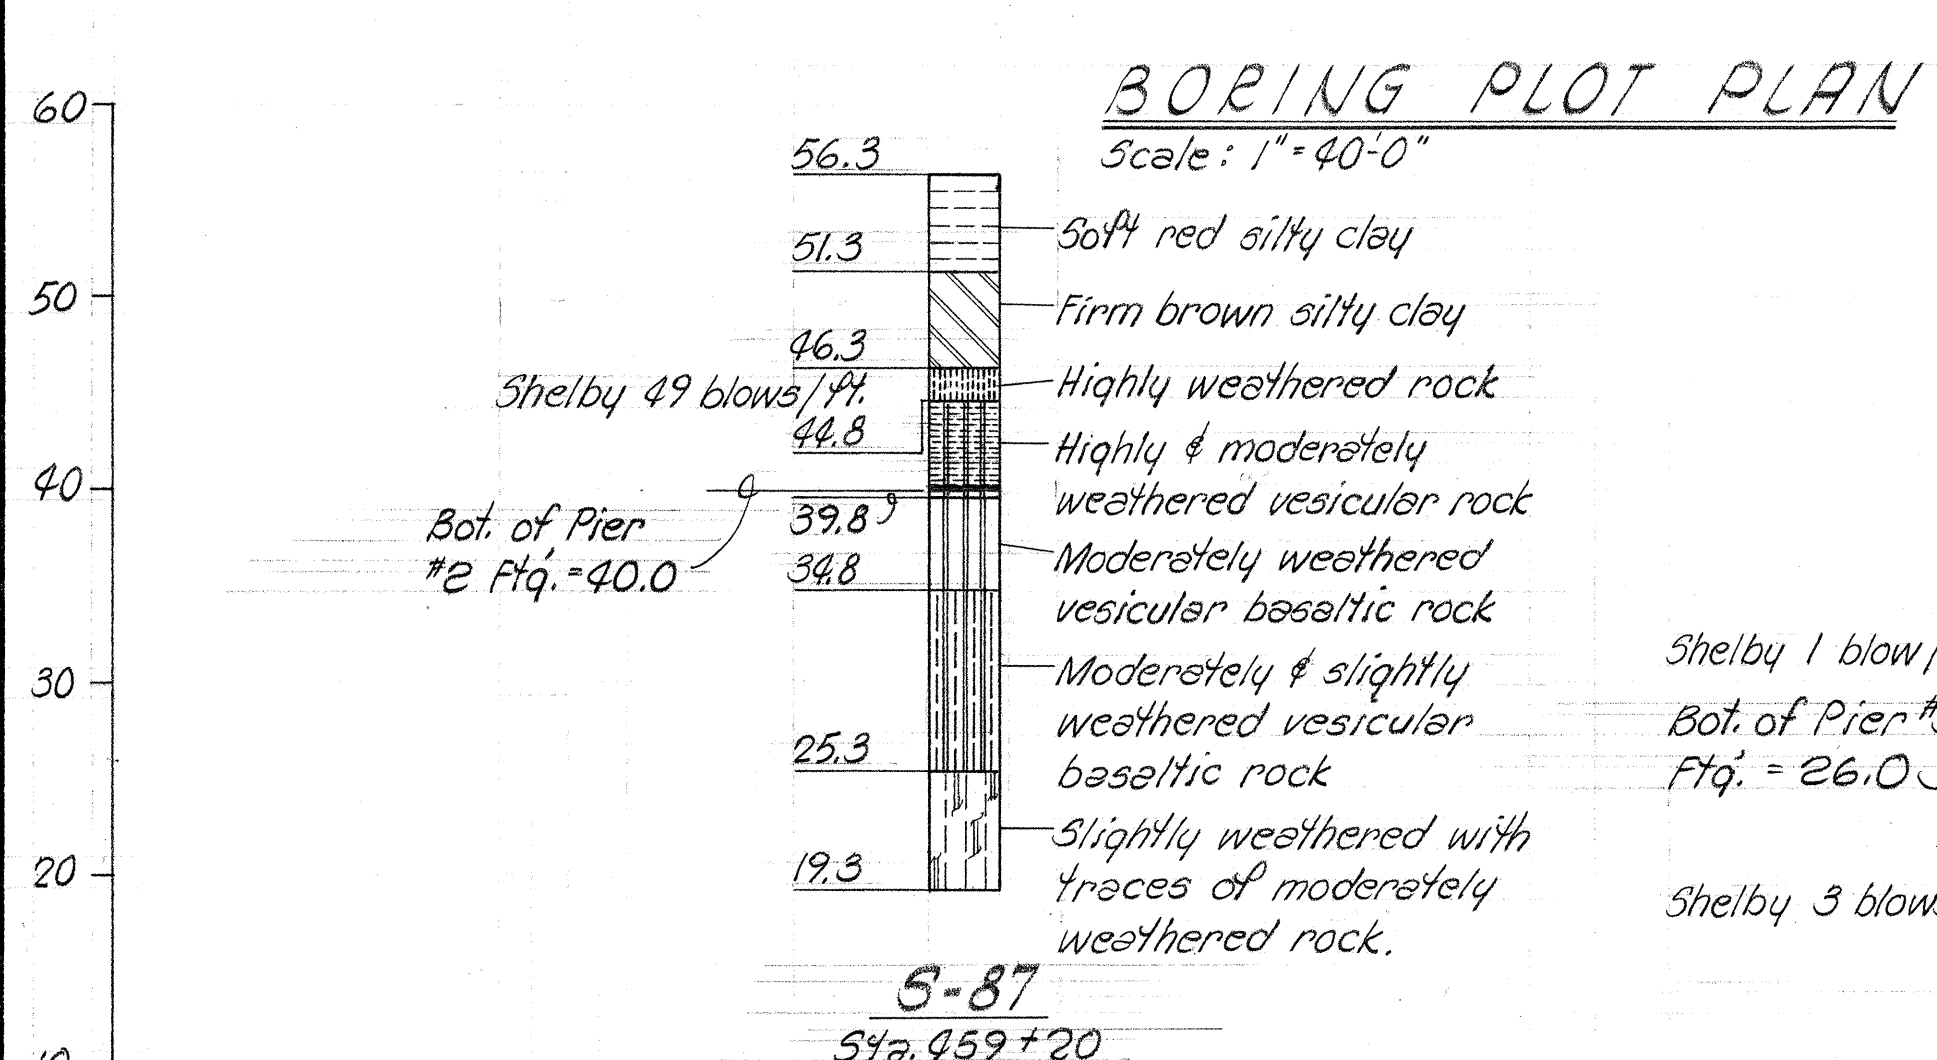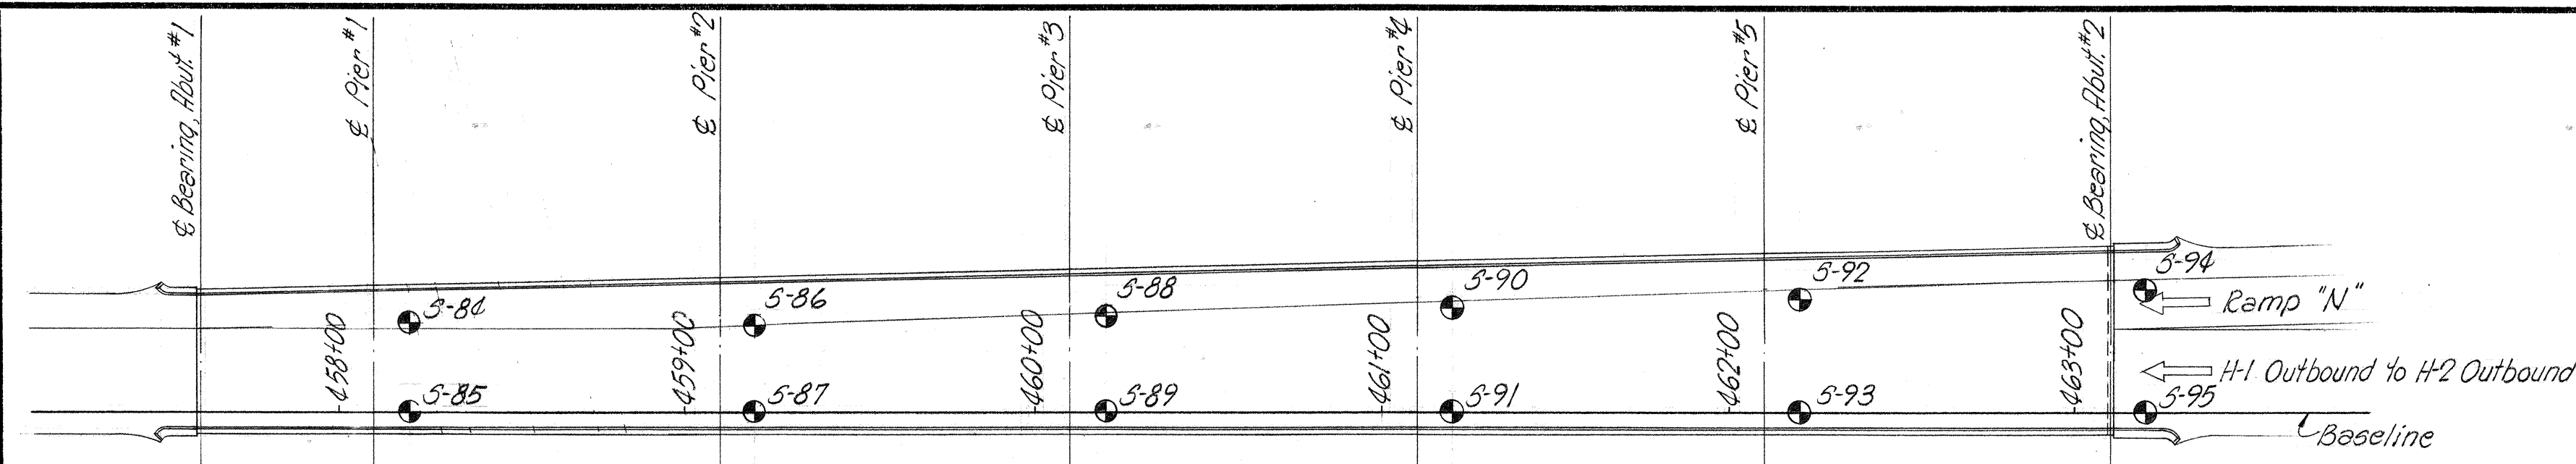

SHIMAZU SHIMABUKURO & FUKUDA, INC.
Consulting Structural Engineers
1210 Ward Ave., Honolulu, HI 96814

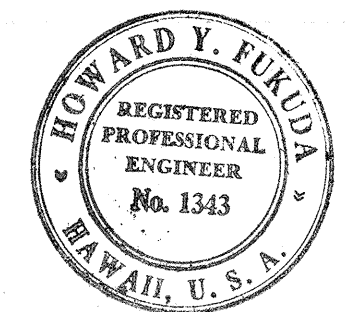

This work was prepared by me or under my supervision.
Howard Y. Fukuda

STATE OF HAWAII
DEPARTMENT OF TRANSPORTATION
HIGHWAYS DIVISION

STRUCTURE NO. 13
BORING LOGS

WAI'AWA INTERCHANGE
F.A.I. Proj. No. I-HI-1(75):8

Scale: As shown. Date: JUNE, 1969
SHEET No. 12 OF 12 SHEETS

BORING LOGS FOR STRUCTURE 13