

WAIAWA INTERCHANGE


STRUCTURE 16

12


For details see Sht. #136

NAME & DATE OF STRUCTURE

Not to Scale

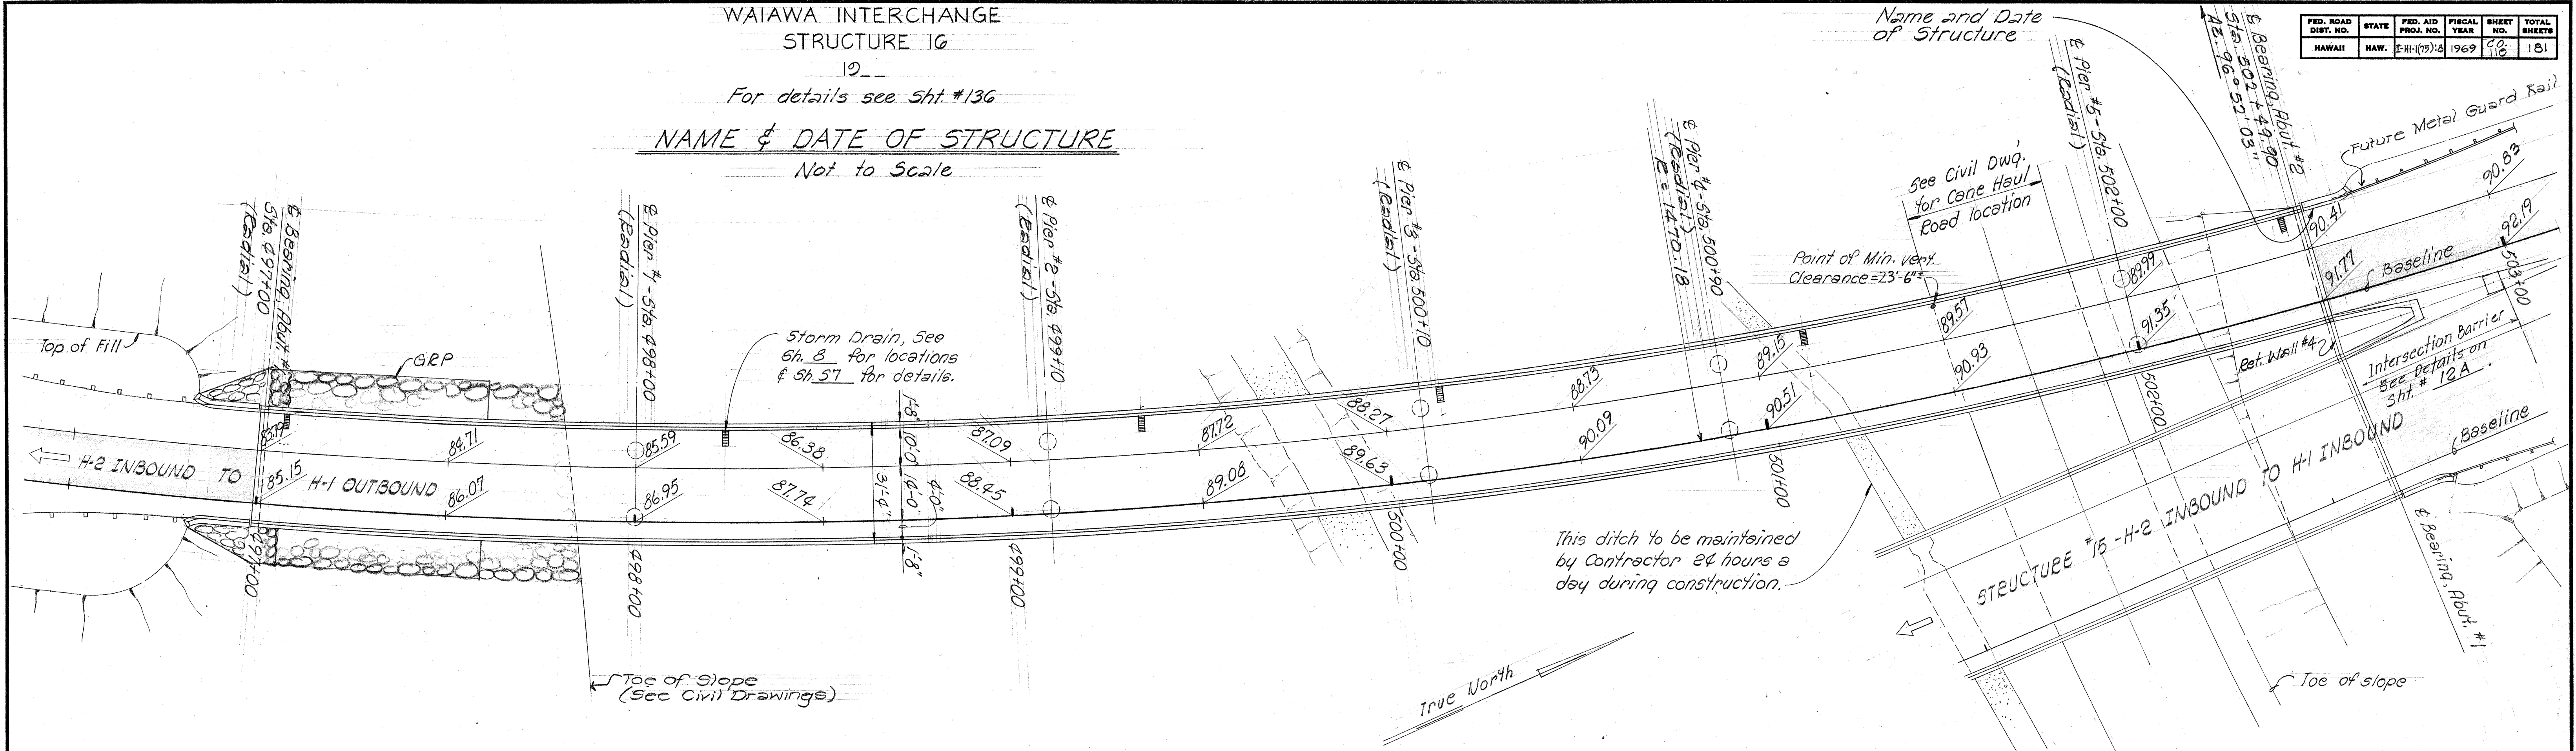

PLAN
Scale: 1" = 20'-0"

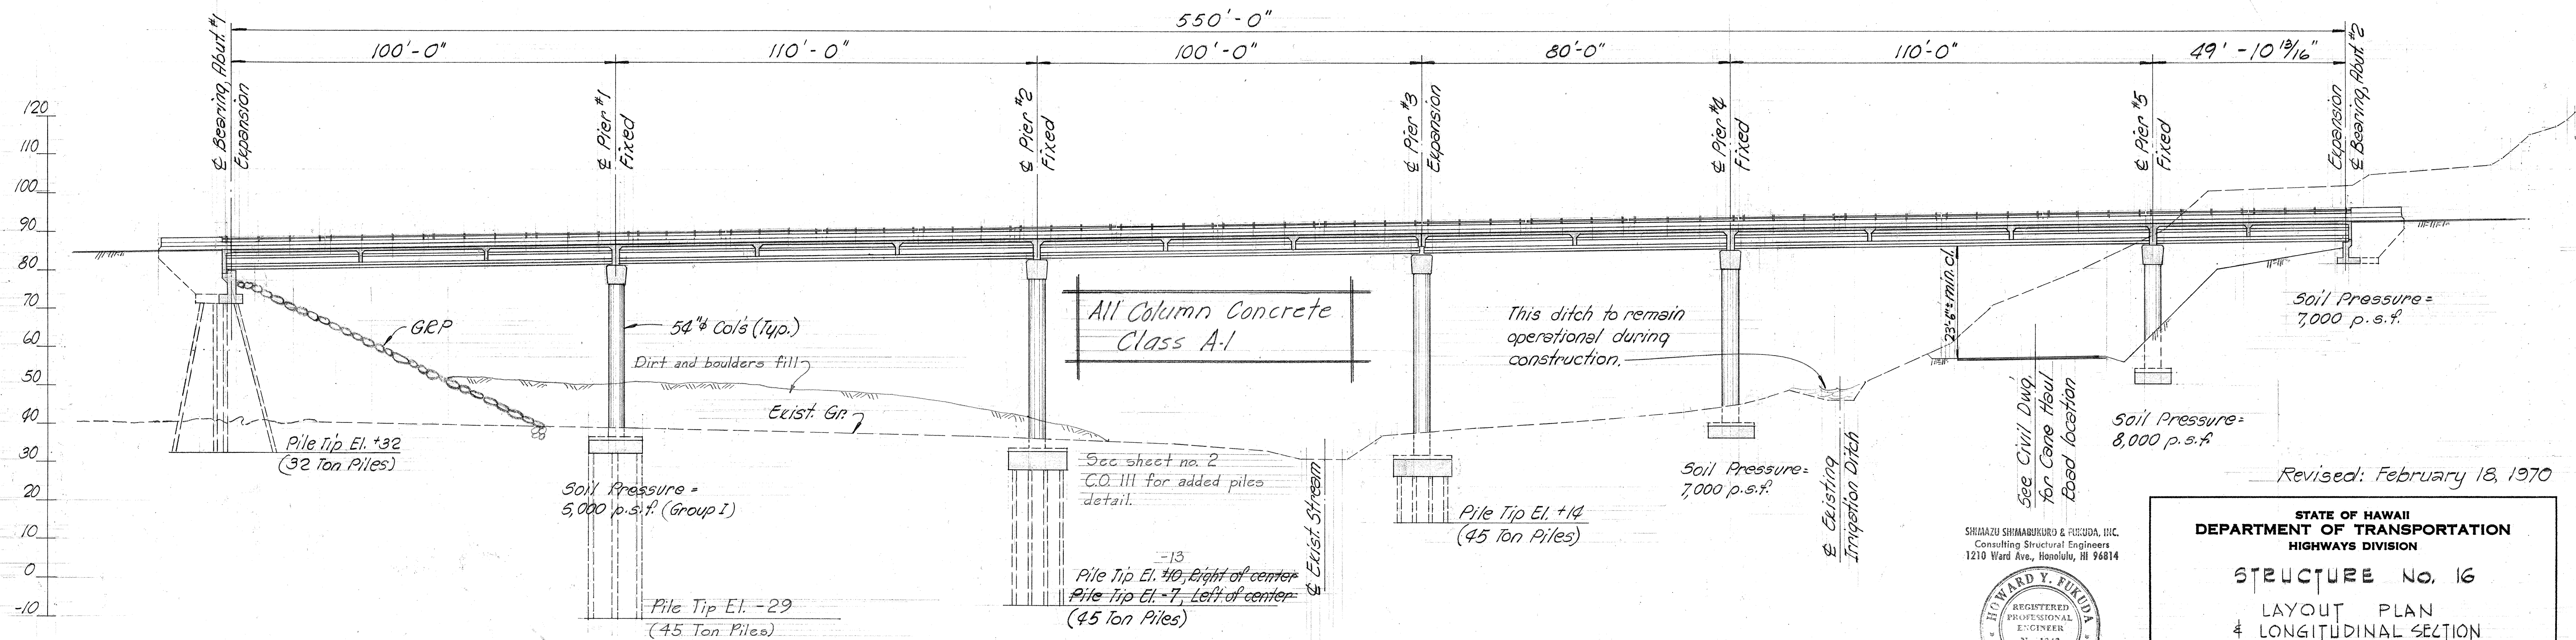


LONGITUDINAL SECTION ALONG BASELINE OF STRUCTURE

Scale: 1" = 20'-0"

THIS SHEET SUPERSEDES
SHEET NO. 110 & ADD. 110

SHIMAZU SHIMABUKURO & FUKUDA, INC.
Consulting Structural Engineers
1210 Ward Ave., Honolulu, HI 96814

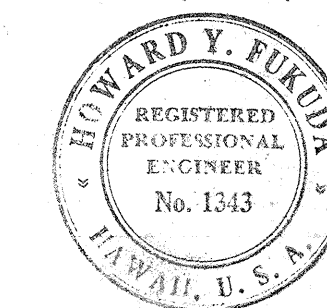

This work was prepared by
me or under my supervision.
Howard Y. Fukuda

STATE OF HAWAII
DEPARTMENT OF TRANSPORTATION
HIGHWAYS DIVISION

STRUCTURE NO. 16

LAYOUT PLAN
& LONGITUDINAL SECTION

WAIAWA INTERCHANGE
F.A.I. Proj. No. I-HI-1 (75):8

Scale: As shown Date: JUNE, 1969


SHEET No. 1 OF 13 SHEETS

JUNE 24, 1971

110

FED. ROAD DIST. NO.	STATE	FED. AID PROJ. NO.	FISCAL YEAR	SHEET NO.	TOTAL SHEETS
HAWAII	HAW.	I-HI-1(75):B	1969	60.111	151

Revision: 12-10-69
2-18-70

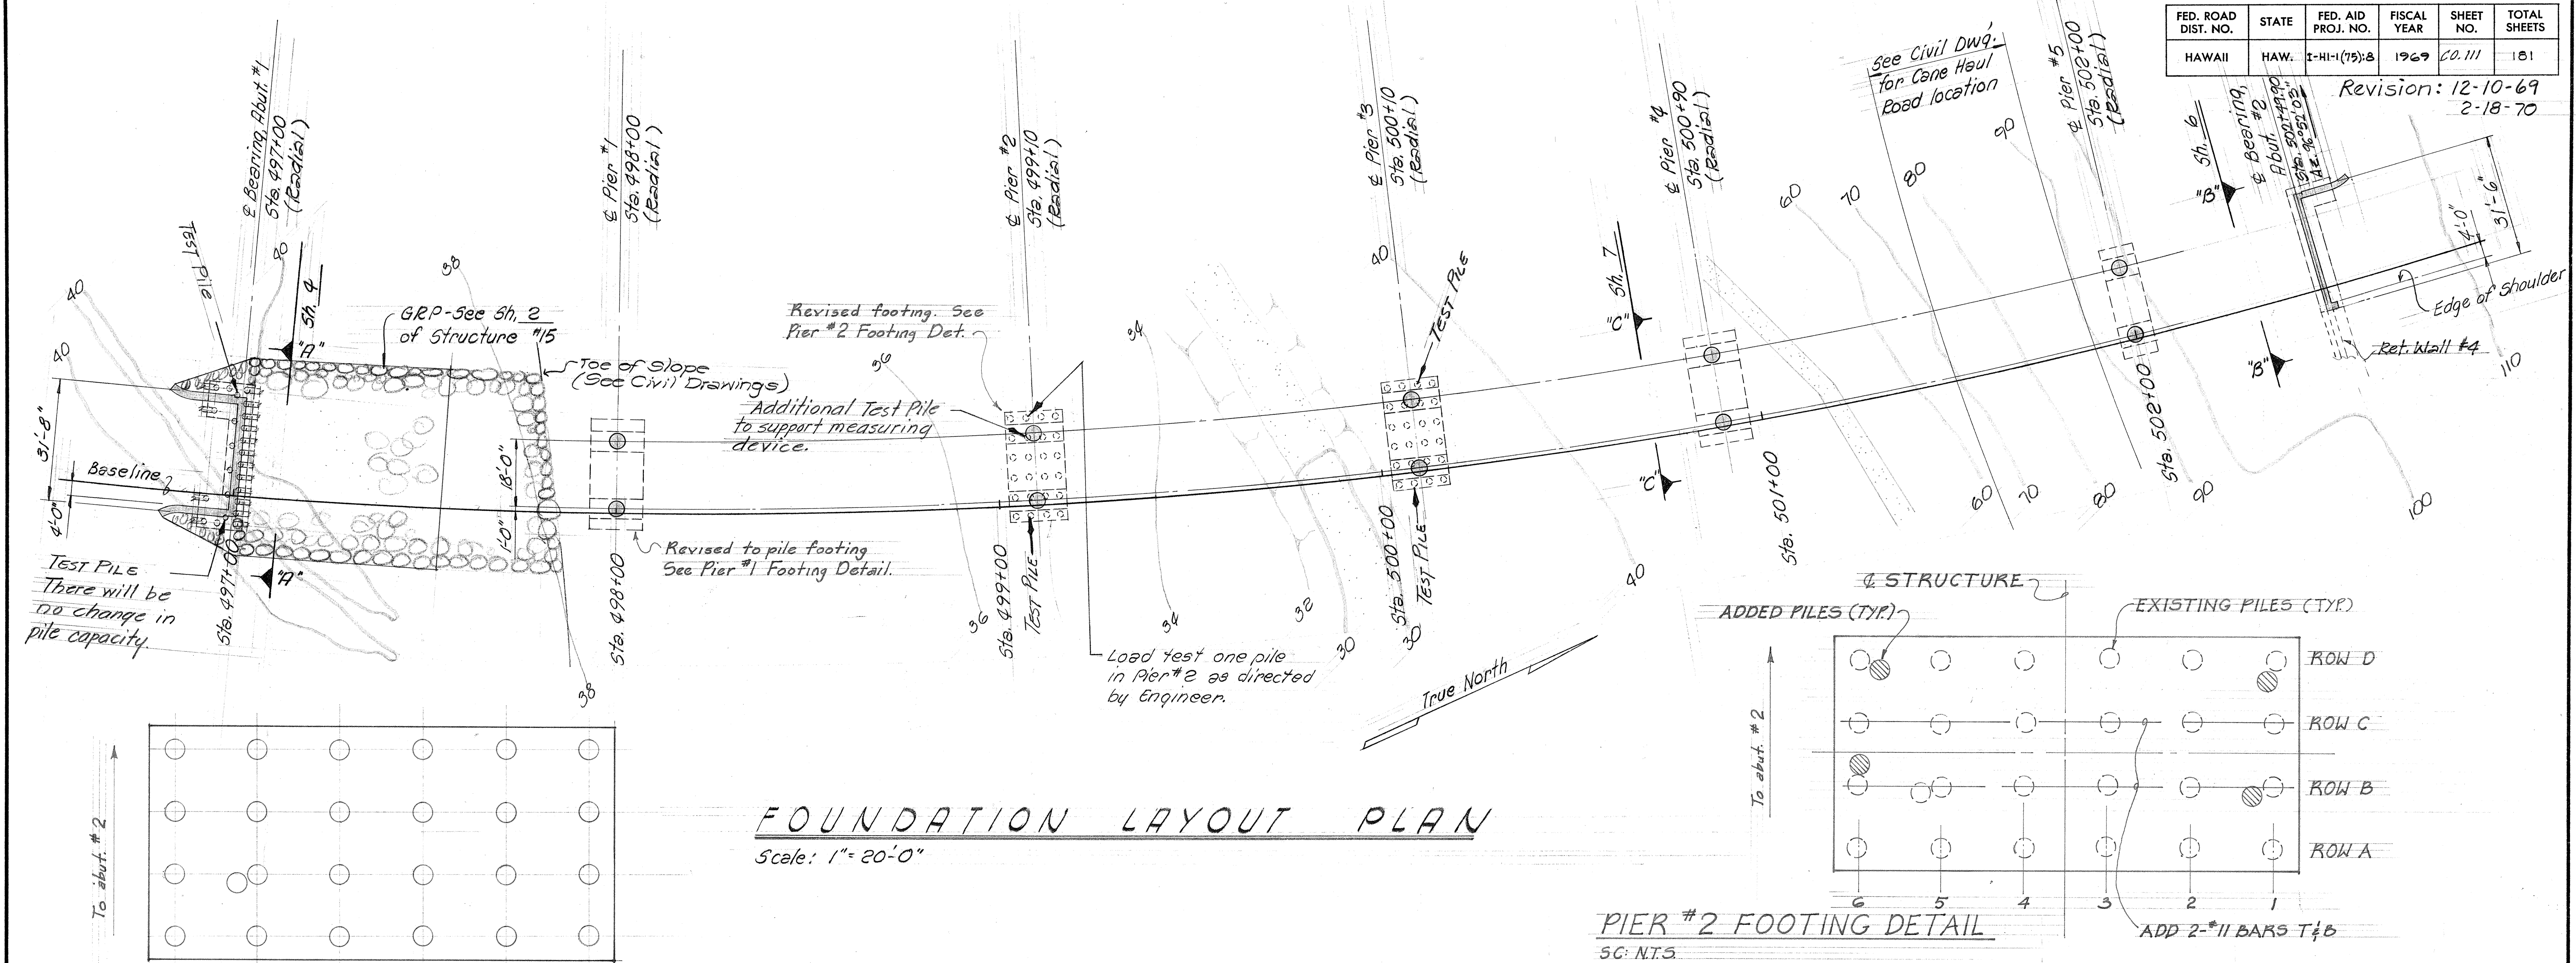

FOUNDATION LAYOUT PLAN
Scale: 1" = 20'-0"

PIER #1 FOOTING DETAIL
SC: N.T.S.

PIER #2 FOOTING DETAIL
SC: N.T.S.

REFERENCE DRAWINGS

1. Abutment #1 Foundations -- Sh. 3
2. Abutment #2 Foundations -- Sh. 5
3. Pier Foundations -- Sh. 52
4. Pier Columns -- Sh. 51
5. General Notes -- Sh. 59

SPECIAL NOTES:

1. See civil drawings for extent of area to be surcharged.
2. No work shall be permitted over surcharged area for 12 months after placement of surcharge.
3. Work permitted on 3 continuous spans adjacent to surcharged area shall not include placing deck slab during period of surcharge application.
4. Work on all other 3 continuous spans shall be permitted.


DESIGN CRITERIA

- A. Loads - HS20-44 or Interstate Loading.
- B. Specifications - Standard Specifications for Highway Bridges, AASHTO, 9th Edition.
- C. Design Stresses
 - a) $f'_c = 3,000$ p.s.i. Concrete unless otherwise noted.
 - b) $f_s = 20,000$ p.s.i. reinforcing steel.
2. Prestressed Girders, See Sh. 38.
3. Pile Capacity, See Longitudinal Section Sh. 1.
4. Allowable Foundation Pressure, See Longitudinal Section, Sh. 1.

BRIDGE QUANTITY ESTIMATES

ITEM #	ITEM	UNIT	QUANTITY
14.60	Structure Excavation for Bridges	C.Y.	889
46.067	Concrete in Structure #16 (Except in Footings)	L.S.	872 C.Y.
46.068	Concrete in Footings for Structure #16	L.S.	302 C.Y.
46P.18	Type III Prestressed Concrete Girders for Structure #16	L.S.	3272 L.F.
48.64	Reinforcing Steel in Structure #16	L.S.	376,530 LB
51.06	Pile Load Test for Structure #16	EA.	One (1)
51.98	Furnishing Conc. Piles for Structure #16	L.F.	2,148
51.99	Driving Conc. Piles for Structure #16	L.F.	1,691
52.10	Filter Material for Structures	C.Y.	98
55.10	Metal Bridge Rail	L.F.	1100.18
55.50	Concrete Bridge Parapet, Including End Post	L.F.	1155.96
65.04	Grouted Rubble Paving for Bridges	C.Y.	163
51.07	Driving Test Piles for Structure #16	L.F.	207

SHIMAZU SHIMABUKURO & FUKUDA, INC.
Consulting Structural Engineers
1210 Ward Ave., Honolulu, HI 96814

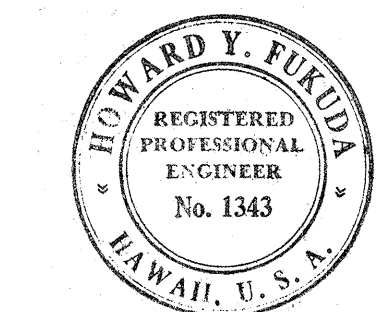

This work was prepared by me or under my supervision.
Howard Y. Fukuda

STATE OF HAWAII
DEPARTMENT OF TRANSPORTATION
HIGHWAYS DIVISION


STRUCTURE No. 16
FOUNDATION LAYOUT PLAN

WAIKAWA INTERCHANGE
F.A.I. Proj. No. I-HI-1(75):B

Scale: As shown Date: JUNE, 1969
SHEET NO. 2 OF 13 SHEETS

JUNE 24, 1971 C.O. III


FED. ROAD DIST. NO.	STATE	FED. AID PROJ. NO.	FISCAL YEAR	SHEET NO.	TOTAL SHEETS
HAWAII	HAW.	I-HI-1(75):8	1969	113	181

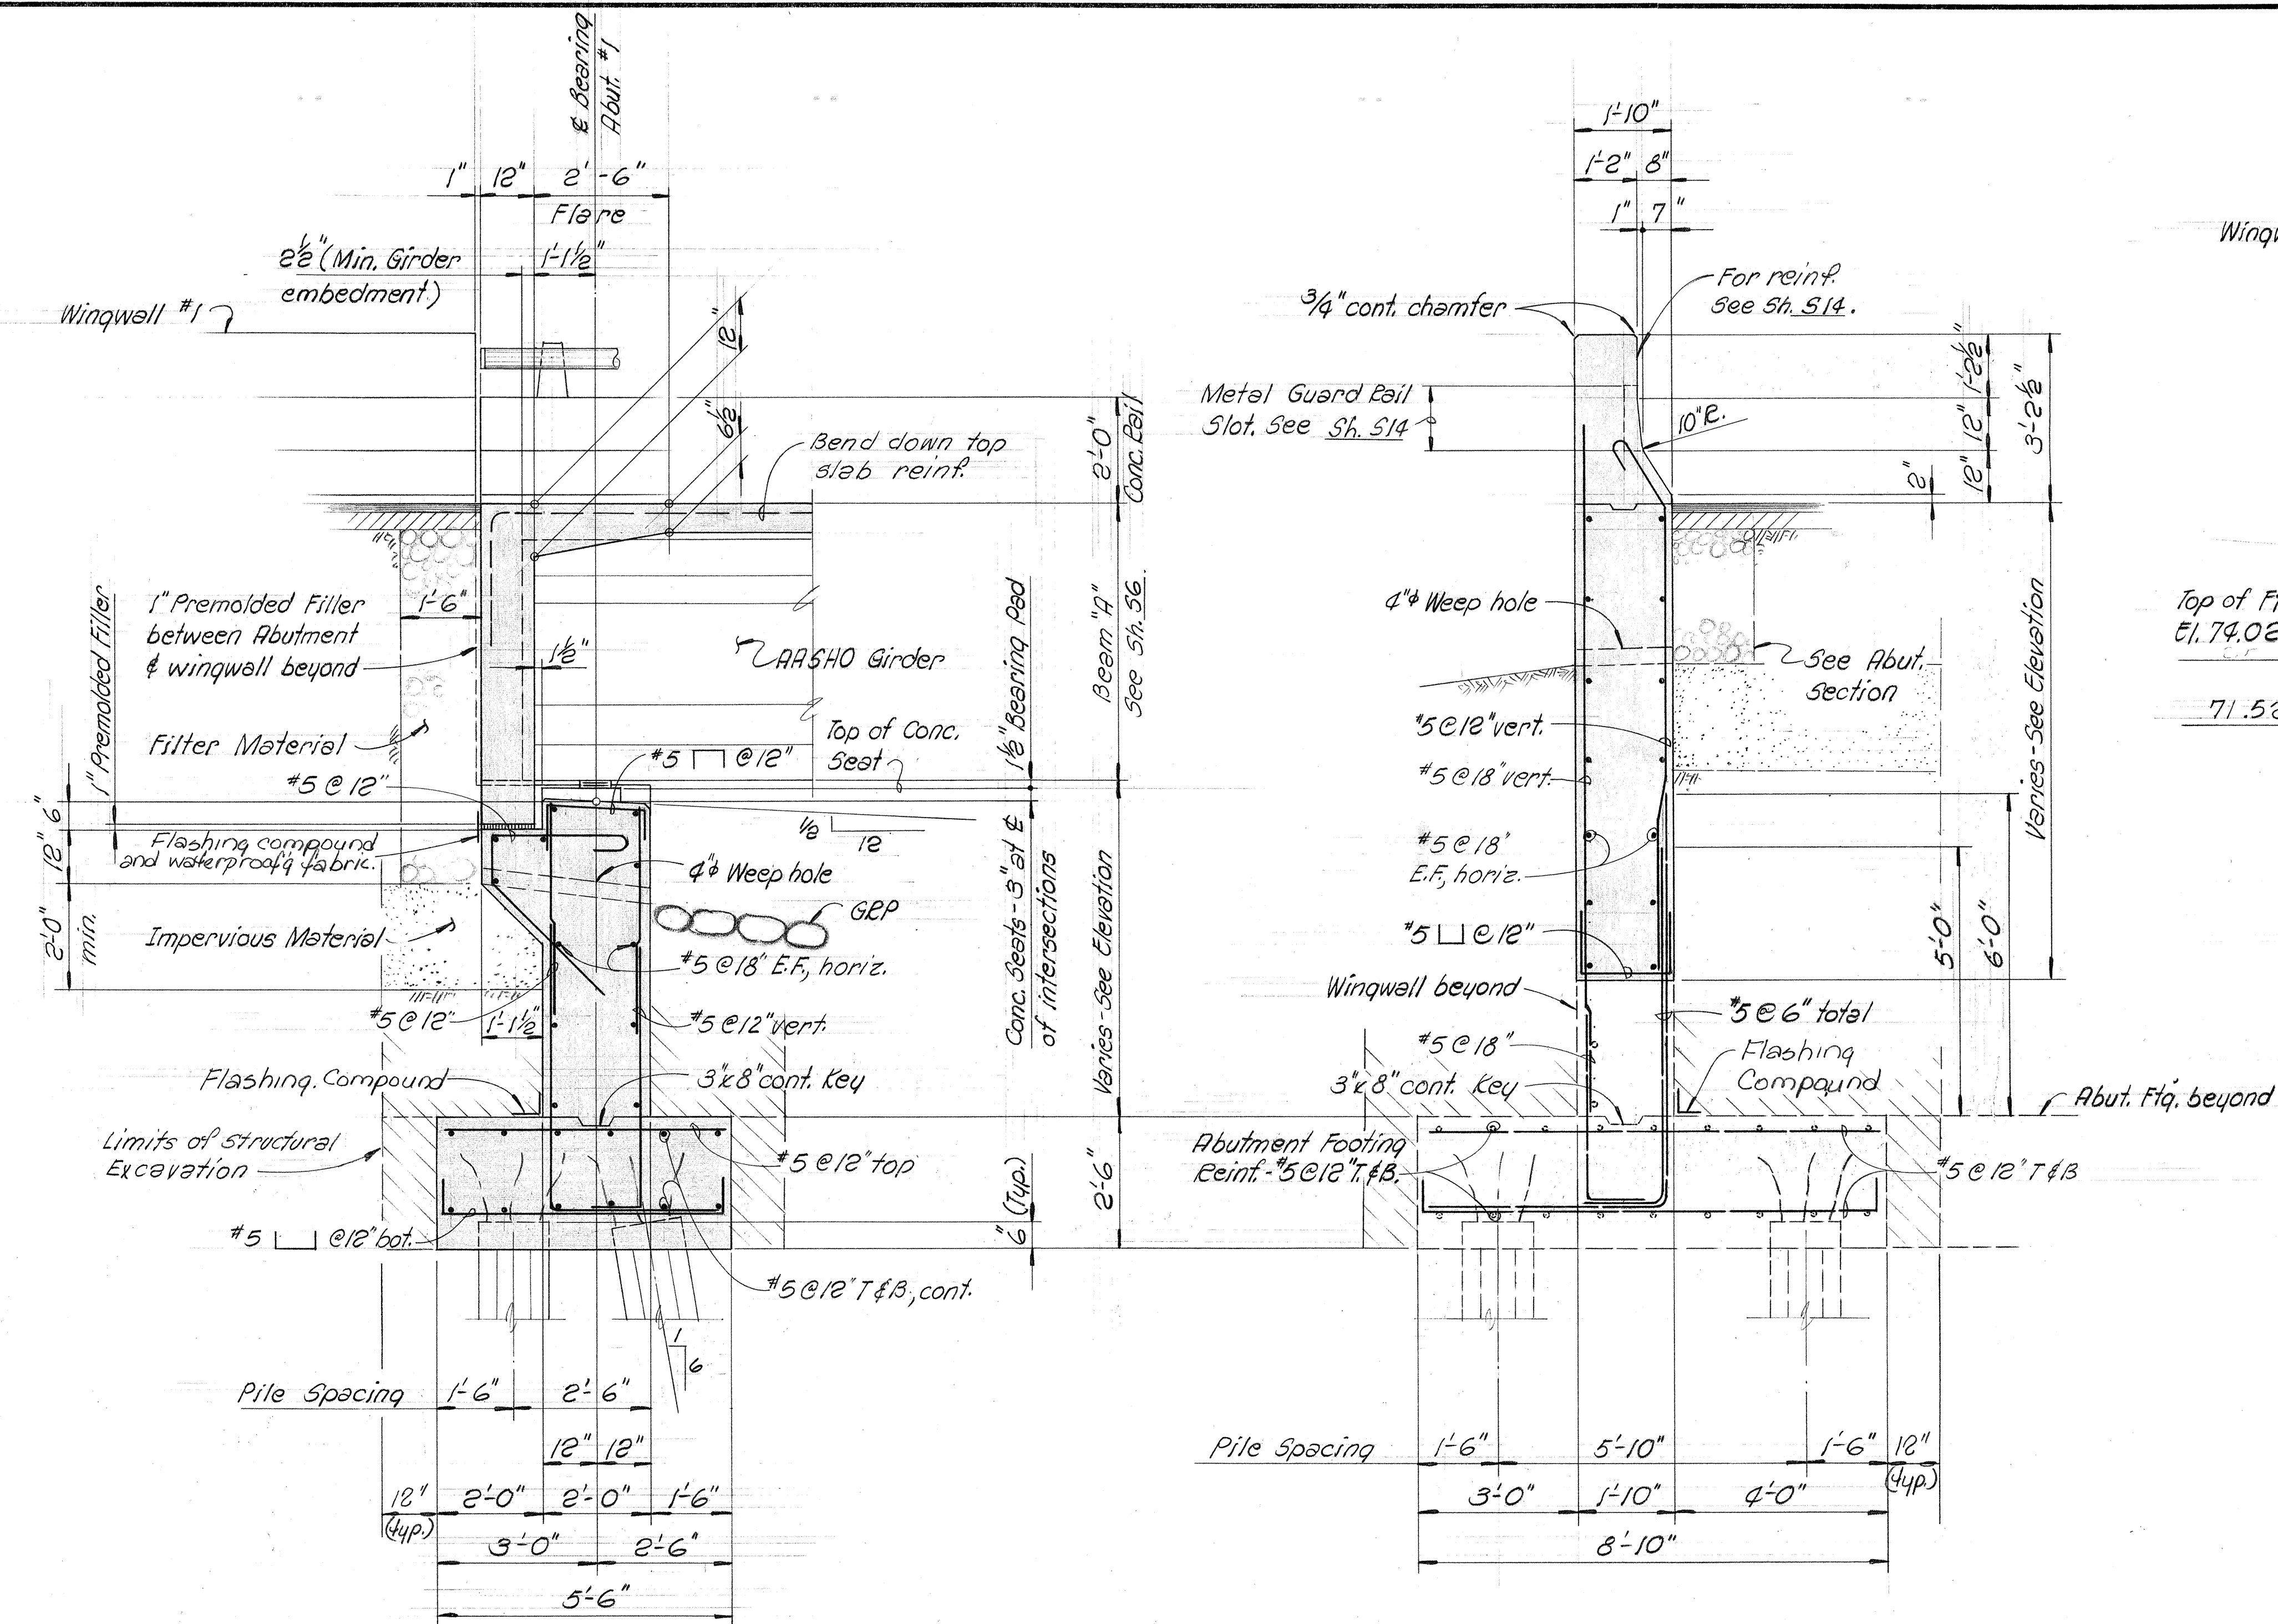

ABUTMENT #1 SECTION
Scale: 1/2" = 1'-0"

WINGWALL #1 SECTION
Scale: 1/2" = 1'-0" (Wingwall #2 similar)


WINGWALL #1 ELEVATION
Scale: 1/4" = 1'-0" (Wingwall #2 similar)

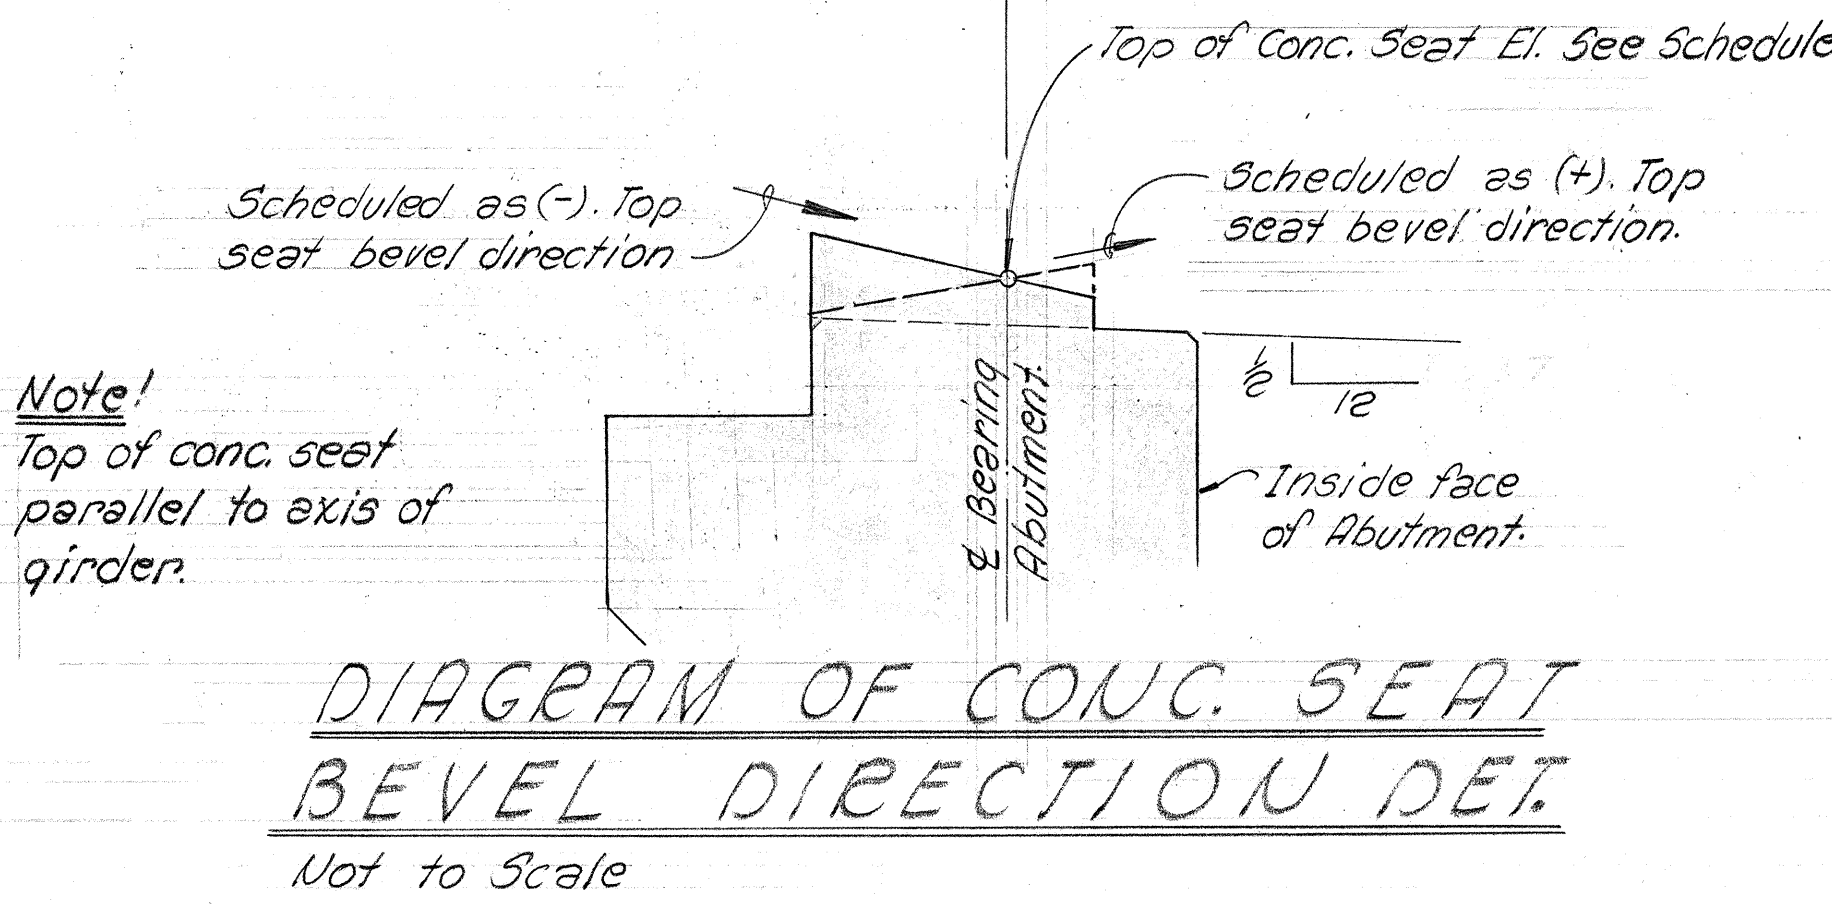

Girders	Top of Slab	Bottom of Girder	Top of Conc. Seat	Conc. Seat Bevels
G-1	82.93	77.44	77.31	+ 1/4 : 12
G-2	83.45	77.95	77.83	+ 3/8 : 12
G-3	83.97	78.47	78.34	+ 1/2 : 12
G-4	84.49	78.99	78.87	+ 5/8 : 12
G-5	85.00	79.51	79.38	+ 7/8 : 12
G-6	85.52	80.03	79.90	+ 1 : 12

Girders	Top of Slab	Bottom of Girder	Top of Conc. Seat	Conc. Seat Bevels
G-1	82.93	77.60	77.48	+ 1/4 : 12
G-2	83.45	78.12	78.00	+ 1/4 : 12
G-3	83.97	78.64	78.52	+ 1/4 : 12
G-4	84.49	79.16	79.03	+ 1/4 : 12
G-5	85.00	79.68	79.55	+ 1/4 : 12
G-6	85.52	80.20	80.07	+ 1/4 : 12

Note:
1. Elevations are at $\pm$ intersections.
2. Girder seat bevel direction - see diagram this sheet.

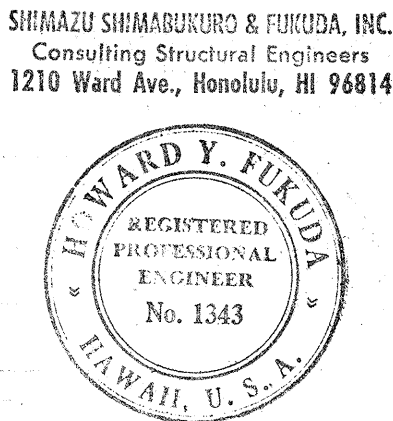

STATE OF HAWAII
DEPARTMENT OF TRANSPORTATION
HIGHWAYS DIVISION


STRUCTURE NO. 16
ABUTMENT #1 + WINGWALL #1
SECTIONS & ELEVATIONS

WAIKAWA INTERCHANGE
F.A.I. Proj. No. I-HI-1 (75):8
Scale: As shown Date: JUNE, 1969
SHEET NO. 4 OF 13 SHEETS

DATE: _____
DRAWN BY: _____
DESIGNED BY: _____
CHECKED BY: _____
ORIGINAL PLAN: _____
NOTE BOOK: _____

Revised: February 18, 1970

FED. ROAD DIST. NO.	STATE	FED. AID PROJ. NO.	FISCAL YEAR	SHEET NO.	TOTAL SHEETS
HAWAII	HAW.	1-HH(75):8	1969	10114	181

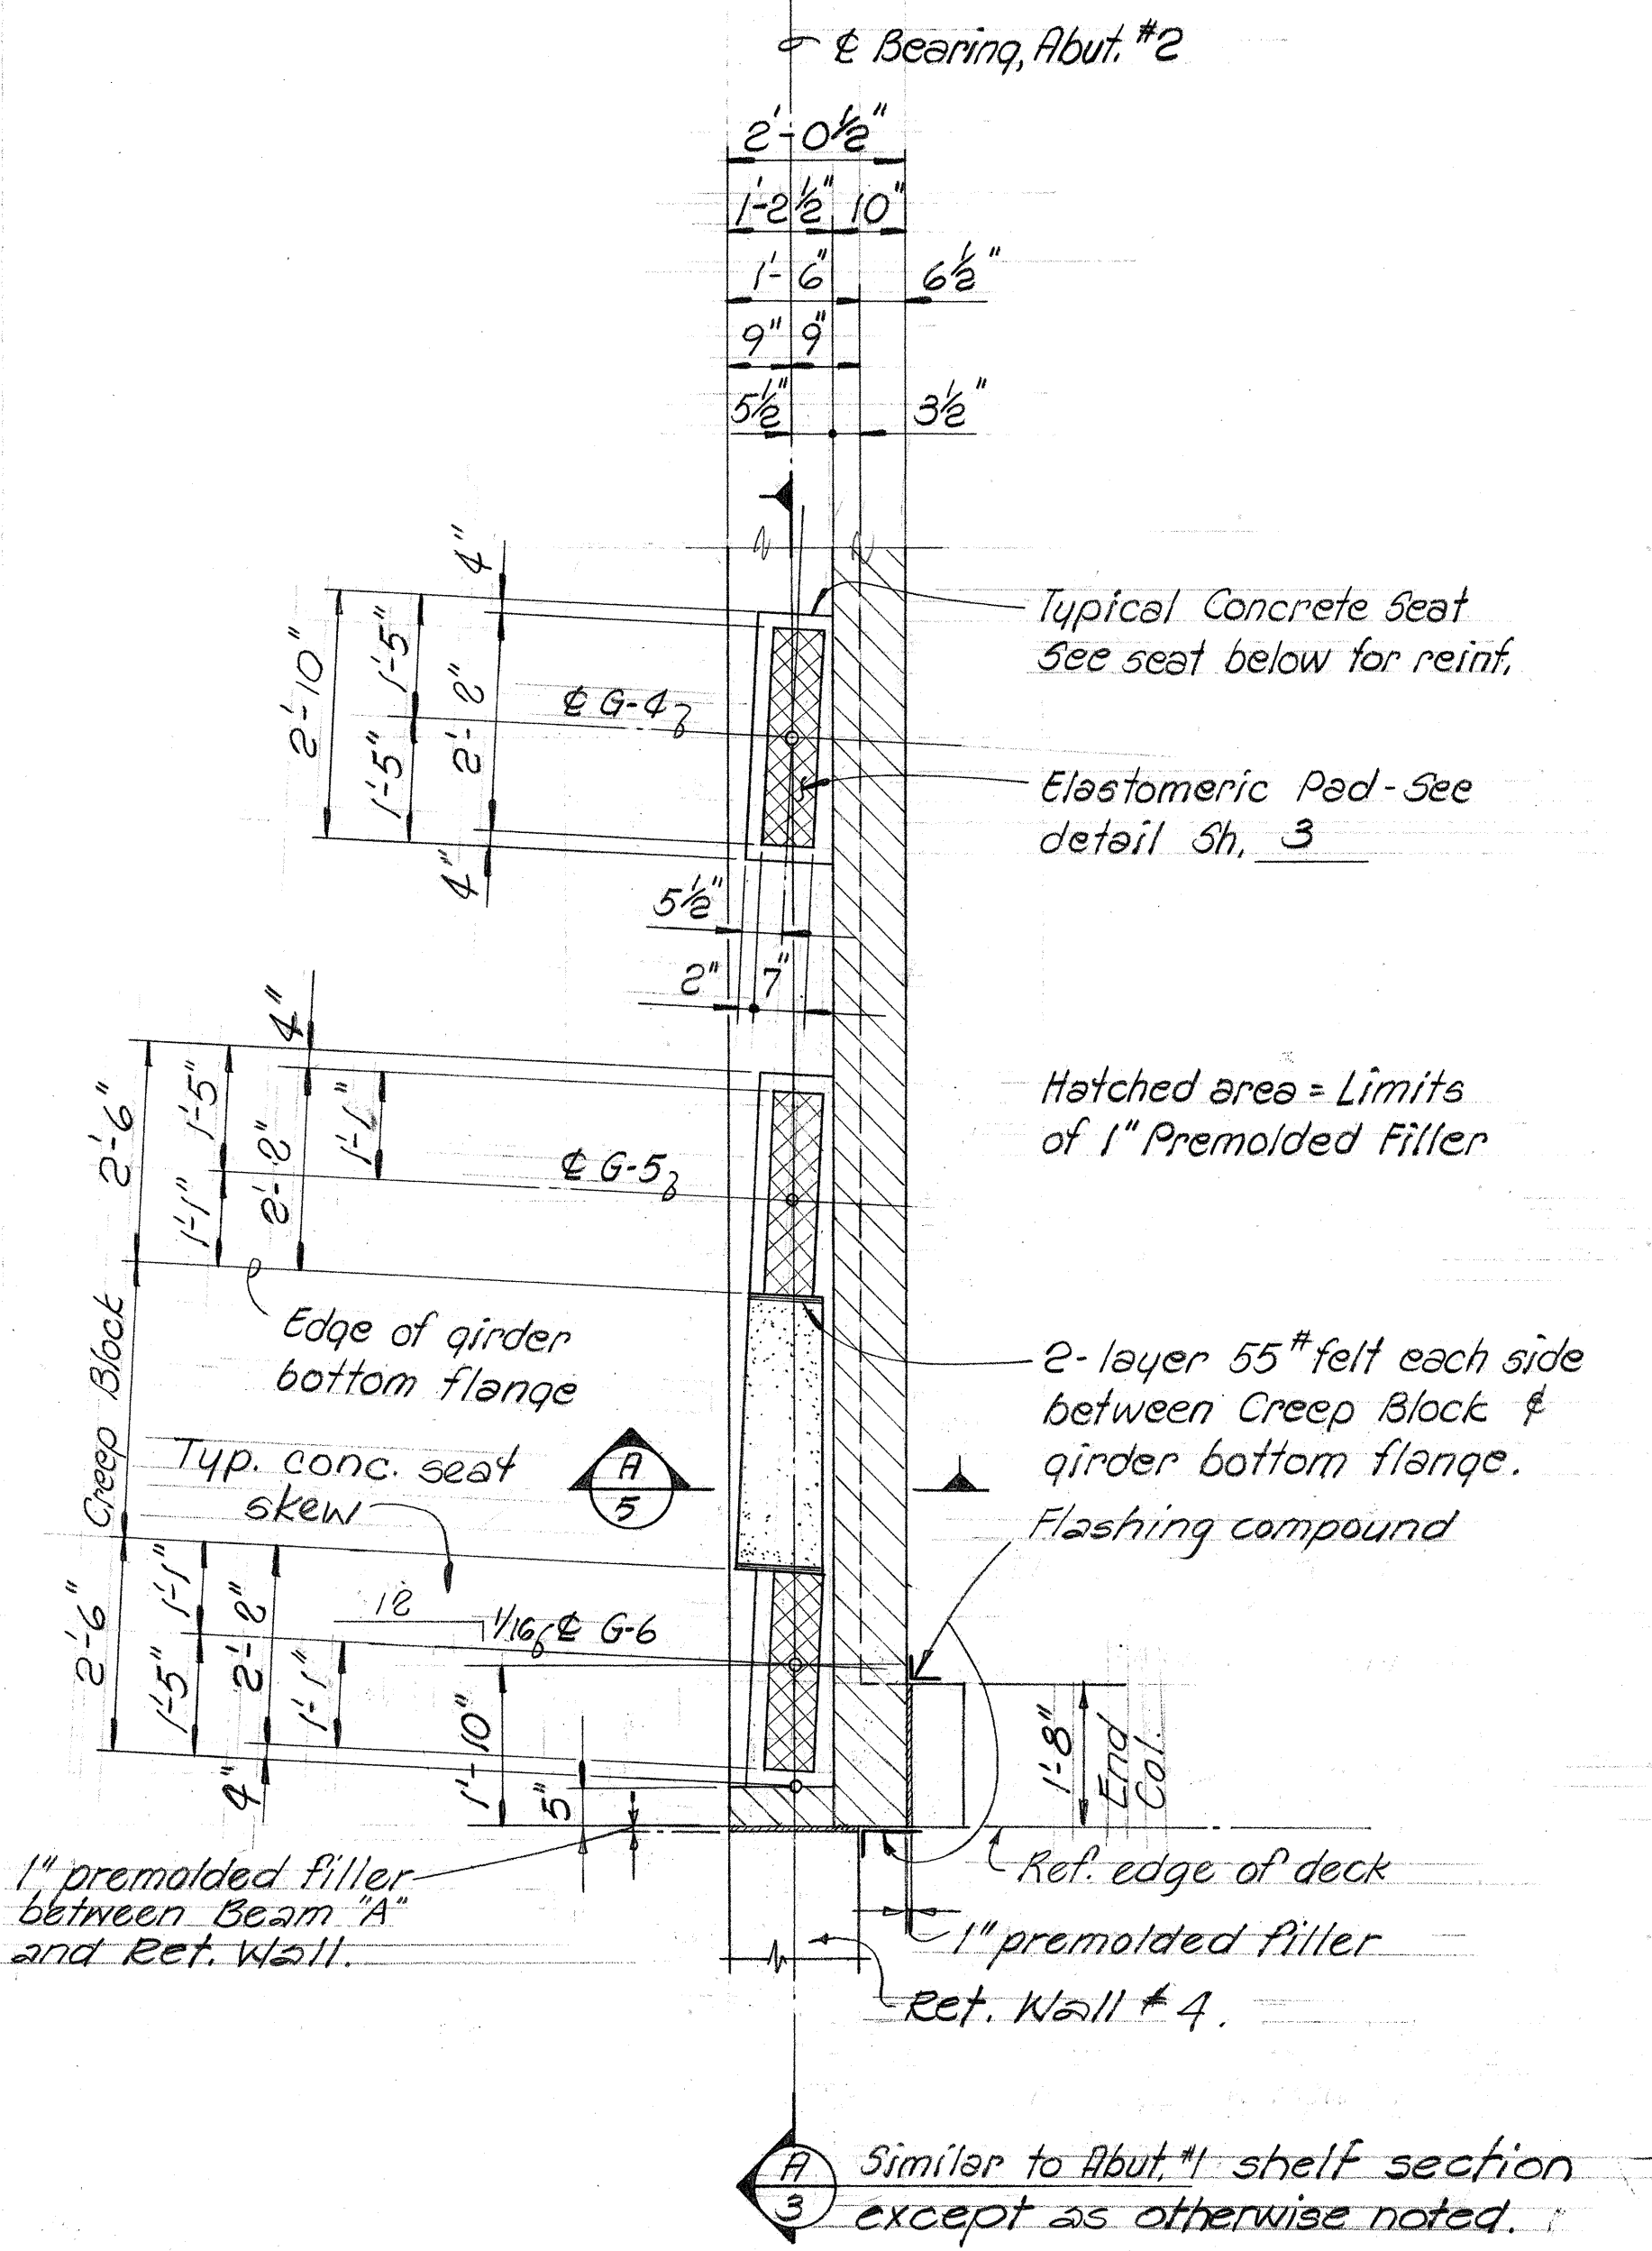

PART PLAN - ABUTMENT #2
CONCRETE SEAT & CREEP BLOCK DETAILS
Scale: 1/2" = 1'-0"

THIS SHEET SUPERSEDES
SHEET NO. 114 & ADD. 114

SHIMAZU SHIMAZUKI & FUKUDA, INC.
Consulting Structural Engineers
1210 Ward Ave., Honolulu, HI 96814



This work was prepared by
me or under my supervision.
Howard Y. Fukuda

STATE OF HAWAII
DEPARTMENT OF TRANSPORTATION
HIGHWAYS DIVISION

STRUCTURE No. 16
ABUTMENT #2 PLANS
& CONCRETE SEAT & CREEP BLOCK DETAILS


WAIKAWA INTERCHANGE
F.A.I. Proj. No. 1-HI-1 (75):8

Scale: As shown Date: JUNE, 1969

SHEET No. 5 OF 13 SHEETS

JUNE 24, 1971

C (1) .1114

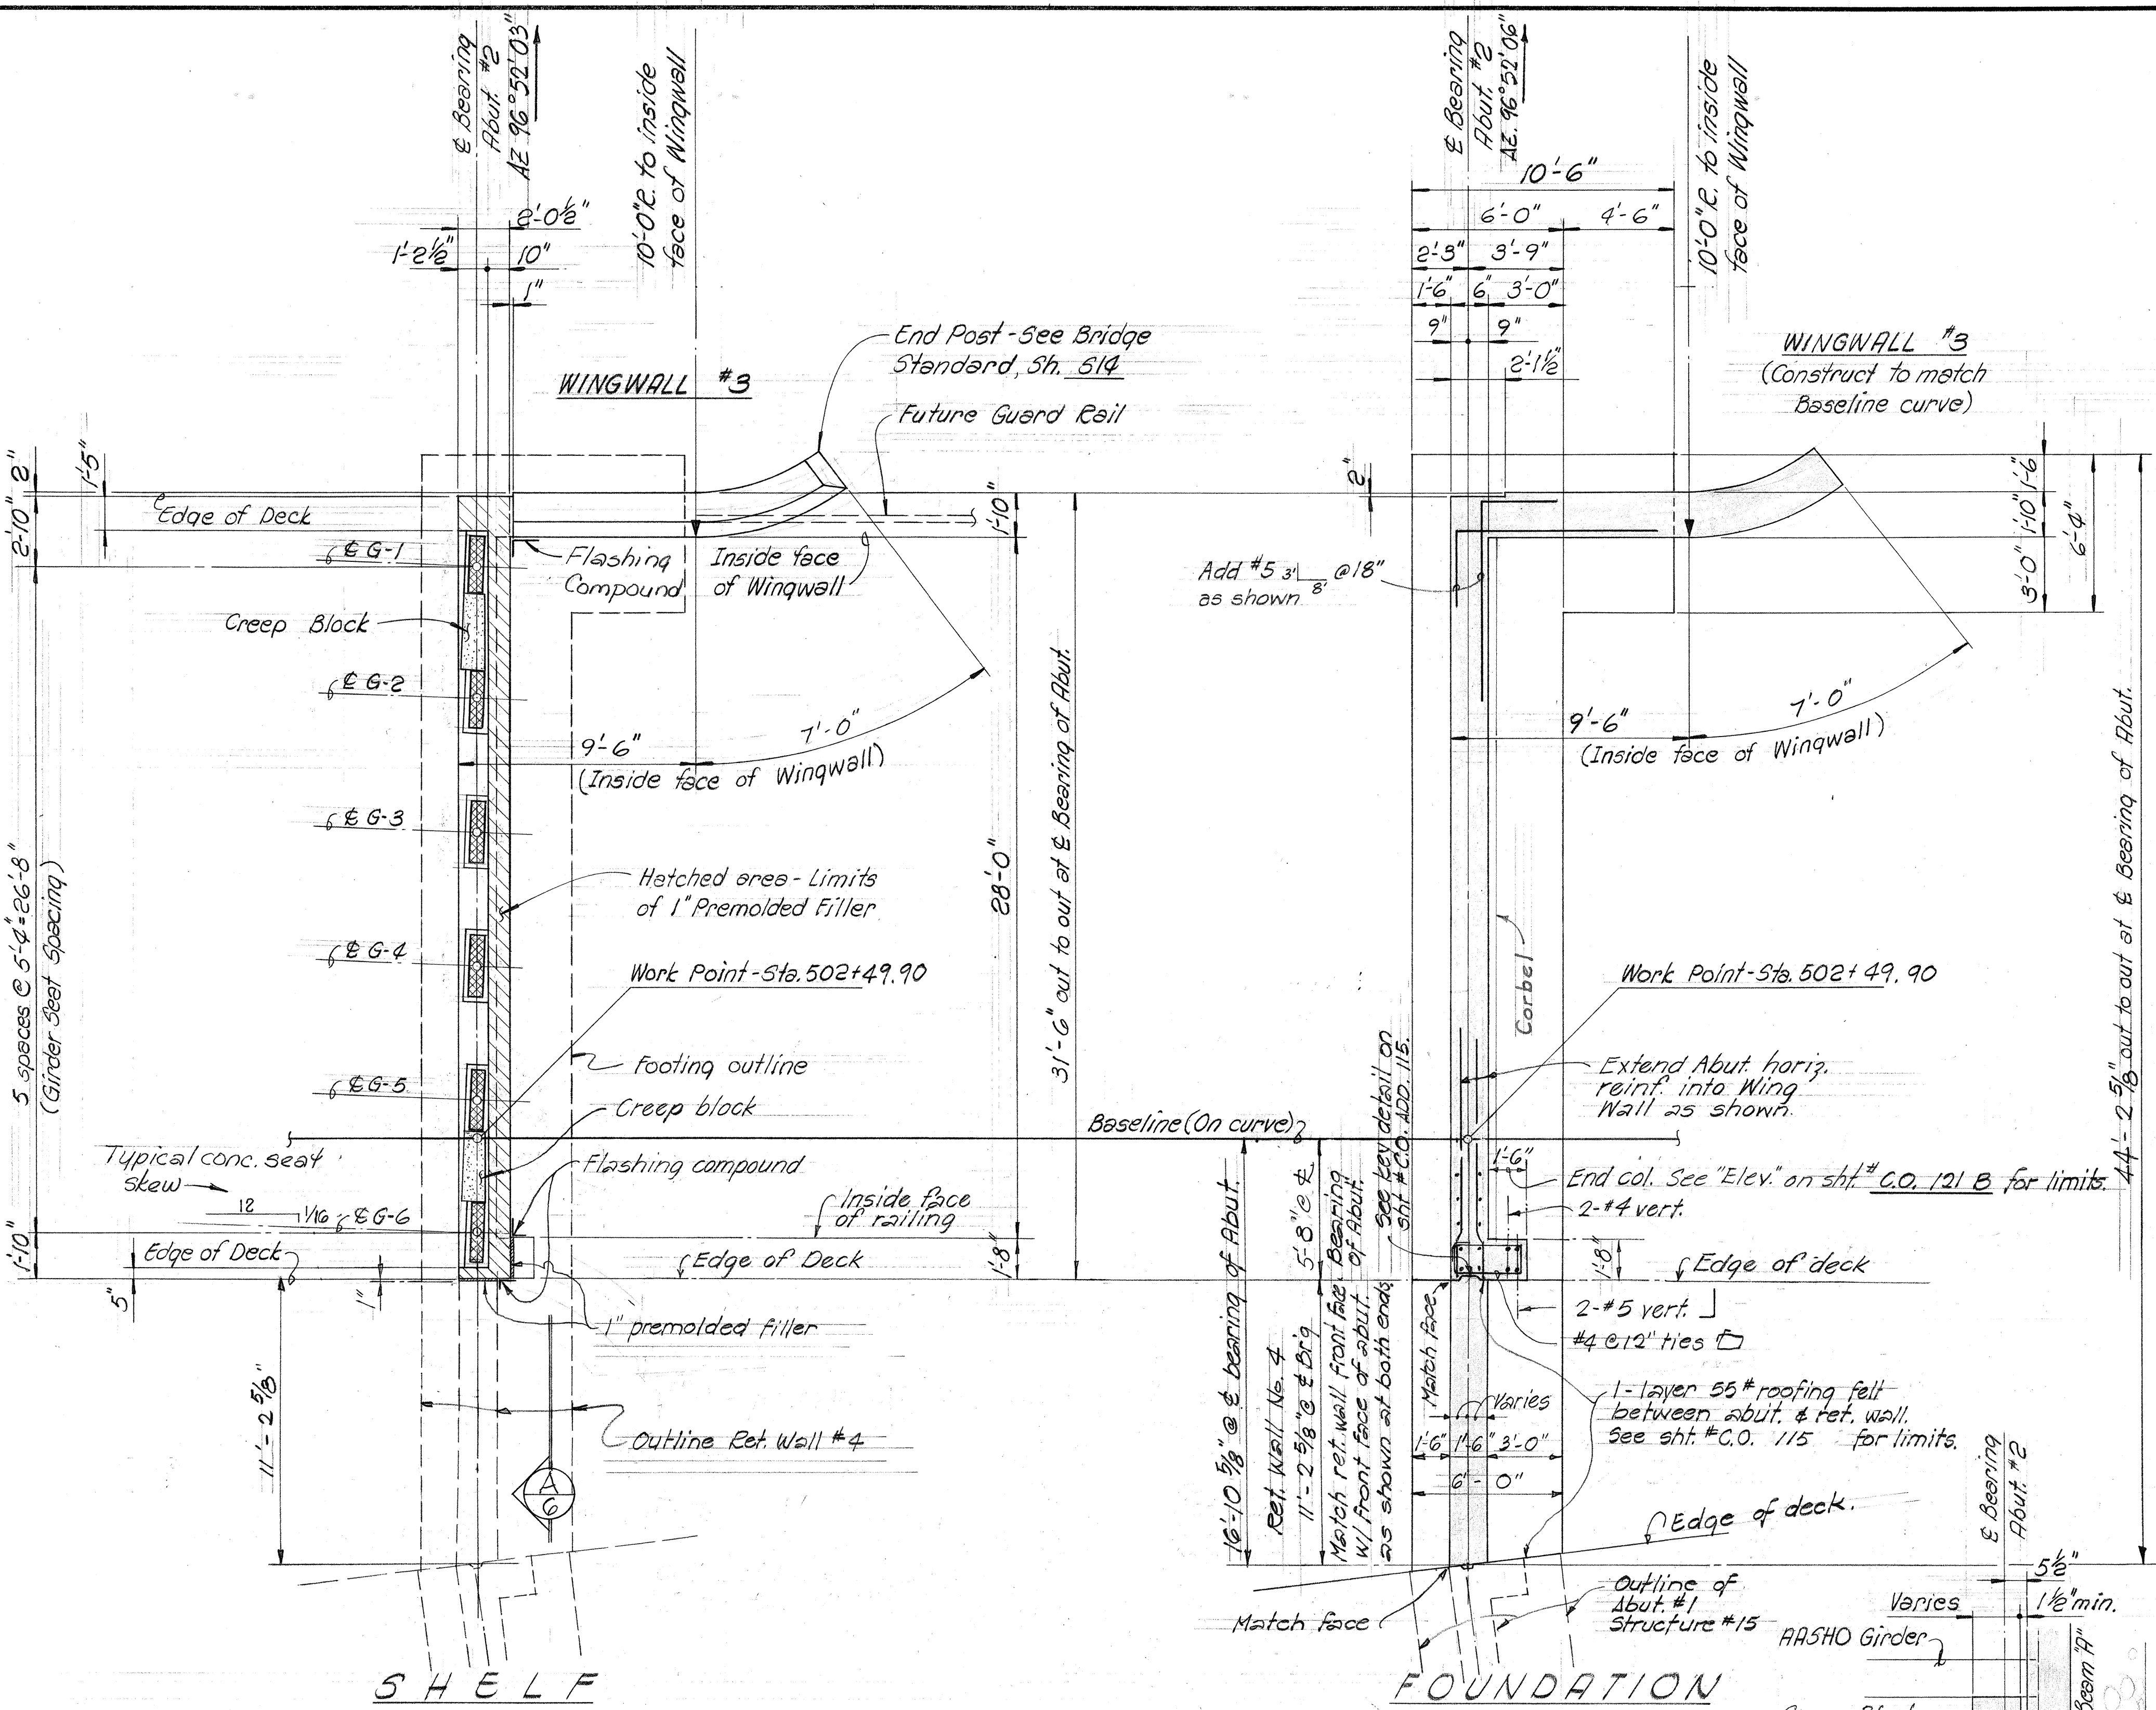


ABUTMENT #2 PLANS
Scale: 1/4" = 1'-0"

SECTION A
Scale: 1/2" = 1'-0"

DATE	DESIGNED BY	CHECKED BY
PLAN	TRACED BY	QUANTITIES BY
NOTE BOOK	NO.	NO.


Revised: Feb 18, 1970

FED. ROAD DIST. NO.	STATE	FED. AID PROJ. NO.	FISCAL YEAR	SHEET NO.	TOTAL SHEETS
HAWAII	HAW.	I-HI-1(75):8	1969	60.115	181

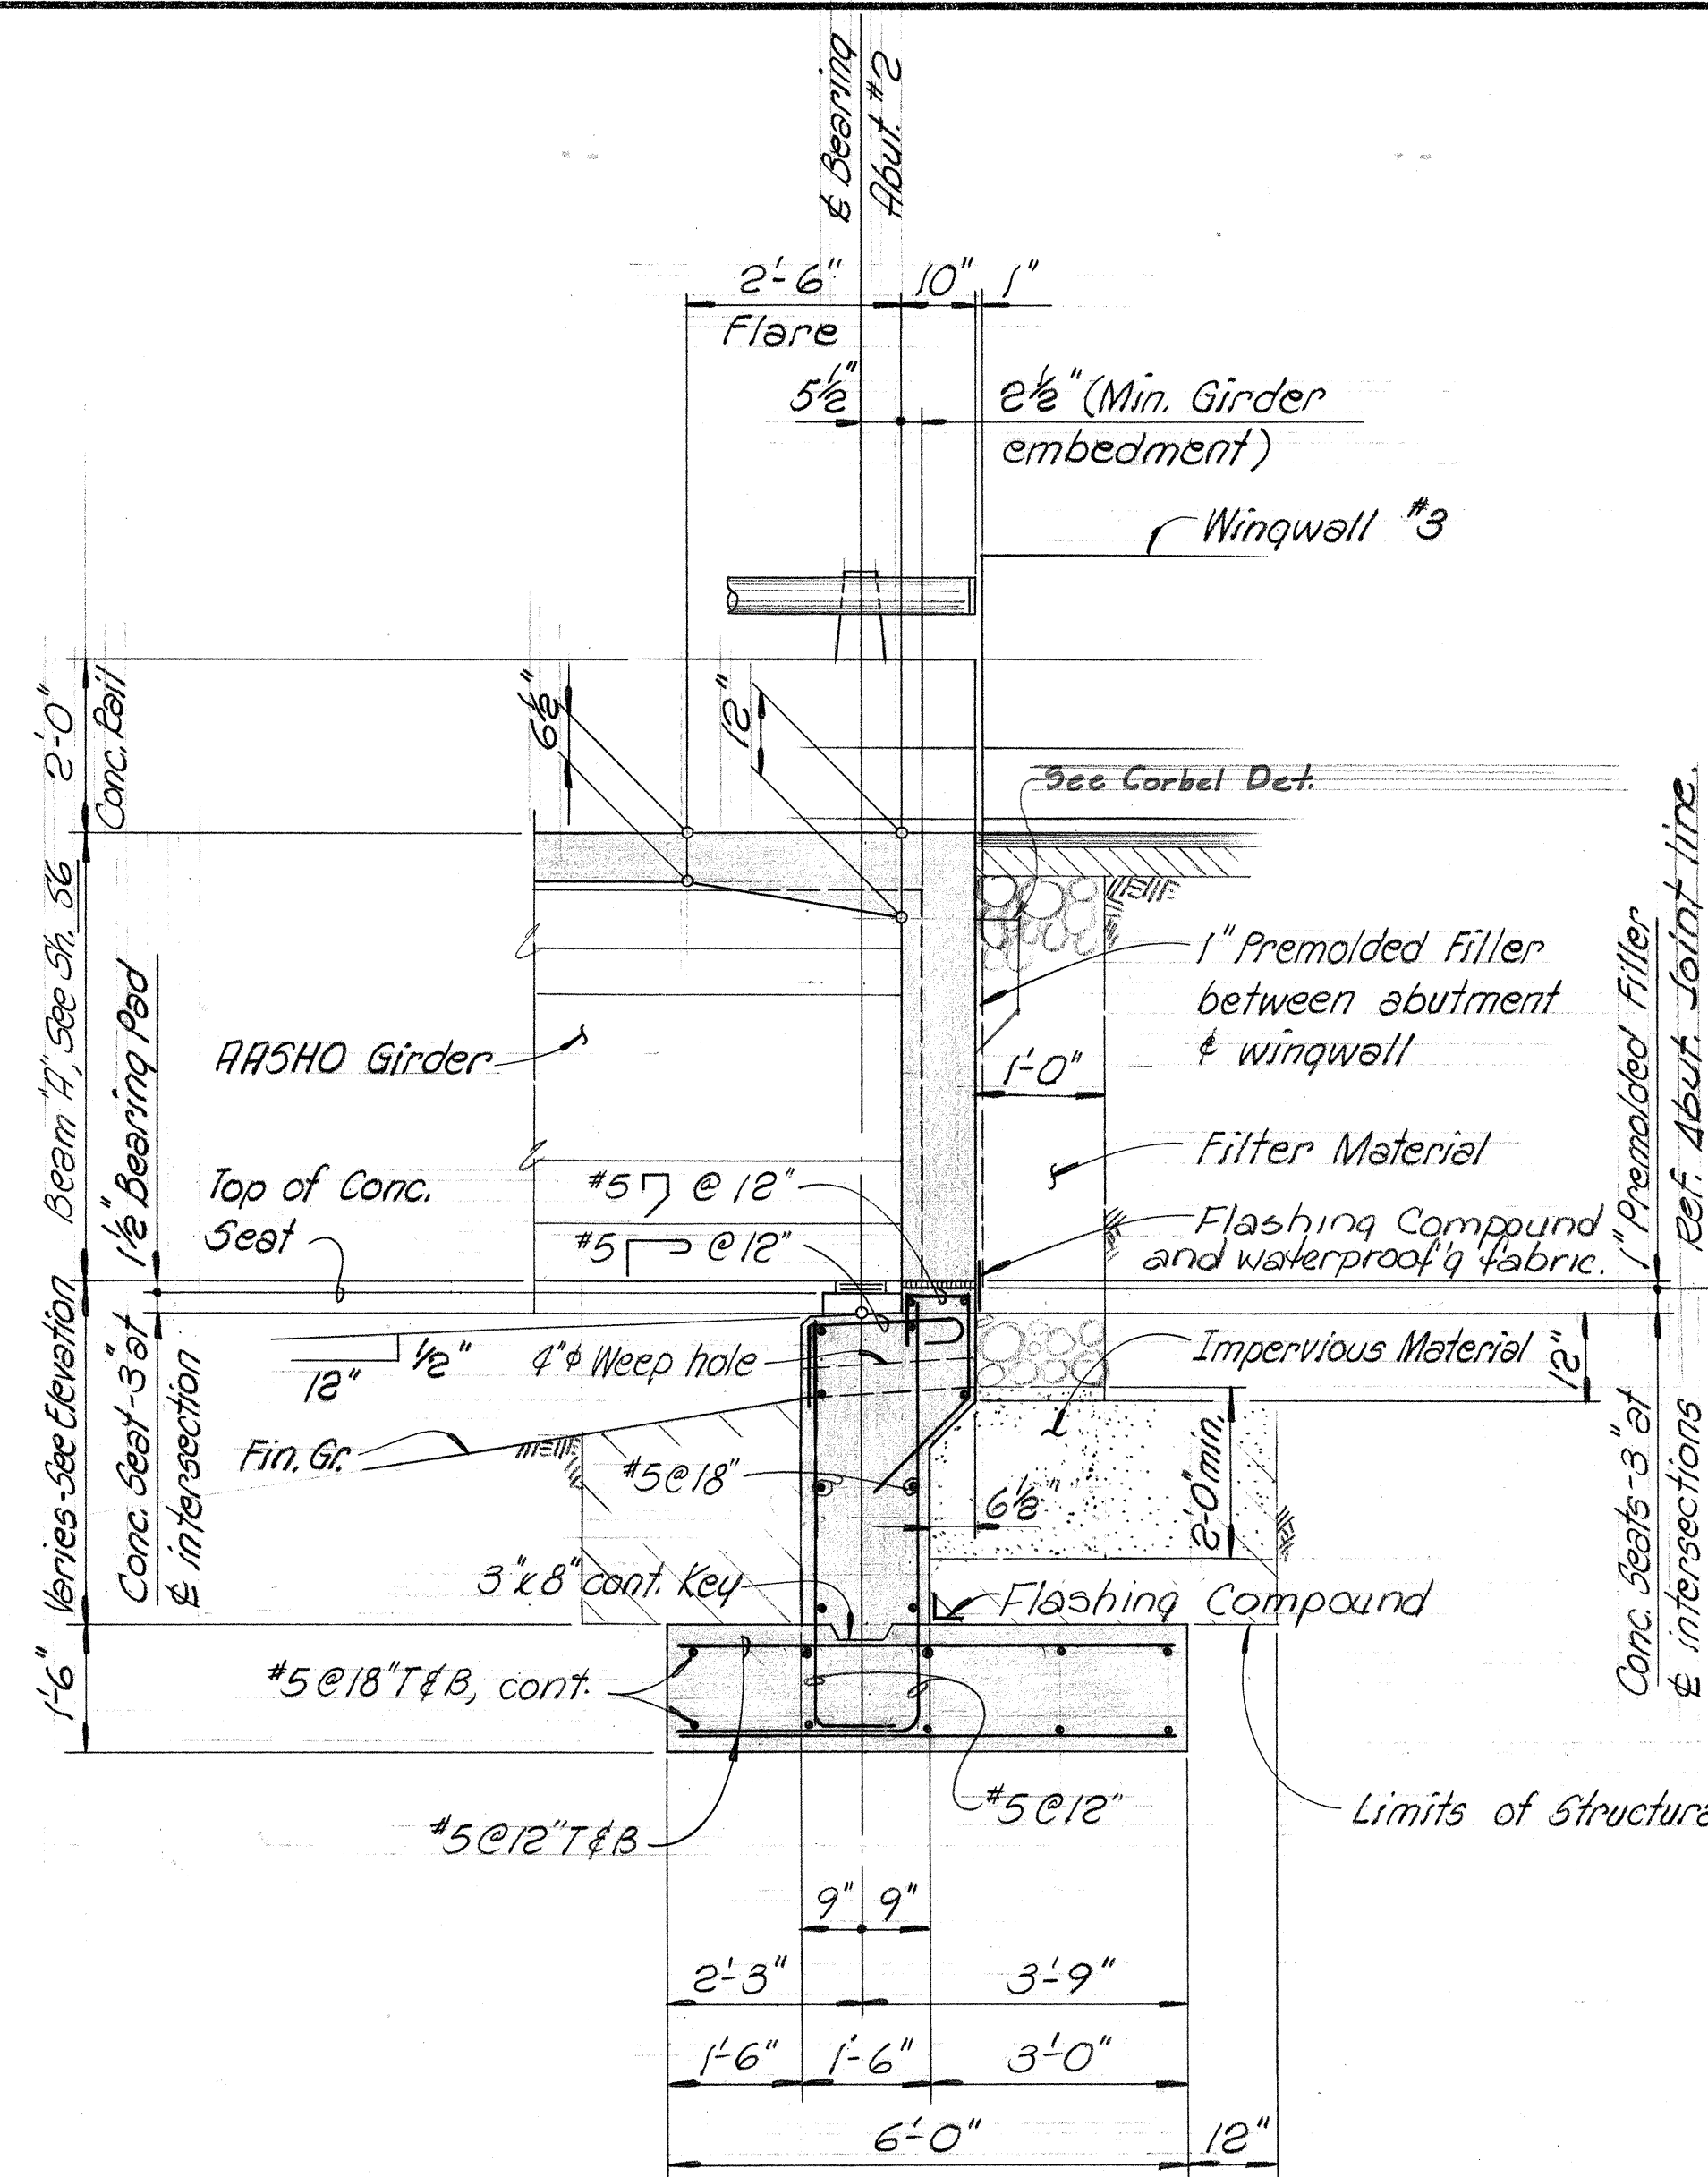

ABUTMENT #2 SECTION

Scale: 1/8" = 1'-0"

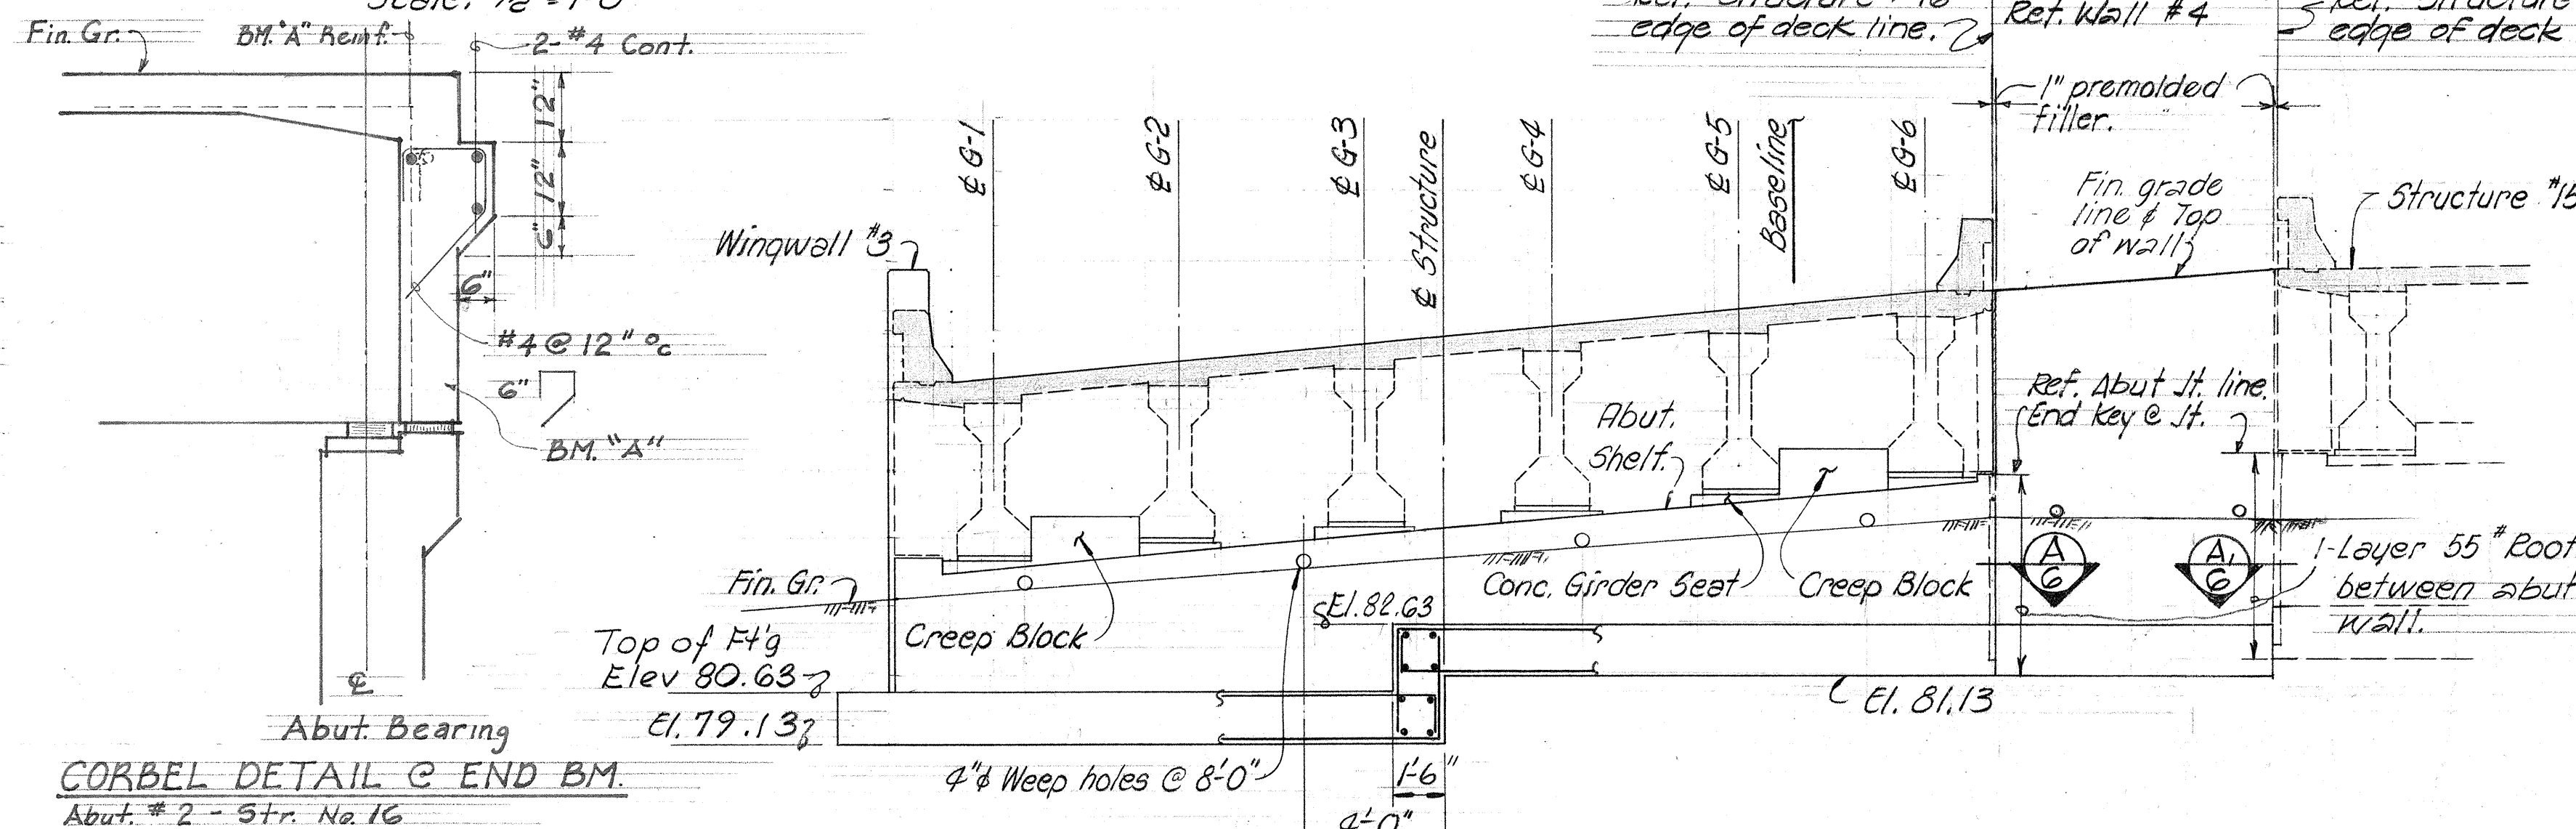

CORBEL DETAIL C END BM.


Abut. #2 - Str. No. 16

Notes:

1. Corbel at end beams are to extend from inside face of wingwall to inside face of End Col.
2. Place two layers 55# roofing paper between Corbel & Wingwall & between Corbel & End Col.
3. For details not shown see Contract Plans.


ABUTMENT #2 ELEVATION "B-B"

Scale: 1/4" = 1'-0"

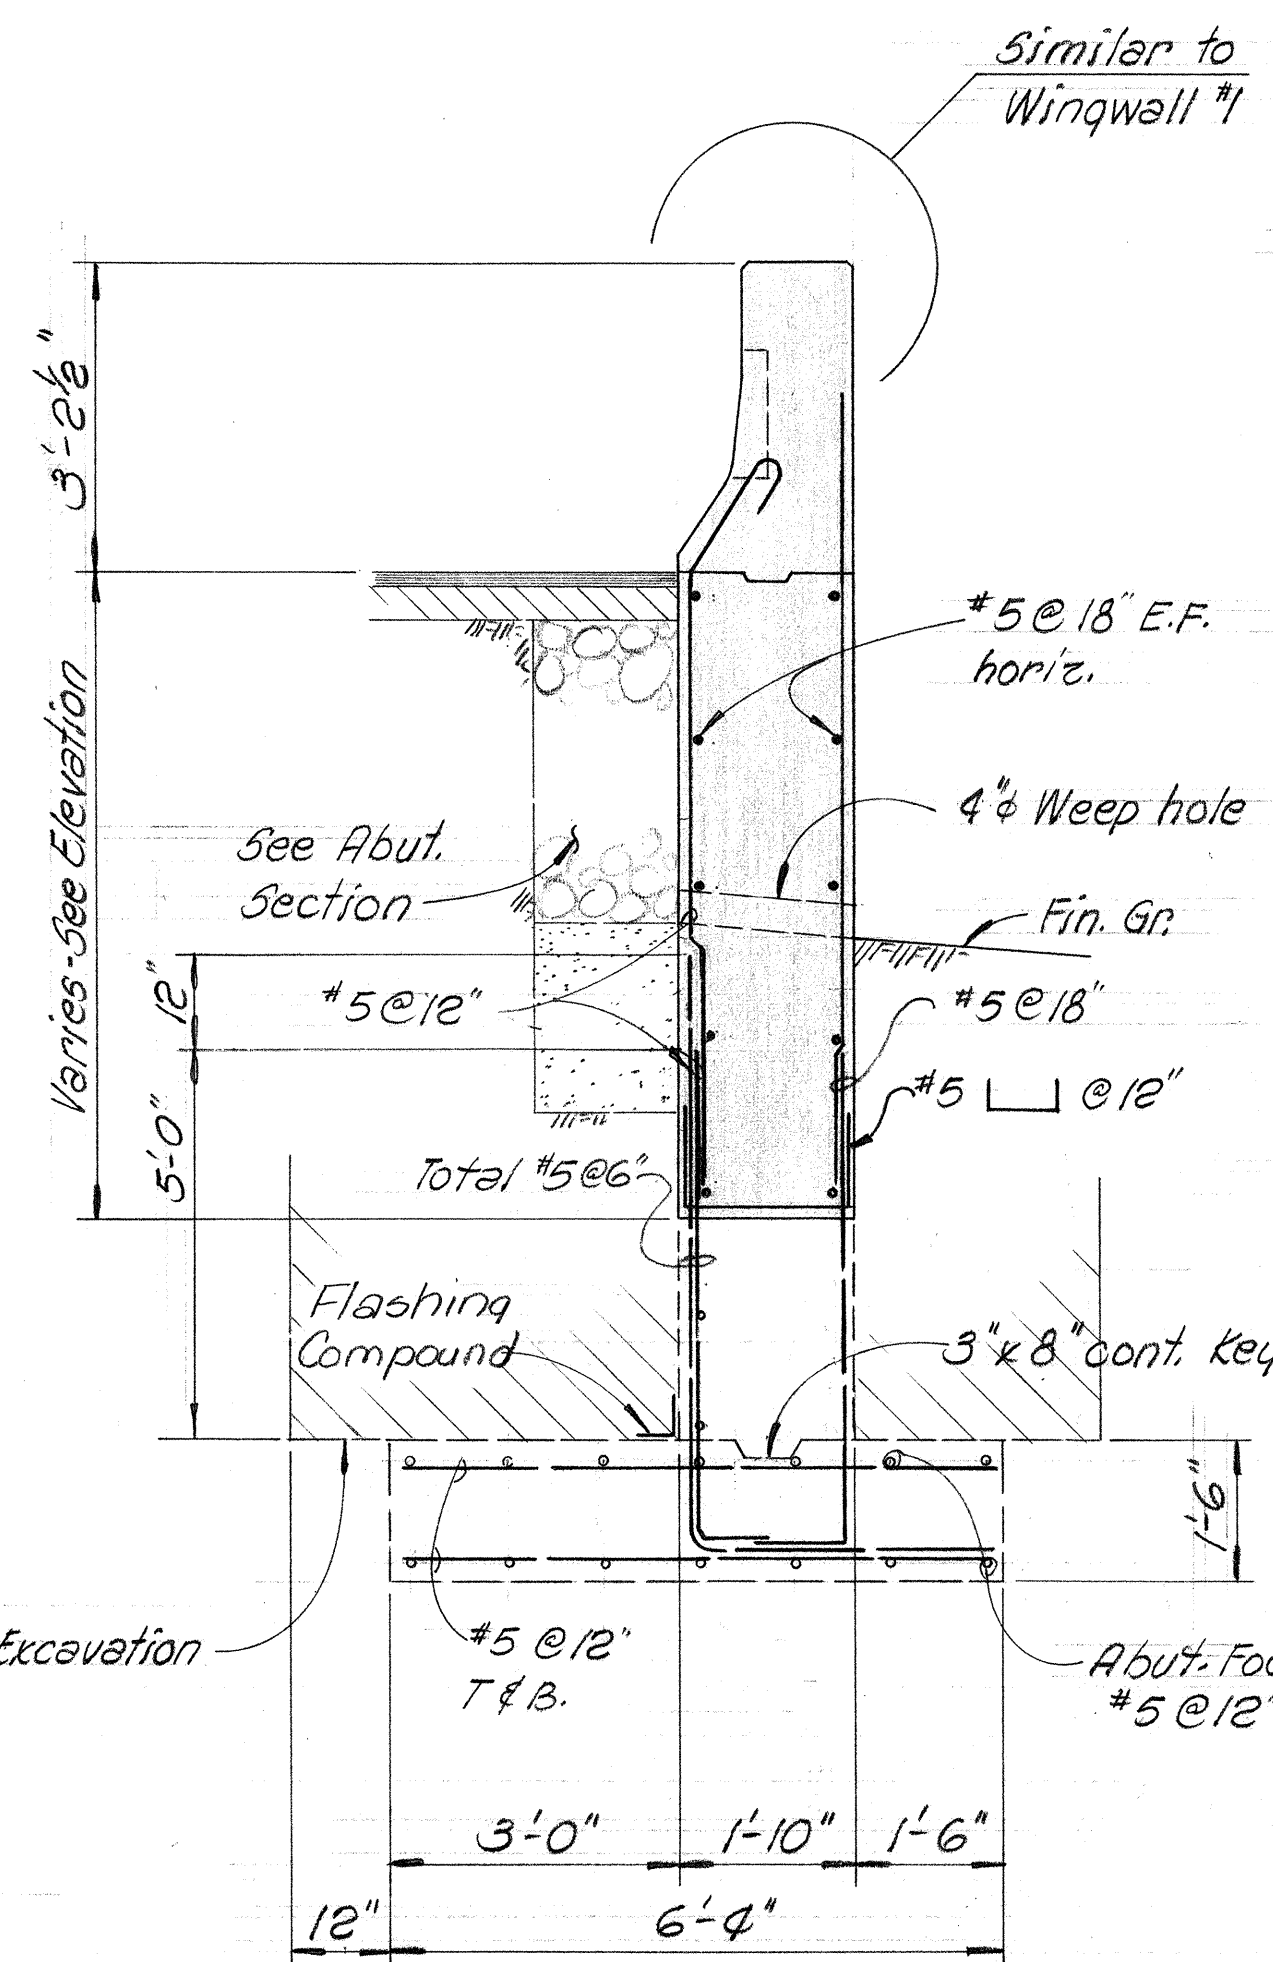

WINGWALL #3 SECTION

Scale: 1/8" = 1'-0"

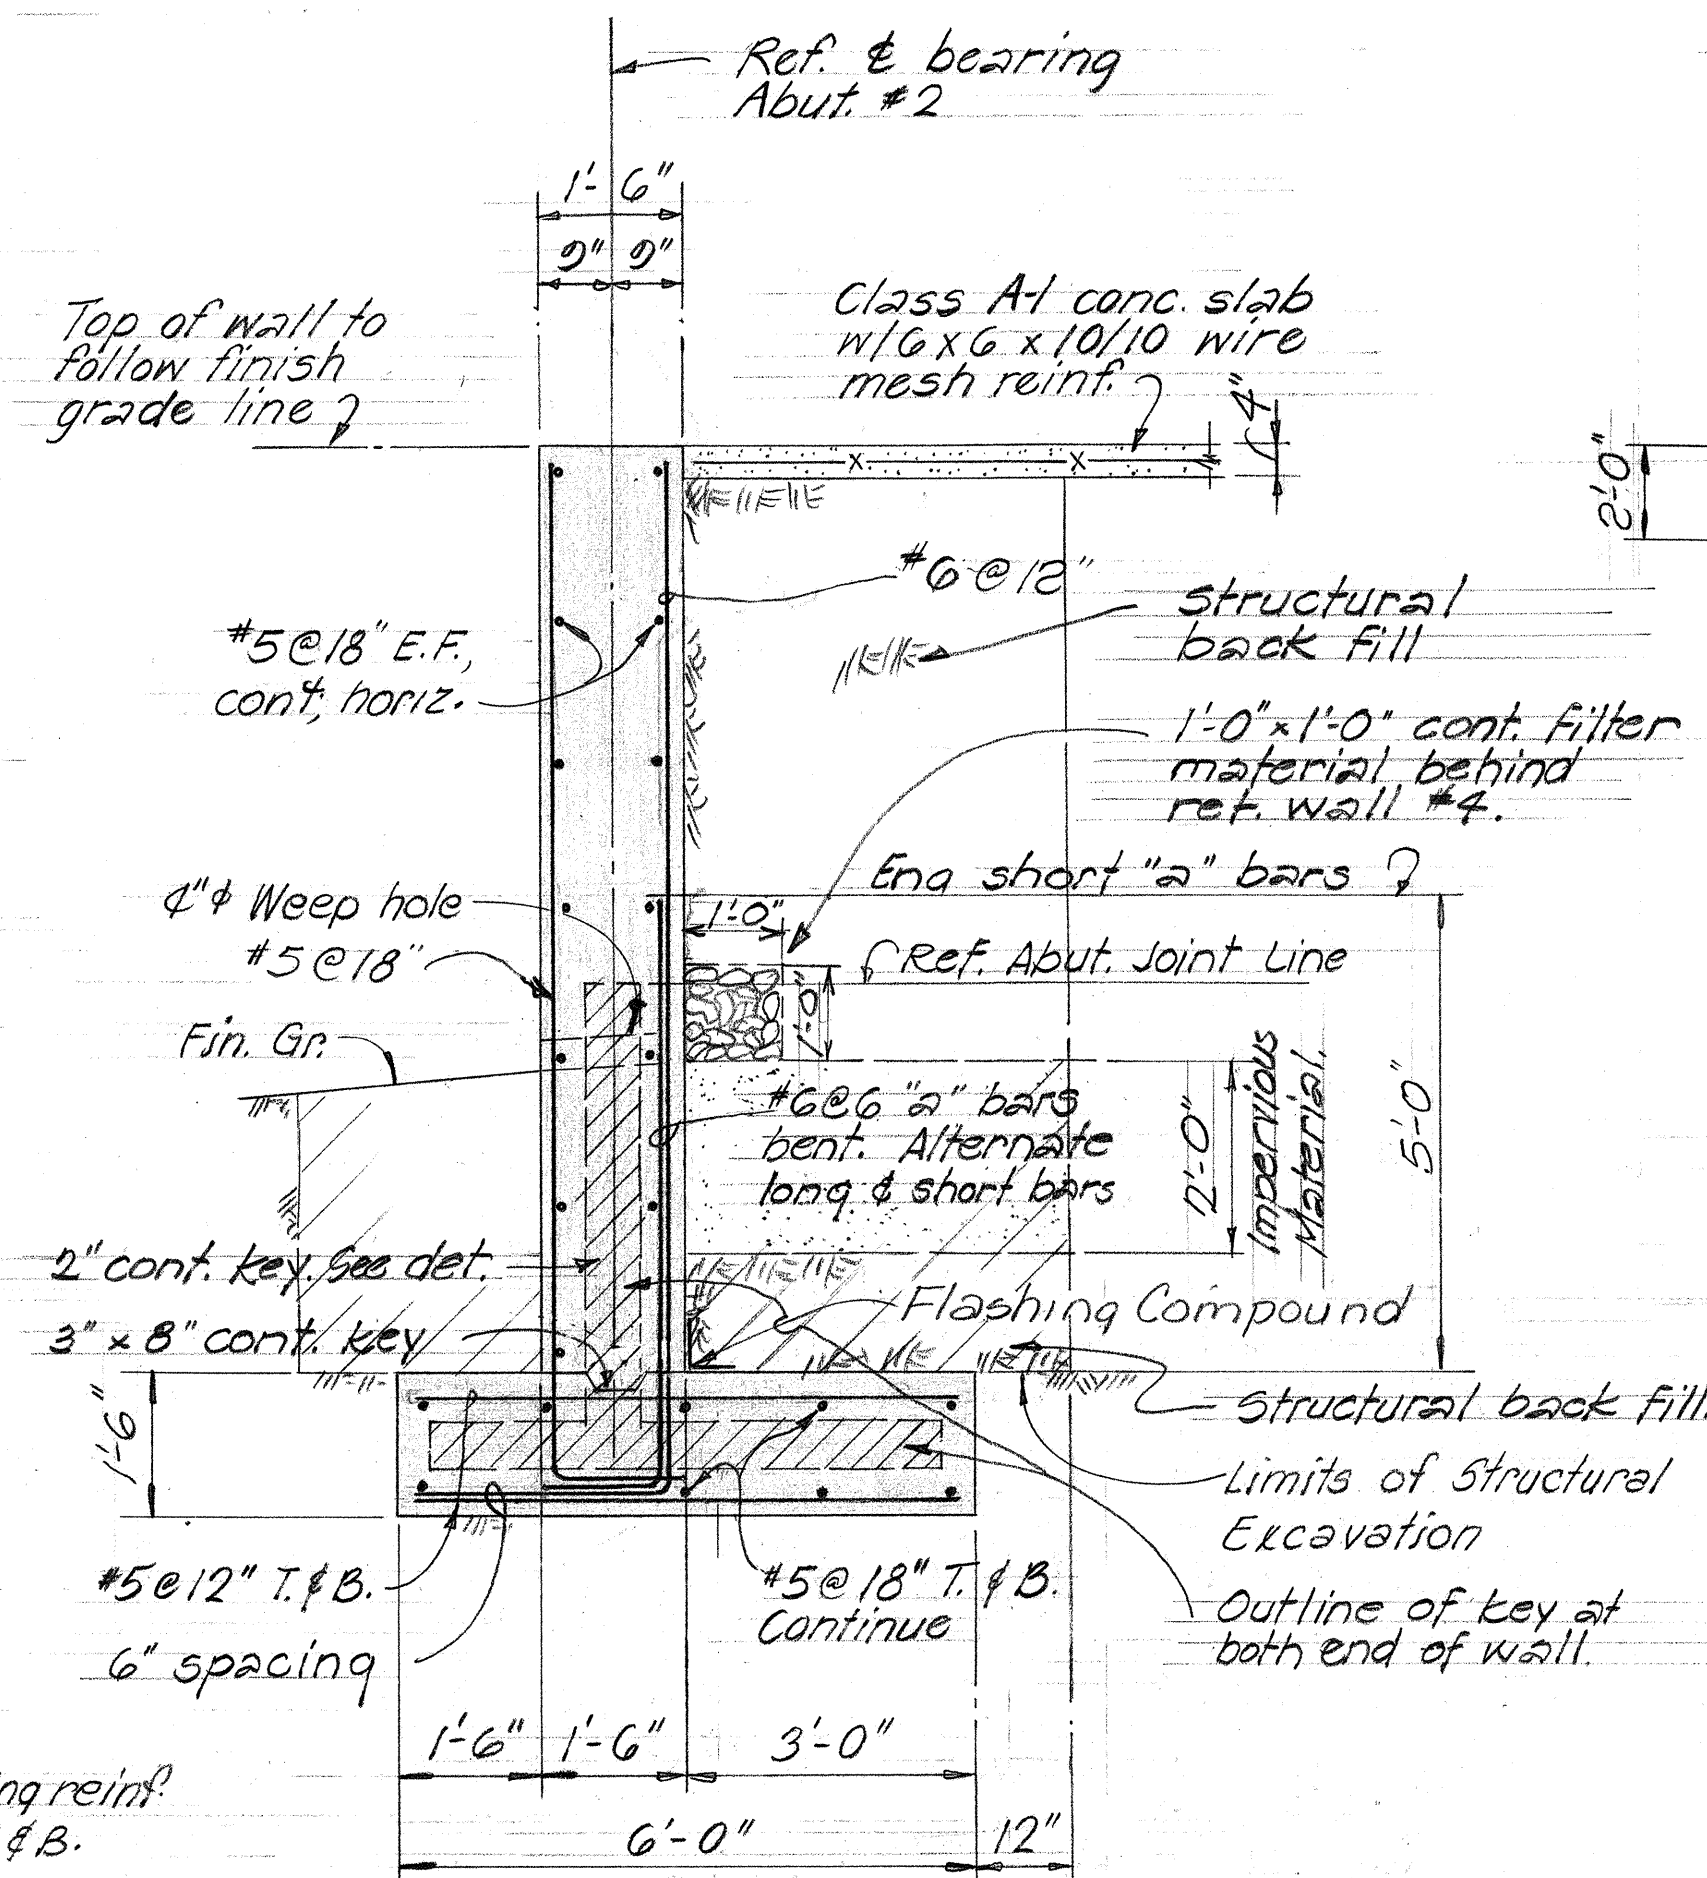

RETAINING WALL #4 SECTION

Scale: 1/2" = 1'-0"


ABUTMENT #2 ELEVATIONS & BEVELS

Girders	Top of Slab	Bot. of Girder	Top of Conc. Seat	Conc. Seat Bevels
G-1	89.55	84.34	84.21	+1/8":12
G-2	90.07	84.86	84.73	+1/8":12
G-3	90.59	85.37	85.25	+1/8":12
G-4	91.11	85.89	85.77	+1/8":12
G-5	91.62	86.41	86.28	+1/8":12
G-6	92.14	86.93	86.80	+1/8":12

Note:

1. Elevations are at E intersections
2. Girder seat bevel direction - See Sh. 4

SHIMAZU SHIMAZUKU & FUKUDA, INC.
Consulting Structural Engineers
1210 Ward Ave., Honolulu, HI 96814

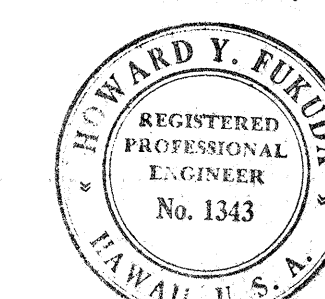

This work was prepared by me or under my supervision.

Howard Y. Fukuda

THIS SHEET SUPERSEDES SHEET NO. 115 & ADD. 115

**STATE OF HAWAII
DEPARTMENT OF TRANSPORTATION
HIGHWAYS DIVISION**



**STRUCTURE No. 16
ABUTMENT #2 & WINGWALLS #3 & #4
SECTIONS & ELEVATIONS**

**WAIKAWA INTERCHANGE
F.A.I. Proj. No. I-HI-1(75):8**

Scale: As shown Date: JUNE, 1969
SHEET NO. 6 OF 13 SHEETS

JUNE 24, 1971 (C) O. 115

FED. ROAD DIST. NO.	STATE	FED. AID PROJ. NO.	FISCAL YEAR	SHEET NO.	TOTAL SHEETS
HAWAII	HAW.	I-HI-1(75):8	1969	116	181

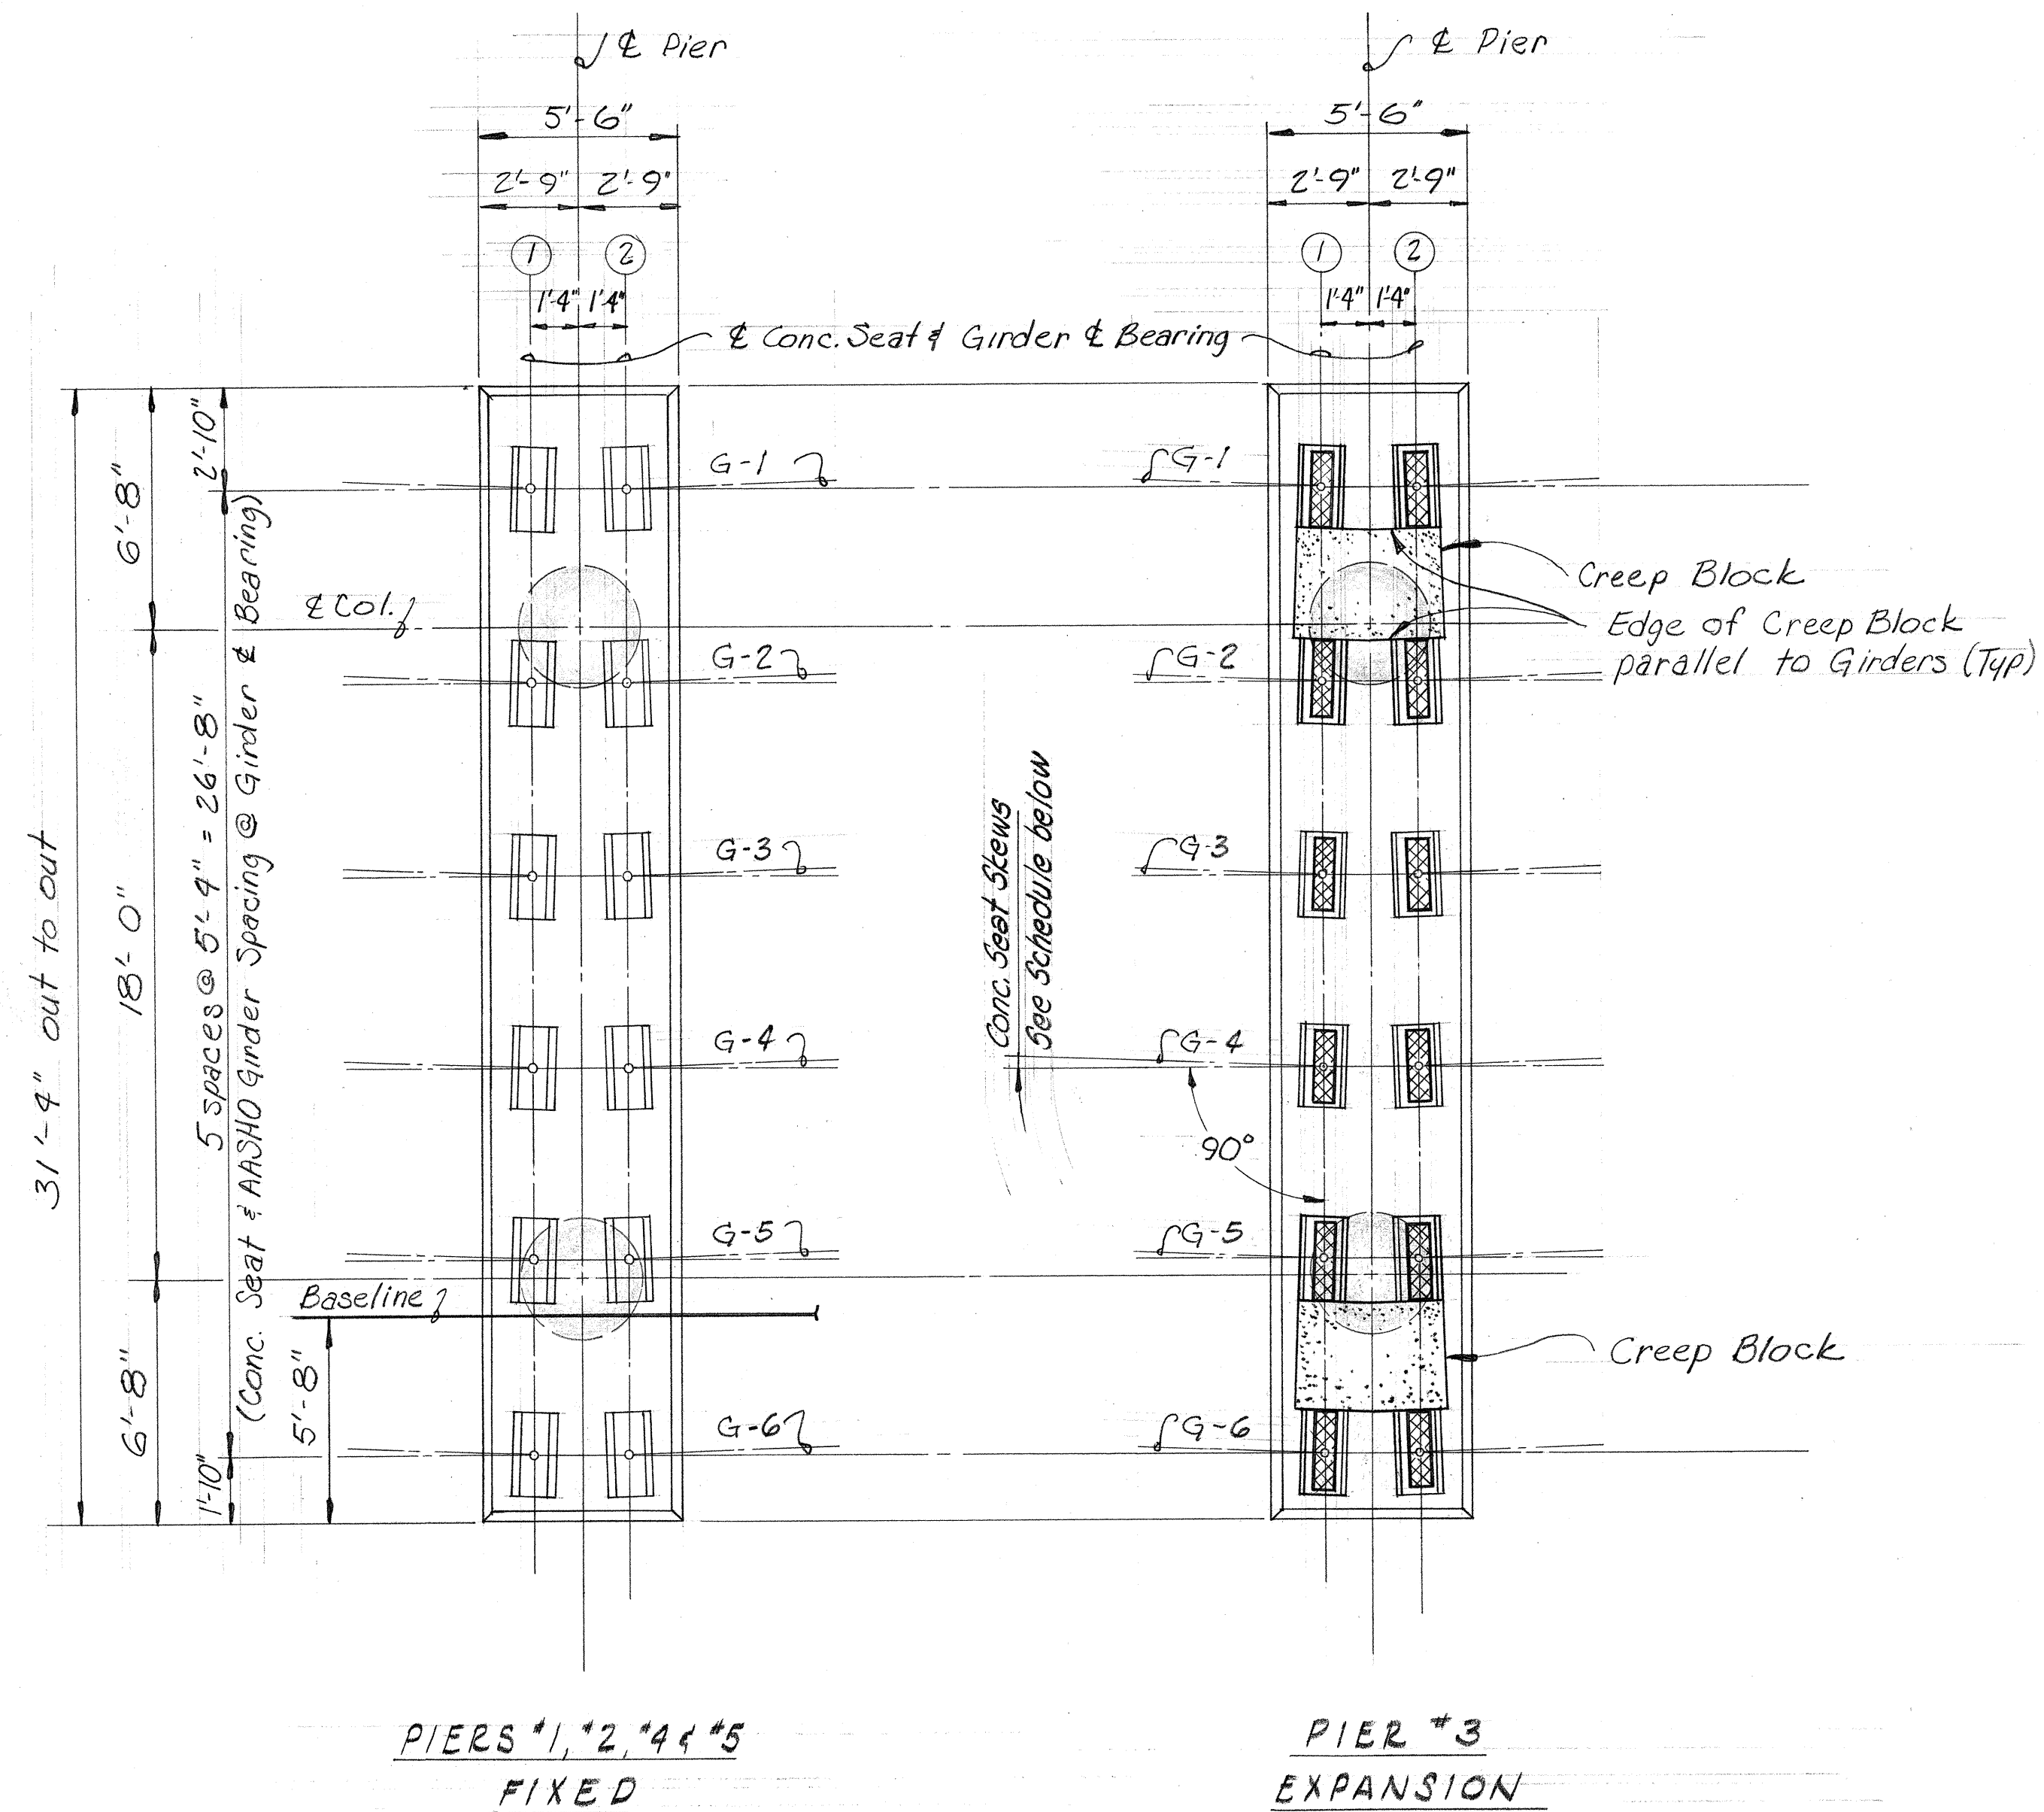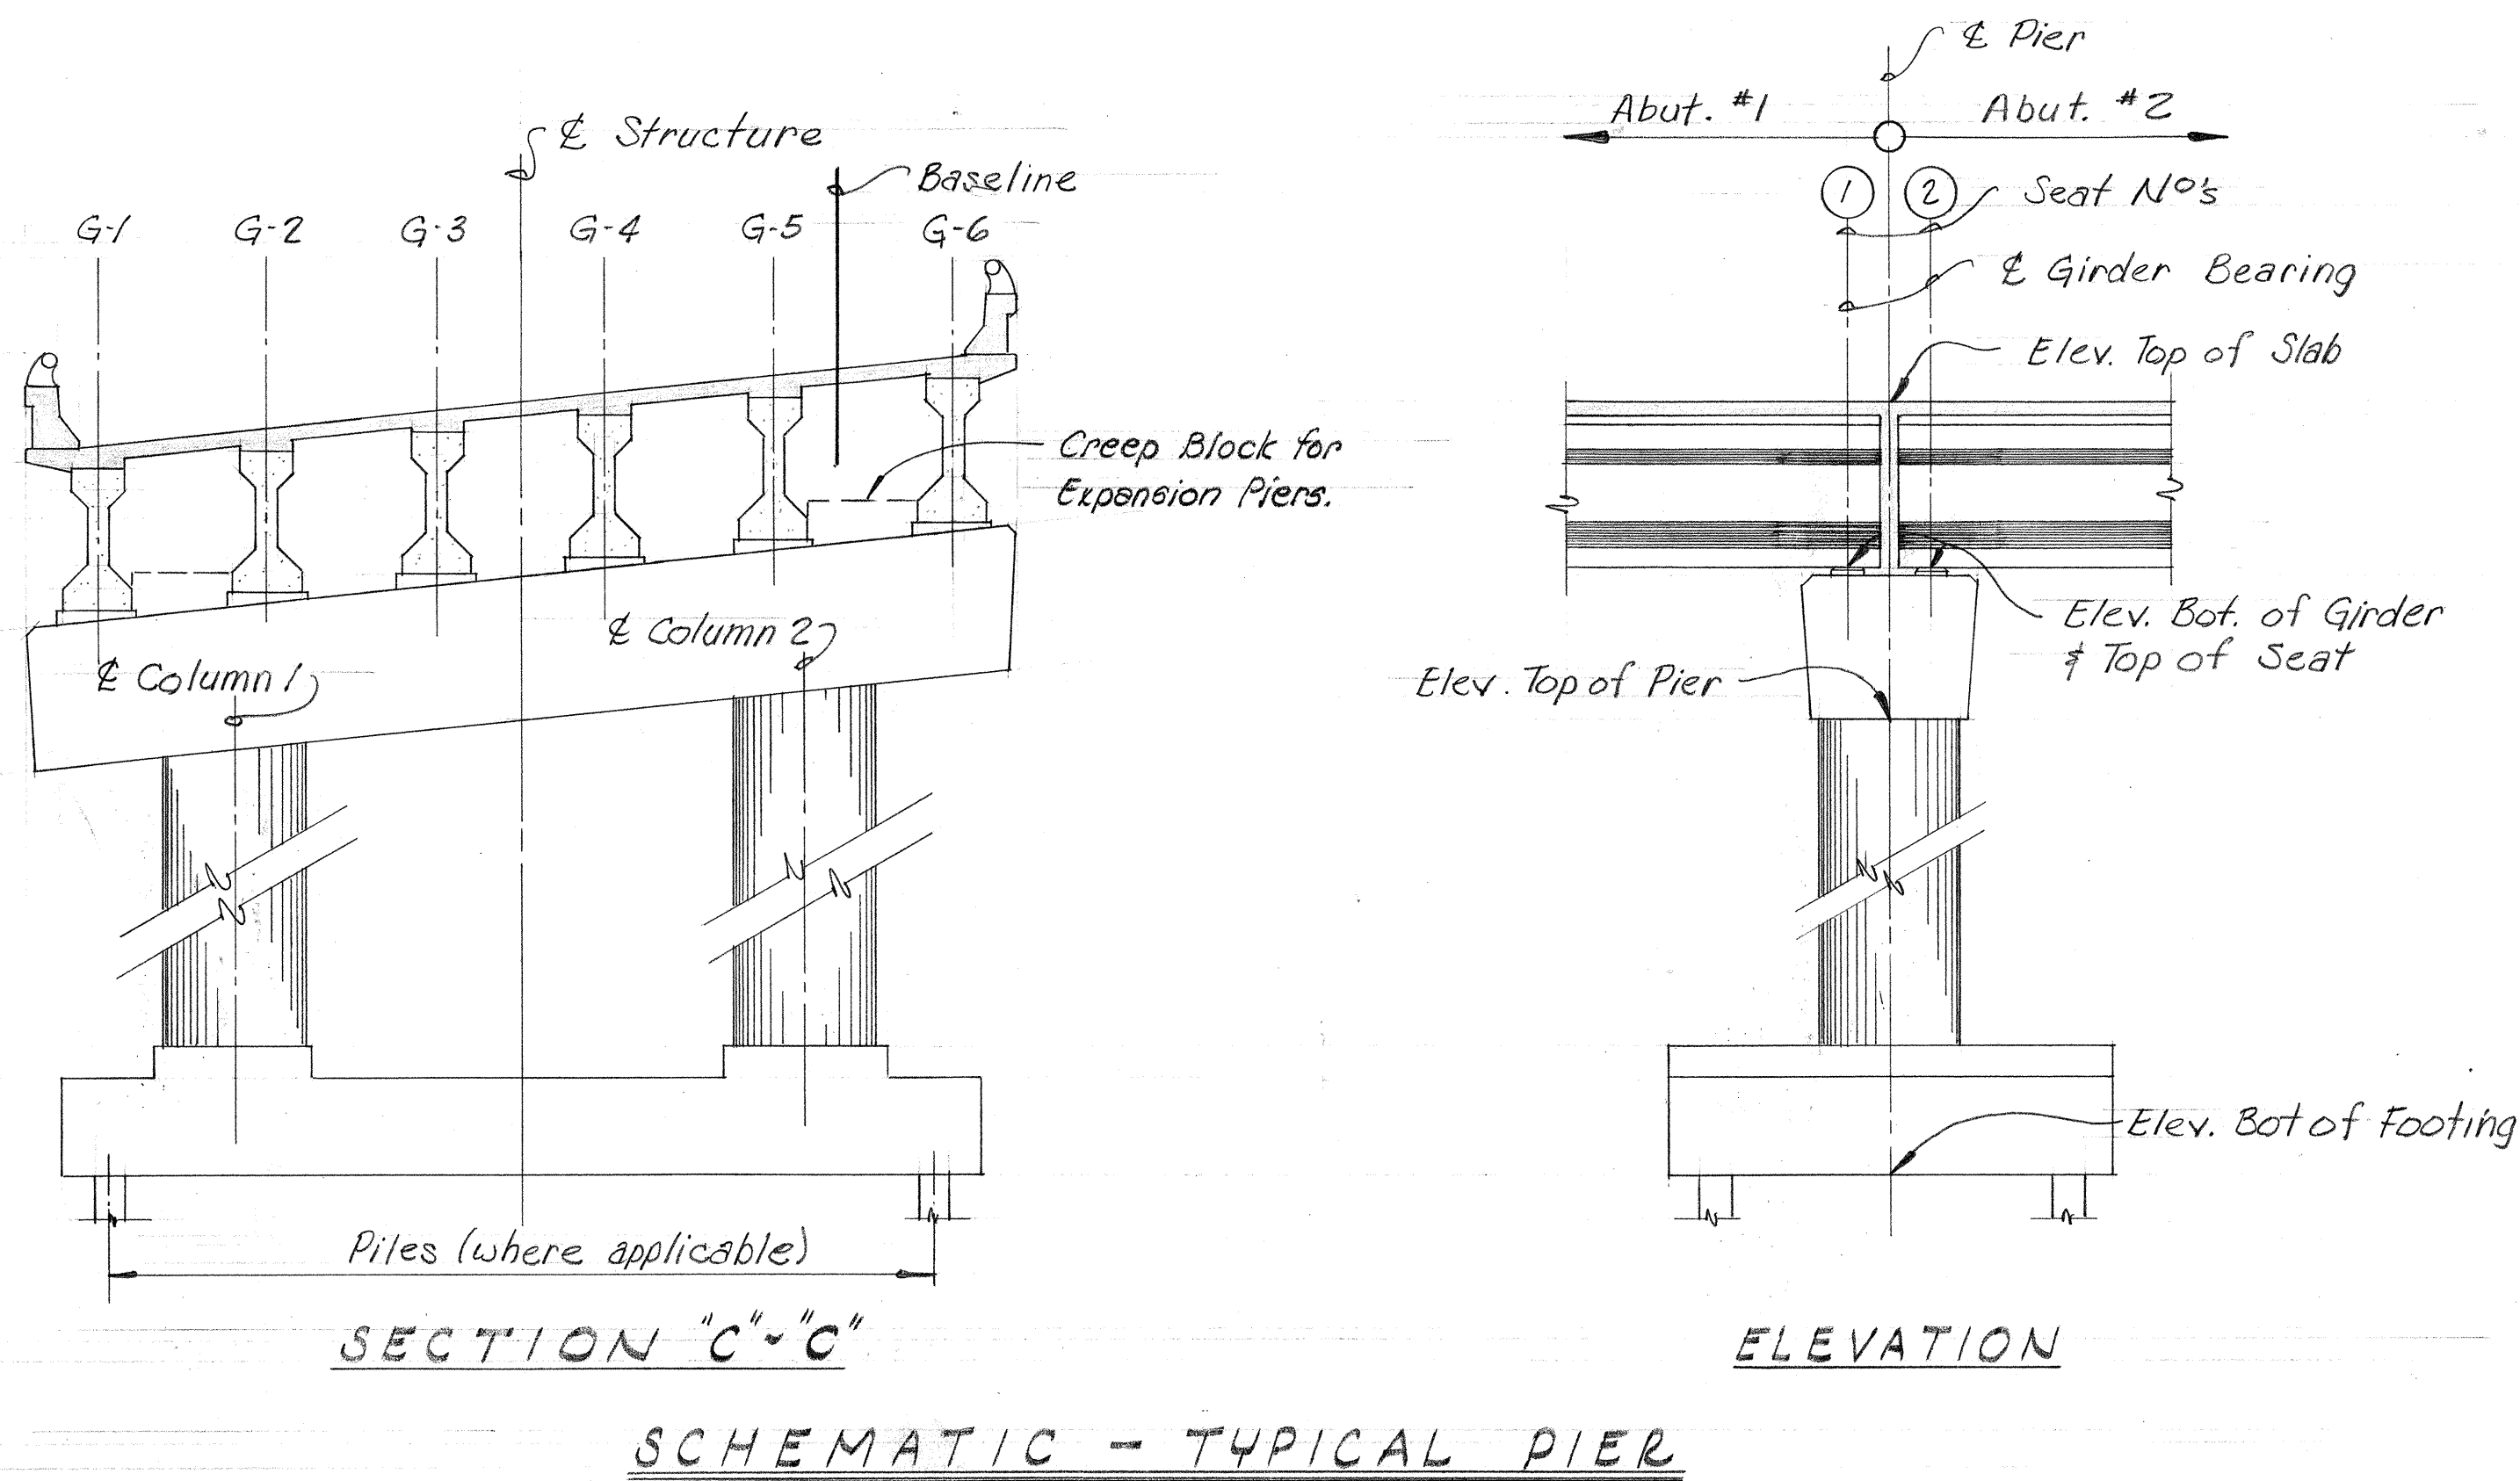


5	4	3	2	1	PIER NO						TOP OF SLAB						BOTTOM OF GIRDER												TOP OF SEATS												TOP OF COLUMN		BOT. OF FOOTING																																																																																																																																																																																																																																																																																																																																																																																																																																																																																																																																																																																																																																																																																																																																																																																								
					G-1	G-2	G-3	G-4	G-5	G-6	G-1	G-2	G-3	G-4	G-5	G-6	G-1	G-2	G-3	G-4	G-5	G-6	G-1	G-2	G-3	G-4	G-5	G-6	1	2																																																																																																																																																																																																																																																																																																																																																																																																																																																																																																																																																																																																																																																																																																																																																																																																					
																															GIRDER NO						GIRDER & SEAT NO							GIRDER & SEAT NO																																																																																																																																																																																																																																																																																																																																																																																																																																																																																																																																																																																																																																																																																																																																																																																							
89.13	88.21	87.50	86.39	84.72	84.72	84.7

NOTE: Piers #1, #2, #4, & #5 are fixed supports. Therefore, elevations of Top of Conc. Seats are same as Bottom of Girders.

SCHEDULE OF ELEVATIONS

CONCRETE SEAT SKEWS			CONCRETE SEAT BEVELS									
PIERS	①	②	PIERS	①	②	③	④	⑤	⑥	⑦	⑧	⑨
1	13/32 3/8:12	7/16:12	G1	1/4:12	3/16:12	1/8:12	1/8:12	1/8:12	1/8:12	1/8:12	1/8:12	1/8:12
2	7/16:12	3/8:12	G2	3/16:12	1/4:12	1/8:12	1/8:12	1/8:12	1/8:12	1/8:12	1/8:12	1/8:12
3	13/32 3/8:12	7/16:12	G3	1/4:12	3/16:12	1/8:12	1/8:12	1/8:12	1/8:12	1/8:12	1/8:12	1/8:12
4	13/32 5/16:12	7/16:12	G4	1/4:12	3/16:12	1/8:12	1/8:12	1/8:12	1/8:12	1/8:12	1/8:12	1/8:12
5	13/32 5/16:12	7/16:12	G5	1/4:12	3/16:12	1/8:12	1/8:12	1/8:12	1/8:12	1/8:12	1/8:12	1/8:12
			G6	1/4:12	3/16:12	1/8:12	1/8:12	1/8:12	1/8:12	1/8:12	1/8:12	1/8:12

SHIMAZU SHIMABUKURO & FUKUDA, INC.
Consulting Structural Engineers
1210 Ward Ave., Honolulu, HI 96814

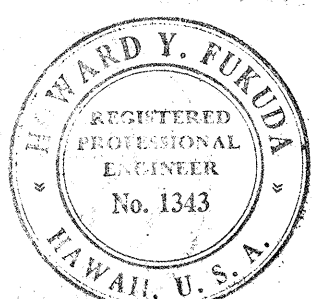

This work was prepared by me or under my supervision.
Howard Y. Fukuda

STATE OF HAWAII
DEPARTMENT OF TRANSPORTATION
HIGHWAYS DIVISION

STRUCTURE No. 16
PIER ELEVATION & SECTION, SCHEDULE OF ELEVATIONS & PIER CAP TOP PLANS



WAIKAWA INTERCHANGE
F.A.I. Proj. No. I-HI-1(75):8
Scale: As shown Date: June, 1969
SHEET No. 7 OF 13 SHEETS

1. Foundations ----- Sh. 52
2. Pier Caps ----- Sh. 53
3. Conc. Seats & Creep Blocks ----- Sh. 54

DATE	_____
DESIGNED BY	_____
CHECKED BY	_____
NOTED BY	_____
ORIGINAL PLAN	_____
TRACED BY	_____
NOTE BOOK	_____
No.	_____

FED. ROAD DIST. NO.	STATE	FED. AID PROJ. NO.	FISCAL YEAR	SHEET NO.	TOTAL SHEETS
HAWAII	HAW.	I-HI-175:8	1969	117	181

<u>DATE</u>	<u>REVISION</u>
March 30, 1971	changed girder lengths and dimensions.

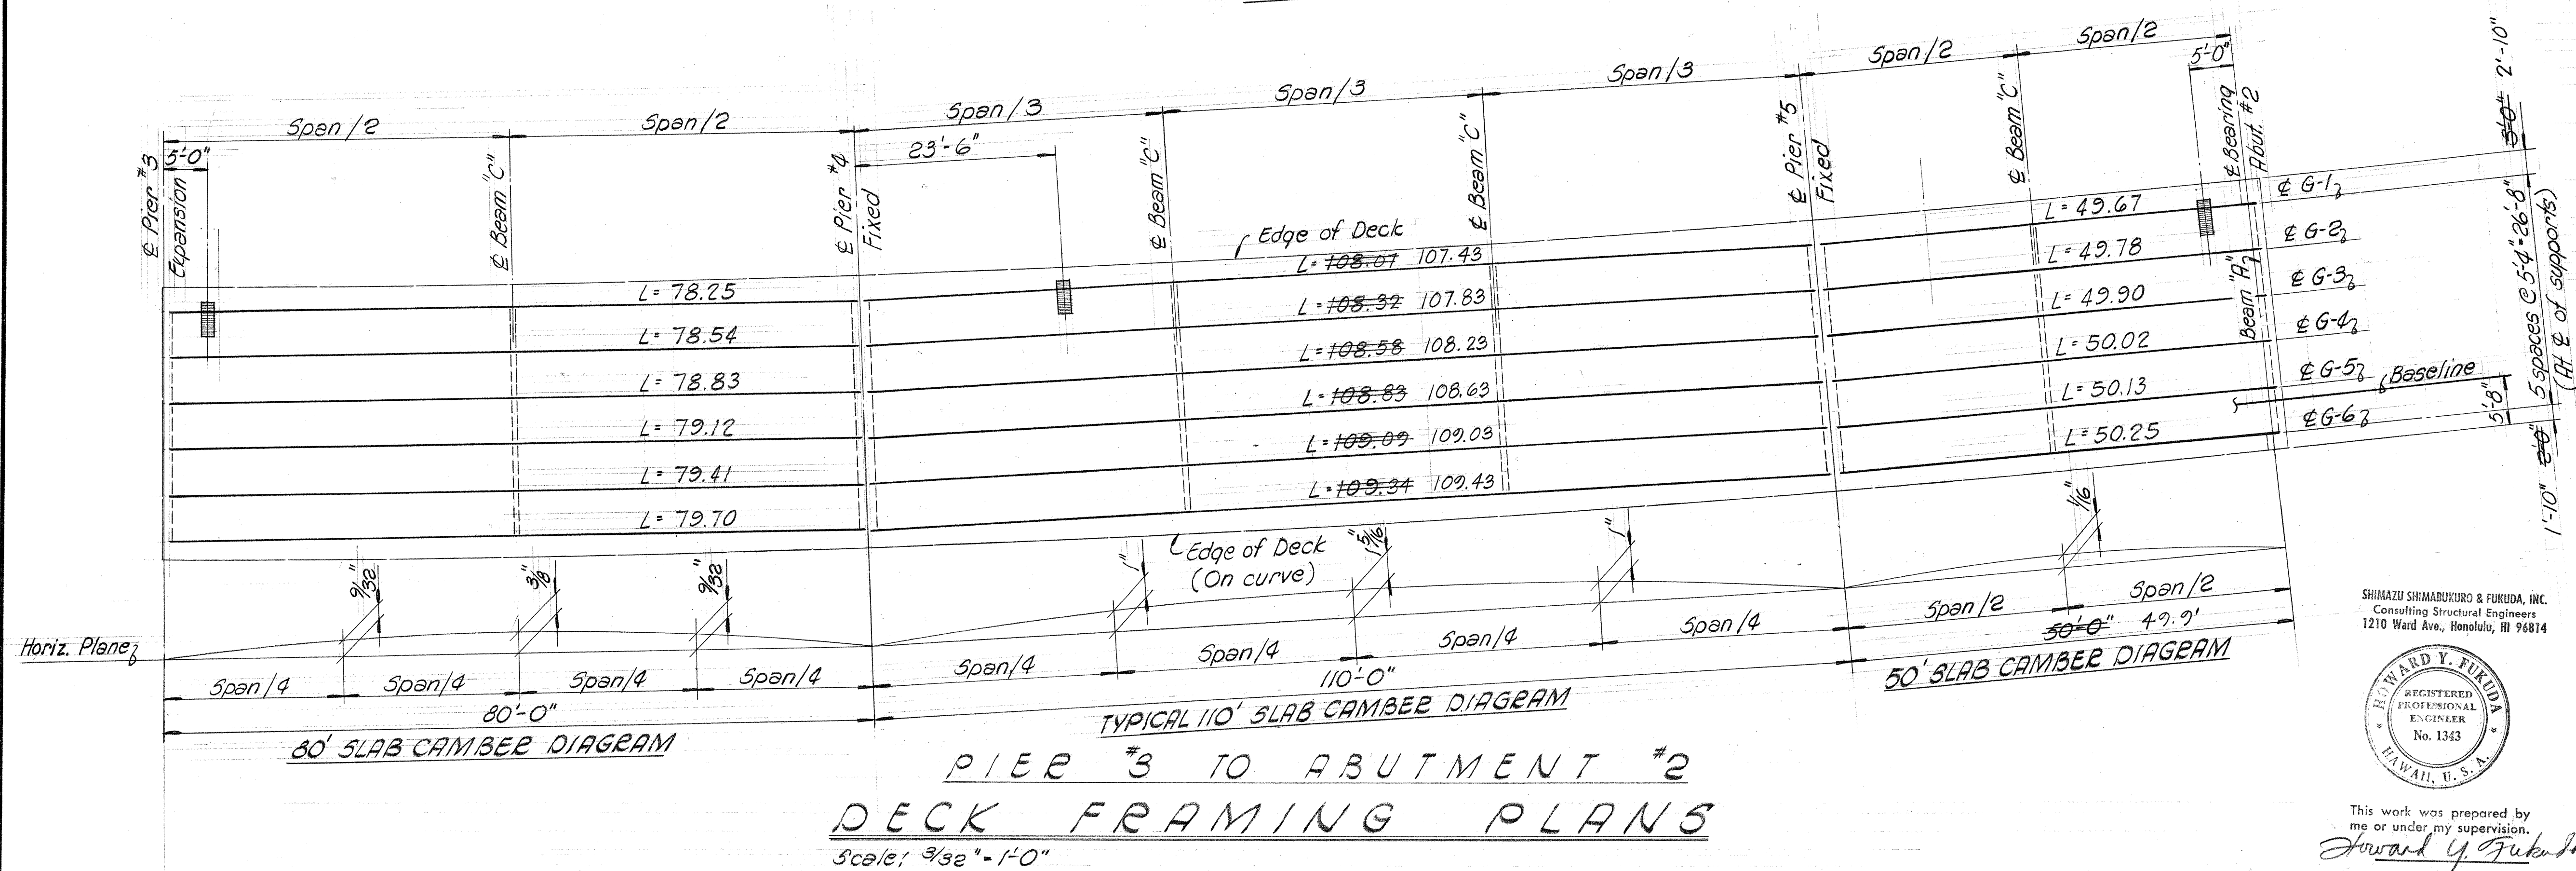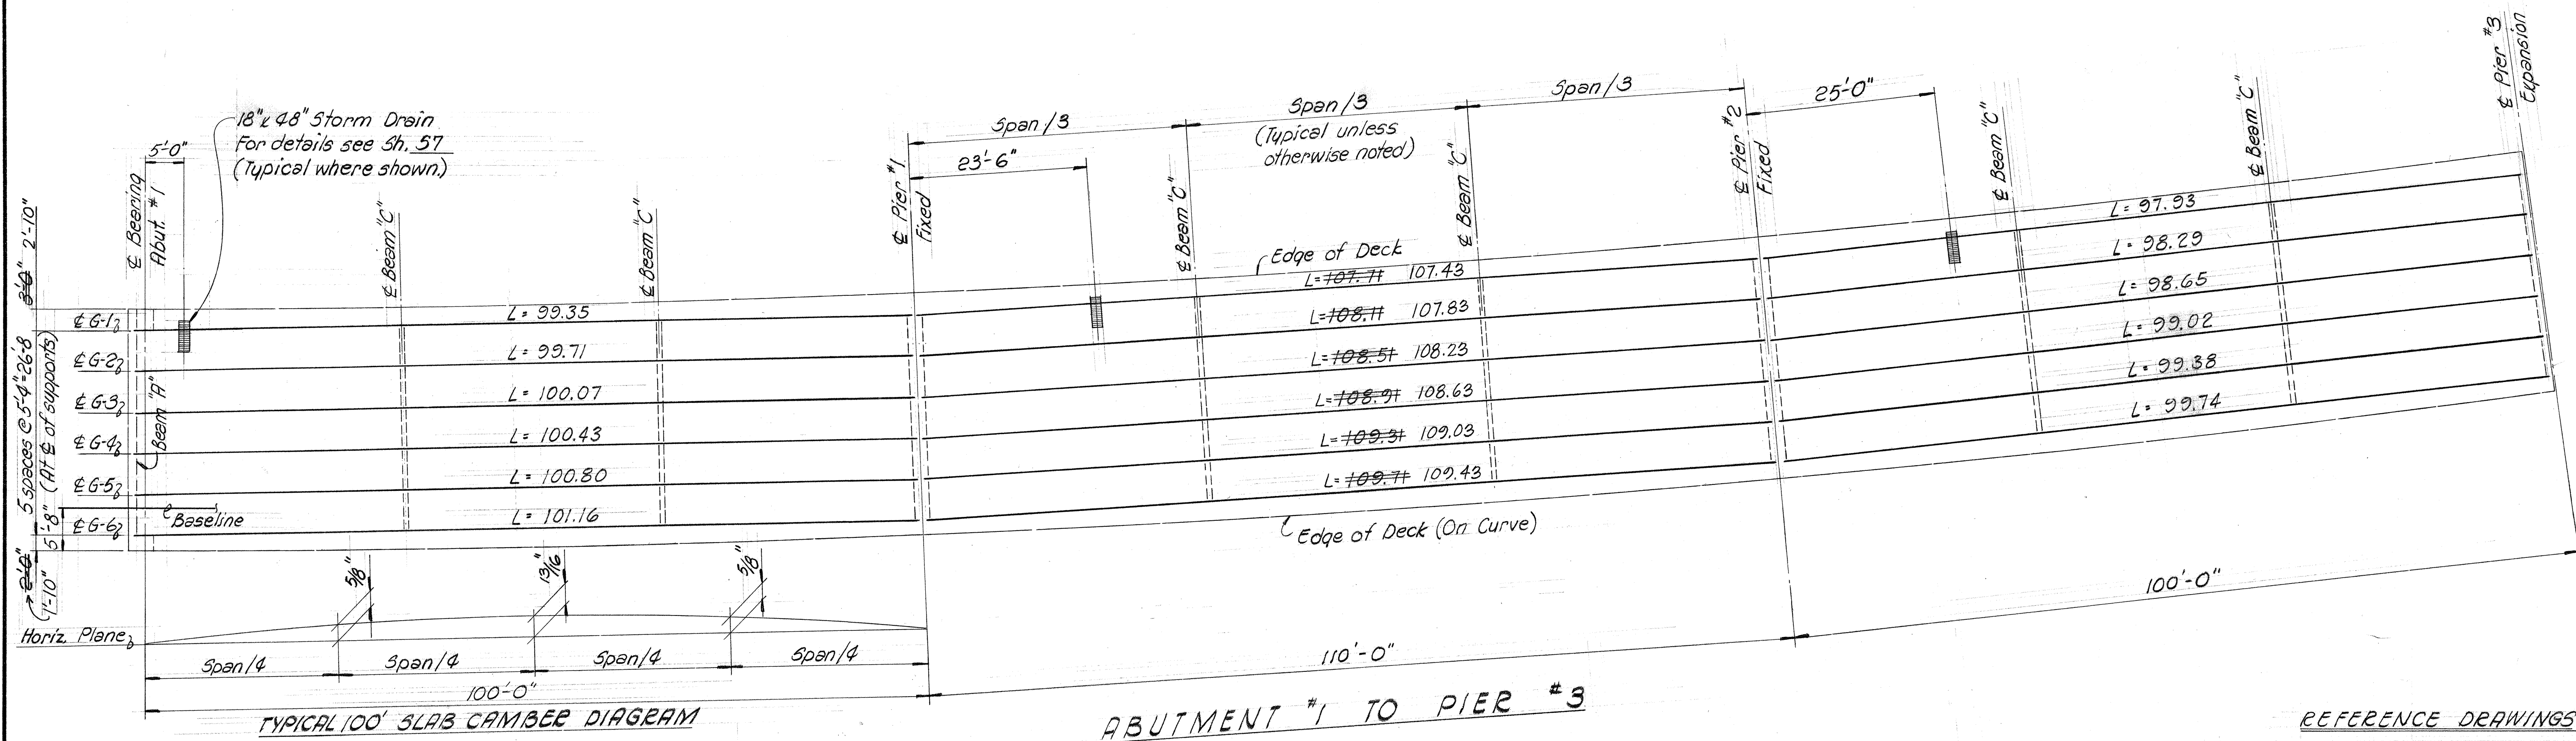

- REFERENCE DRAWINGS
- | | |
|---|--------|
| 1. Beam "A"----- | Sh. 56 |
| 2. Beam "C"----- | Sh. 56 |
| 3. Beam over Fixed &
Expansion Pier Supports-- | Sh. 55 |

NOTES
Girder lengths "L" are measured @
E of girders and horizontally out
to out.

This sheet supersedes
sheet No. 117.

**STATE OF HAWAII
DEPARTMENT OF TRANSPORTATION
HIGHWAYS DIVISION**

STRUCTURE No. 16

DECK FRAMING PLANS


WAIAWA INTERCHANGE
F.A.I. Proj. No. I - HI - 1 (75):8

Scale: As shown Date: JUNE, 1969

SHEET No. 8 OF 13 SHEETS


C.O. 117

SHIMAZU SHIMABUKURO & FUKUDA, INC.
Consulting Structural Engineers
1210 Ward Ave., Honolulu, HI 96814

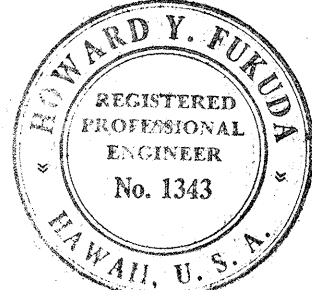

This work was prepared by
me or under my supervision.
Howard Y. Fukuda

FED. ROAD DIST. NO.	STATE	FED. AID PROJ. NO.	FISCAL YEAR	SHEET NO.	TOTAL SHEETS
HAWAII	HAW.	75-8	1969	119	181

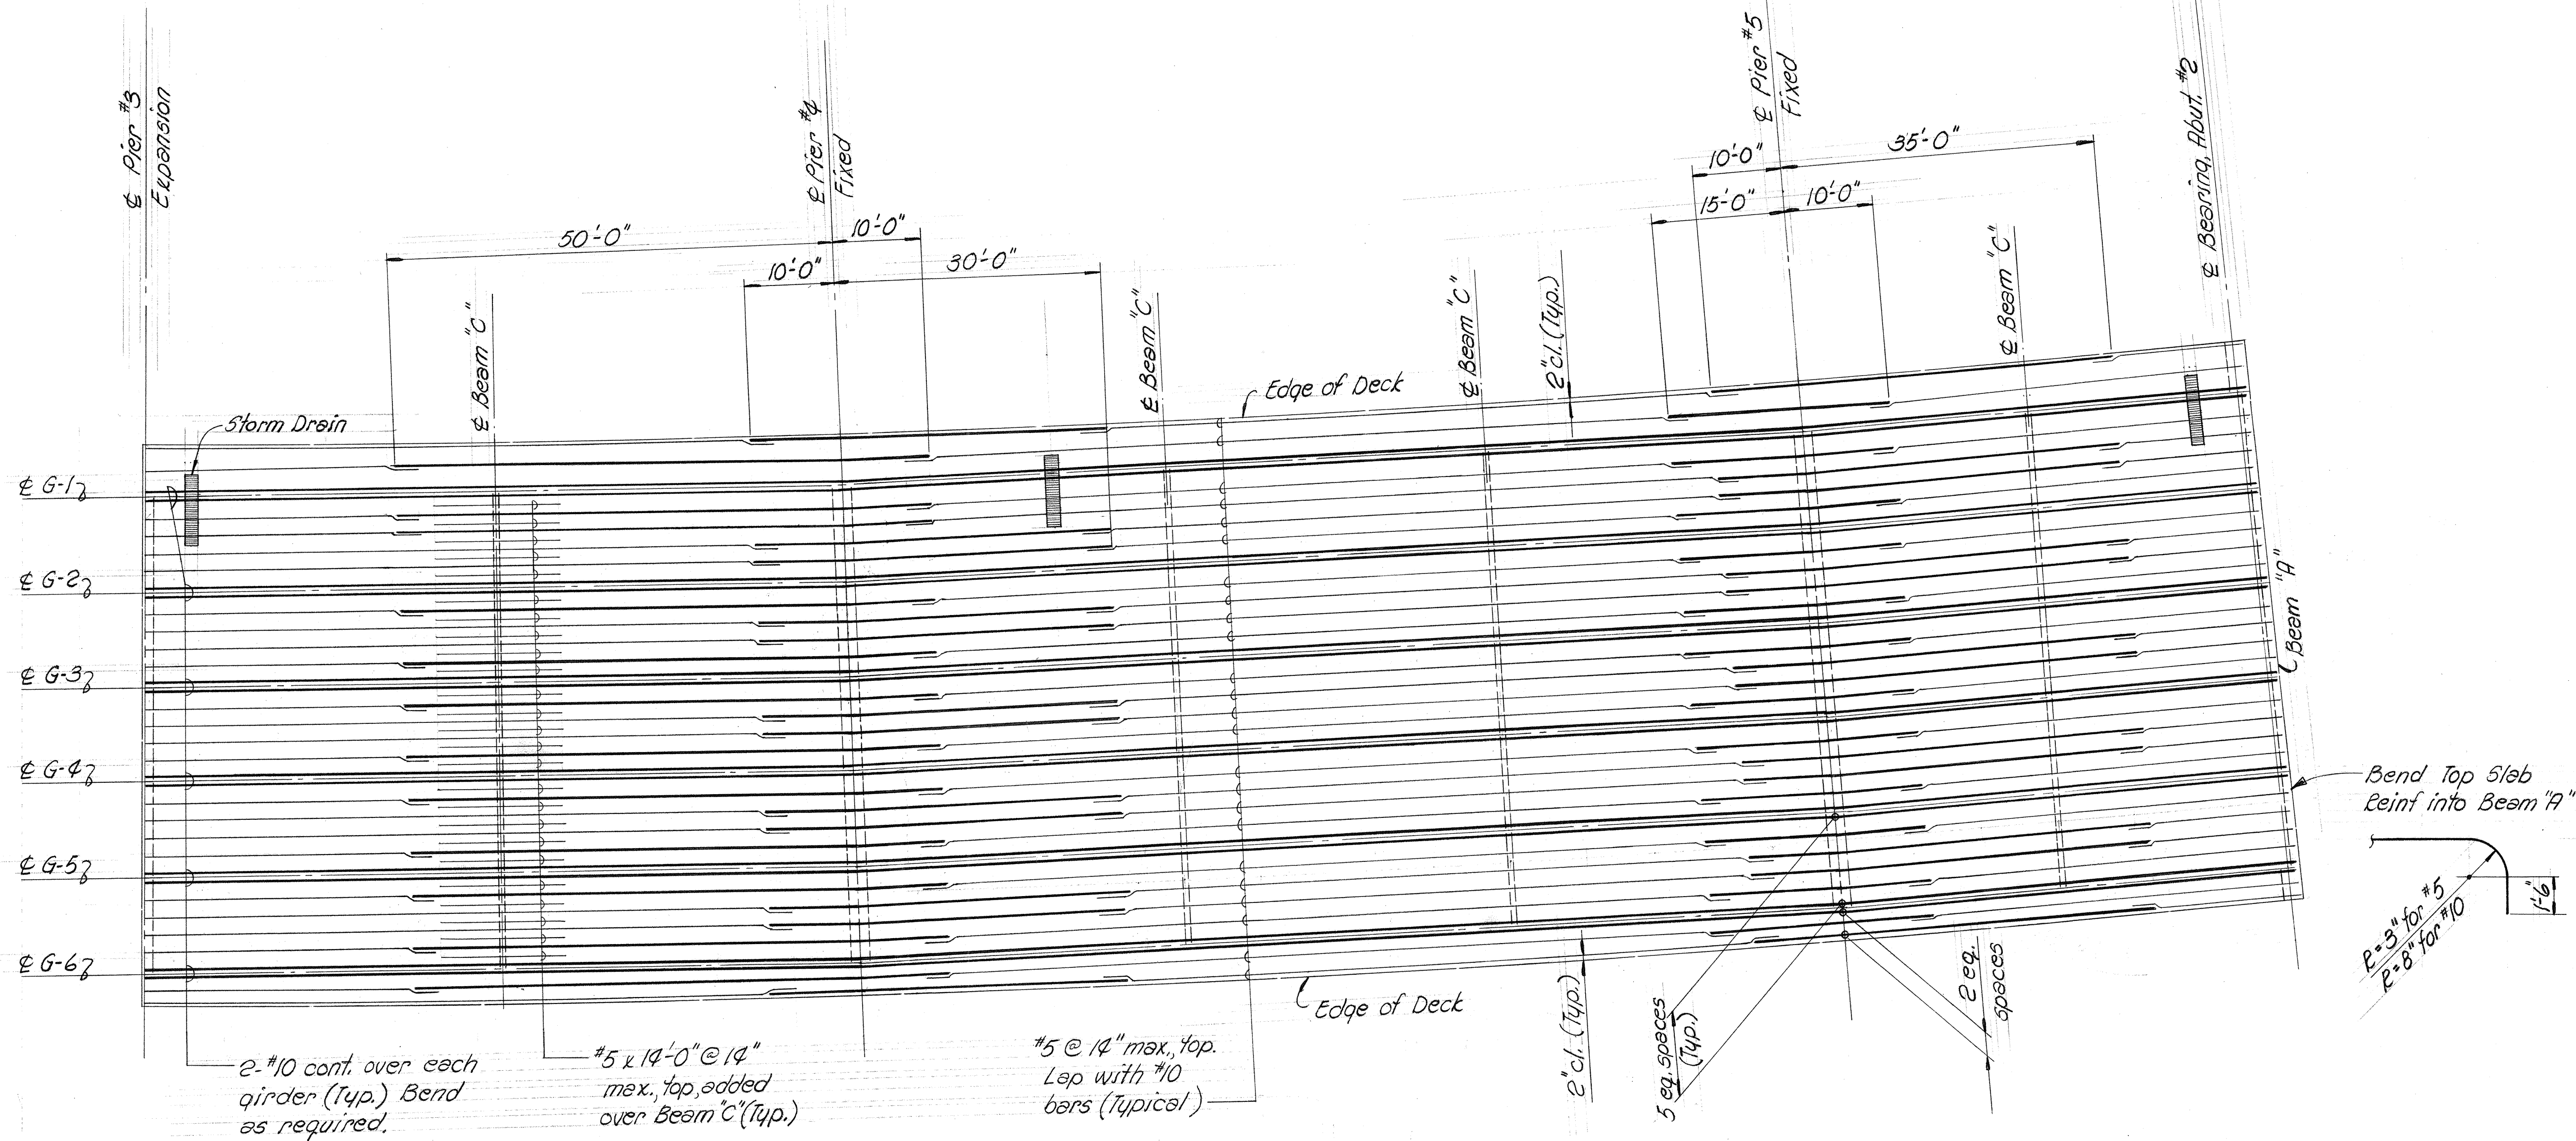

PIER #3 TO ABUTMENT #2


DECK SLAB REINFORCING PLACEMENT PLAN

Scale: Horiz. 3/32" = 1'-0", Vert. 3/16" = 1'-0"

NOTE! See notes Sh. 9

DATE	_____
ORIGINAL PLAN	_____
DESIGNED BY	_____
CHECKED BY	_____
NO.	_____


SHIMAZU SHIMAZUKU & SUGITA, INC.
Consulting Structural Engineers
1210 Ward Ave., Honolulu, HI 96814

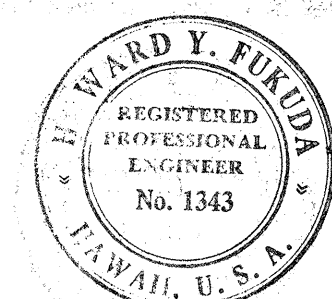

This work was prepared by me or under my supervision.
Howard Y. Fukuda

STATE OF HAWAII DEPARTMENT OF TRANSPORTATION HIGHWAYS DIVISION	
STRUCTURE No. 16	
DECK SLAB REINFORCING PLACEMENT PLAN PIER #3 TO ABUTMENT #2	
WATAWA INTERCHANGE F.A.I. Proj. No. I-HI-1 (75):8	
Scale: As shown	Date: JUNE 1969
SHEET No. 10 OF 13 SHEETS	


FED. ROAD DIST. NO.	STATE	FED. AID PROJ. NO.	FISCAL YEAR	SHEET NO.	TOTAL SHEETS
HAWAII	HAW.	I-HI-1(75):8	1969	120	181

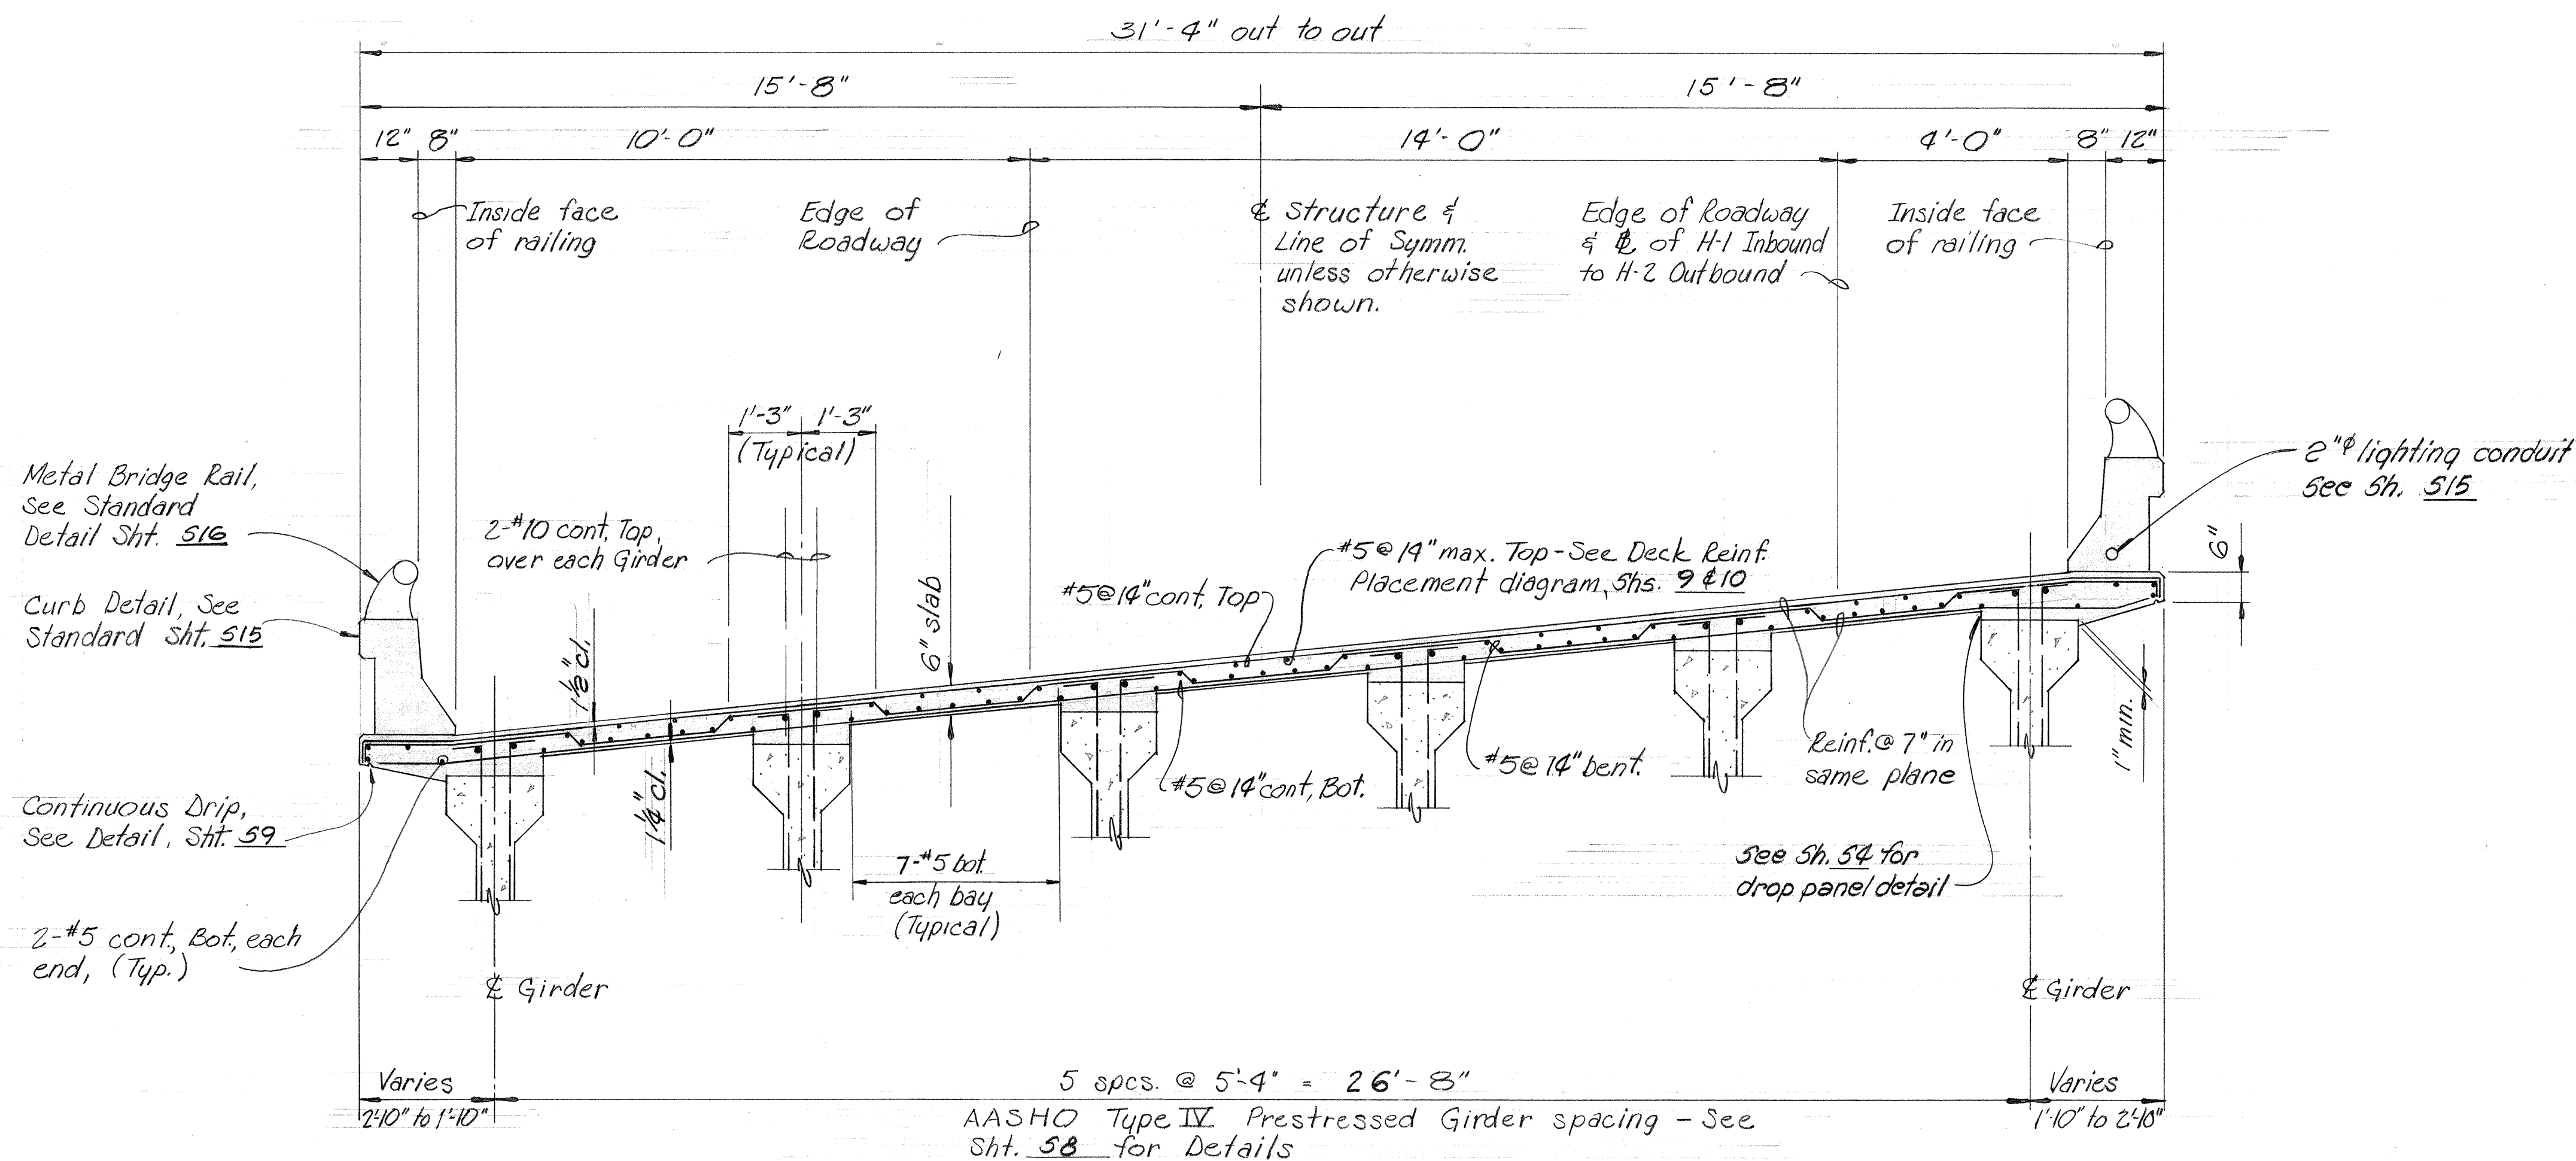

TYPICAL DECK SECTION
1/2" = 1'-0"

ORIGINAL PLAN	DATE
SURVEY PLOTTED BY	
DRAWN BY	
DESIGNED BY	
CHECKED BY	
NOTE BOOK	
No.	

CHAMBERLAIN & FUKUDA, INC.
Consulting Structural Engineers
1210 Ward Ave., Honolulu, HI 96814

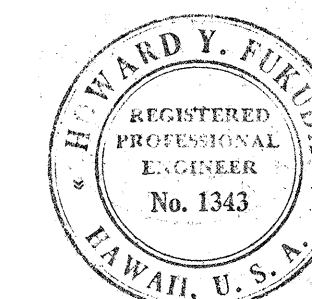

This work was prepared by me or under my supervision.
Howard Y. Fukuda

STATE OF HAWAII
DEPARTMENT OF TRANSPORTATION
HIGHWAYS DIVISION


STRUCTURE No. 16

TYPICAL DECK SECTION

WATAWA INTERCHANGE
F.A.I. Proj. No. I - HI - 1 (75):8







Scale: As shown Date: June, 1969

SHEET No. 11 OF 13 SHEETS

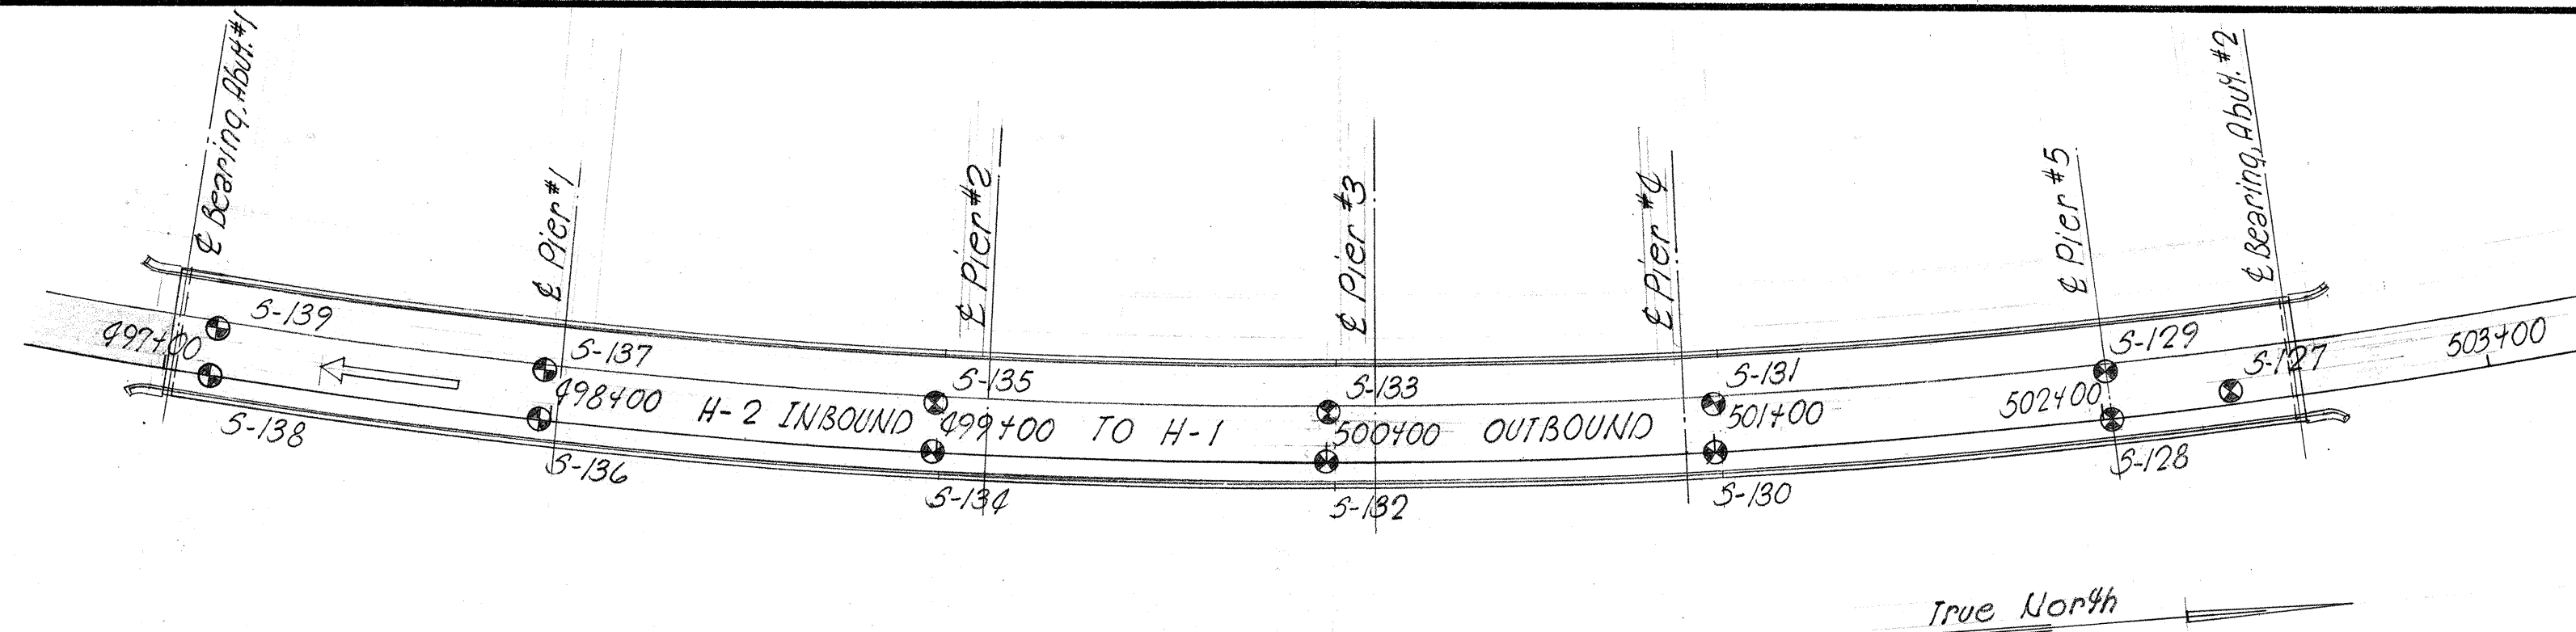


BORING PLOT PLAN

Scale: 1" = 90'-0"

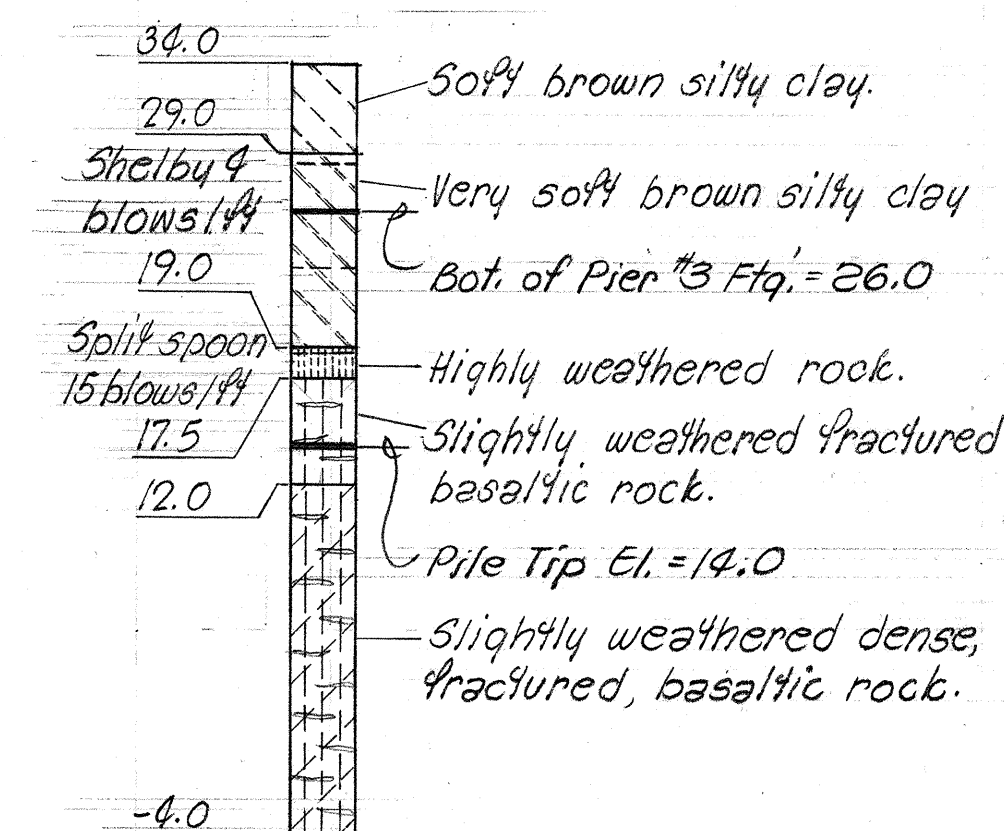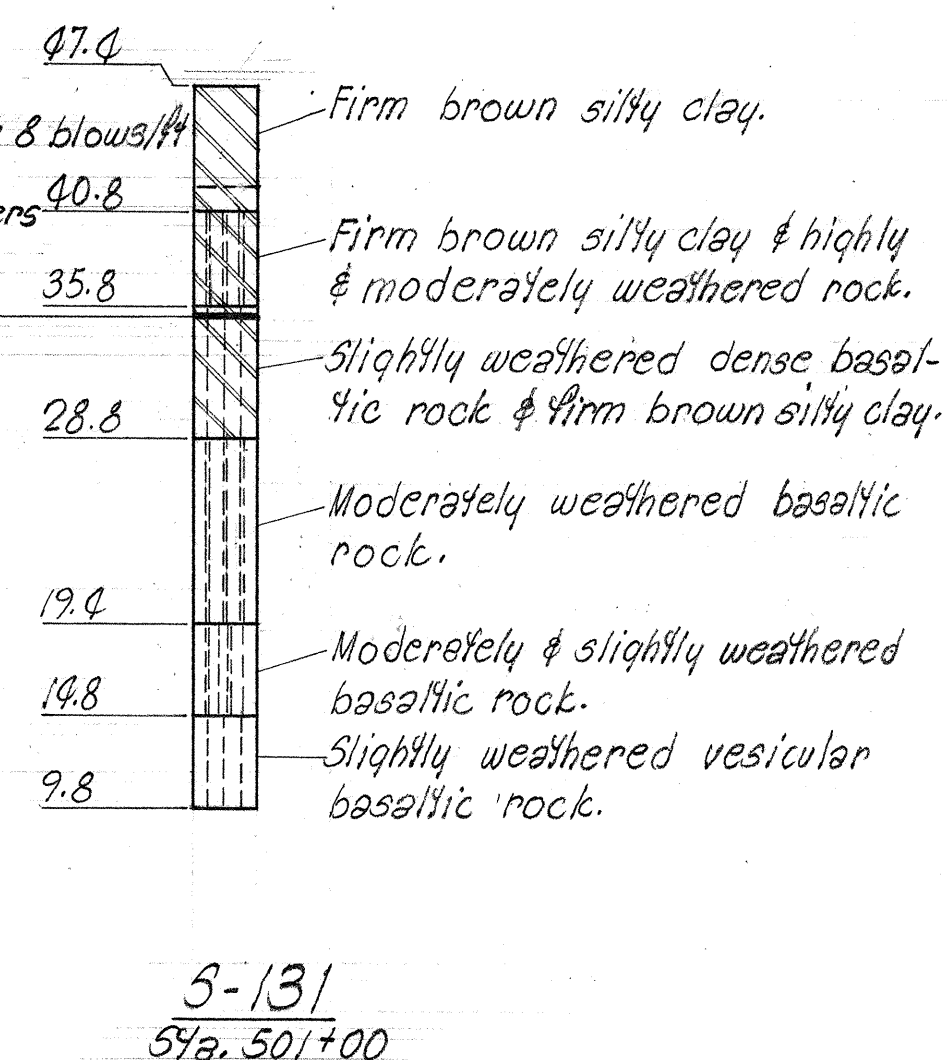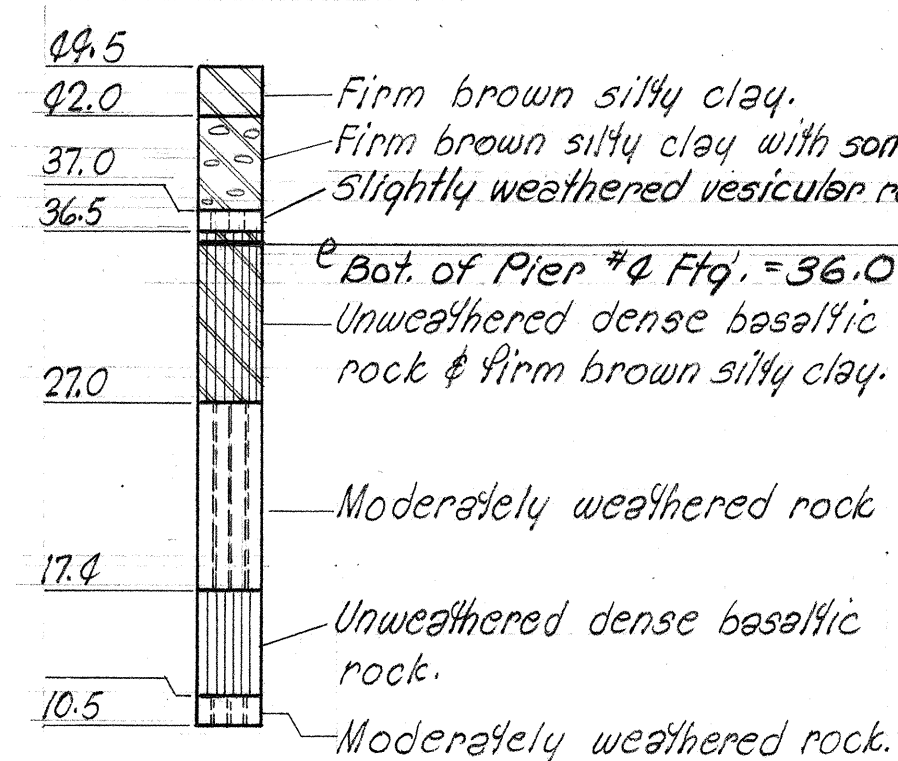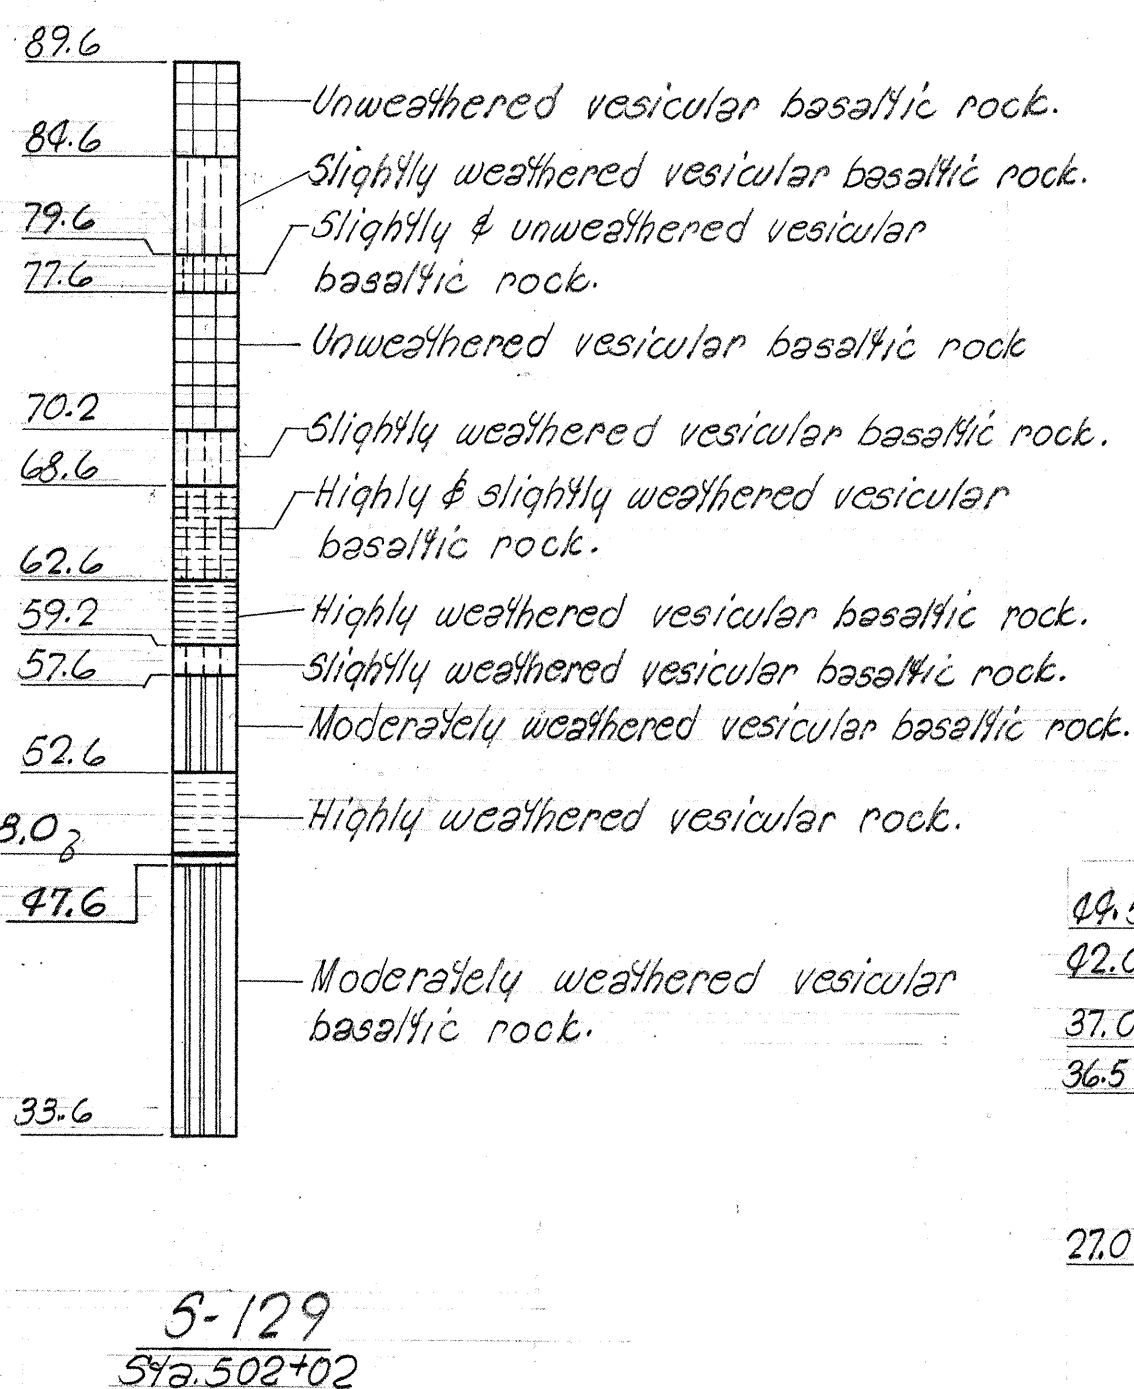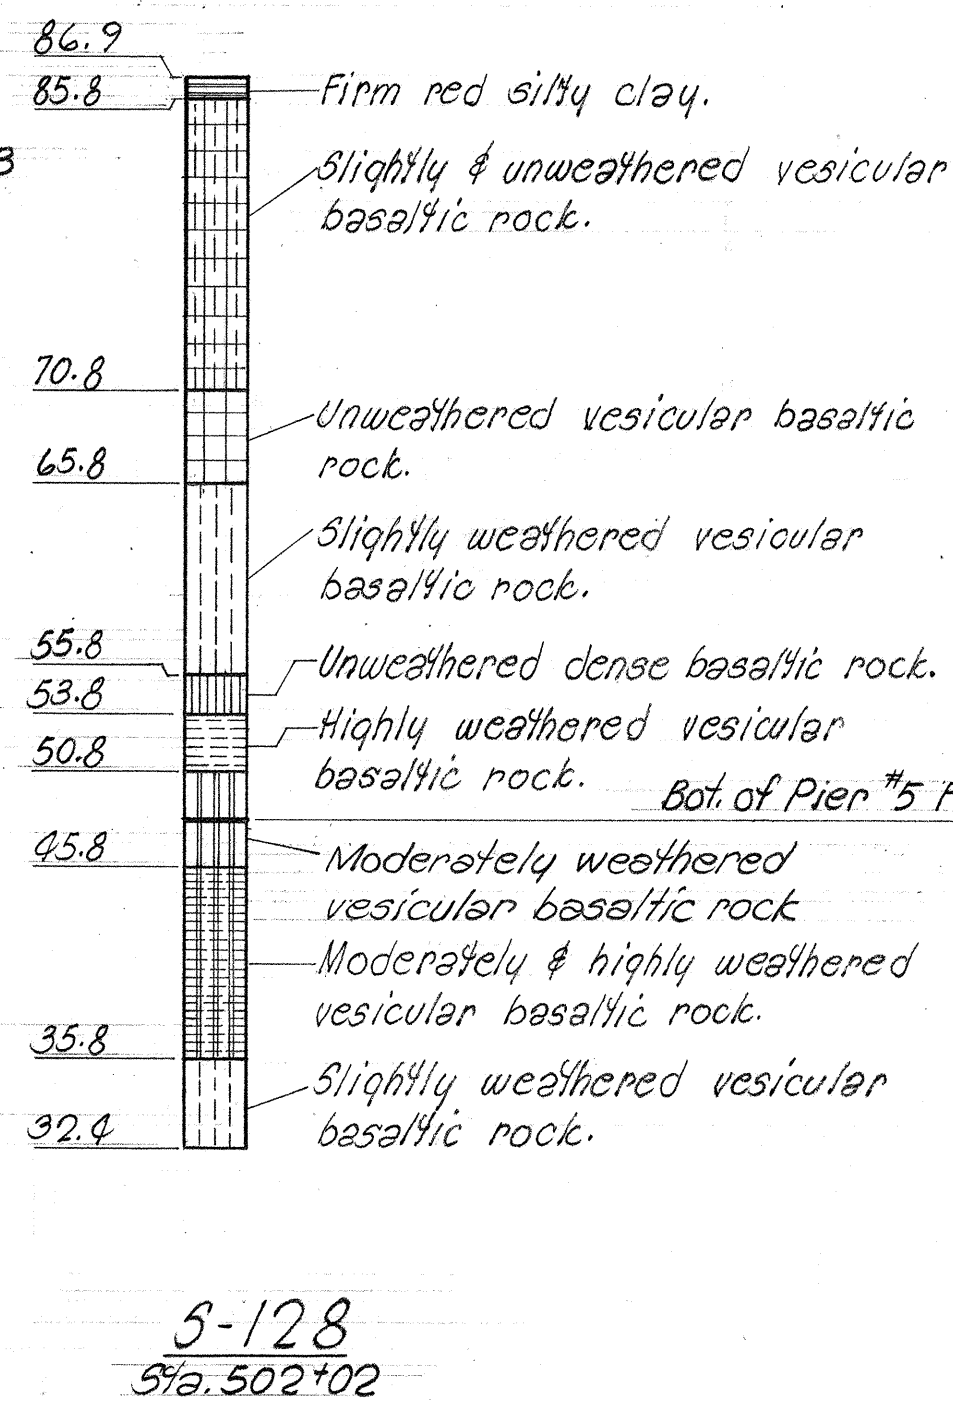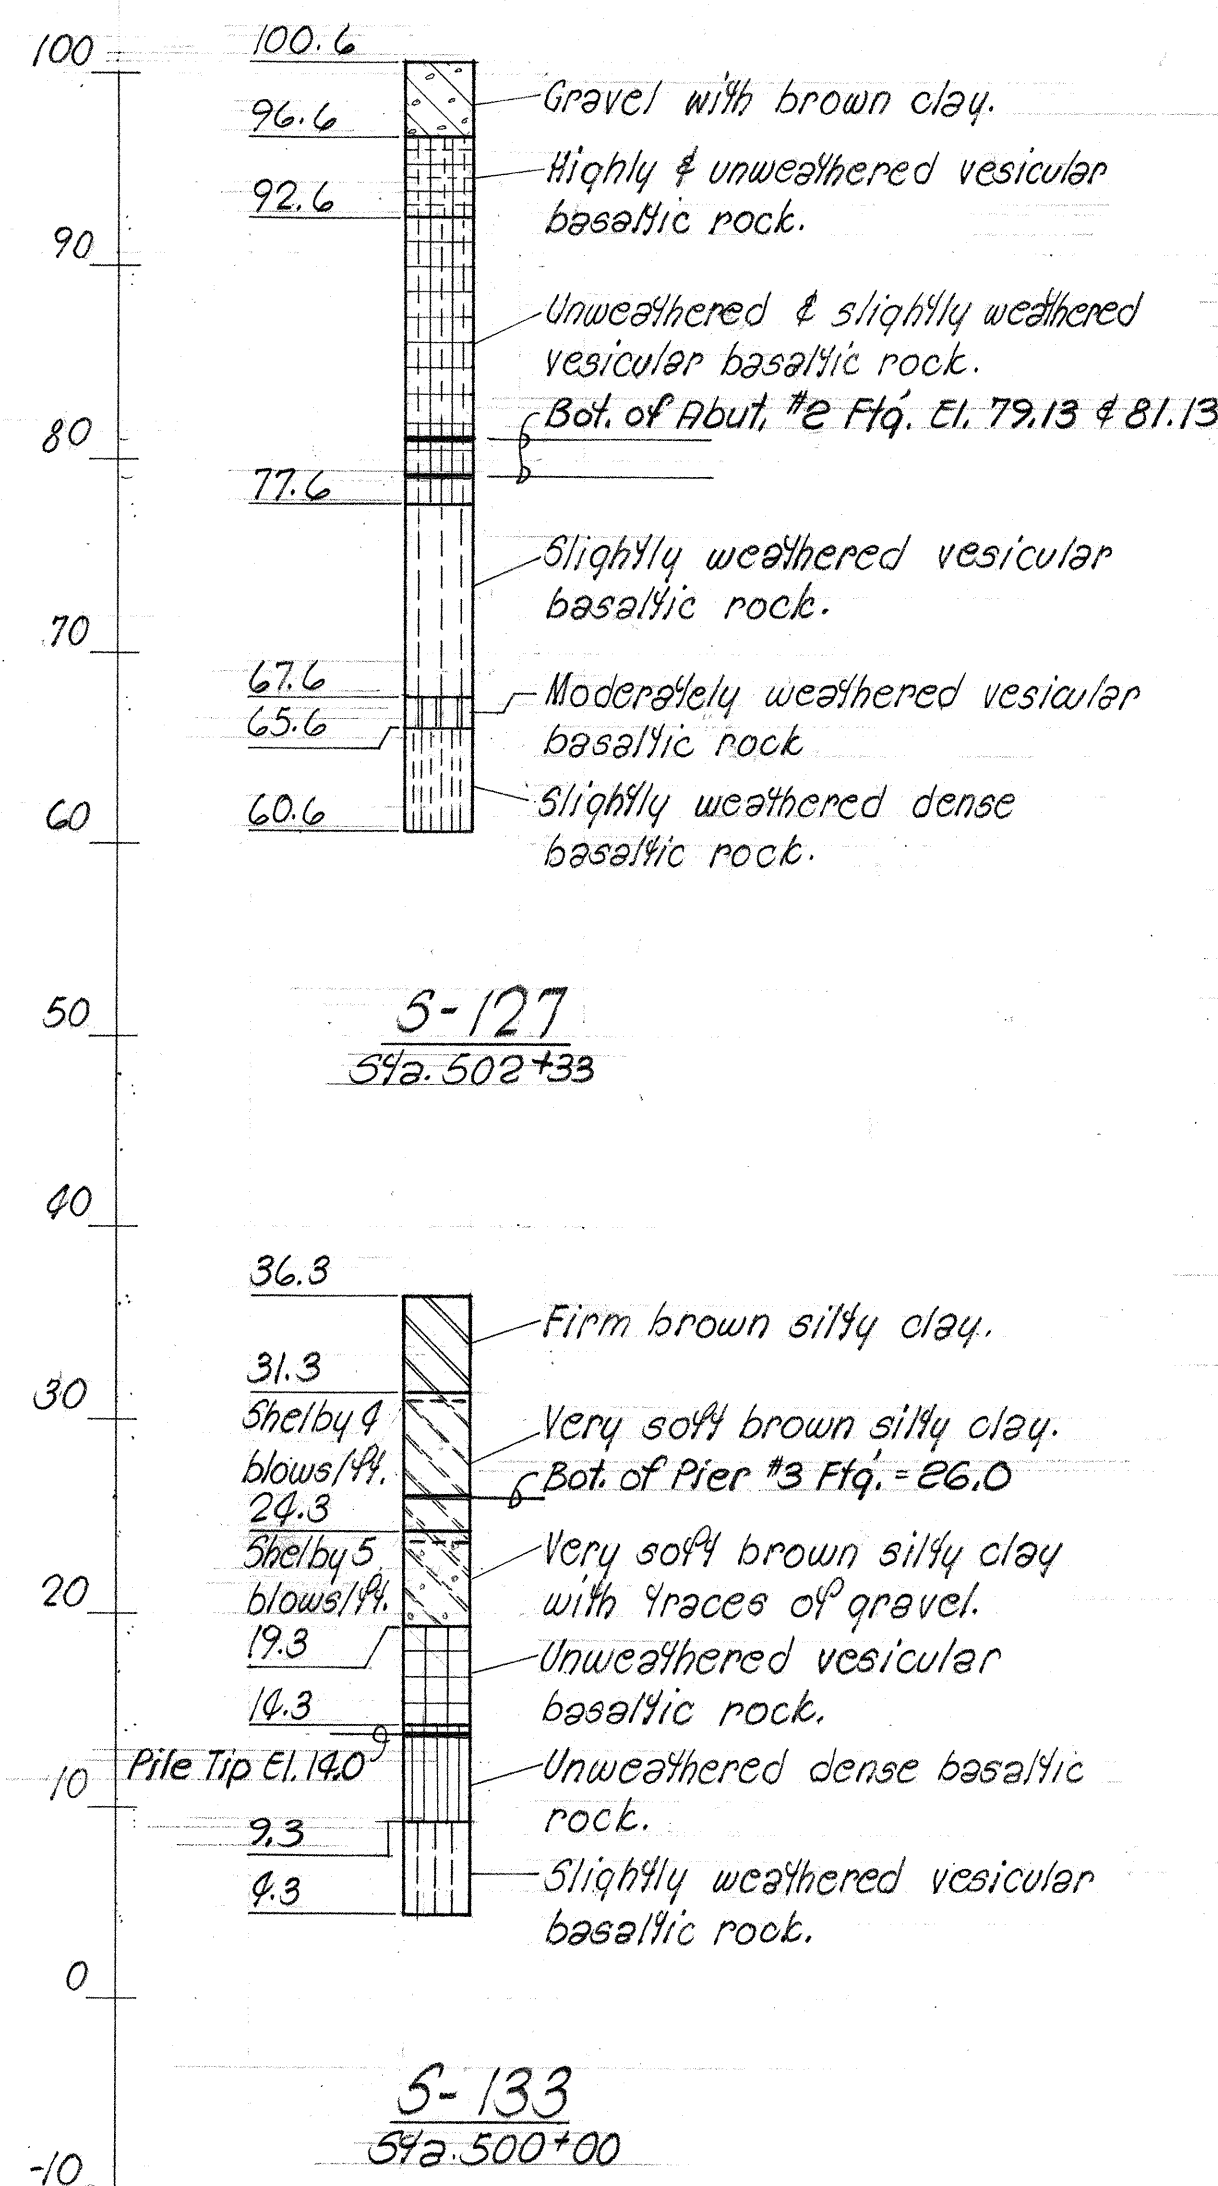

BORING LOGS FOR STRUCTURE 16

SHIMAZU SHIMADZUKU & FUKUDA, INC.
Consulting Structural Engineers
1210 Ward Ave., Honolulu, HI 96814

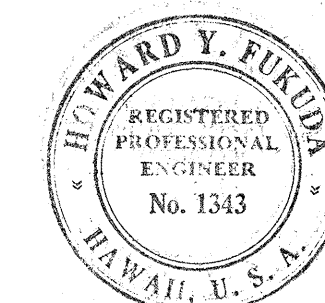

This work was prepared by me or under my supervision.
Howard Y. Fukuda



STATE OF HAWAII
DEPARTMENT OF TRANSPORTATION
HIGHWAYS DIVISION

STRUCTURE NO. 16
BORING LOGS

WAIKAWA INTERCHANGE
F.A.I. Proj. No. I-HI-1(75)8

Scale: As shown Date: June, 1969
SHEET No. 12 OF 13 SHEETS

FED. ROAD DIST. NO.	STATE	FED. AID PROJ. NO.	FISCAL YEAR	SHEET NO.	TOTAL SHEETS
HAWAII	HAW.	I-HI-1(75)-8	1969	121 C	181

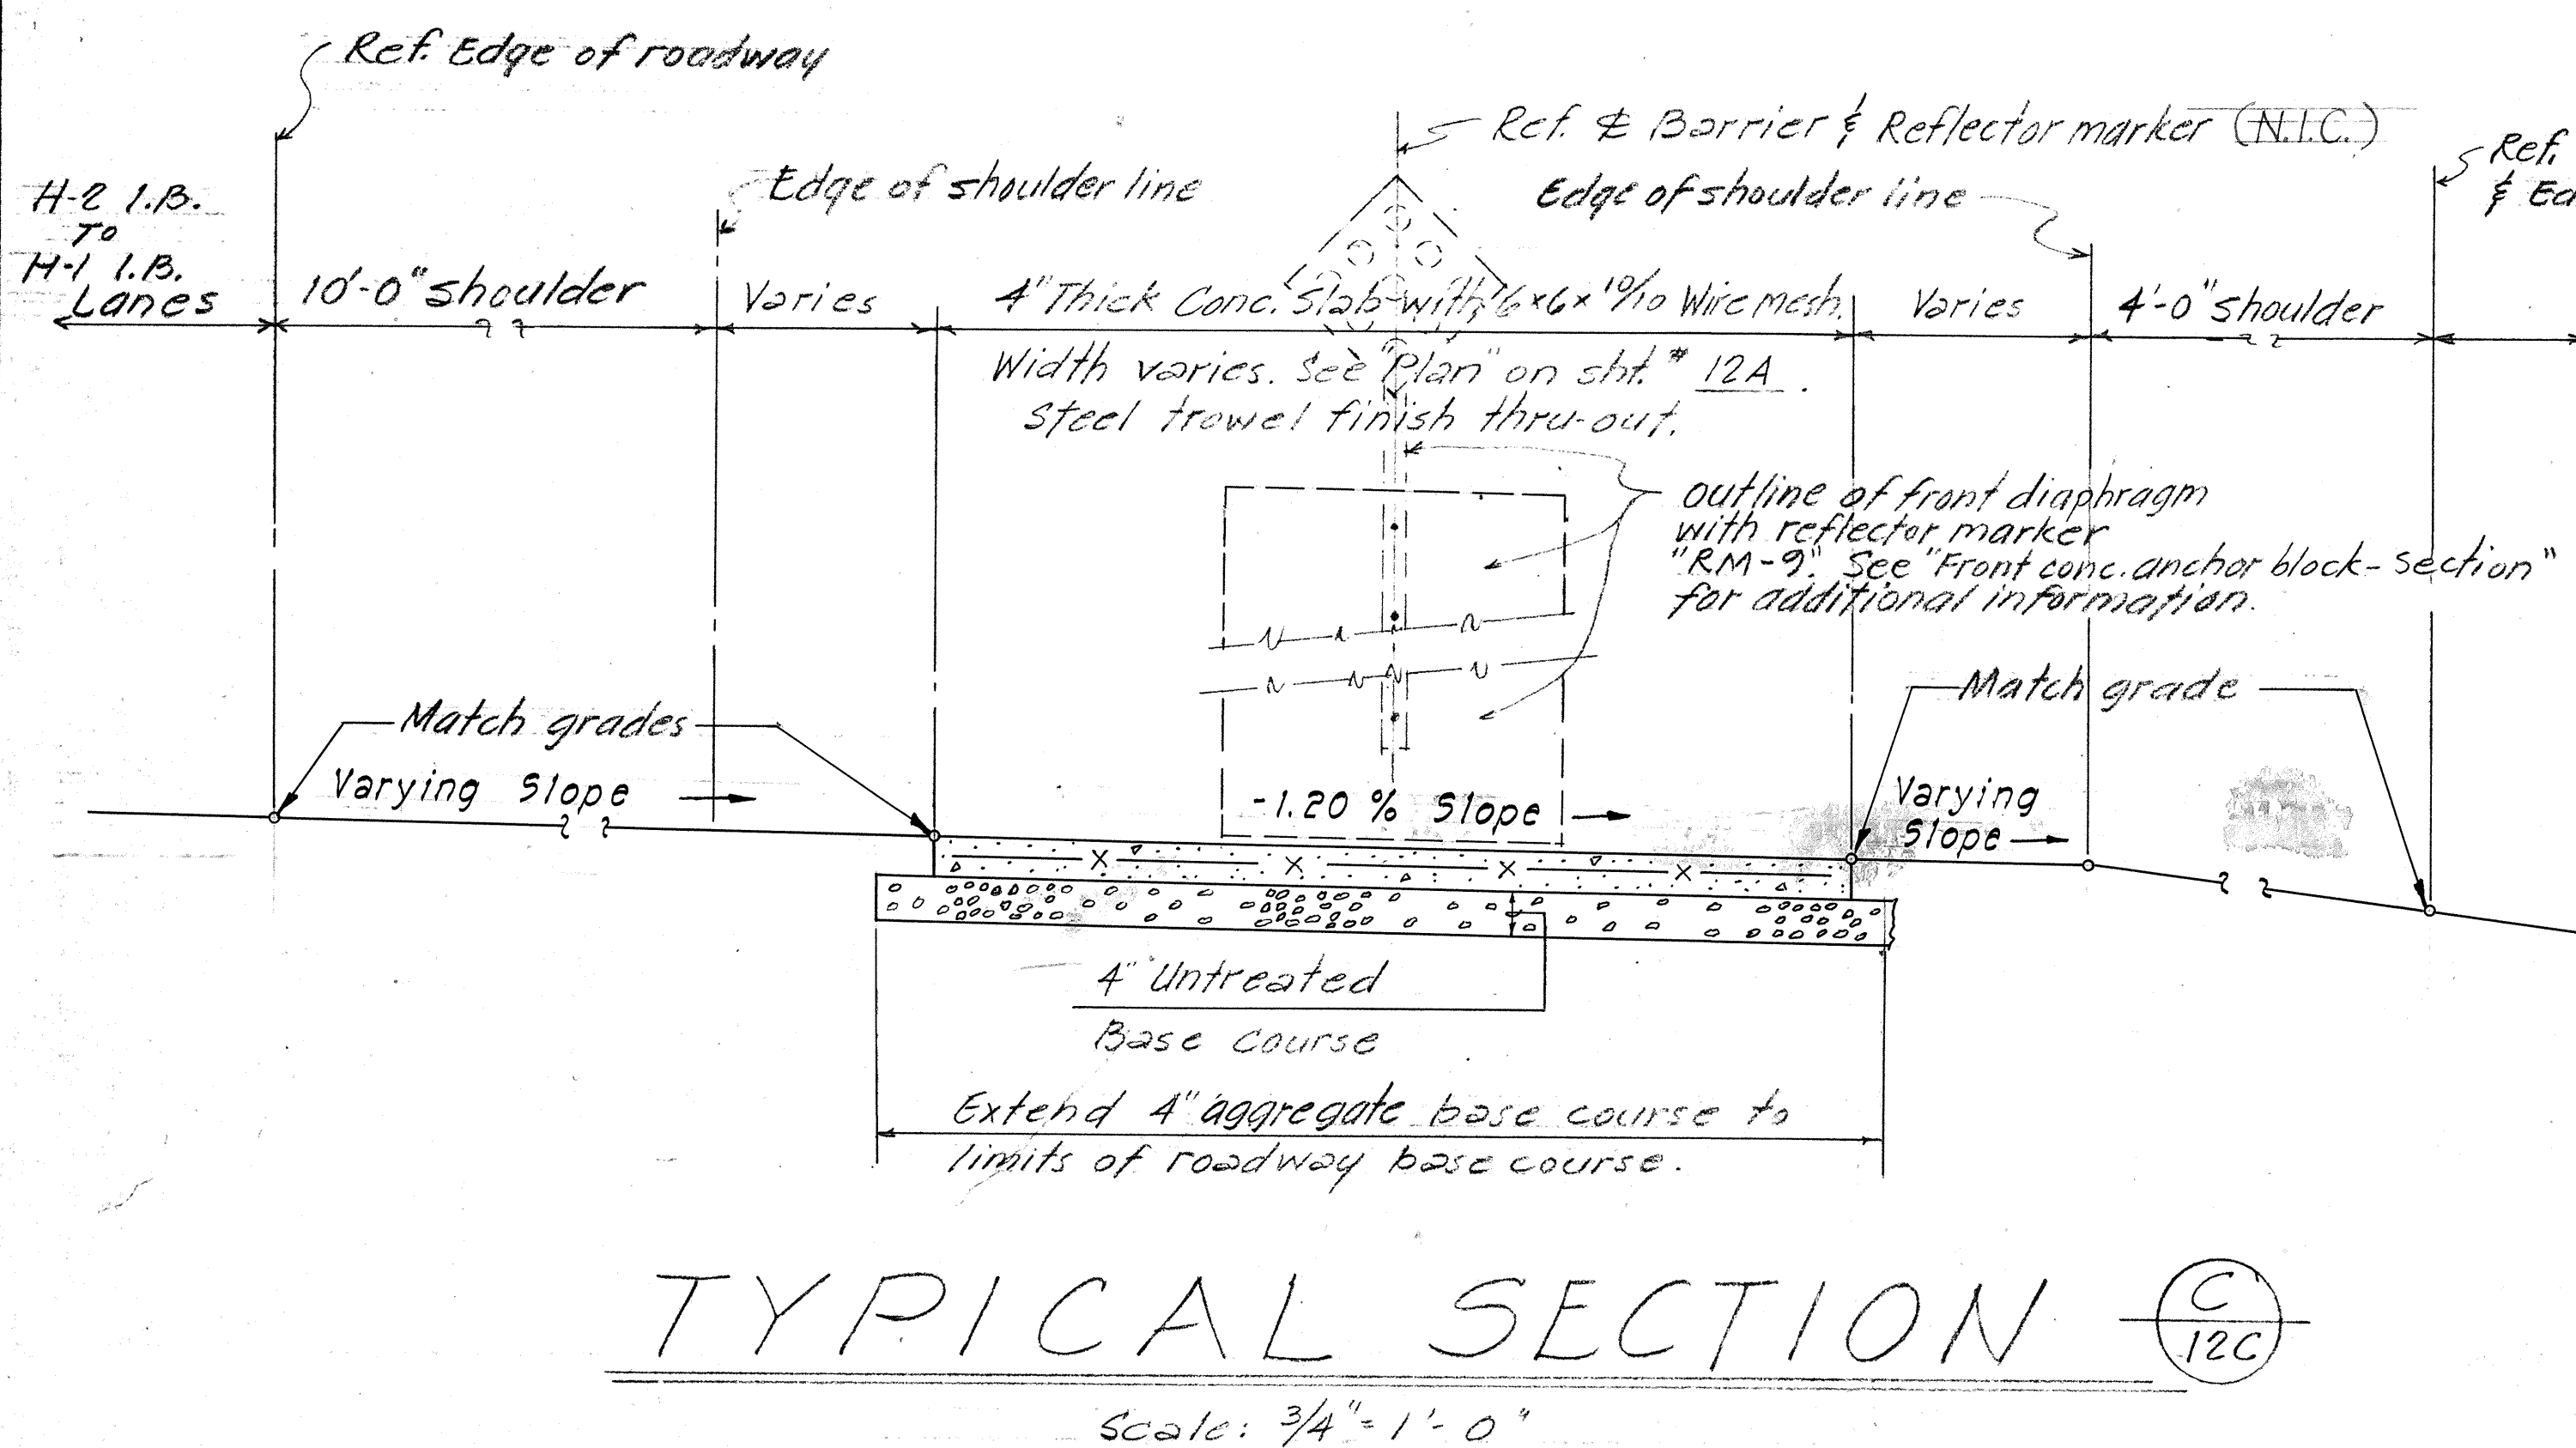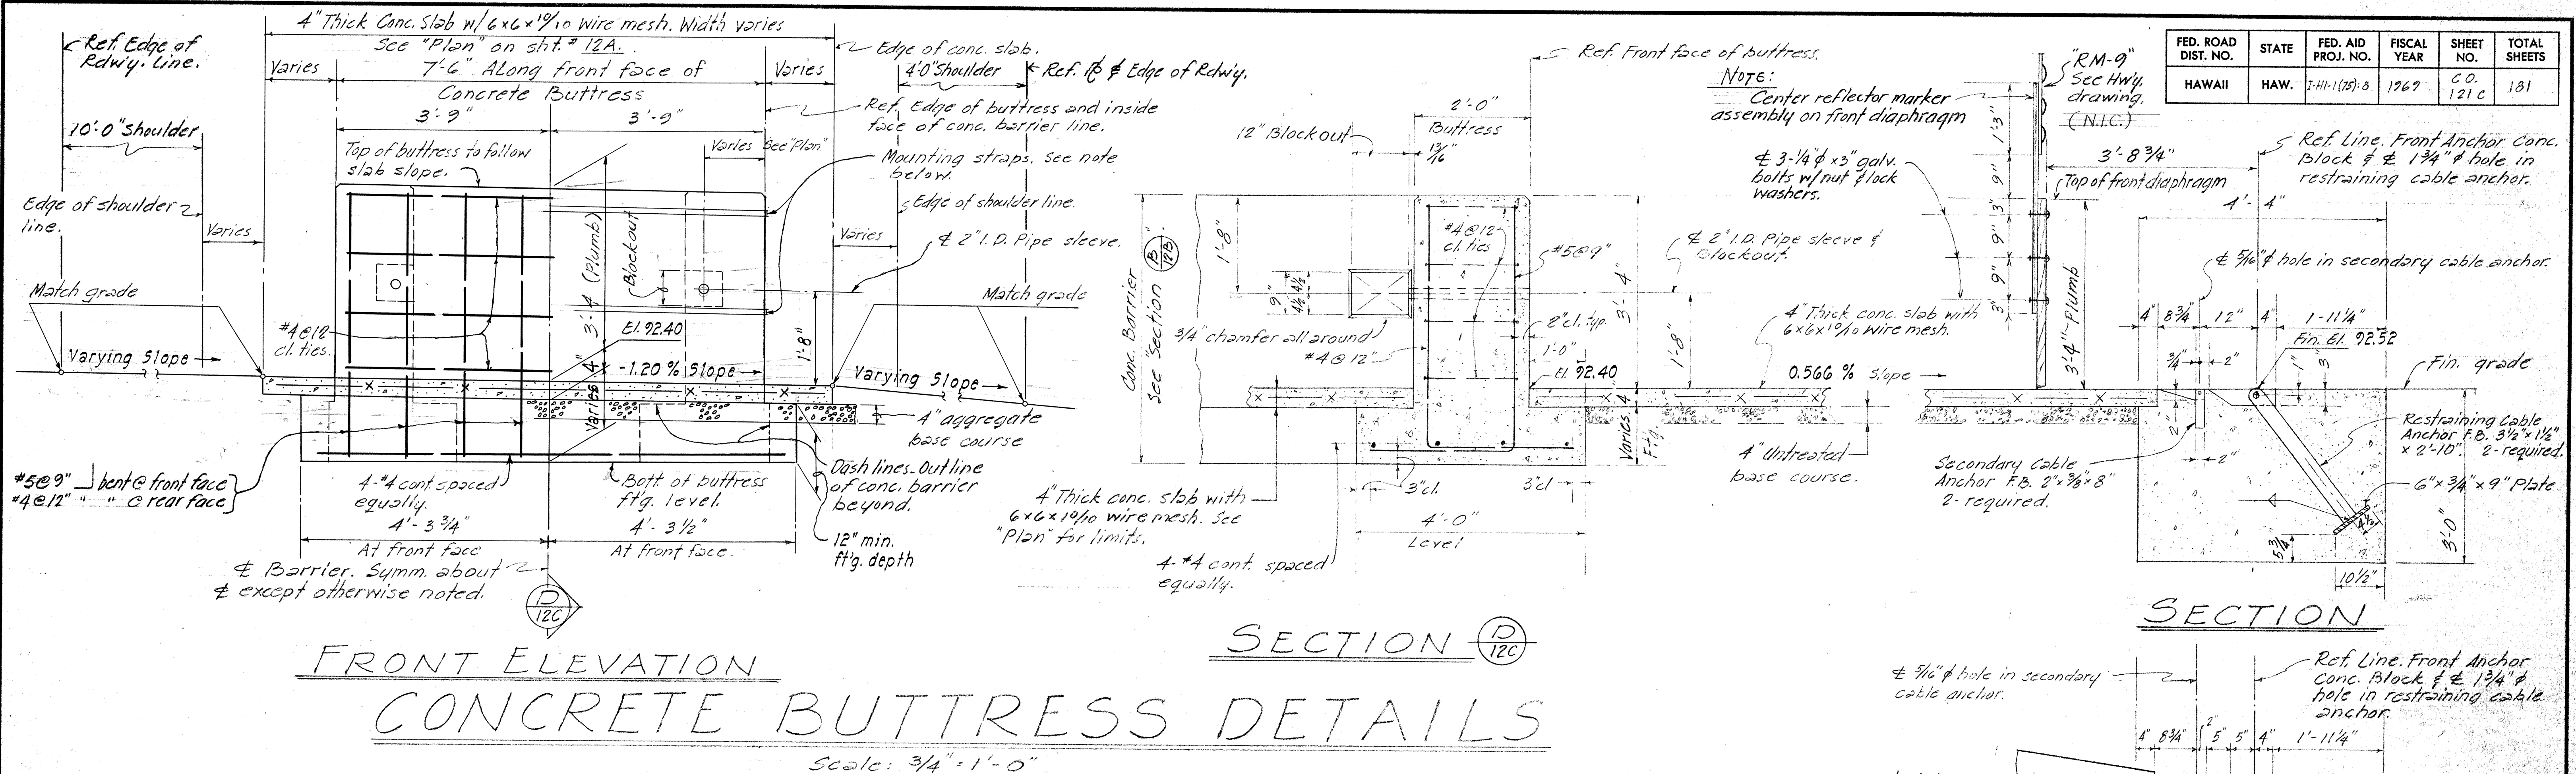


NOTE

All materials and information necessary to properly construct and install the cells shall be furnished by the manufacturers of the cells. All brackets, bolts and other appurtenances necessary for the installation of the cushion barrier shall be placed in the structure that is being constructed, in accordance with the plans and the manufacturer's recommendations.

The individual components, fastenings and overall installation shall reflect the latest designs and installation practices at the time of installation.

Galvanize all anchor assemblies in front anchor block and buttruss and all bolts, mounting straps, sleeves and other appurtenances used in the installation of the cushion barrier.

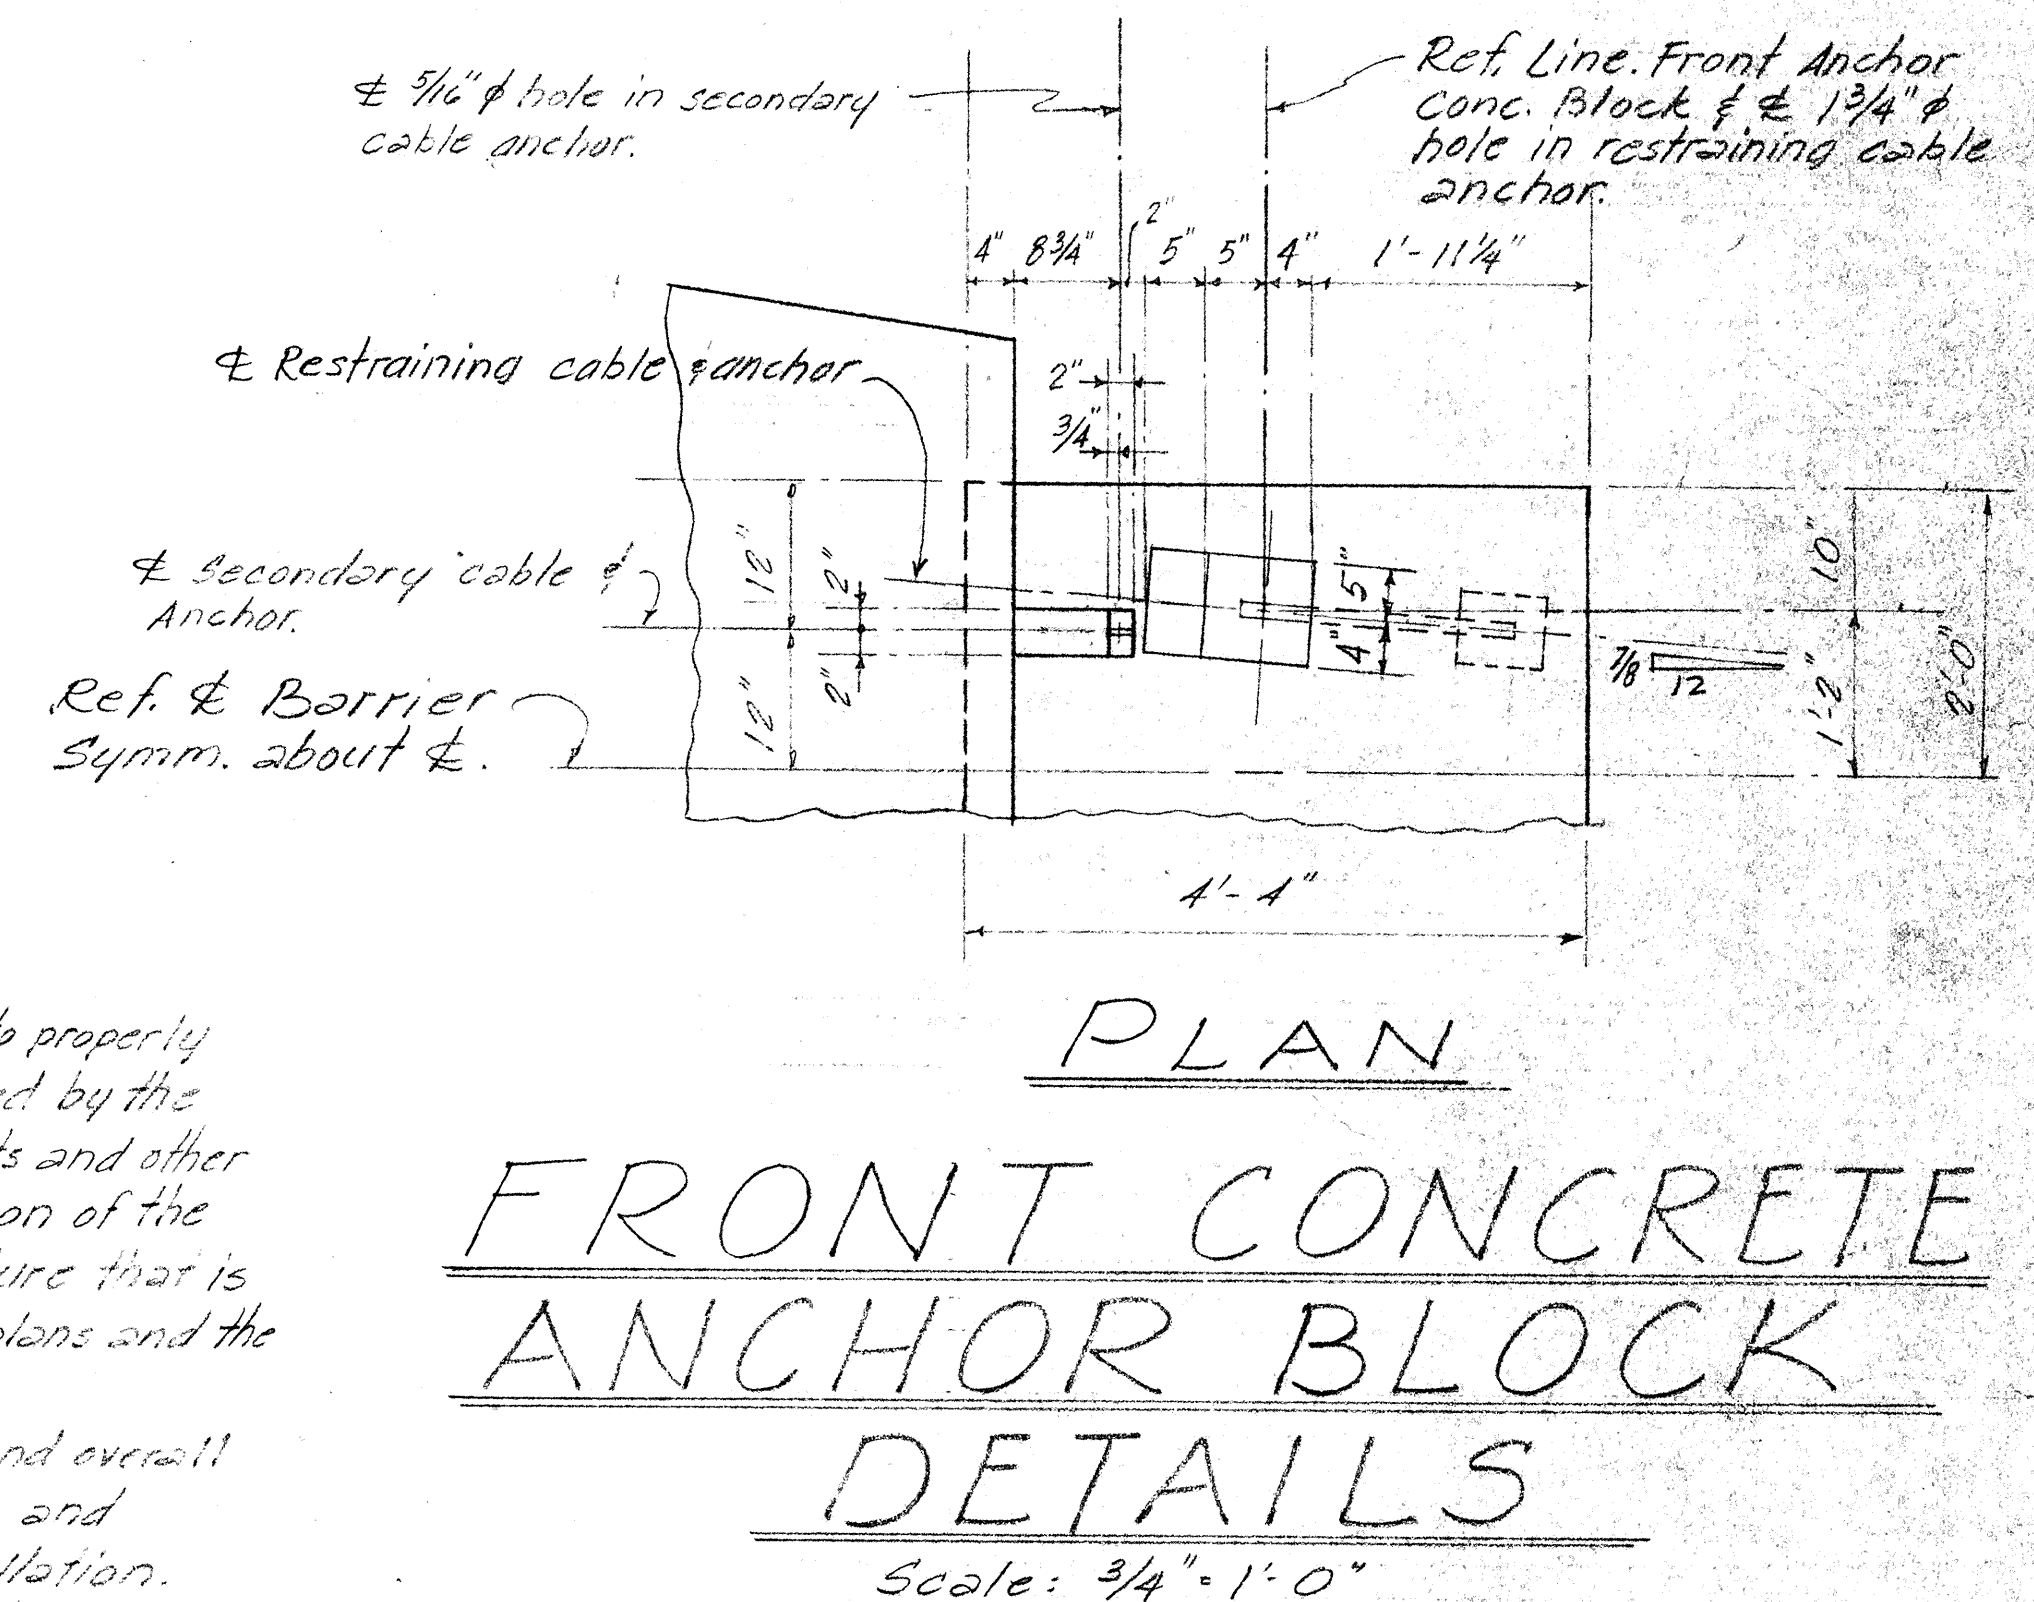

THIS SHEET SUPERSEDES
SHT. NO. ADD. 121C

STATE OF HAWAII DEPARTMENT OF TRANSPORTATION HIGHWAYS DIVISION
STRUCTURE N° 15 & 16 INTERSECTION CONC. BARRIER DETAILS WAIAWA INTERCHANGE F.A.I. PROJ. N° I-HI-1(75)-8 Scale as shown Date: June, 1971
SHEET No. 12C OF 13 SHEETS


DATE	REVISION
4-18-73	Cushion barrier conc. structure grades revised to match revised Highway grades. Also detail drawing of reflector marker RM-9 added.
6-24-71	Abut wingwalls #1 & #4 realigned due to addition of cushion barrier conc. structure.

APR. 18, 1973

JUNE 24, 1971

C O. 121 C

FED. ROAD DIST. NO.	STATE	FED. AID PROJ. NO.	FISCAL YEAR	SHEET NO.	TOT SHEETS
HAWAII	HAW.	I-HI-1(75):8	1969	122	18

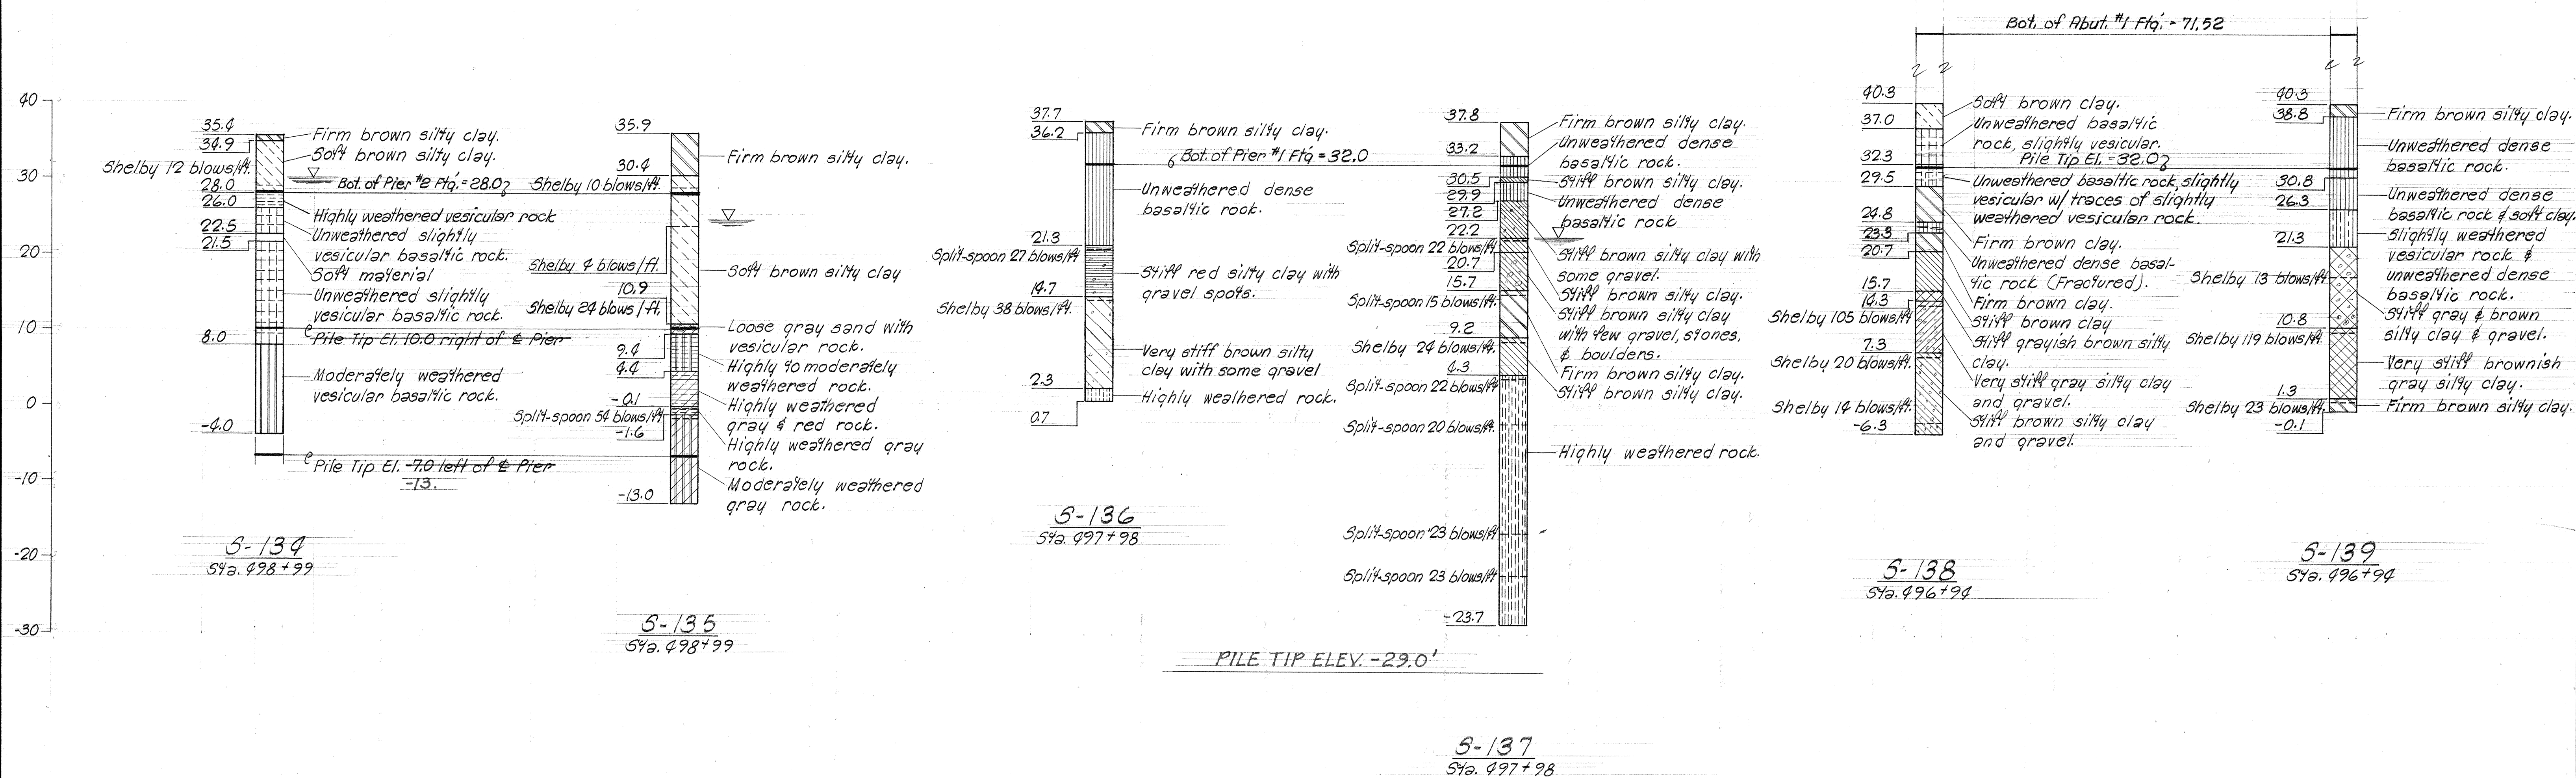


BORING LOGS FOR STRUCTURE 16

See Sh. 12 for Boring Plot Plan.

ORIGINAL PLAN	SURVEY PLOTTED BY _____ DATE _____
NOTE BOOK	DRAWN BY _____
	TRACED BY _____
	DESIGNED BY _____
	QUANTITIES BY _____
NO. _____	CHECKED BY _____

SHIMAZU SHIMABUKURO & FUKUDA, INC.
Consulting Structural Engineers
1210 Ward Ave., Honolulu, HI 96814

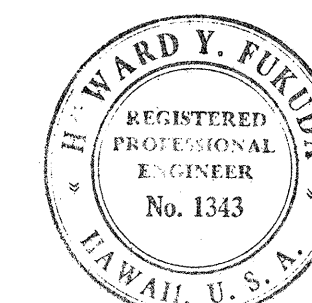

This work was prepared by
me or under my supervision.
Howard Y. Finkbeiner

STATE OF HAWAII
DEPARTMENT OF TRANSPORTATION
HIGHWAYS DIVISION

STRUCTURE NO. 16

BORING LOGS

WAIAWA INTERCHANGE
F.A.I. Proj. No. I- HI-1 (75):8

Scale: As shown Date: JUNE, 1969

SHEET No. 13 OF 13 SHEETS