

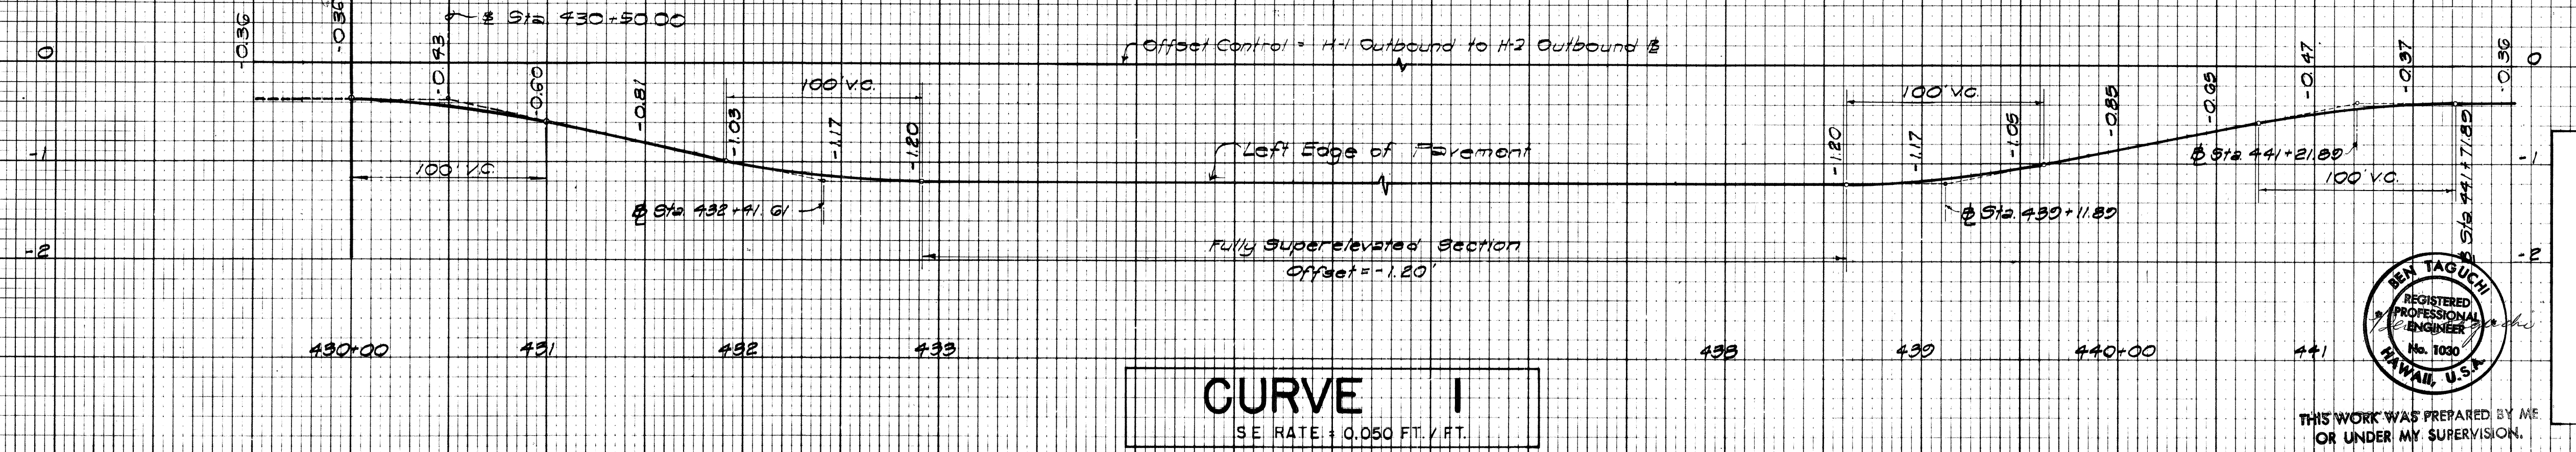
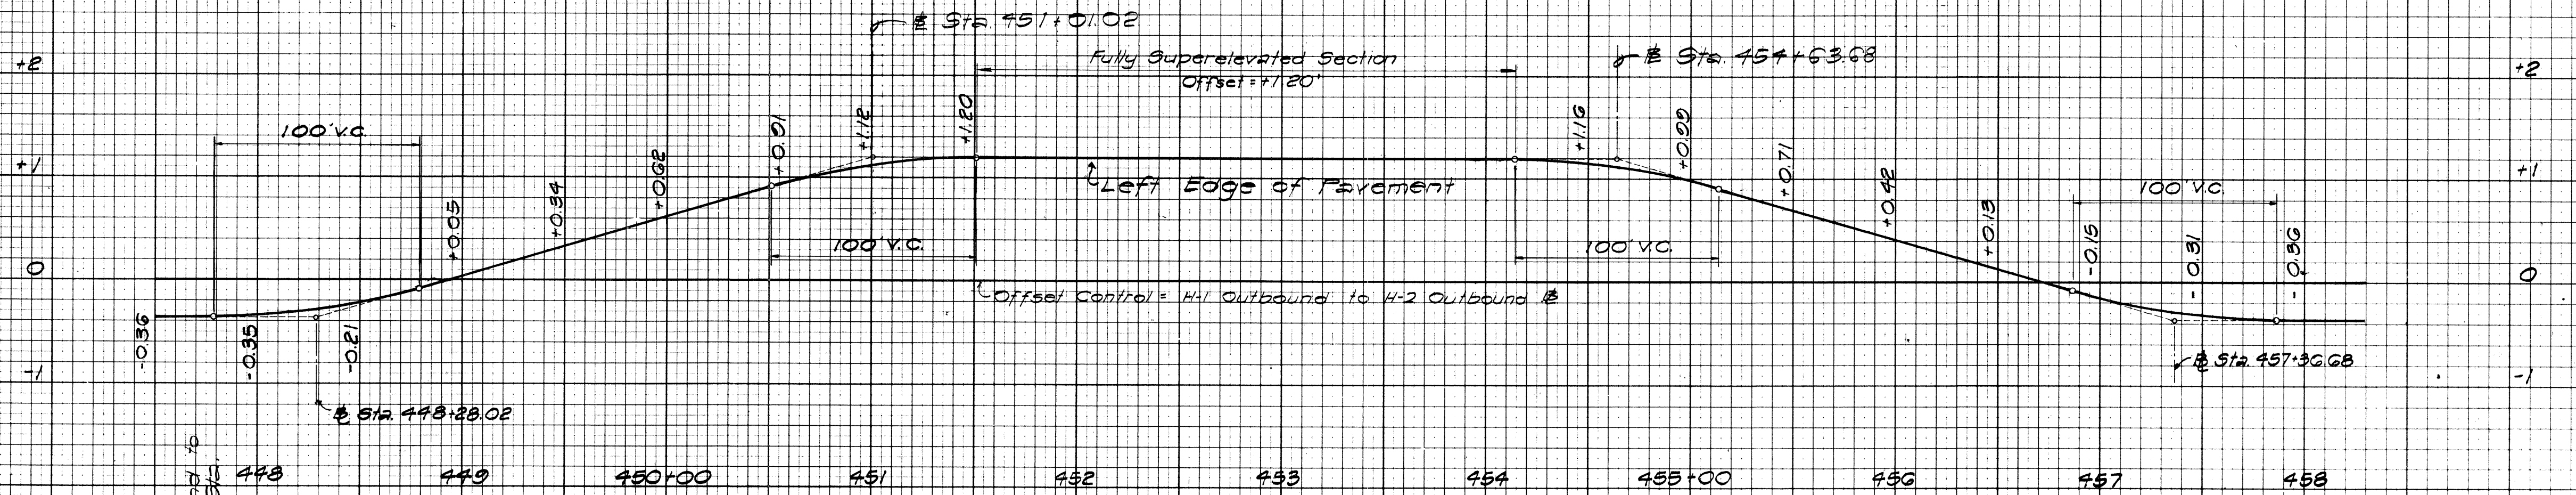


FED. ROAD DIST. NO.	STATE	FED. AID PROJ. NO.	FISCAL YEAR	SHEET NO.	TOTAL SHEETS
HAWAII	HAW.	I-H-1(75):8	1969	17	181

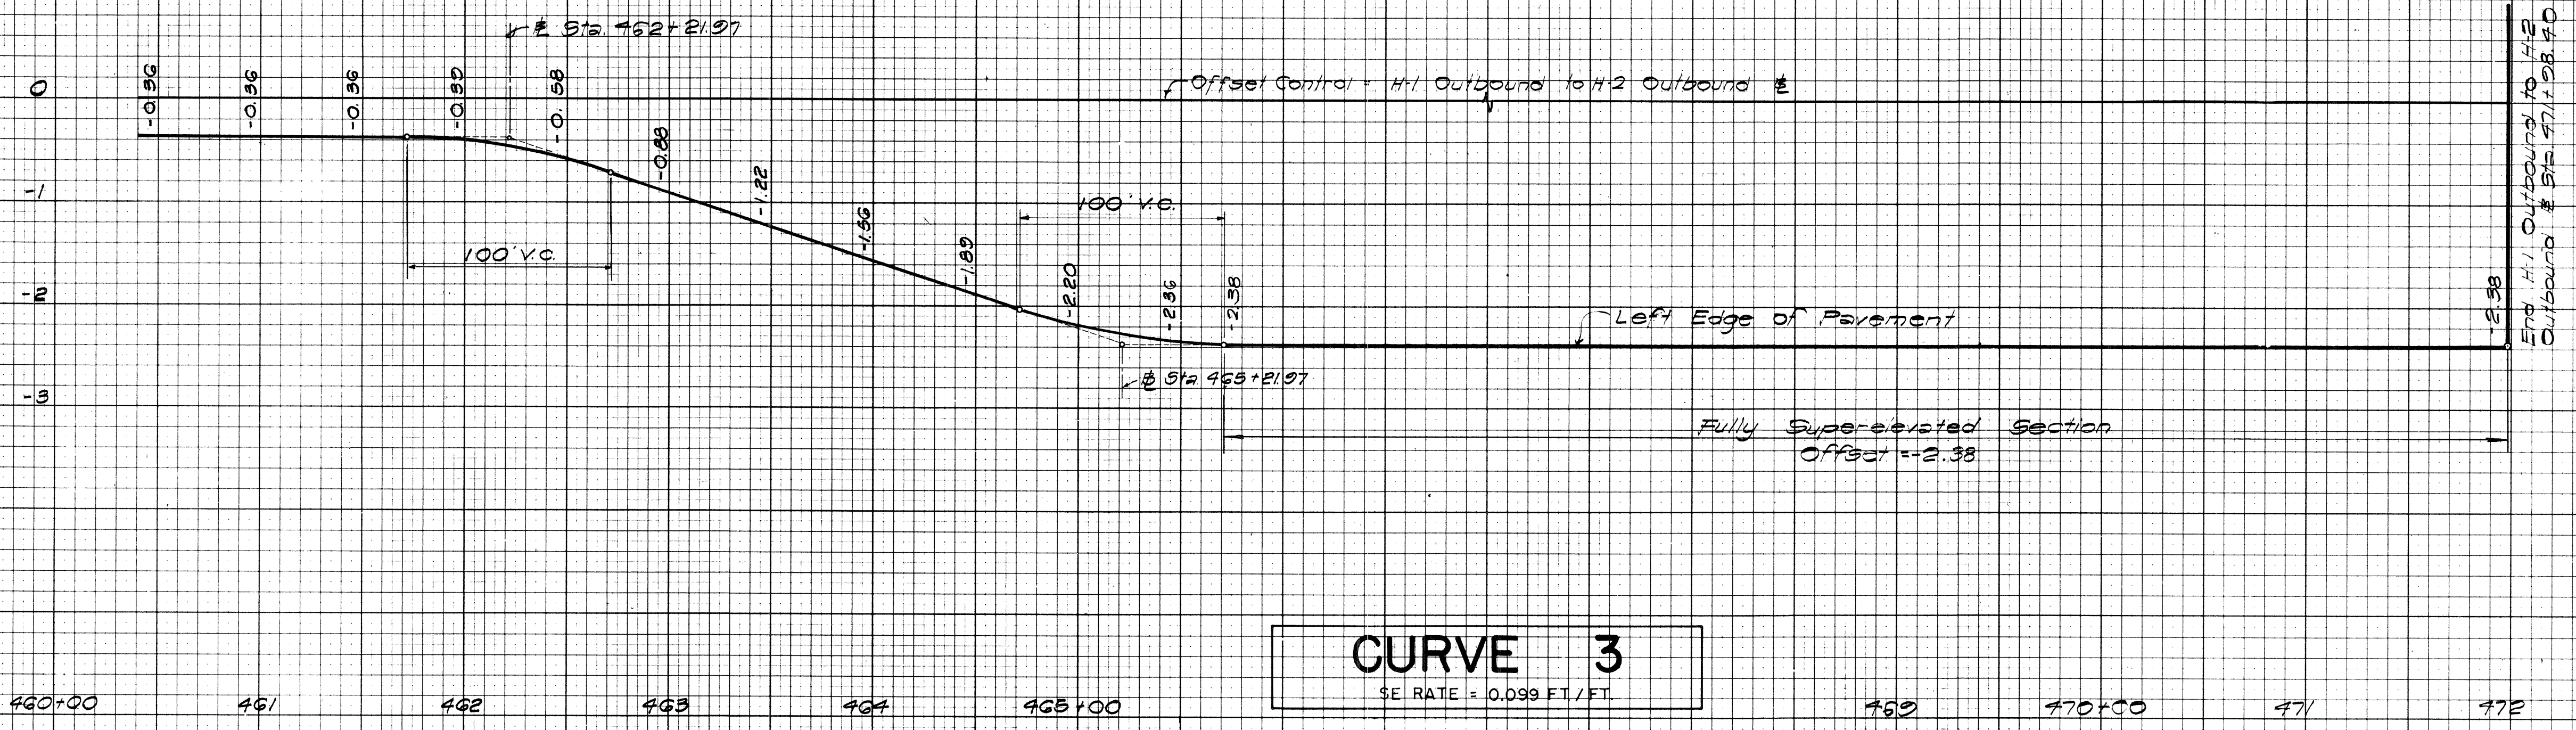

NOTE: Transition Section Graphically Developed.

Scales: Horiz 1" = 50'
Vert 1" = 1'

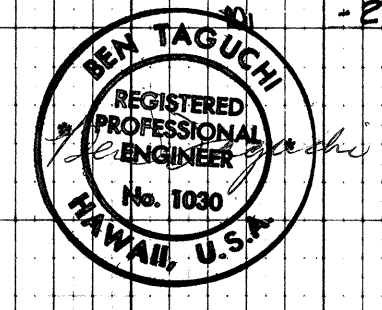

THIS WORK WAS PREPARED BY ME OR UNDER MY SUPERVISION.

STATE OF HAWAII
DEPARTMENT OF TRANSPORTATION
HIGHWAYS DIVISION

SUPERELEVATION DIAGRAMS


WAIAWA INTERCHANGE
F.A.I. Proj. No. I-H-1(75):8

Scale: As shown Date: JULY, 1969


DATE	BY
SURVEYED	PLOTTED
NOTE BOOK	TEMPERATURE
NO.	AREAS CHECKED

DATE	BY
SURVEYED	PLOTTED
NOTE BOOK	TEMPERATURE
NO.	AREAS CHECKED


FED. ROAD DIST. NO.	STATE	FED. AID PROJ. NO.	FISCAL YEAR	SHEET NO.	TOTAL SHEETS
HAWAII	HAW.	I-41-1738	1969	18	181

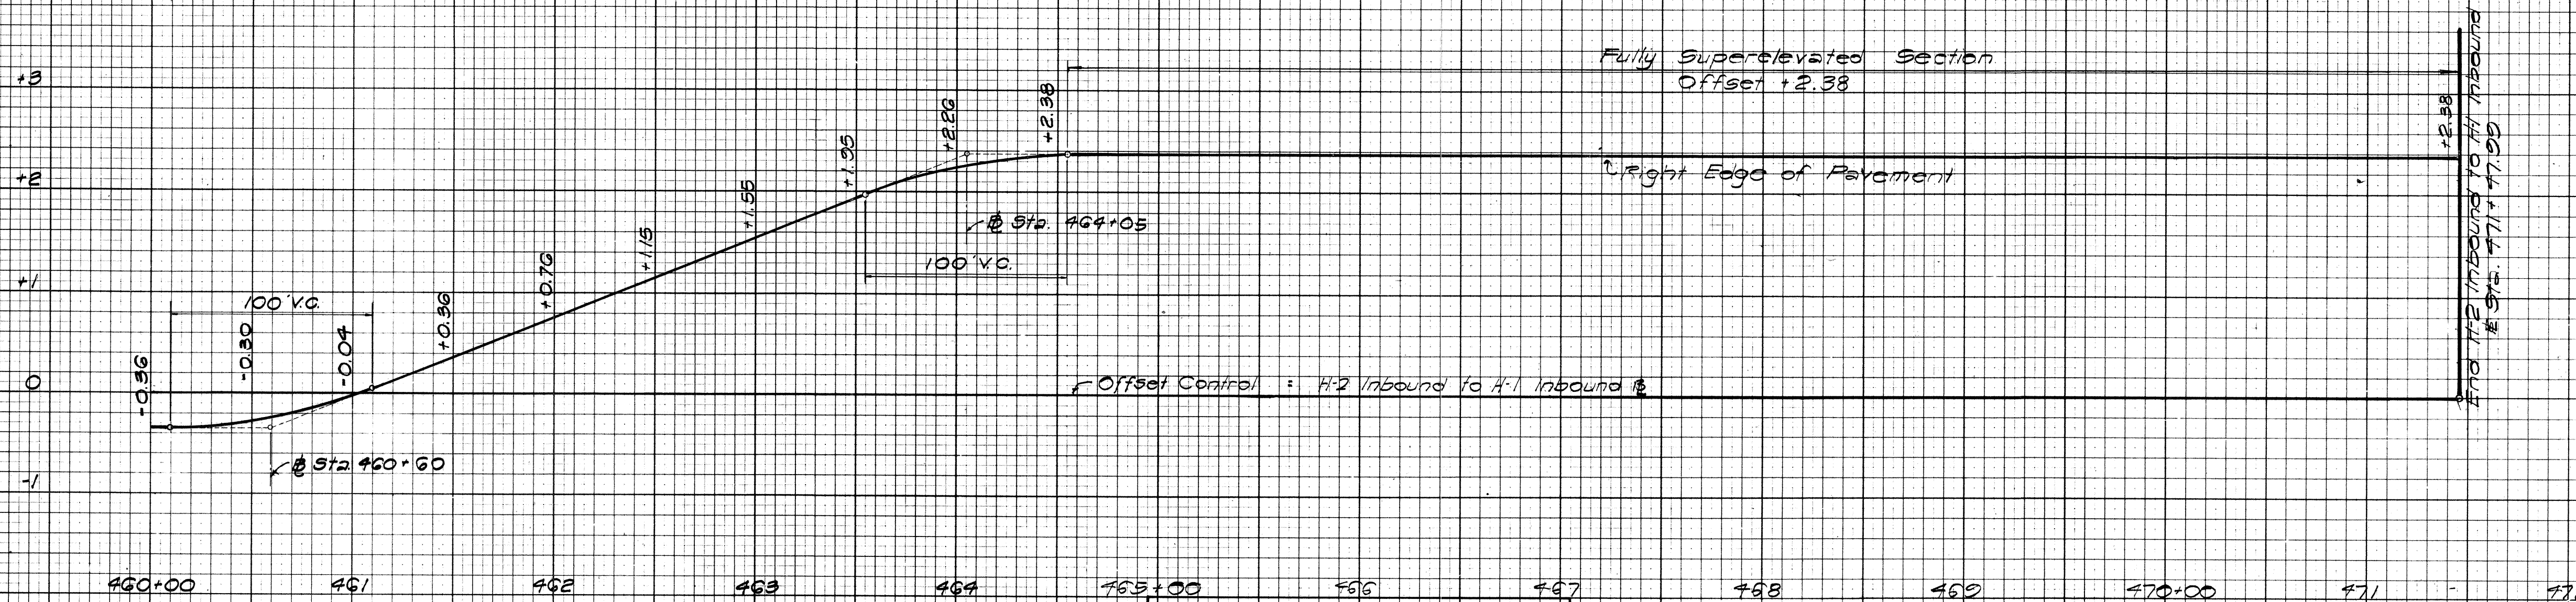

CURVE 6
SE RATE = 0.099 FT./FT.

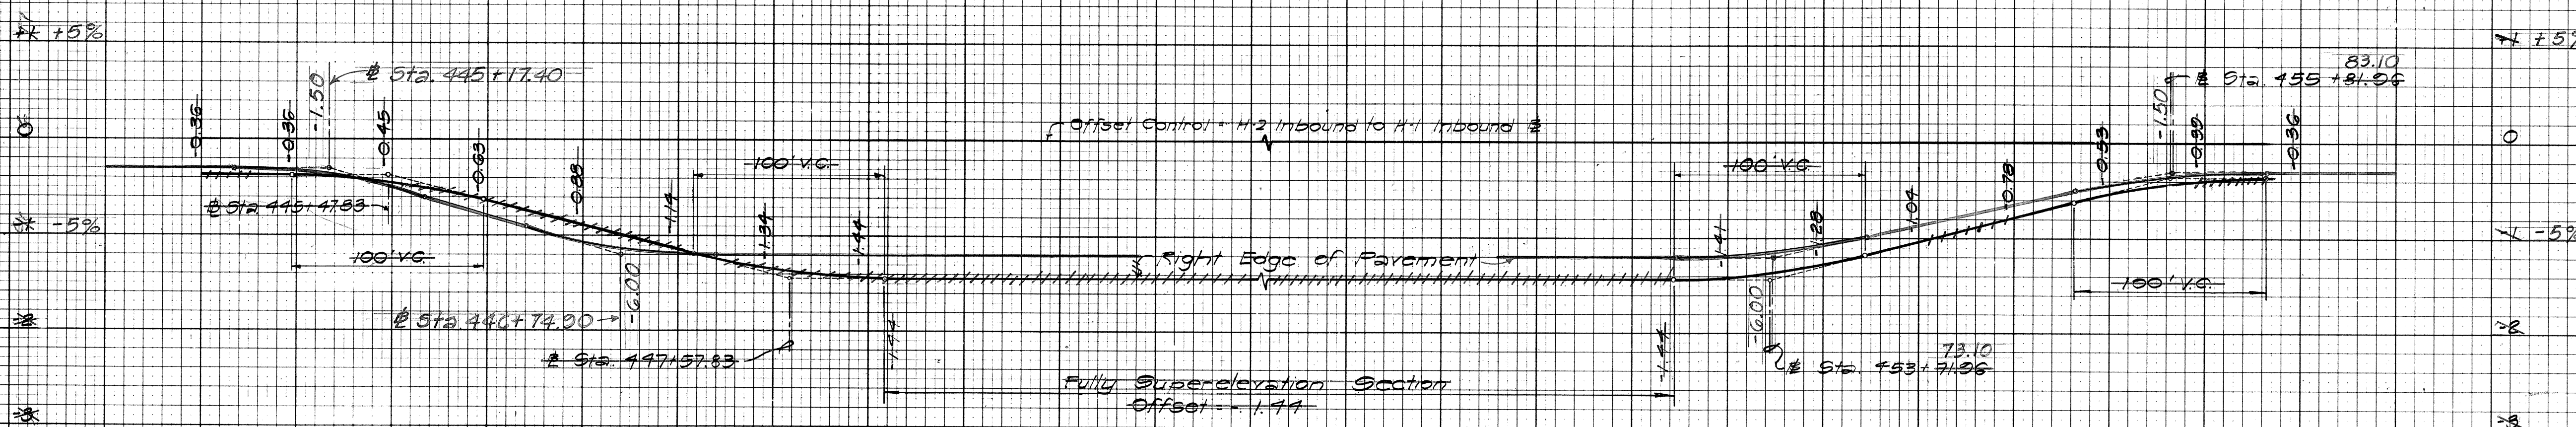


CURVE 5A
SE RATE = 0.060 FT./FT.

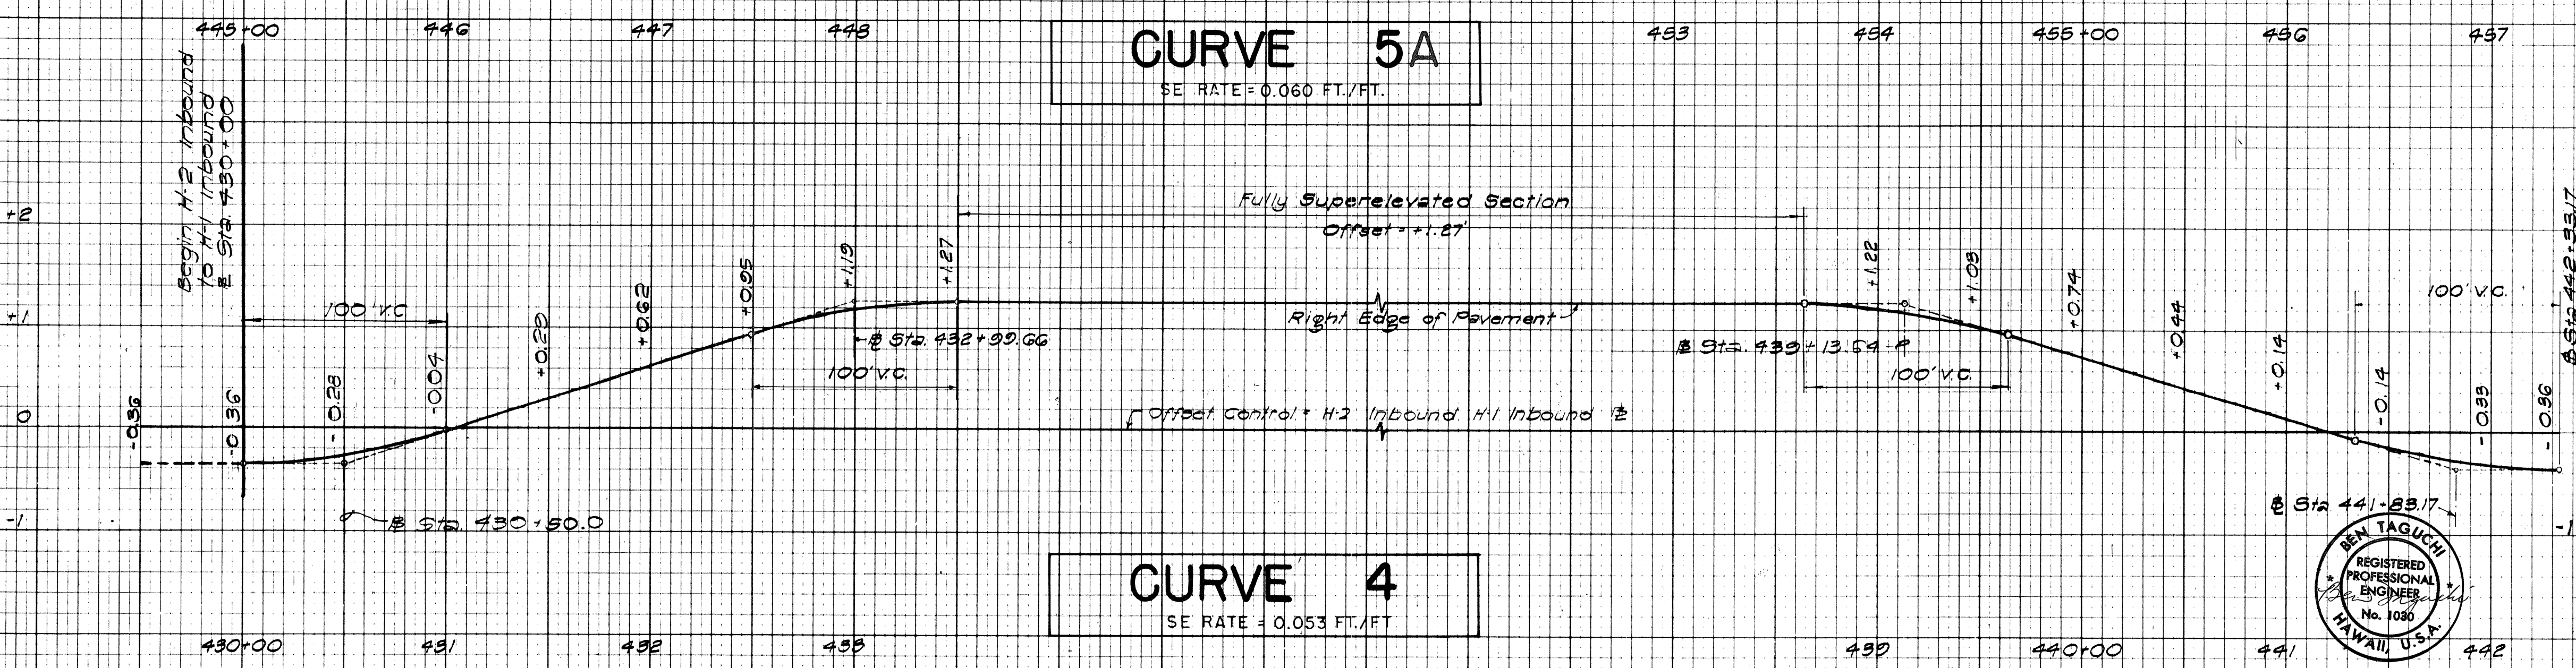

CURVE 4
SE RATE = 0.053 FT./FT.

NOTE: Transition Section Graphically Developed.

Scales: Horiz. 1" = 50'
Vert. 1" = 1'

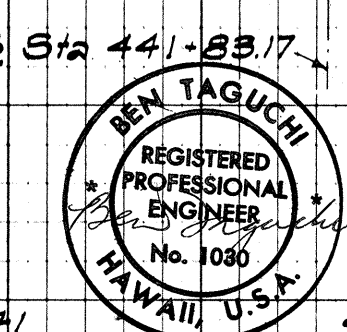

THIS WORK WAS PREPARED BY ME OR UNDER MY SUPERVISION.

STATE OF HAWAII
DEPARTMENT OF TRANSPORTATION
HIGHWAYS DIVISION

SUPERELEVATION DIAGRAMS

WAIAWA INTERCHANGE
F.A.I. Proj. No. I-HI-1(75):8

Scale: As shown Date: JUNE, 1969

FINAL SURVEY		BY	DATE
	SURVEYED		
	% LOTTED		
	TEMPLATE		
	AREAS		
	AREAS CHECKED		
NO.			

	ORIGINAL SURVEY	SURVEYED _____	BY _____	DATE _____
		PLOTTED _____		
		TEMPLATE _____		
		AREAS _____		
		AREAS CHECKED _____		
NO.				

