




FED. ROAD DIST. NO.	STATE	FED. AID PROJ. NO.	FISCAL YEAR	SHEET NO.	TOTAL SHEETS
HAWAII	HAW.	I-HI-1(77):13	1969	127	1554

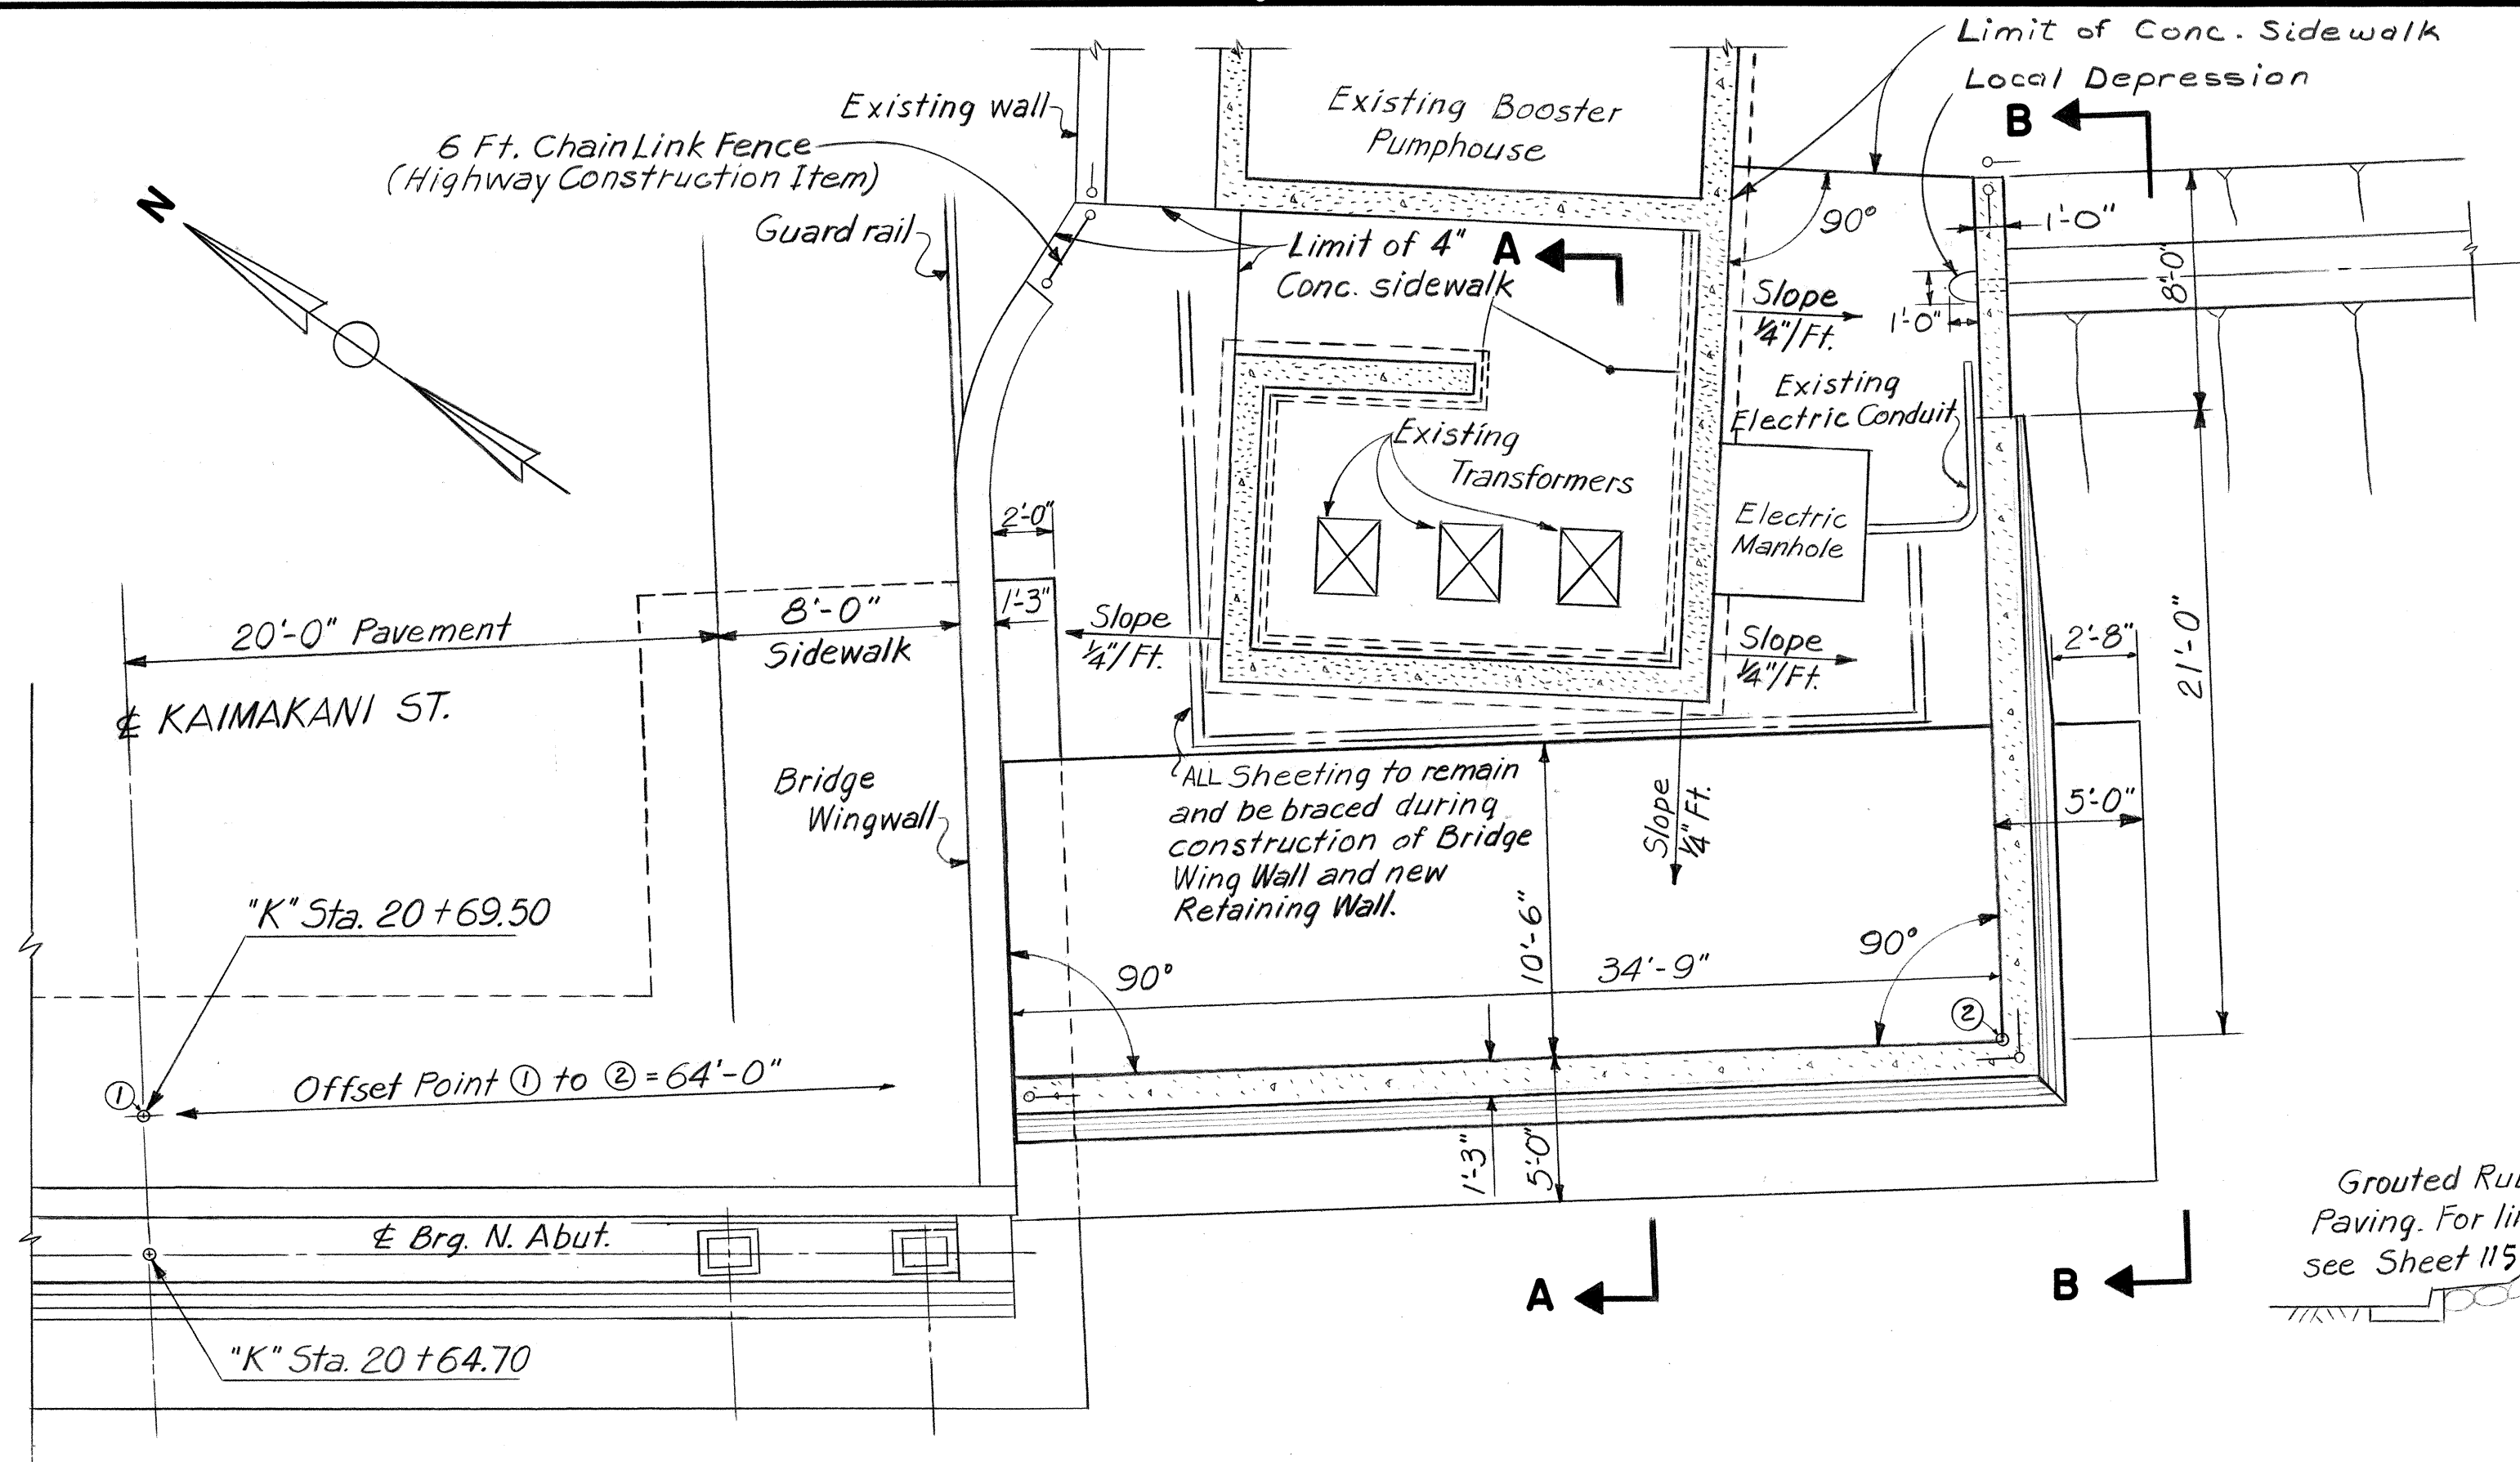

PLAN

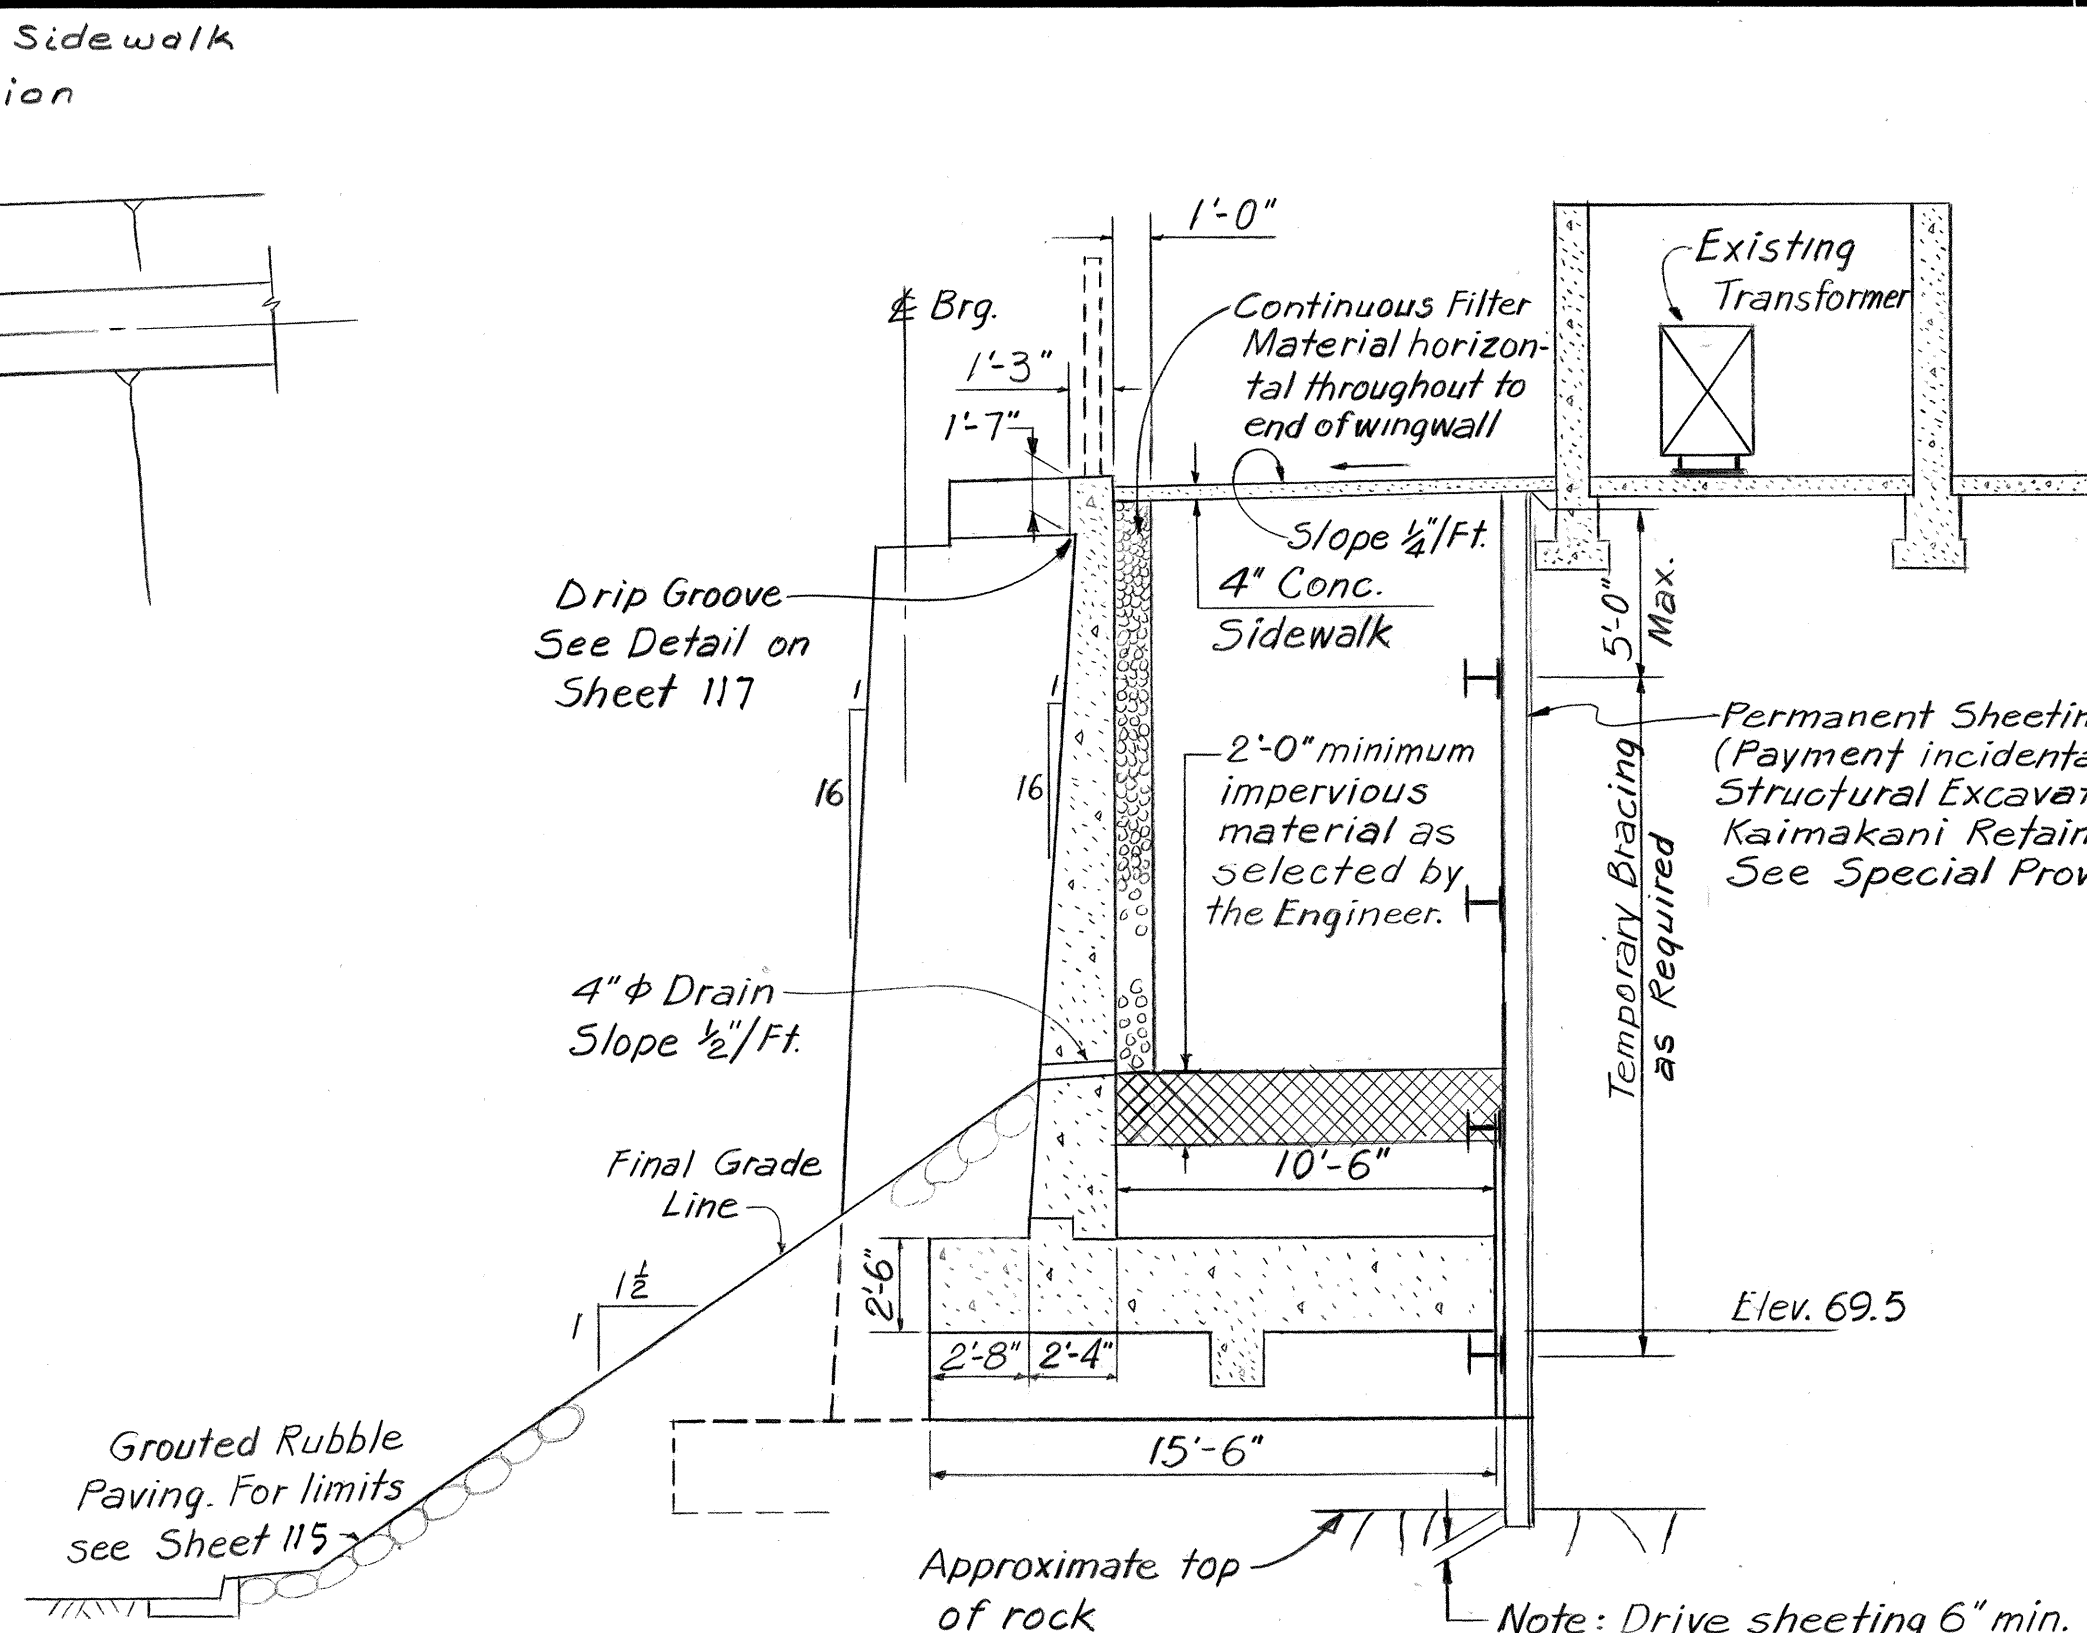


SECTION A-A

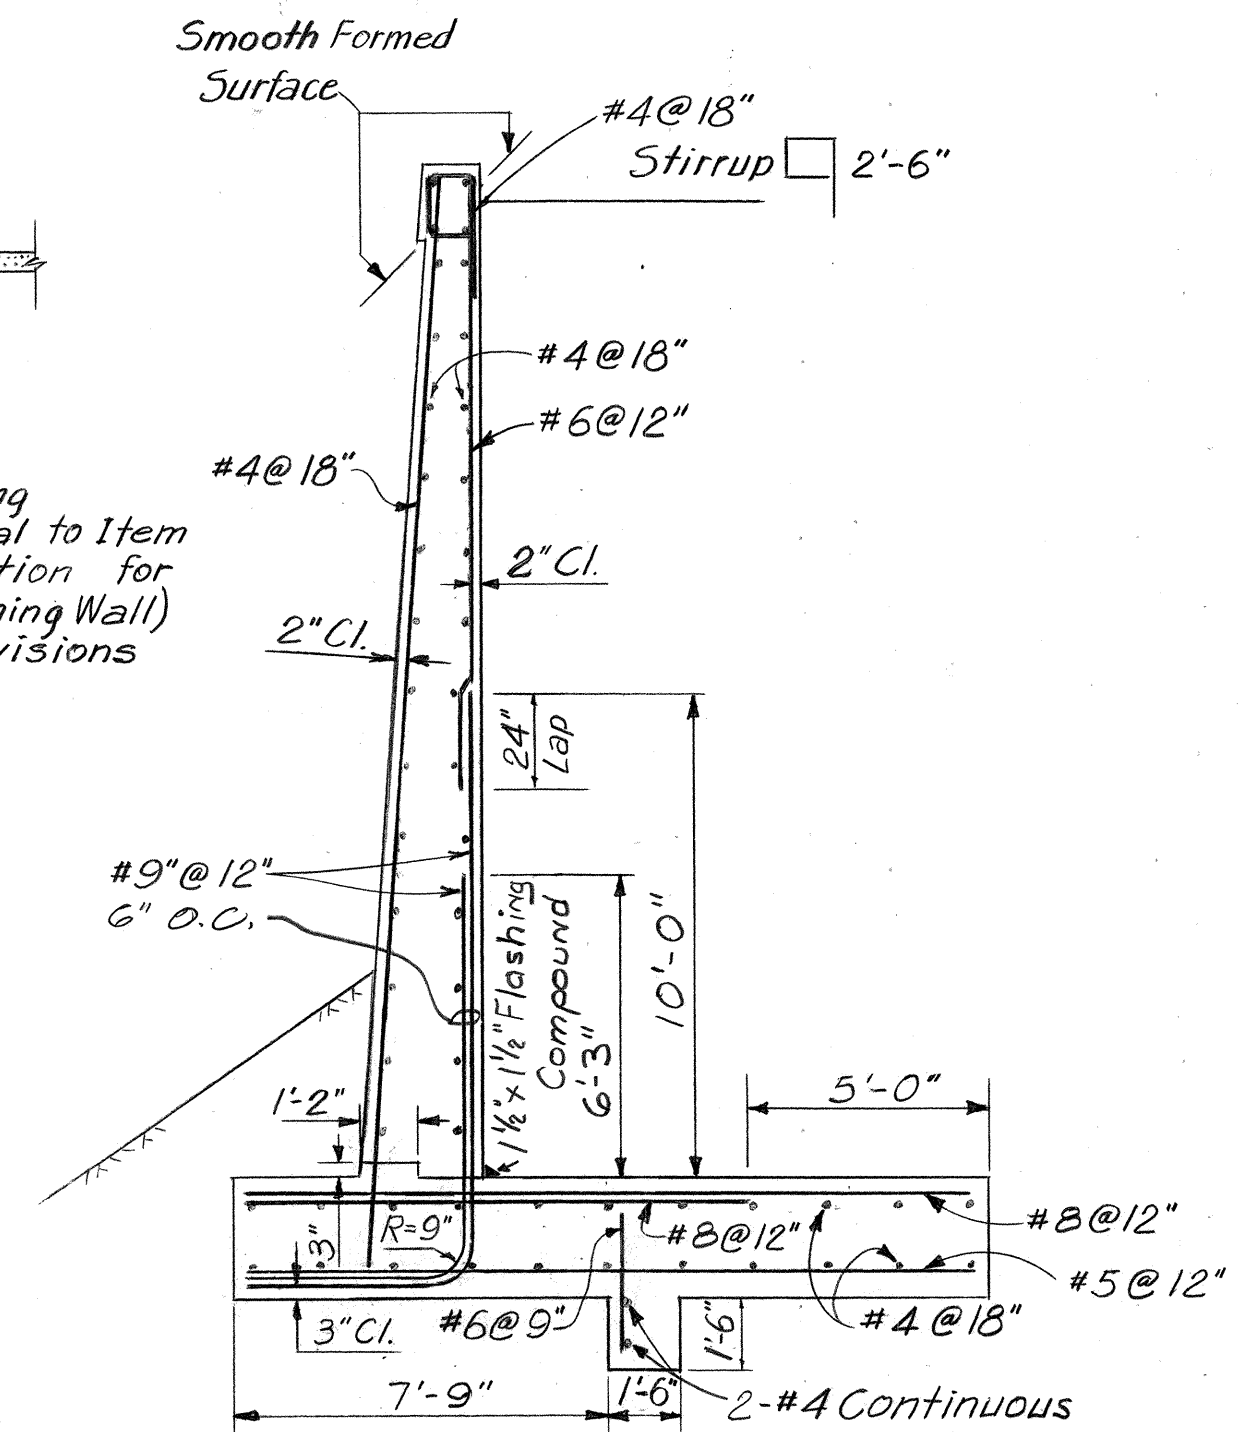


TYPICAL SECTION

Scale: 1/4"=1'-0"

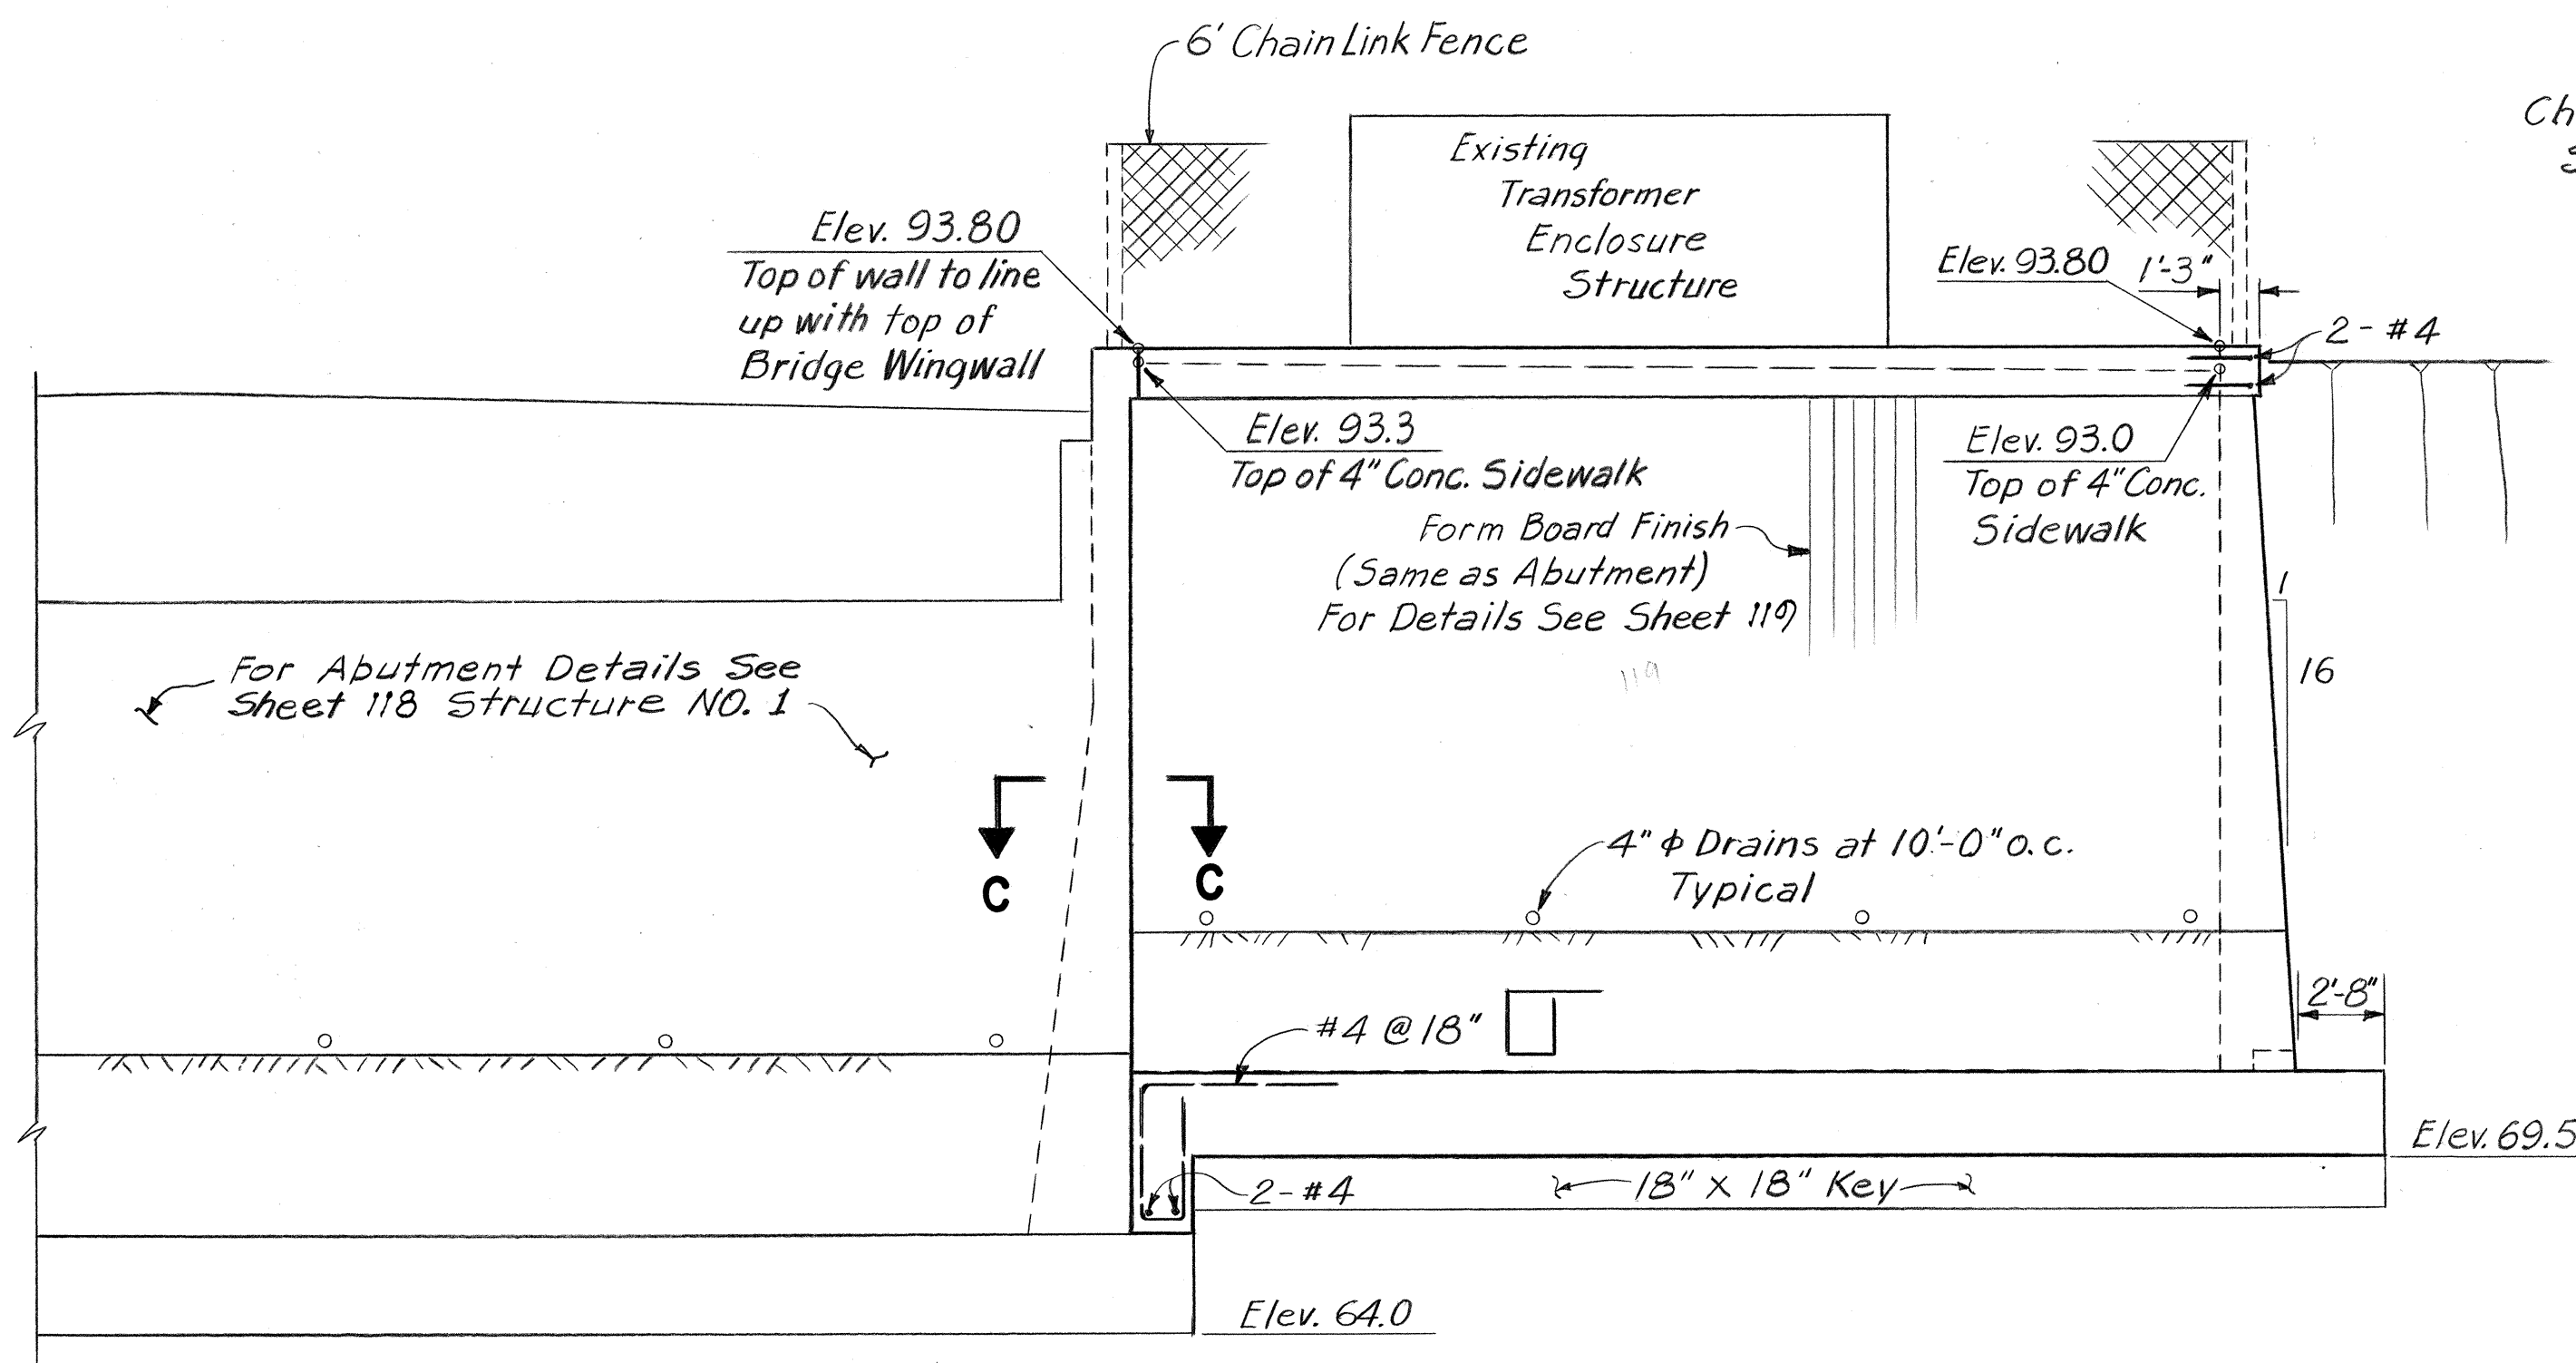


ELEVATION

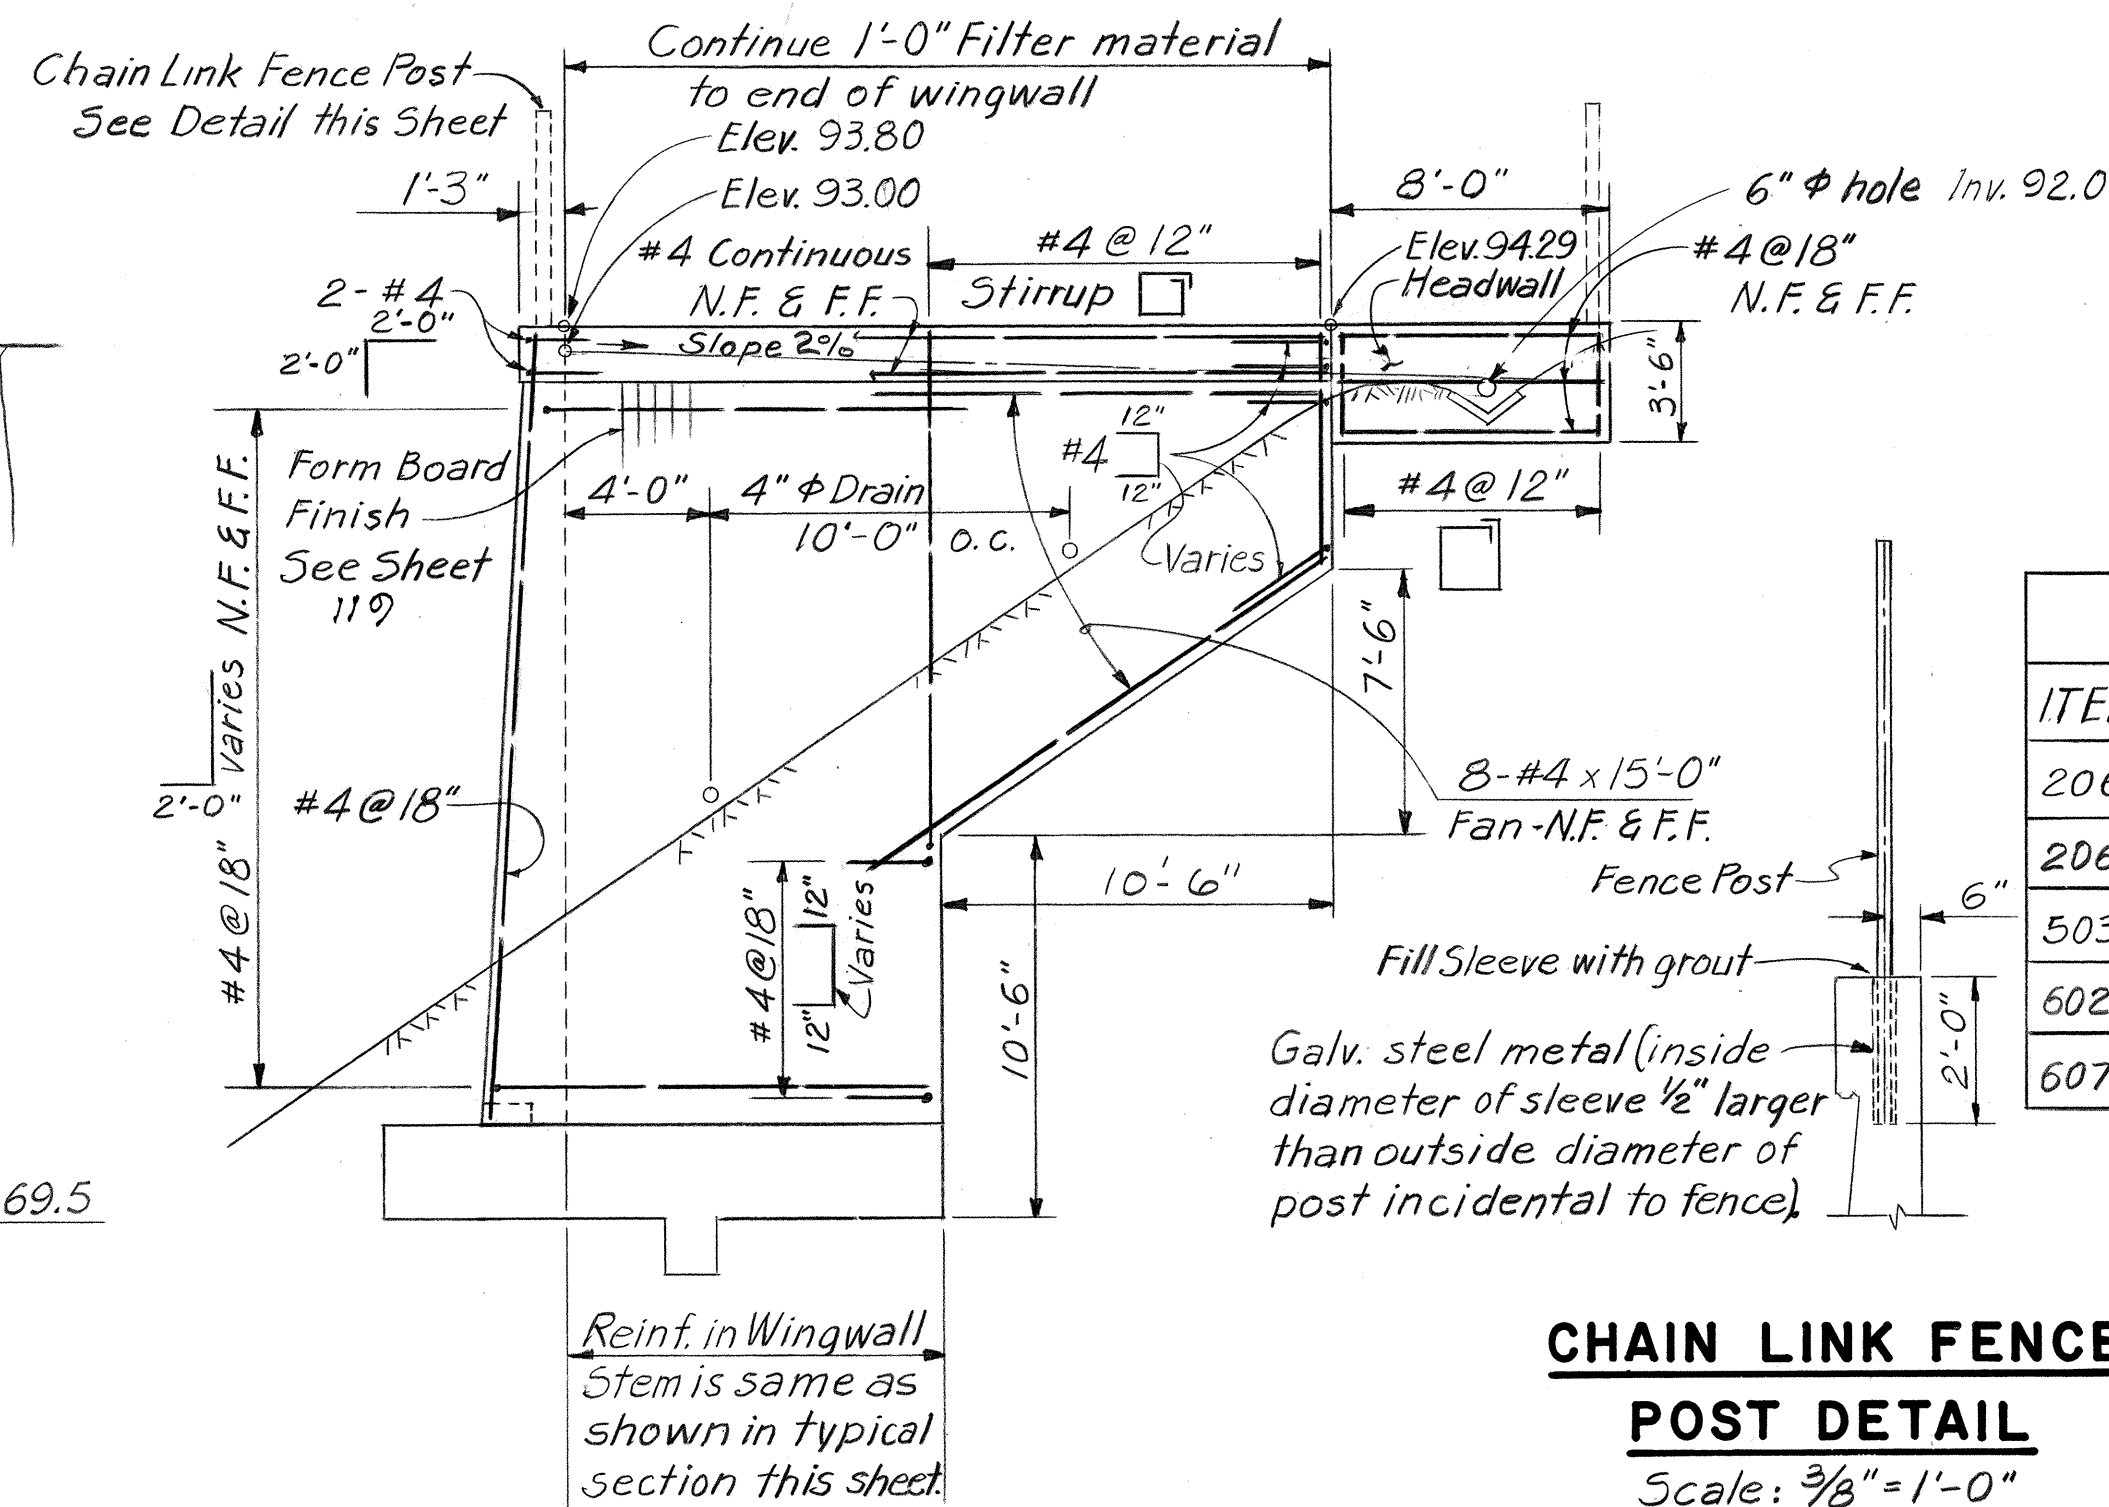

SECTION B-B

CHAIN LINK FENCE POST DETAIL

Scale: 3/8"=1'-0"

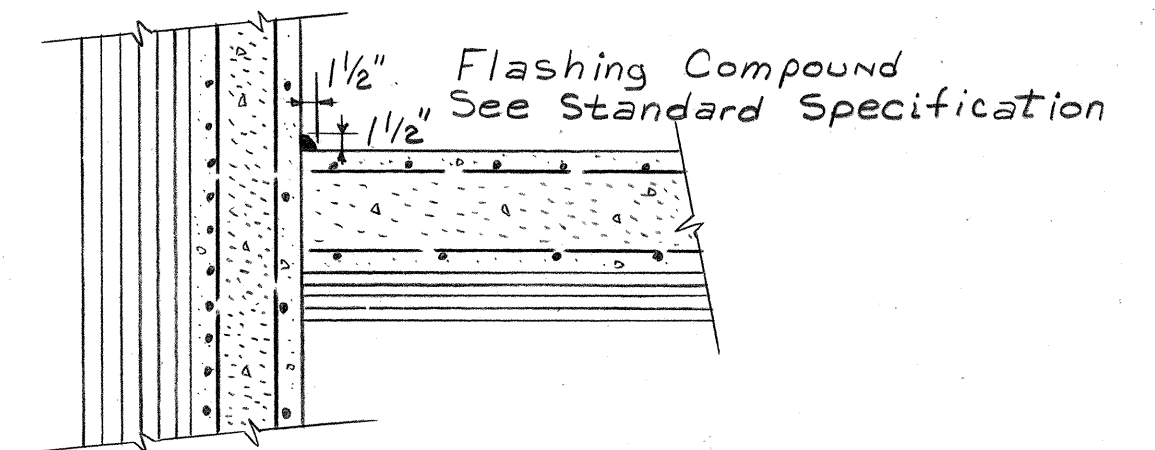

SECTION C-C

Scale: 3/8"=1'-0"


ESTIMATED QUANTITIES

ITEM NO.	ITEM	UNIT	QUANTITY
206.42	STRUCT. EXC. FOR KAIMAKANI RETAINING WALL	C.Y.	232
206.82	FILTER MATERIAL FOR RETAINING WALLS	C.Y.	30
503.050	CONCRETE IN RETAINING WALLS	L.S.	130 C.Y.
602.050	REINFORCING STEEL IN RETAINING WALLS	L.S.	12,300 LBS.
607.030	6 FT. CHAIN LINK FENCE ON CONCRETE STRUCT.	L.F.	65

ORIGINAL PLAN	DATE	11-21-69
DESIGNED BY	BY	11-21-69
CHECKED BY	BY	11-21-69
NOTED BY	BY	11-21-69
NO.		

THIS WORK WAS PREPARED BY ME OR UNDER MY SUPERVISION.

Martin Rubin

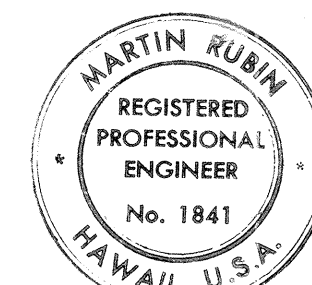

STATE OF HAWAII
DEPARTMENT OF TRANSPORTATION
HIGHWAYS DIVISION

NAVY BOOSTER PUMP
STATION WALL

HALAWA INTERCHANGE
PROJECT NO. I-HI-1(77):13

SCALE: 3/16"=1'-0"
Unless Noted

DATE: NOV. 28, 1969

SHEET No. 1W OF 1W SHEETS