


ORIGINAL PLAN	SURVEY PLOTTED BY _____ DATE _____	
	DRAWN BY _____	" " _____
NOTE BOOK	TRACED BY <u>P. HART</u>	
	DESIGNED BY <u>H. D. HESS</u>	
No. _____	QUANTITIES BY _____	
	CHECKED BY <u>M. BEAUGER</u>	

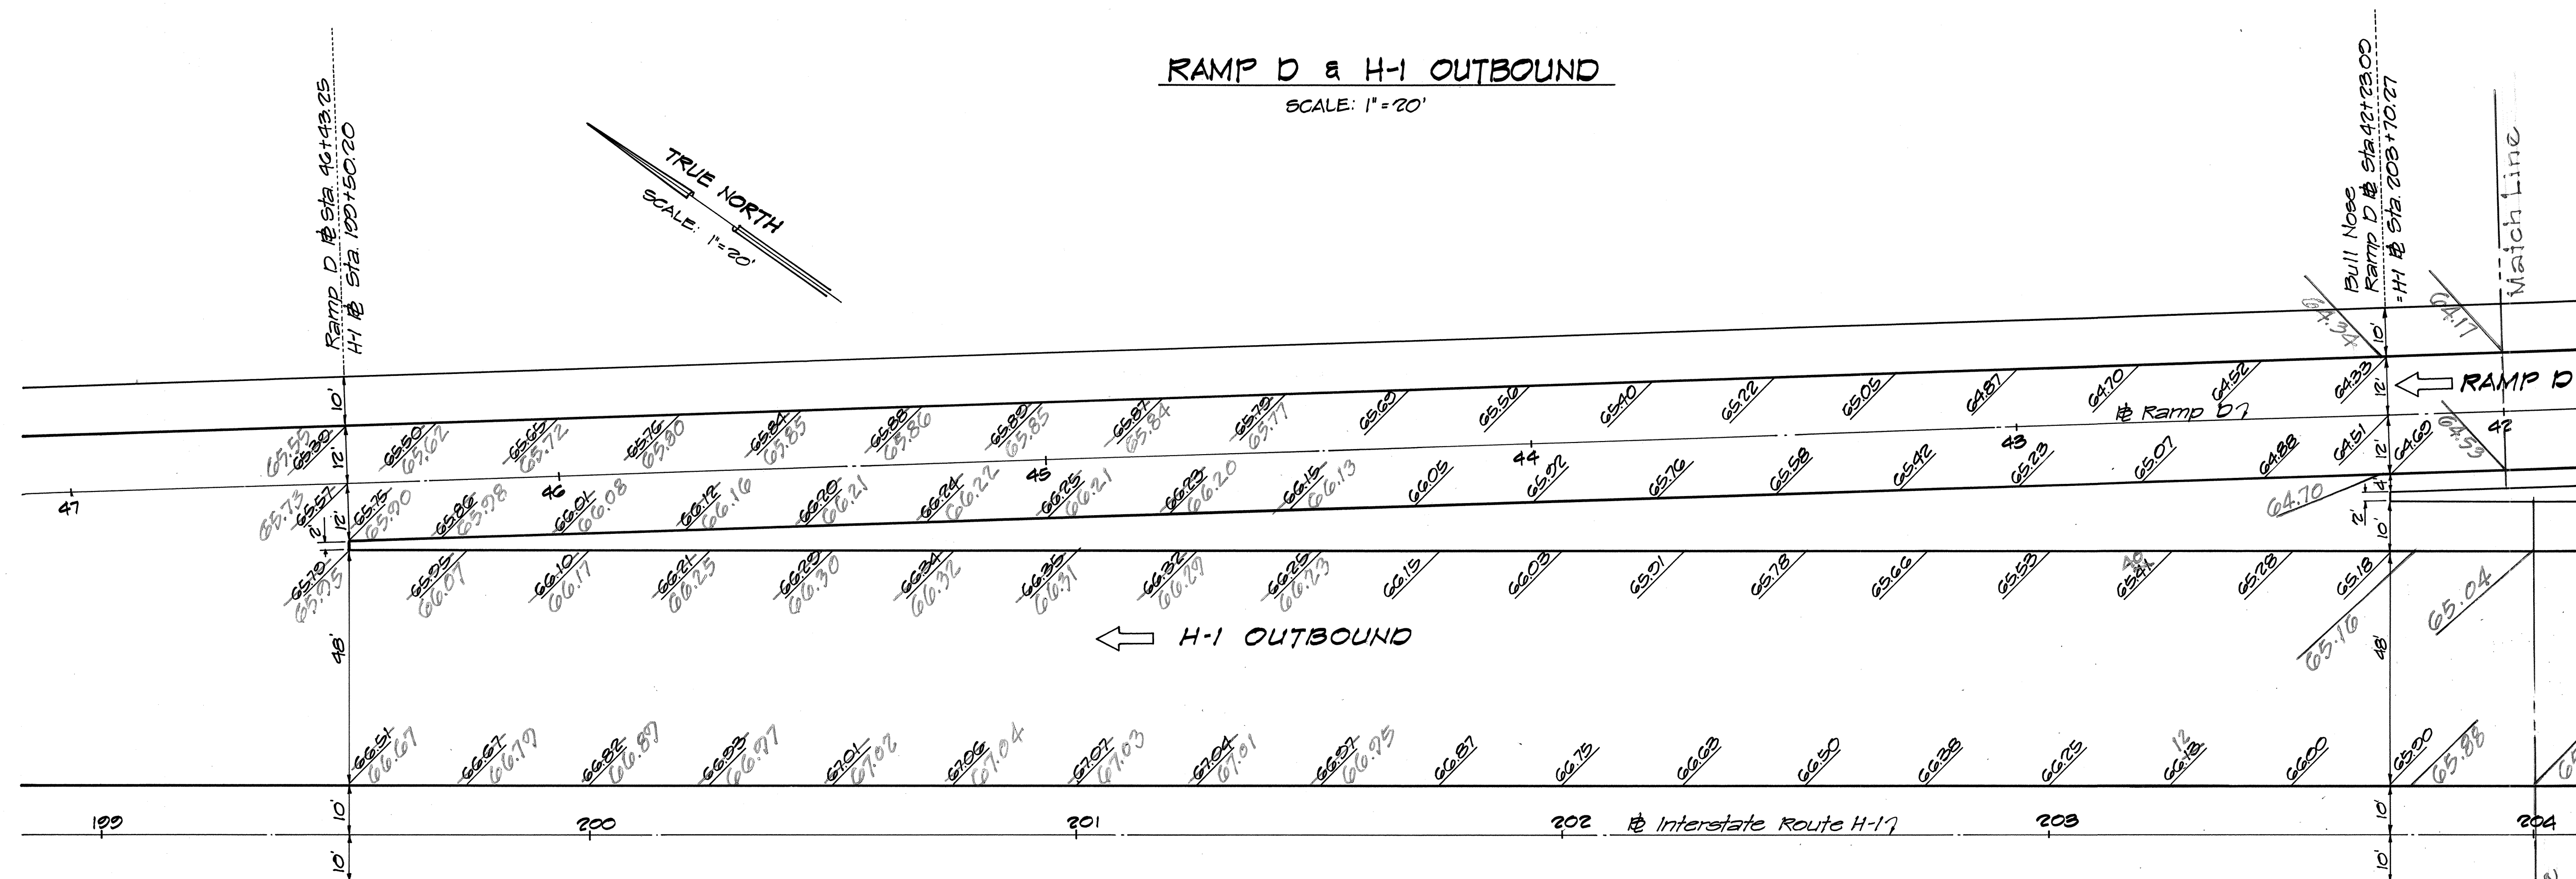

STATE OF HAWAII
DEPARTMENT OF TRANSPORTATION
HIGHWAYS DIVISION


RAMP TERMINAL DETAILS
RAMP D

HALAWA INTERCHANGE
PROJECT NO. I-41-1 (77):13



SCALE: 1"=20' DATE: Nov. 28, 1969

SHEET No. 1 OF 2 SHEETS

FED. ROAD DIST. NO.	STATE	FED. AID PROJ. NO.	FISCAL YEAR	SHEET NO.	TOTAL SHEETS
HAWAII	HAW.	I-HI-1(77):13	1969	11	15

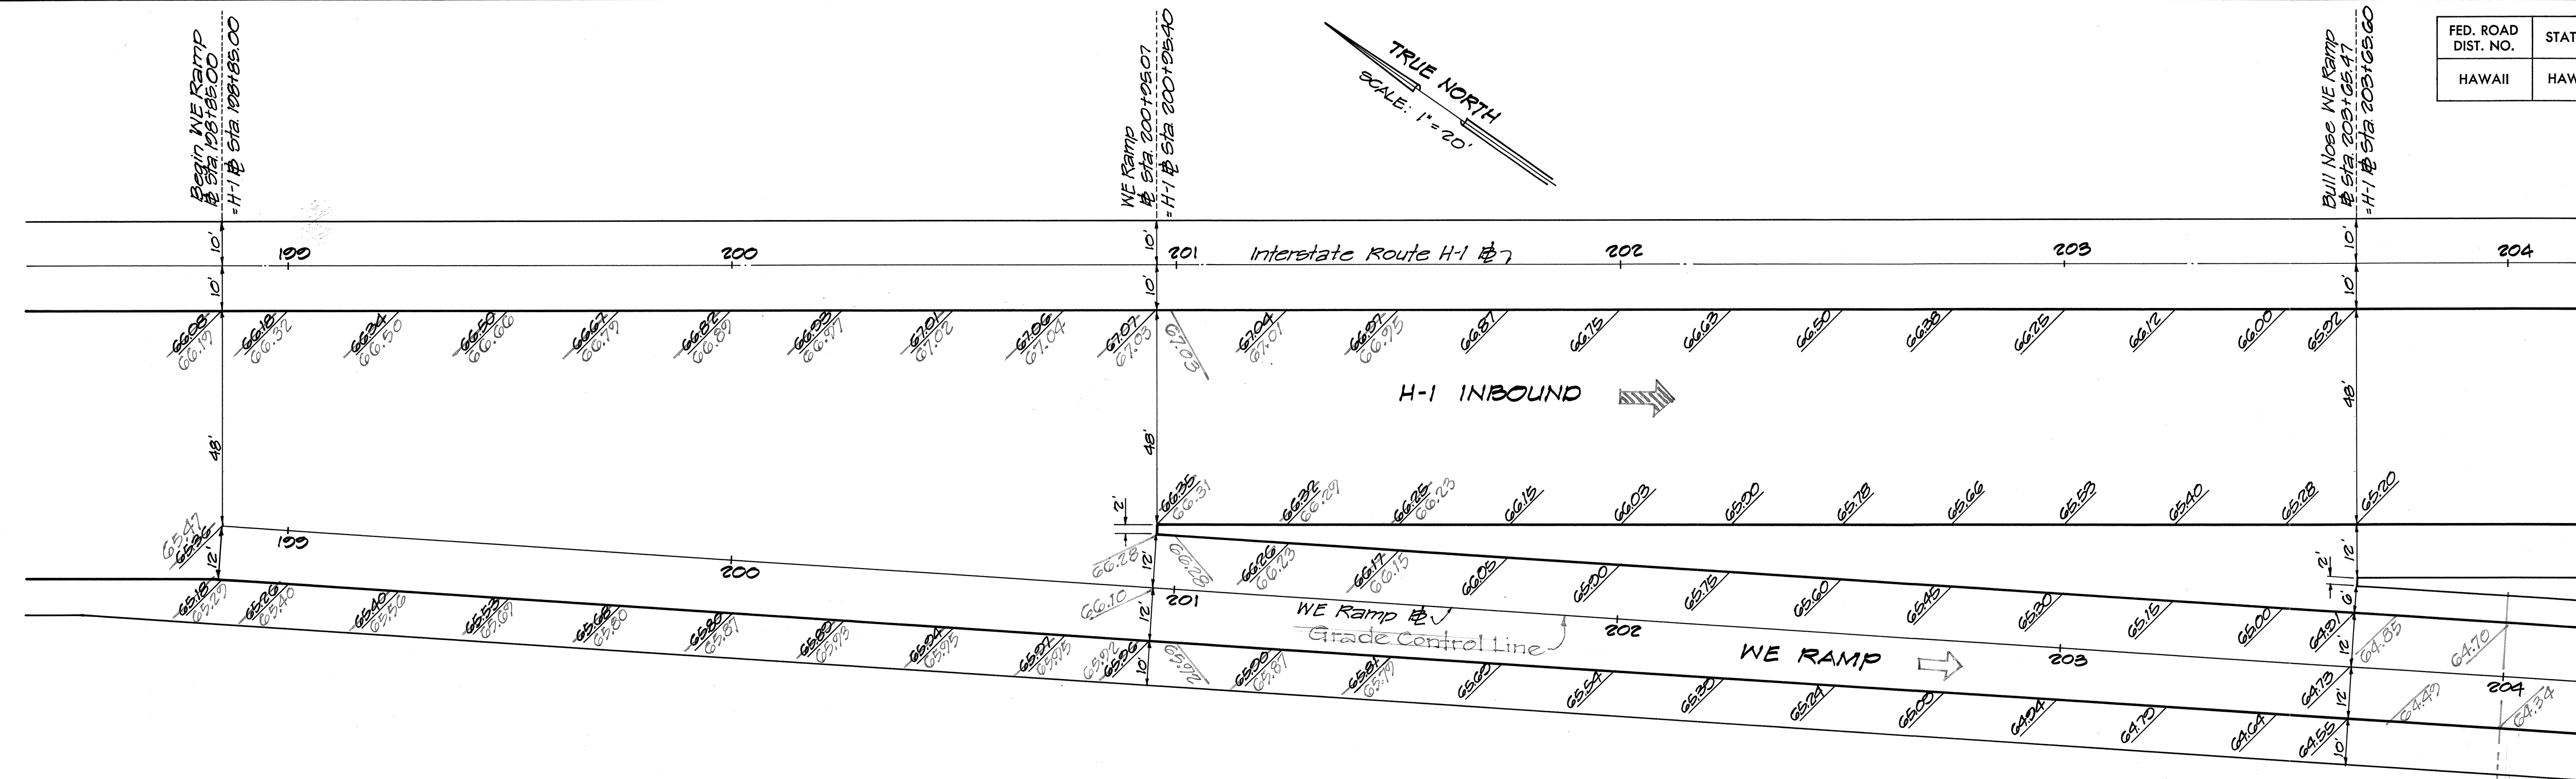


WE RAMP & H-1 INBOUND INTERSECTION
SCALE: 1"=20'

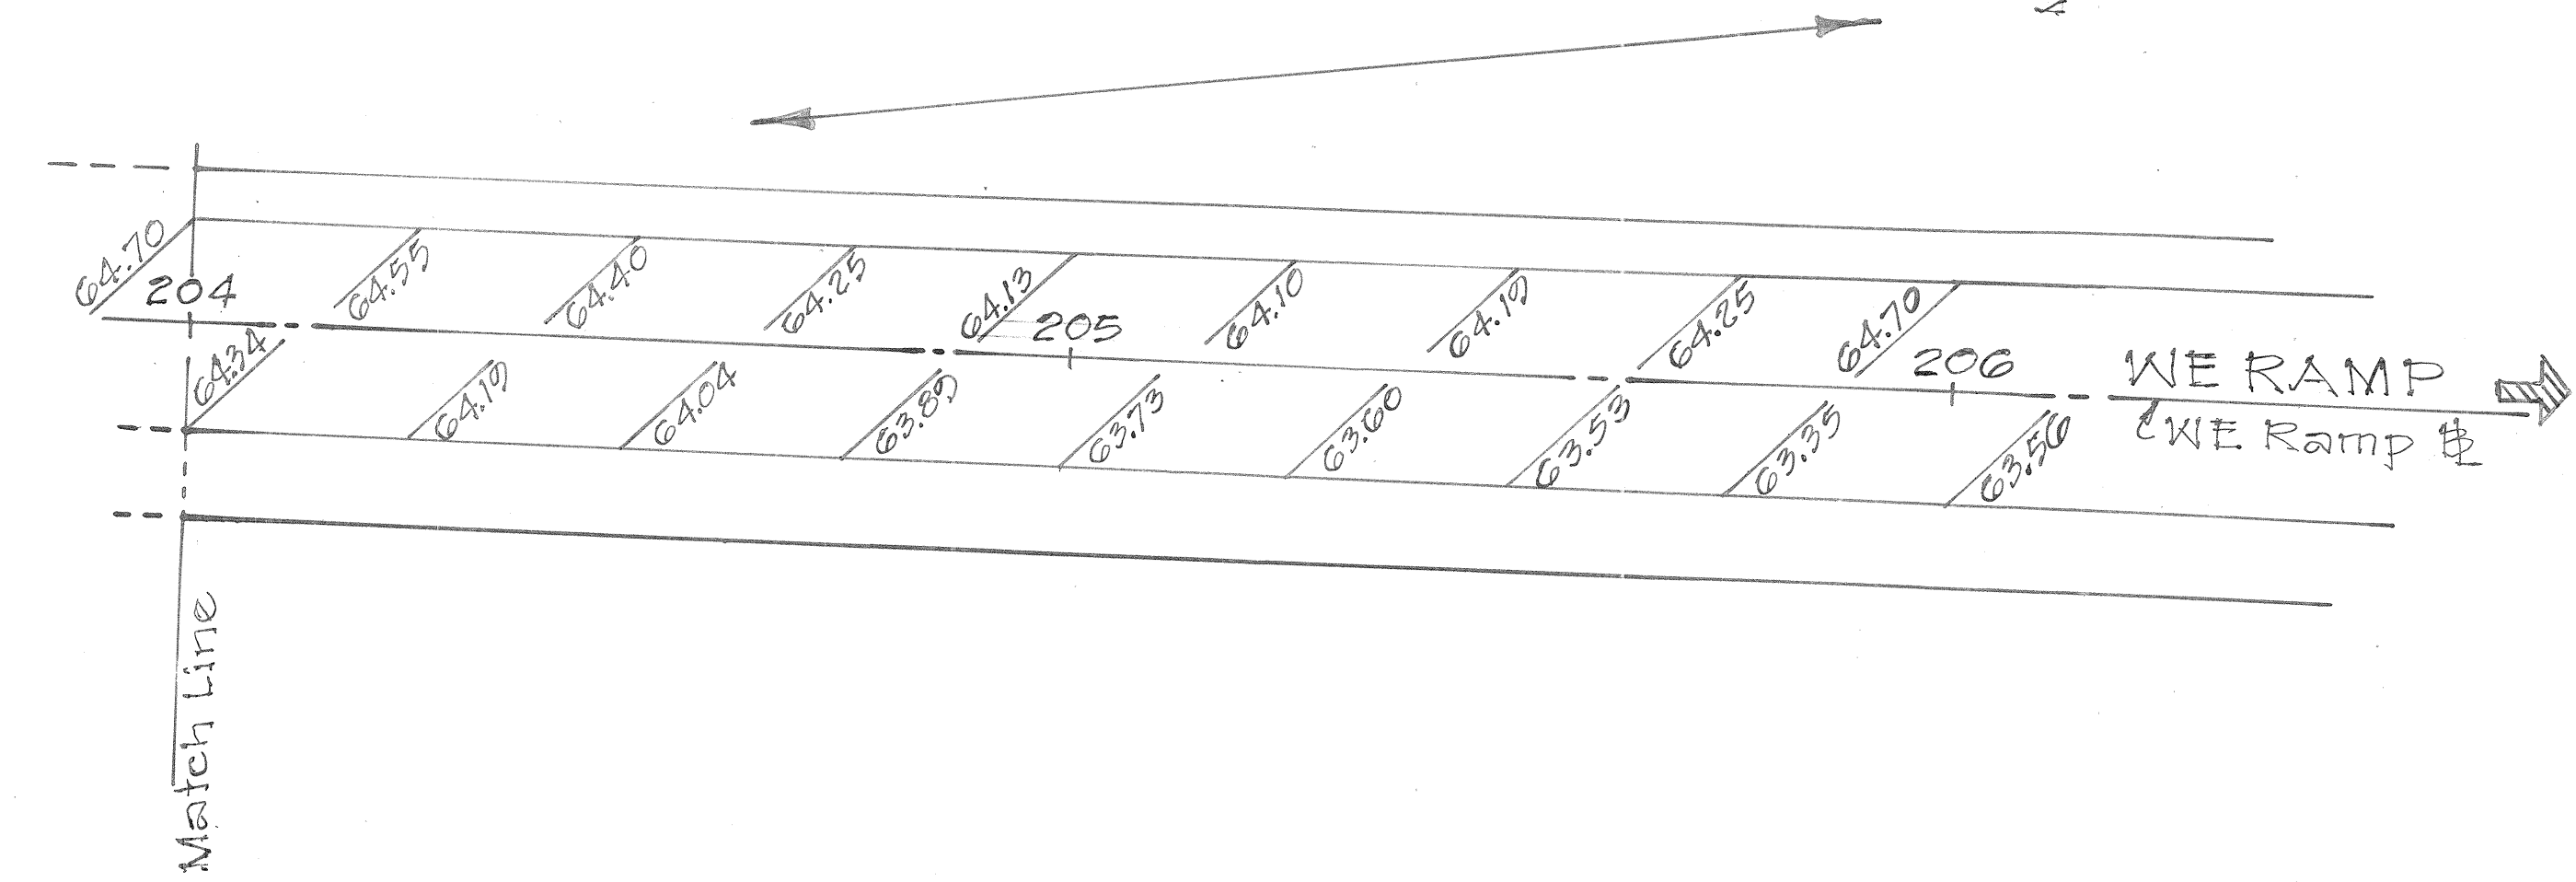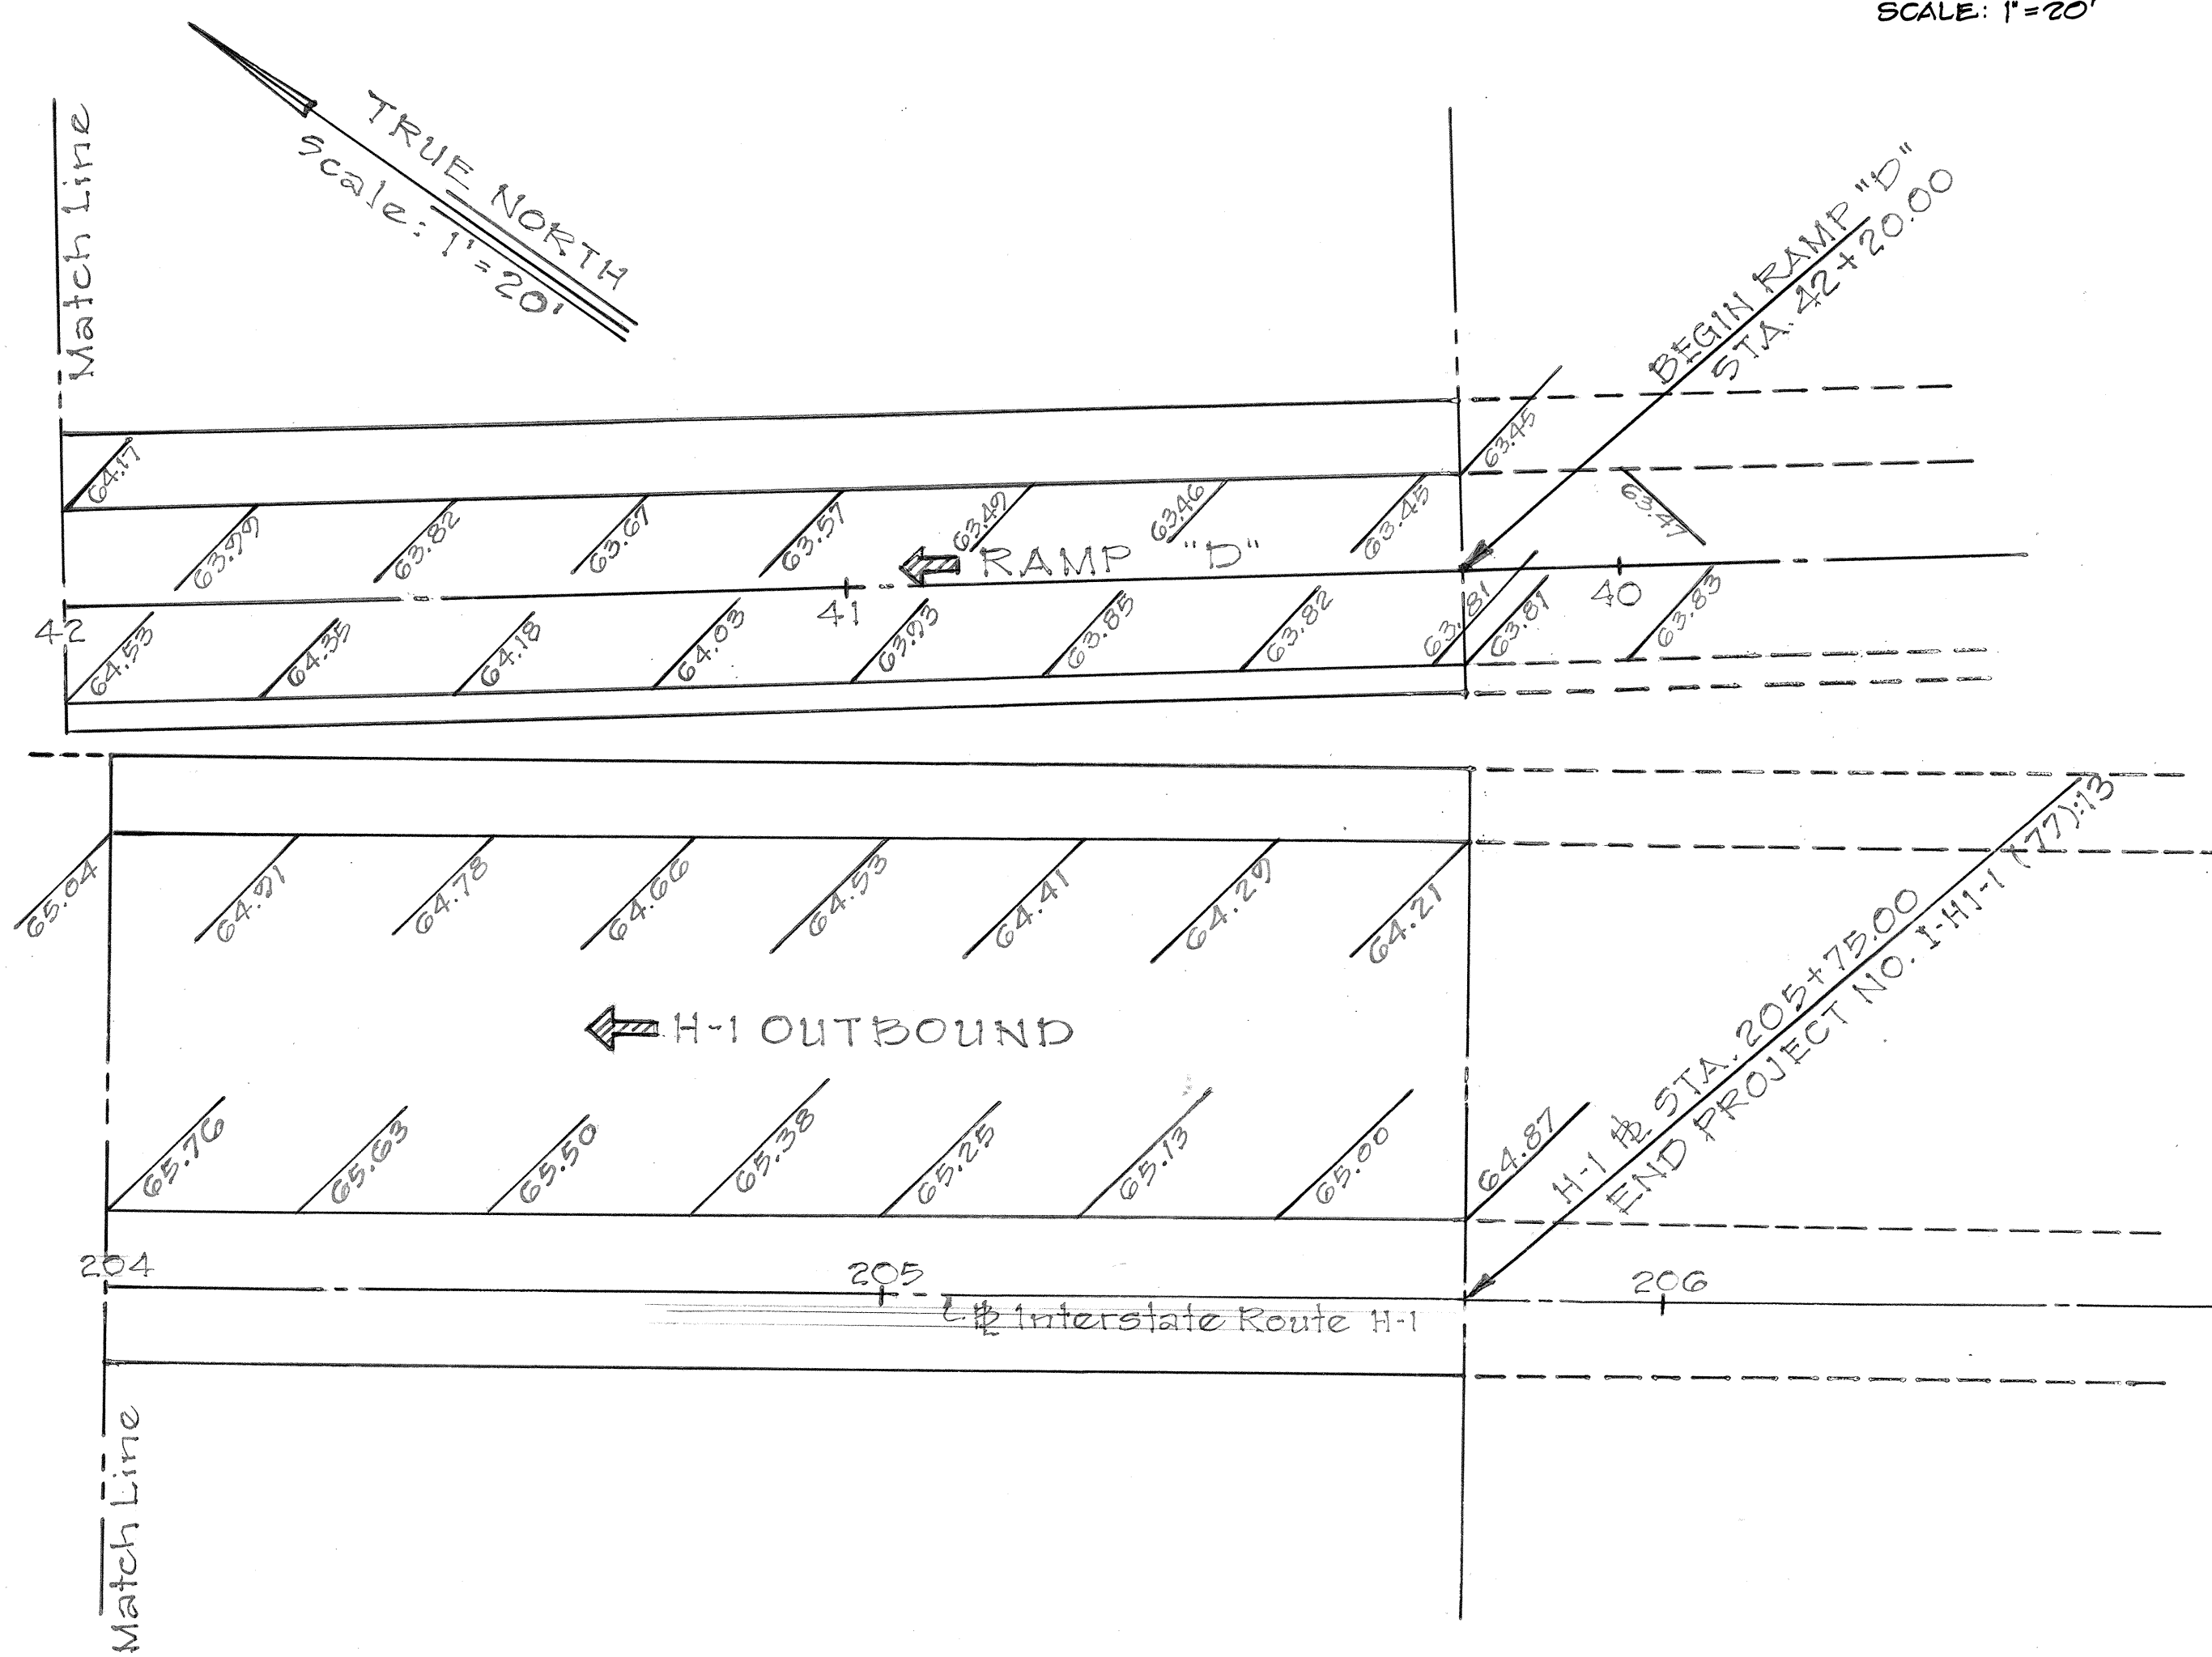

NOTE: See Plan Sheet No. 10, For Continuation.

ORIGINAL PLAN	DATE
DRAWN BY	
TRACED BY	
QUANTITIES BY	
CHECKED BY	
NO.	

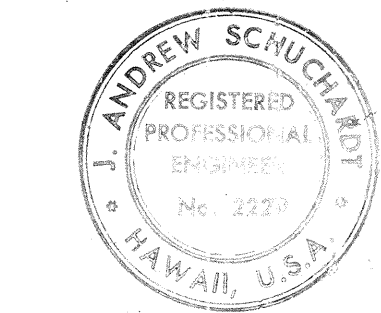

THIS WORK WAS PREPARED BY ME OR UNDER MY SUPERVISION.

STATE OF HAWAII
DEPARTMENT OF TRANSPORTATION
HIGHWAYS DIVISION

RAMP TERMINAL DETAILS
WE RAMP

HALAWA INTERCHANGE
PROJECT NO. I-HI-1(77):13

SCALE: 1"=20' DATE: Nov. 28, 1969

SHEET No. 2 OF 2 SHEETS