

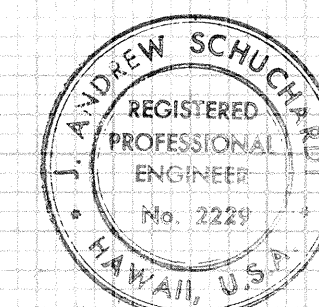
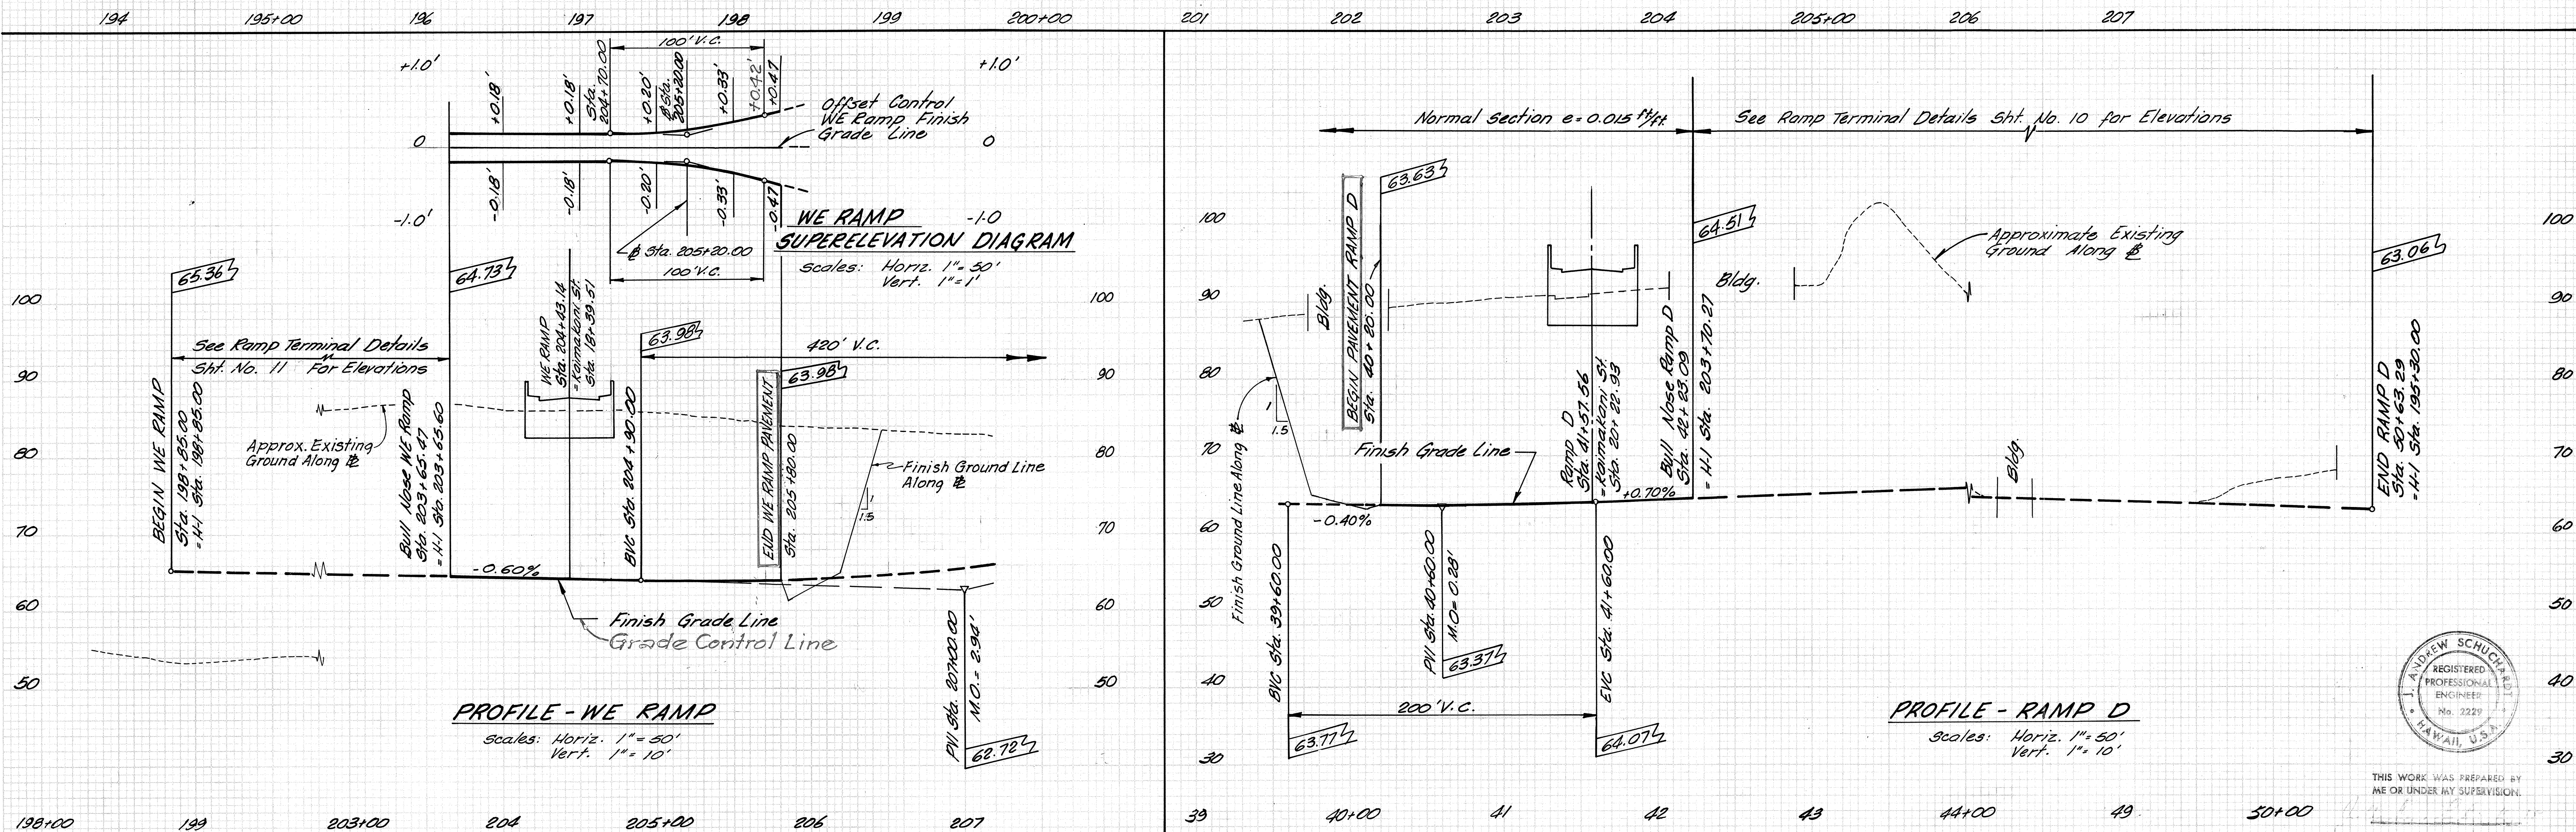
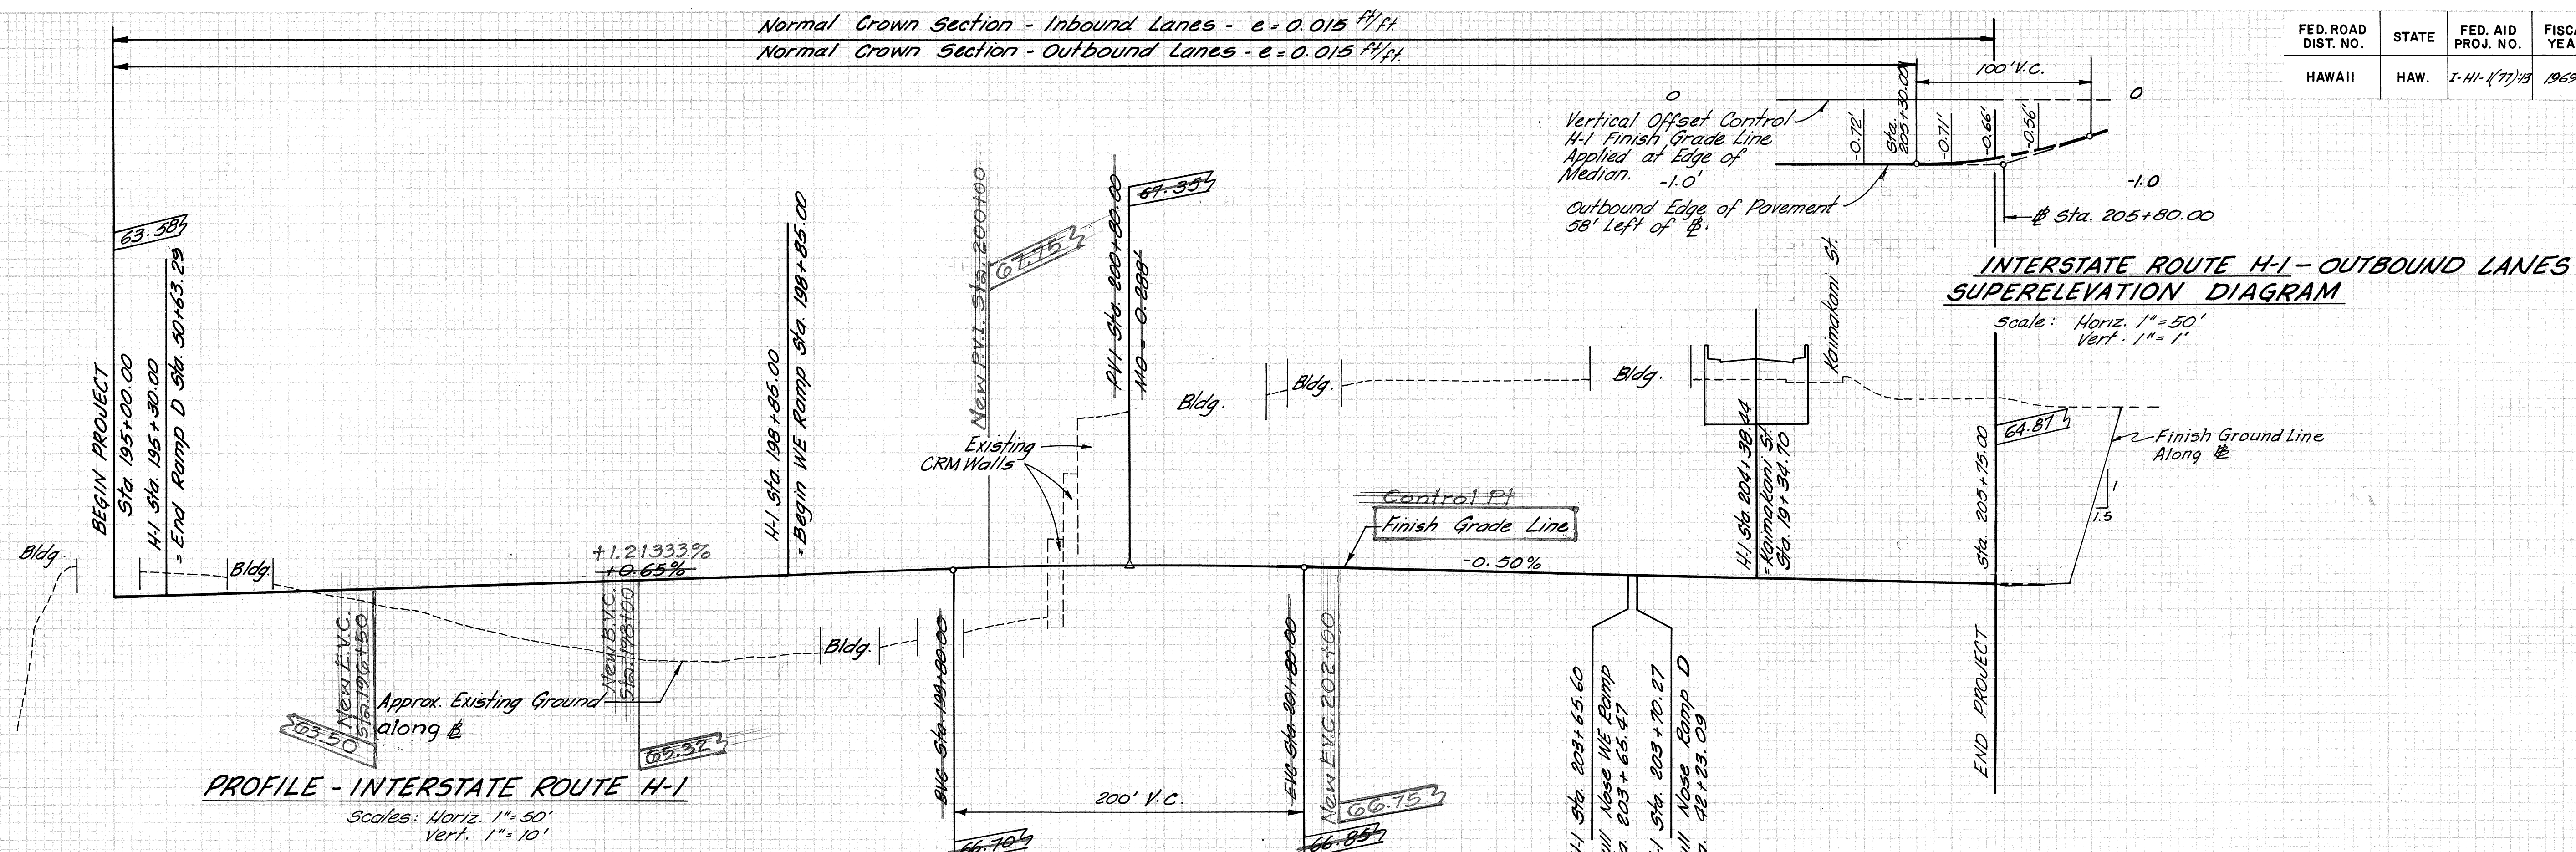
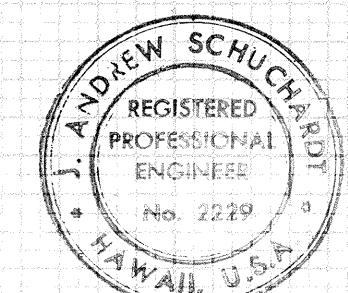


FED. ROAD DIST. NO.	STATE	FED. AID PROJ. NO.	FISCAL YEAR	SHEET NO.	TOTAL SHEETS
HAWAII	HAW.	I-HI-1(77)13	1963	8	15

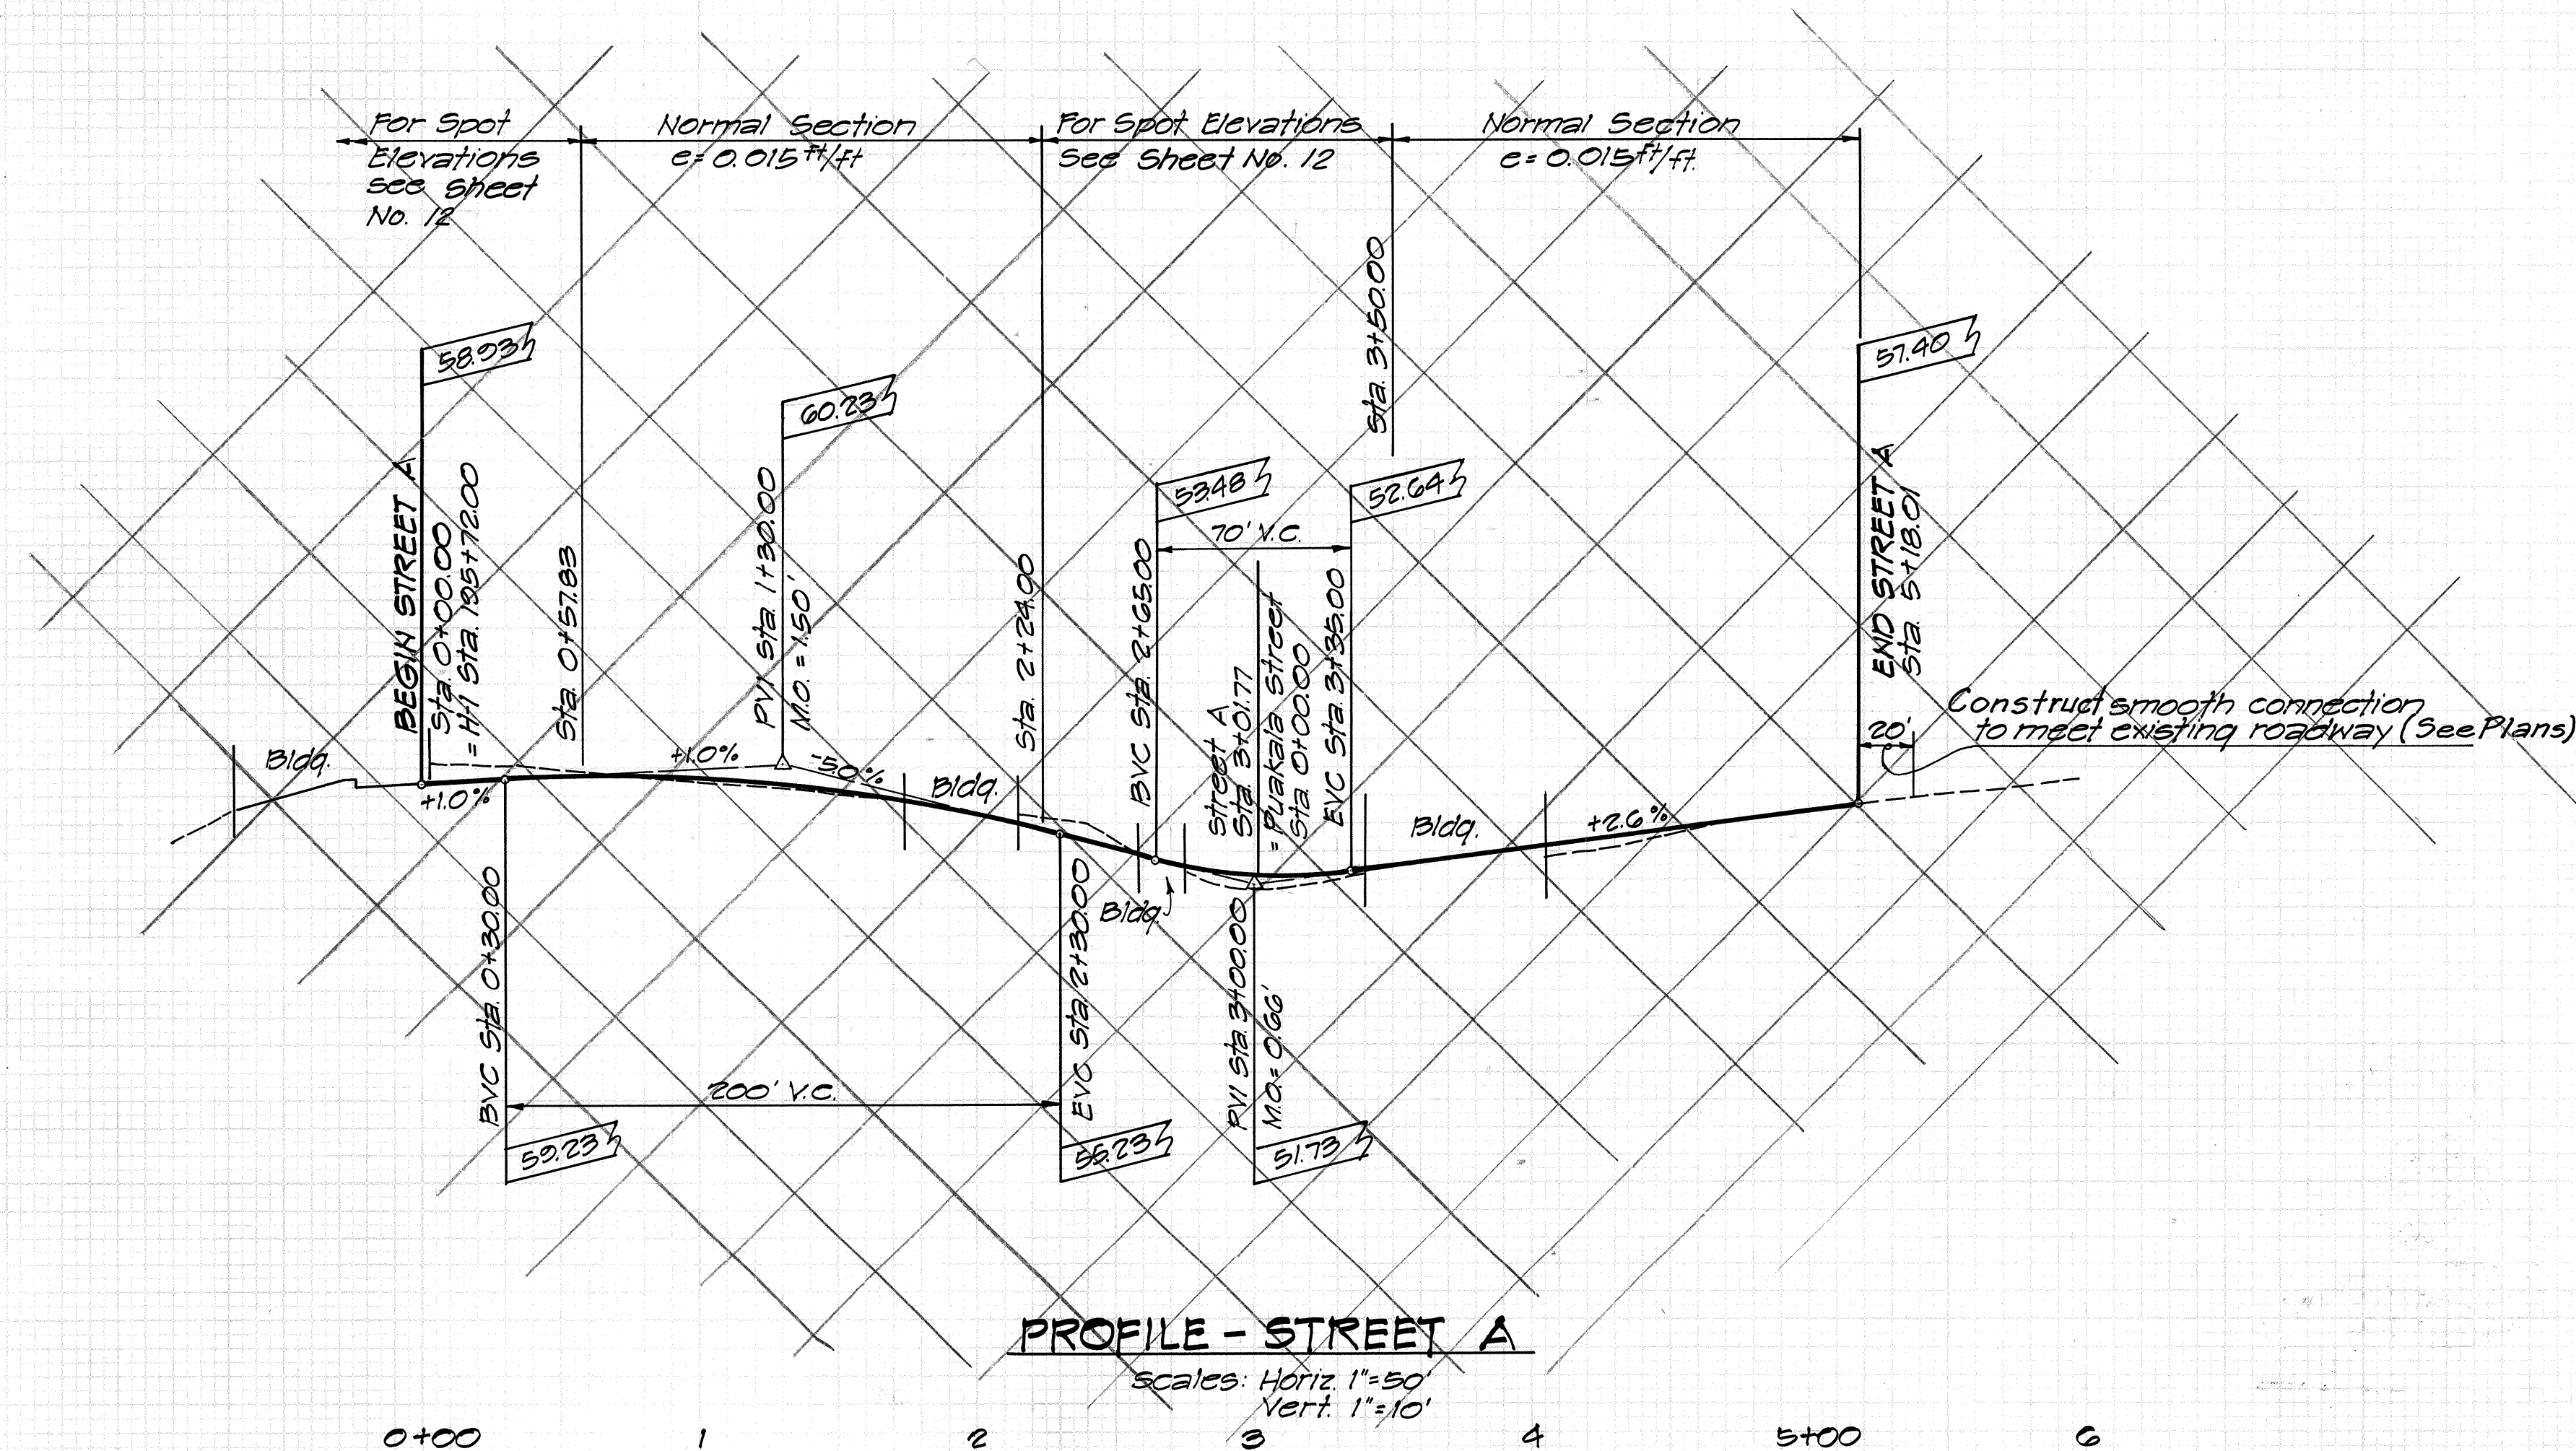

THIS WORK WAS PREPARED BY
ME OR UNDER MY SUPERVISION.

FED. ROAD DIST. NO.	STATE	FED. AID PROJ. NO.	FISCAL YEAR	SHEET NO.	TOTAL SHEETS
HAWAII	HAW.	I-41-1(77)13	1969	9	15 ⁴

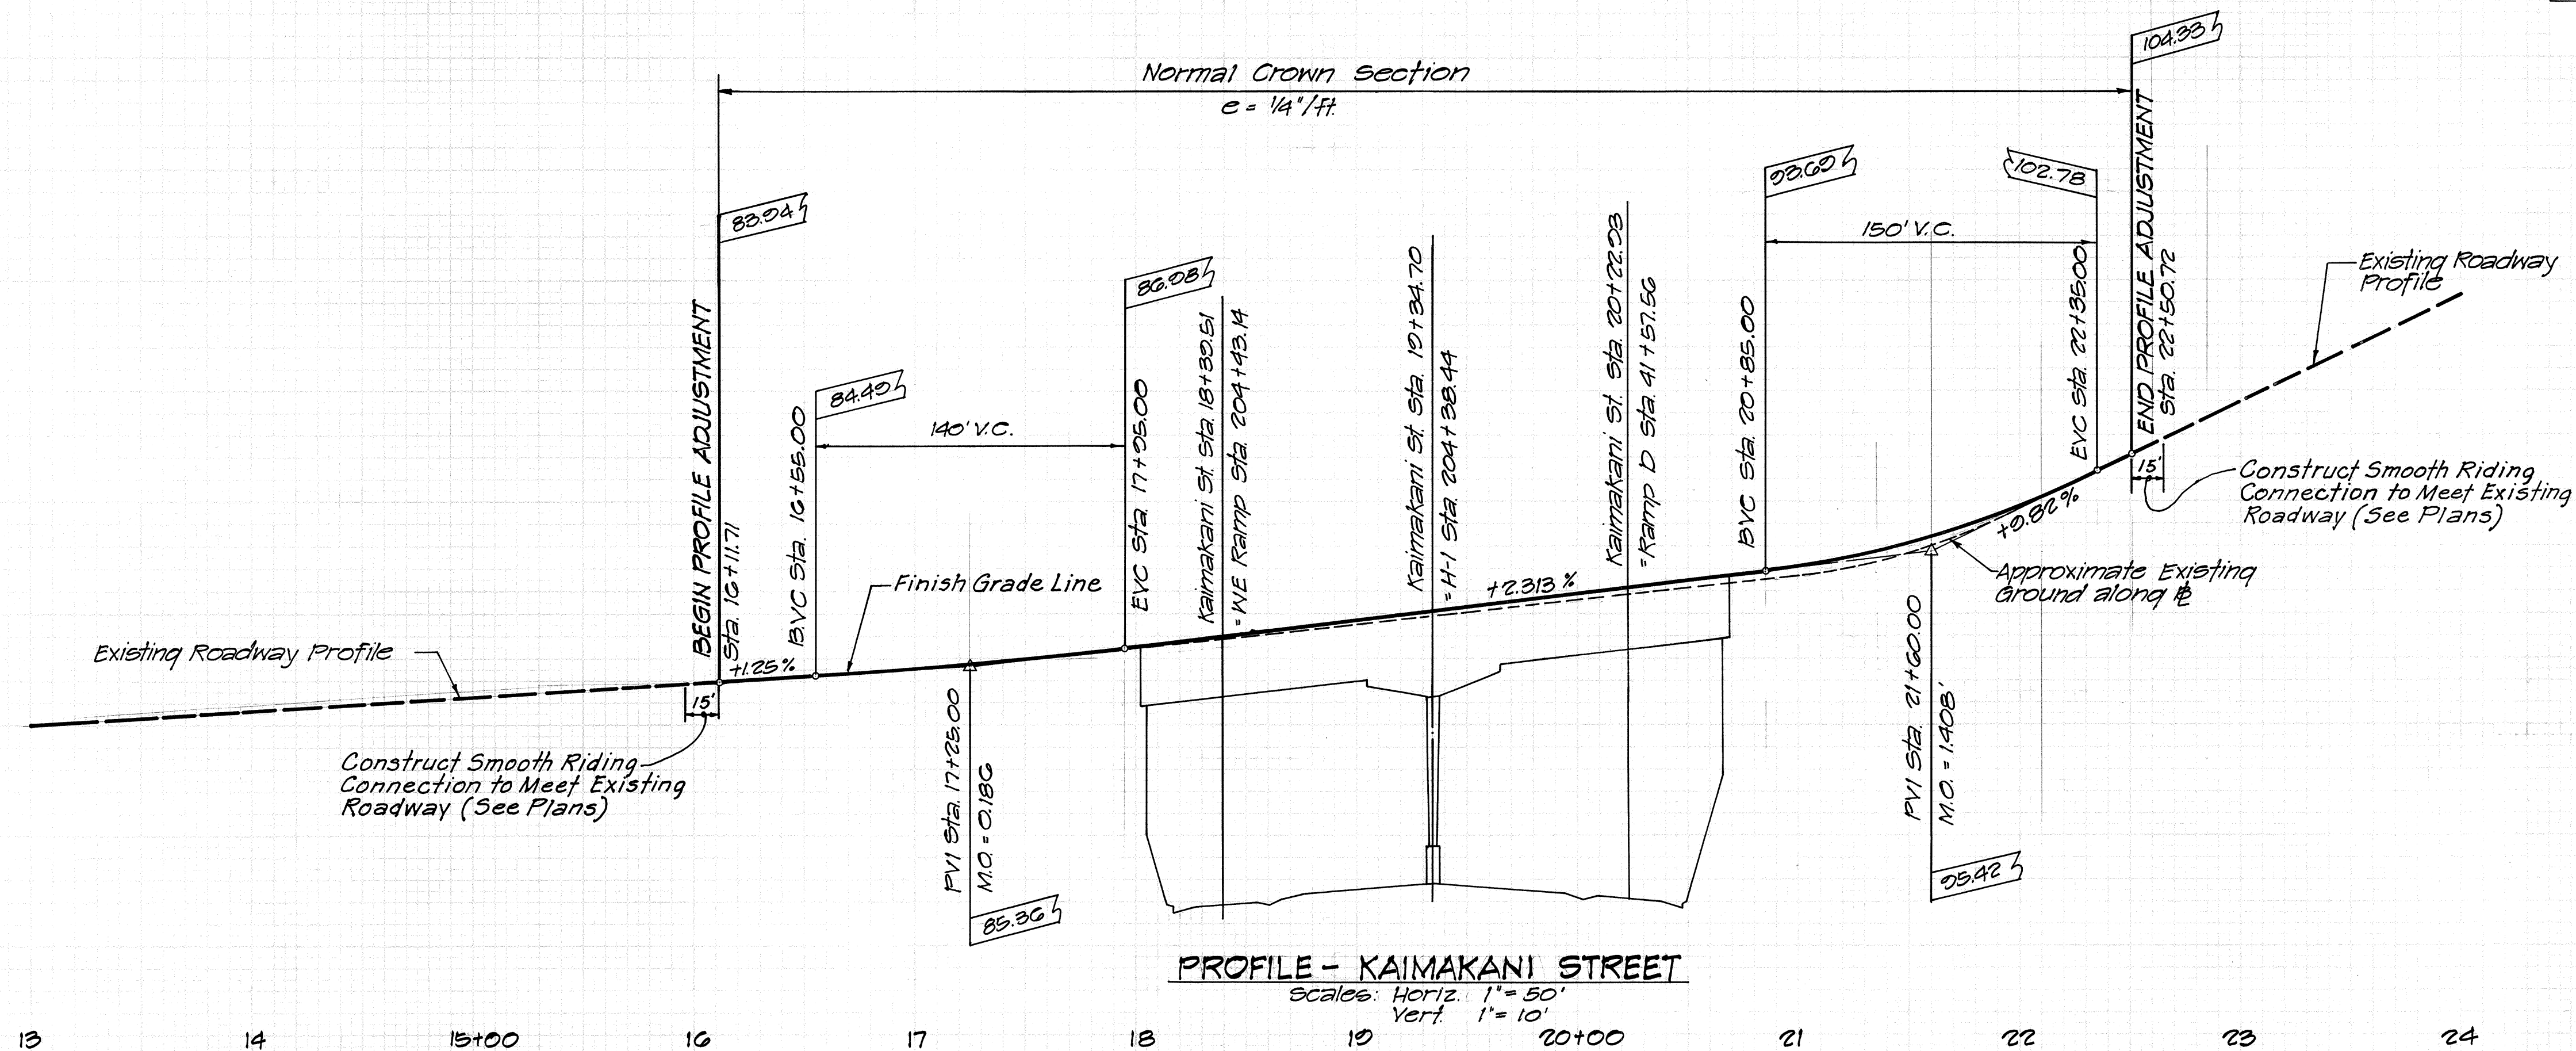

THIS WORK WAS PREPARED BY
ME OR UNDER MY SUPERVISION.