


FED. ROAD DIST. NO.	STATE	FED. AID PROJ. NO.	FISCAL YEAR	SHEET NO.	TOTAL SHEETS
HAWAII	HAW.	I-H-1(66):10 I-H-1(67):10	1970	94	97

DATE	BY	DATE	BY
NO.	NO.	NO.	NO.
NO.	NO.	NO.	NO.

DATE	BY	DATE	BY
NO.	NO.	NO.	NO.
NO.	NO.	NO.	NO.

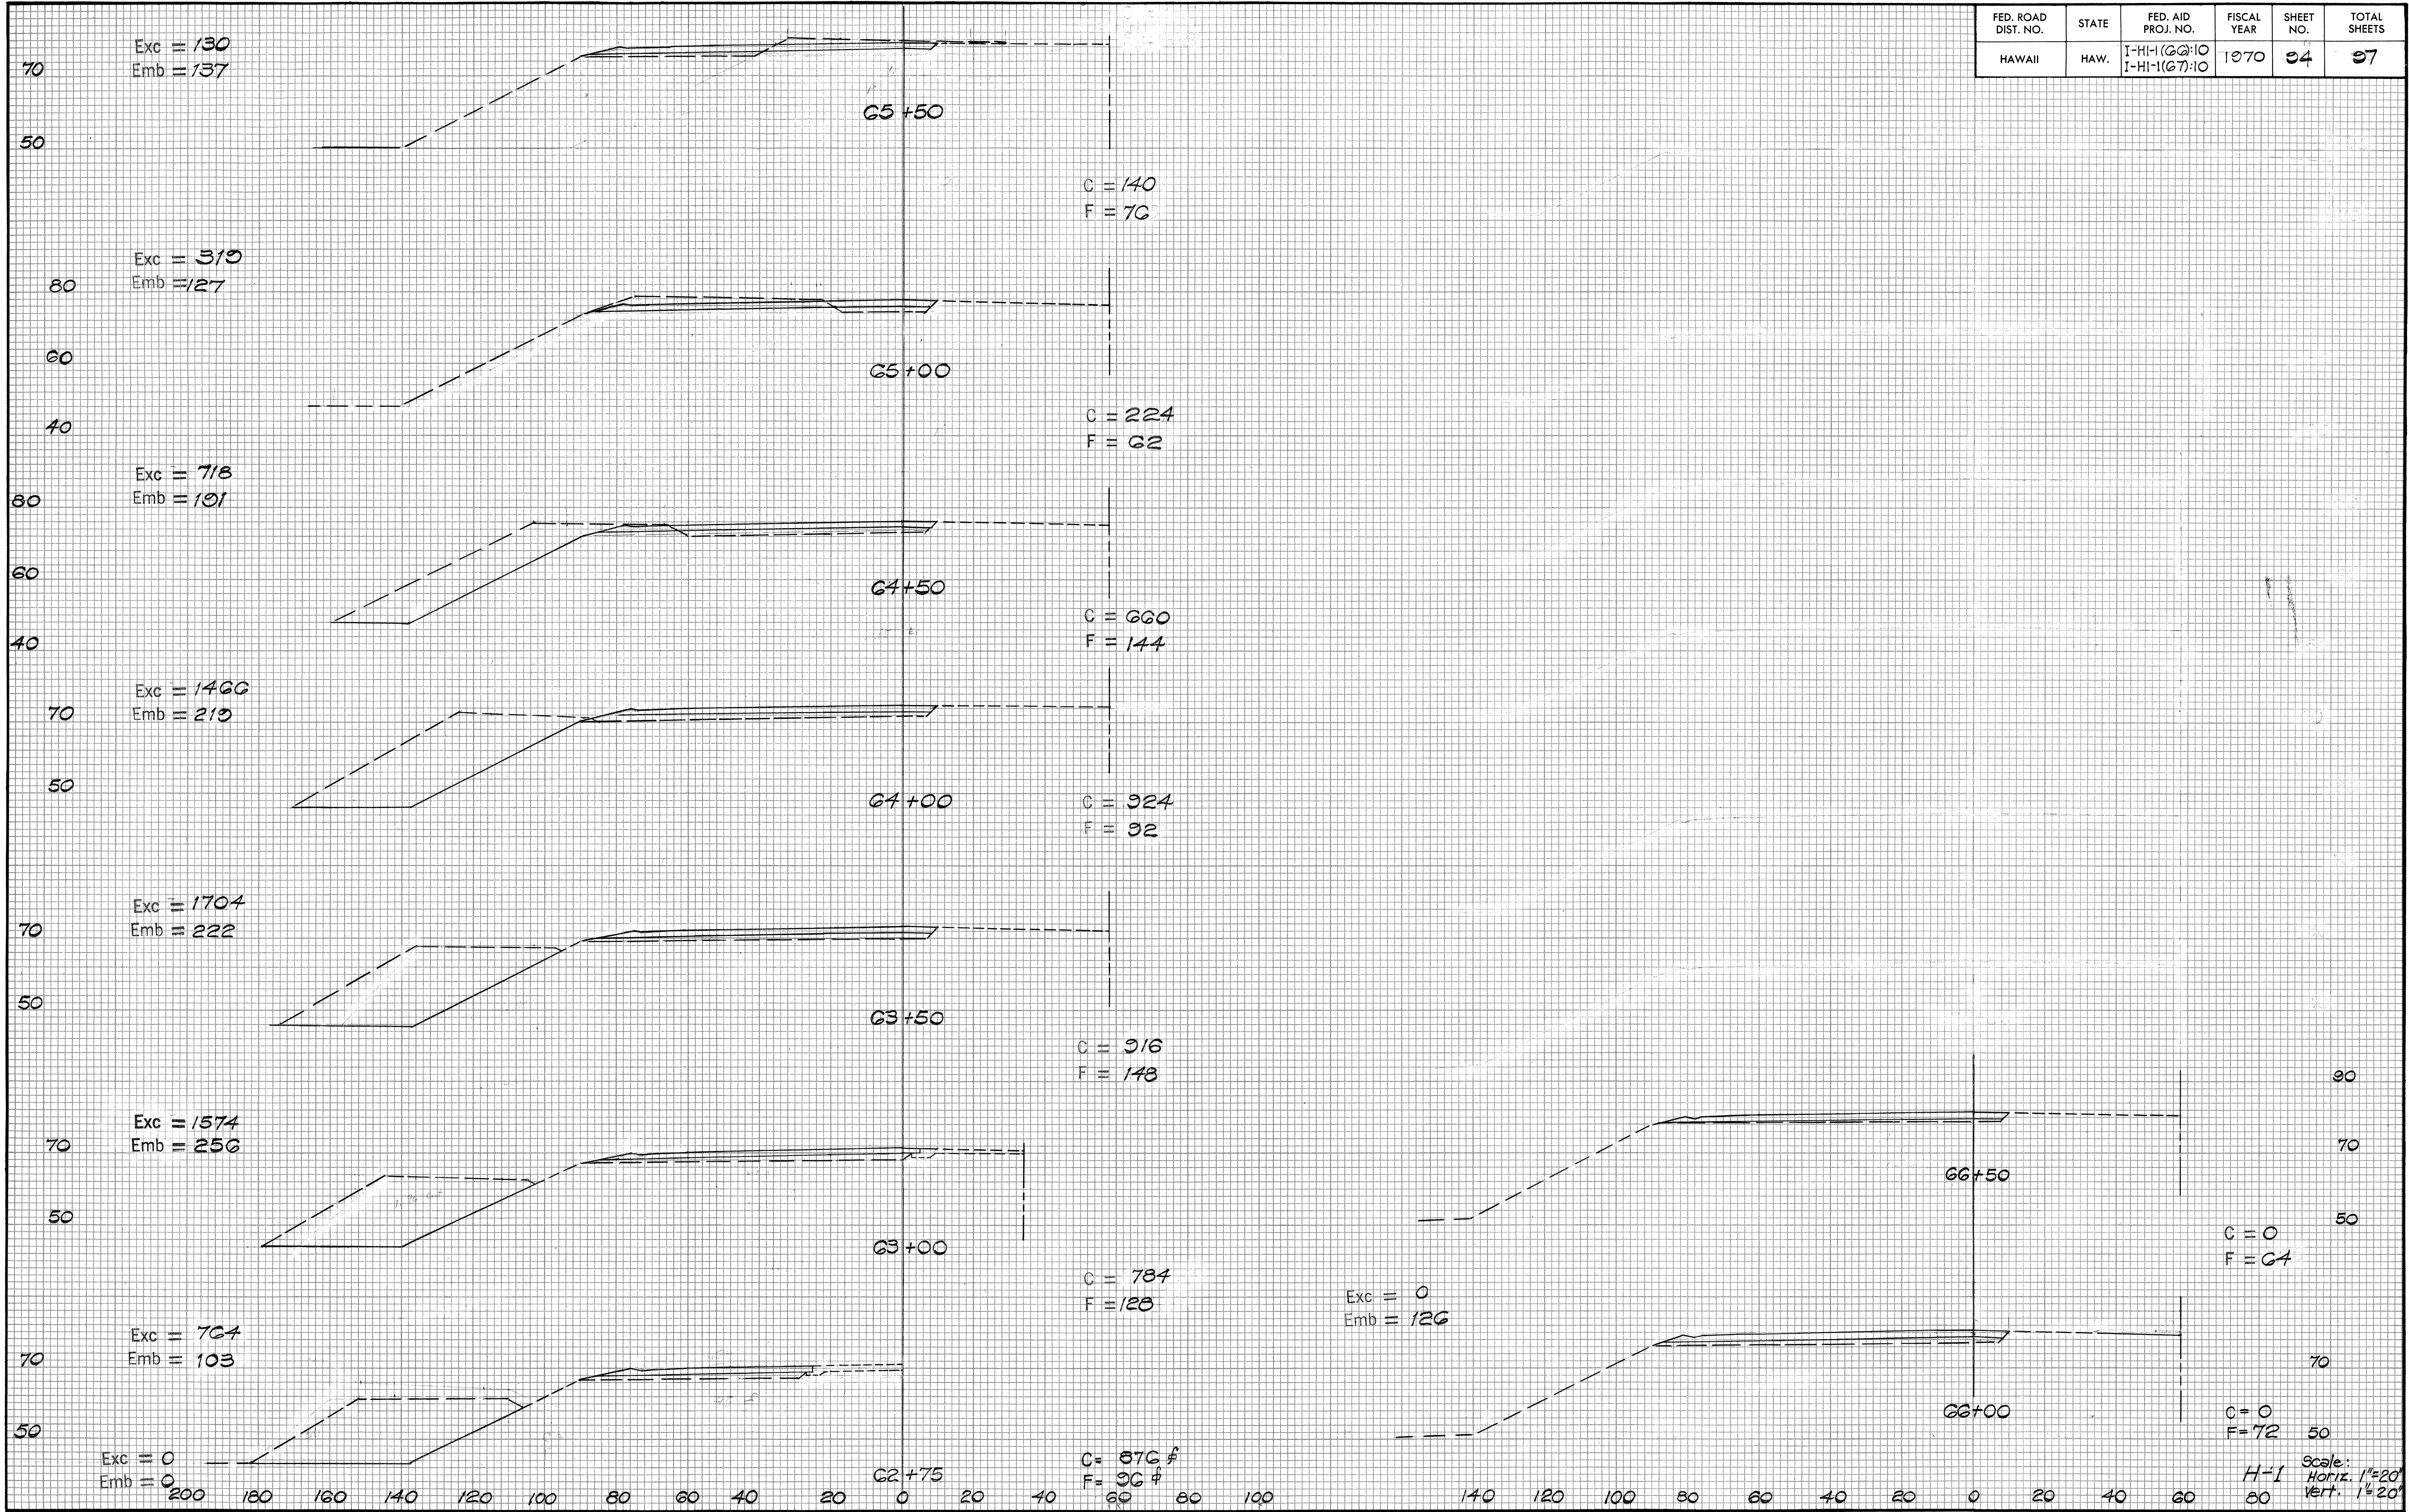

FED. ROAD DIST. NO.	STATE	FED. AID PROJ. NO.	FISCAL YEAR	SHEET NO.	TOTAL SHEETS
HAWAII	HAW.	I-HI-1(66)-10 I-HI-1(67)-10	1970	96	97

DATE

BY

FINAL SURVEY

SURVEYED

NOTE BOOK

NO.

PLATTED

TEMPLATE

AREAS CHECKED

DATE

BY

ORIGINAL SURVEY

SURVEYED


NOTE BOOK

NO.

PLATTED

TEMPLATE


AREAS CHECKED

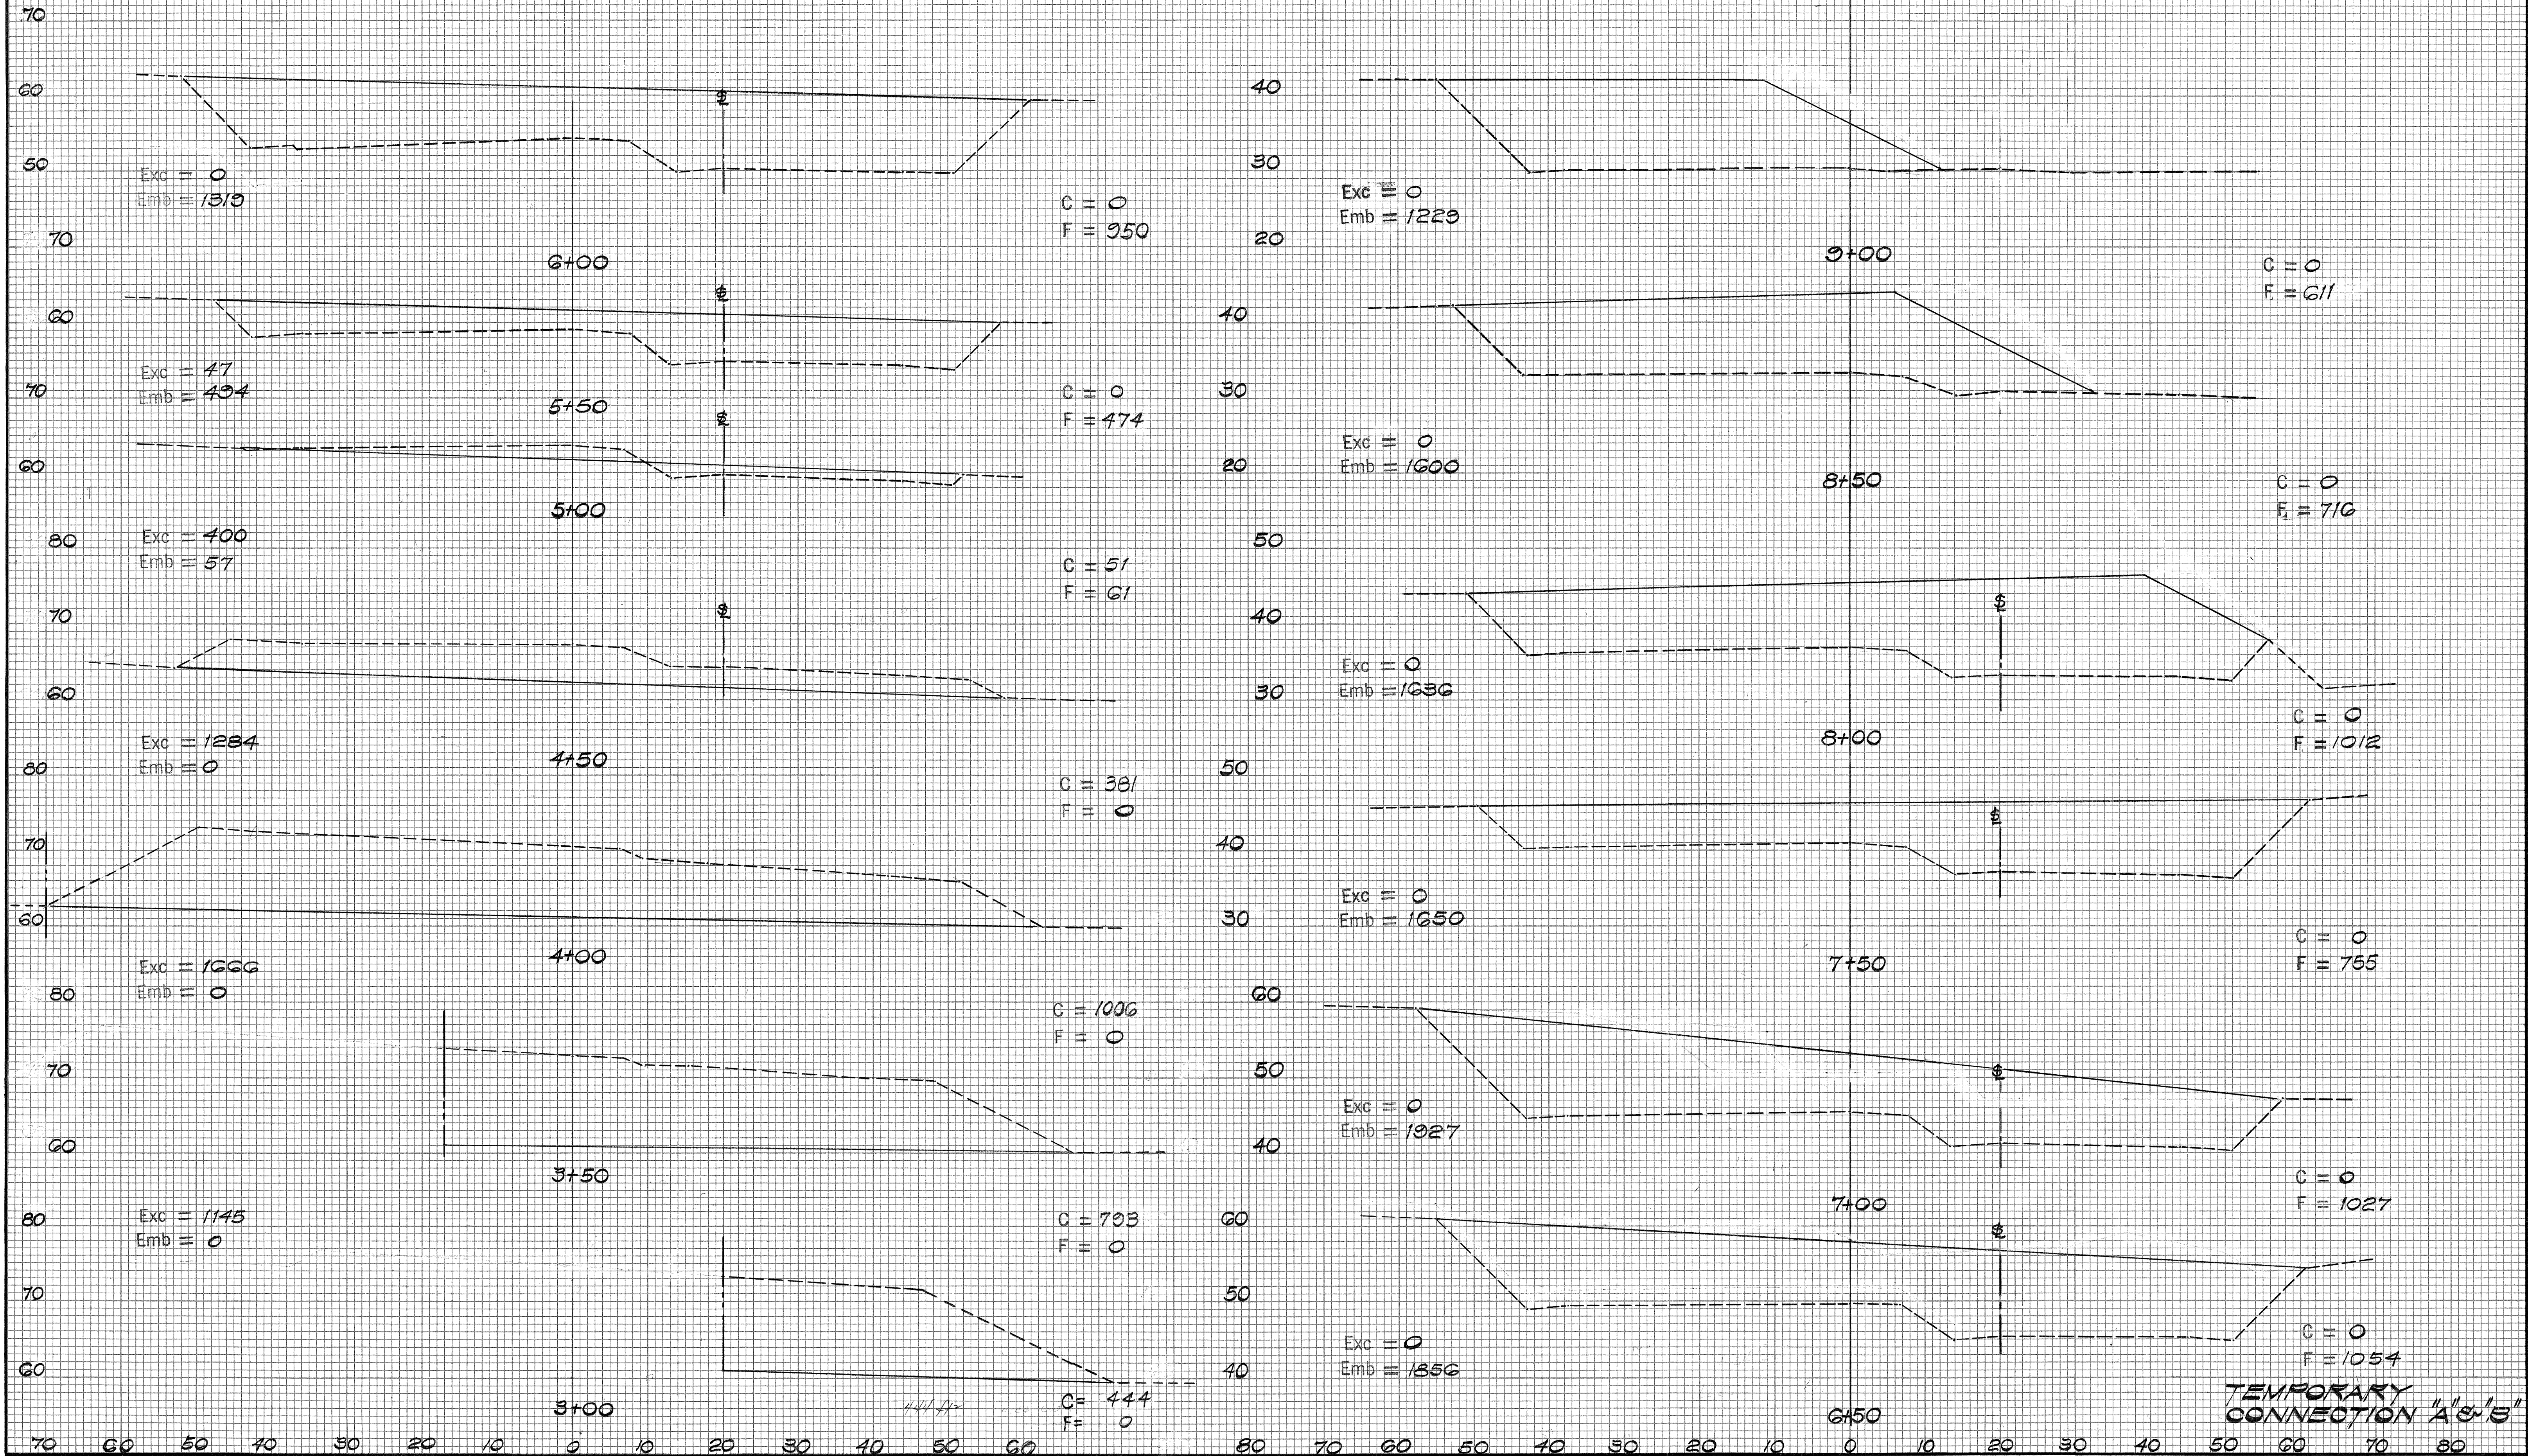

FED. ROAD DIST. NO.	STATE	FED. AID PROJ. NO.	FISCAL YEAR	SHEET NO.	TOTAL SHEETS
HAWAII	HAW.	I-HI-1(66):10 I-HI-1(67):10	1970	97	97

FINAL SURVEY NOTE BOOK NO.	DATE
	BY
	SURVEYED PLOTTED TEMPERATURE AREAS CHECKED

ORIGINAL SURVEY NOTE BOOK NO.	DATE
	BY
	SURVEYED PLOTTED TEMPERATURE AREAS CHECKED

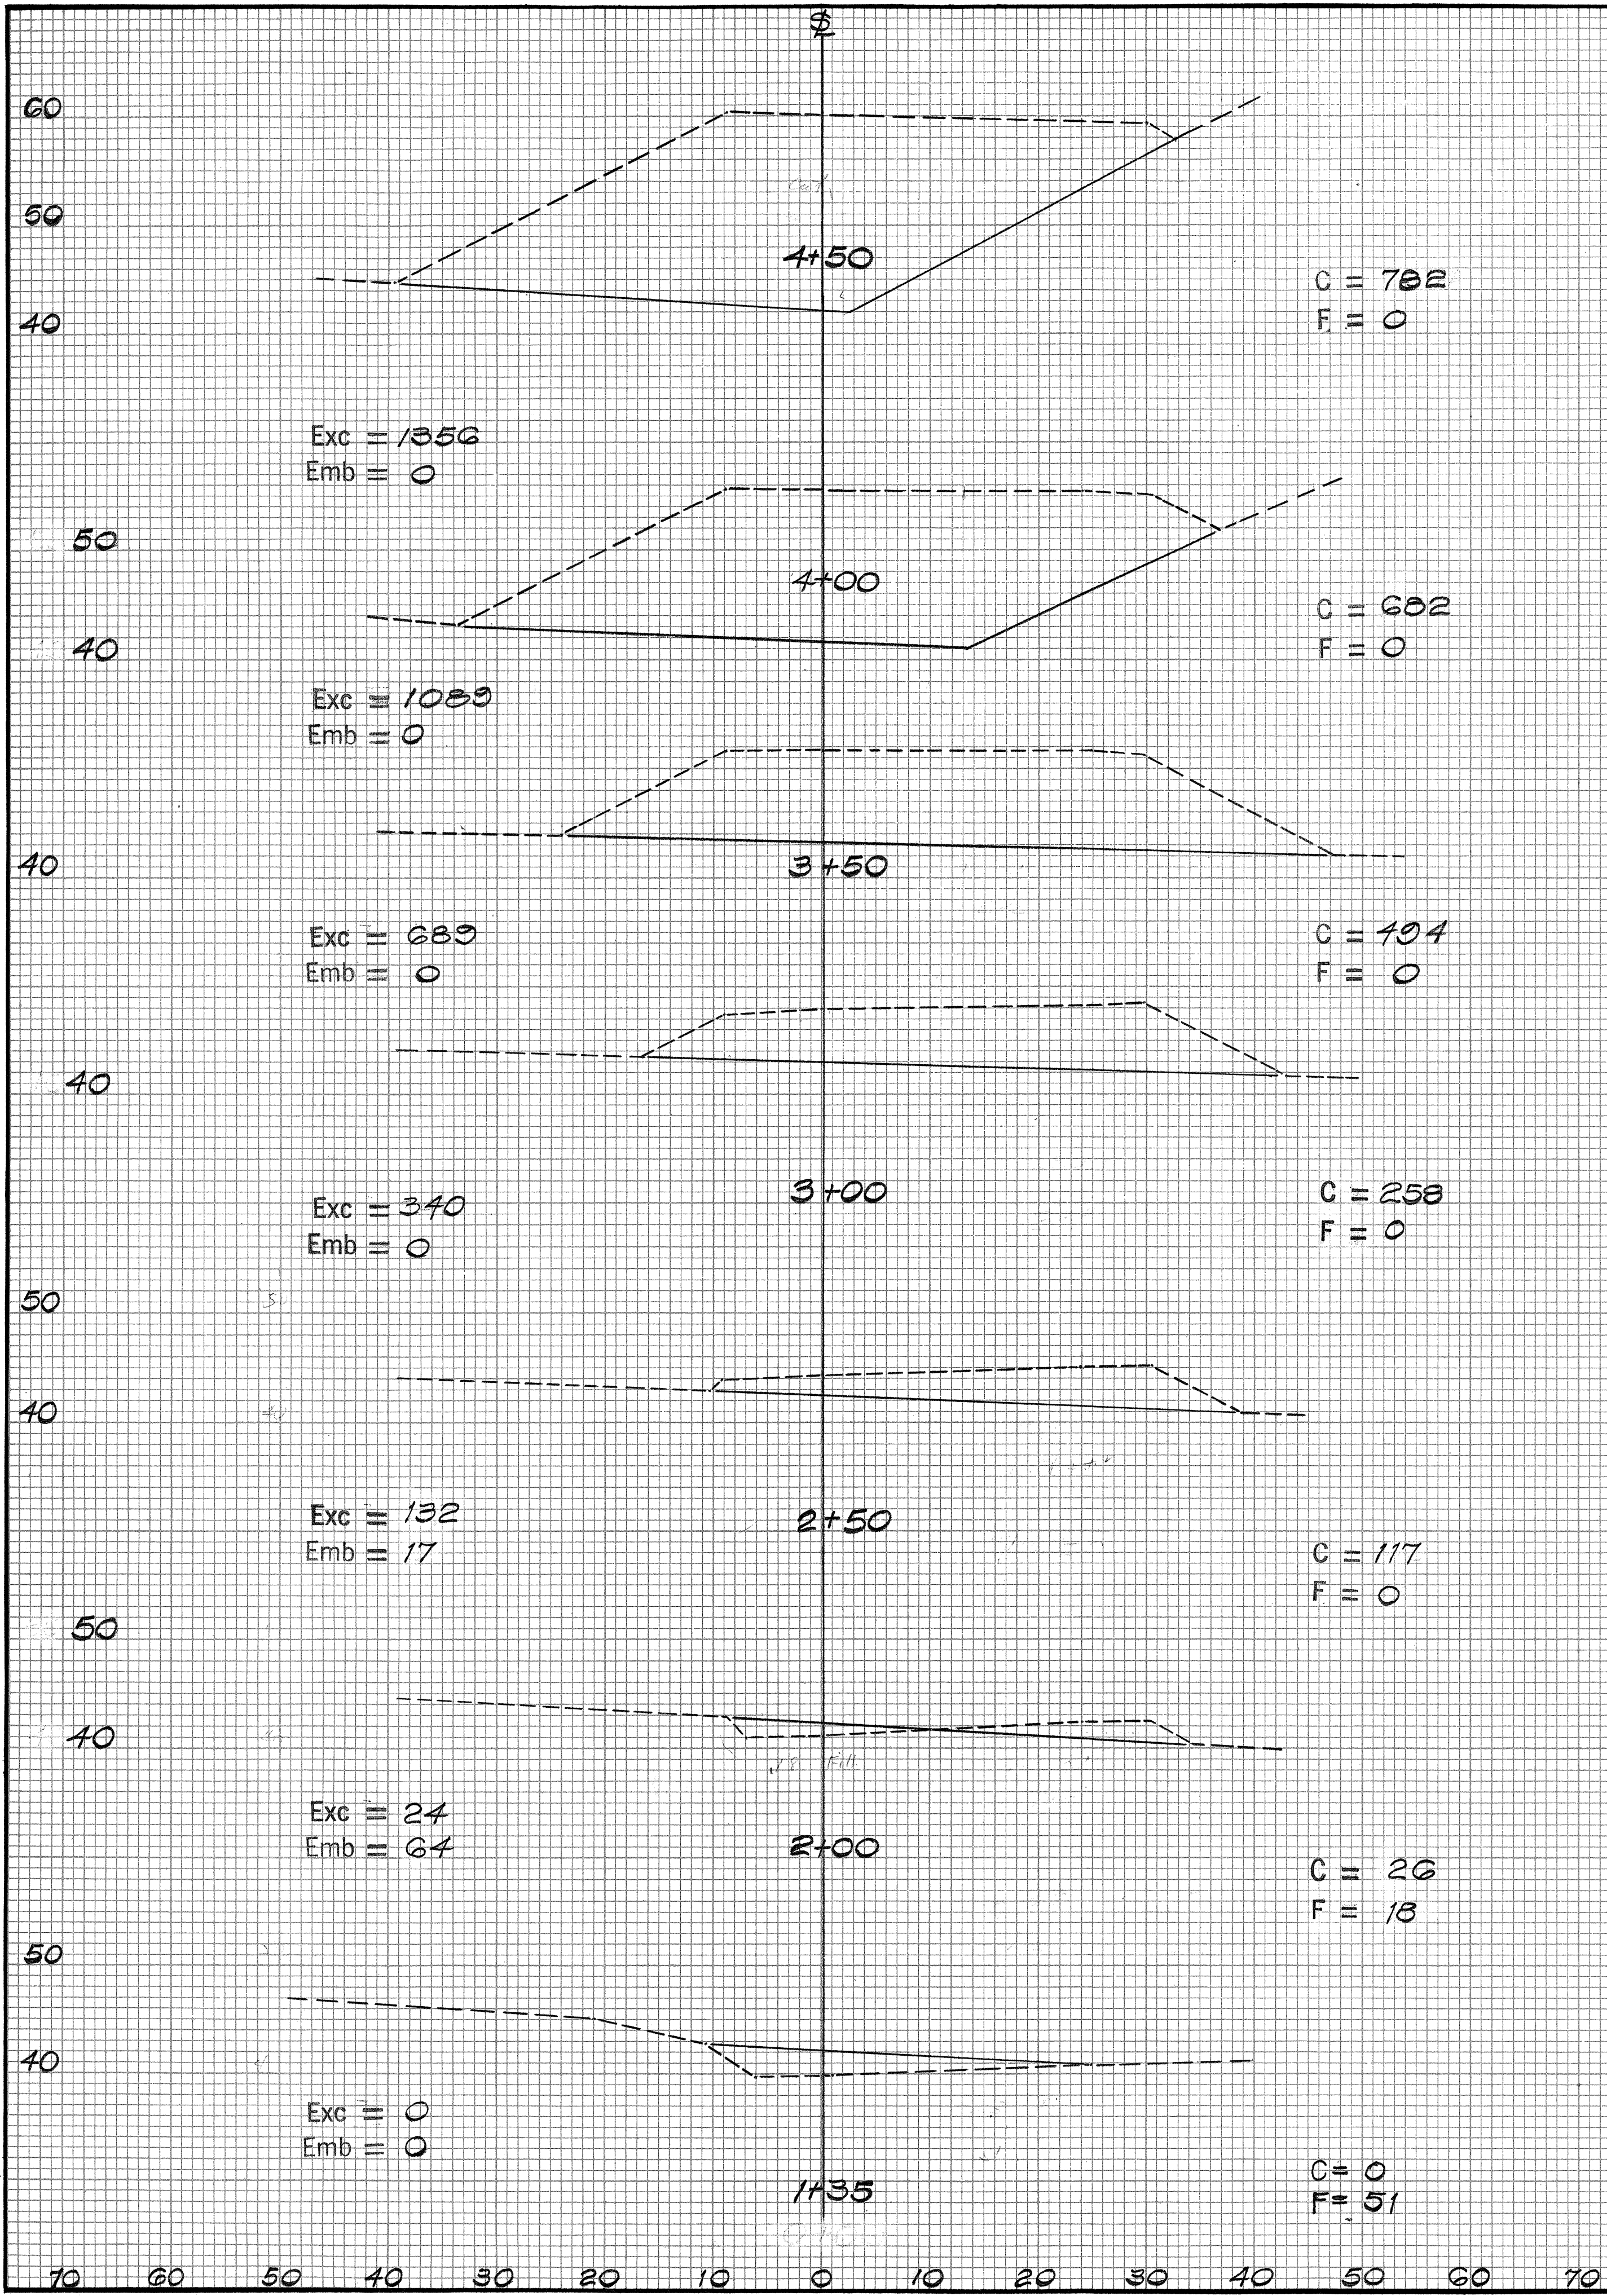

TEMPORARY
CONNECTION "O"