

S U M M A R Y

SHEET No. 1 OF 17 SHEETS

FSA

S U M M A R Y

ORIGINAL PLAN	SURVEY PLOTTED BY	DATE
	DRAWN BY	44
	TRACED BY	44
	DESIGNED BY	44
	QUANTITIES BY	44
NOTE BOOK	CHECKED BY	44
	No.	44

SHEET No. 2 OF 17 SHEETS

FED. ROAD DIST. NO.	STATE	FED. AID PROJ. NO.	FISCAL YEAR	SHEET NO.	TOTAL SHEETS
HAWAII	HAW.	I-HH(66)10	1970	80	97
		I-HH(67)10			

ORIGINAL	SURVEY PLOTTED BY _____	DATE _____
PLAN	DRAWN BY _____	BY _____
	TRACED BY _____	BY _____
NOTE BOOK	DESIGNED BY _____	BY _____
	QUANTITIES BY _____	BY _____
No. _____	CHECKED BY _____	BY _____

S U M M A R Y

ORIGINAL PLAN	SURVEY PLOTTED BY _____		DATE _____
	DRAWN BY _____		_____
	TRACED BY _____		_____
	DESIGNED BY _____		_____
	QUANTITIES BY _____		_____
NOTE BOOK	CHECKED BY _____		_____
	No. _____		_____

SHEET No. 4 OF 17 SHEETS

NOTES:

1. All pipes designated by ϕ shall be 10 gage C.M.P. or Class III R.C.P. or A.C.P.
2. For Profiles & Details of 102" ϕ Pipe @ Kam. Hwy. & Channel 1 & 1a, see Shts. 83, 84, 84A & 85.
3. For Details of Type "G/G12" & "G/G13" Drop Intake, see Sht. 88.
4. For Details of discharge facilities downstream of Type "G/G12" Drop Intakes see Sht. 87.

CHANNEL #1a CURVE DATA

①	②	③
$\Delta = 15^{\circ}40'00"$	$\Delta = 13^{\circ}05'00"$	$\Delta = 73^{\circ}39'30"$
$\Delta_2 = 7^{\circ}50'00"$	$\Delta_2 = 6^{\circ}32'30"$	$\Delta_2 = 36^{\circ}49'45"$
$R = 300.00'$	$R = 300.00'$	$R = 75.00'$
$T = 41.27'$	$T = 34.40'$	$T = 56.17'$
$Lc = 82.03'$	$Lc = 68.50'$	$Lc = 96.42'$
$Ch = 81.775'$	$Ch = 68.36'$	$Ch = 89.91'$

CHANNEL #1 CURVE DATA

$\Delta = 13^{\circ}01'40"$
$\Delta_2 = 60^{\circ}30'50"$
$R = 140.00'$
$T = 15.99'$
$Lc = 31.83'$
$Ch = 31.76'$

To be place 30' from this corner
 CCO #27
 Install 6 ft. high 10' ft. wide double hung gate.

Sta. 15 + 55.71
 End Channel #1
 Begin 102" ϕ Pipe
 Top Head Wall = 42.5
 Invert = 32.0
 29.0

Sta. 14 + 70
 Inv. = 32.5
 Sta. 11 + 85
 Inv. = 46.5

CC #21'40" + 489.86 (10+50 to P.I.)

Channel #1
 Sta. 0 + 00
 Sta. 65 + 20
 Type "G/G12"
 Drop Intake
 Inv. = 64.3
 Inv. = 71.6

BEGIN PROJ. NO. I-H-1 (66) 10
 H-1 STA. 62 + 57.24
 END PEARL CITY VIADUCT
 APPROACH SLAB

246'21'40" +

Ramp "C" Sta. 2 + 60
 Type "G/G12"
 Drop Intake
 Inv. = 69.7

Ramp "C" Sta. 4 + 75
 Type "G/G13"
 Drop Intake
 Inv. = 72.0

Ramp "C" Sta. 4 + 85
 Type "G/G12"
 Drop Intake
 Inv. = 73.0

Ramp "C" Sta. 4 + 85
 Type "G/G12"
 Drop Intake
 Inv. = 73.0

Removal and reconstruction of exist.
 chain link fence shall be incidental
 to the construction of 102" dia.
 drainage pipe.

H-1 STA. 66+50 TO H-1 STA. 54+60±

Construct: 4-Type "G/G12" Drop Intake
 1-Type "G/G13" Drop Intake
 2-Concrete Headwall

Install: 24" ϕ C.M.P. or R.C.P. or A.C.P.
 102" Sectional Plate Pipe (No Option)
 Lined Channel

ESTIMATED QUANTITIES

Class "A" Concrete	446 CY.
Reinforcing Steel	32,753 LB.
Structural Excavation	4,403 CY.
Grouted Rubble Paving	7 CY.
24" 10 Gage C.M.P. or	
24" C.I. III, R.C.P. or	
24" C.I. III, A.C.P.	186 LF.
102" 10 Gage Sectional Plate Pipe (5% Elongated)	262 LF.
Untreated Base for Pipe Foundation	153 CY.
Type "G/G12" Steel Frame and Grate	4 EA.
Type "G/G13" Steel Frame and Grate	1 EA.

APPROVED: E. Lowe
 Chief, Division of Sewers
 Approval to Construct over
 Exist. 36" ϕ Sewer Line Only

12/17/60
 J. J. Date




THIS WORK WAS PREPARED BY
 ME OR UNDER MY SUPERVISION.

DETAILED DRAINAGE PLAN




INTERSTATE ROUTE H-1
 PROJ. NO. I-H-1 (66) 10

Scale: 1" = 50' Date: SHEET No. 5 OF 17 SHEETS

FED. ROAD DIST. NO.	STATE	FED. AID PROJ. NO.	FISCAL YEAR	SHEET NO.	TOTAL SHEETS
HAWAII	HAW.	I-H-1(66)10 I-41(67)10	1970	83	97

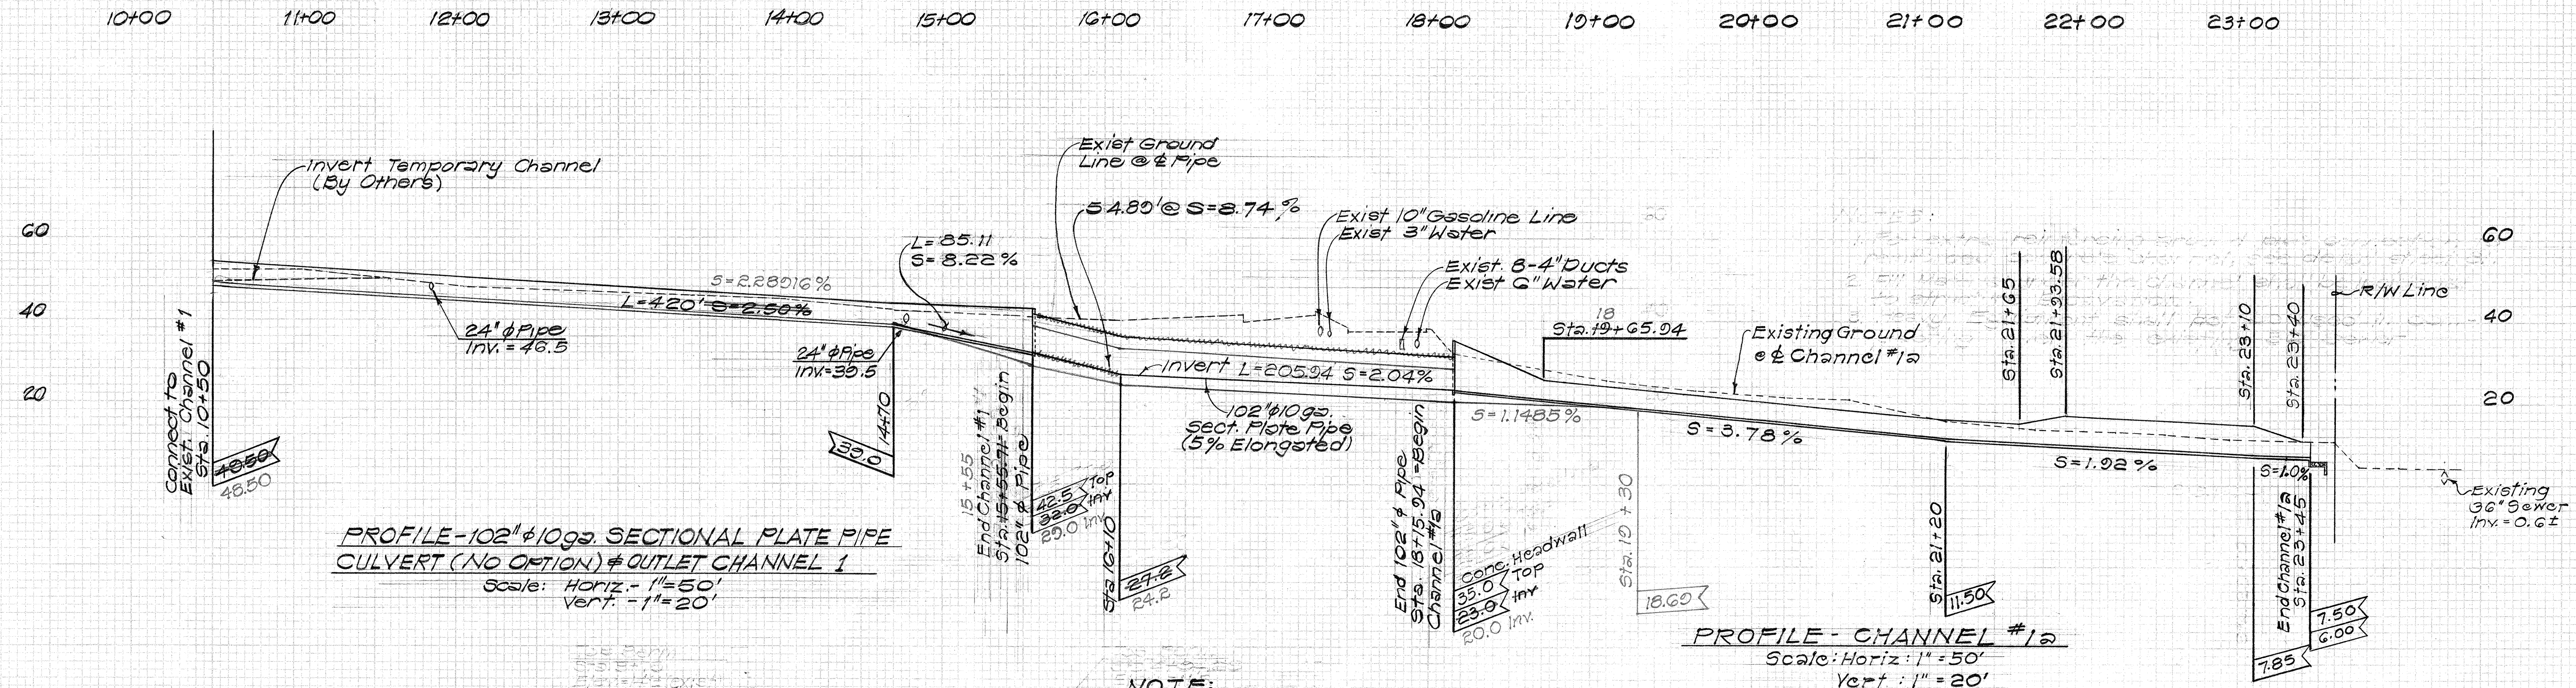

NOTE:
For extra reinforcing around pipe connection to reinforced concrete channel, see detail sheet 93

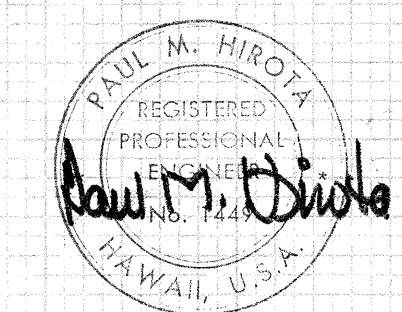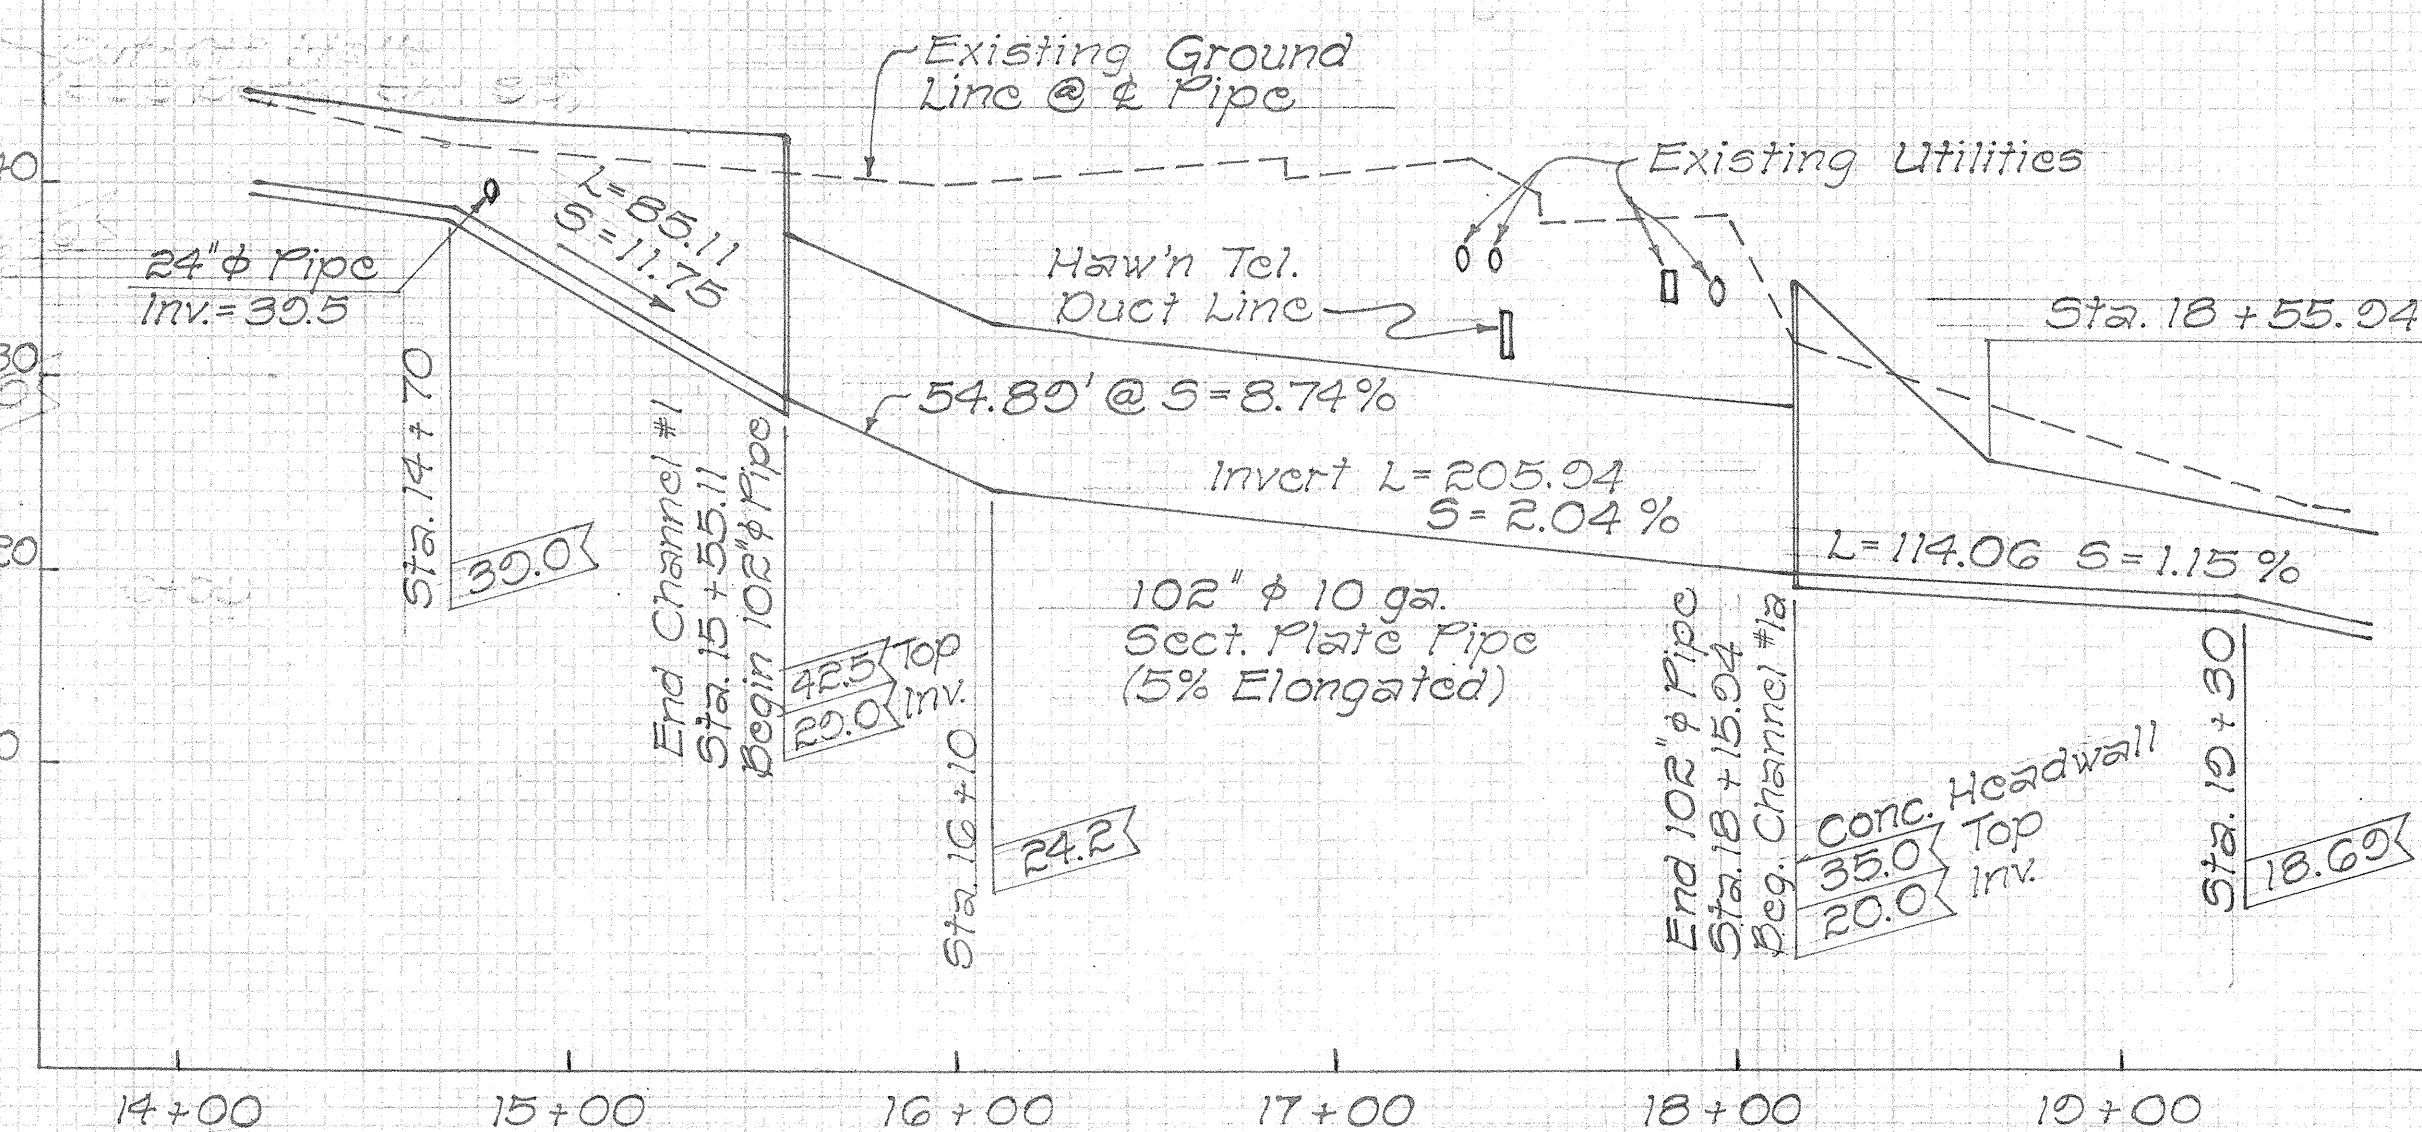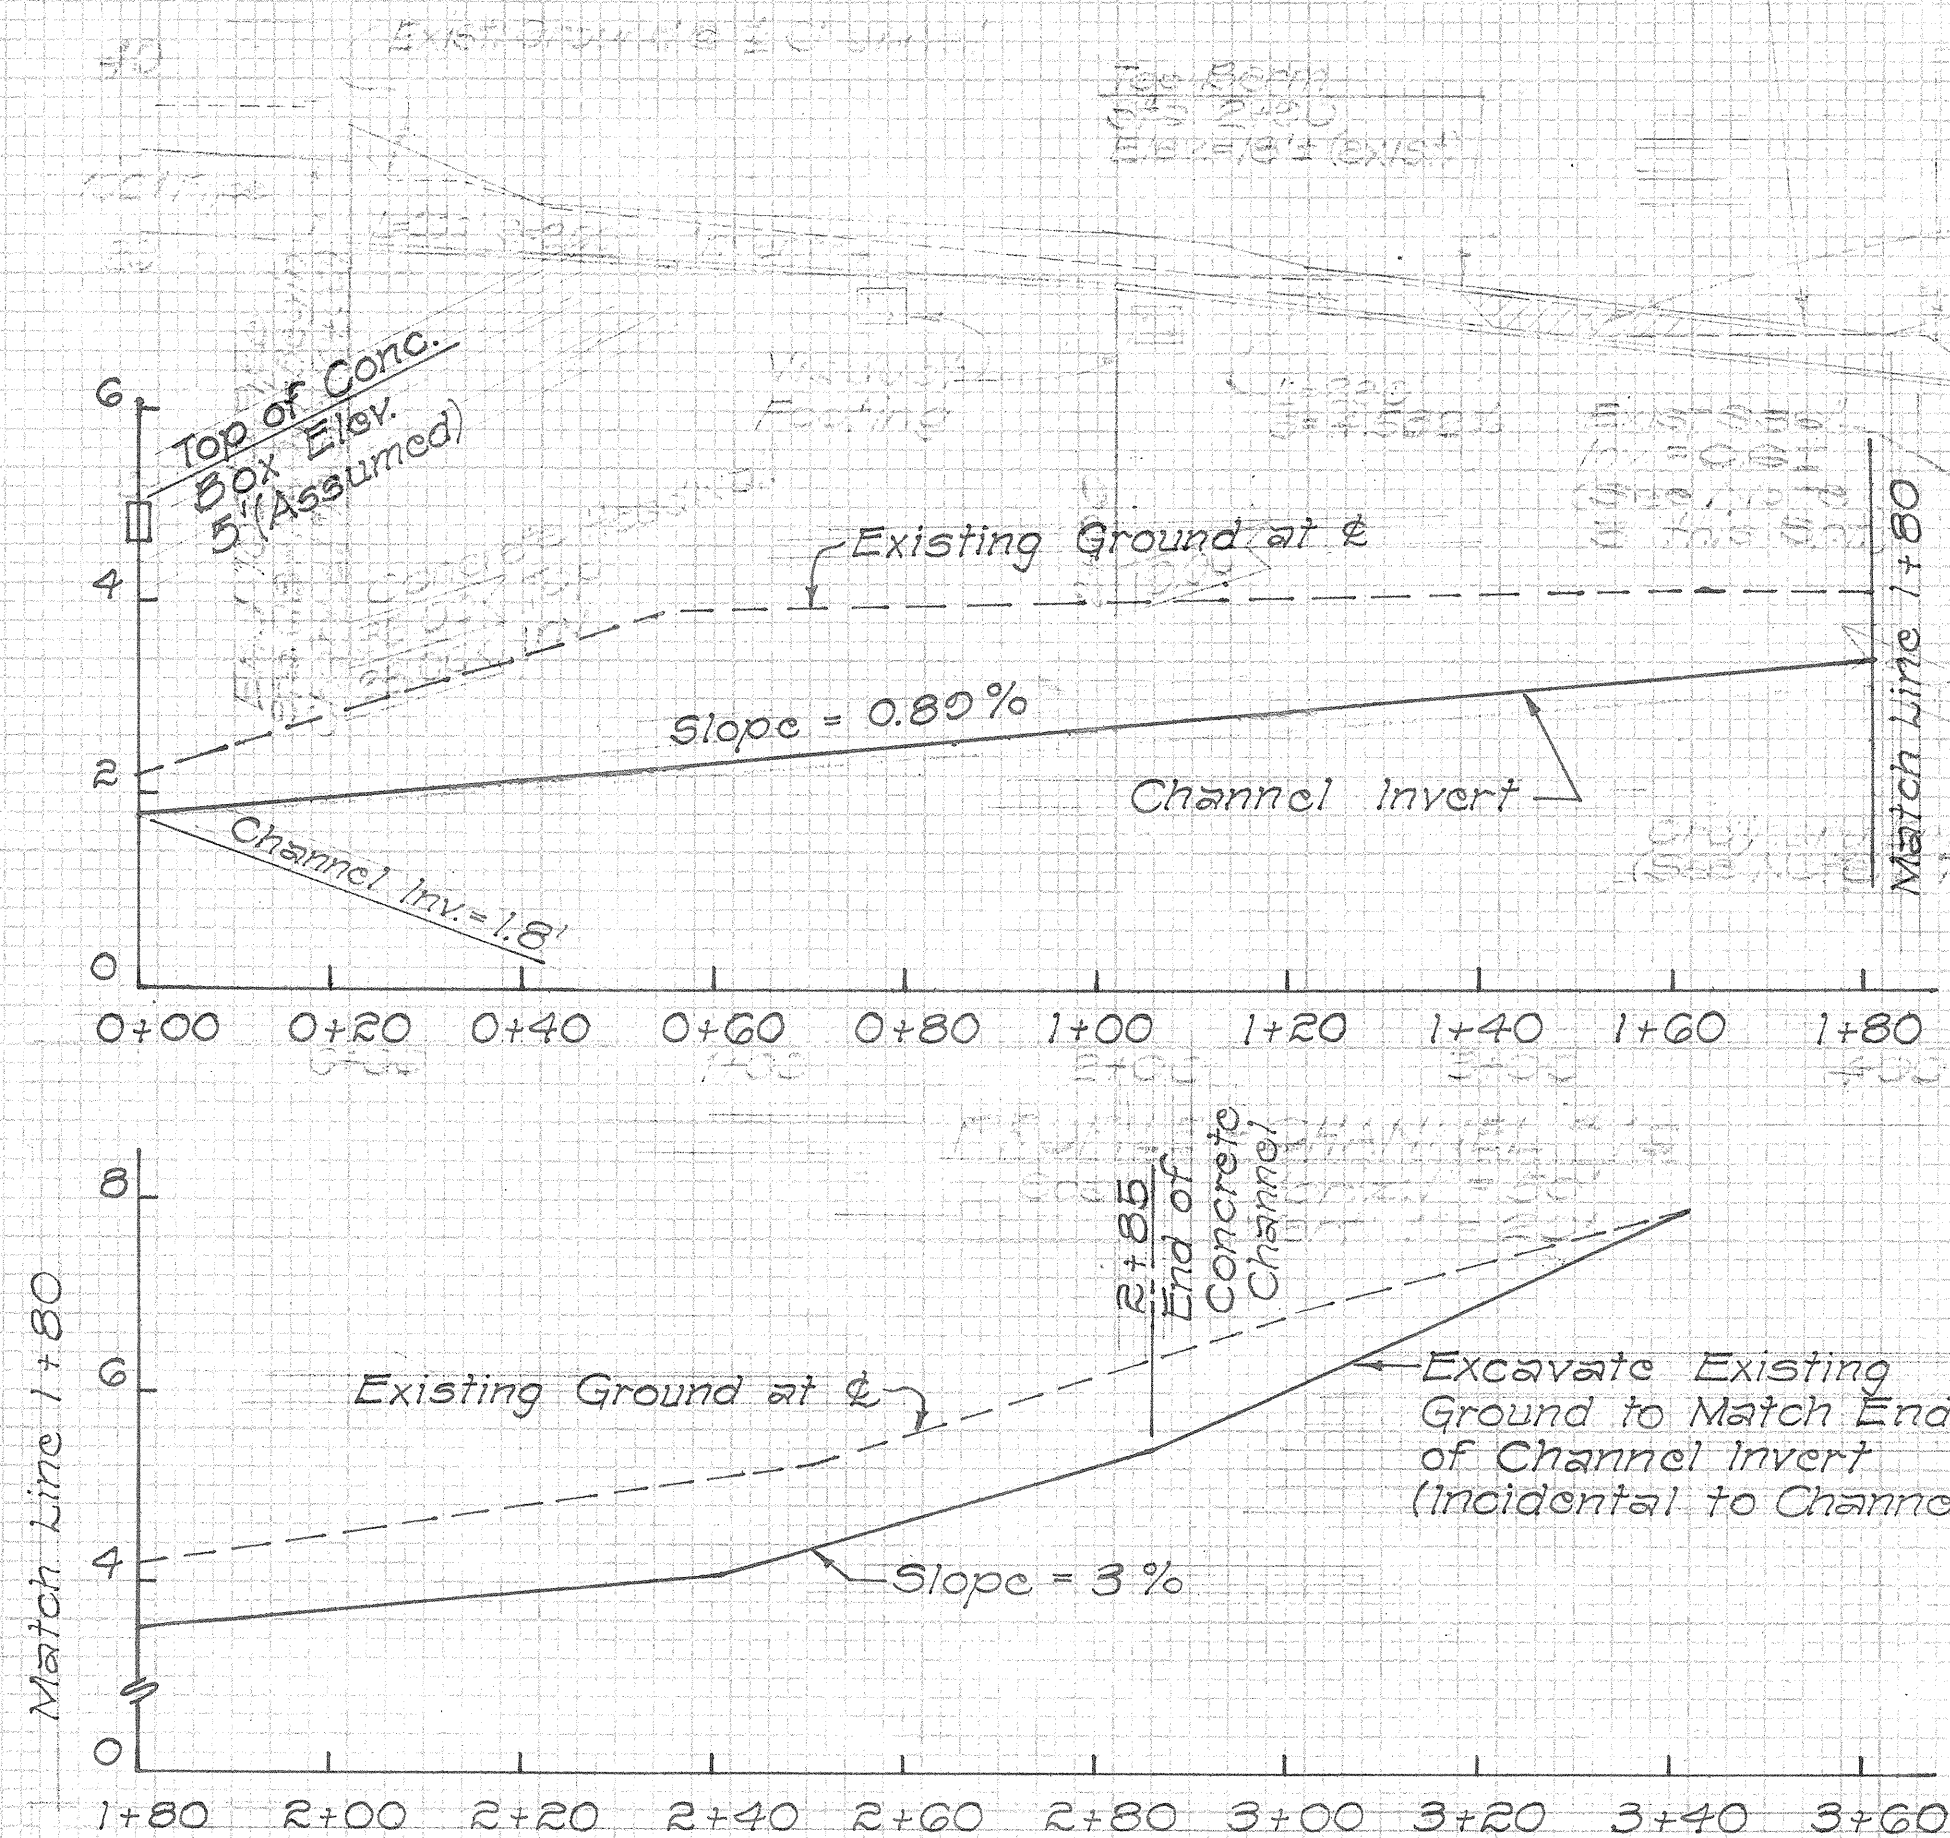

THIS WORK WAS PREPARED BY ME OR UNDER MY SUPERVISION.

STATE OF HAWAII
DEPARTMENT OF TRANSPORTATION
HIGHWAYS DIVISION

102" SECTIONAL PLATE PIPE CULVERT & OUTLET CHANNELS #1 & 1a

INTERSTATE ROUTE H-1
PROJECT NO. I-H-1(66)10

SCALE: As Shown DATE: 12/17/69


SHEET No. 83 OF 17 SHEETS

FED. ROAD DIST. NO.	STATE	FED. AID PROJ. NO.	FISCAL YEAR	SHEET NO.	TOTAL SHEETS
HAWAII	HAW.	I-HI-1(66)10 I-HI-1(67)10	1970	84	97


CHANNEL #1a CURVE DATA

①	②	③
$\Delta = 15^{\circ}40'00''$	$\Delta = 13^{\circ}05'00''$	$\Delta = 73^{\circ}39'30''$
$\Delta/2 = 7^{\circ}50'00''$	$\Delta/2 = 6^{\circ}32'30''$	$\Delta/2 = 36^{\circ}49'45''$
$R = 300.00'$	$R = 300.00'$	$R = 75.00'$
$T = 41.27'$	$T = 34.40'$	$T = 56.17'$
$Lc = 82.03'$	$Lc = 68.50'$	$Lc = 96.42'$
$Ch = 81.775'$	$Ch = 68.36'$	$Ch = 89.91'$


TRUE NORTH
Scale: 1" = 20'

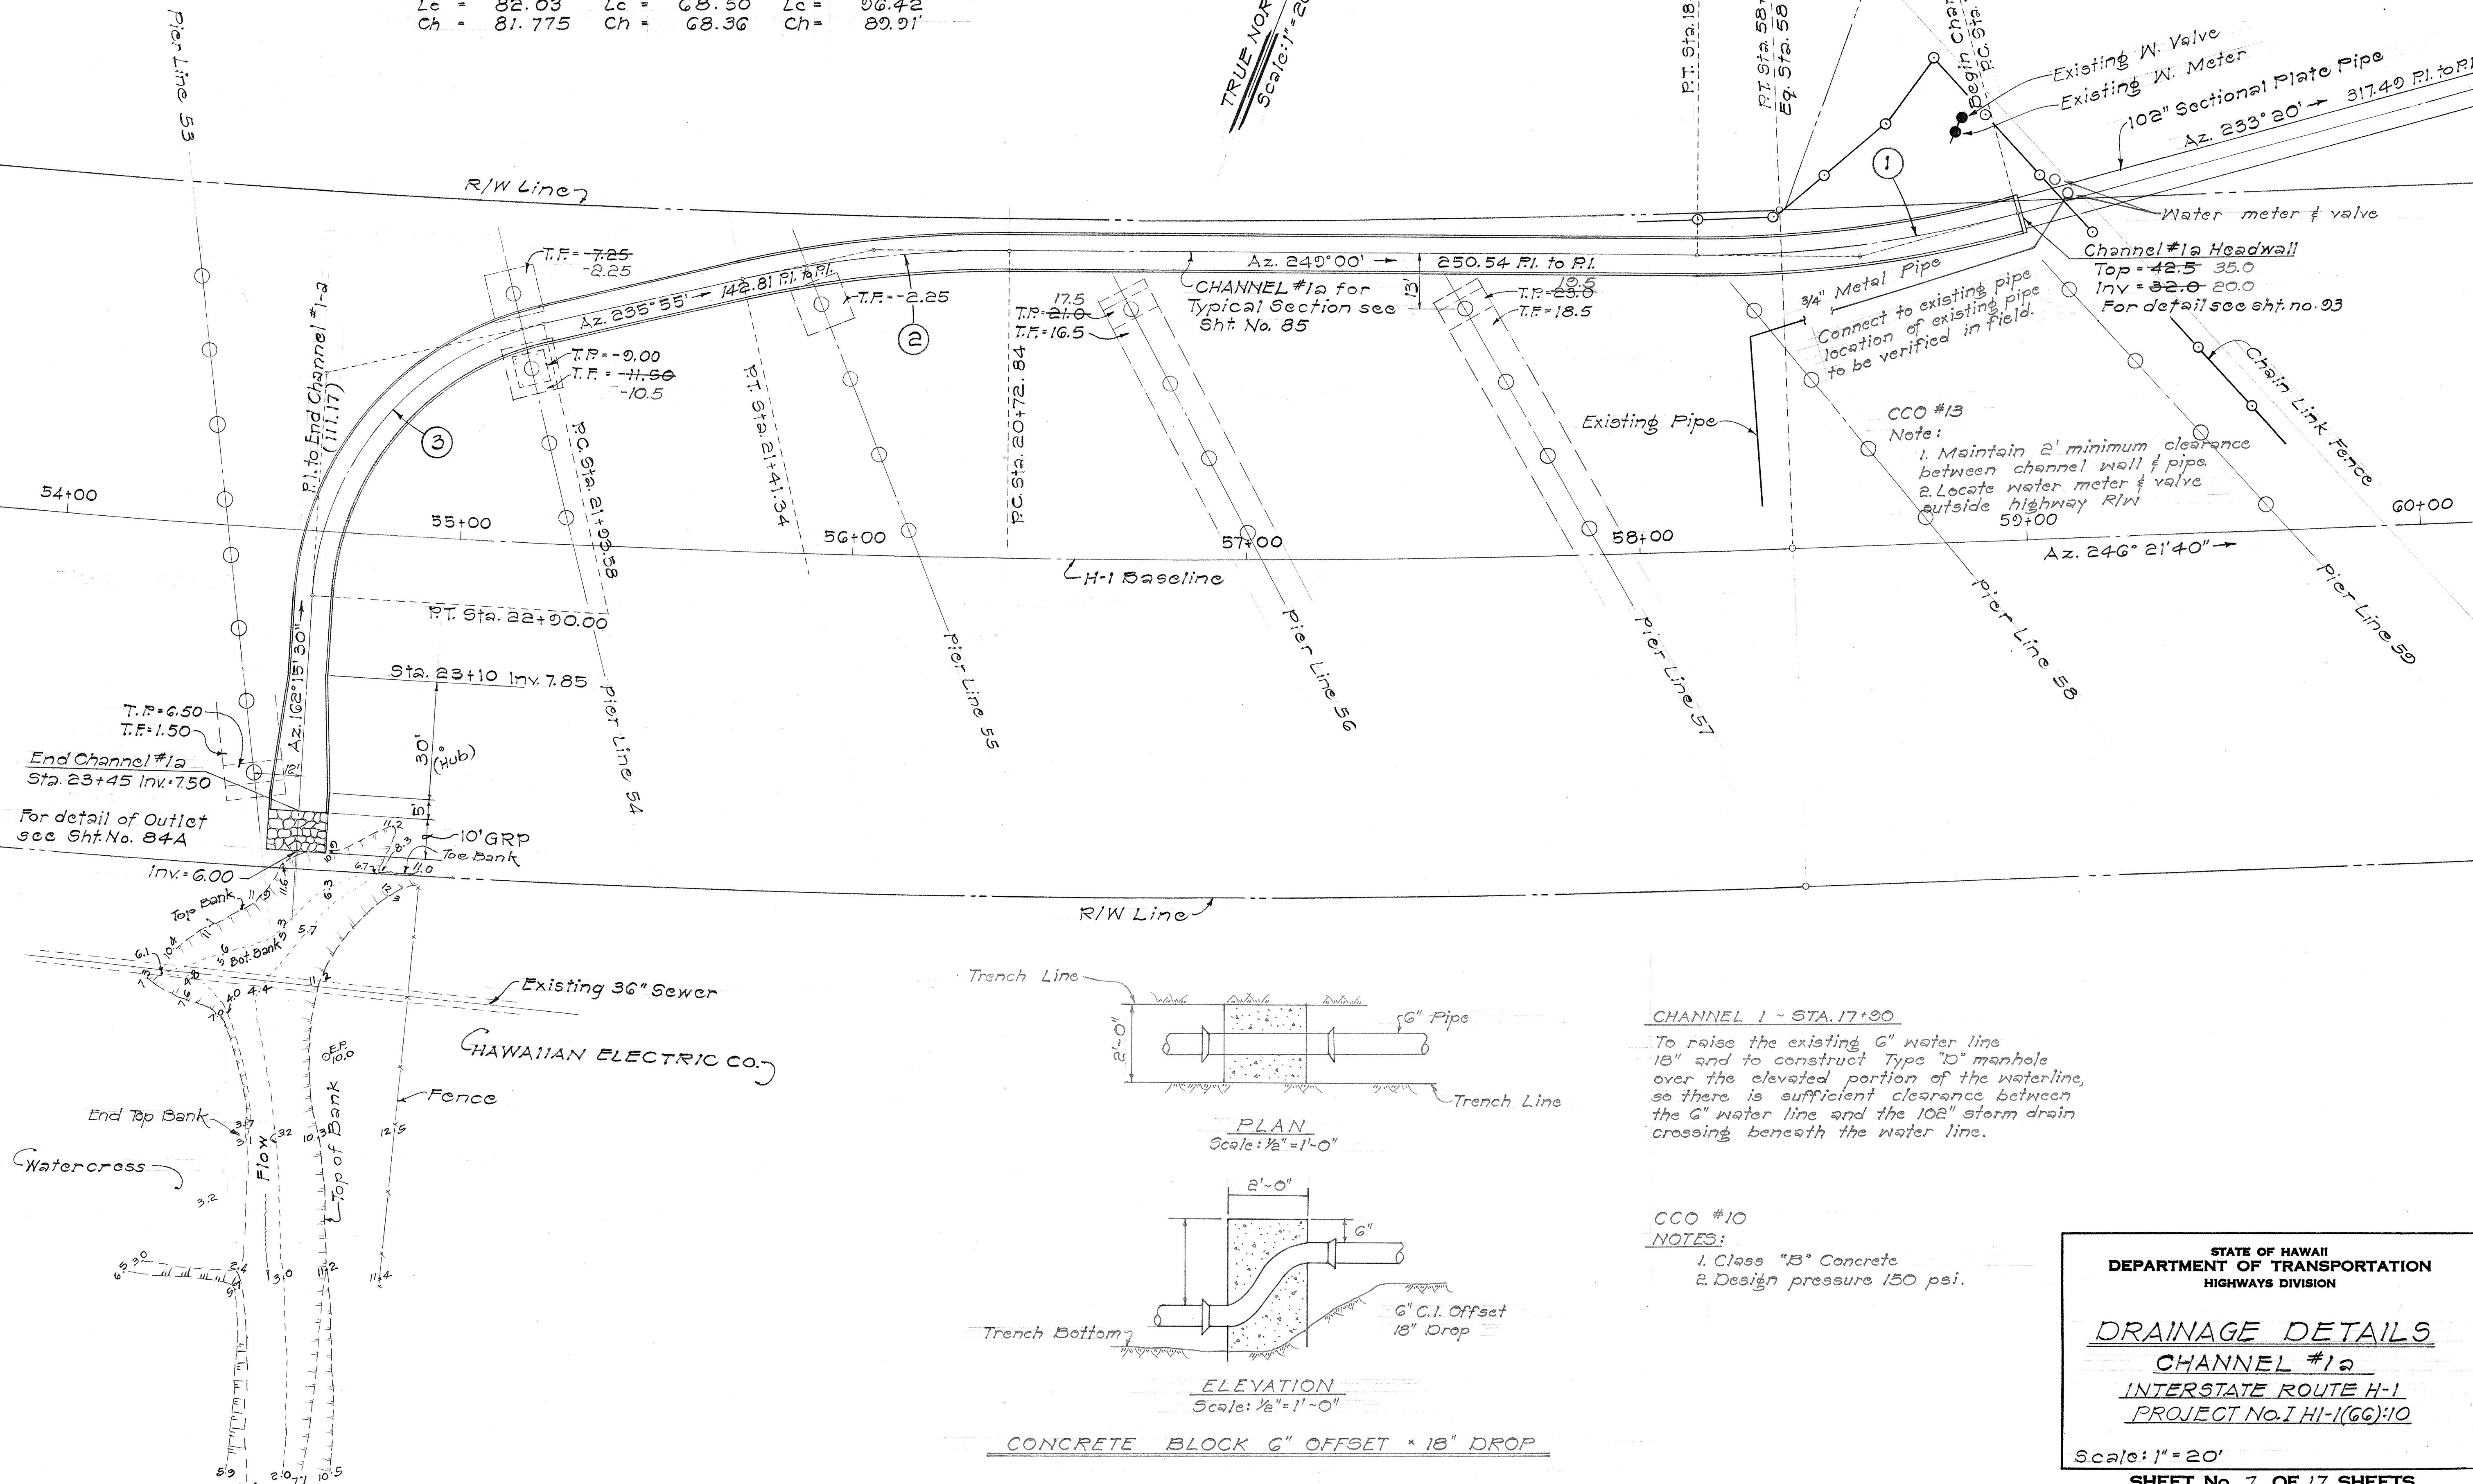


For detail of Outlet see Sht. No. 84A

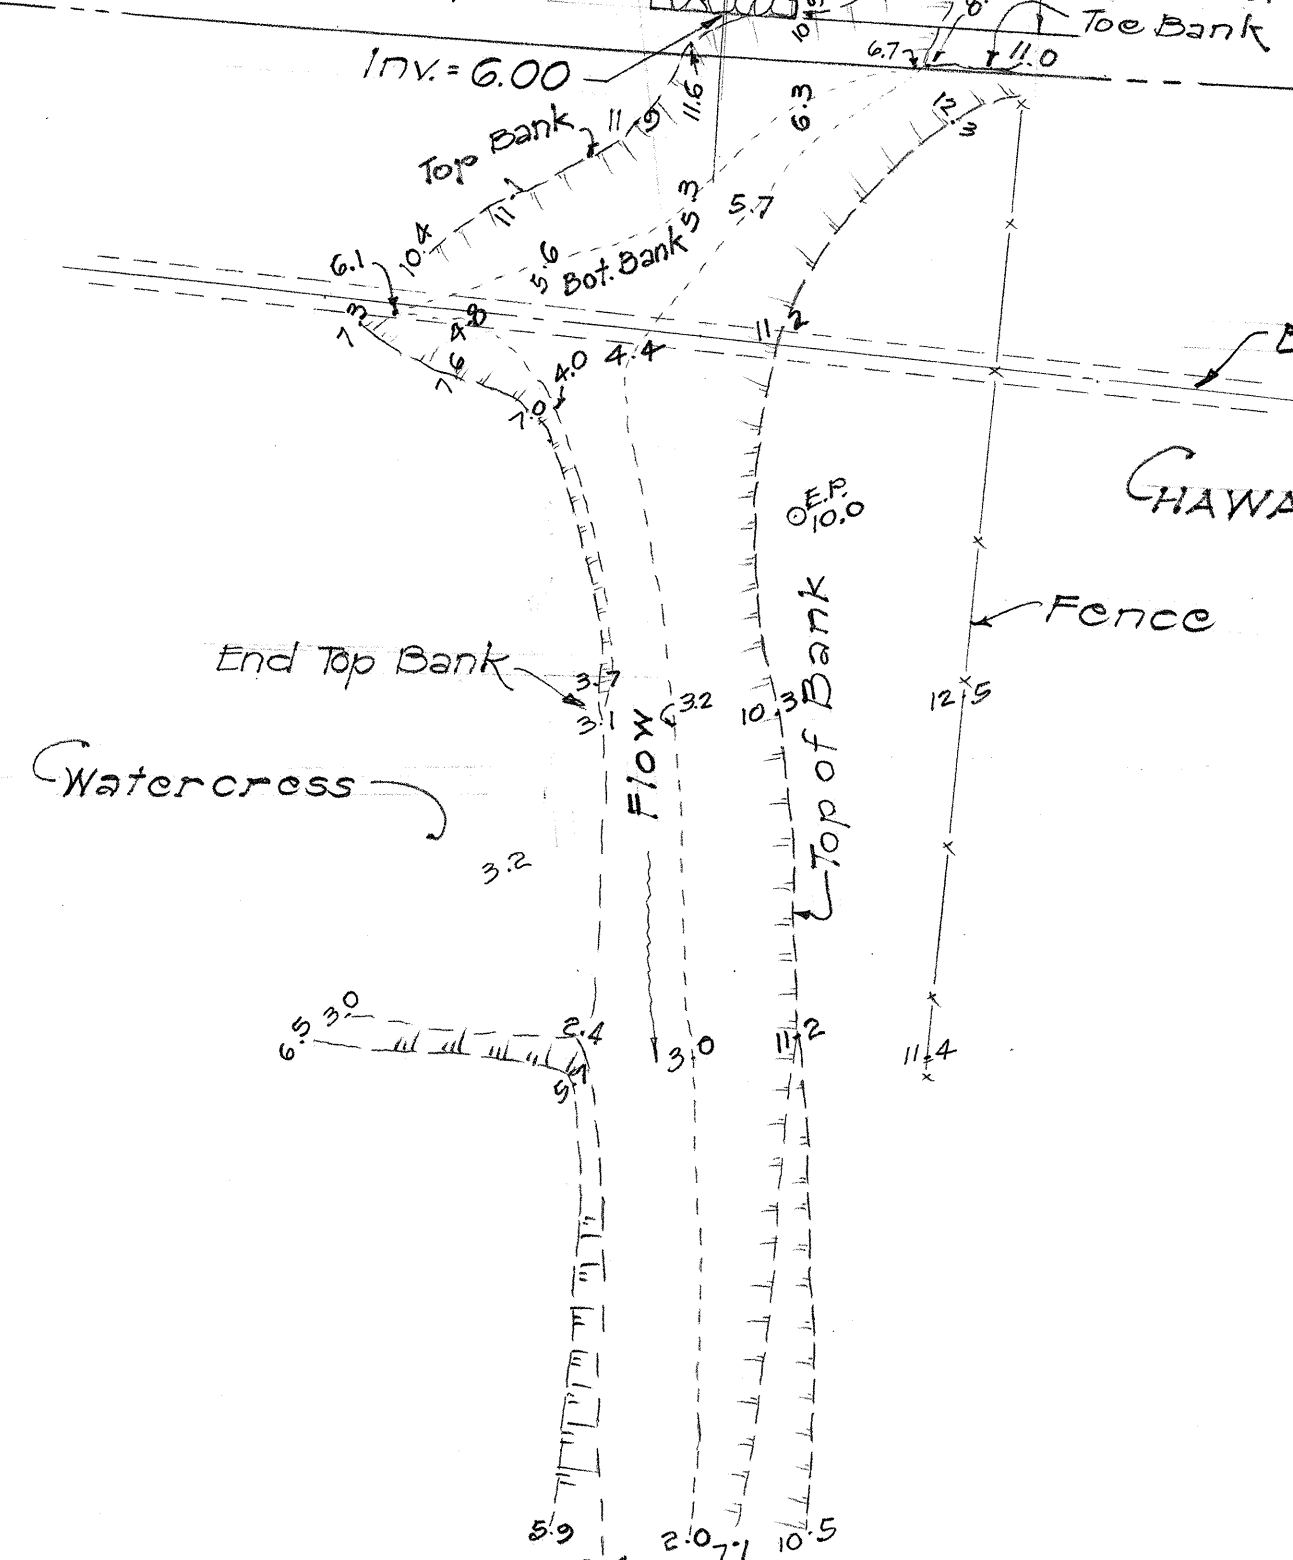

HAWAIIAN ELECTRIC CO.

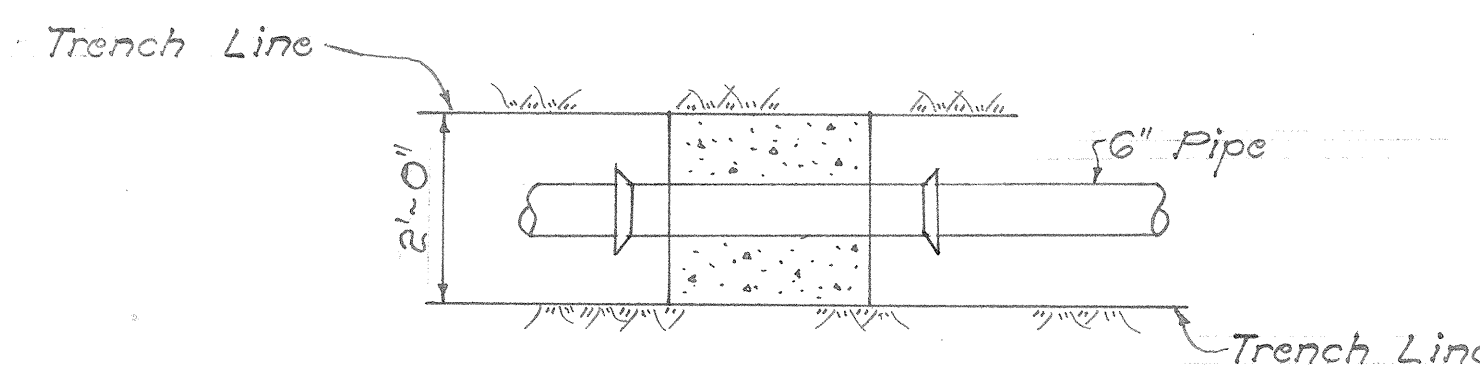

PLAN
Scale: 1/2" = 1'-0"

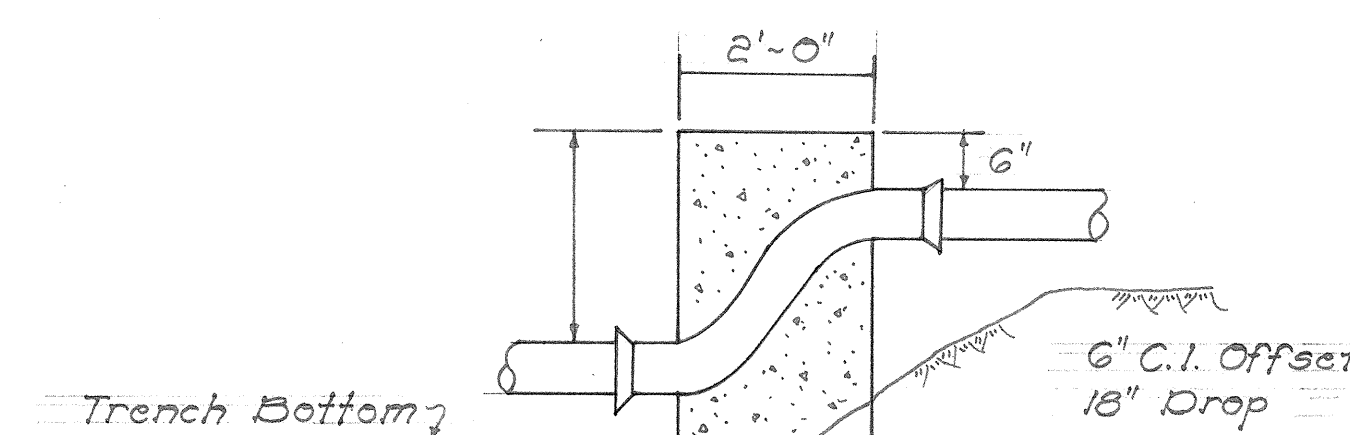

ELEVATION
Scale: 1/2" = 1'-0"

CHANNEL 1 - STA. 17+90

To raise the existing 6" water line 18" and to construct Type "D" manhole over the elevated portion of the waterline, so there is sufficient clearance between the 6" water line and the 102" storm drain crossing beneath the water line.

CCO #10

NOTES:

1. Class "B" Concrete
2. Design pressure 150 psi.

STATE OF HAWAII
DEPARTMENT OF TRANSPORTATION
HIGHWAYS DIVISION

DRAINAGE DETAILS
CHANNEL #1a
INTERSTATE ROUTE H-1
PROJECT No. I-HI-1(66)10

Scale: 1" = 20'

SHEET No. 7 OF 17 SHEETS

84

ORIGINAL PLAN	DATE
DESIGNED BY	DESIGNED BY
NOTED BY	NOTED BY
CHECKED BY	CHECKED BY


ROADWAY SCHEDULES

Roadway Lined Gutters & Ref. Sta.	TYPE	ESTIMATED QUANTITIES (L.F.)		REMARKS
3+51.87 (A) %Rt. to 13+14.20 (A) %Rt.	7B	962		
16+65 (A) %Rt. to 17+45 (A) %Rt.	7B	80		
0+21 (B) %Rt. to 3+33 (B) %Rt.	7B	312		
2+60 (C) %Rt. to 10+20 (C) %Rt.	7A	760		
4+35 (C) %Rt. to 5+70 (G) %Rt.	7B	1235		Transition 4+35 to Inlet @ 4+75
14+43 (C) %Rt. to 19+05 (C) %Rt.	7B	462		Transition - Inlet @ 18+75 to 19+05
5+75 (E) %Rt. to 19+75 (E) %Rt.	7C	1400		
3+72 (E) %Rt. to 6+54 (E) %Rt.	7B	282		
6+54 (E) %Rt. to 4+55 (H) %Rt.	7C	1225		
1+01.10 (F) %Rt. to 8+64 (F) %Rt.	7B	763		
40+35 (M-R) %Rt. to 41+48 (M-R) %Rt.	7B	113		Transition - Inlet @ 41+35 to 41+48
42+18 (M-R) %Rt. to 43+68 (M-R) %Rt.	7B	150		Transition - Inlet @ 43+50 to 43+68
46+84 (M-R) %Rt. to 49+61 (M-R) %Rt.	7B	277		Transition - Inlet @ 49+55 to 49+61
62+35 (H-I) %Rt. to 11+75 (F) %Rt.	7A	927		
90+75 (H-I) %Rt. to 102+88 (H-I) %Rt.	7C	1213		Begin Gutter Transition @ 102+88
103+25 (H-I) %Rt. to 110+65 (H-I) %Rt.	7A	740		
124+00 (H-I) %Rt. to 145+45 (H-I) %Rt.	7C	2145		Begin Gutter Transition @ 145+45
146+00 (H-I) %Rt. to 149+25 (H-I) %Rt.	7A	325		
149+75 (H-I) %Rt. to 163+00 (H-I) %Rt.	7C	1325		Begin Gutter Transition @ 163+00
169+50 (H-I) %Rt. to 179+34 (H-I) %Rt.	7C	984		Begin Gutter Transition @ 169+50
77+50 (H-I) %Rt. to 81+75 (H-I) %Rt.	7B	425		Begin Gutter Transition @ 78+00
82+75 (H-I) %Rt. to 89+25 (H-I) %Rt.	7A	650		
90+25 (H-I) %Rt. to 101+65 (H-I) %Rt.	7C	1140		Begin Gutter Transition @ 101+65
102+15 (H-I) %Rt. to 110+65 (H-I) %Rt.	7A	850		
124+00 (H-I) %Rt. to 144+70 (H-I) %Rt.	7C	2070		Begin Gutter Transition @ 144+70
145+25 (H-I) %Rt. to 149+25 (H-I) %Rt.	7A	400		
149+75 (H-I) %Rt. to 162+20 (H-I) %Rt.	7C	1315		Begin Gutter Transition @ 162+20
163+25 (H-I) %Rt. to 168+75 (H-I) %Rt.	7A	550		
169+30 (H-I) %Rt. to 172+32 (H-I) %Rt.	7C	302		Begin Gutter Transition @ 169+30
172+92 (H-I) %Rt. to 188+50 (H-I) %Rt.	7A	1558		
179+36 (H-I) %Rt. to 187+00 (H-I) %Rt.	7A	764		
Gutter Transition & Reference Stations				
78+00 %Rt. to 77+00 %Rt.		100		
101+65 %Rt. to 102+15 %Rt.		50		
102+88 %Rt. to 103+28 %Rt.		40		
144+70 %Rt. to 145+20 %Rt.		50		
145+45 %Rt. to 145+95 %Rt.		50		
162+20 %Rt. to 163+40 %Rt.		50		
163+00 %Rt. to 163+50 %Rt.		50		
169+30 %Rt. to 168+80 %Rt.		50		
169+50 %Rt. to 169+28 %Rt.		22		
Gutter Connection & Reference Stations				
82+75 %Rt. to 81+75 %Rt.		100		
89+25 %Rt. to 90+25 %Rt.		100		
149+25 %Rt. to 149+75 %Rt.		50		
149+25 %Rt. to 149+75 %Rt.		50		
172+35 %Rt. to 172+92 %Rt.		60		


NOTES:

- Reverse plan view when flow is in direction opposite to that shown.
- The spillway shall not be a part of this contract.
- Where Guard Rail is to be installed in the concrete gutter section a 10"x10" size opening shall be provided in the slab at the Guard Rail post location. After the Guard Rail Post has been placed in position, the remaining portion of the opening shall be filled with asphaltic concrete Mix V (Asphaltic concrete to be incidental to Class "B" concrete).
- Type 7A, 7B & 7C Gutters shall be paid for by the linear feet.


- Where Guardrail Post is to be installed in A.C. Gutter section the post shall be driven through the asphalt. Any damage done to the asphalt during this operation shall be repaired by the contractor at his expense.
- Payment for gutter transitions and gutter connections shall be paid for by the linear ft. and considered as Type 7C Gutter.
- All wire mesh reinforcing shall be incidental to the concrete lining.

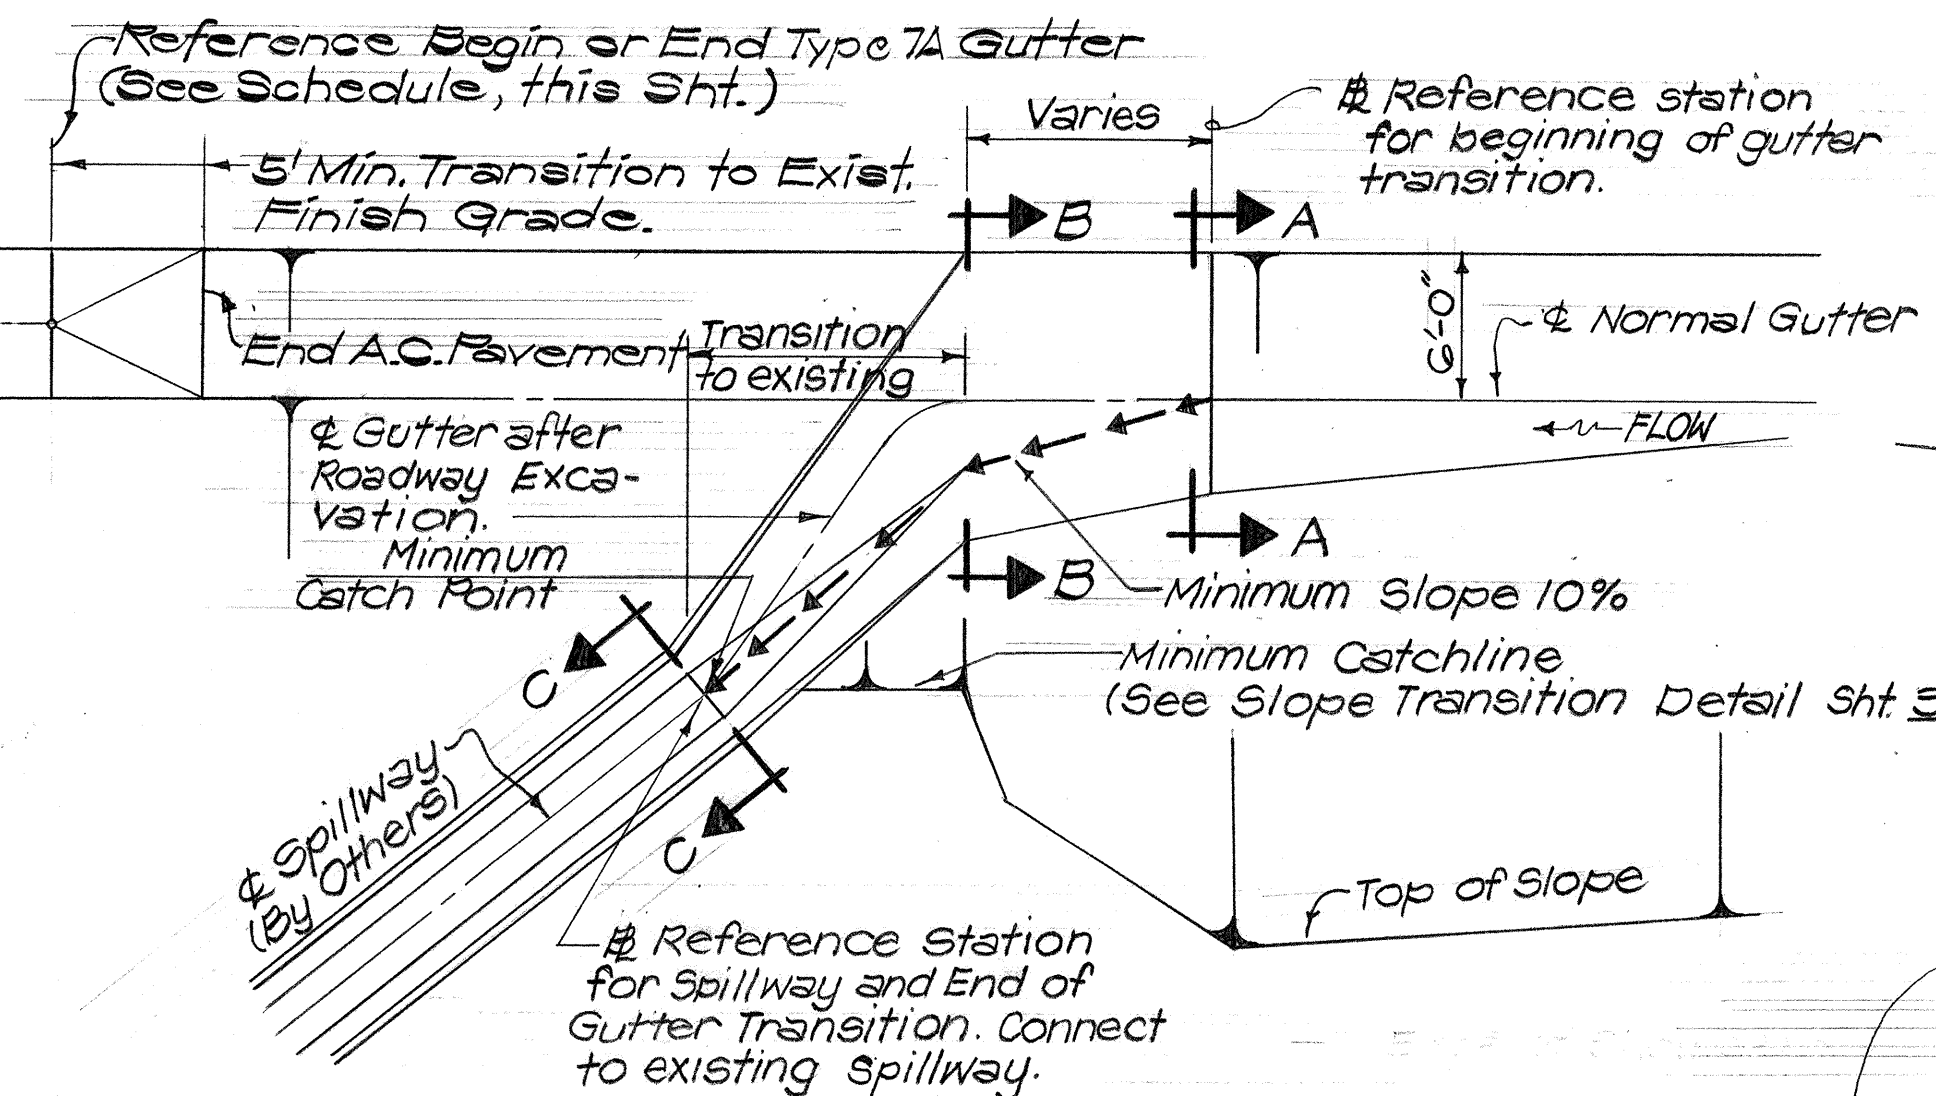

PLAN
Not To Scale

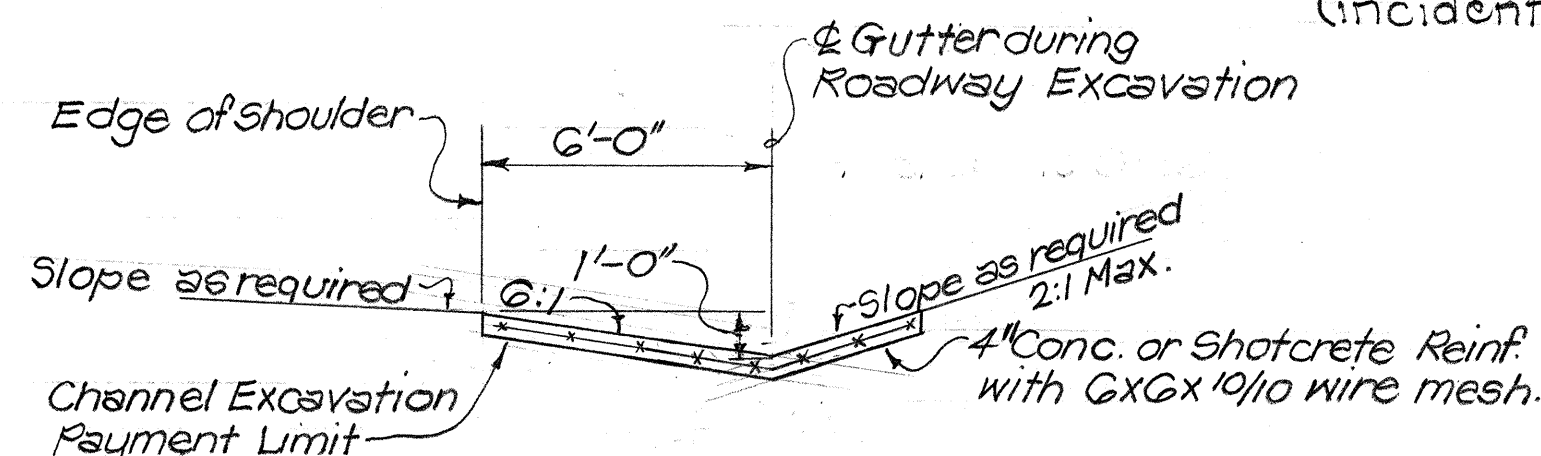


SECTION "A-A"
Scale: 1/4" = 1'-0"

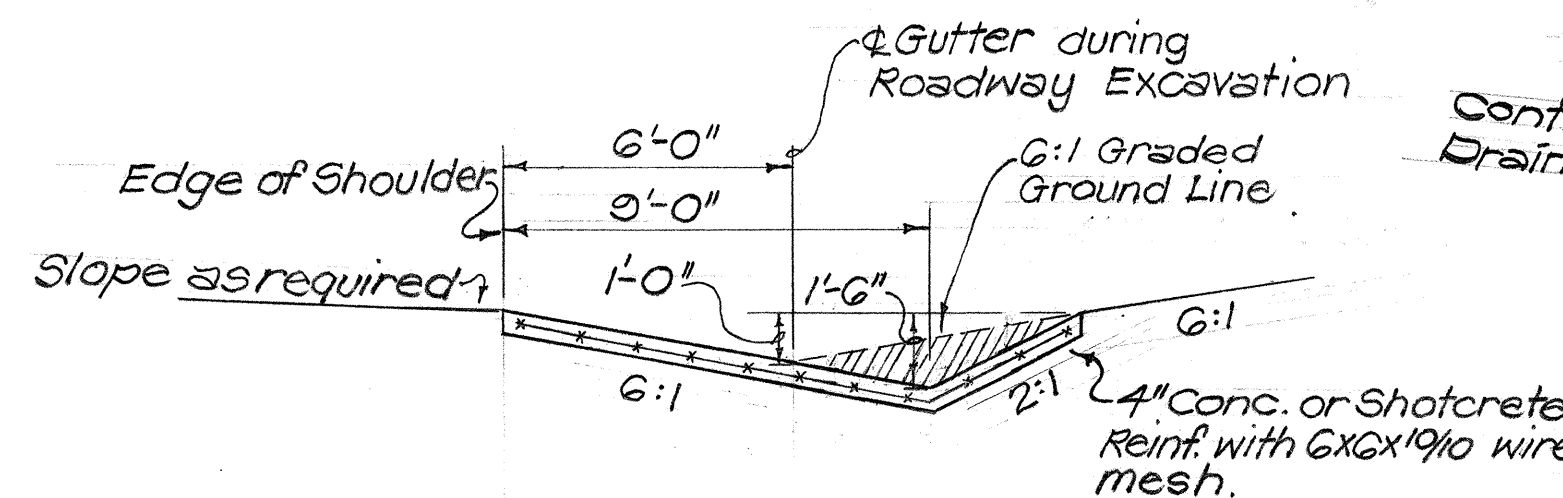



SECTION "B-B"
Scale: 1/4" = 1'-0"

GUTTER TRANSITION
Scale As Shown.


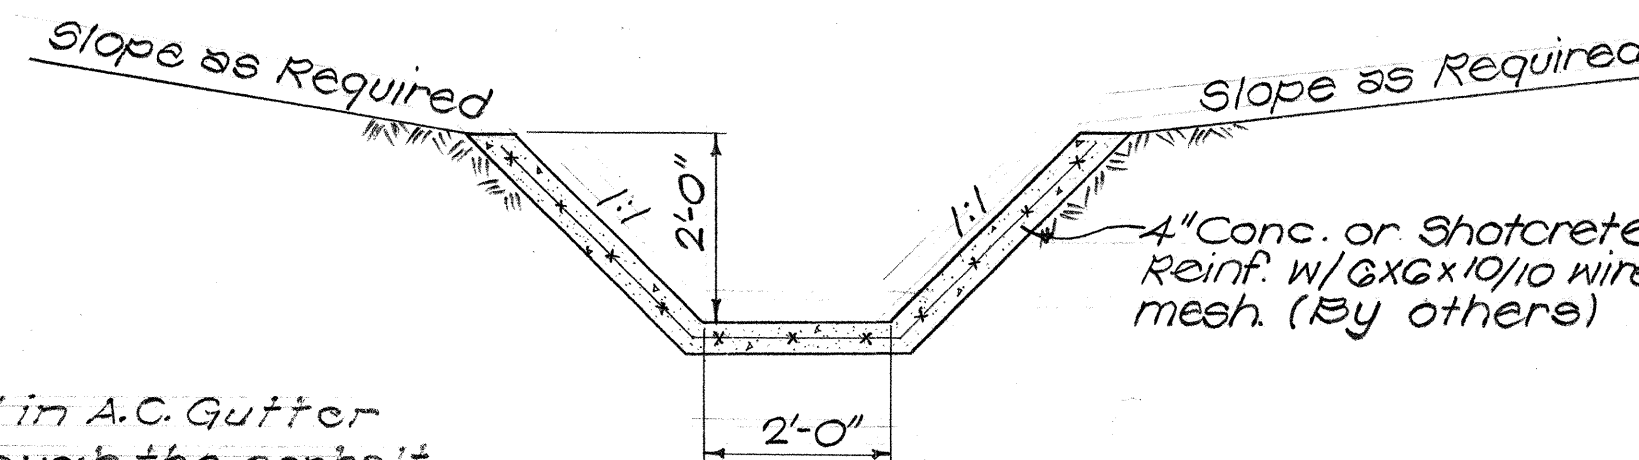


SECTION "C-C"
TYPICAL SPILLWAY SECTION
(BY OTHERS)
Scale: 1/2" = 1'-0"

FED. ROAD DIST. NO.	STATE	FED. AID PROJ. NO.	FISCAL YEAR	SHEET NO.	TOTAL SHEETS
HAWAII	HAW.	I-41-(GQ)10 I-41-(G7)10	1970	86	97

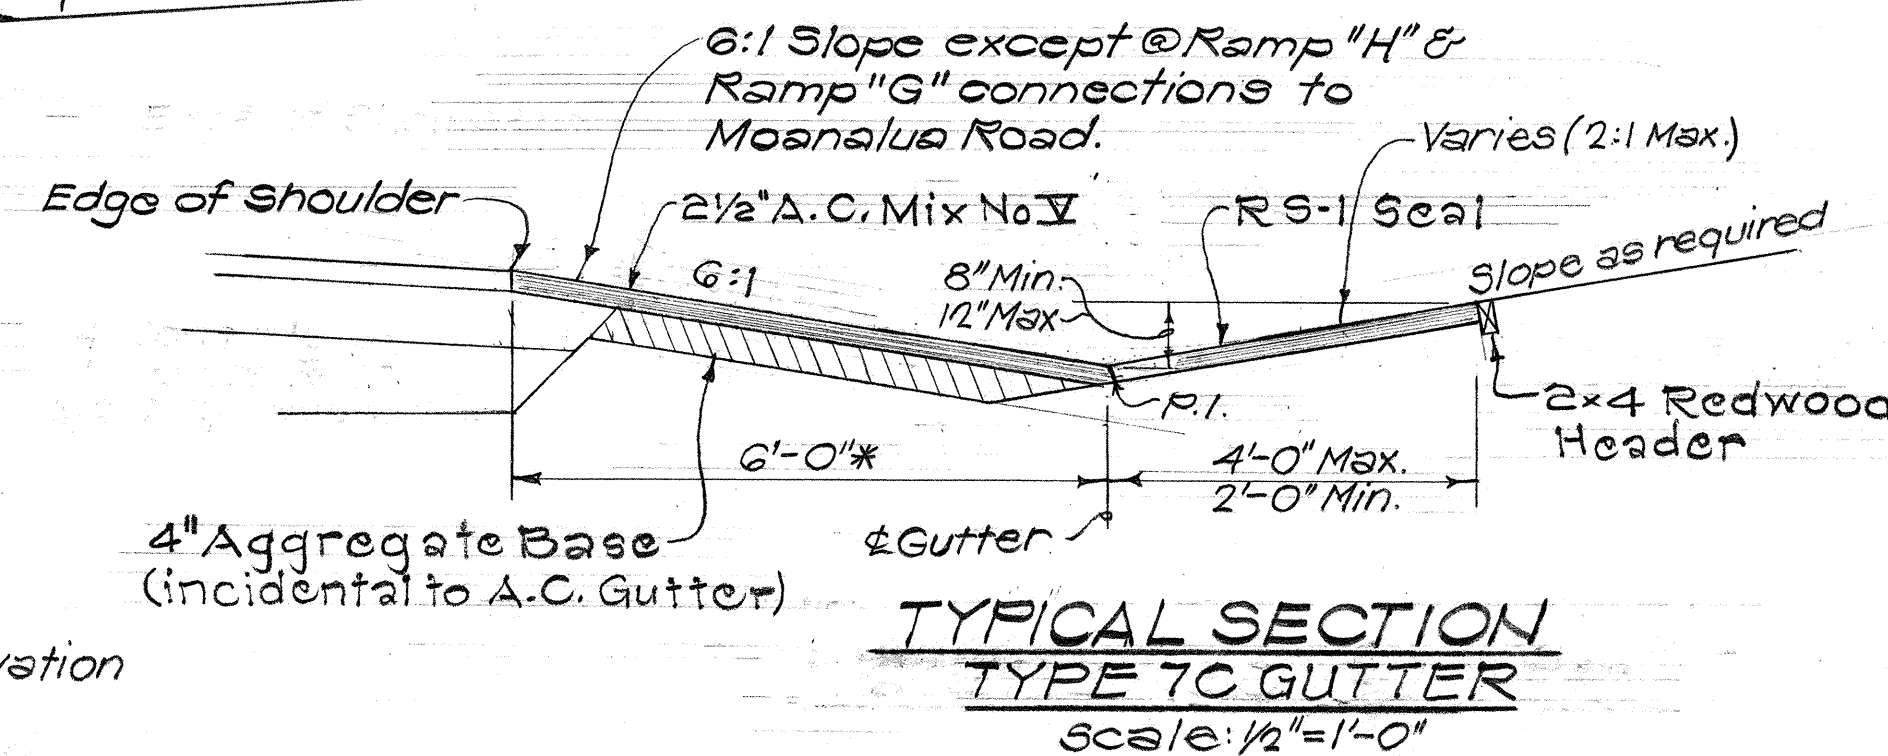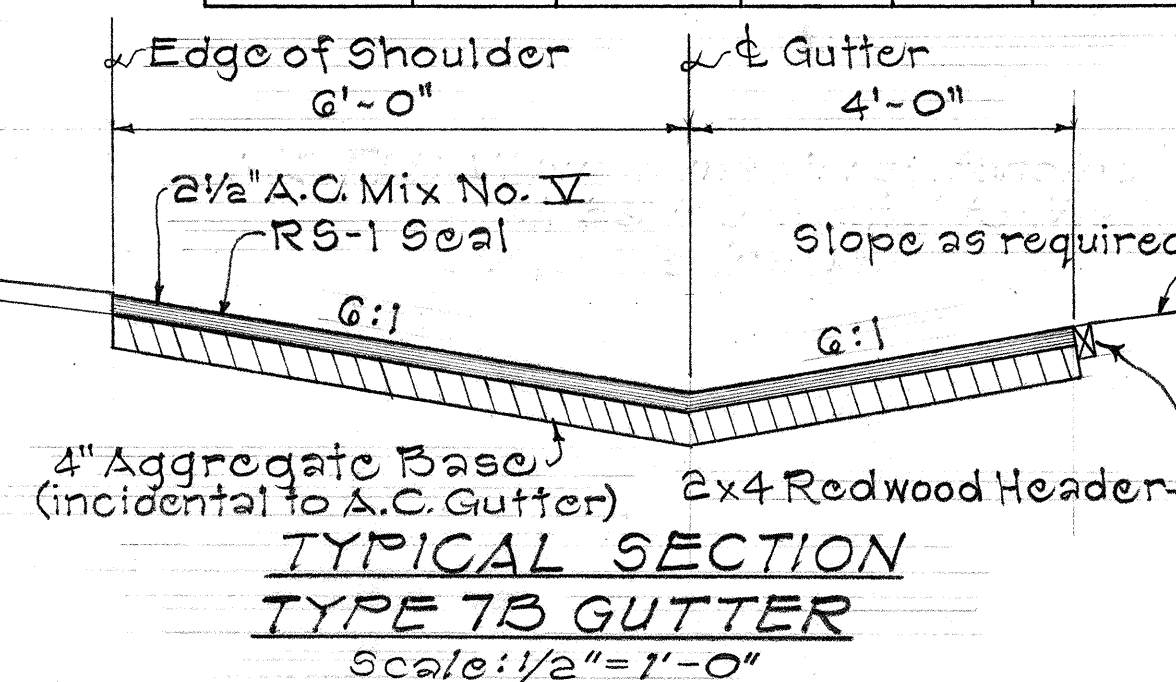

* Dimension varies at the connection to the Moanalua Separation Structure Wing Wall. (See detail sht. 24).

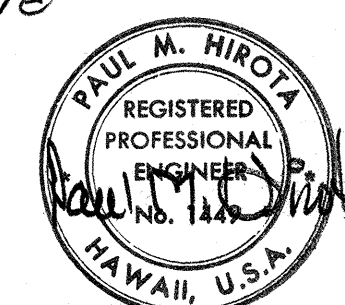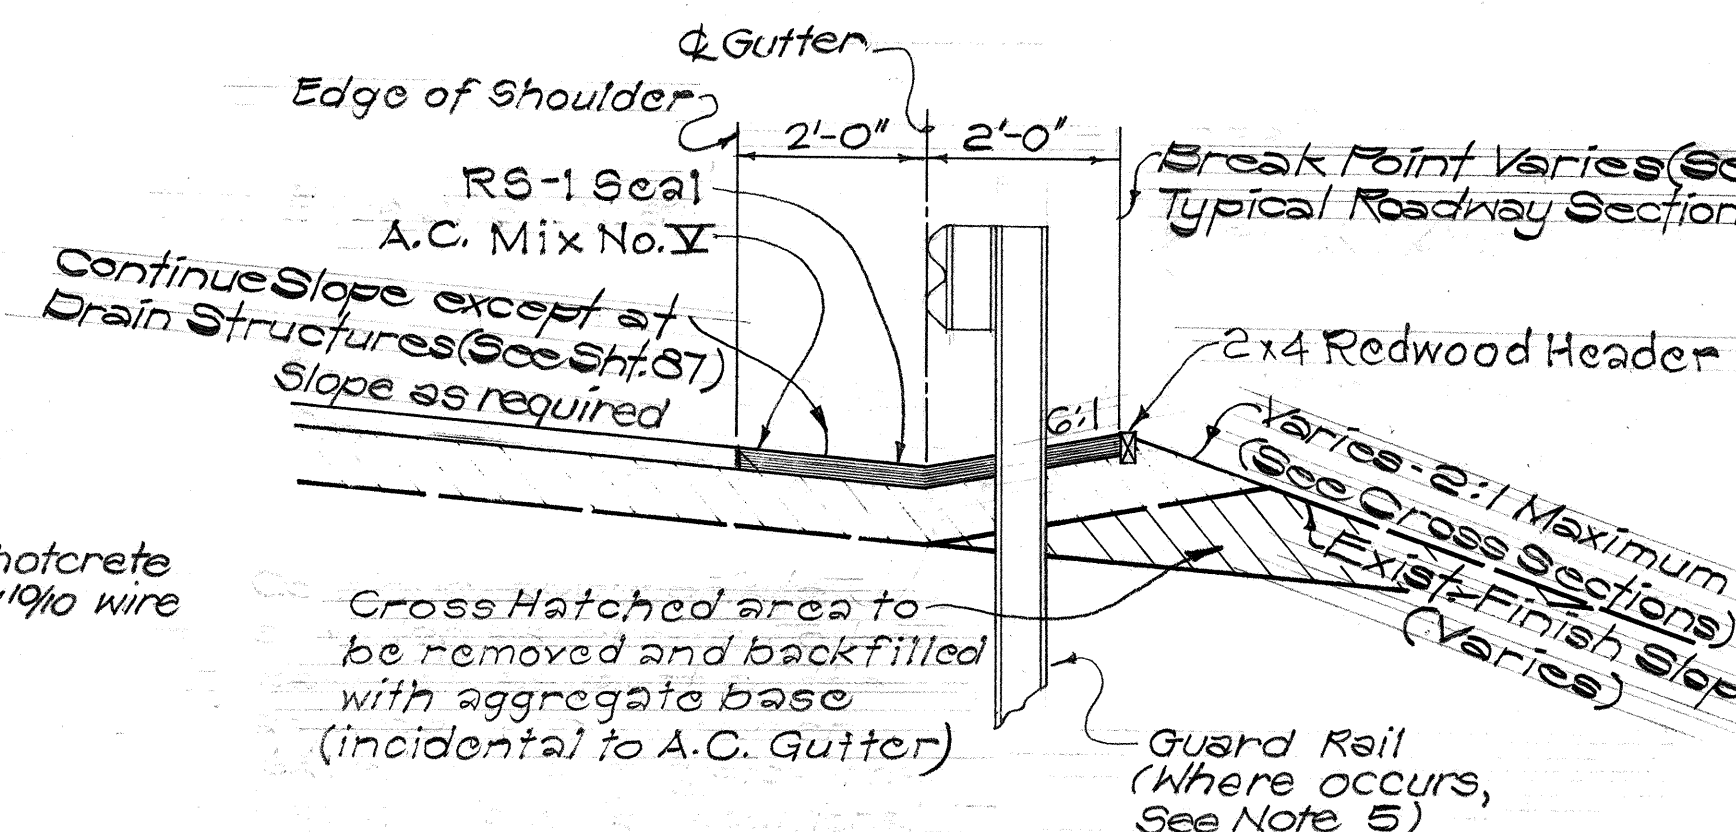

THIS WORK WAS PREPARED BY ME OR UNDER MY SUPERVISION.

STATE OF HAWAII
DEPARTMENT OF TRANSPORTATION
HIGHWAYS DIVISION

DRAINAGE DETAILS

INTERSTATE ROUTE H-1
PROJ. NO. I-41-(GQ)10

Scale: As Shown Date: _____
SHEET No. 10 OF 17 SHEETS

FED. ROAD DIST. NO.	STATE	FED. AID PROJ. NO.	FISCAL YEAR	SHEET NO.	TOTAL SHEETS
HAWAII	HAW.	I-HI-1(66)-10 I-HI-1(67)-10	1970	88	97

GENERAL NOTES

- Grates and Frames shall be hot dip galvanized after fabrication, see specifications.
- All welds $\frac{3}{8}$ " unless otherwise noted.
- Refer to "Spacing Table" for Types 61612 & 61613 Drop Intake and Frame & Grates dimensions.
- The Frame & Grate materials shall conform to the specifications of ASTM Designation Structural Steel A283, Grade D and the Standard Specifications.
- Culvert shall leave Drop Intake from any position and any direction indicated by plans or ordered by the Engineer. Culverts may both enter and leave Drop Intake so that Drop Intake will act as manhole.
- Where 61612 Inlets are installed at Type 7A gutter sections provide 25' minimum transition up and down stream of the structure. See sheet 87 for transition details.

SPACING TABLE					
TYPE	NO. BARS	A	B	C	D
61612	11	2'-0"	1'-11½"	1¼"	1'-6"
61613	17	3'-0"	2'-11½"	1⅛"	2'-0"


STATE OF HAWAII
DEPARTMENT OF TRANSPORTATION
HIGHWAYS DIVISION

DRAINAGE DETAIL DETAILS OF 61612 & 61613 DROP INTAKE

INTERSTATE ROUTE H-1
PROJ. NO. I-HI-1(66)-10


Scales: As Noted Date:

SHEET No. 12 OF 17 SHEETS

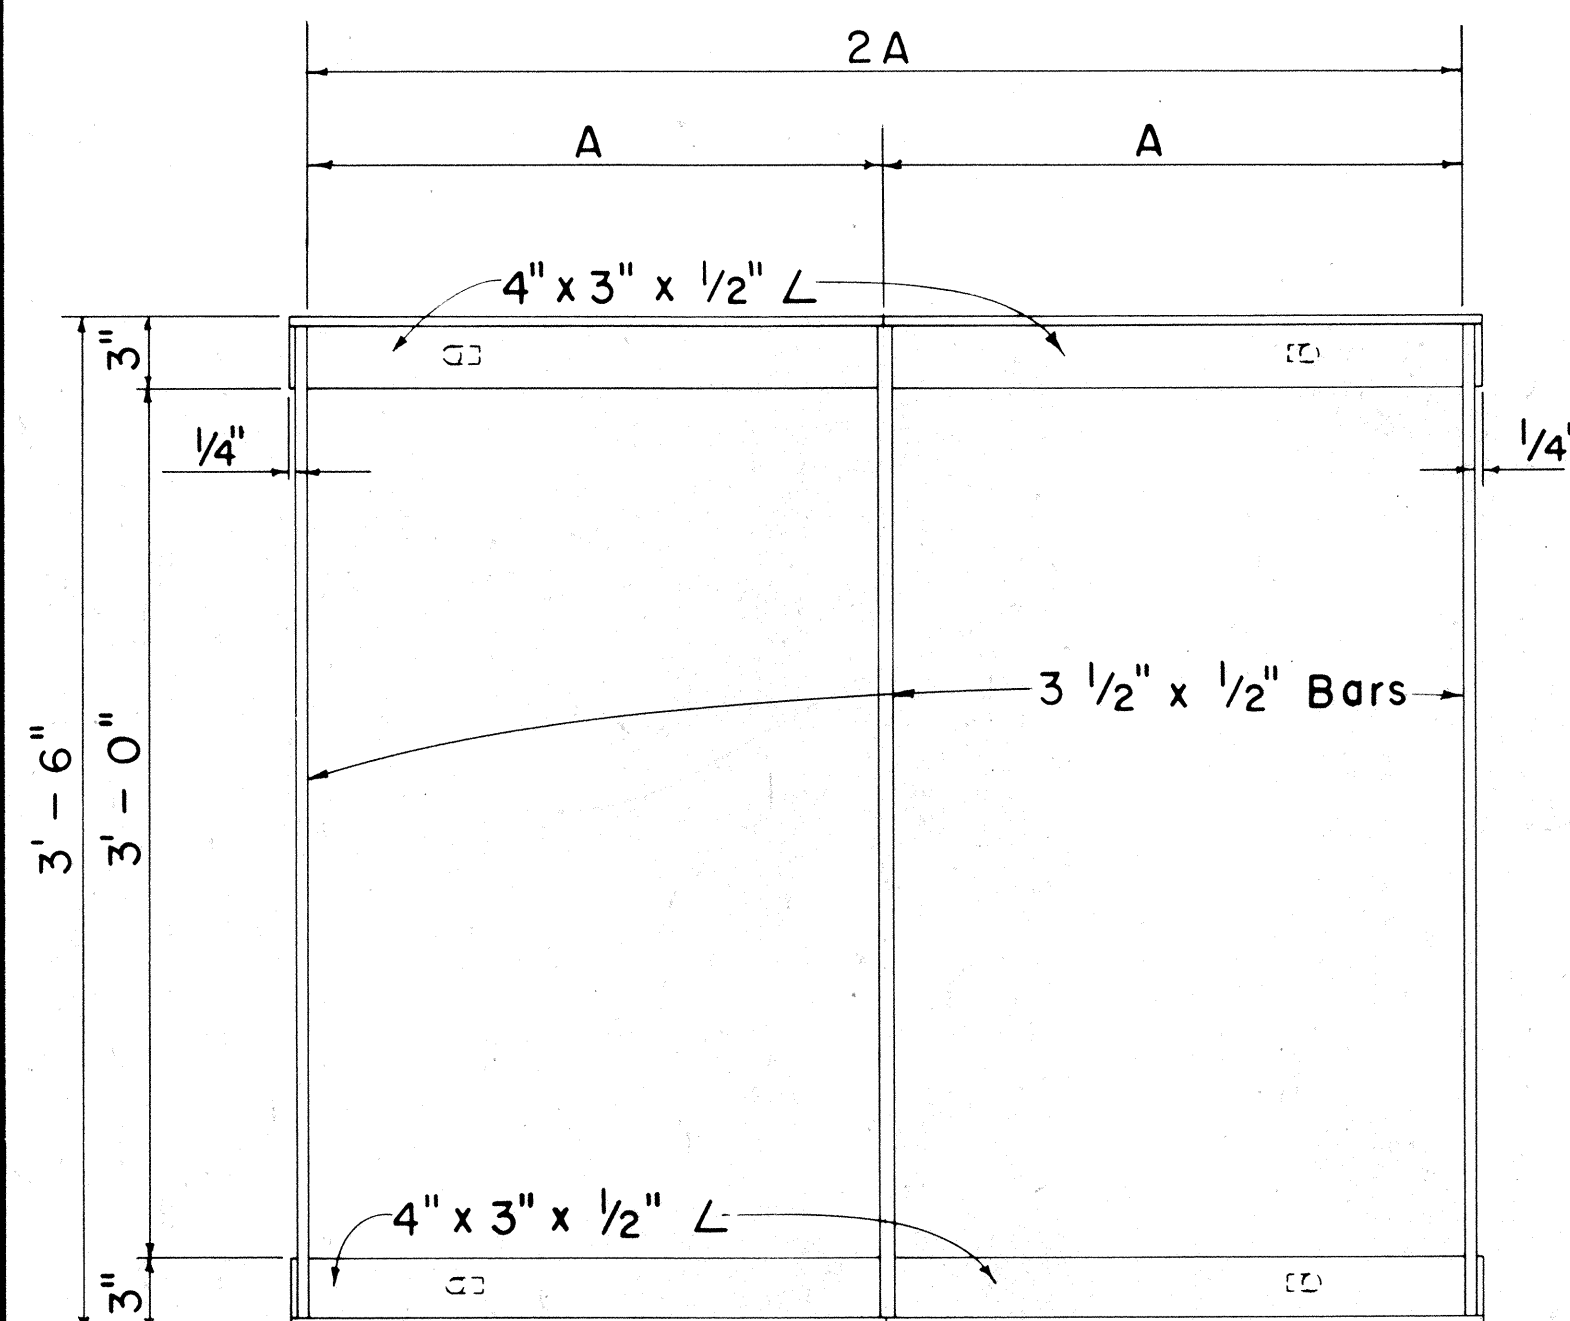


PLAN

Scale: 1 1/2" = 1'-0"

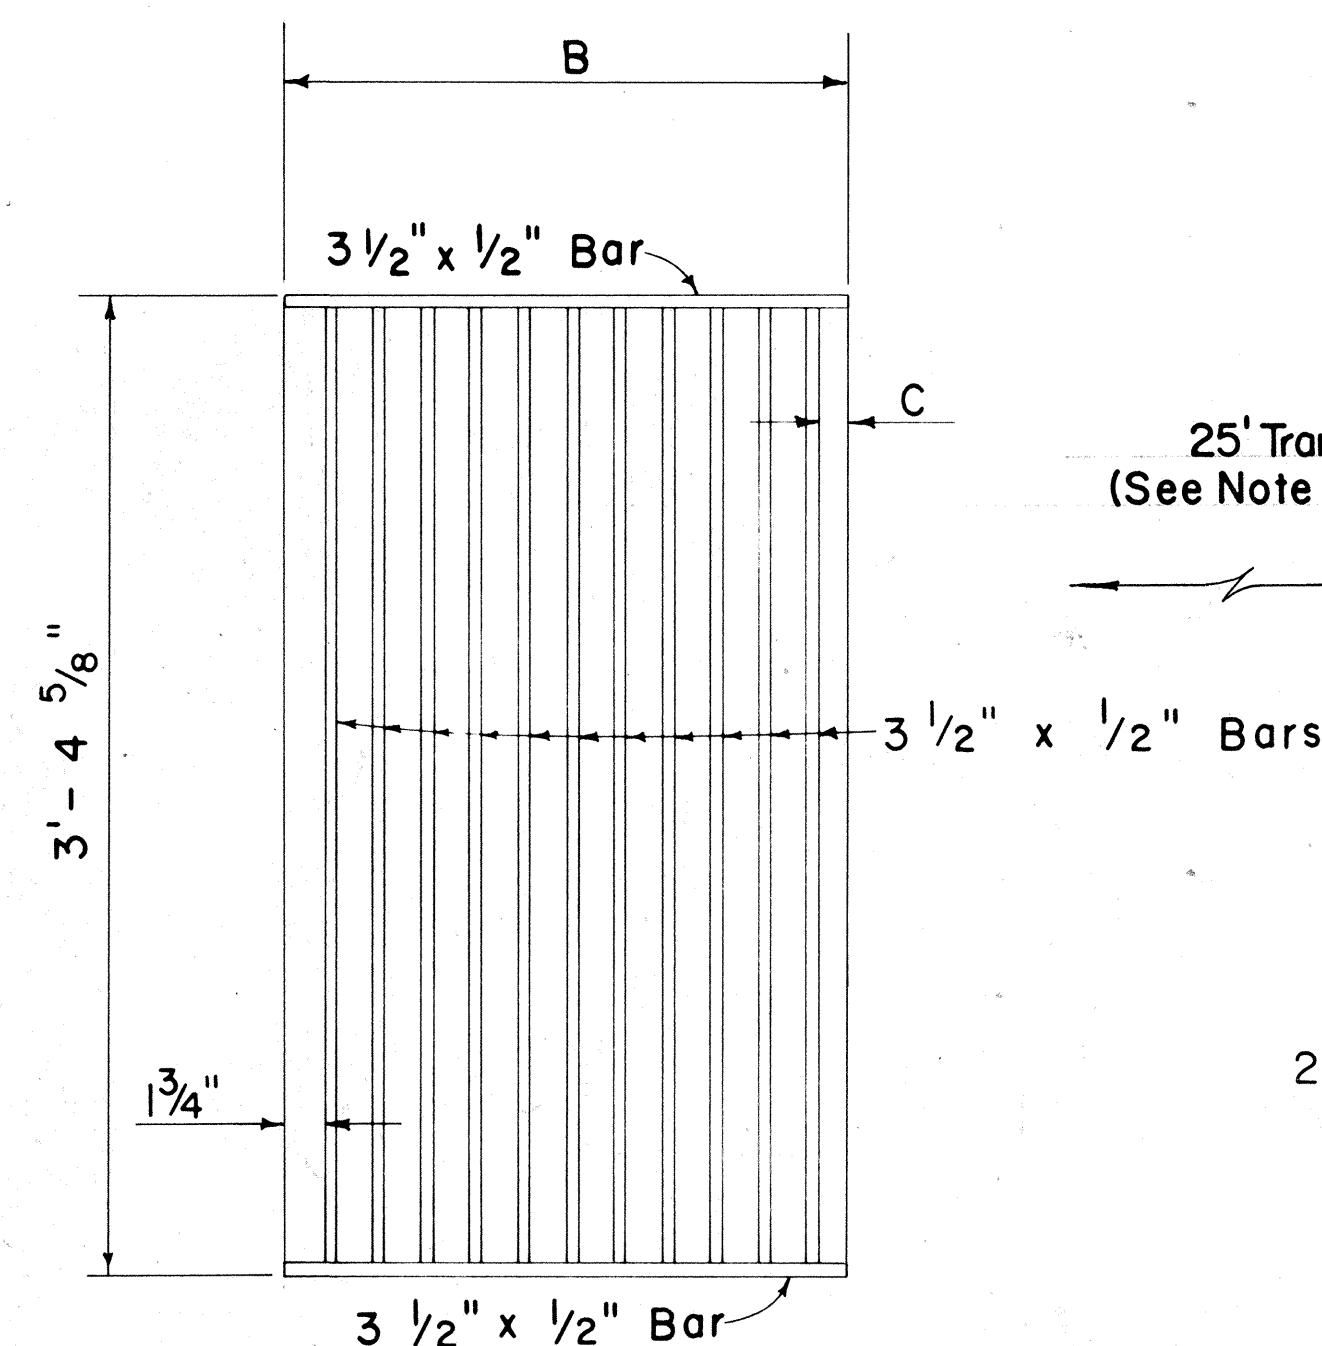


PLAN

Scale: 1 1/2" = 1'-0"

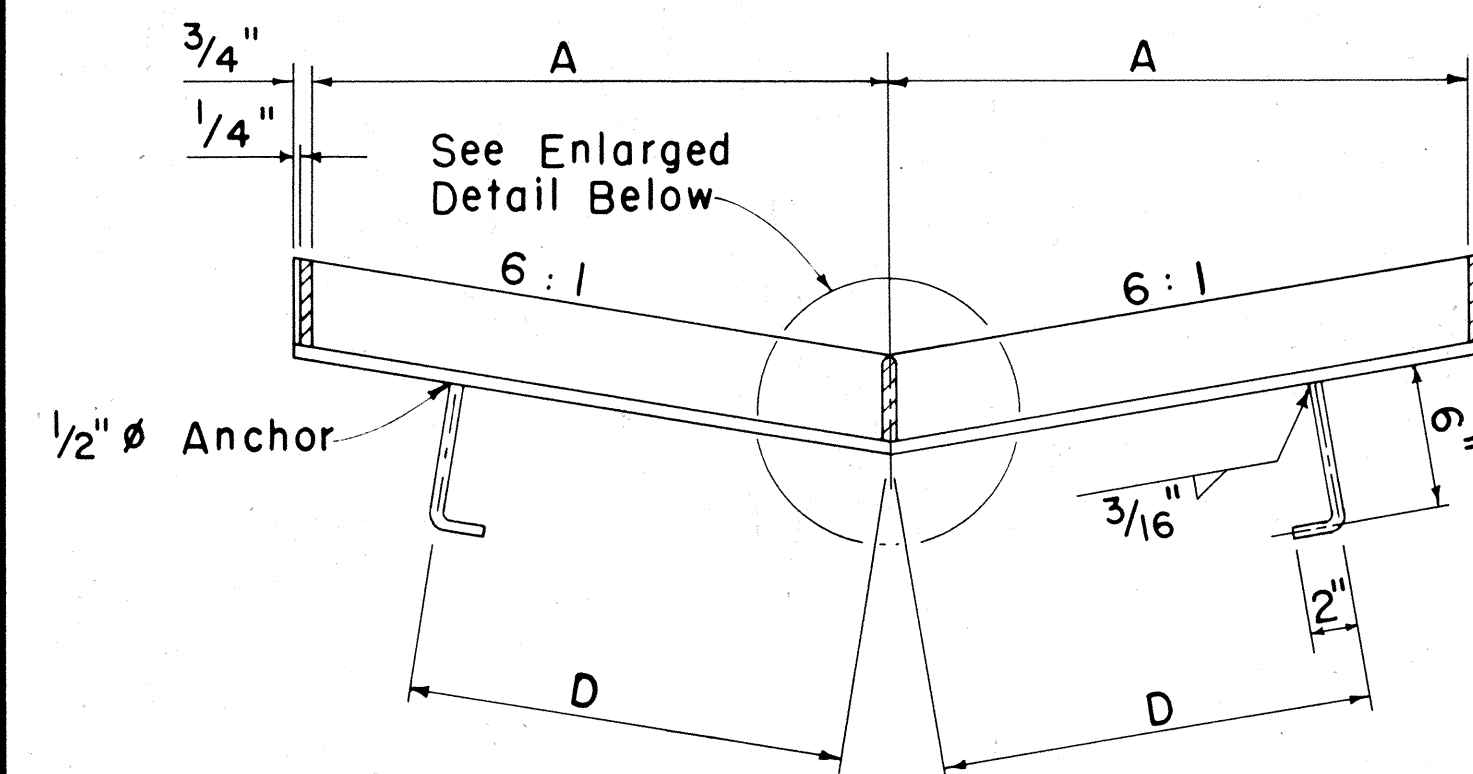


SECTION

Scale: 1 1/2" = 1'-0"

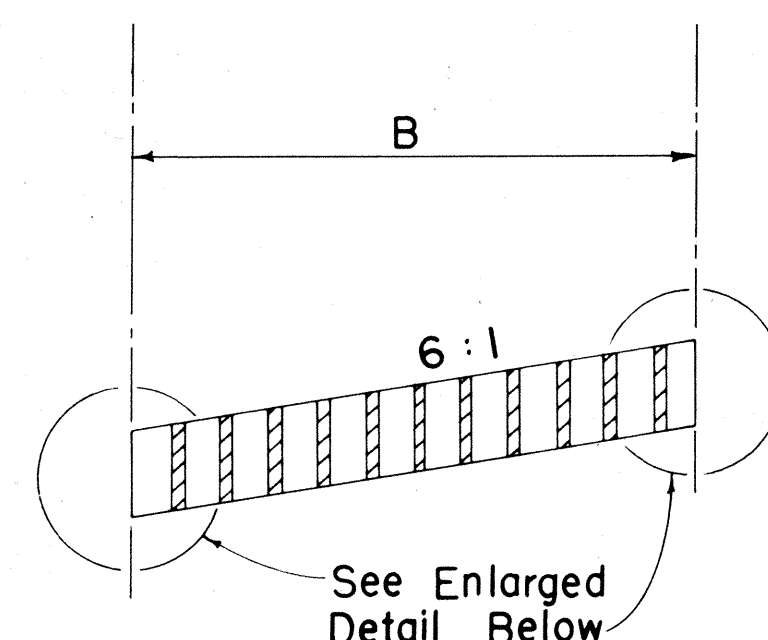


SECTION

Scale: 1 1/2" = 1'-0"

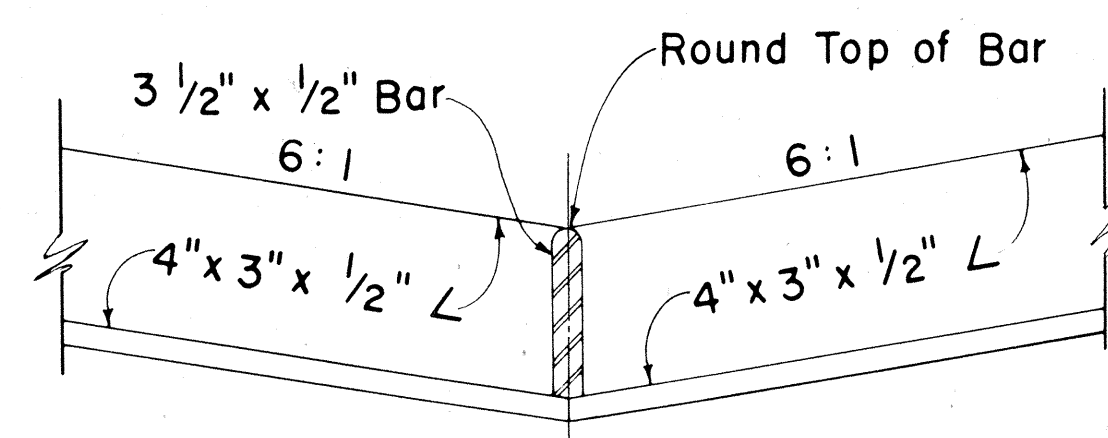


FRAME

Scale: 3" = 1'-0"

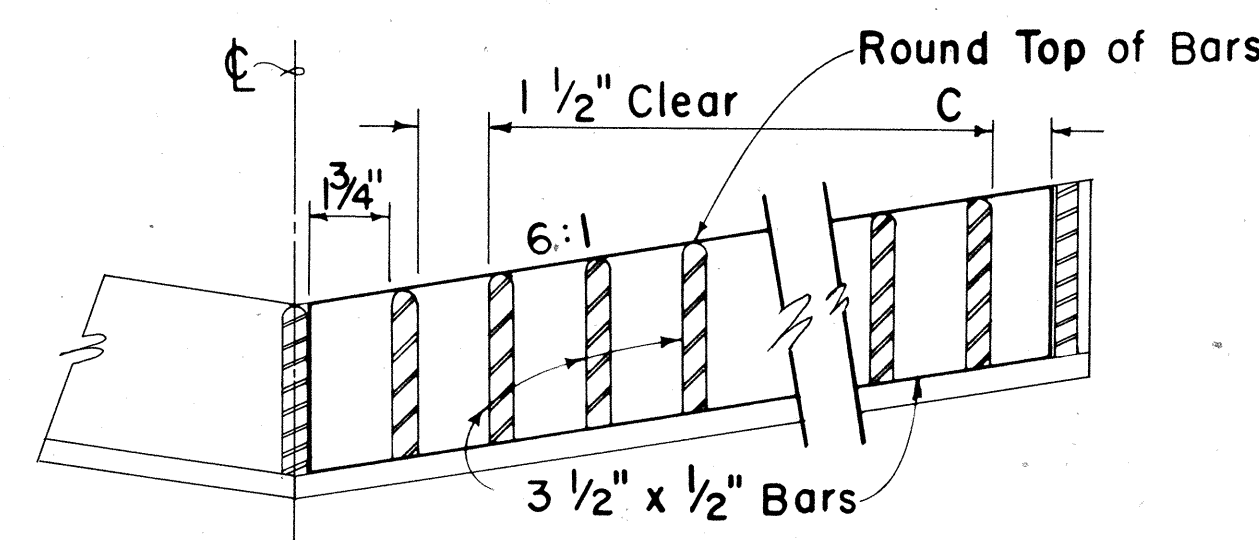


GRATE

Scale: 3" = 1'-0"

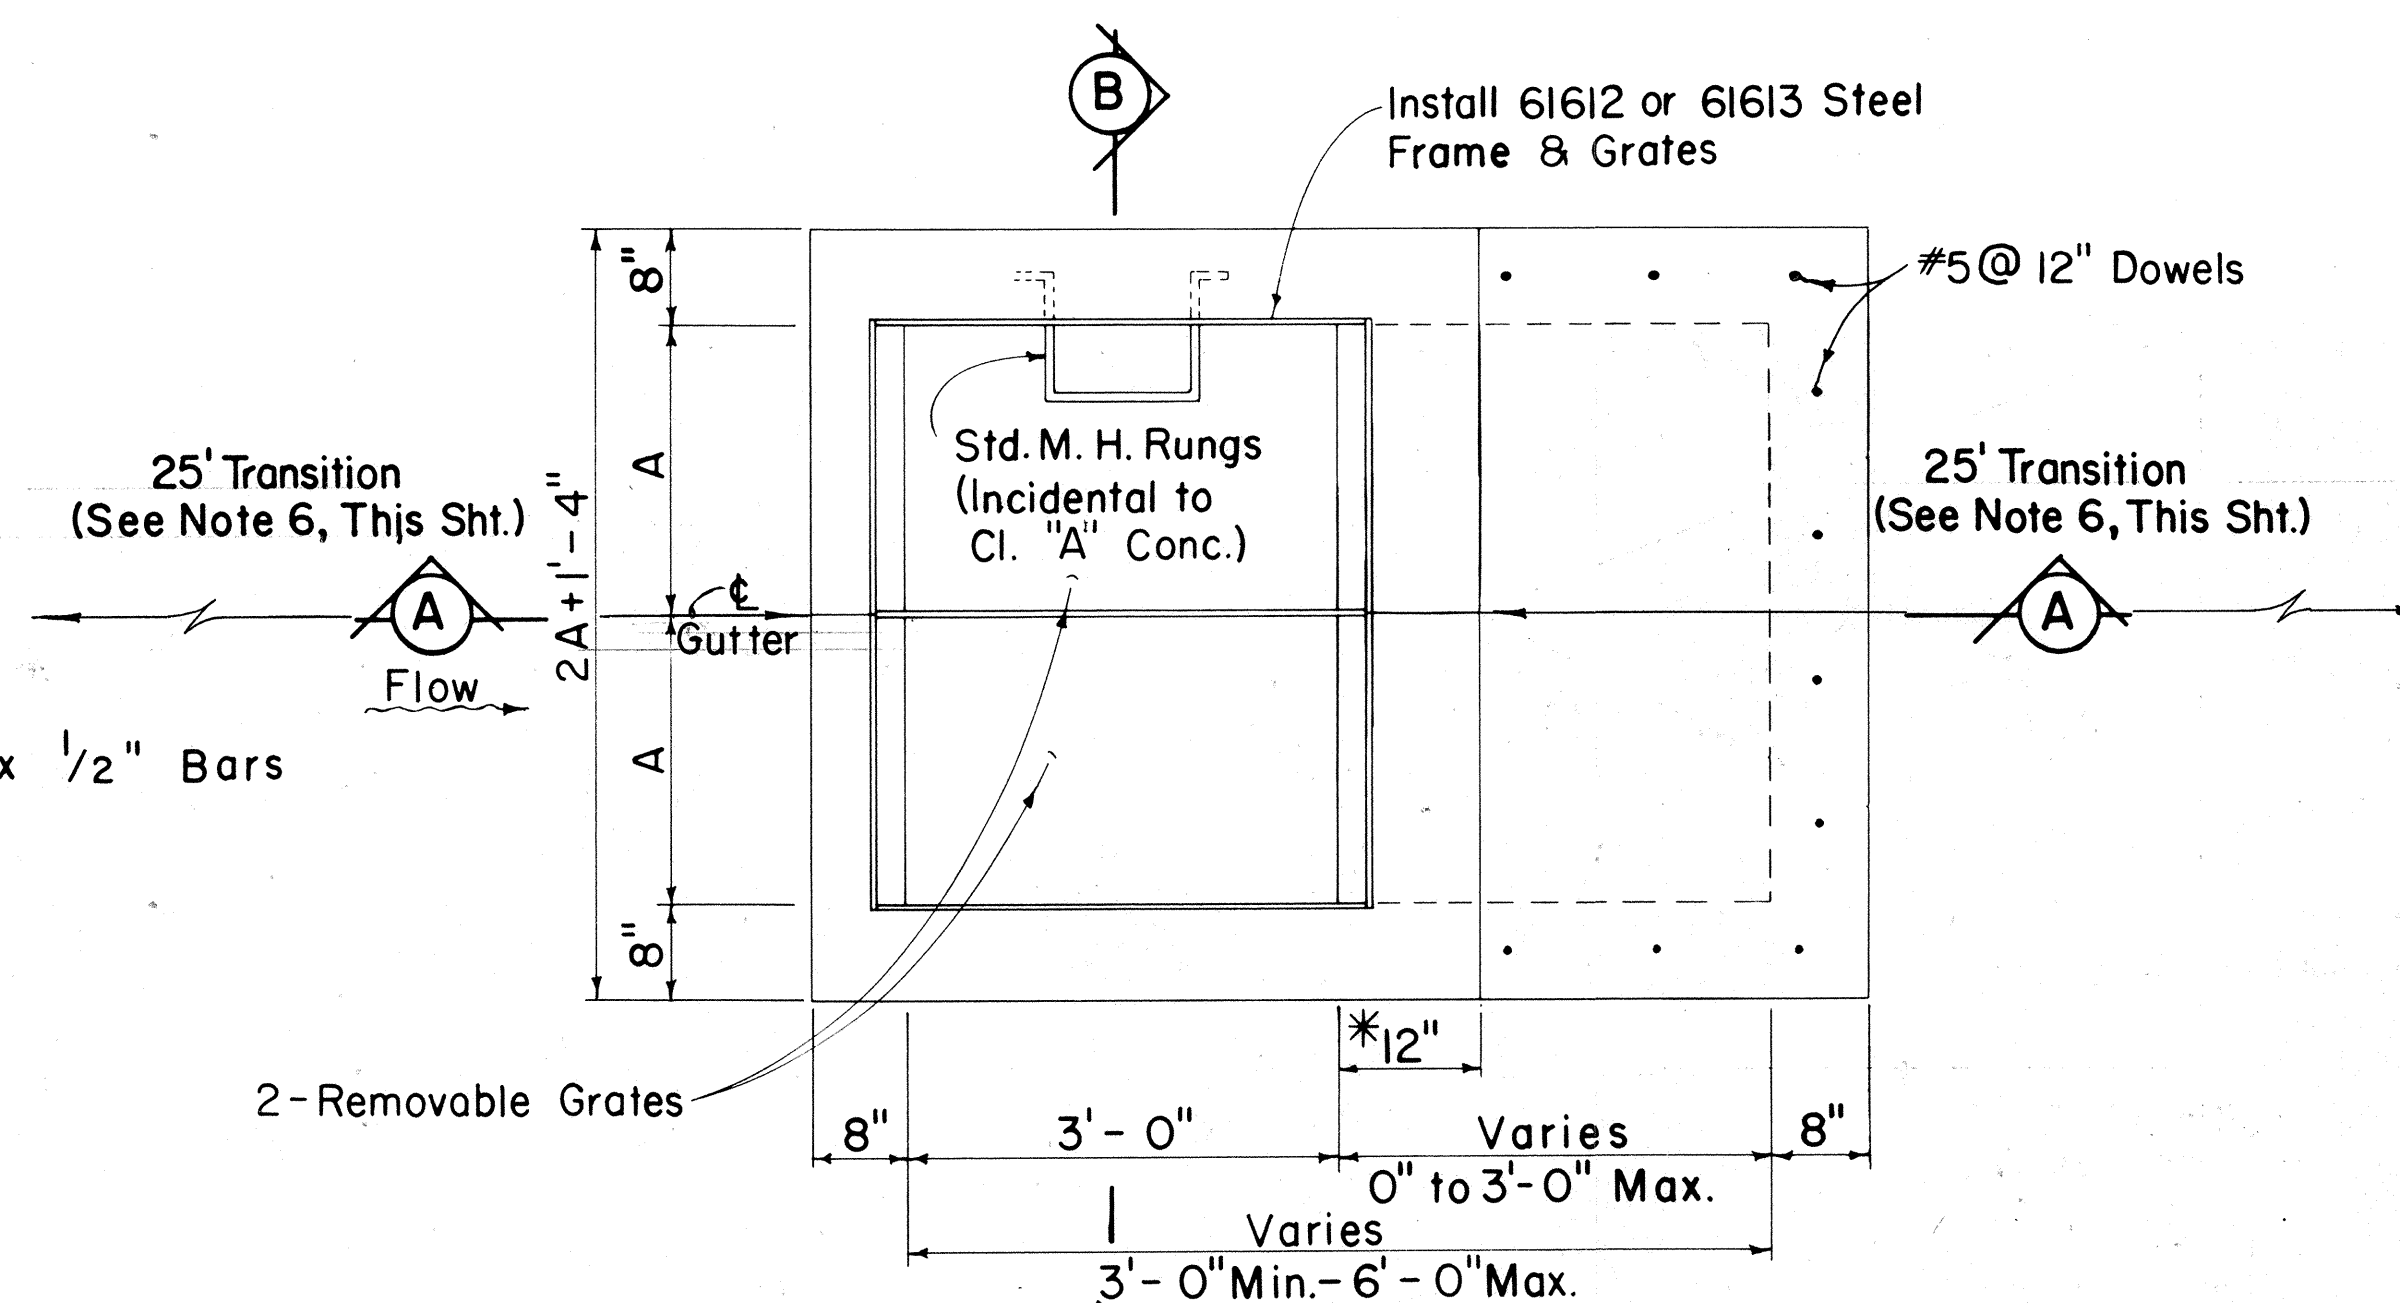


PLAN

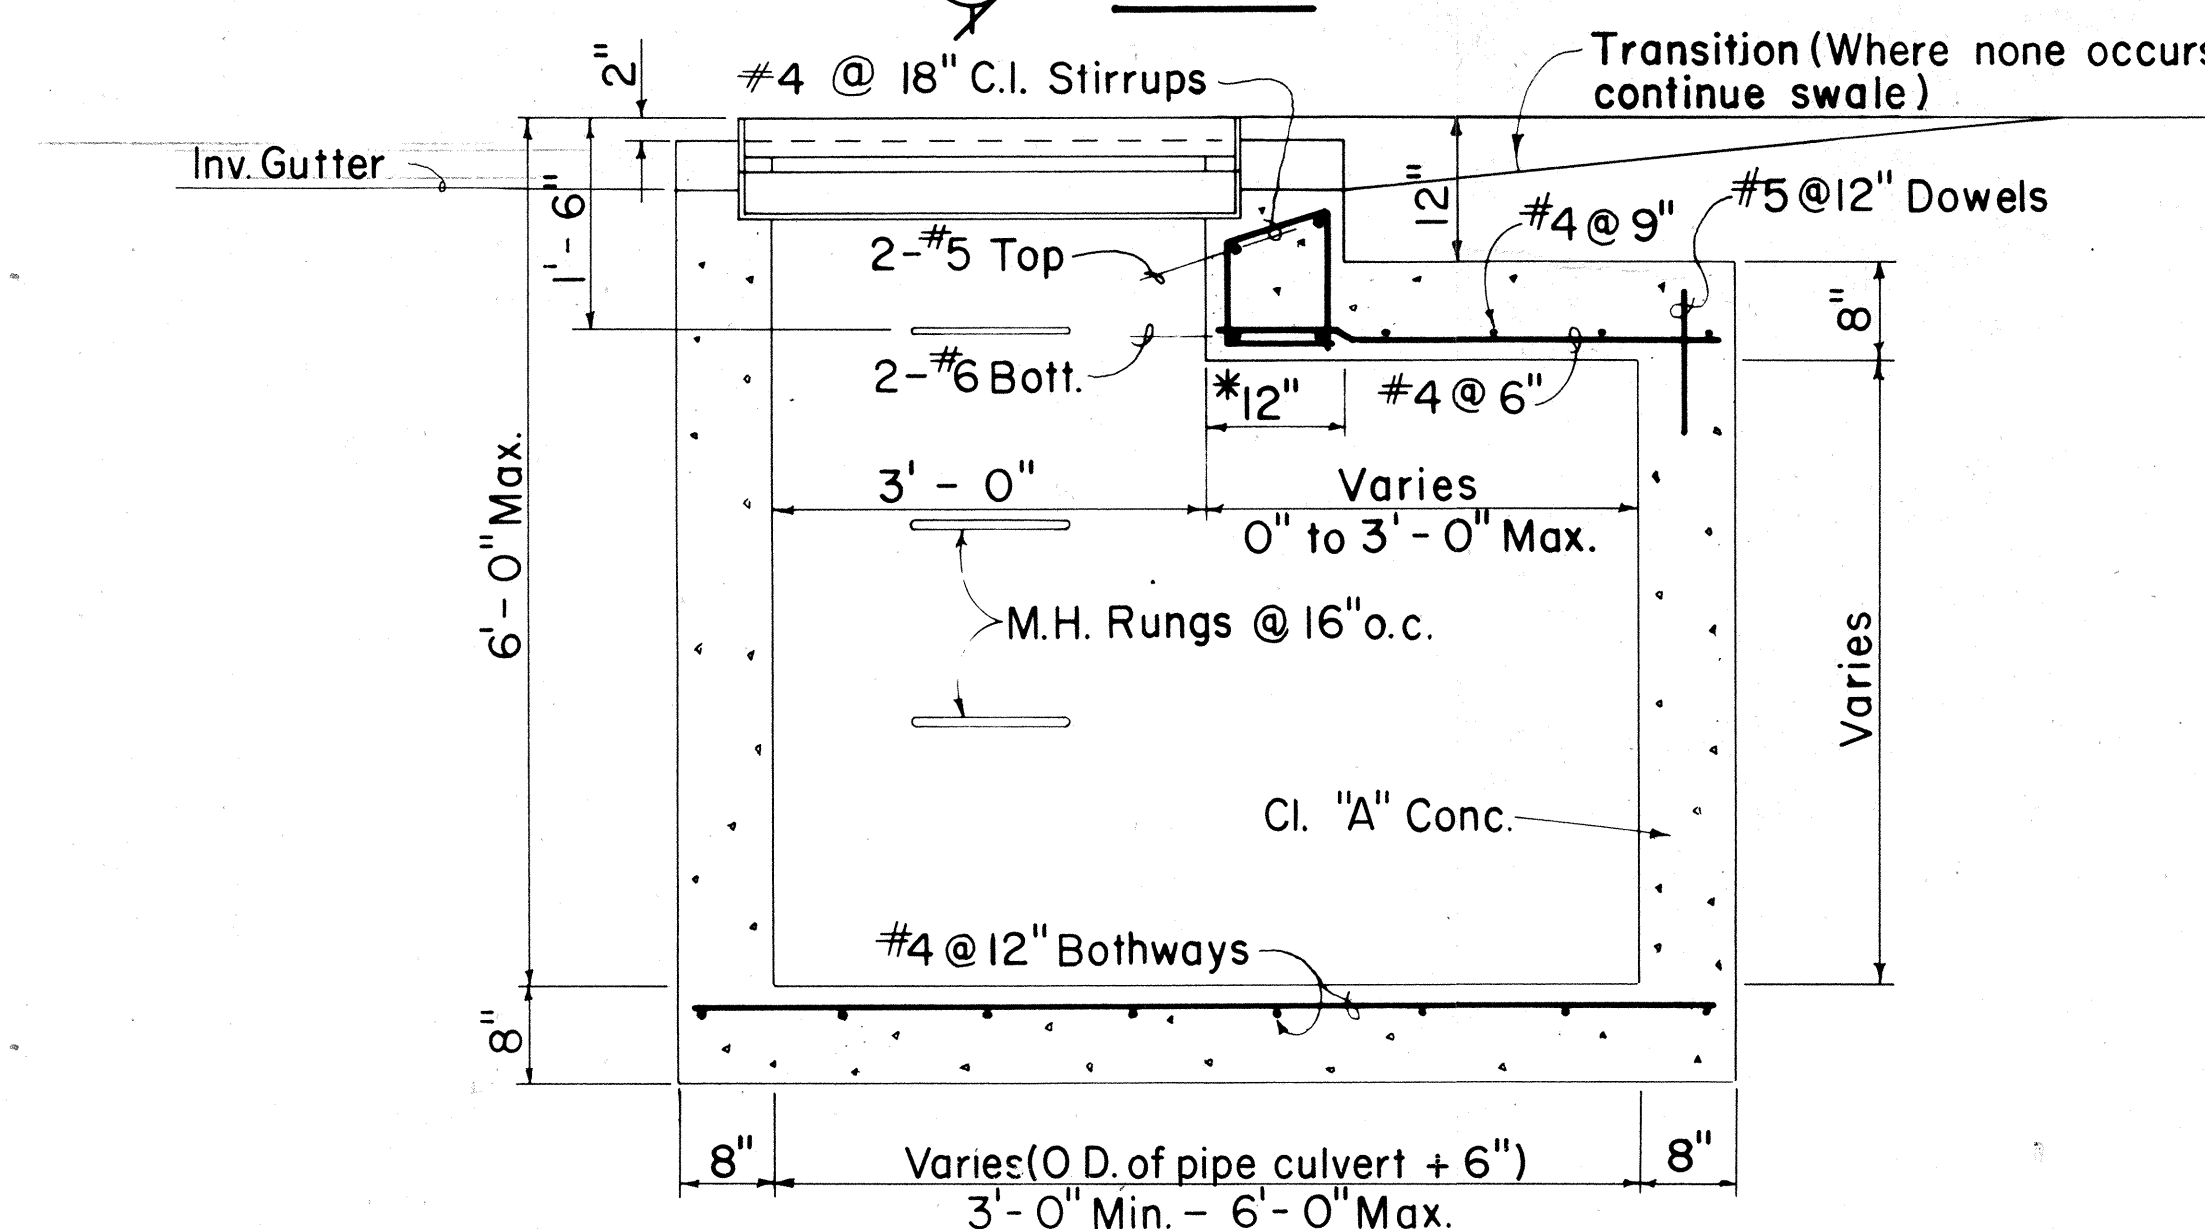

SECTION A - A

61612 or 61613 Steel Frame & Grate

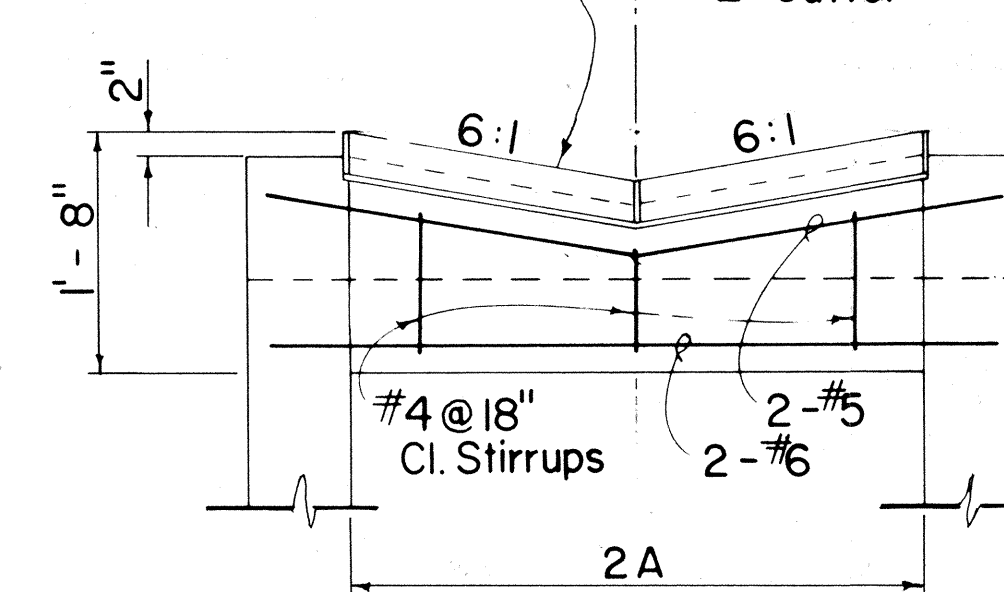

SECTION B - B

DETAIL OF 61612 OR 61613 DROP INTAKE







Scale: 3/4" = 1'-0"

*For Minimum size box of 3'-0" only use 8" and eliminate reinforcing steel shown in the top portion.

FED. ROAD DIST. NO.	STATE	FED. AID PROJ. NO.	FISCAL YEAR	SHEET NO.	TOTAL SHEETS
HAWAII	HAW.	I-HI-1(66)10 I-HI-1(67)10	1970	208832	97

ESTIMATED QUANTITIES

LOCATION	Struct. Exc.	Class "A" Conc.	Reinf. Steel	
	C.Y.	C.Y.	Lbs.	
Sta. 75+25	1	0.5	20	
Sta. 77+50	1	0.5	20	
Sta. 97+50	1	0.5	20	
Sta. 99+00	1	0.5	20	

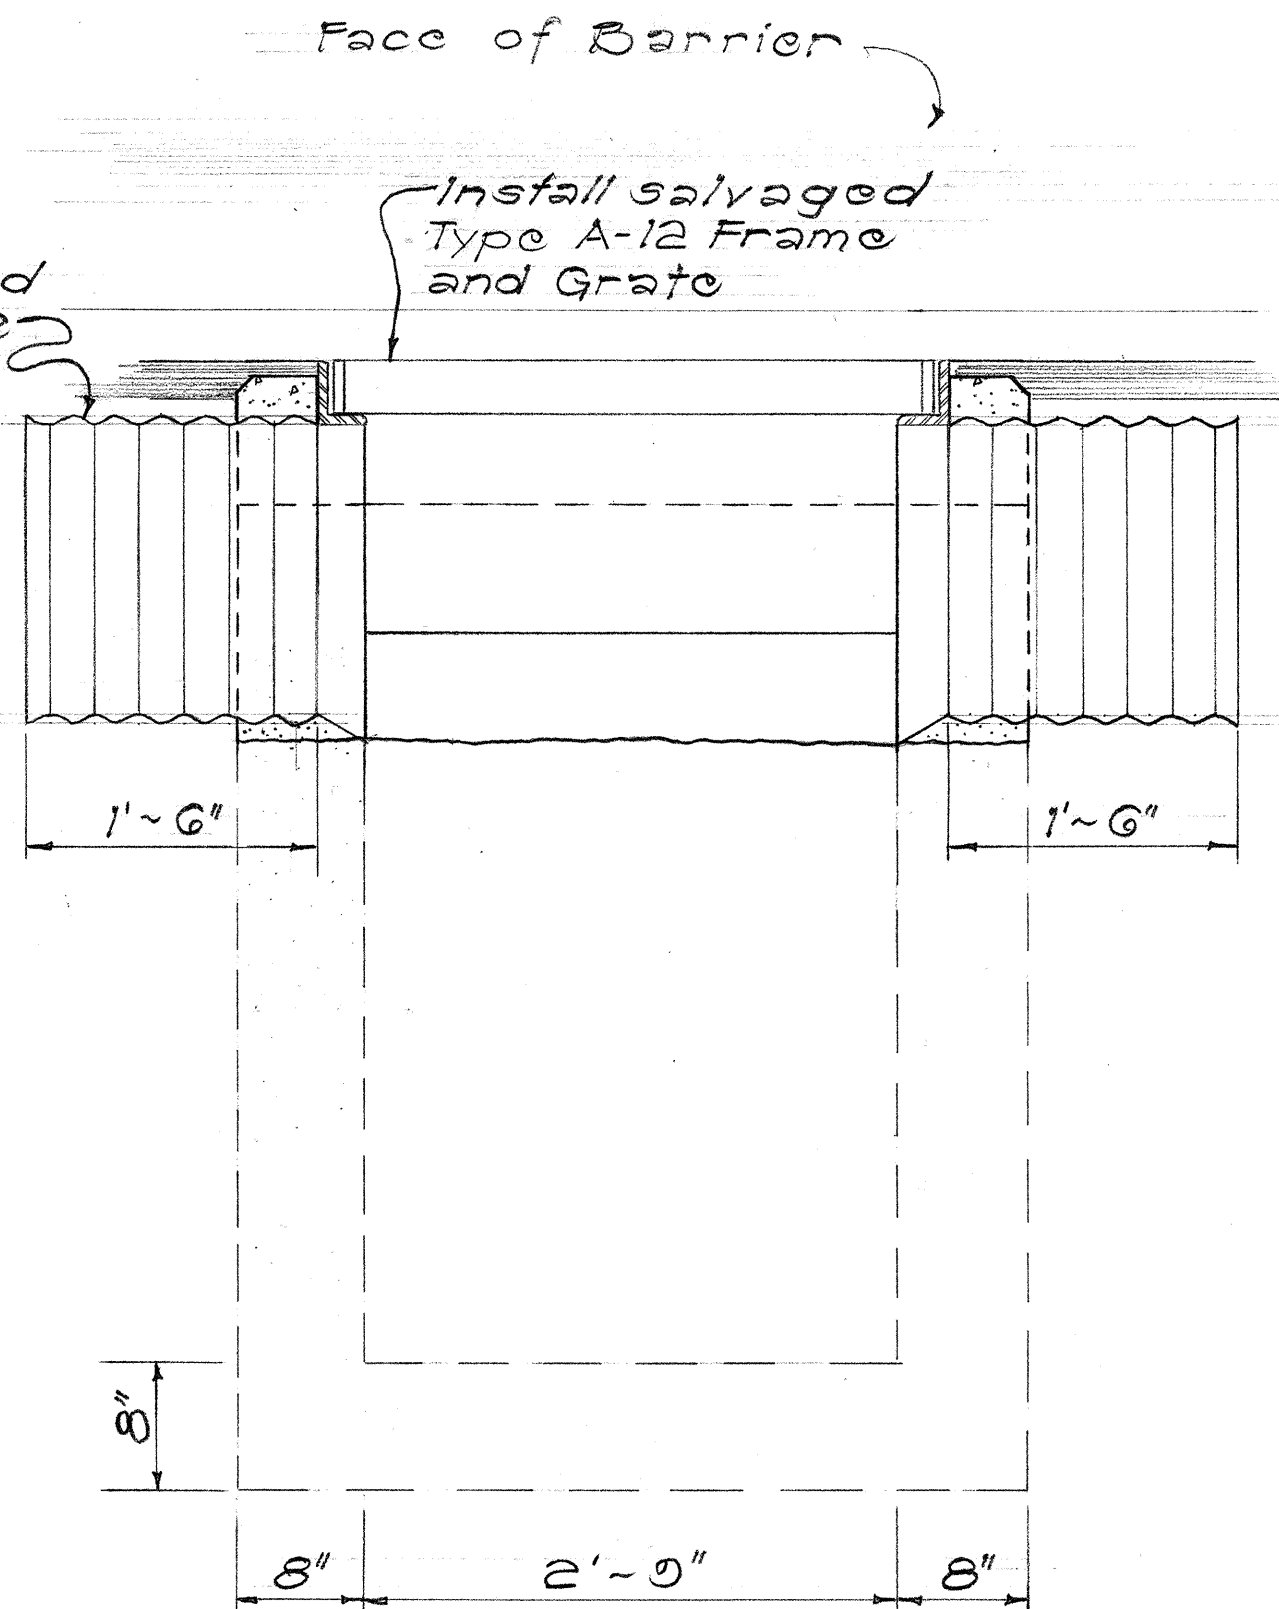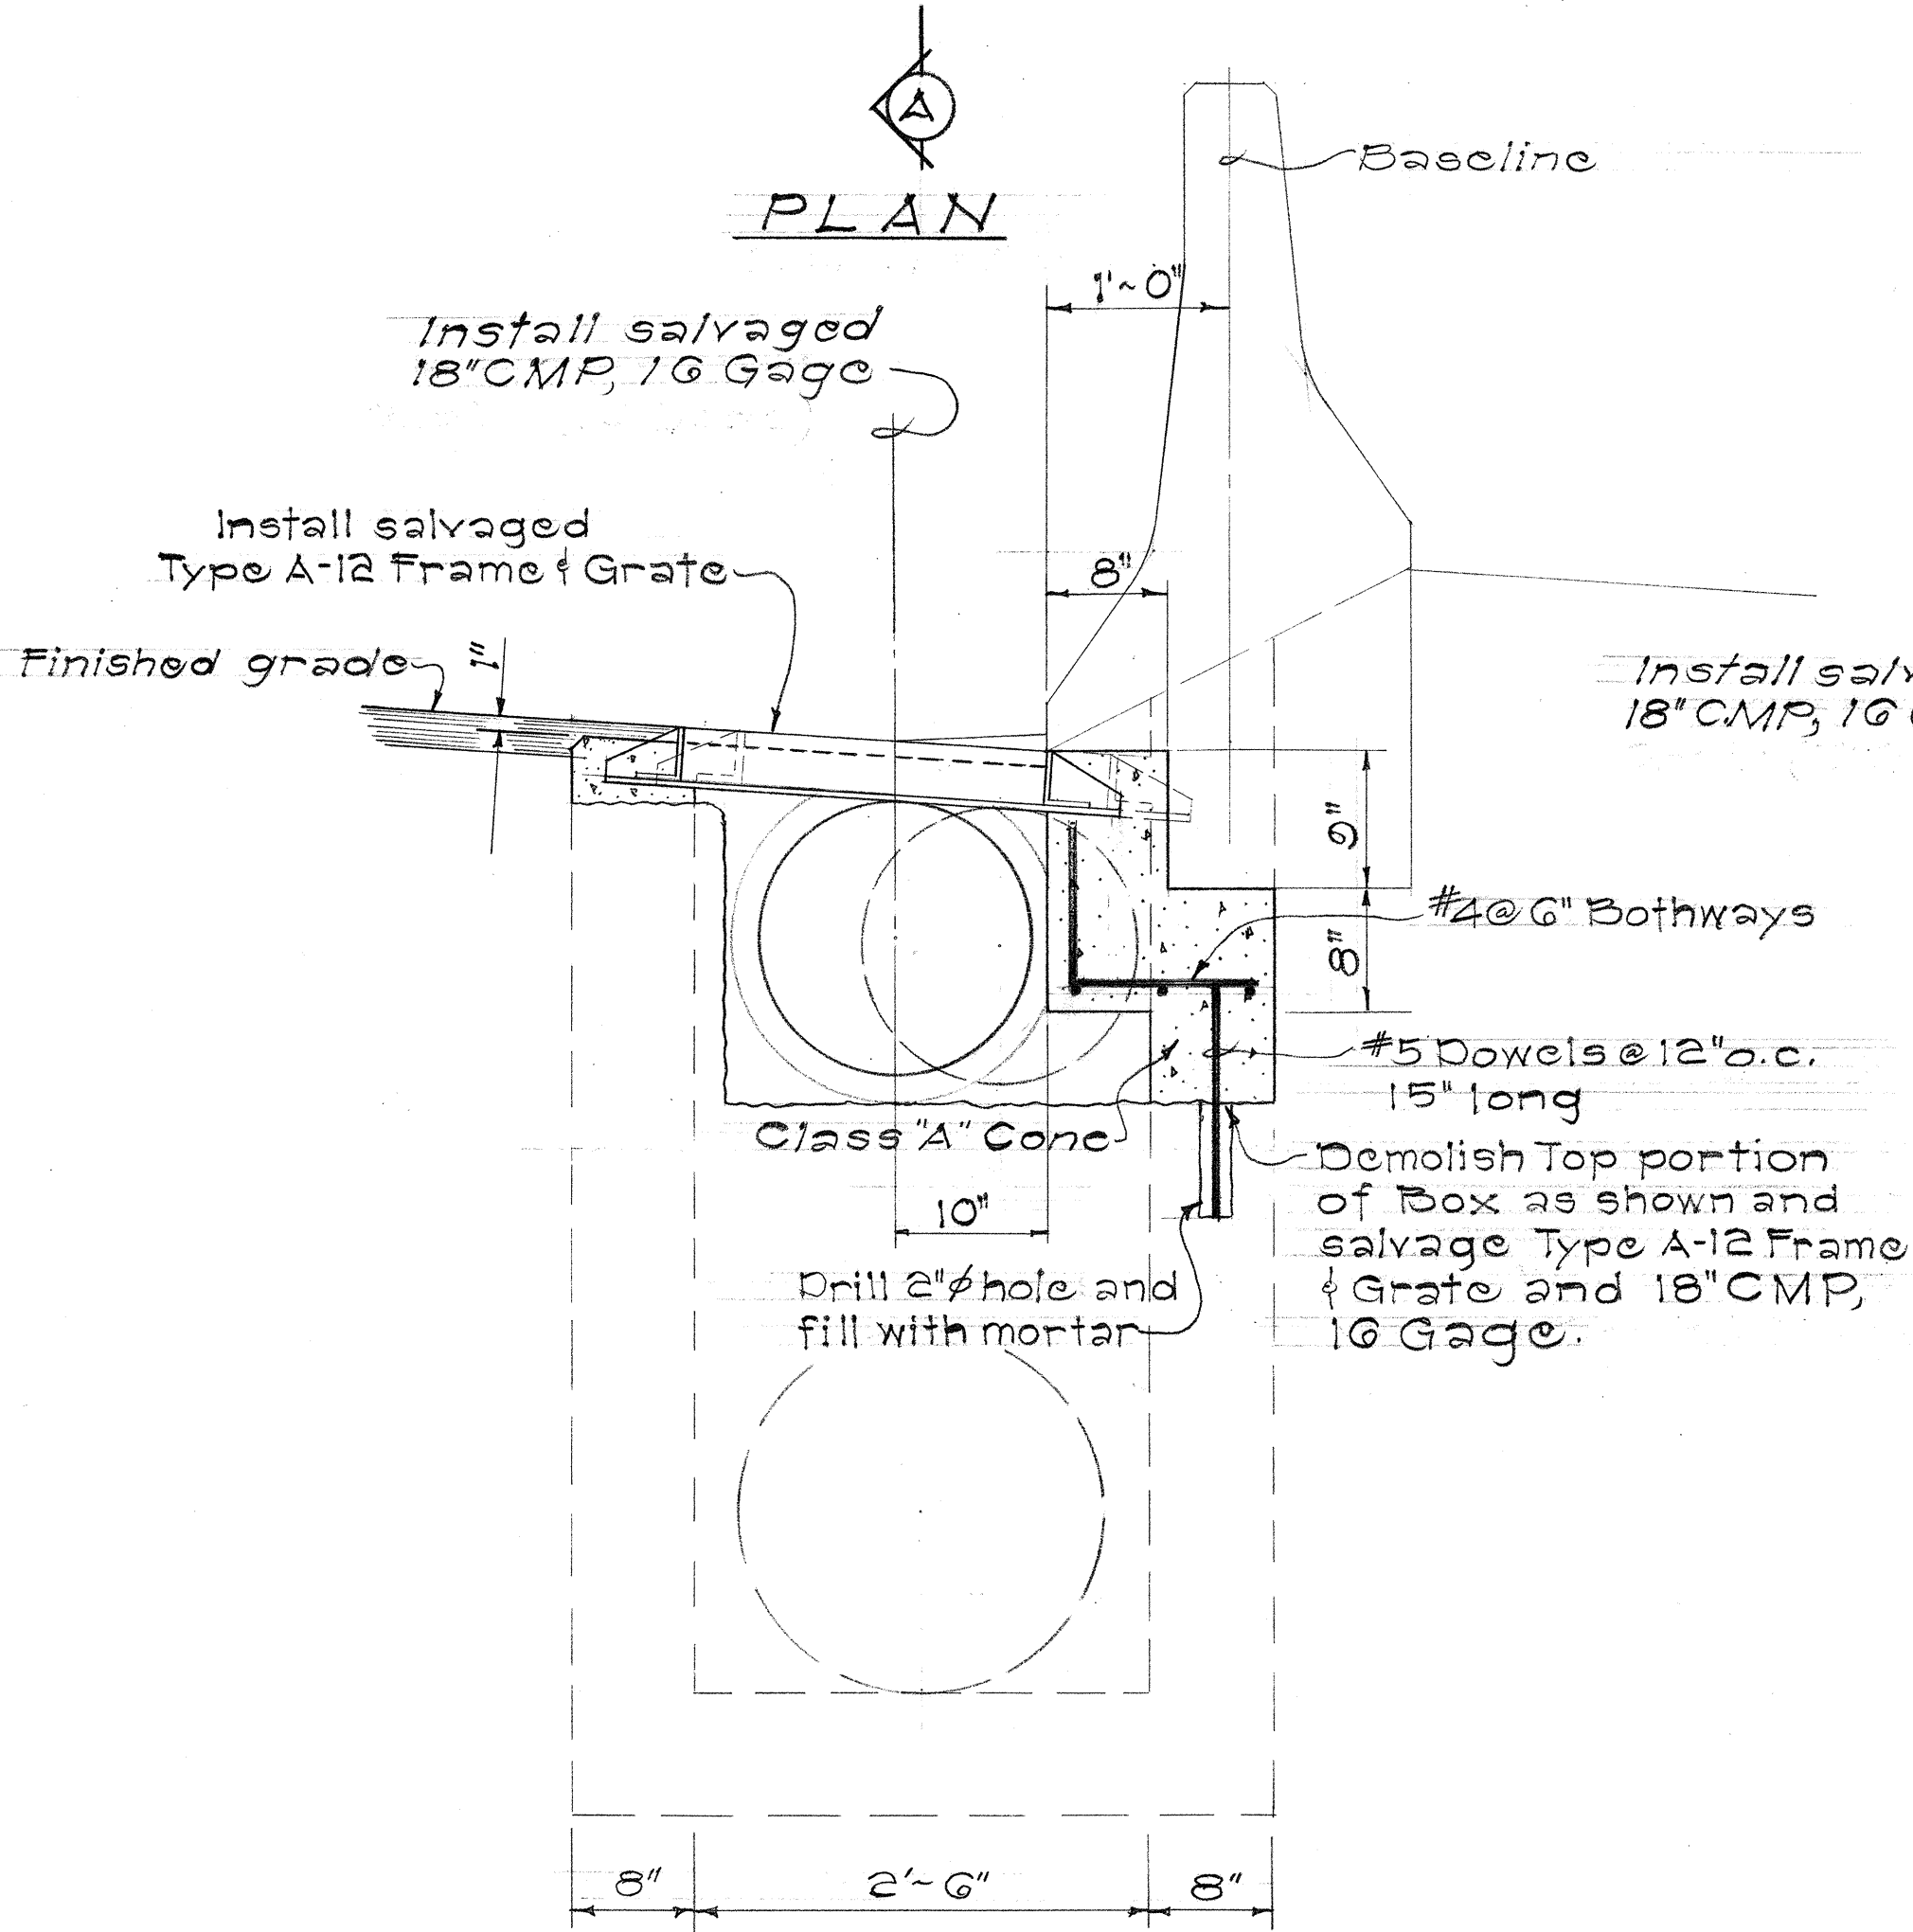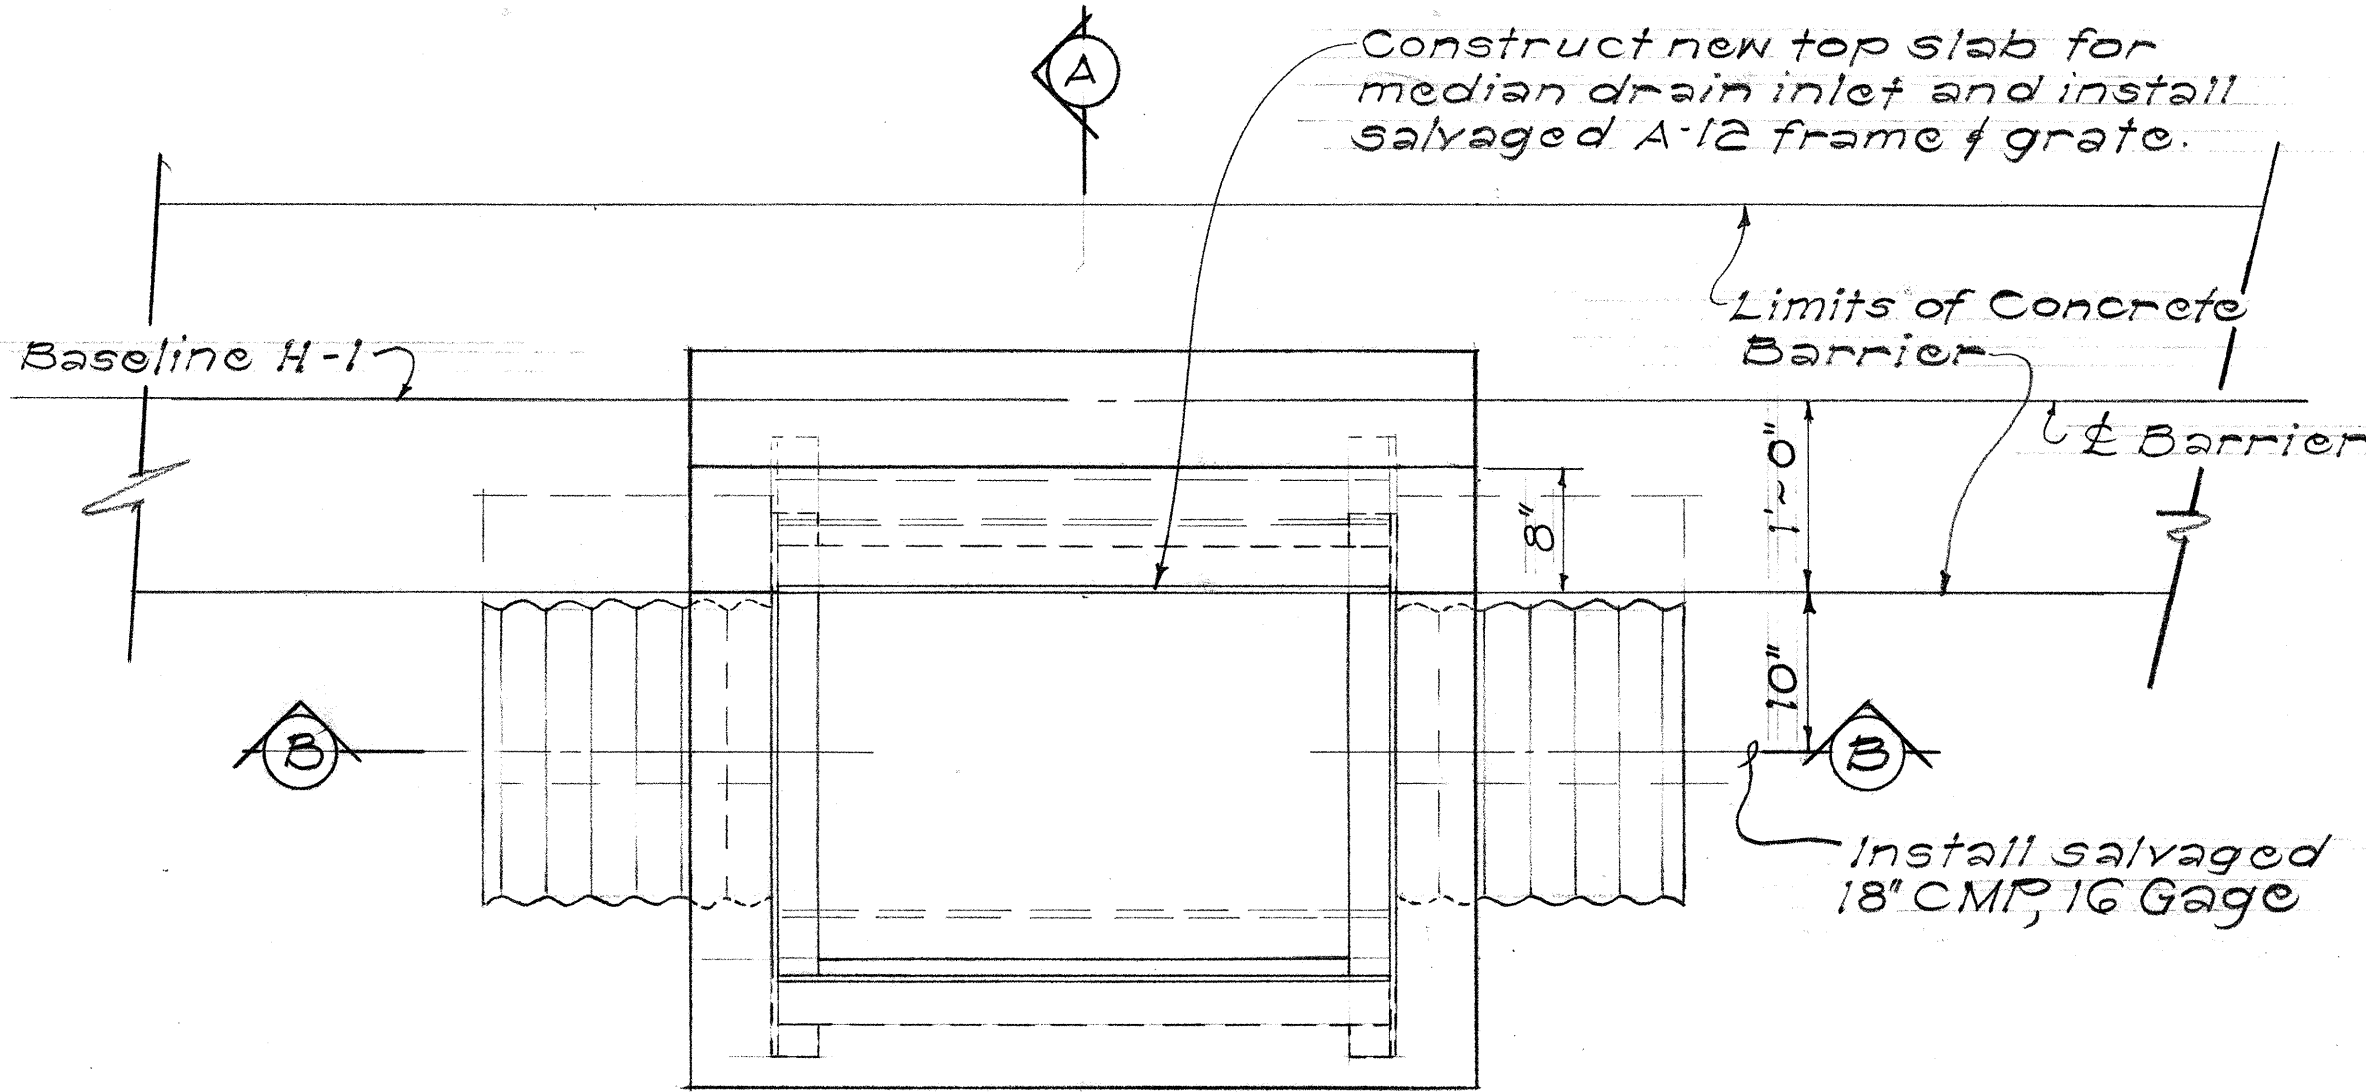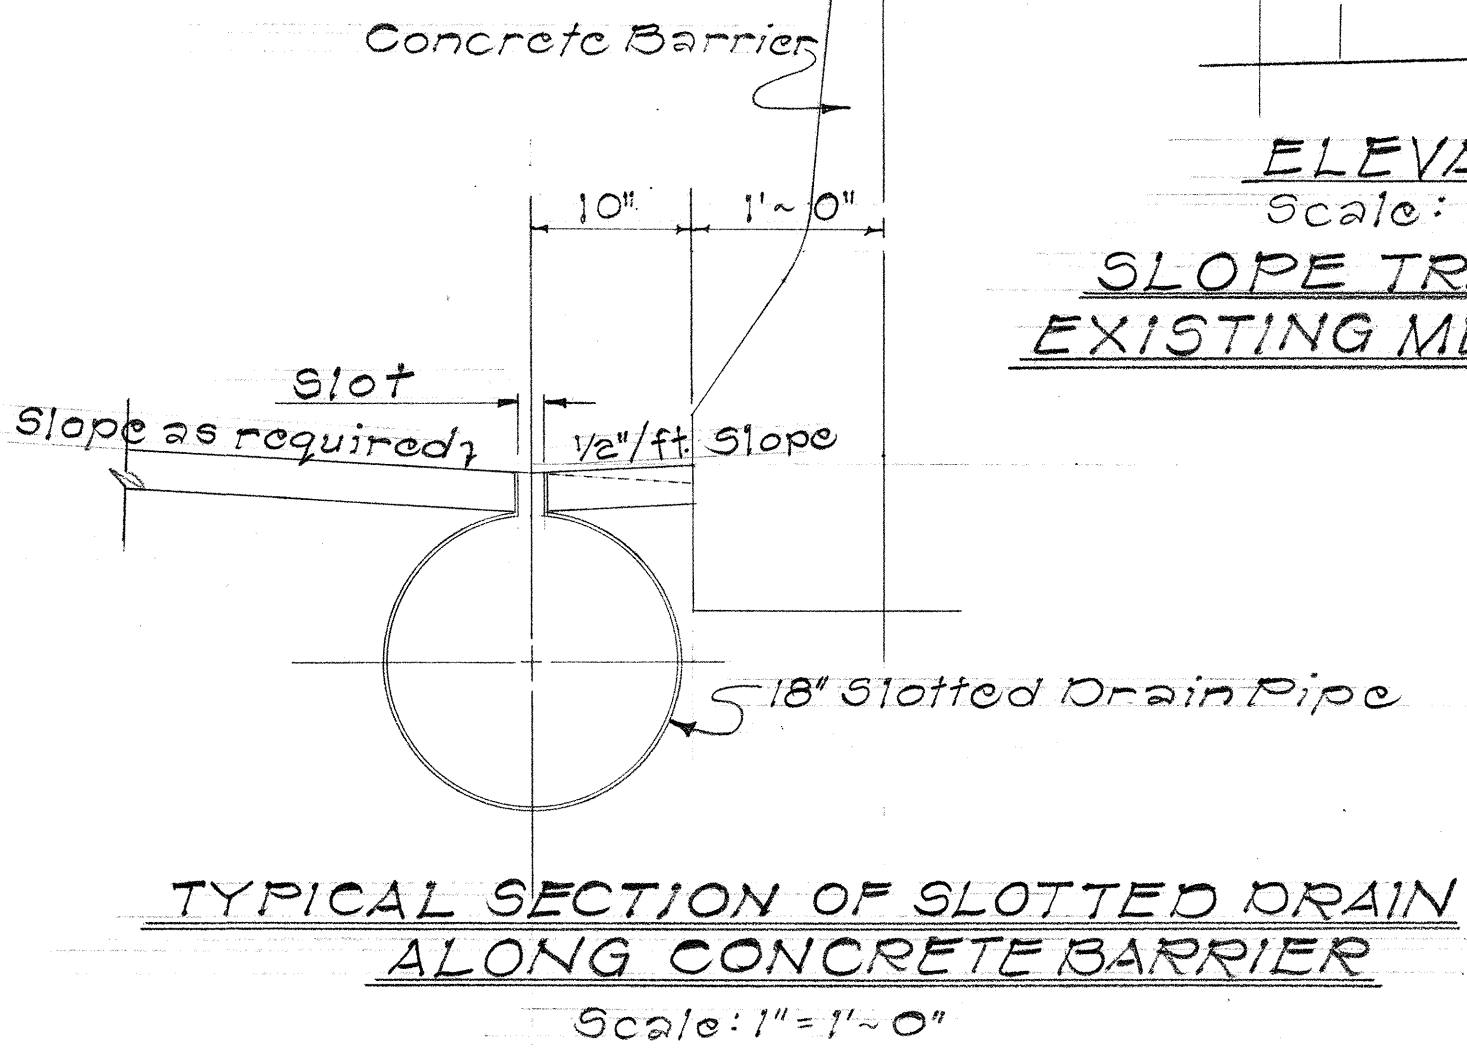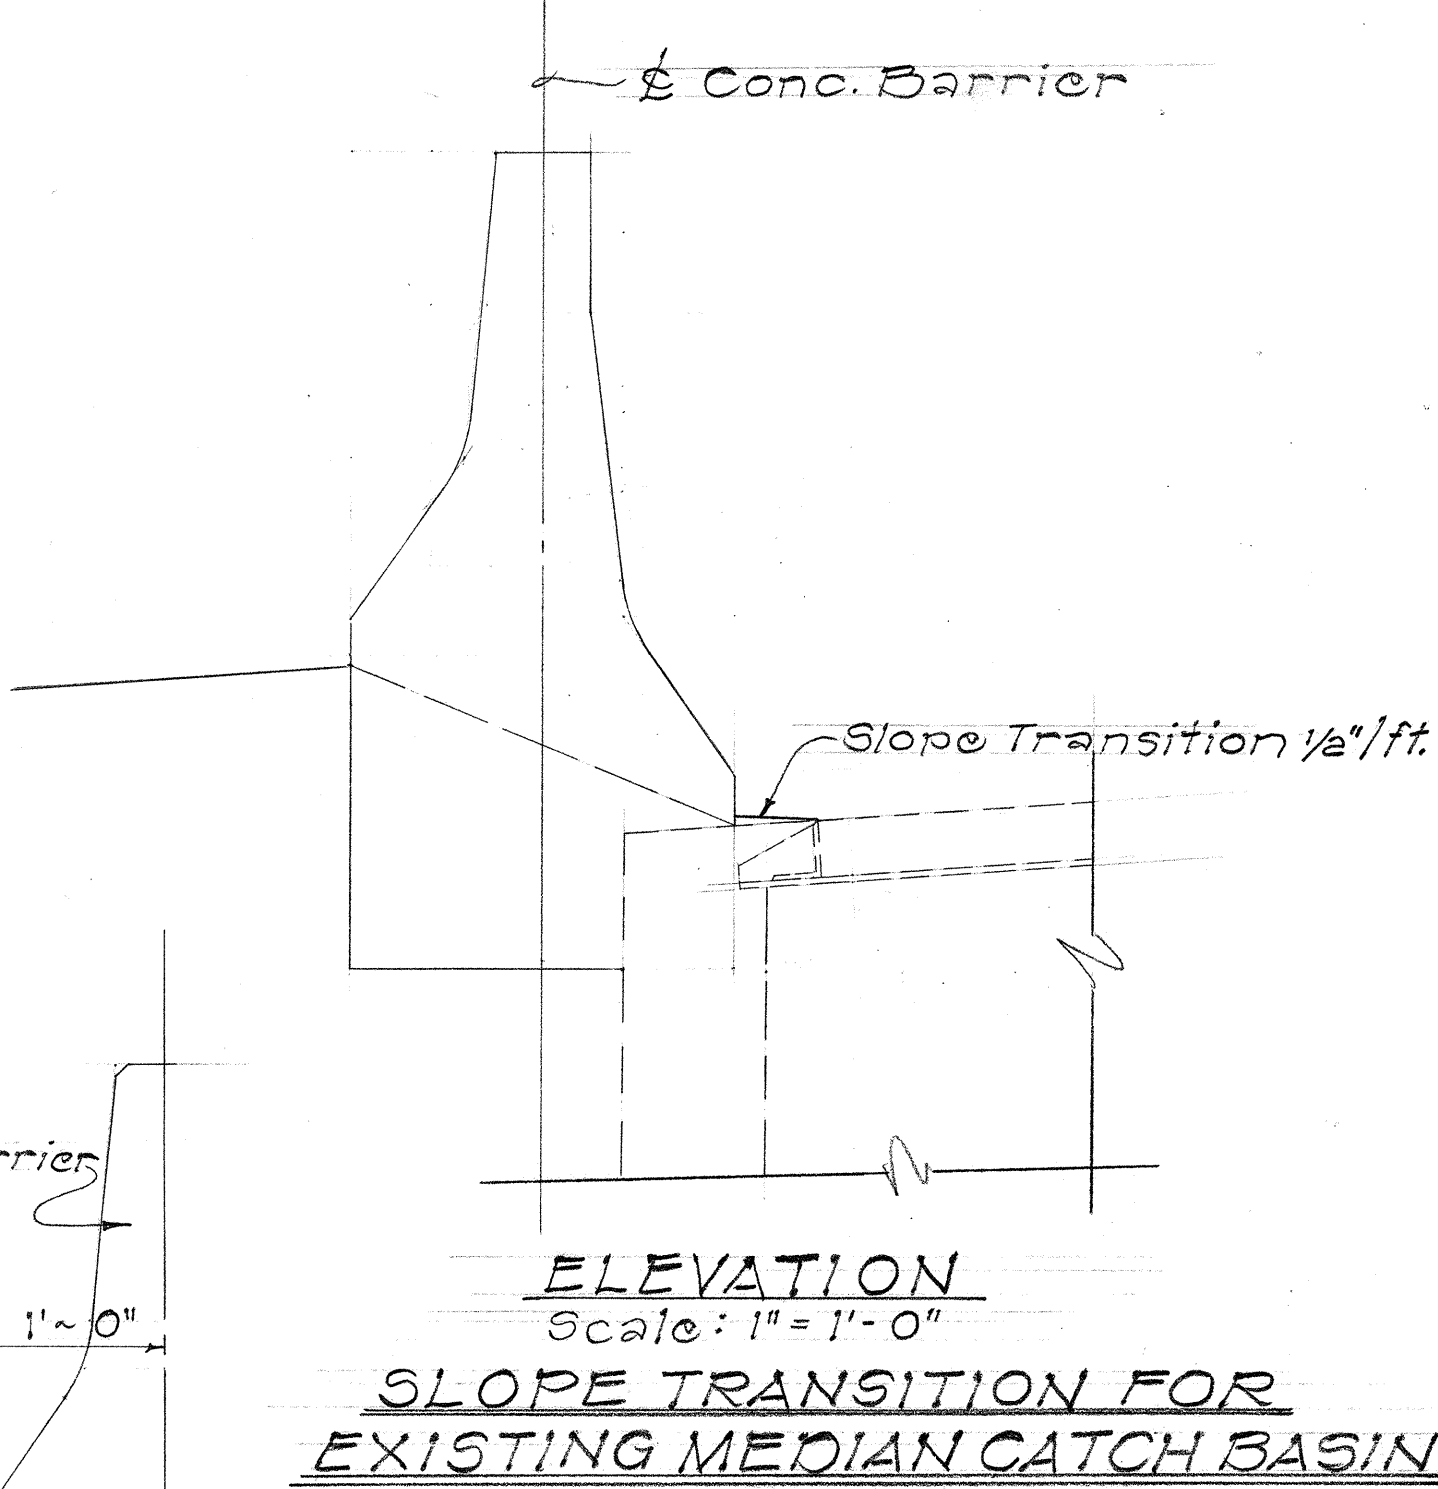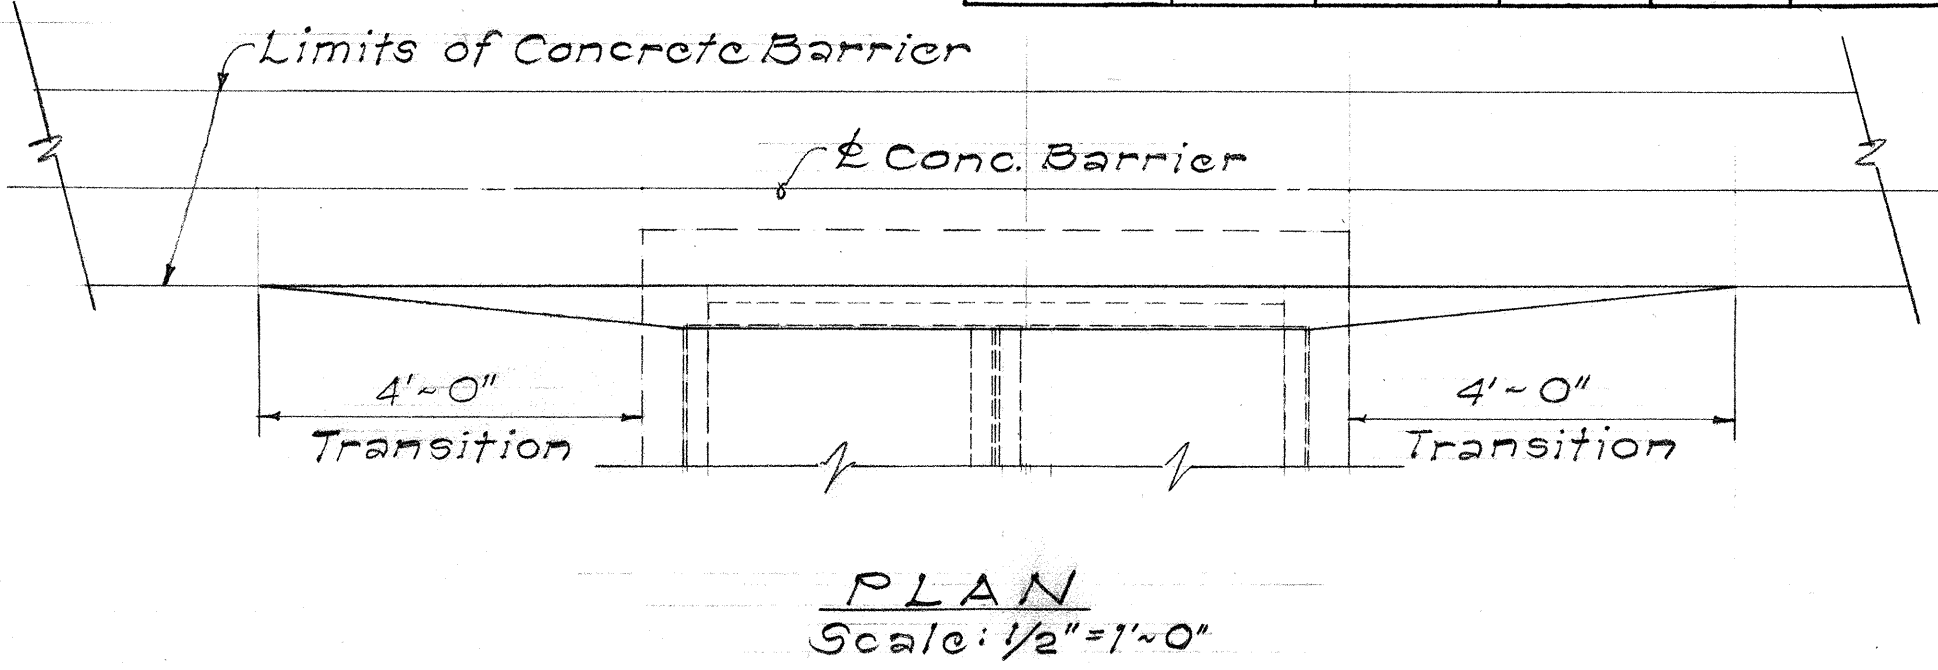

MODIFICATION TO EXISTING MEDIAN DRAIN INLET STRUCTURE
Scale: 1" = 1'-0"


THIS SHEET IS A SUPPLEMENT TO THE
CONTRACT PLANS.

STATE OF HAWAII
DEPARTMENT OF TRANSPORTATION
HIGHWAYS DIVISION


DRAINAGE DETAILS
MEDIAN DRAIN INLET STRUCTURE
Interstate Route H-1
Project No. I-HI-1(66)10
Scale as Shown Date: April 1970
SHEET No. OF SHEETS

SURVEY PLOTTED BY	DATE
DRAWN BY	
DESIGNED BY	
QUANTITIES BY	
CHECKED BY	


FED. ROAD DIST. NO.	STATE	FED. AID PROJ. NO.	FISCAL YEAR	SHEET NO.	TOTAL SHEETS
HAWAII	HAW.	I-HI-1(66)10 I-HI-1(67)10	1970	89	97

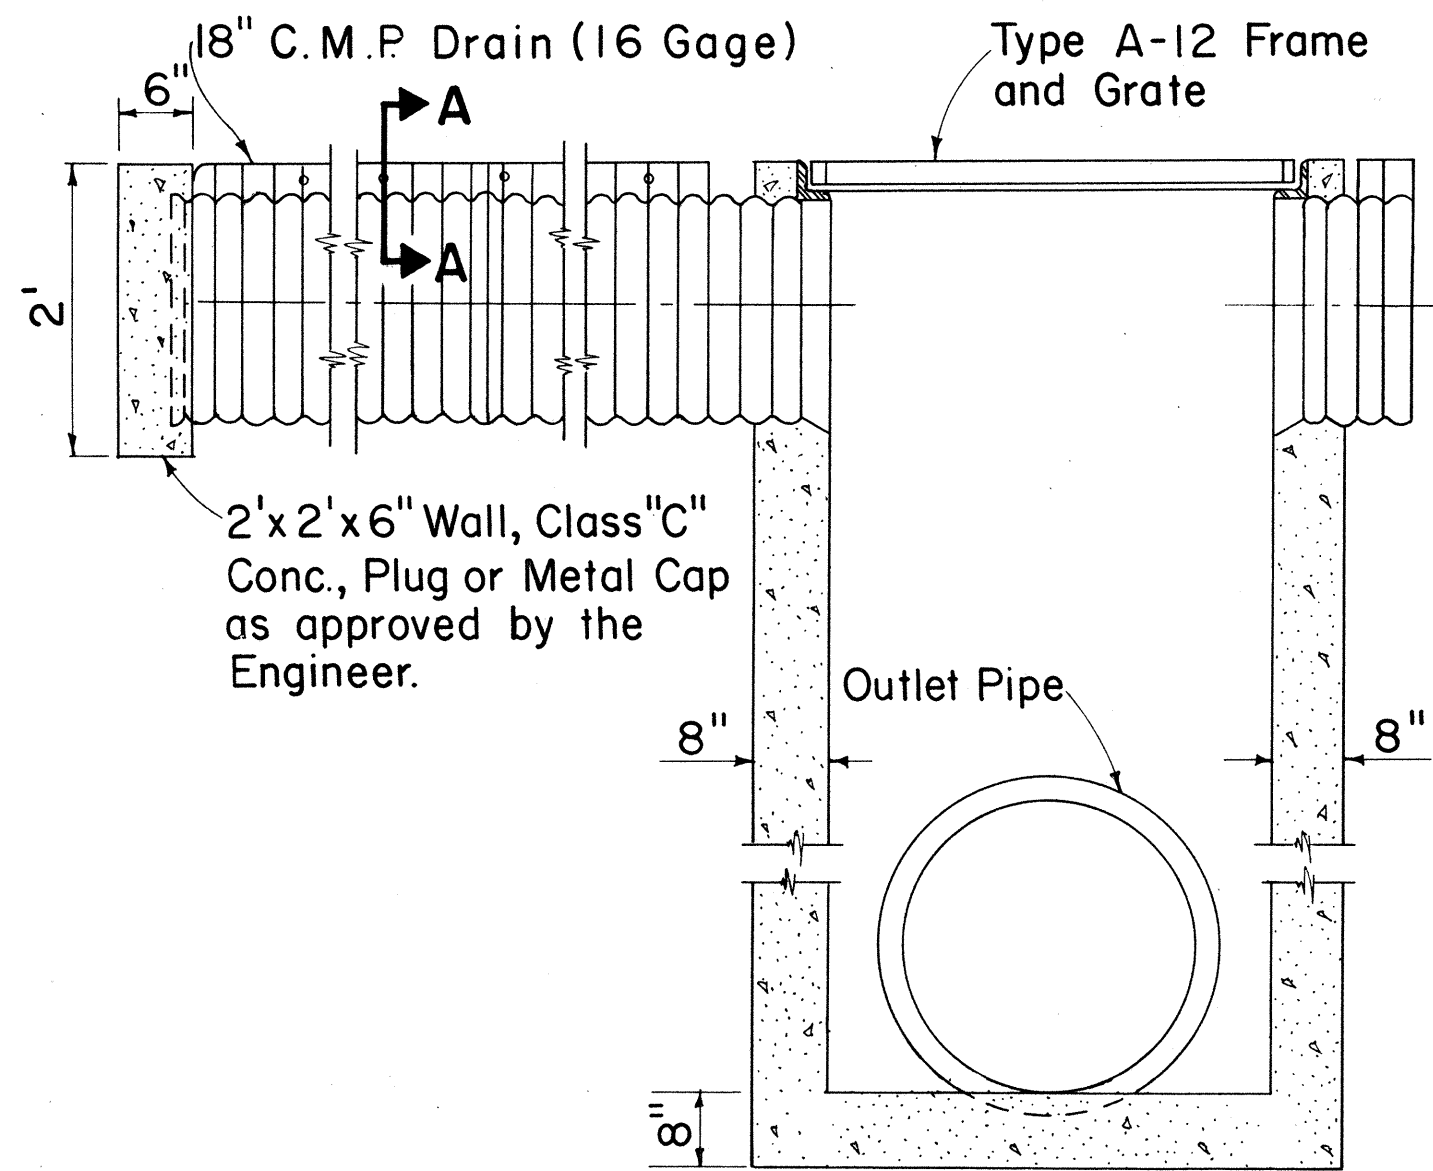


MEDIAN DRAIN INLET STRUCTURE

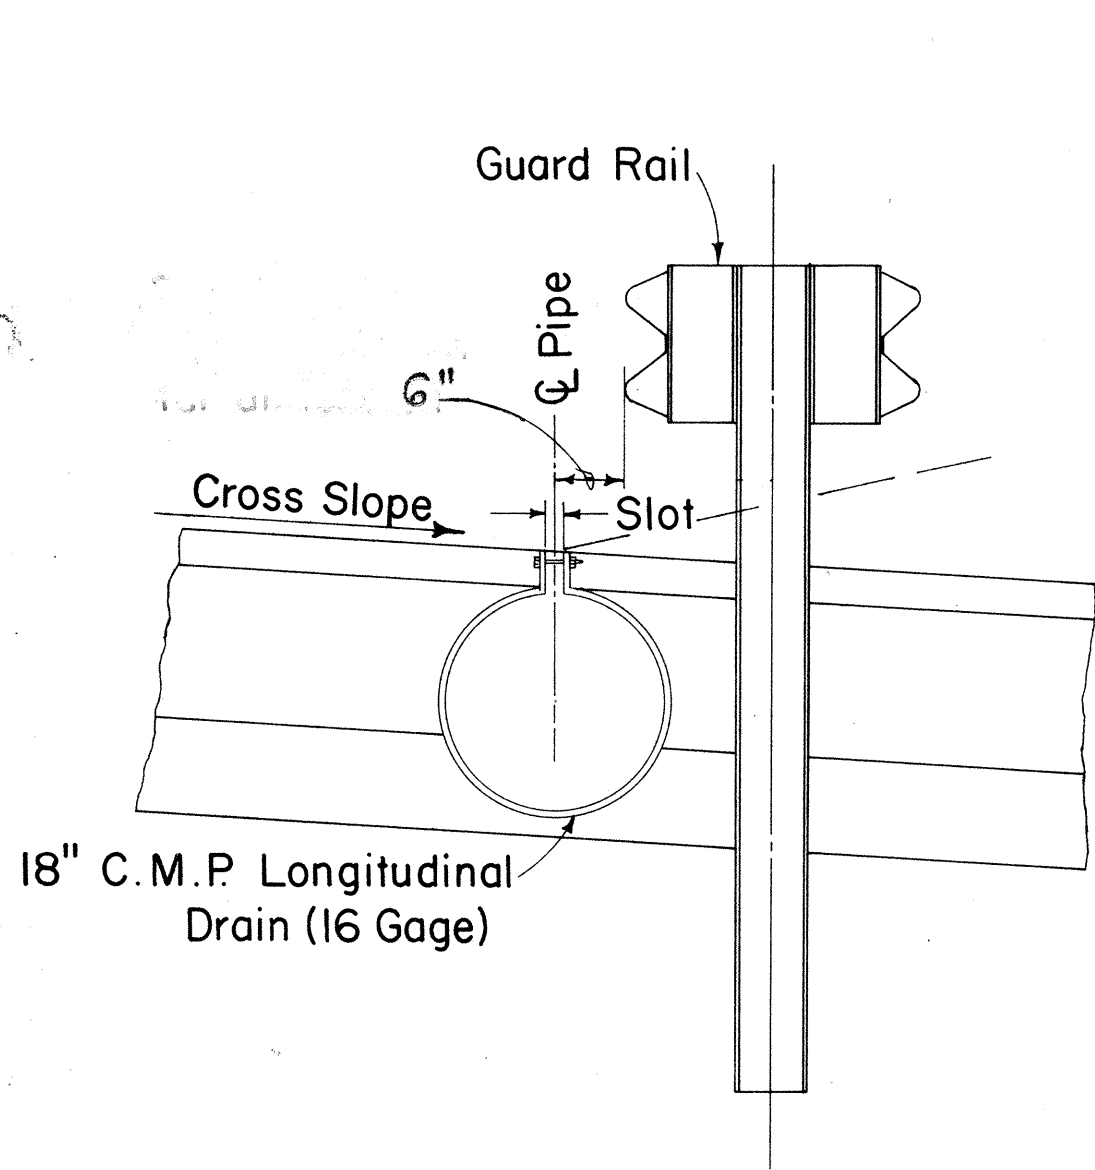


TYPICAL CROSS SECTION

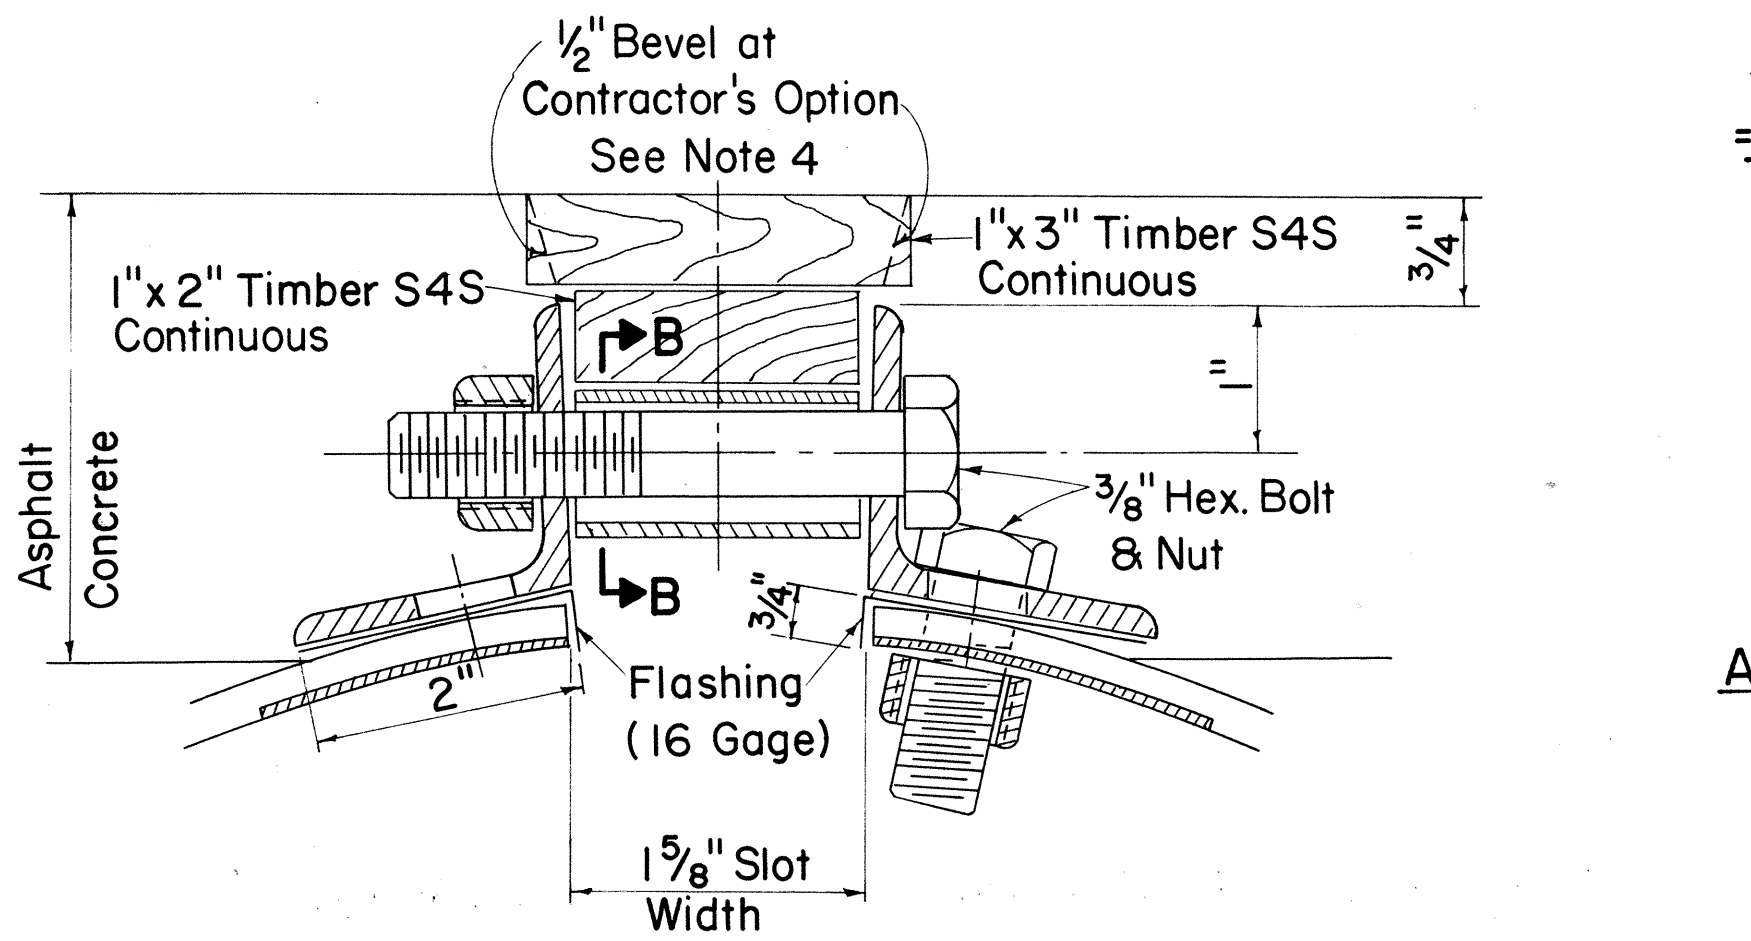


SECTION A-A
ANGLE SLOT DETAIL

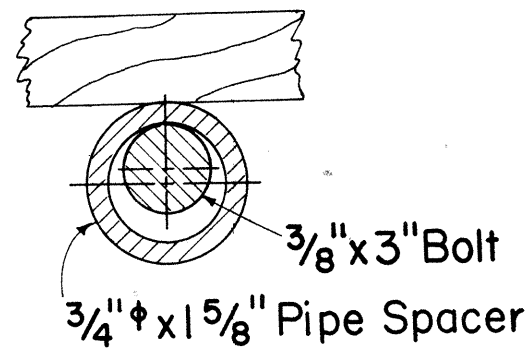


SECTION B-B

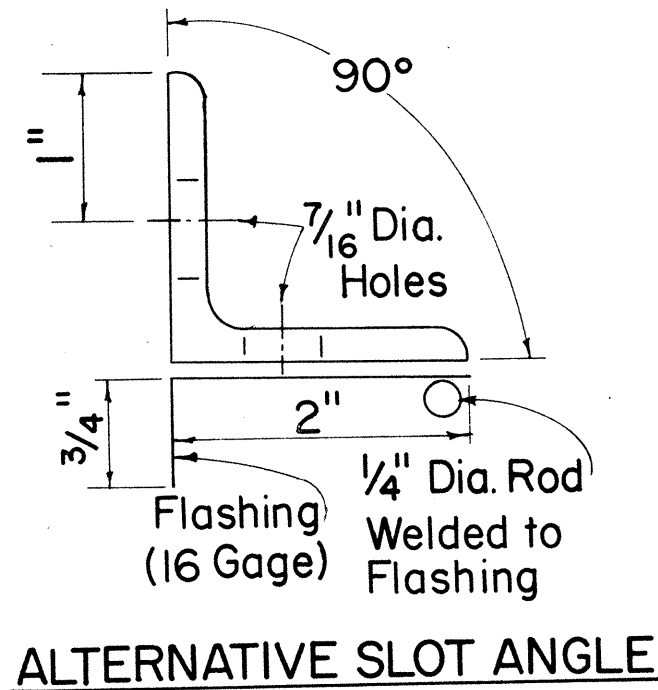

ALTERNATIVE SLOT ANGLE

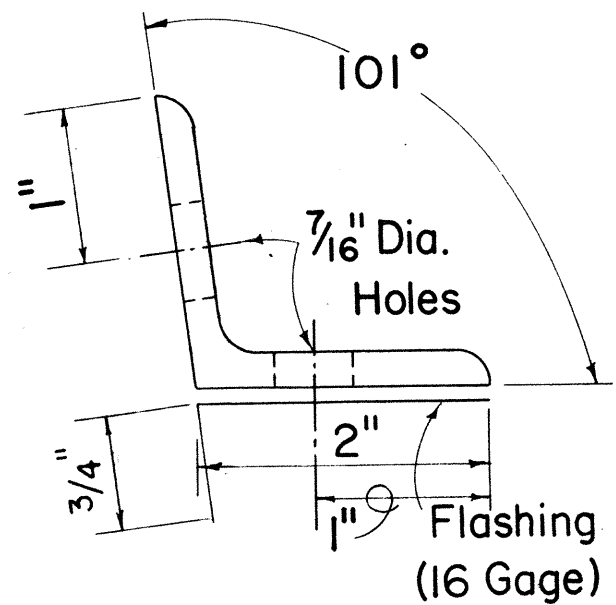


SLOT ANGLE
2"x2"x3/16" ANGLE
DETAILS

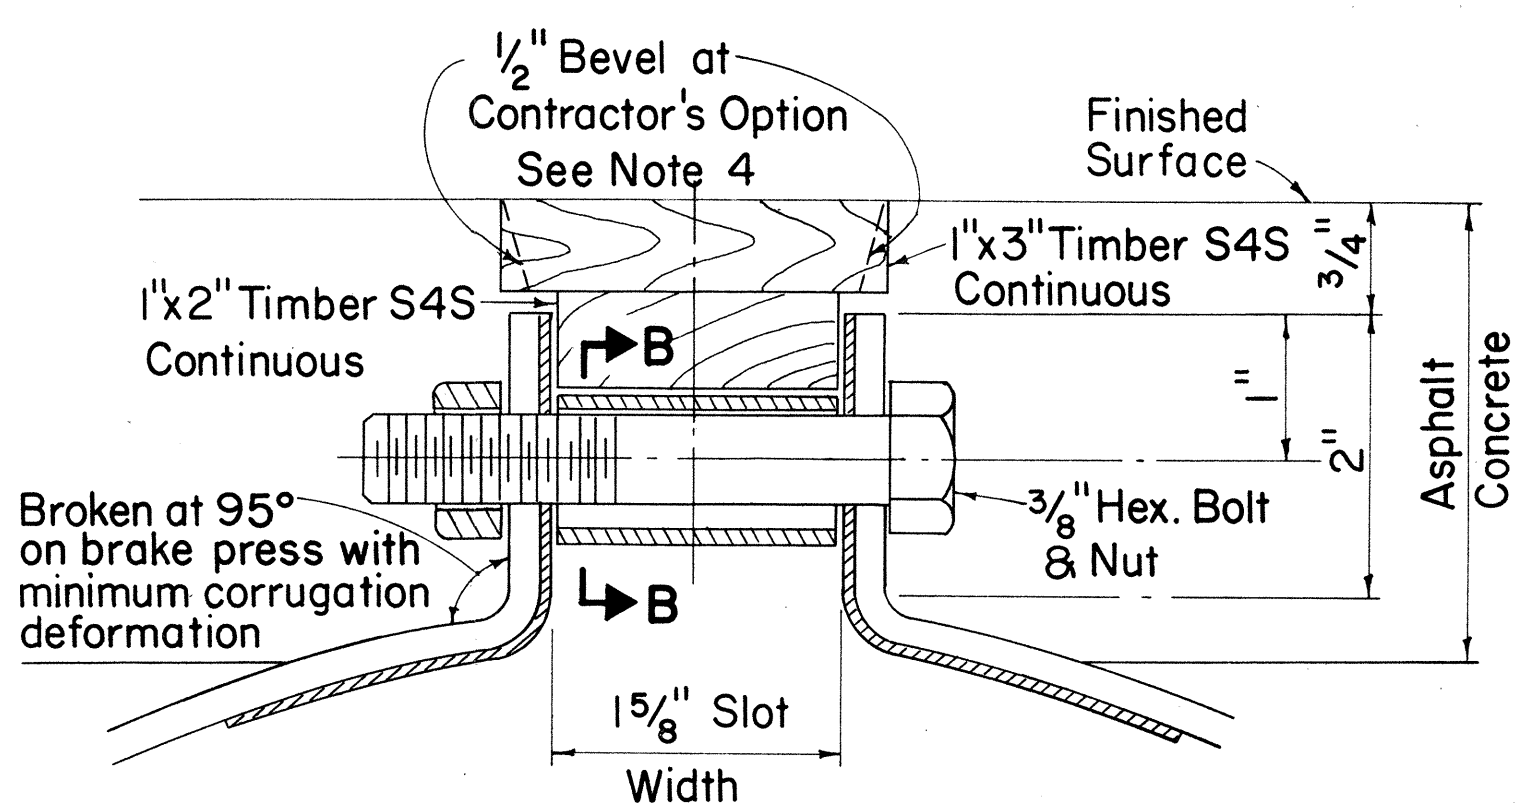


SECTION A-A
FLANGED SLOT DETAIL

- All bolts, nuts, angles and pipe spacers to be galvanized.
- 1"x2" and 1"x3" S4S timber to remain in place until final clean-up operations are complete.
- Each drain section shall be assembled with flange slot coupling band and bolted thru drain section flange.
- If the Contractor elects to use bevel, a 1"x4" S4S timber shall be used in lieu of 1"x3" S4S timber.
- 20' units of 18" slotted C. M. P. drain shall be fabricated and all nuts and bolts tightened prior to beginning field installation.
- The Contractor shall take precaution to prevent adhesion between timber placed in the slotted drain as shown on Section A-A and the asphalt concrete paving.
- The Contractor may elect to use either alternative method of fabrication.
- The slotted C. M. P. shall not be installed until after any adjacent P.C.C. pavement has been completed.

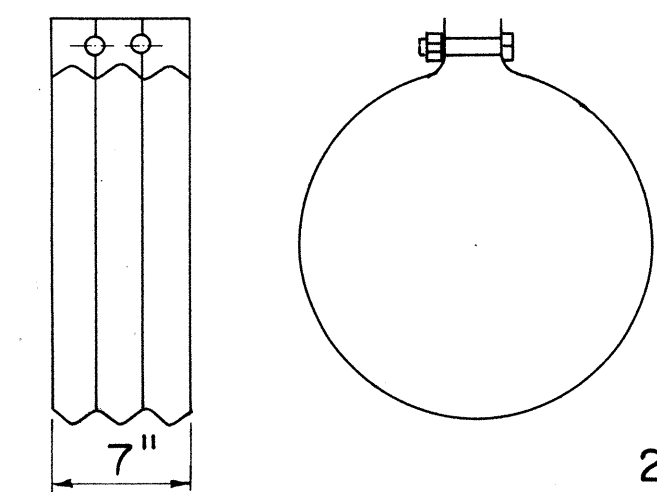


FLANGE SLOT
COUPLING BAND


See Note 3

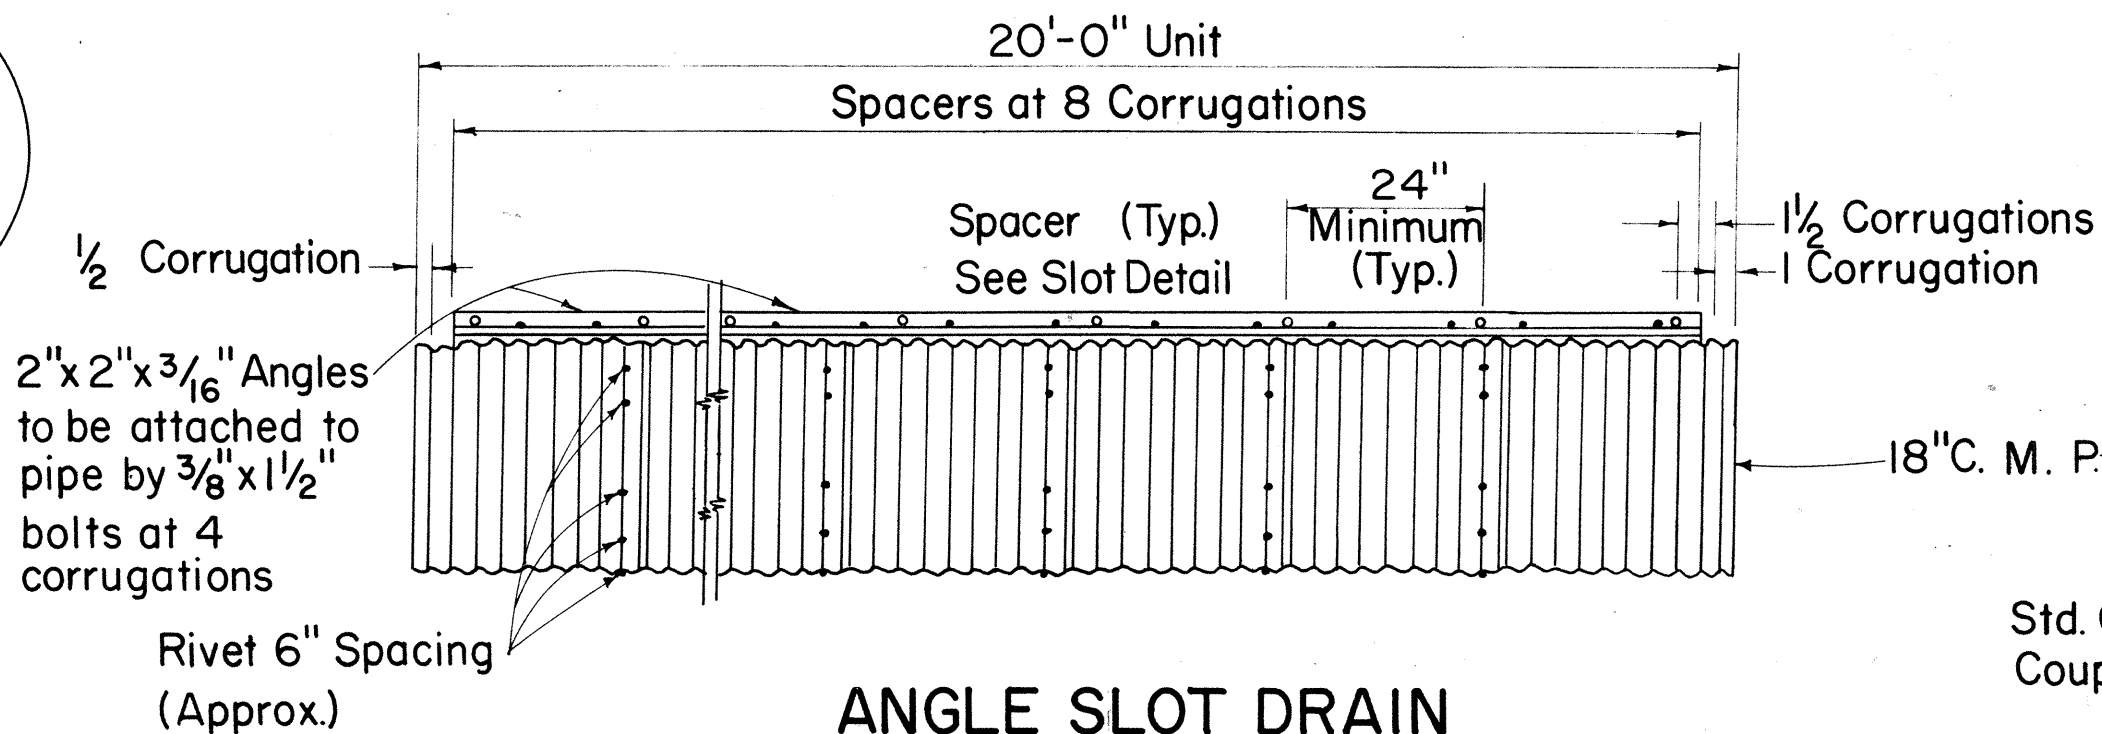

ANGLE SLOT DRAIN

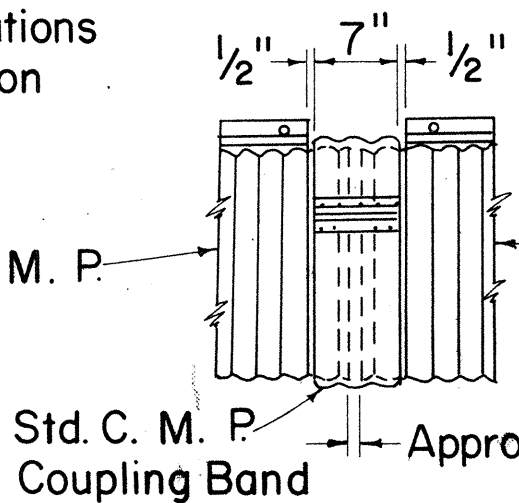


JOINT DETAIL

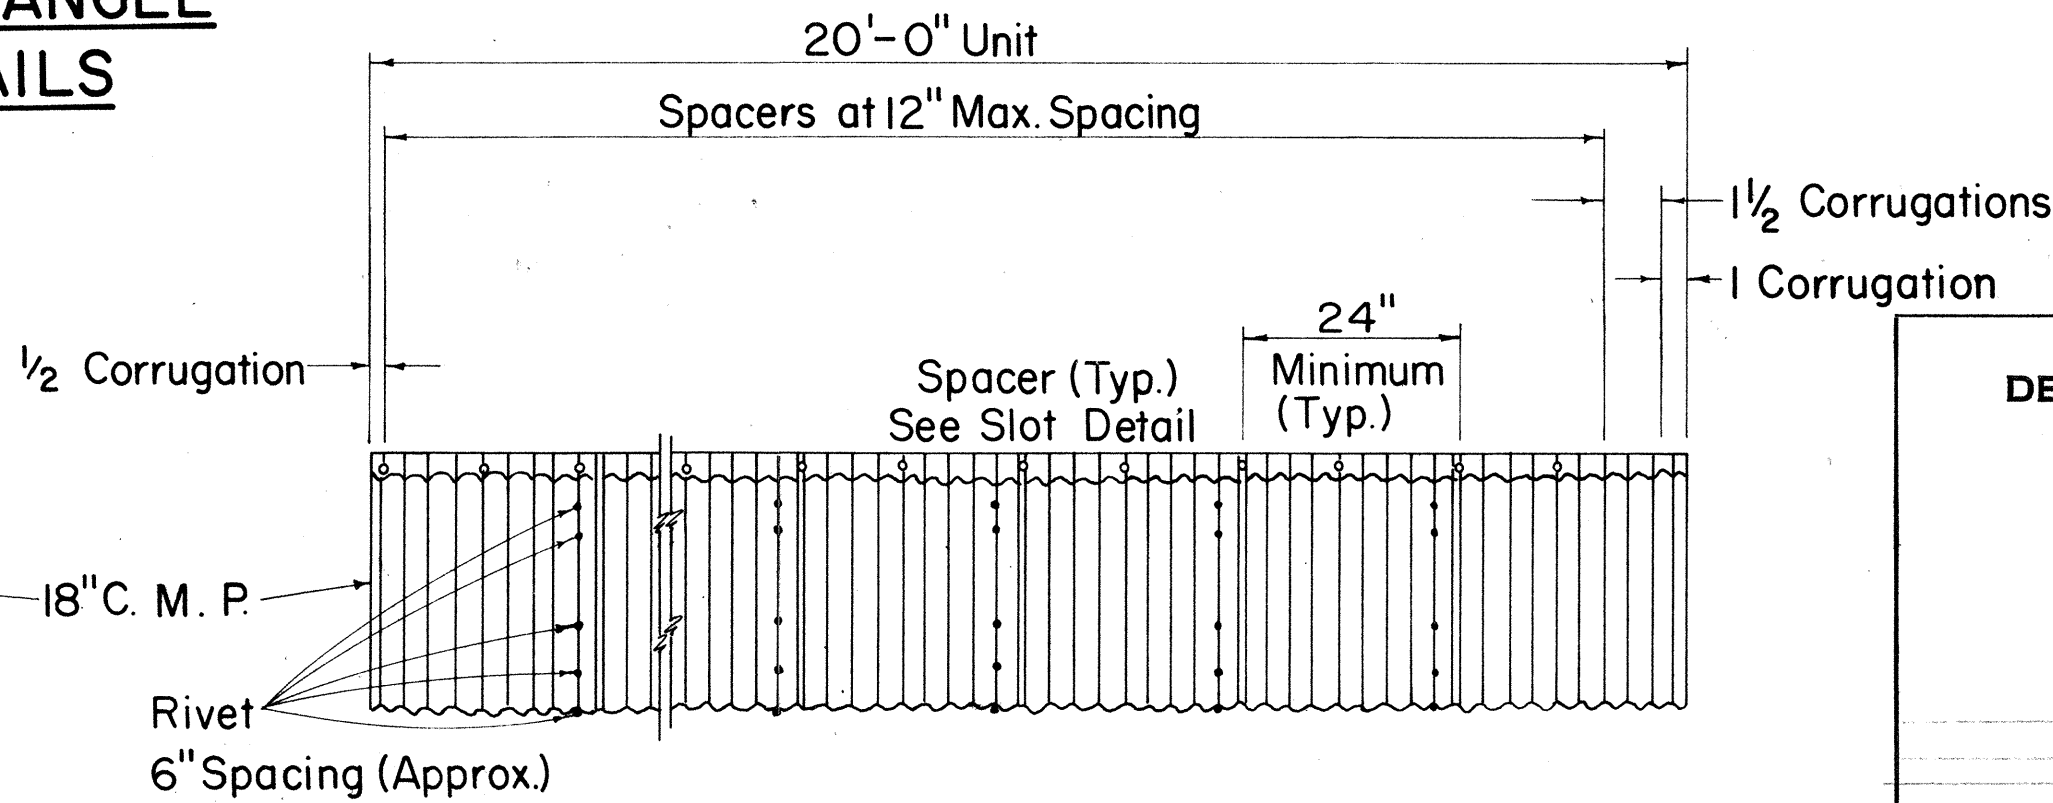


FLANGED SLOT DRAIN

STATE OF HAWAII DEPARTMENT OF TRANSPORTATION HIGHWAYS DIVISION
STANDARD DETAILS
18" SLOTTED C. M. P. DRAINS
INTERSTATE ROUTE H-1 PROJECT NO. I-HI-1(66)10
Not To Scale Date:
SHEET No. 13 OF 17 SHEETS

FED. ROAD DIST. NO.	STATE	FED. AID. PROJECT	FISCAL YEAR	SHEET NO.	TOTAL SHEETS
HAWAII	HAWAII	Z-HI-1(66)/10 Z-HI-1(67)/10	1970	50	57

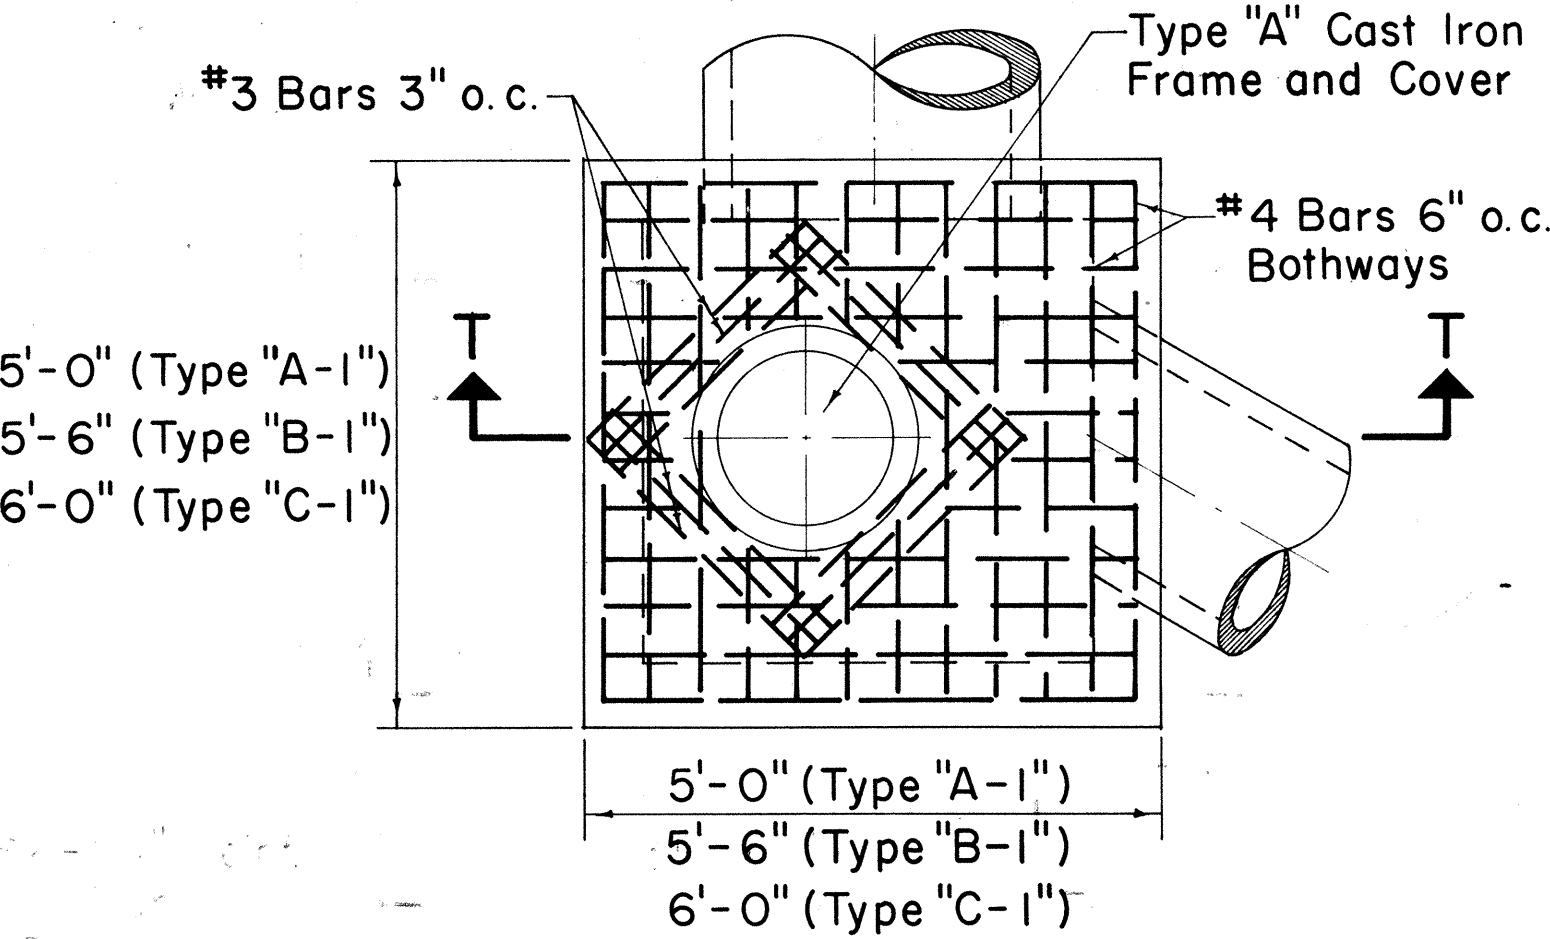

PLAN

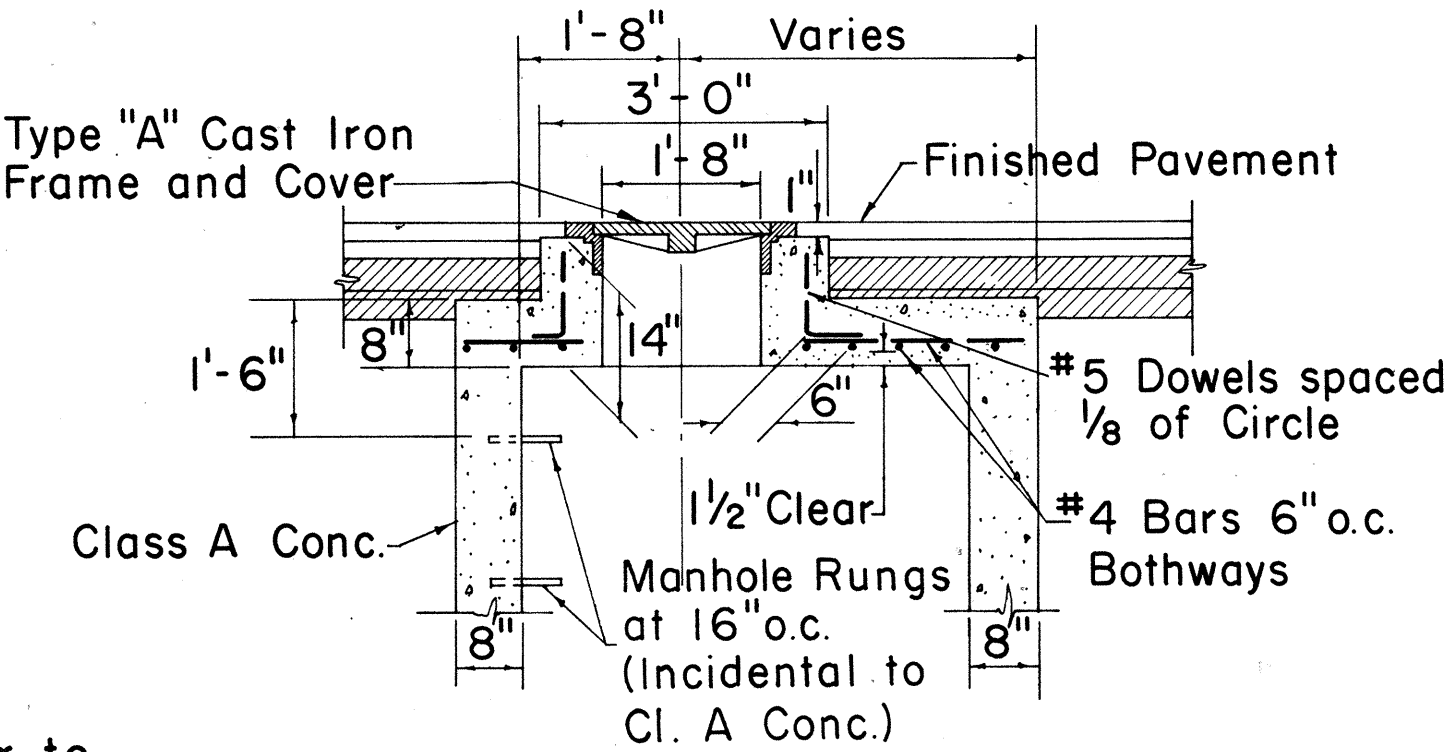

SECTION T-T


TYPE "A-I", "B-I", & "C-I"
STORM DRAIN MANHOLE
TOP DETAIL UNDER PAVEMENT

Scale: 1/2" = 1'-0"


Note:
Bottom detail similar to
Type "A", "B", & "C".

GENERAL NOTES


- Culvert shall enter and leave S.D.M.H. from any position and in the direction indicated by the plans or ordered by the Engineer.
- Manhole Rungs (16" o.c.) are required when "H" is greater than 4'-6". Only one rung (12" from the bottom) is required if "H" is 4'-6" or less. Type "A" C.I. Frame and Cover and Manhole Rungs may be placed at any location as ordered by the Engineer.

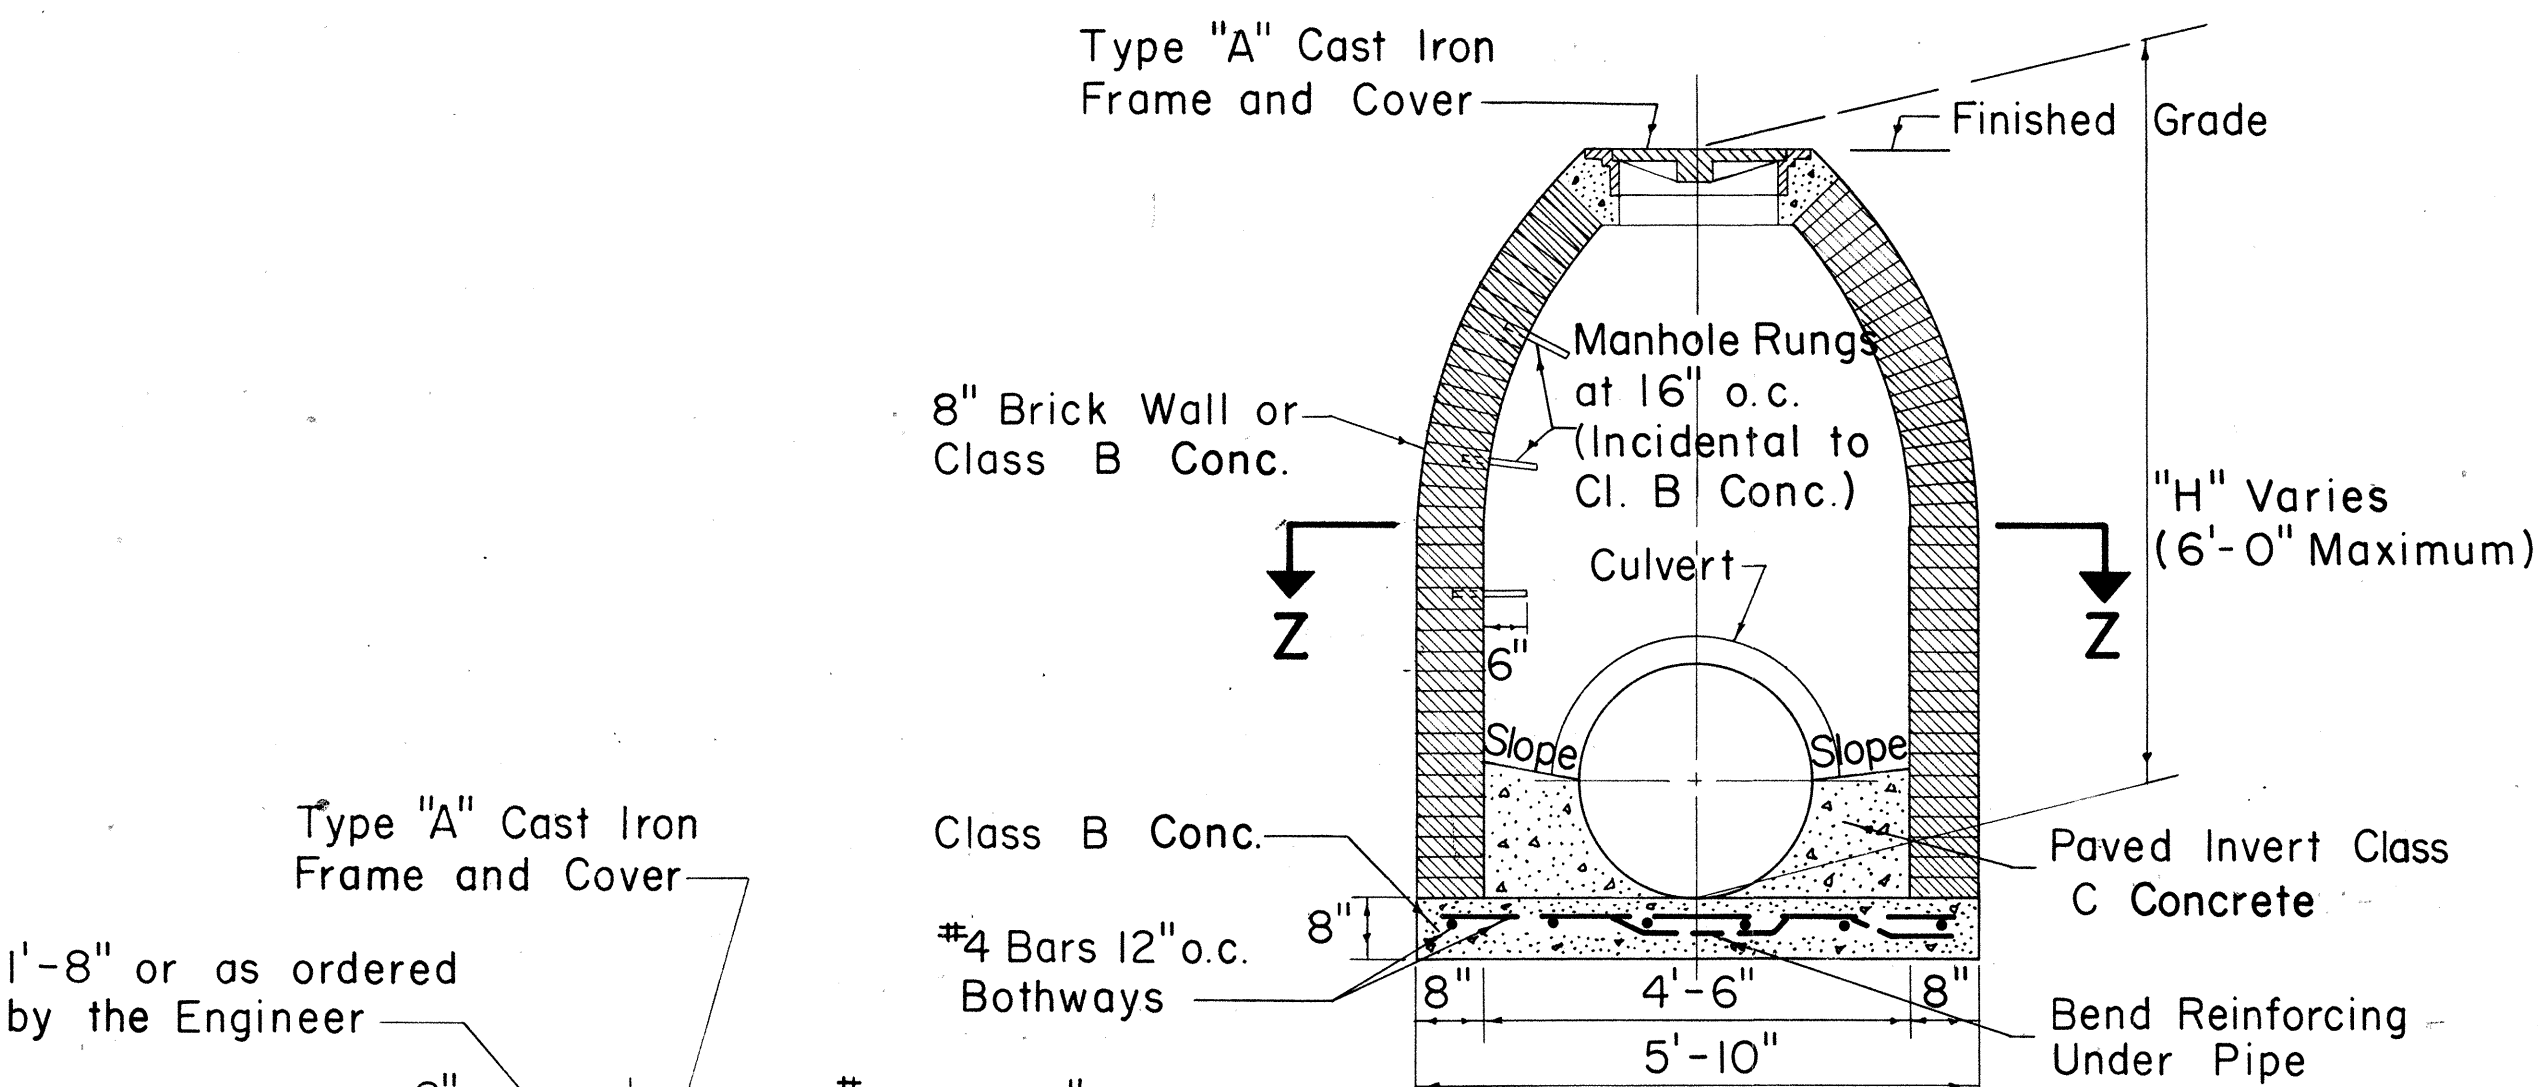

SECTION Y-Y

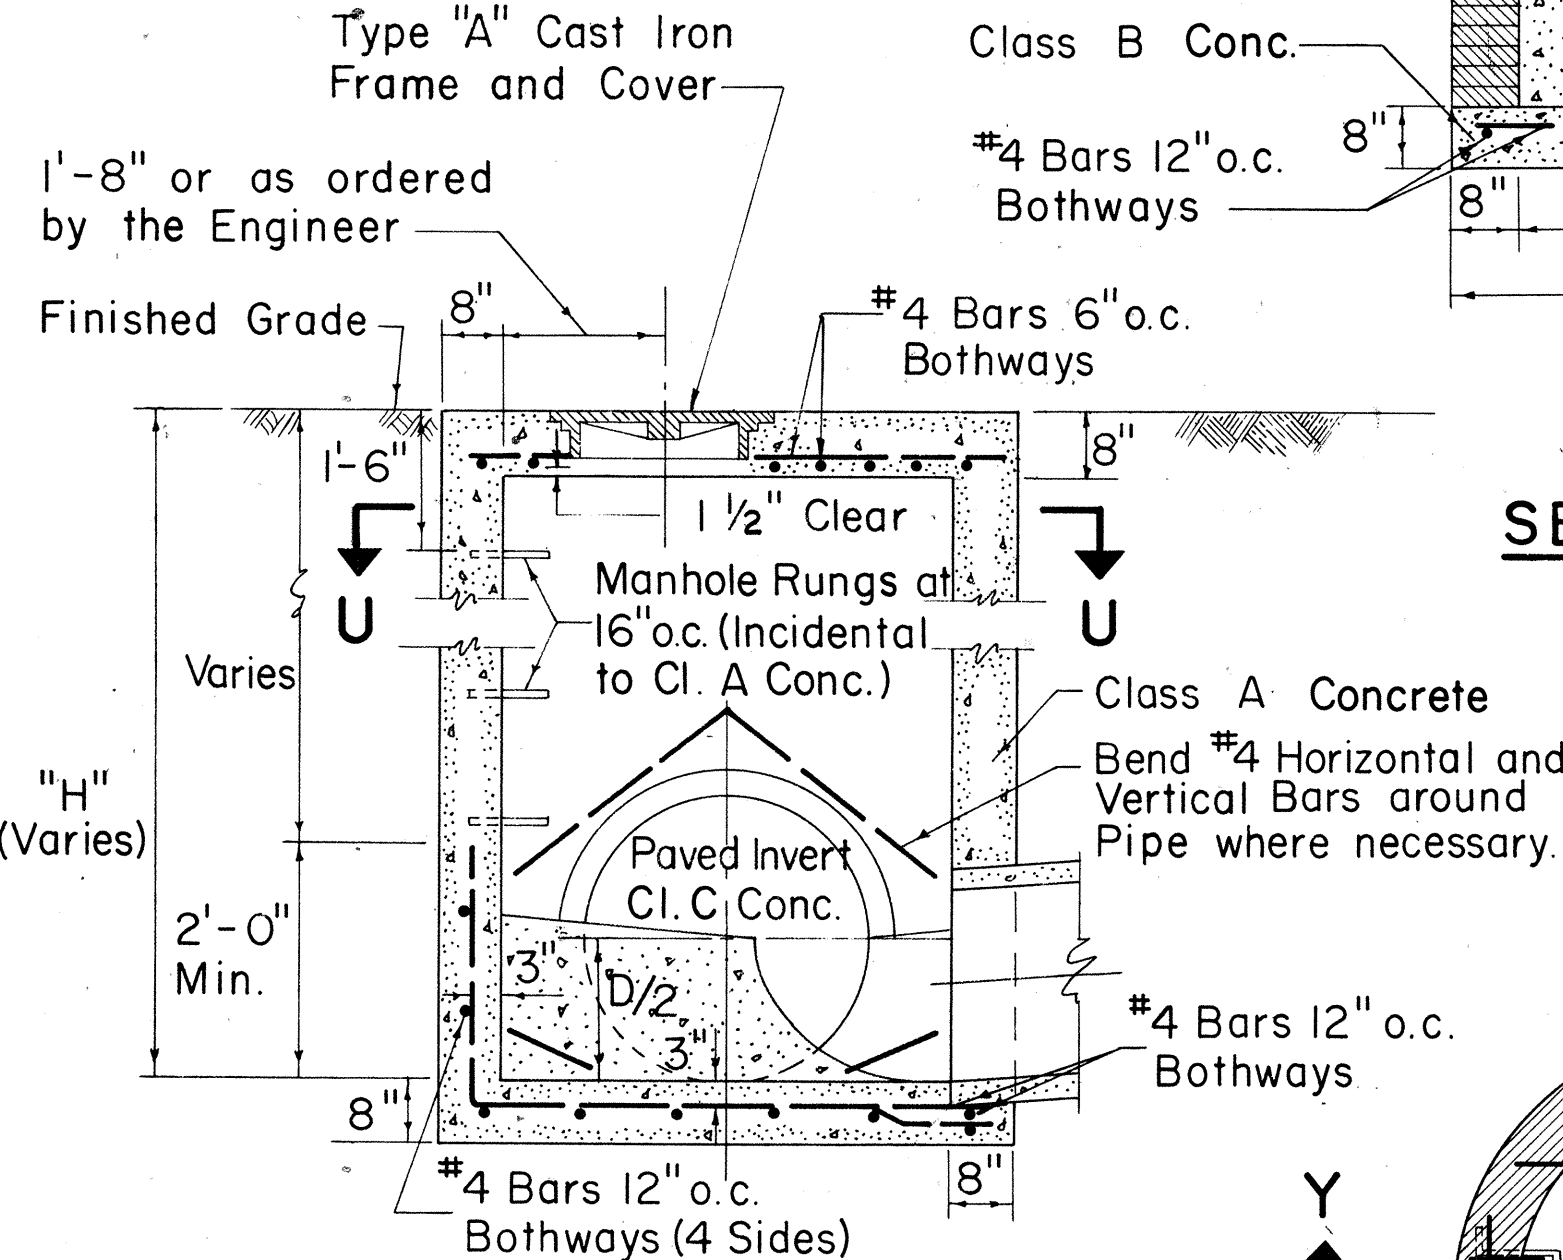

SECTION V-V

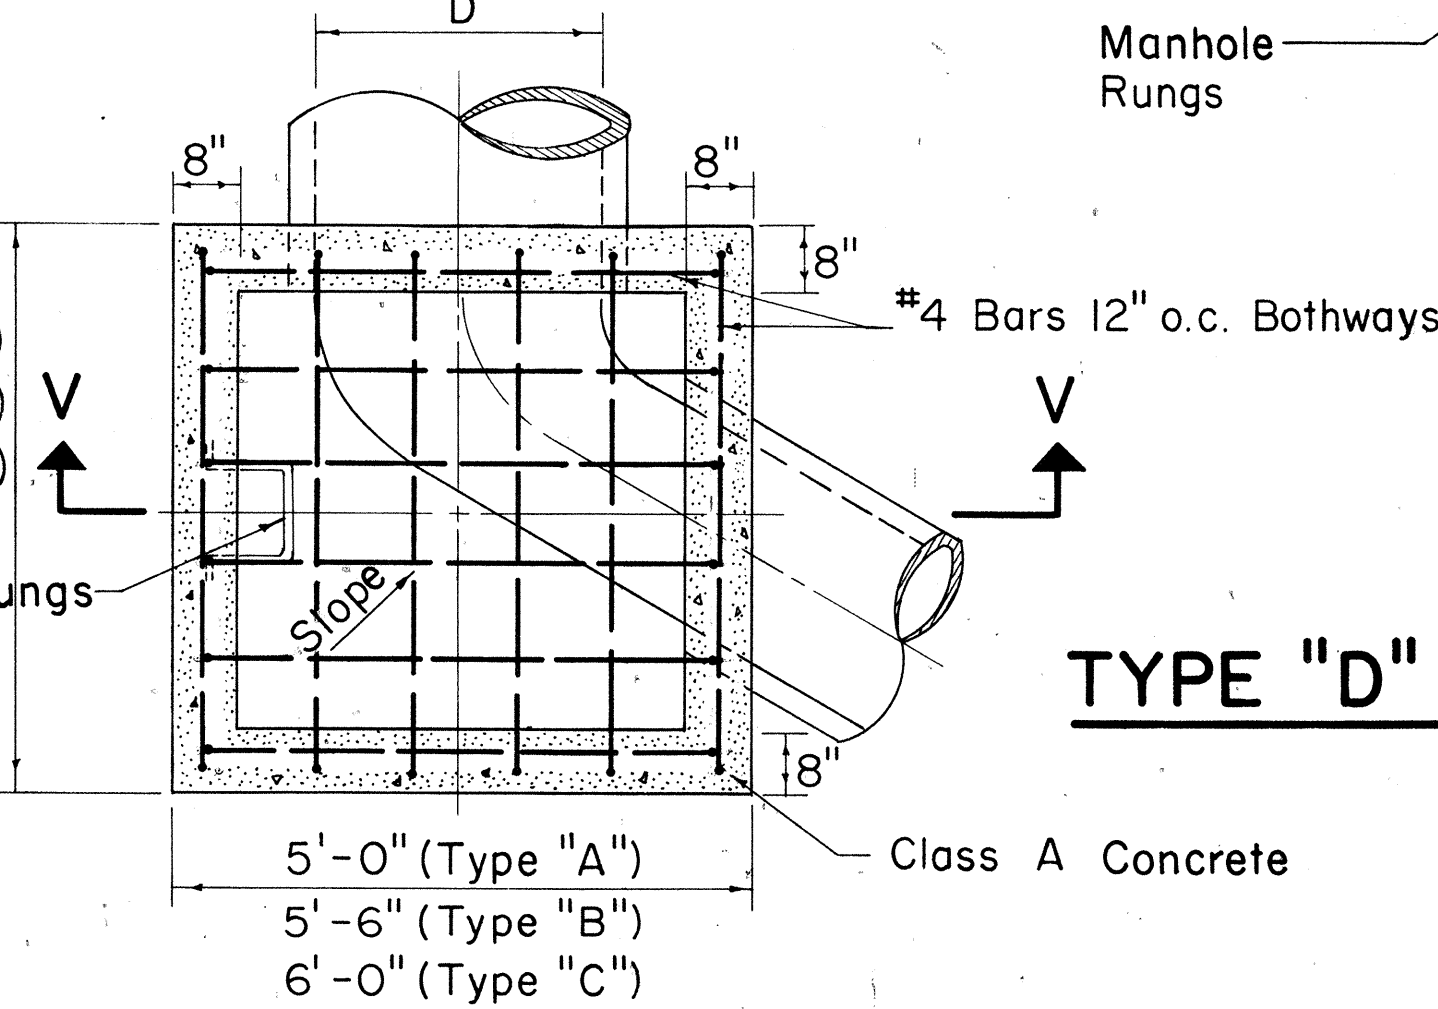


SECTION U-U

TYPE "A", "B", & "C"

S.D.M.H.


Scale: 1/2" = 1'-0"

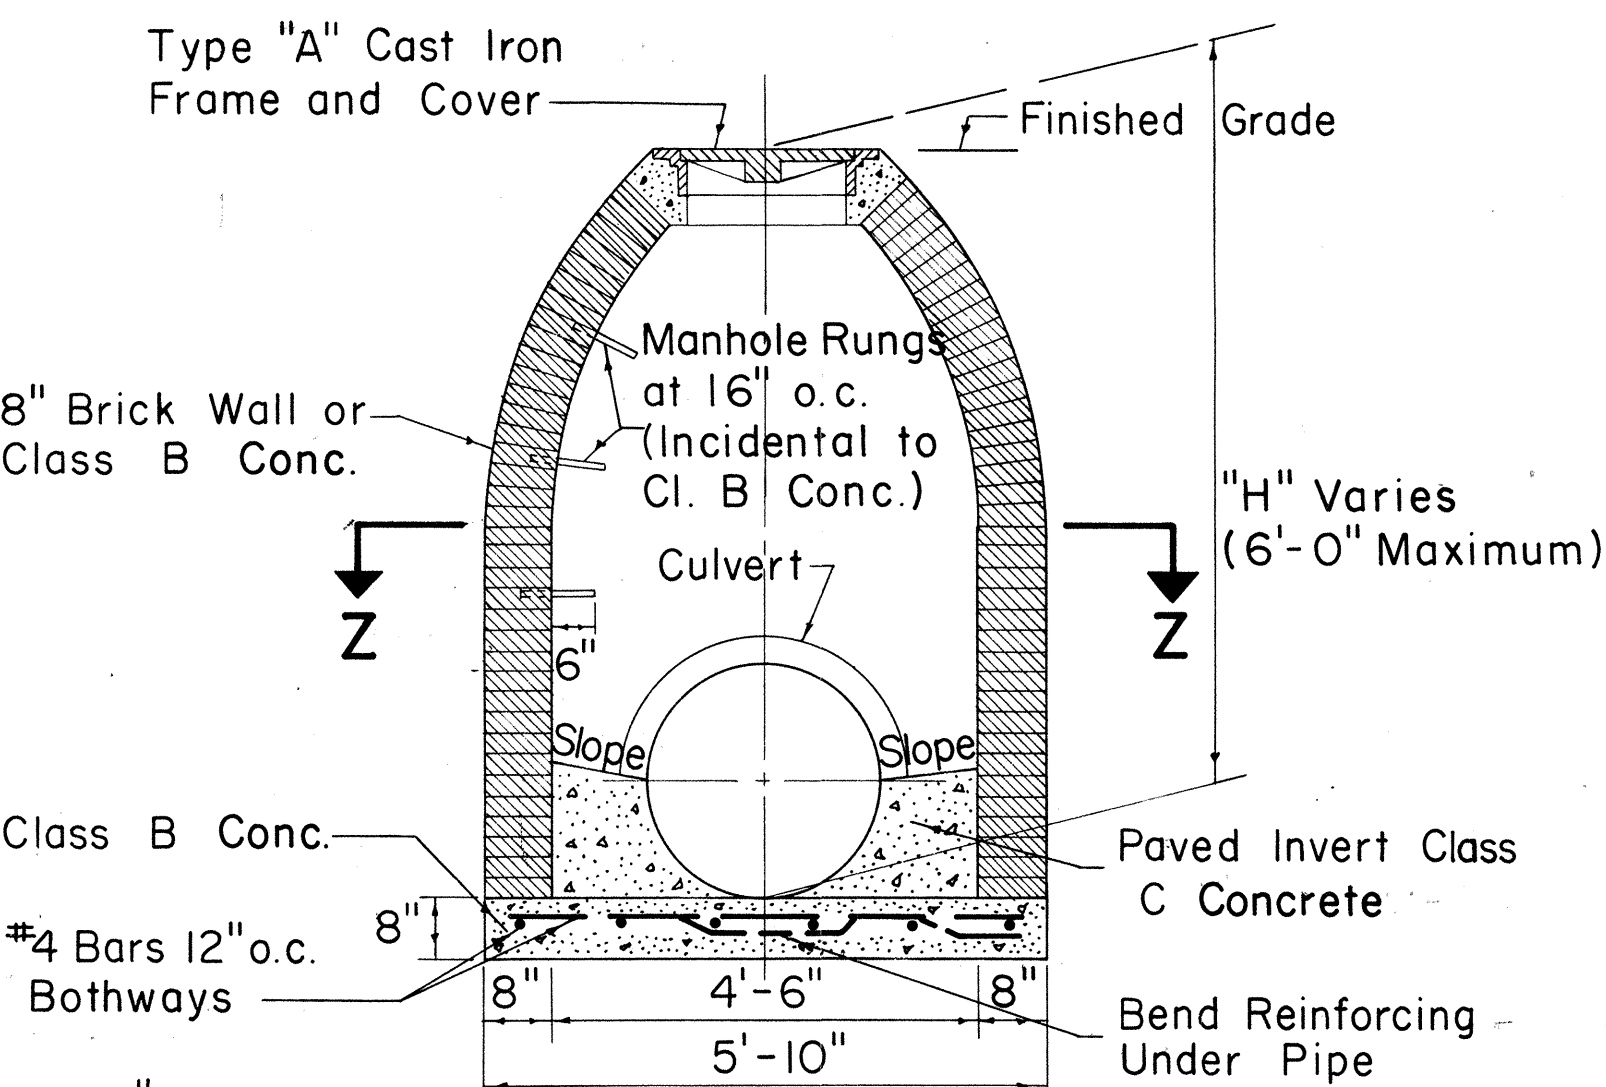


SECTION Z-Z

TYPE "D" STORM DRAIN MANHOLE

Scale: 1/2" = 1'-0"

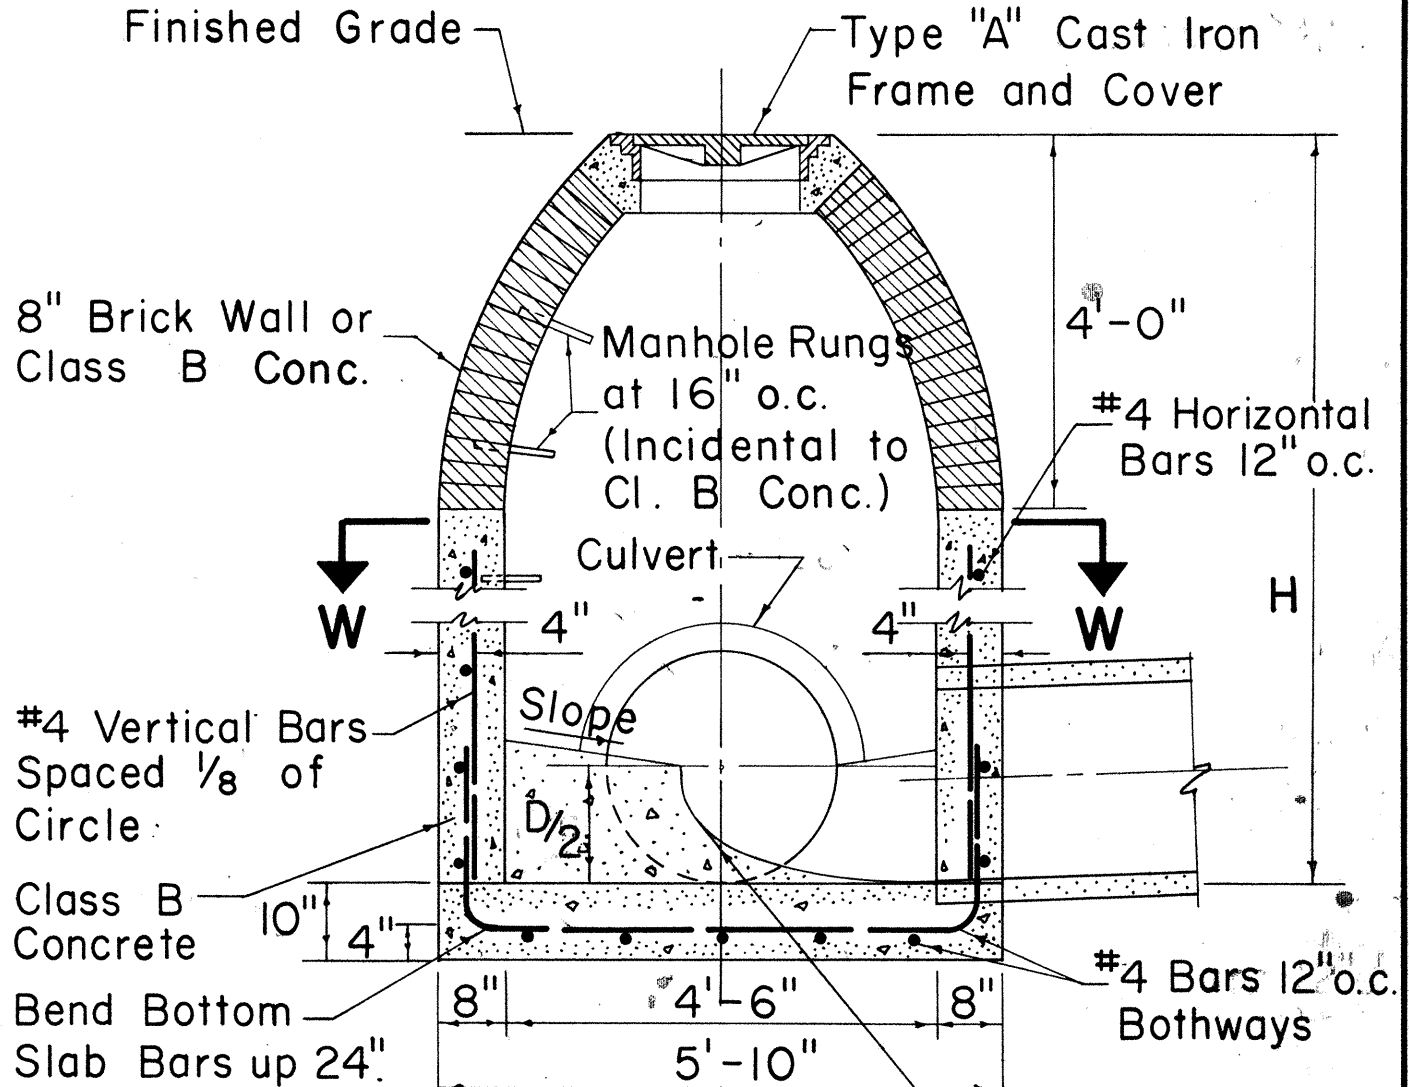

SECTION X-X

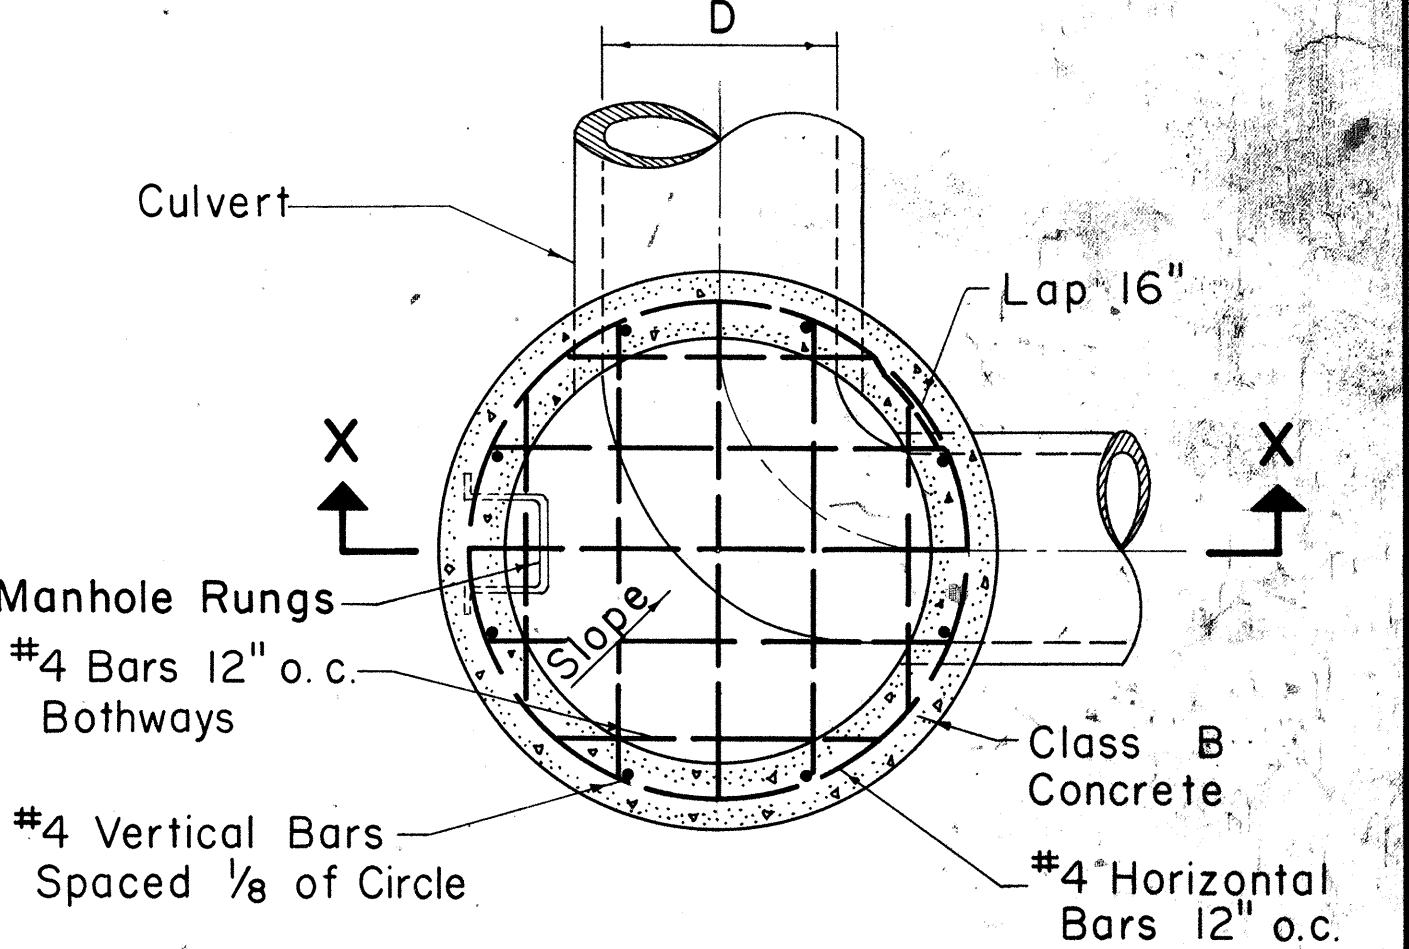

SECTION W-W

TYPE "E" STORM DRAIN MANHOLE

Scale: 1/2" = 1'-0"

NOTE:

- Exterior surface of brick wall shall be plastered with 1" thickness of 1:2 Cement Mortar.
- Number, size and direction of culvert at manhole to be as shown on plans.
- Paved invert not required at drop manholes.
- All Class C Concrete to be incidental to Class B Concrete.



STATE OF HAWAII
DEPARTMENT OF TRANSPORTATION
HIGHWAYS DIVISION

STANDARD DETAILS
STORM DRAIN MANHOLES

Scales: As Noted Date: July, 1969

SHEET NO. 14 OF 17 SHEETS

FED. ROAD DIST. NO.	STATE	FED. AID PROJ. NO.	FISCAL YEAR	SHEET NO.	TOTAL SHEETS
HAWAII	HAW.	I-HI-1166-10 I-HI-1167-10	1970	91	97

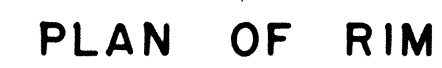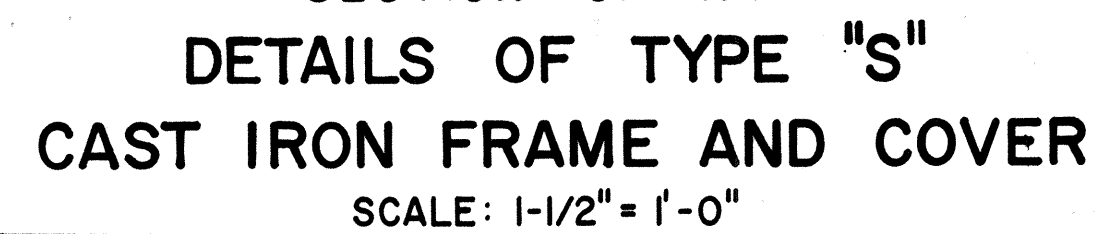

DETAILS OF TYPE "B"
CAST IRON FRAME AND COVER

SCALE : 1-1/2" = 1'-0"



DETAILS OF TYPE "A"

CAST IRON FRAME AND COVER

SCALE: 1-1/2" = 1'-0"




TYPE C C.I. FRAME AND GRATE

SCALE: 3/4" = 1'-0"



SCALE: 1-1/2" = 1'-0"

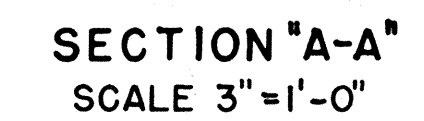

DETAILS OF TYPE "W" CAST IRON FRAME AND COVER

SCALE: 1-1/2" = 1'-0"

STATE OF HAWAII
DEPARTMENT OF TRANSPORTATION
HIGHWAYS DIVISION

STANDARD DETAILS CATCH BASIN AND MANHOLE CASTINGS

Scale: As Noted

Date: July, 1969

SHEET No 15 OF 17 SHEETS

91


ORIGINAL PLAN	SURVEY PLOTTED BY.....	DATE.....
NOTE BOOK	DRAWN BY.....	".....
	TRACED BY.....	".....
	QUANTITIES BY.....	".....
	CHECKED BY.....	".....
No.....		

FED. ROAD DIST. NO.	STATE	FED. AID PROJ. NO.	FISCAL YEAR	SHEET NO.	TOTAL SHEETS
HAWAII	HAW.	I-H-1-(66)10	1970	22	27

NOTES:

- For typical Headwall details see sheet 22.
- Face of new Headwall to be flush with face of exist. Headwall.
- *Top of new Headwall to be at same elevation as top of exist. Headwall.
- Invert elevations shown on the plans and details for the 3-72" x 44" C.M.P. Arch culverts are approximate. The contractor shall set the inverts of the 3 Arch culverts at the same invert elevation as the existing 6'-0" x 3'-6" box culvert.
- The contractor shall remove all rocks, debris and sediment in the existing 6'-0" x 3'-6" box culvert and payment shall be considered incidental to the various contract items.

Clean and Roughen exist. Surface to improve bond.

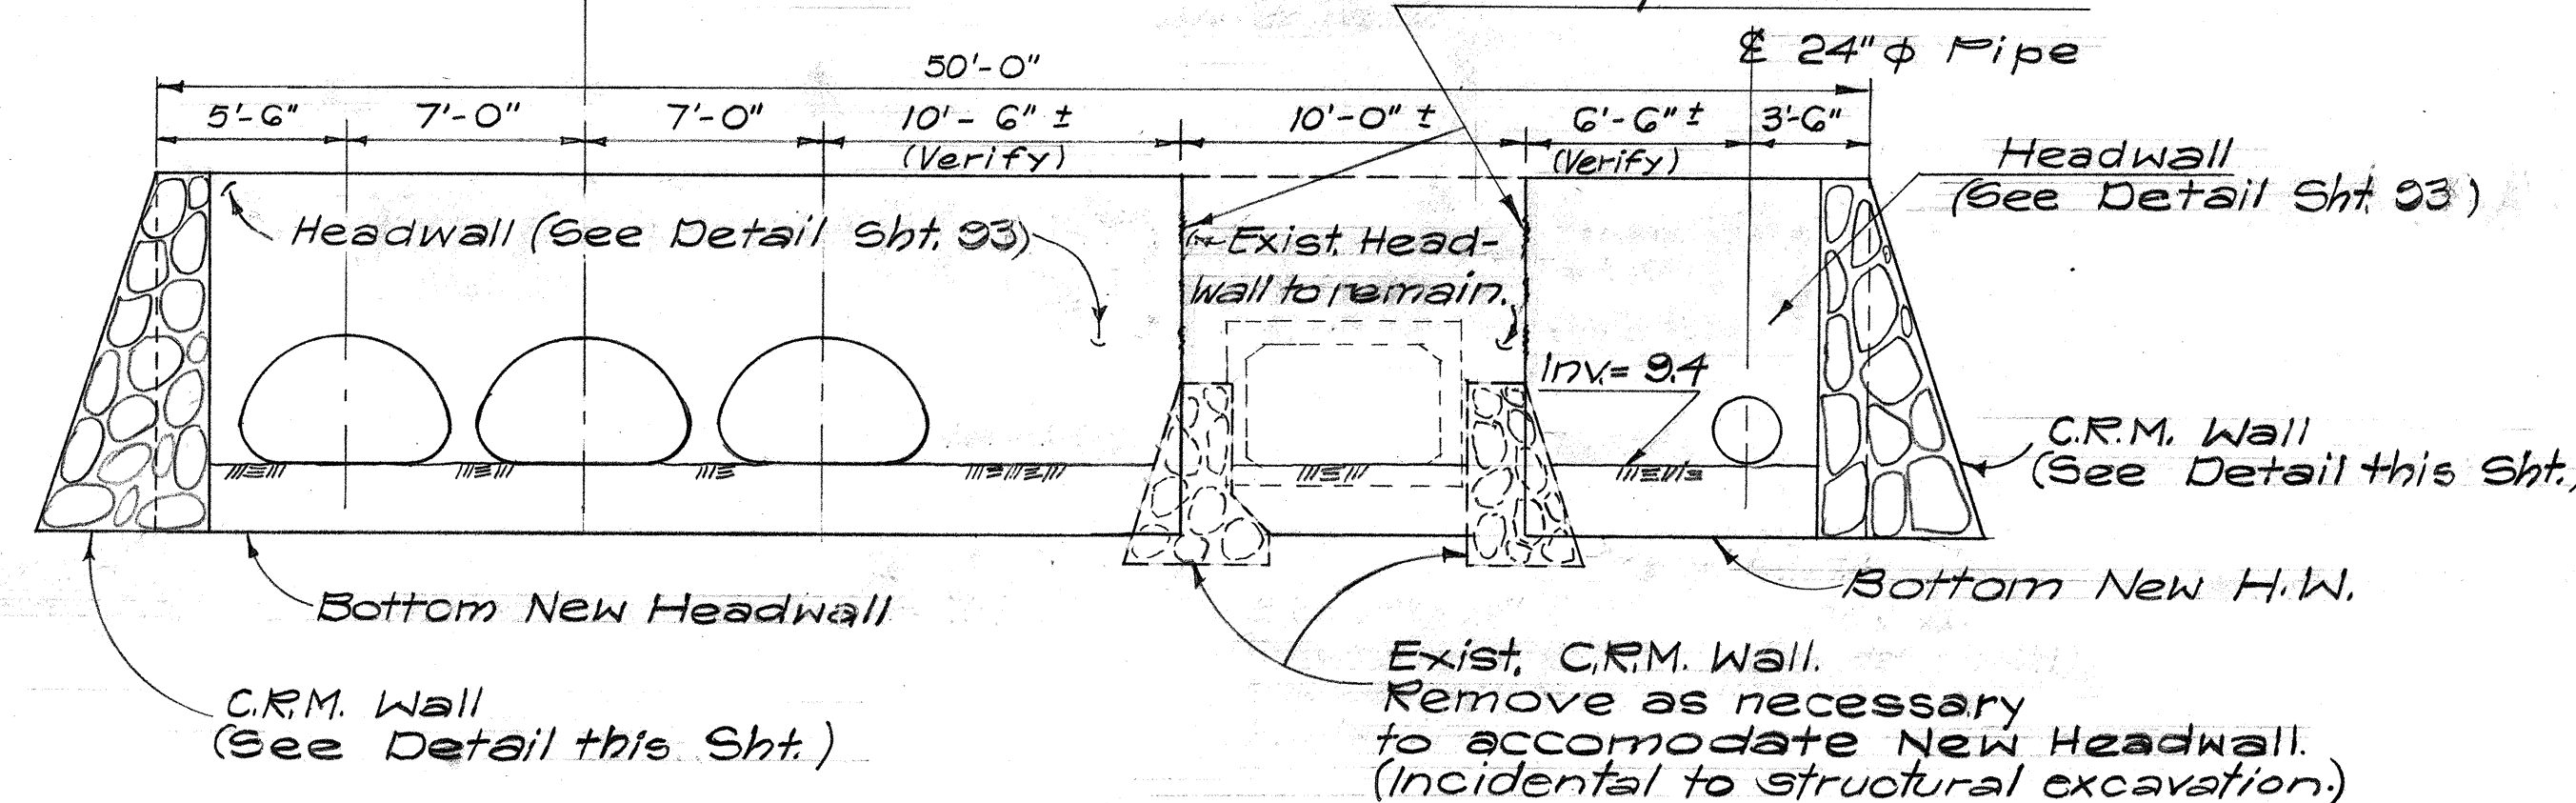


OUTLET ELEVATION

Scale: 3/16" = 1'-0"

ESTIMATED QUANTITIES:

Class "A" Conc.	22 C.Y.
Class "B" Conc.	2 C.Y.
Reinforcing Steel	2000 L.B.
Cement Rubble Masonry	90 C.Y.
Structure Excavation	1374 C.Y.
Brick wall for S.D.M.H.	4 L.F.
72" x 44" C.M.P. ARCH	332 L.F.
24" φ 12 Ga. C.M.P. or 24" φ C.I. III R.C.P. or A.C.P.	125 L.F.
Type "A" C.I. Frame and Cover	1 Ea.

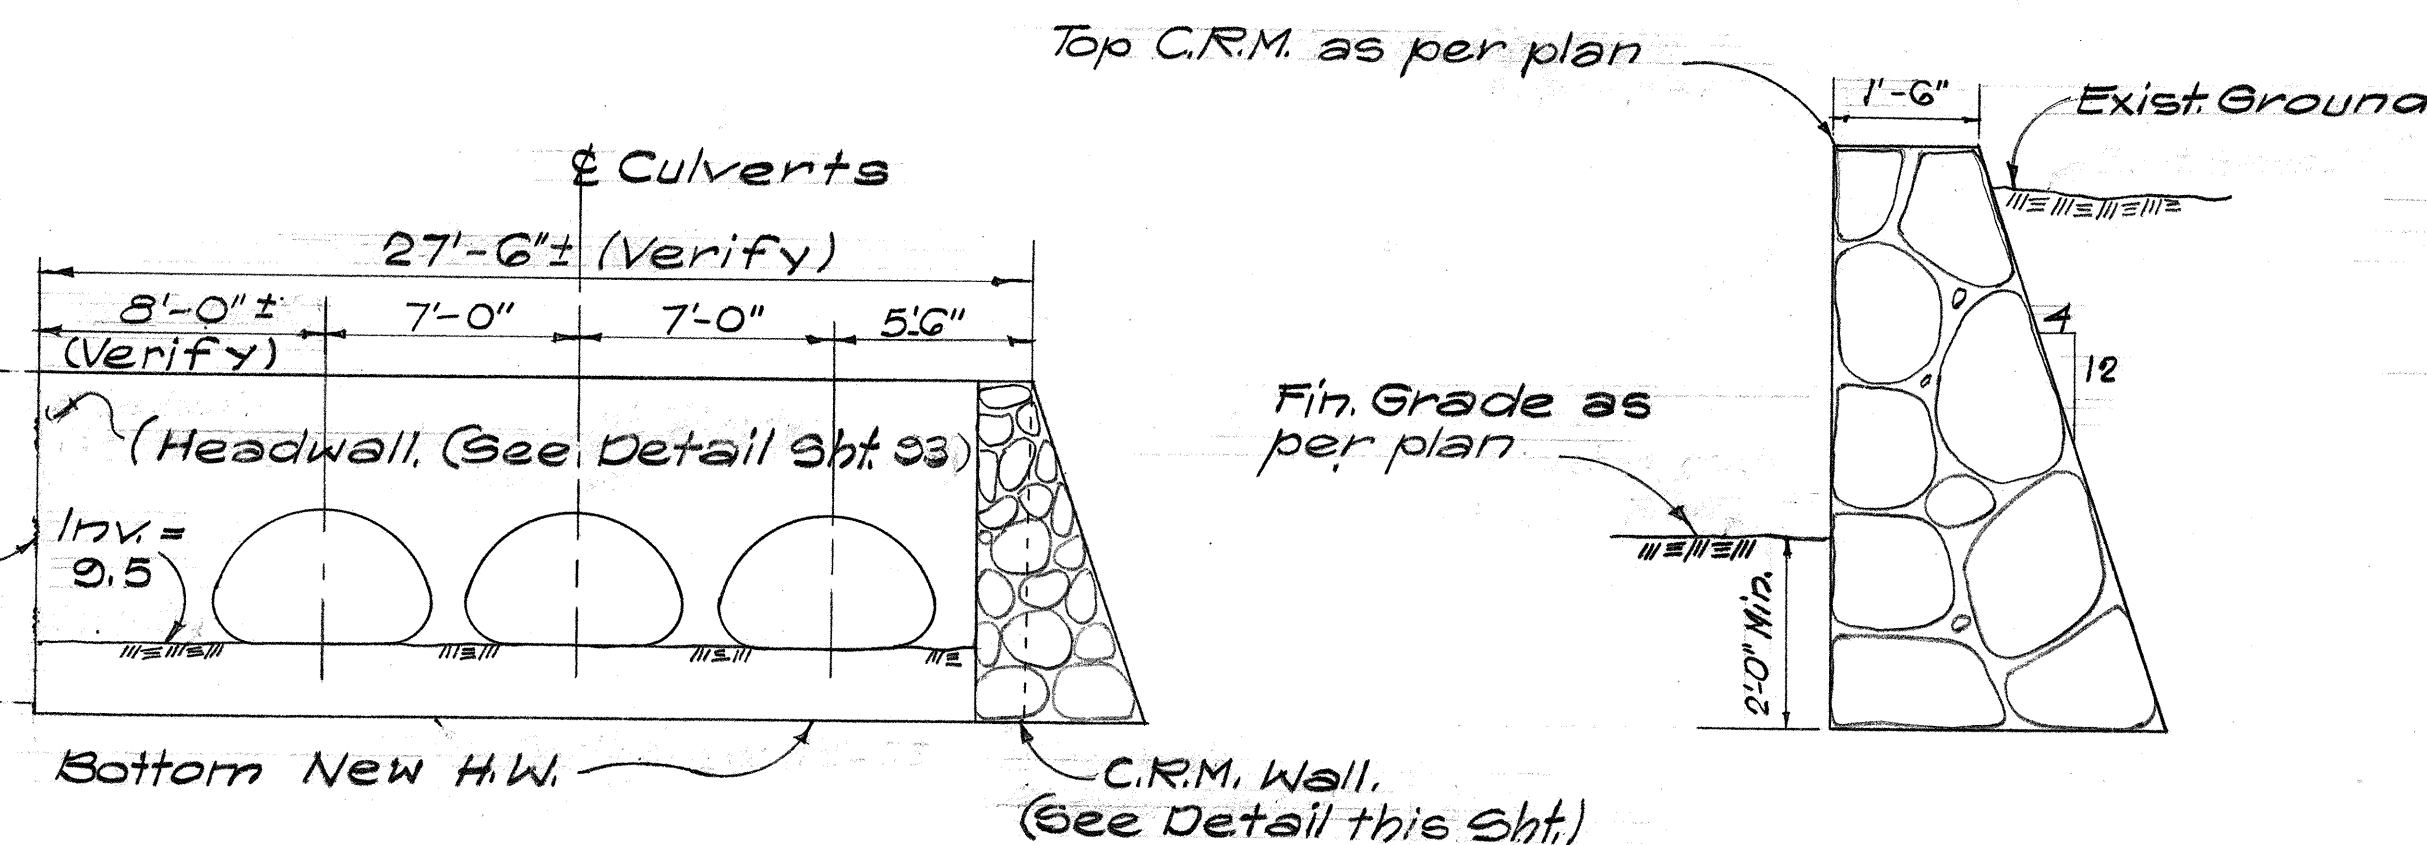


INLET ELEVATION

Scale: 3/16" = 1'-0"

C.R.M. WALL DETAIL


Scale: 1/2" = 1'-0"

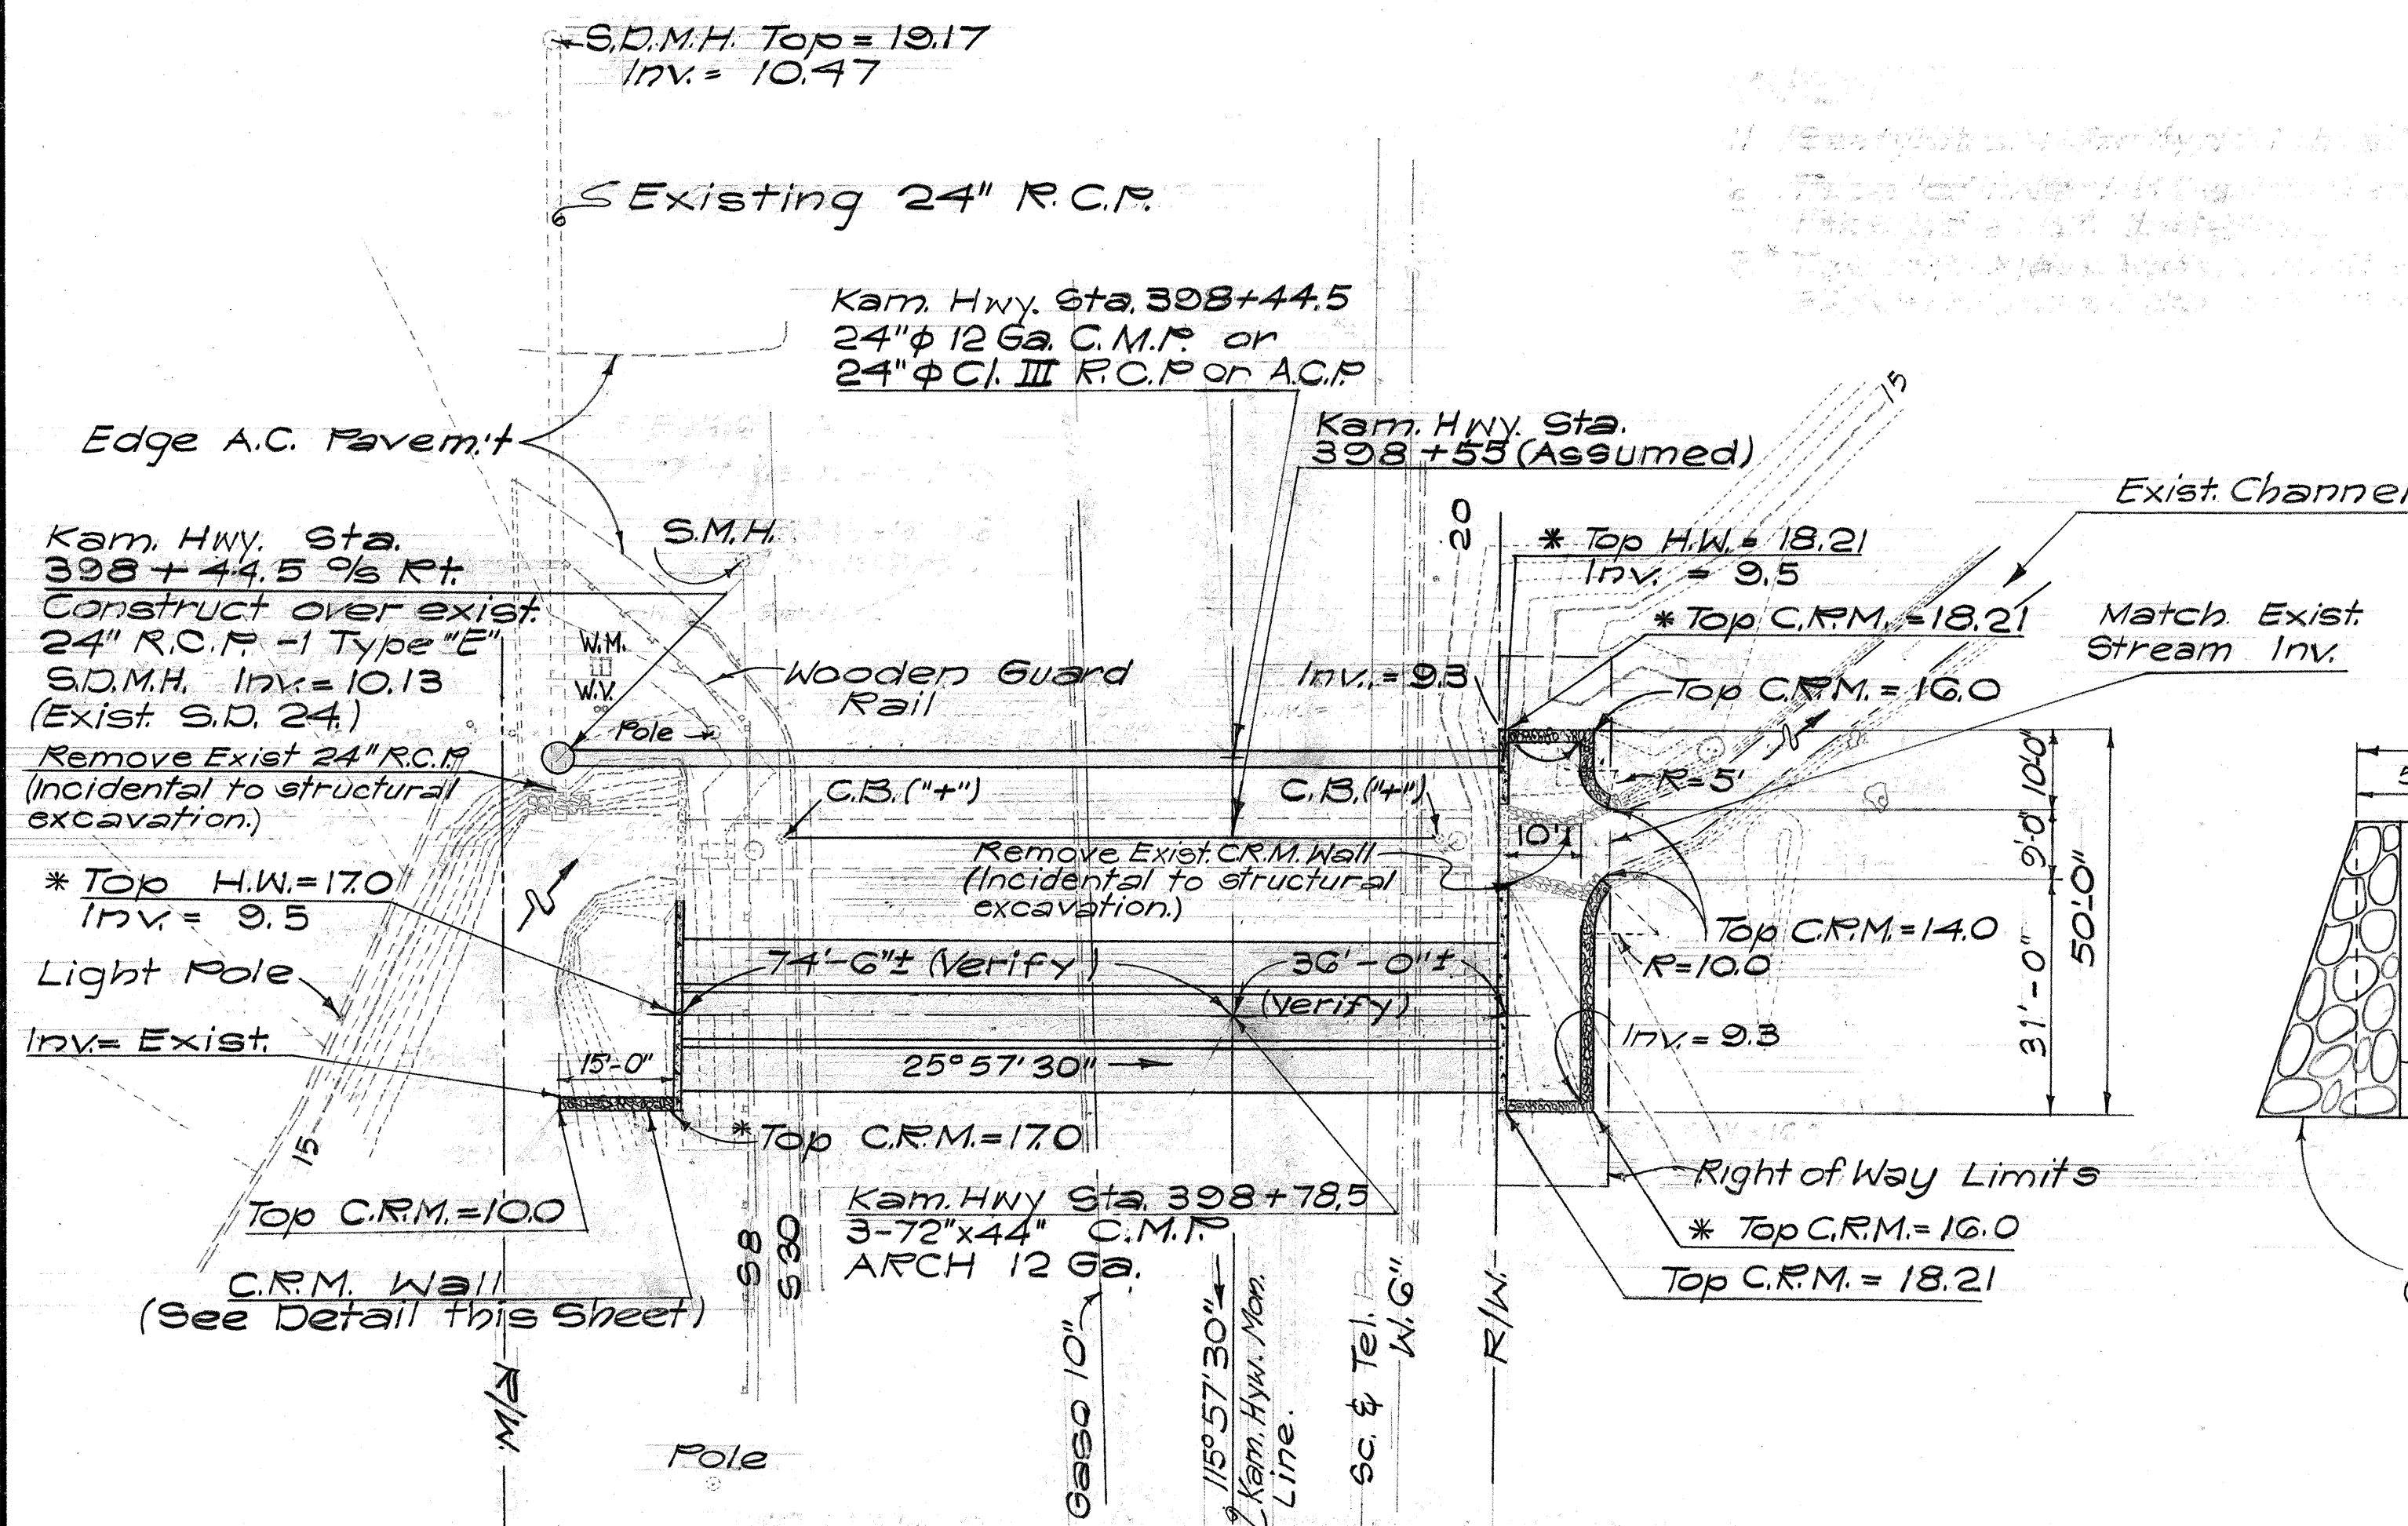

PLAN: 3-72" x 44" C.M.P. ARCH 12 Ga. (No Option)

1-24"-12 Ga. C.M.P. or 24" C.I. III R.C.P. or A.C.P.

Scale: 1" = 20'

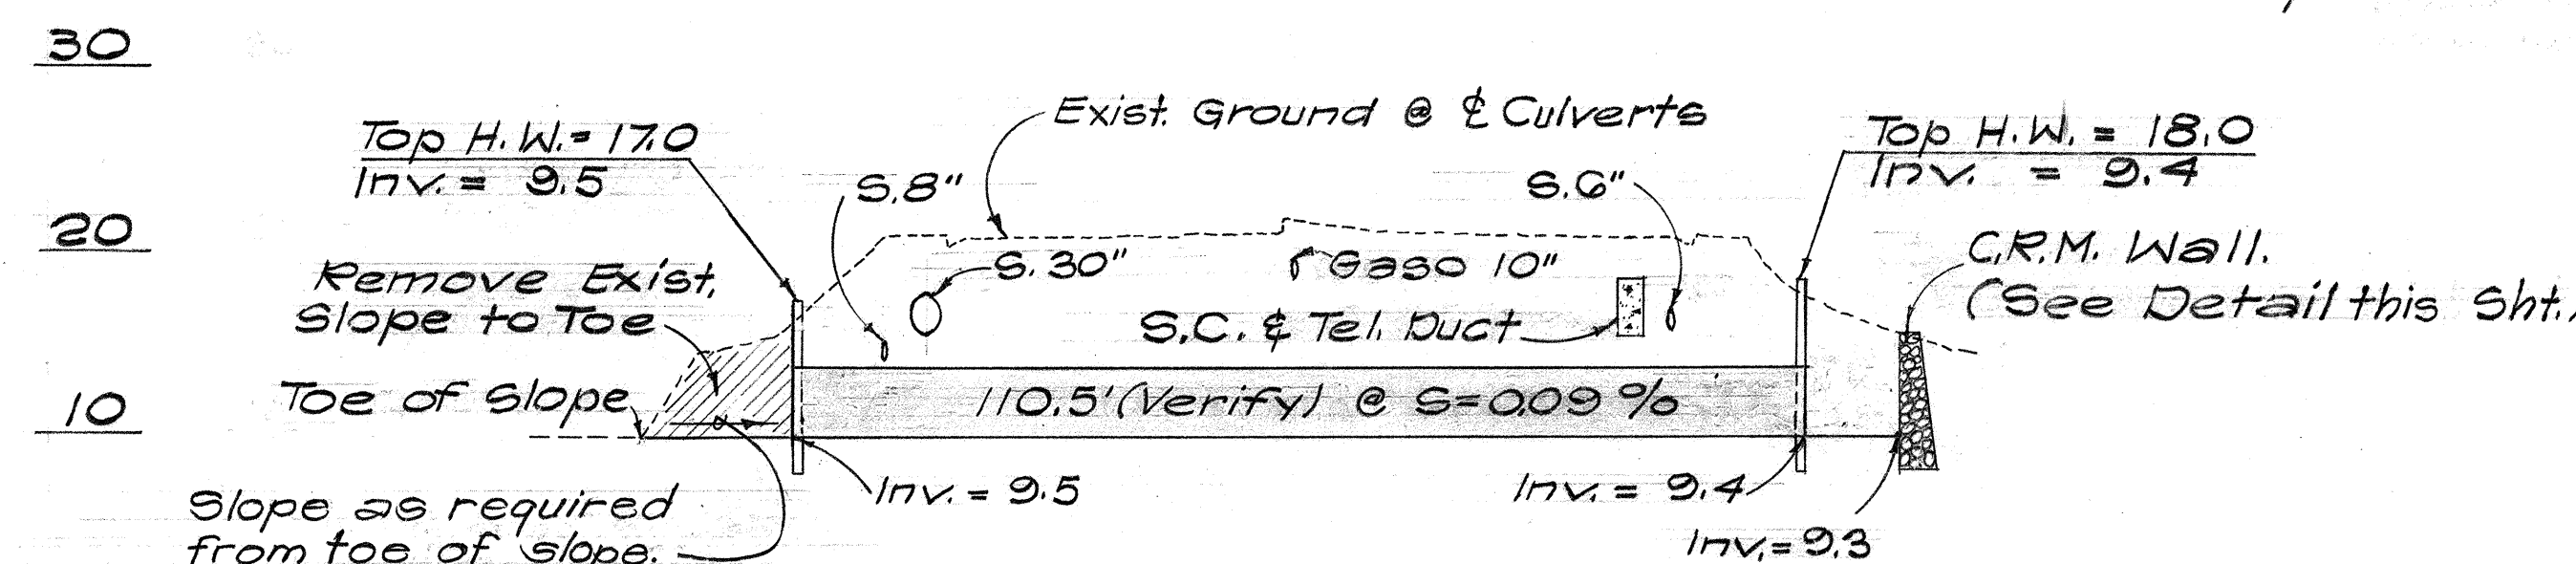

PROFILE: 3-72" x 44" C.M.P. ARCH 12 Ga.





Scale: Hor. 1" = 20'
Vert. 1" = 10'



THIS WORK WAS PREPARED BY ME OR UNDER MY SUPERVISION.


STATE OF HAWAII DEPARTMENT OF TRANSPORTATION HIGHWAYS DIVISION	
3-72" x 44" C.M.P. ARCH 12 Ga. 1-24"-12 Ga. C.M.P. or 24" C.I. III R.C.P. or A.C.P. CROSSING KAMEHAMEHA HIGHWAY	
INTERSTATE ROUTE H-1 PROJ. NO. I-H-1-(66)10	
Scale: As Shown	Date:
SHEET No. 16 OF 17 SHEETS	

FED. ROAD DIST. NO.	STATE	FED. AID PROJ. NO.	FISCAL YEAR	SHEET NO.	TOTAL SHEETS
HAWAII	HAW.	1-H-1(66):10 1-H-1(67):10	1970	33	37

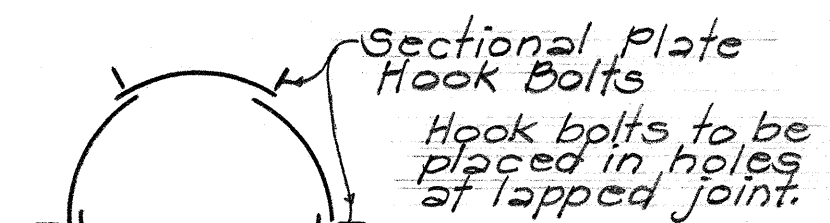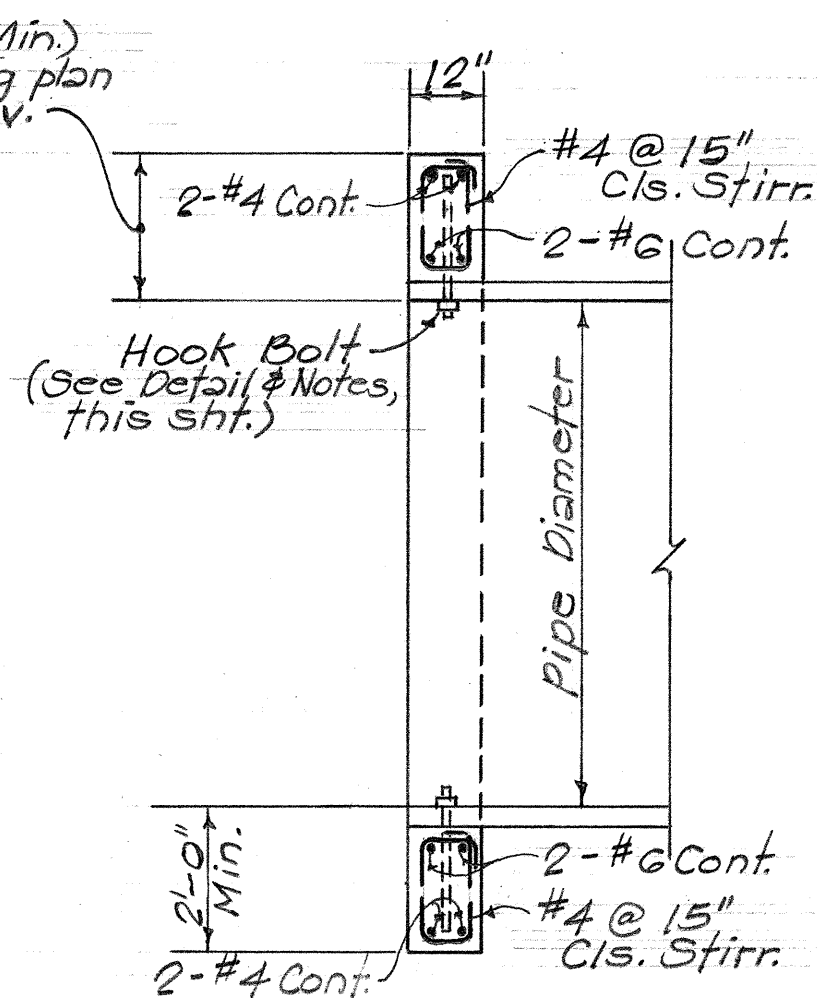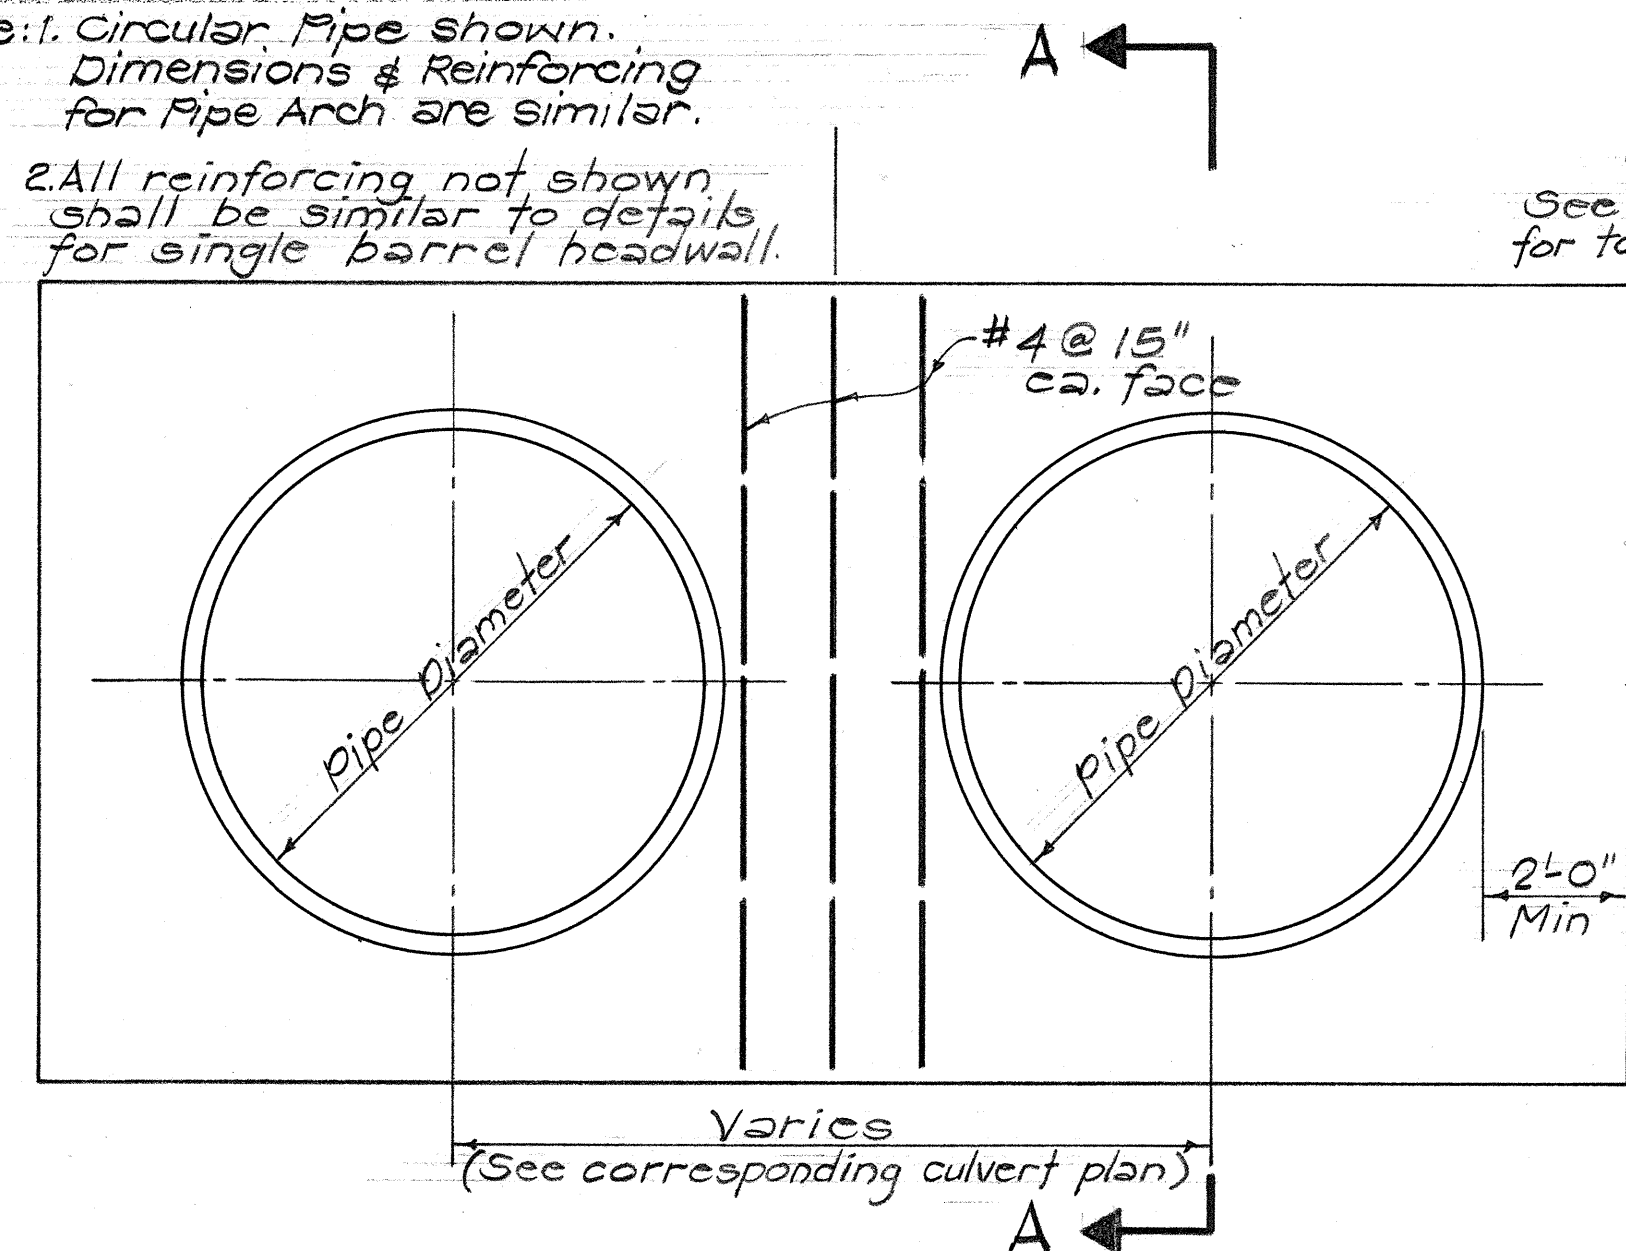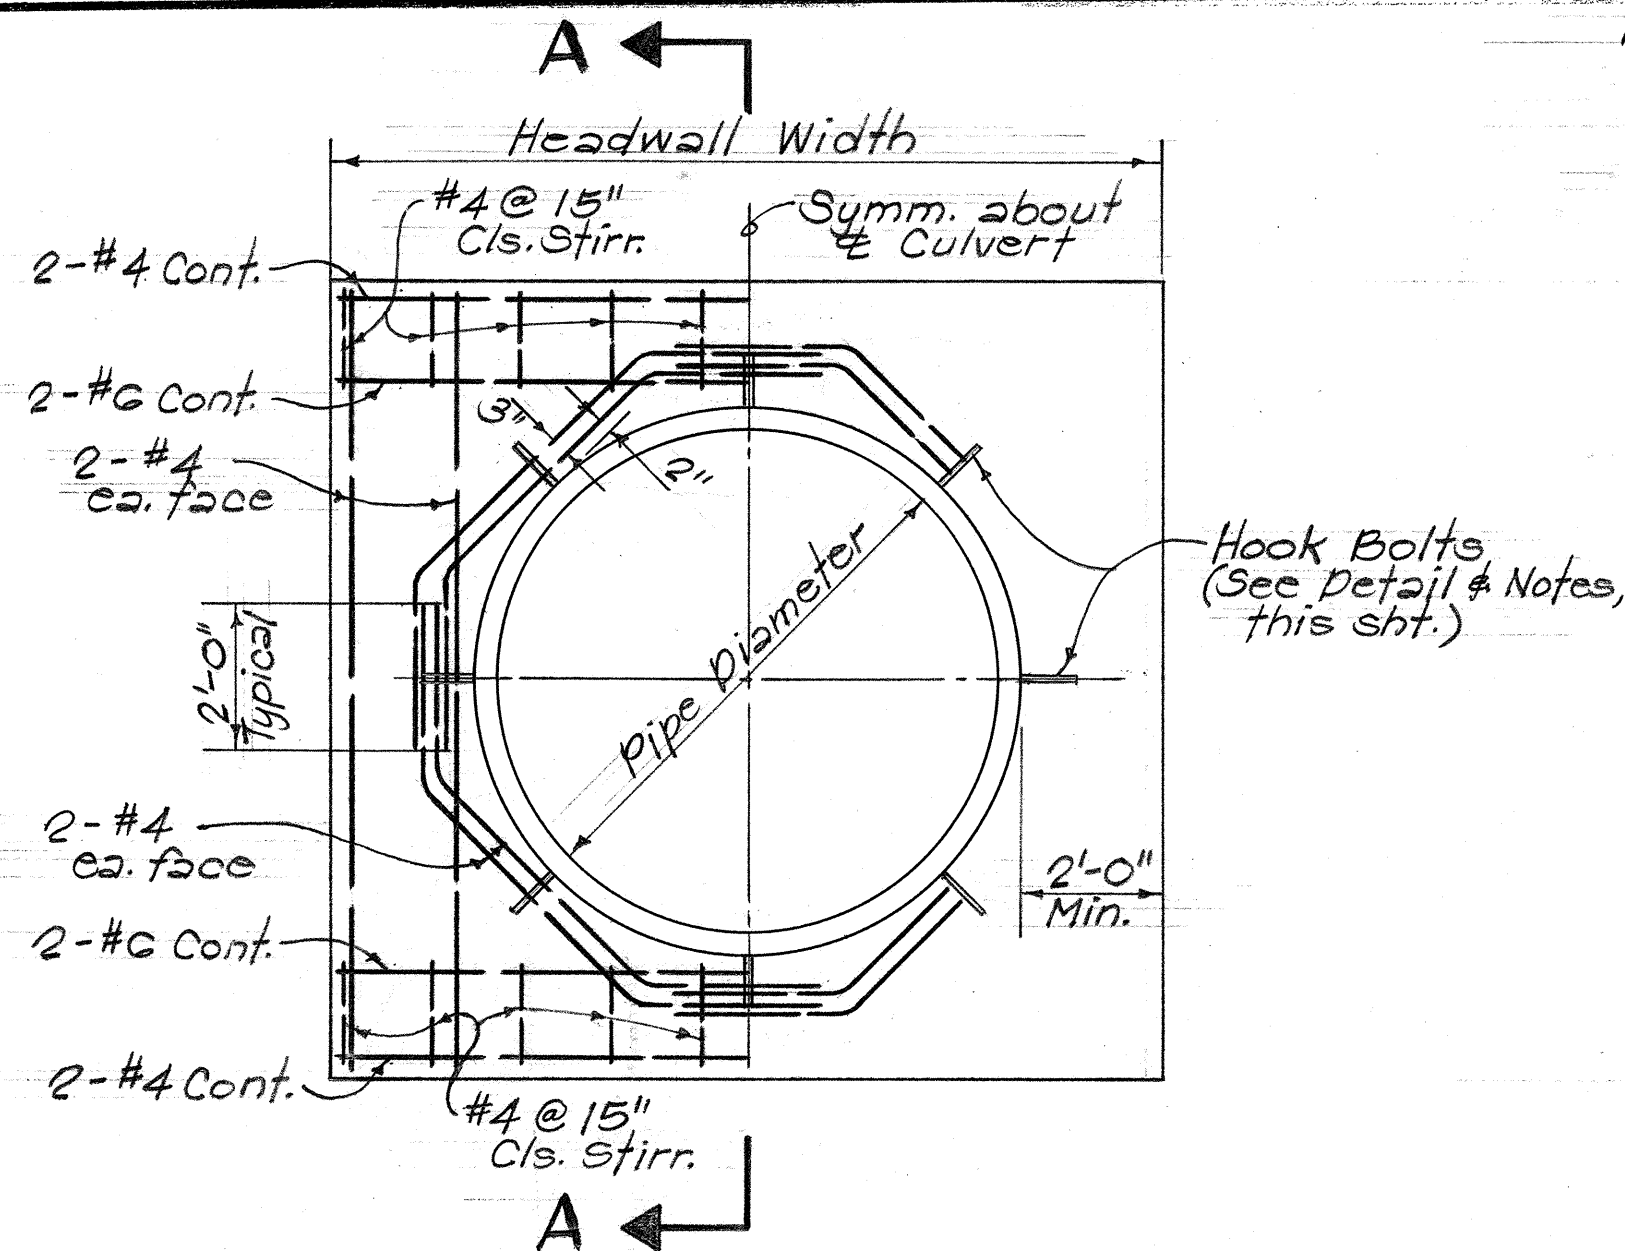

Note: Hook bolts shall be used only with Sectional Plate Pipe Culverts.

LOCATION OF HOOK BOLTS AT HEADWALL

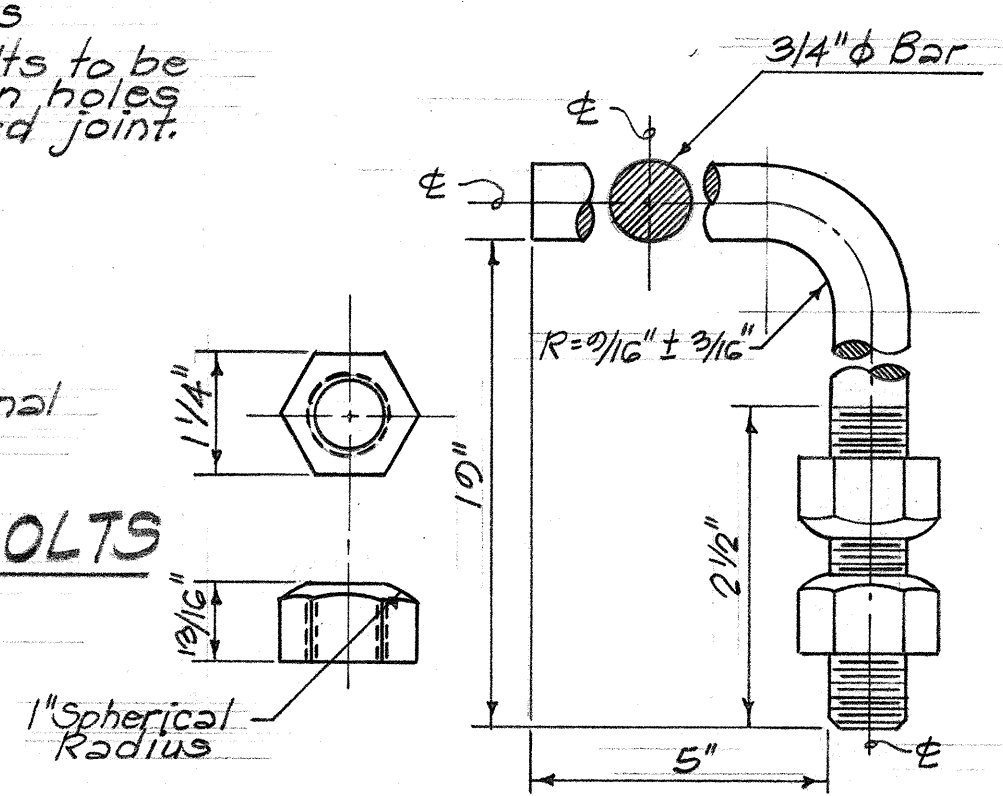

HOOK BOLT DETAIL

NOTE: Hook Bolt material shall meet the current ASTM A-307. Thread shall be American Standard Coarse Thread Series, Class 2, Free Fit. Bolts shall be galvanized to meet current ASTM Specification A-153. The galvanizing on thread portion shall not prevent turning the nut by hand. Nuts shall be carbon steel hot dip galvanized to meet ASTM Specification A-153. Nut threads shall be American Standard Coarse Thread Series (1/4" maximum oversize), cleaned after galvanizing to provide a free running fit on the Class 2 bolt. Nuts shall be 1/4" across flats, 13/16" thick, curve crowned to approximately 1" radius.




FRONT ELEVATION - SINGLE BARREL

FRONT ELEVATION - MULTIPLE BARREL

SECTION "A-A"


TYPICAL PIPE CULVERT HEADWALL DETAILS

Scale: 3/8" = 1'-0"

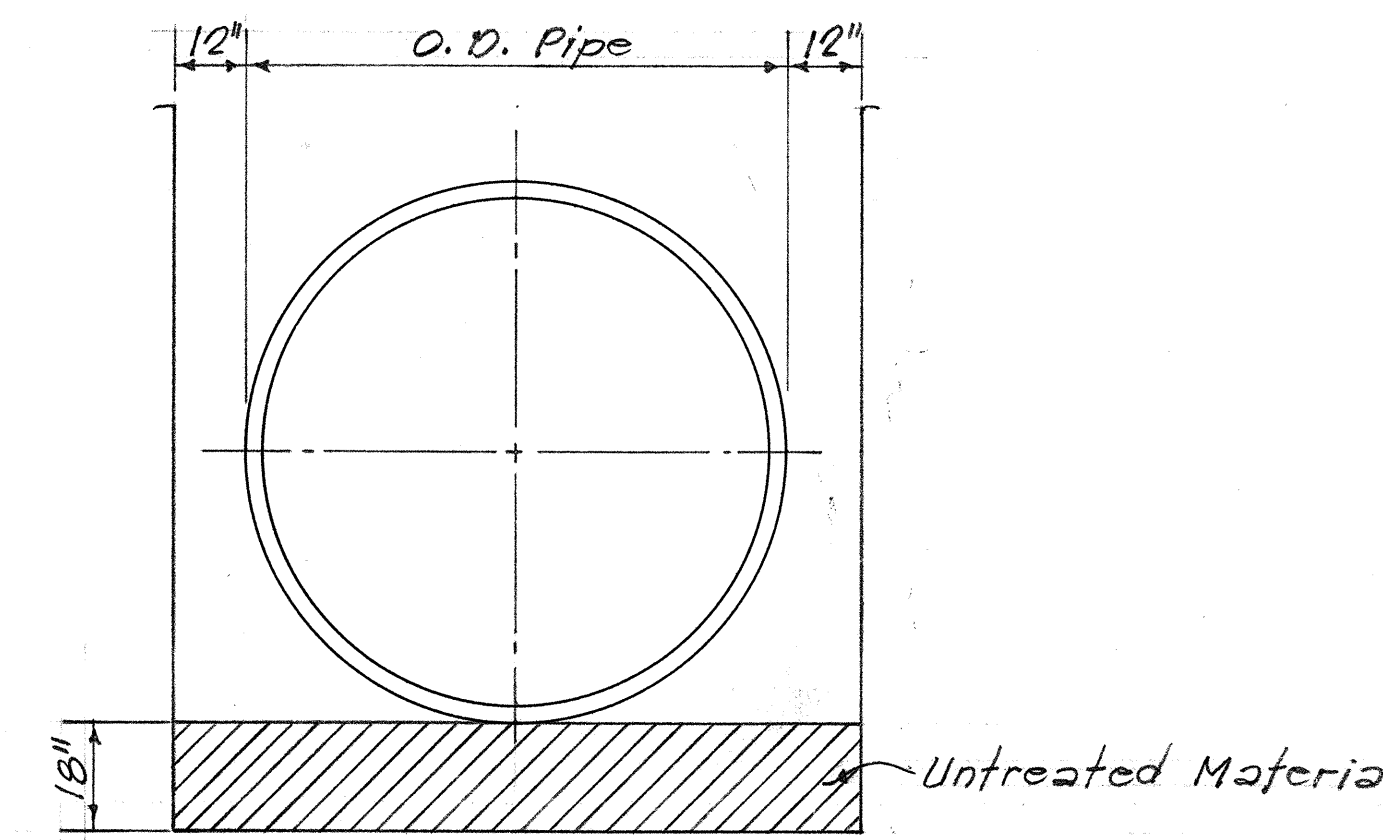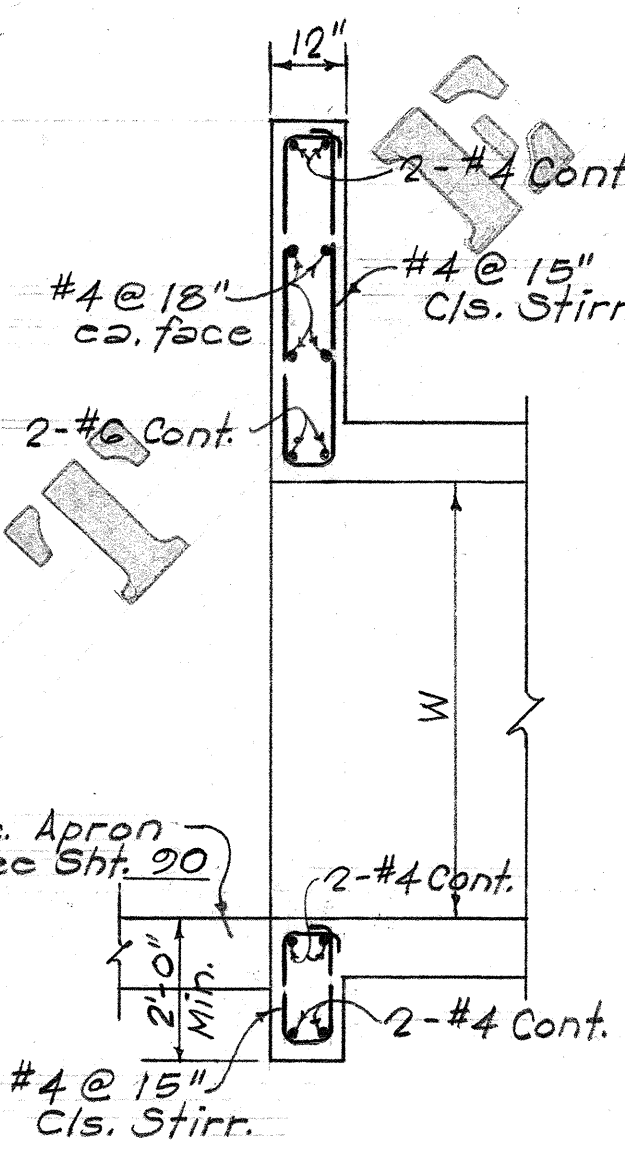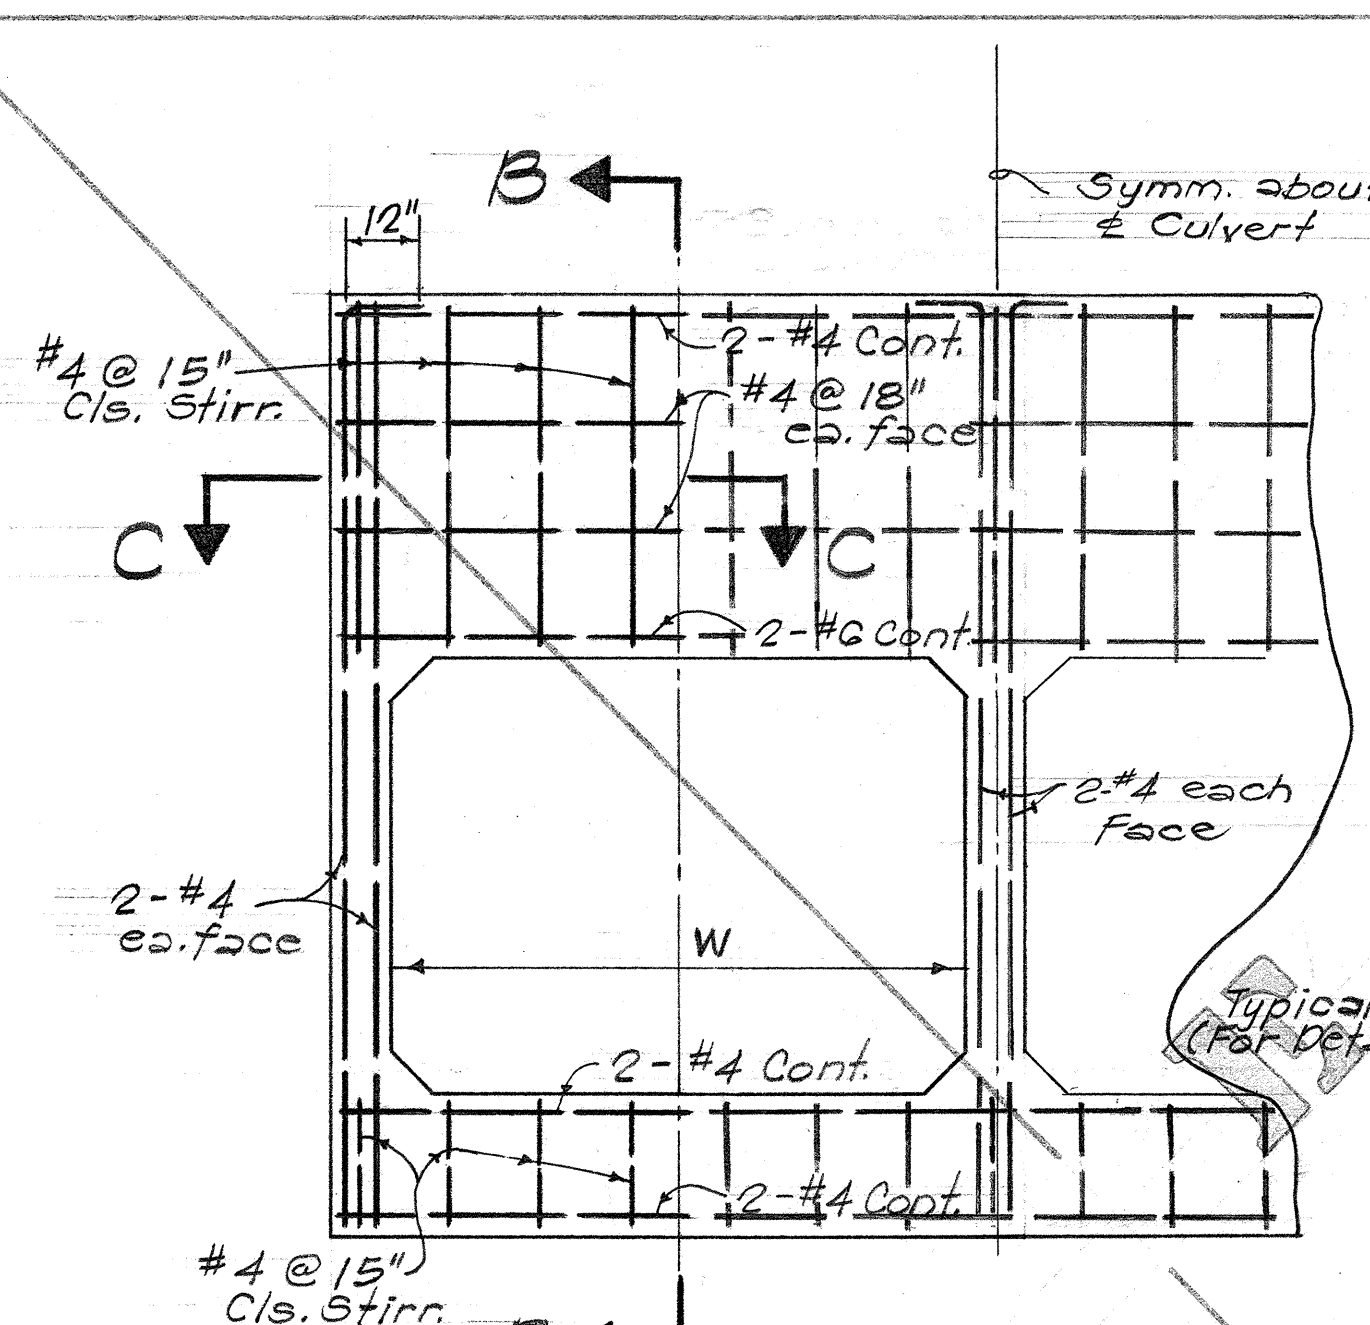


TYPICAL SECTION UNTREATED BASE FOR PIPE FOUNDATION

Scale: 3/8" = 1'-0"

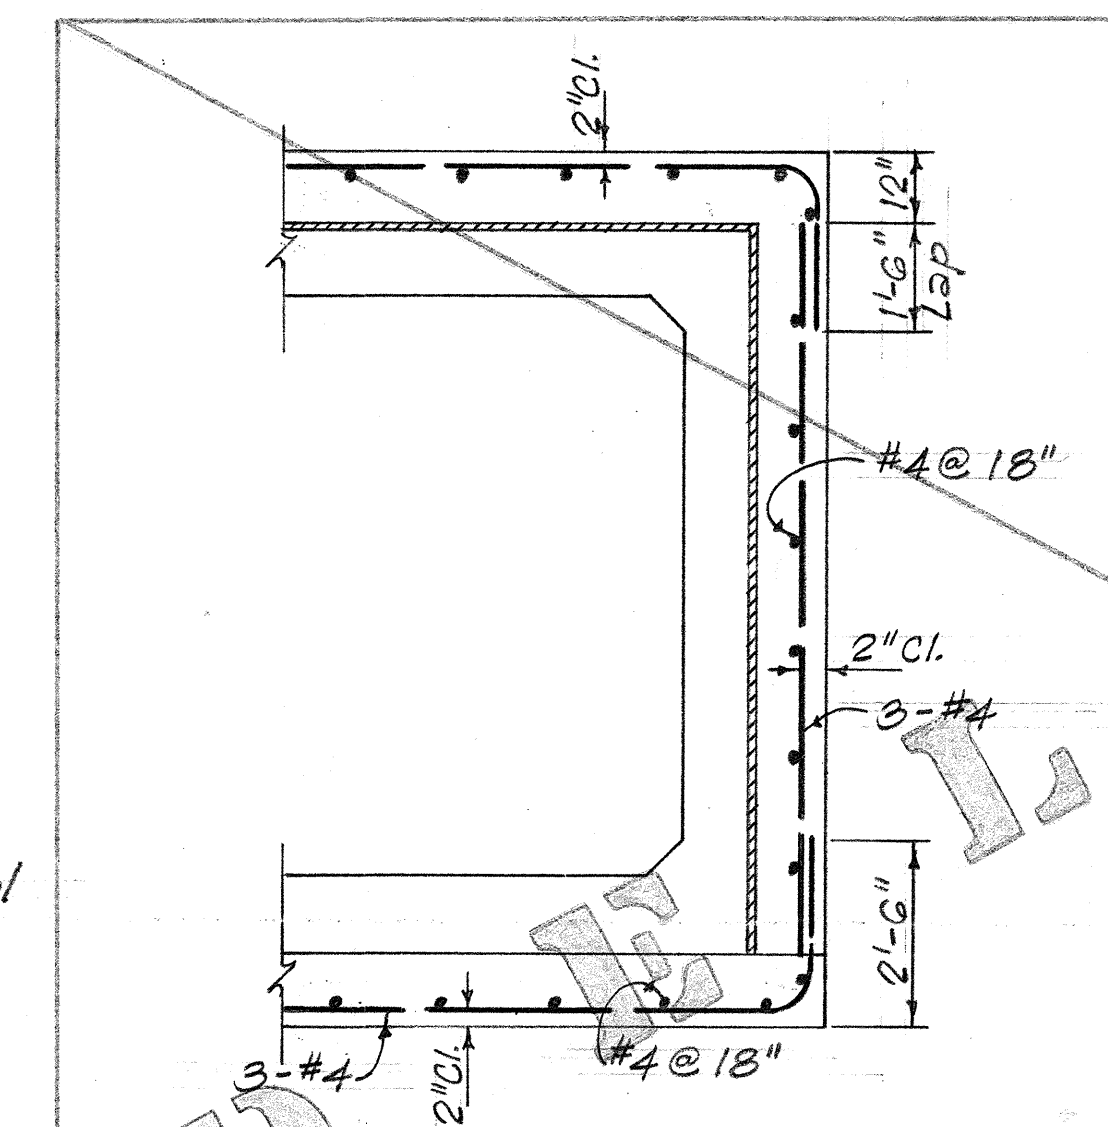


TYPICAL COLLAR DETAIL

Scale: 3/8" = 1'-0"

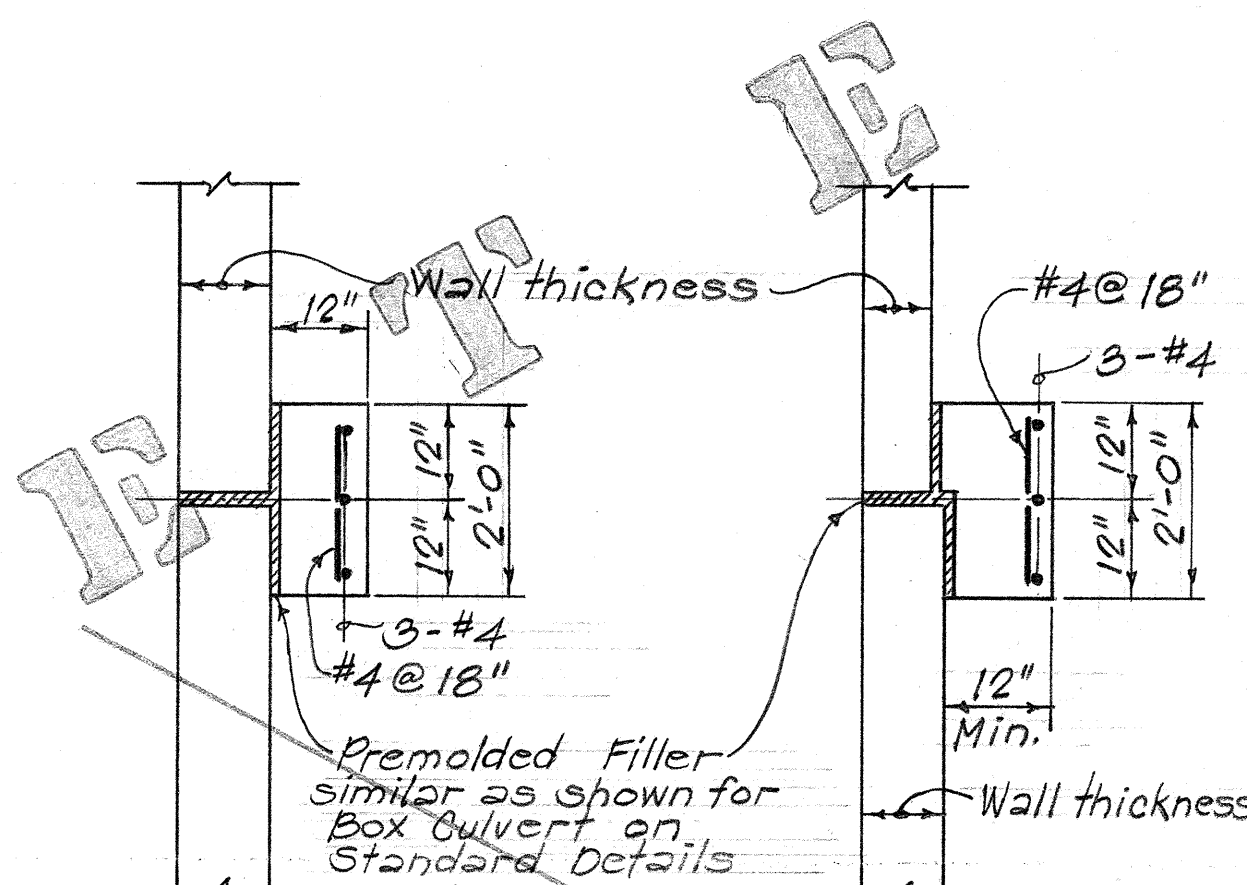

TYPICAL SECTION AT VARYING WALL THICKNESS


Scale: 1/2" = 1'-0"

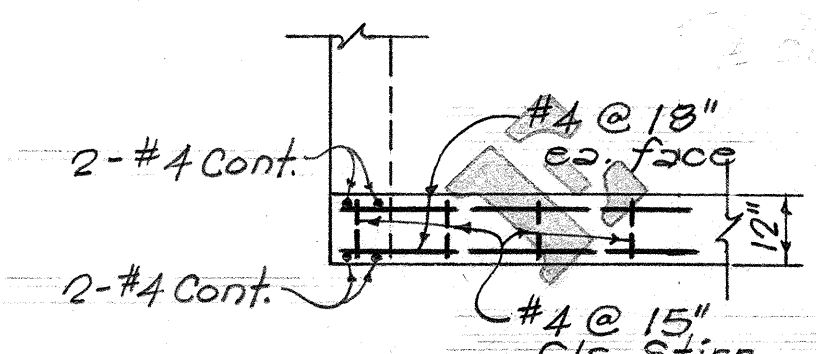

SECTION "C-C"


TYPICAL BOX CULVERT HEADWALL DETAILS

Scale: 3/8" = 1'-0"

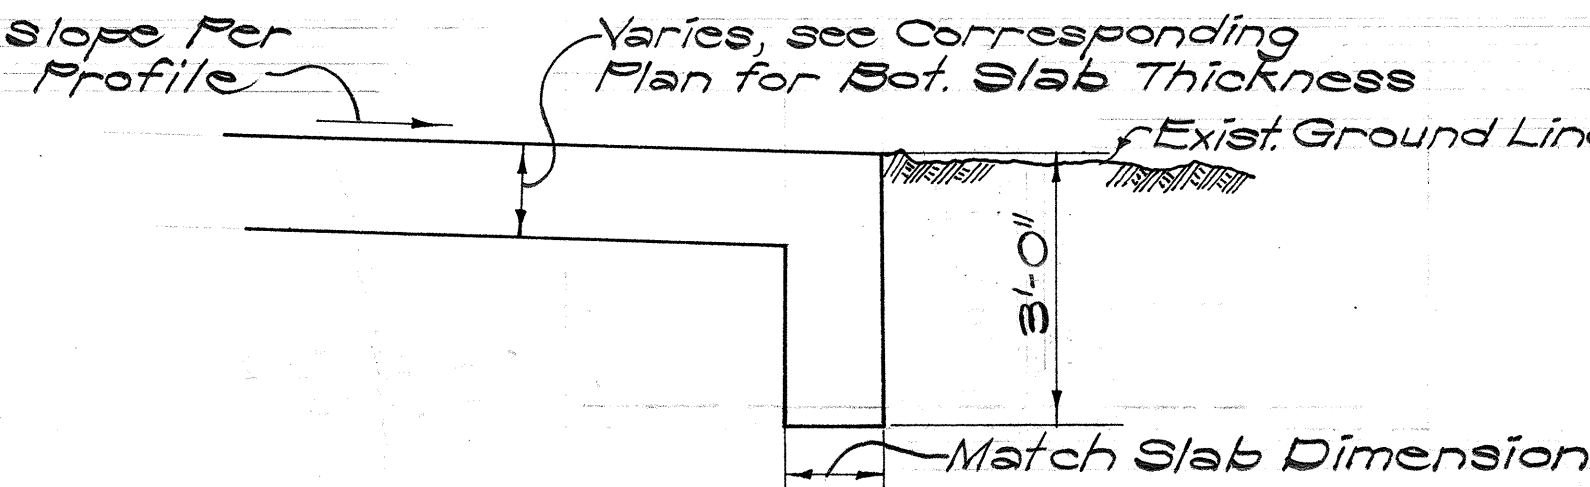

TYPICAL CUT OFF WALL DETAIL

Not to Scale

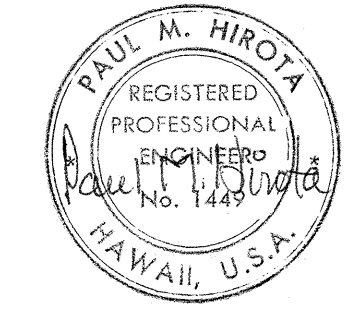

THIS WORK WAS PREPARED BY ME OR UNDER MY SUPERVISION.


STATE OF HAWAII
DEPARTMENT OF TRANSPORTATION
HIGHWAYS DIVISION

TYPICAL CULVERT DETAILS


INTERSTATE ROUTE H-1
PROJ. NO. 1-H-1(66):10

Scale: As Shown Date: SHEET No. 17 OF 17 SHEETS



FED. ROAD DIST. NO.	STATE	FED. AID PROJ. NO.	FISCAL YEAR	SHEET NO.	TOTAL SHEETS
HAWAII	HAW.	I-HI-1(66)10 I-HI-1(67)10	1970	035-1	07

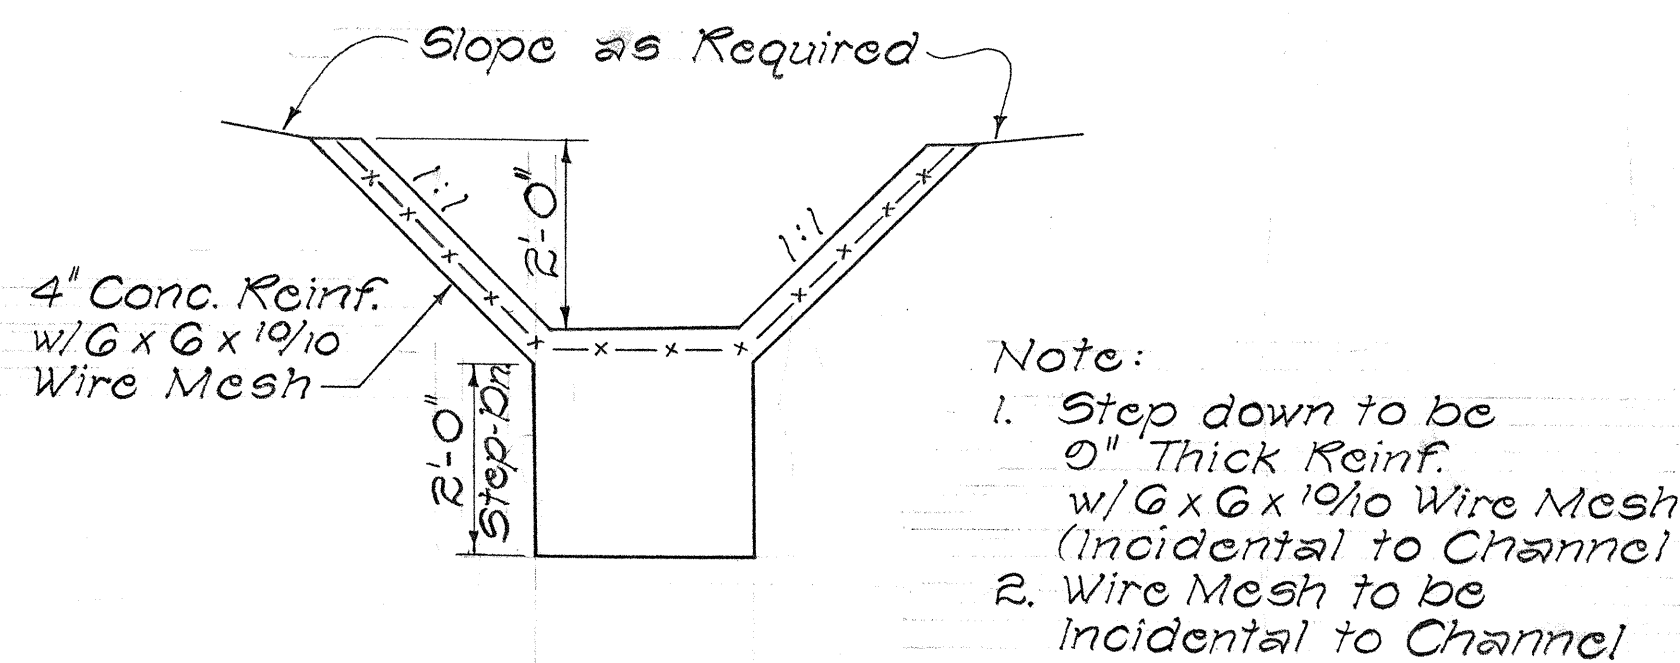

END OF CHANNEL
Scale: 1/2"=1'-0"

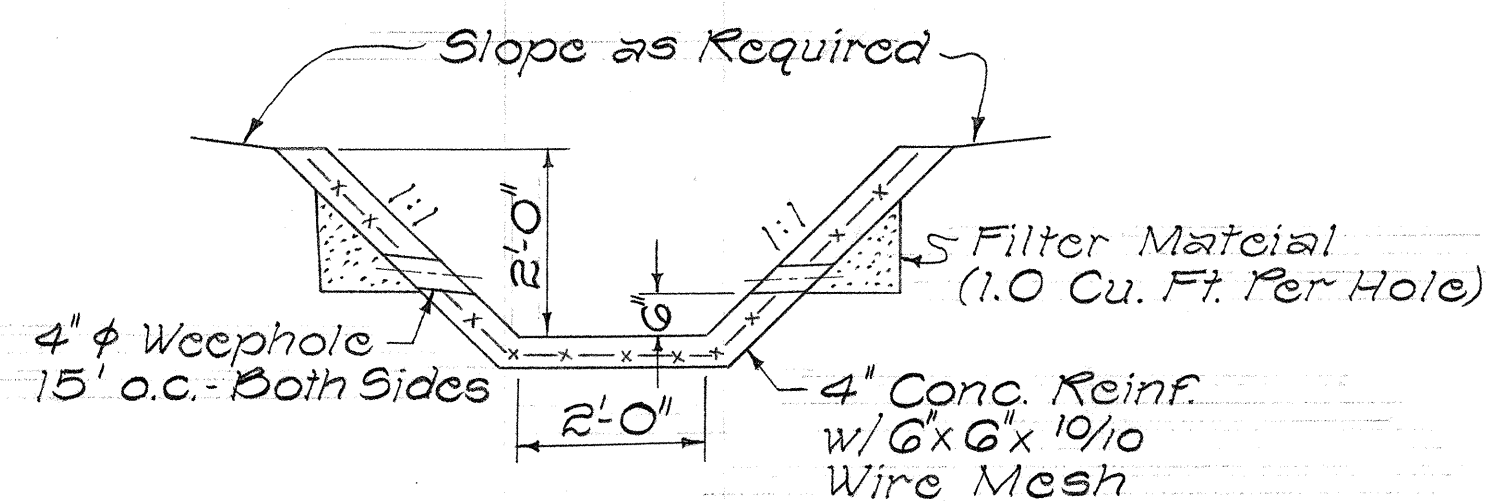


TYPICAL SECTION
Channel Sta. 0+02 to 1+40
Scale: 1/2"=1'-0"

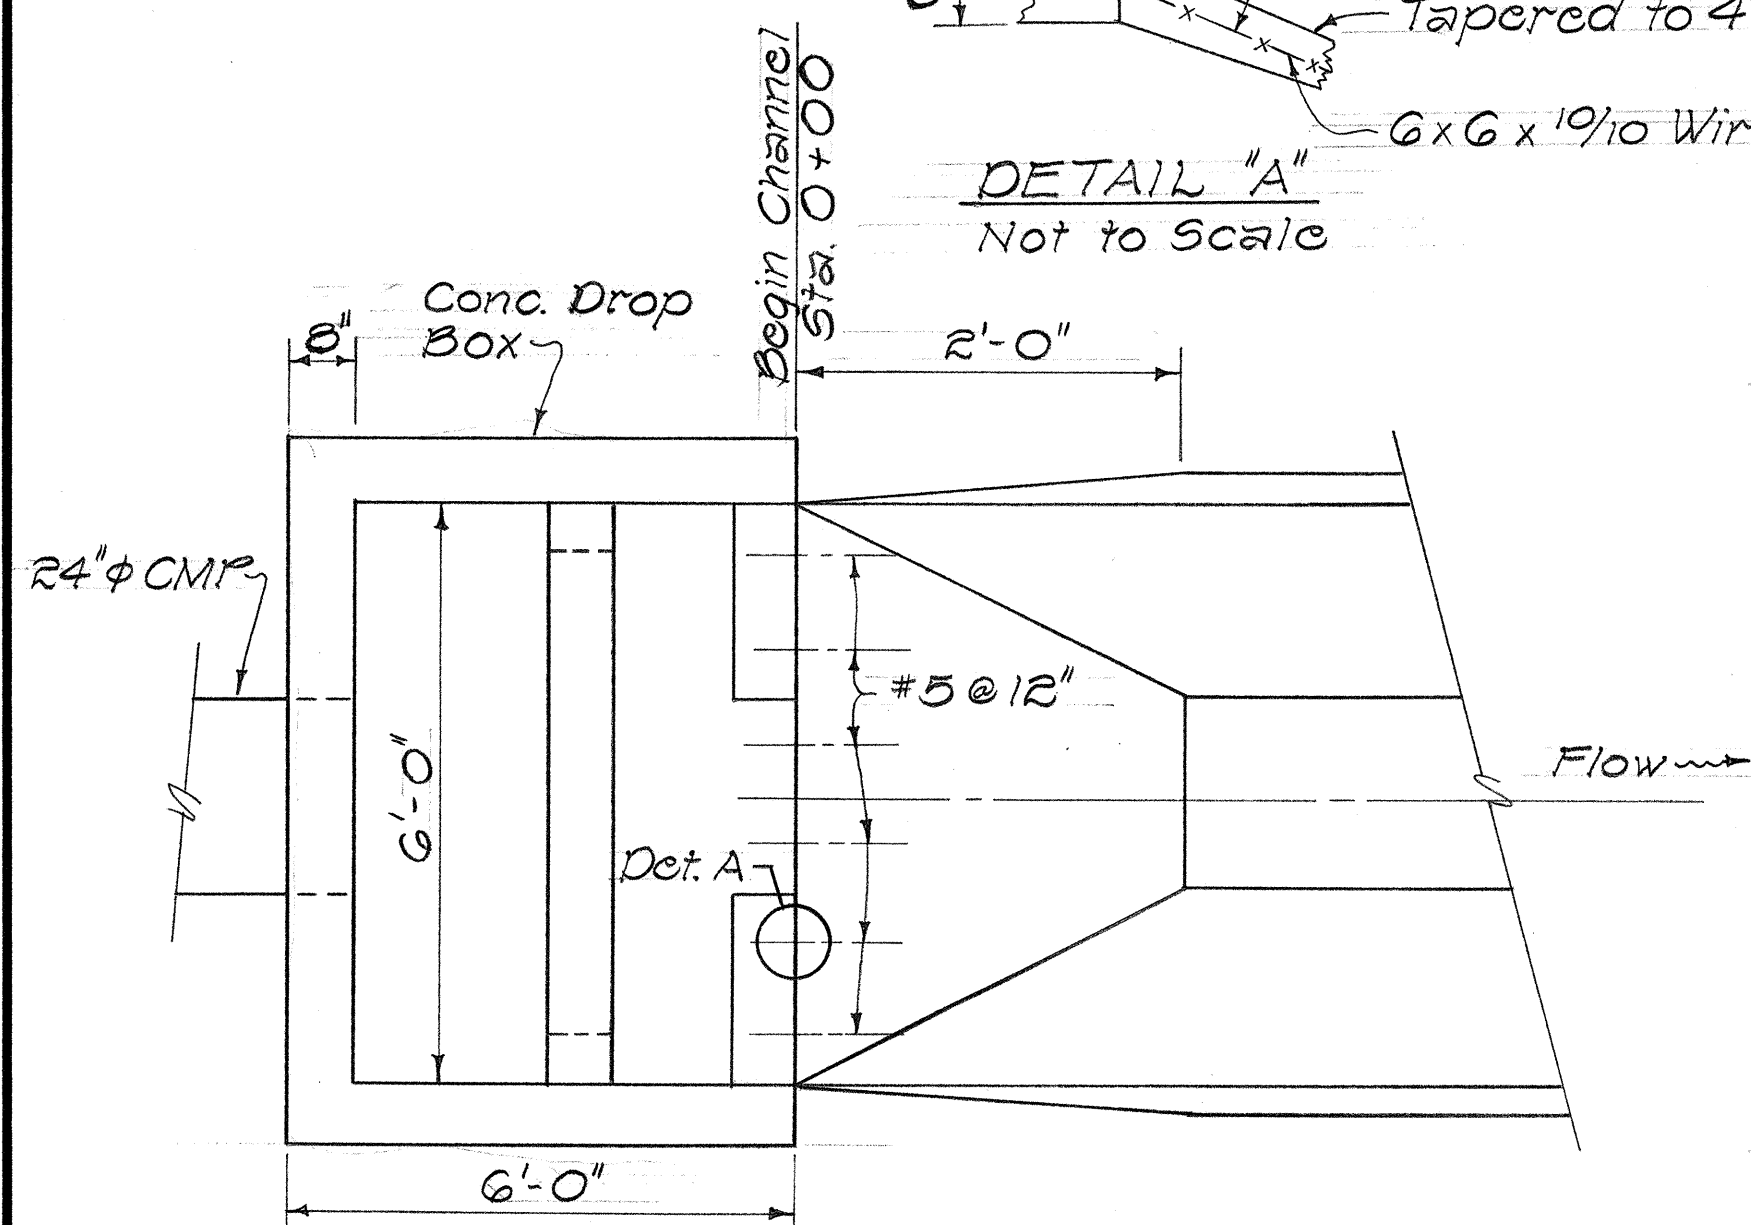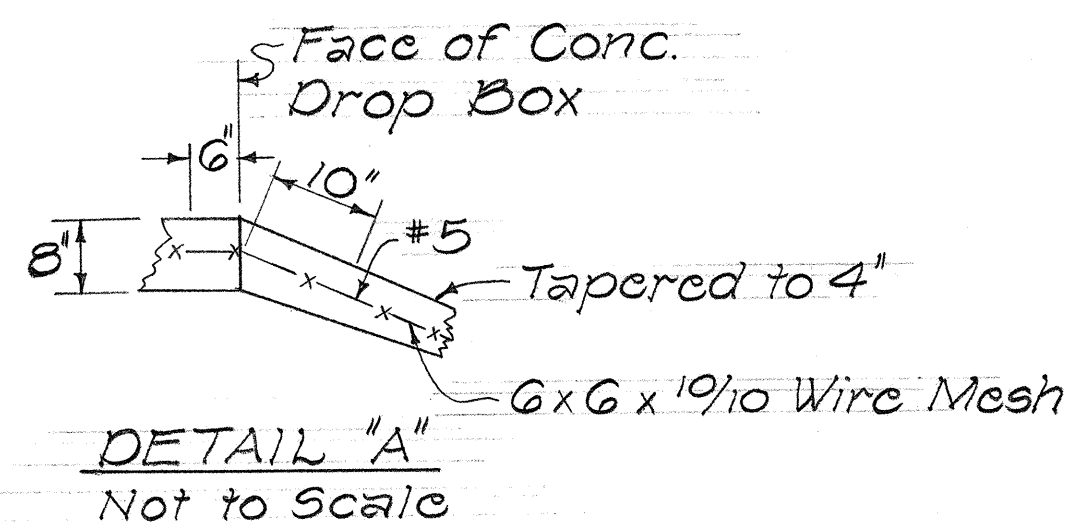

PLAN
Scale: 1/2"=1'-0"


C.C.O. #31

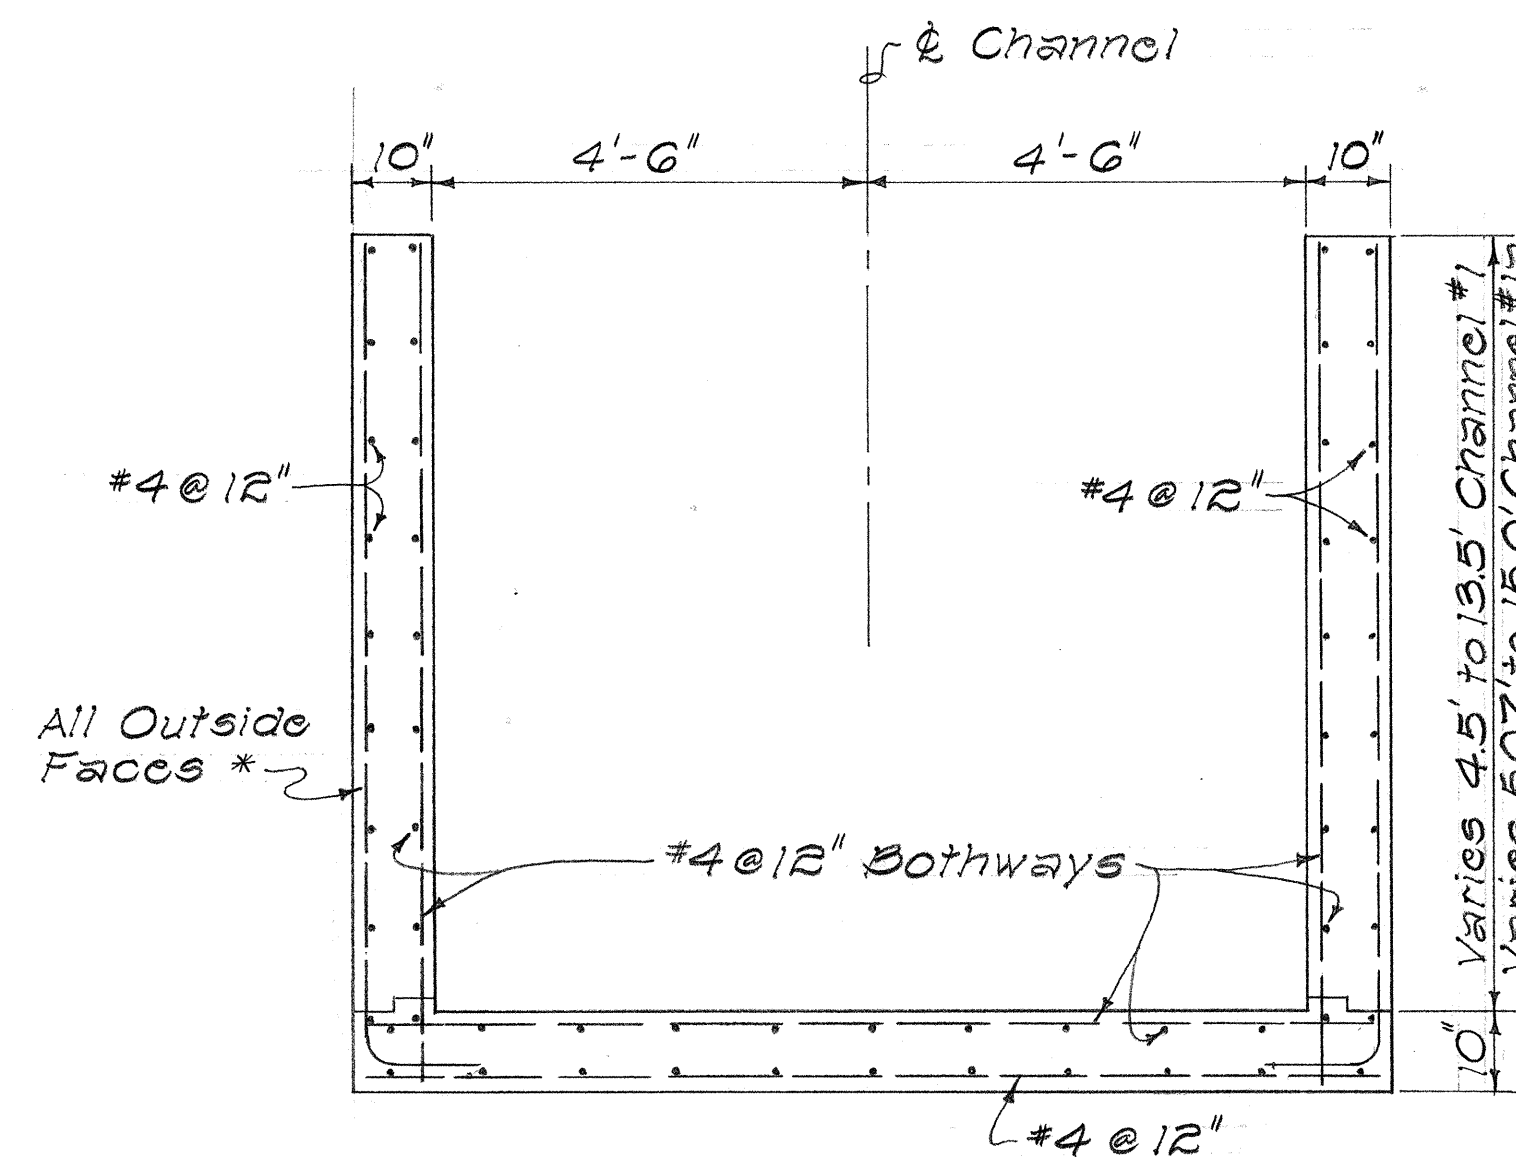


PARTIAL TYPICAL SECTION REINFORCEMENT
Channel #1 Sta. 14+70 to 15+55.11
Outlet Channel #1a Sta. 18+15.94 to 18+65.94
Scale: 1/2"=1'-0"

- * Outside Faces
- #4 @ 12" Sta. 14+70 to 15+05.11
 - #4 @ 12" Sta. 18+65.94 to 19+30
 - #6 @ 12" Sta. 15+05.11 to 15+30.11
 - #6 @ 12" Sta. 18+40.94 to 18+65.94
 - #8 @ 12" Sta. 15+30.11 to 15+55.11
 - #8 @ 12" Sta. 18+15.94 to 18+40.94

C.C.O. #5

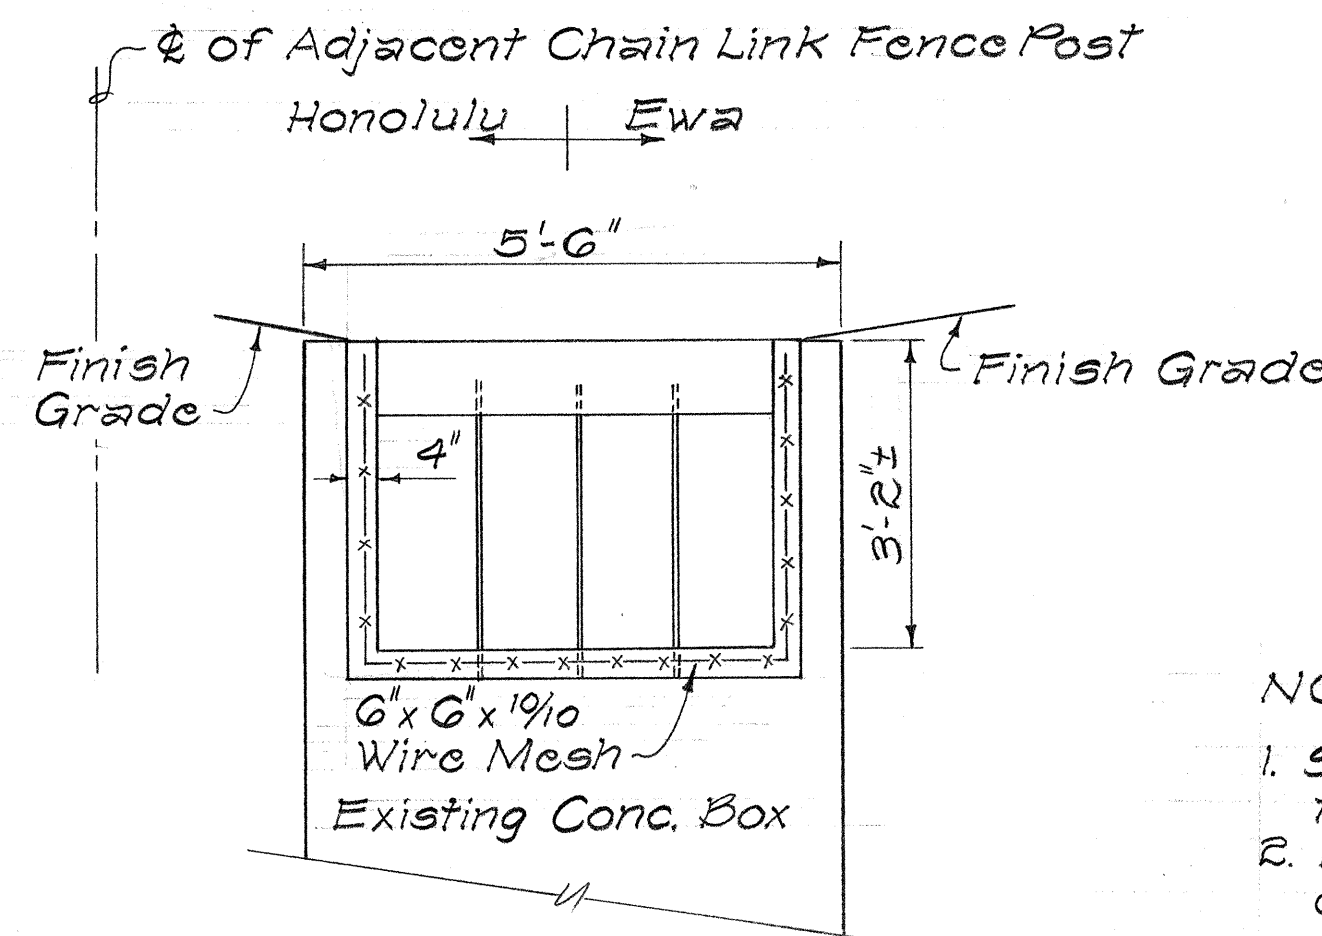

CHANNEL STA. 0+00
Scale: 1/2"=1'-0"

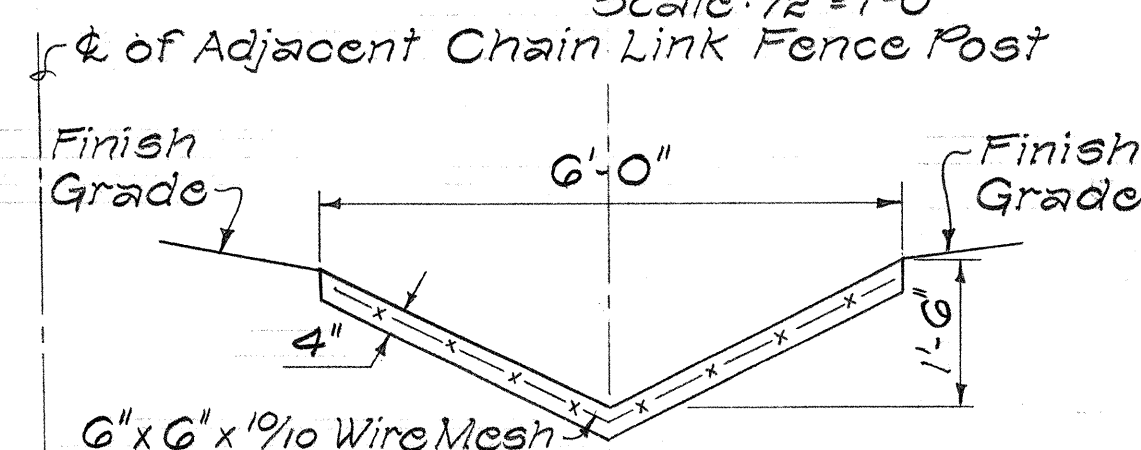


TYPICAL SECTION
Channel Sta. 0+16 To End of Channel
Scale: 1/2"=1'-0"


NOTES:

- Slope "Finish Grade" toward channel.
- Inlet on Honolulu side of box to be plugged with concrete and backfilled to finish grade (incidental to channel).
- Relocate chain link fence to cross channel at sta. 0+00.
- Grading in the vicinity of the channel and wire mesh shall not be paid for but shall be considered incidental to the channel.


C.C.O. #27

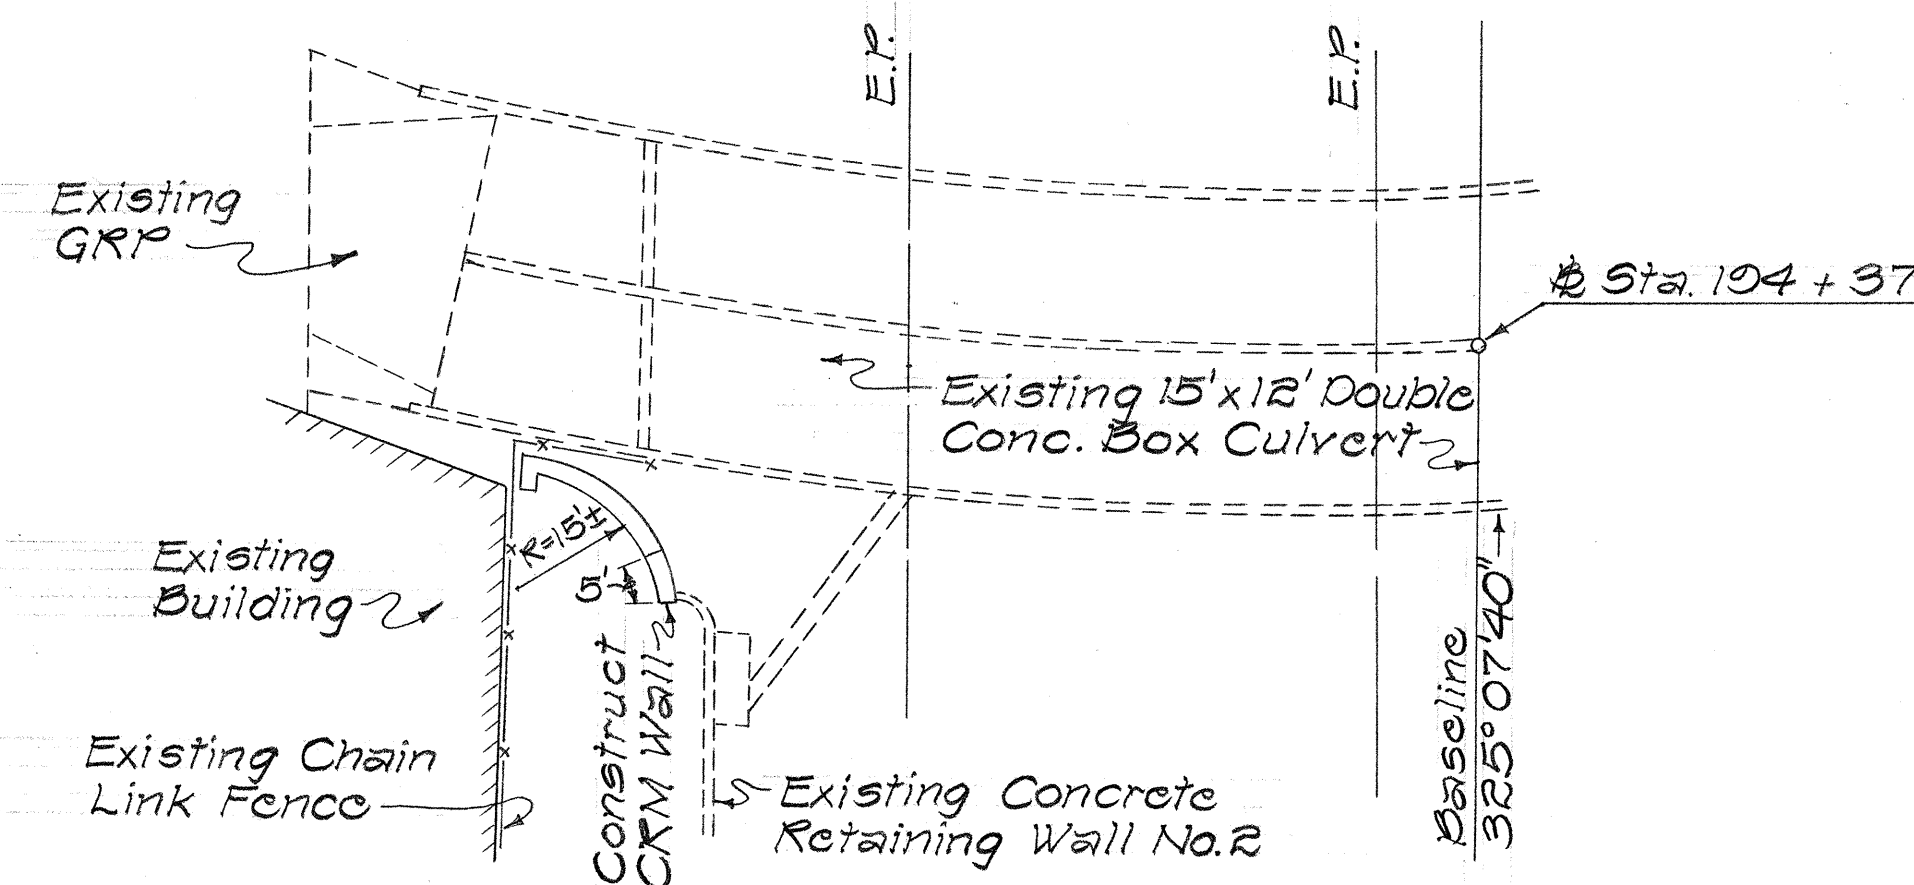

PLAN - CRM WALL LEFT OF STA. 104+15 ±
Scale: 1"=20'

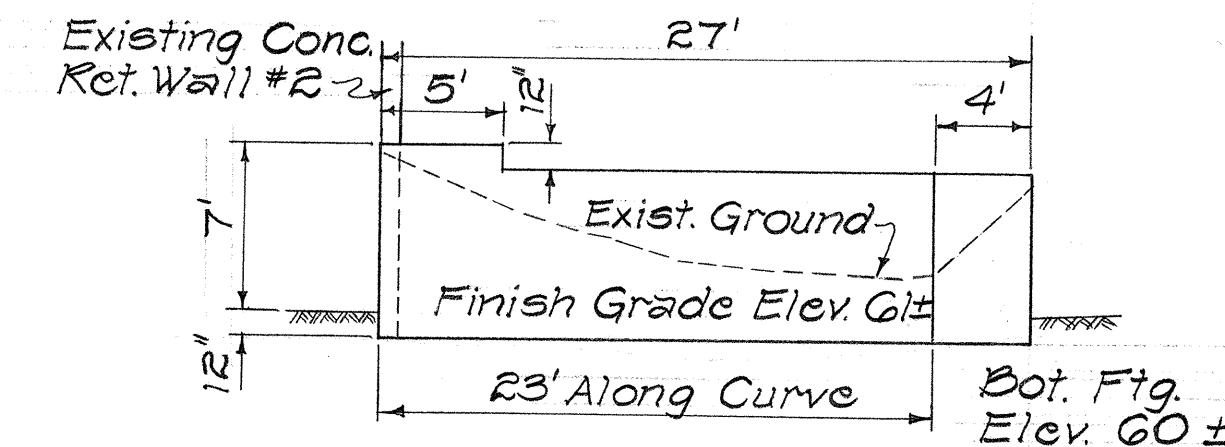

CRM WALL - PROFILE
Scale: 1/8"=1'-0"

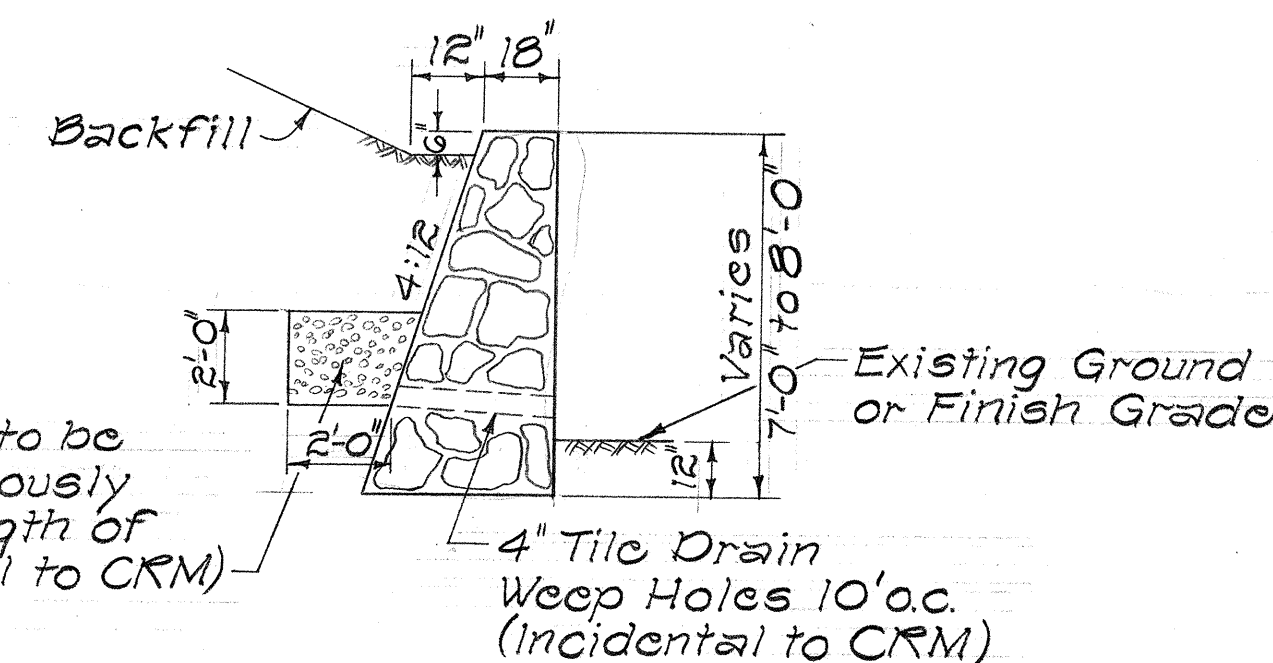

CRM WALL - TYPICAL SECTION
Scale: 1/4"=1'-0"

C.C.O. #11

STATE OF HAWAII
DEPARTMENT OF TRANSPORTATION
HIGHWAYS DIVISION

DRAINAGE DETAILS

INTERSTATE ROUTE H-1
PROJECT NO. I-HI-1(66)10

Scale: As Shown Date:

SHEET No. OF SHEETS

This sheet is a supplement sheet incorporated into the plans at the time of the "As Built" posting.

035-1