STATE OF HAWAII

DEPARTMENT OF TRANSPORTATION
HIGHWAYS DIVISION

HONOLULU, HAWAII

"AS BUILT"

PLANS FOR


INSTALLATION OF EXPRESSWAY SIGNS ON

INTERSTATE ROUTE H-I

FOURTH AVENUE TO KOKO HEAD AVENUE

PROJECT No. HI-K-05-70


DISTRICT OF HONOLULU
ISLAND OF OAHU

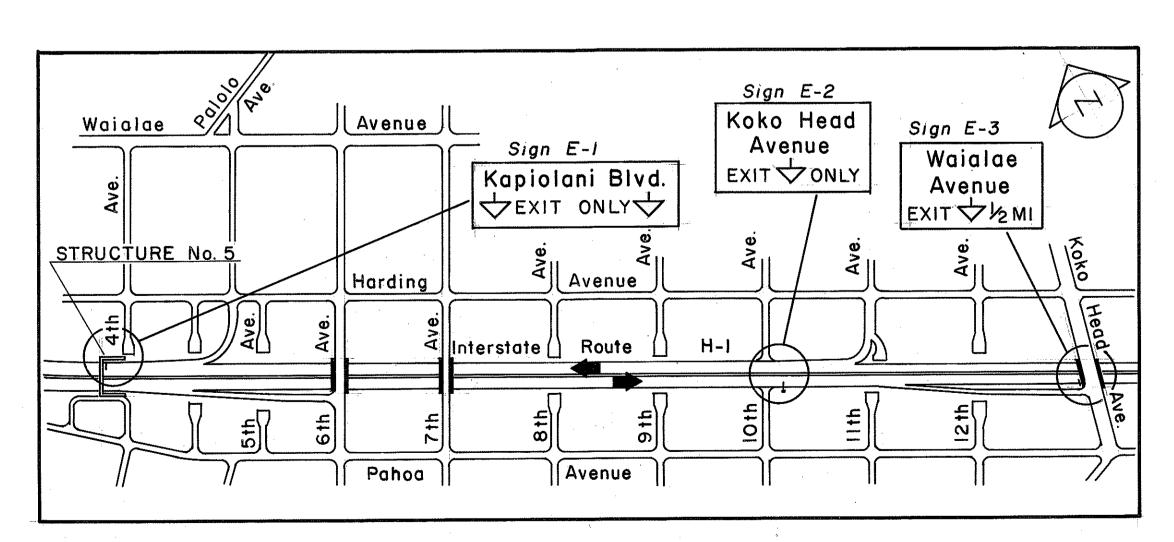

LAYOUT PLAN

400 0 400 800 1200

SCALE IN FEET

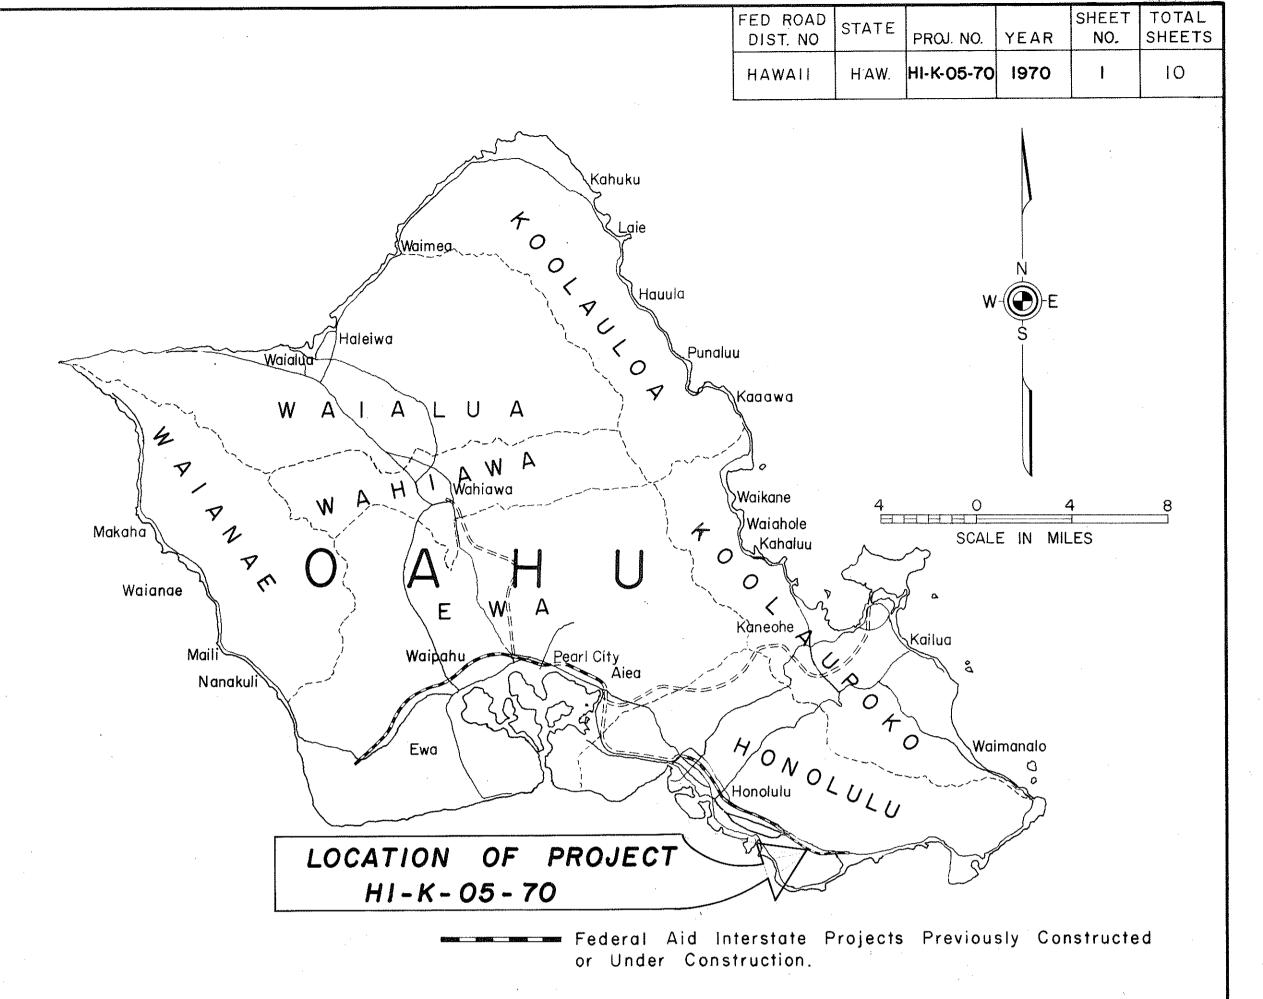

NO CHANGE WAS MADE DURING CONSTRUCTION OF THIS PROJECT.

fr RESIDENT ENGINEER DATE

DEPARTMENT OF TRANSPORTATION
STATE OF HAWAII

APPROVED:

6. Olivey W. D. 4/1/70

DIR. OF TRANSPORTATION DATE

April, 1969

Bevier Apr