


FED. ROAD DIST. NO.	STATE	FED. AID PROJ. NO.	FISCAL YEAR	SHEET NO.	TOTAL SHEETS
HAWAII	HAW.	I-HI-1(78): 13	1970	40	47

FINAL SURVEY	BY	DATE
NOTE BOOK NO.		
SURVEYED		
PLOTTED		
TEAR SHEET		
AREAS CHECKED		



ORIGINAL SURVEY	BY	DATE
NOTE BOOK NO.		
SURVEYED		
PLOTTED		
TEAR SHEET		
AREAS CHECKED		

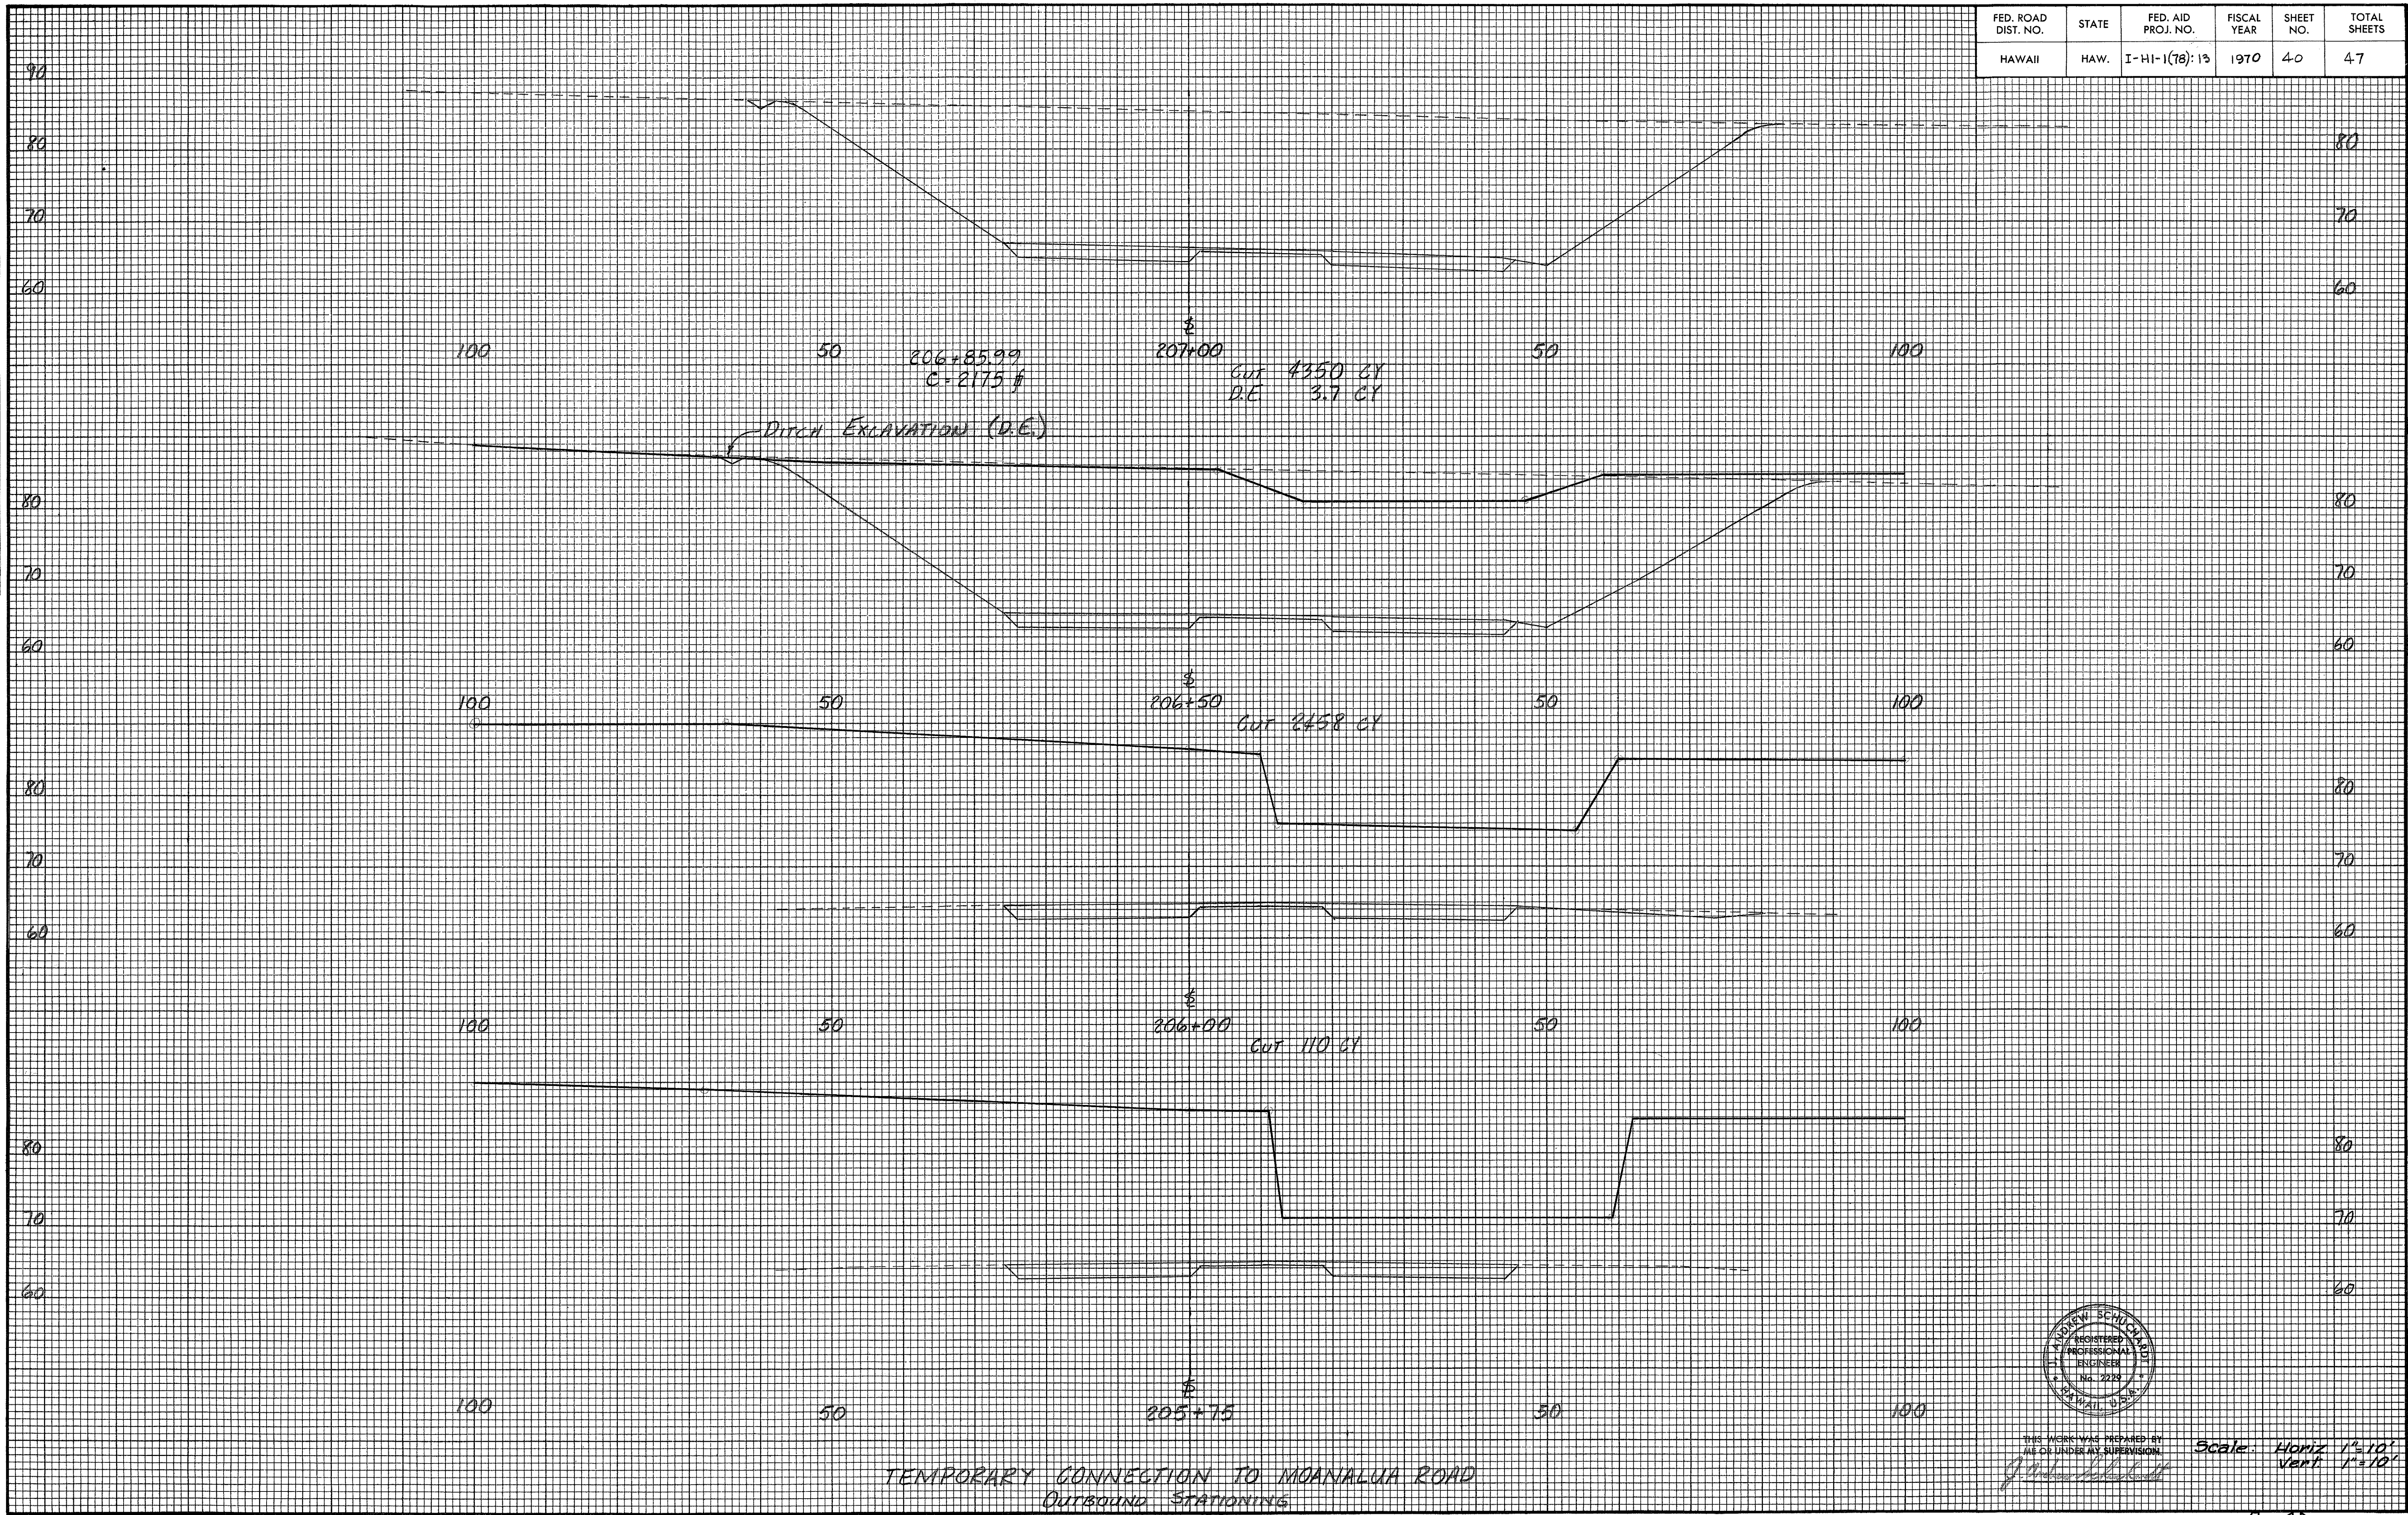

FED. ROAD DIST. NO.	STATE	FED. AID PROJ. NO.	FISCAL YEAR	SHEET NO.	TOTAL SHEETS
HAWAII	HAW.	I-HI-1(78):13	1970	42	47

FINAL SURVEY	DATE	BY
	SURVEYED	PLOTTED
	NOTE BOOK	TEMP. PLATE
	NO.	AREAS CHECKED

ORIGINAL SURVEY	DATE	BY
	SURVEYED	PLOTTED
	NOTE BOOK	TEMP. PLATE
	NO.	AREAS CHECKED

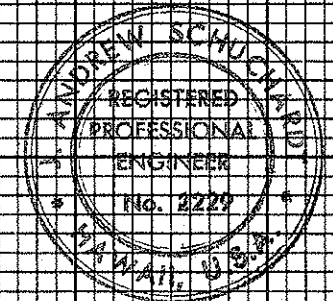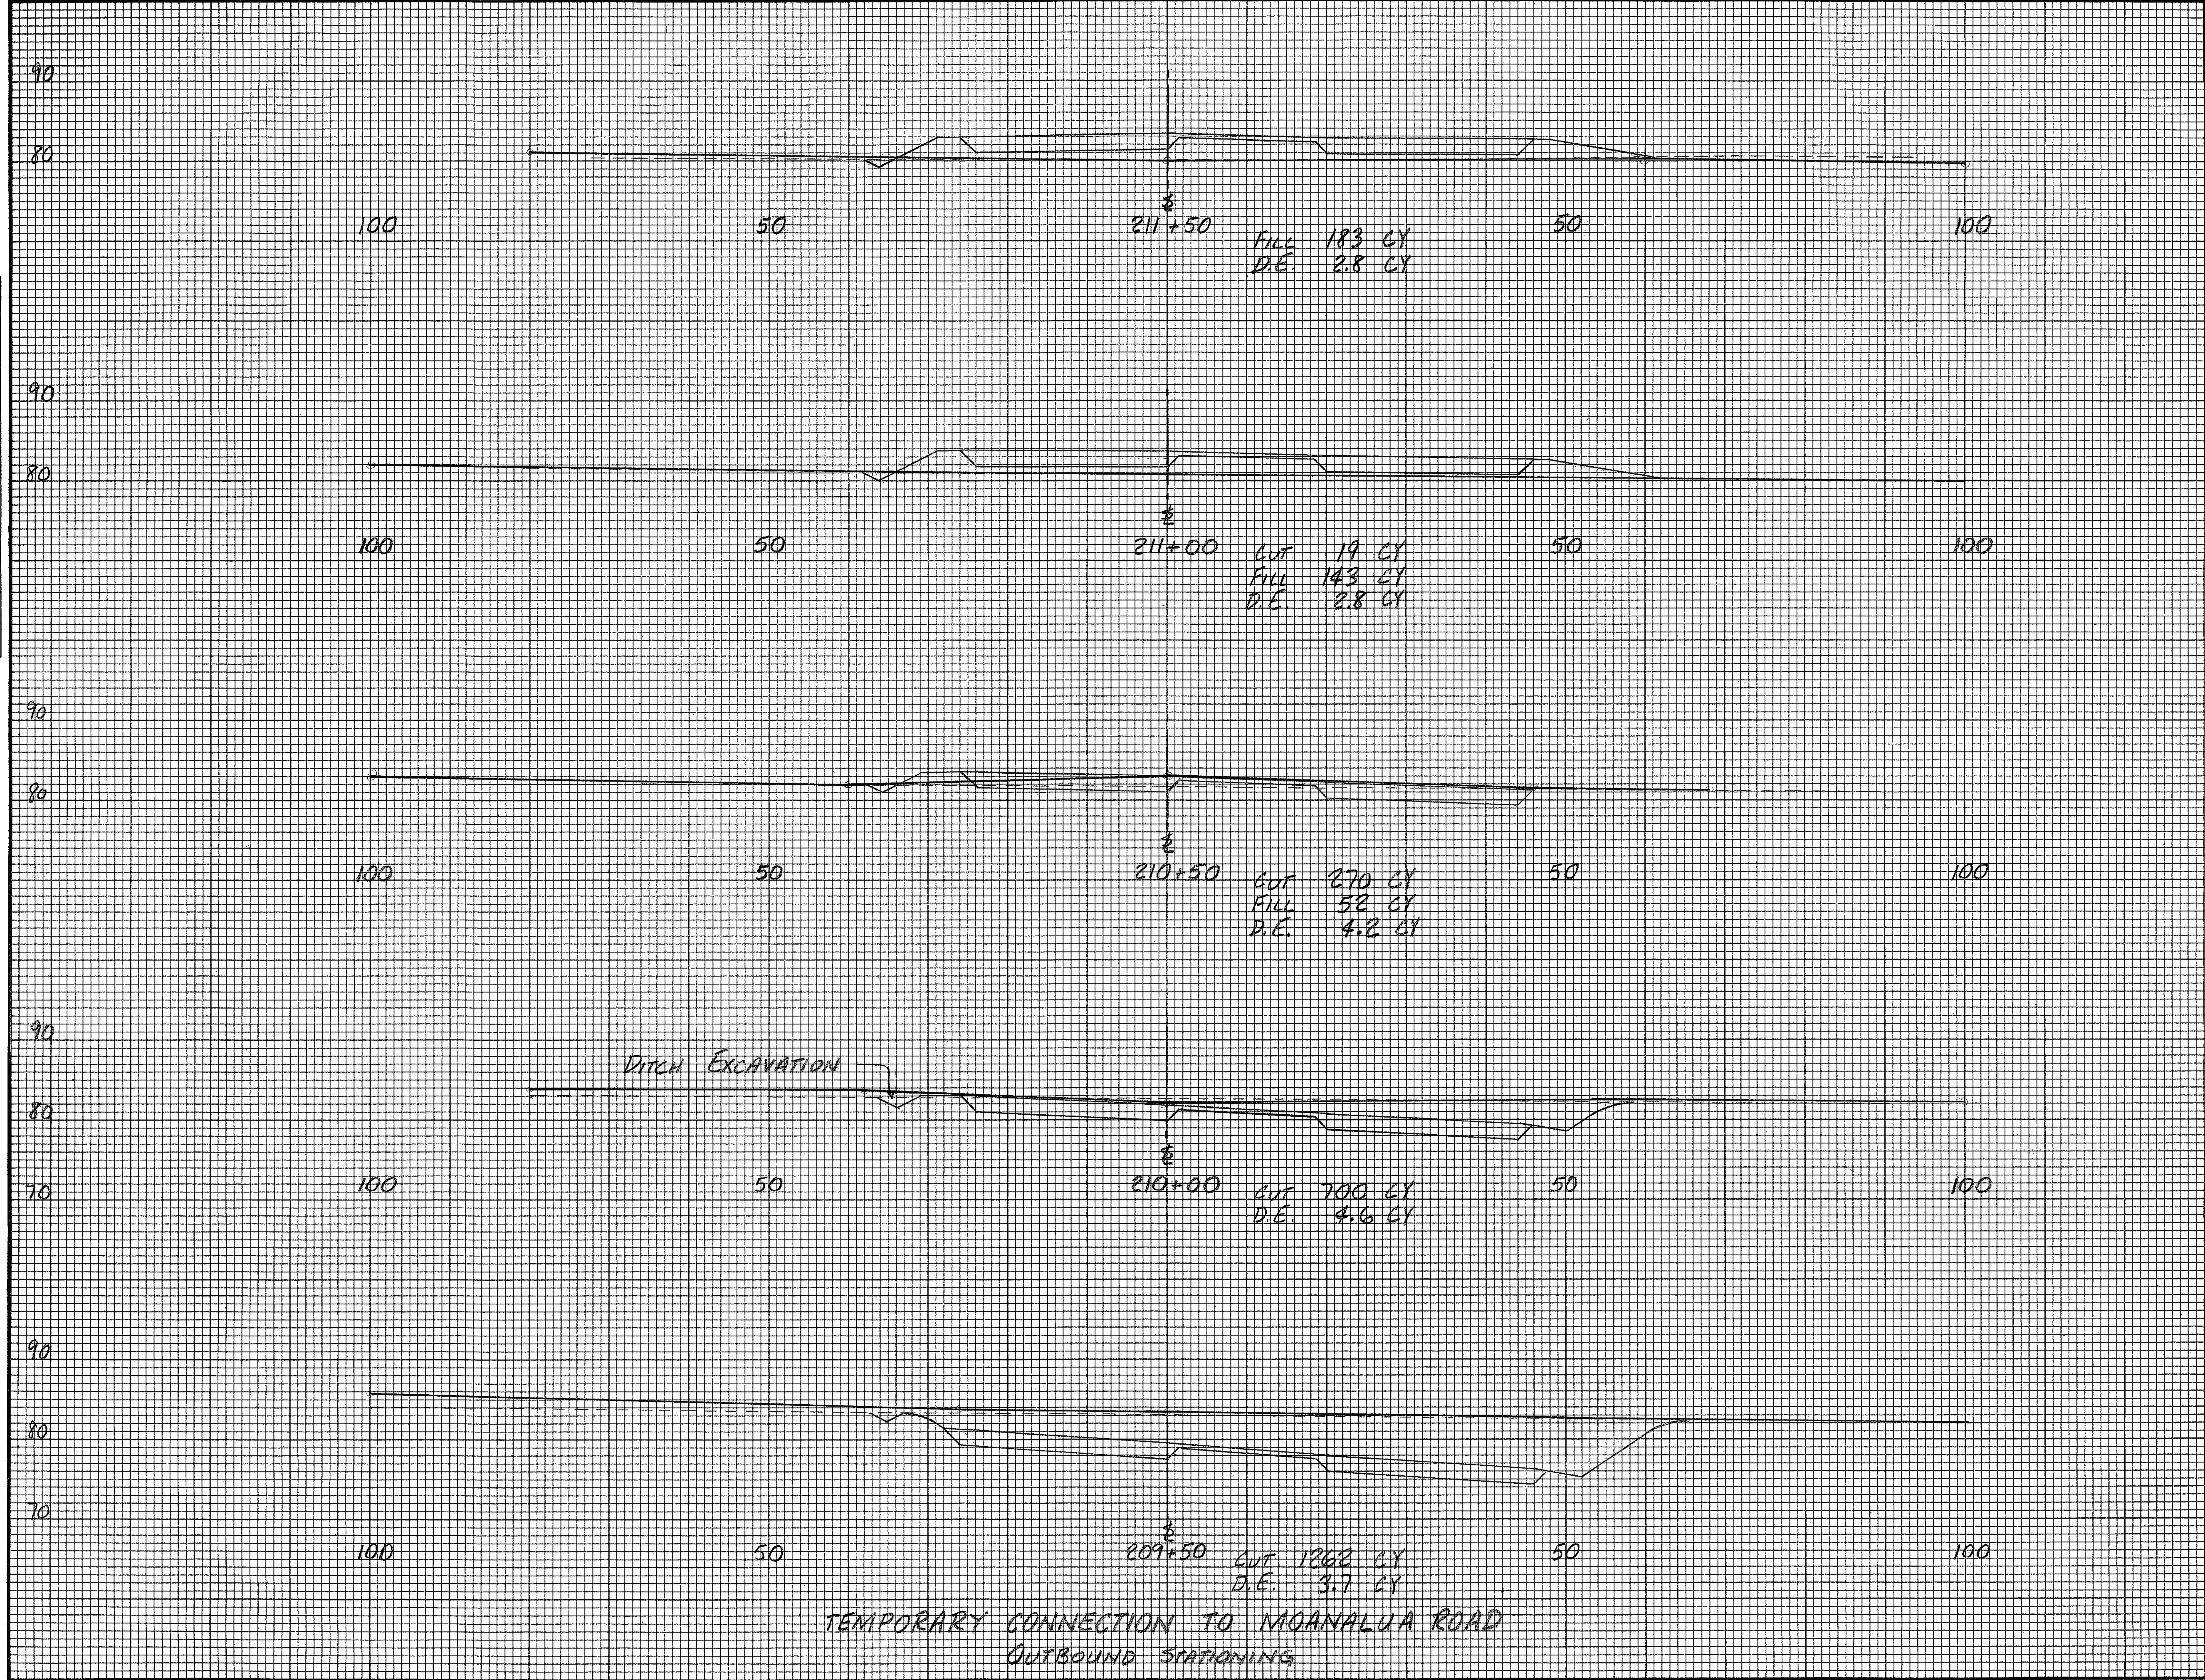

THIS WORK WAS PREPARED BY
ME OR UNDER MY SUPERVISION



[Signature]

Scale: Horiz. 1"=10'
Vert. 1"=10'

FED. ROAD DIST. NO.	STATE	FED. AID PROJ. NO.	FISCAL YEAR	SHEET NO.	TOTAL SHEETS
HAWAII	HAW.	I- HI-1(78):13	1970	44	47


FINAL SURVEY NOTE BOOK NO.	BY	DATE

ORIGINAL SURVEY NOTE BOOK NO.	BY	DATE

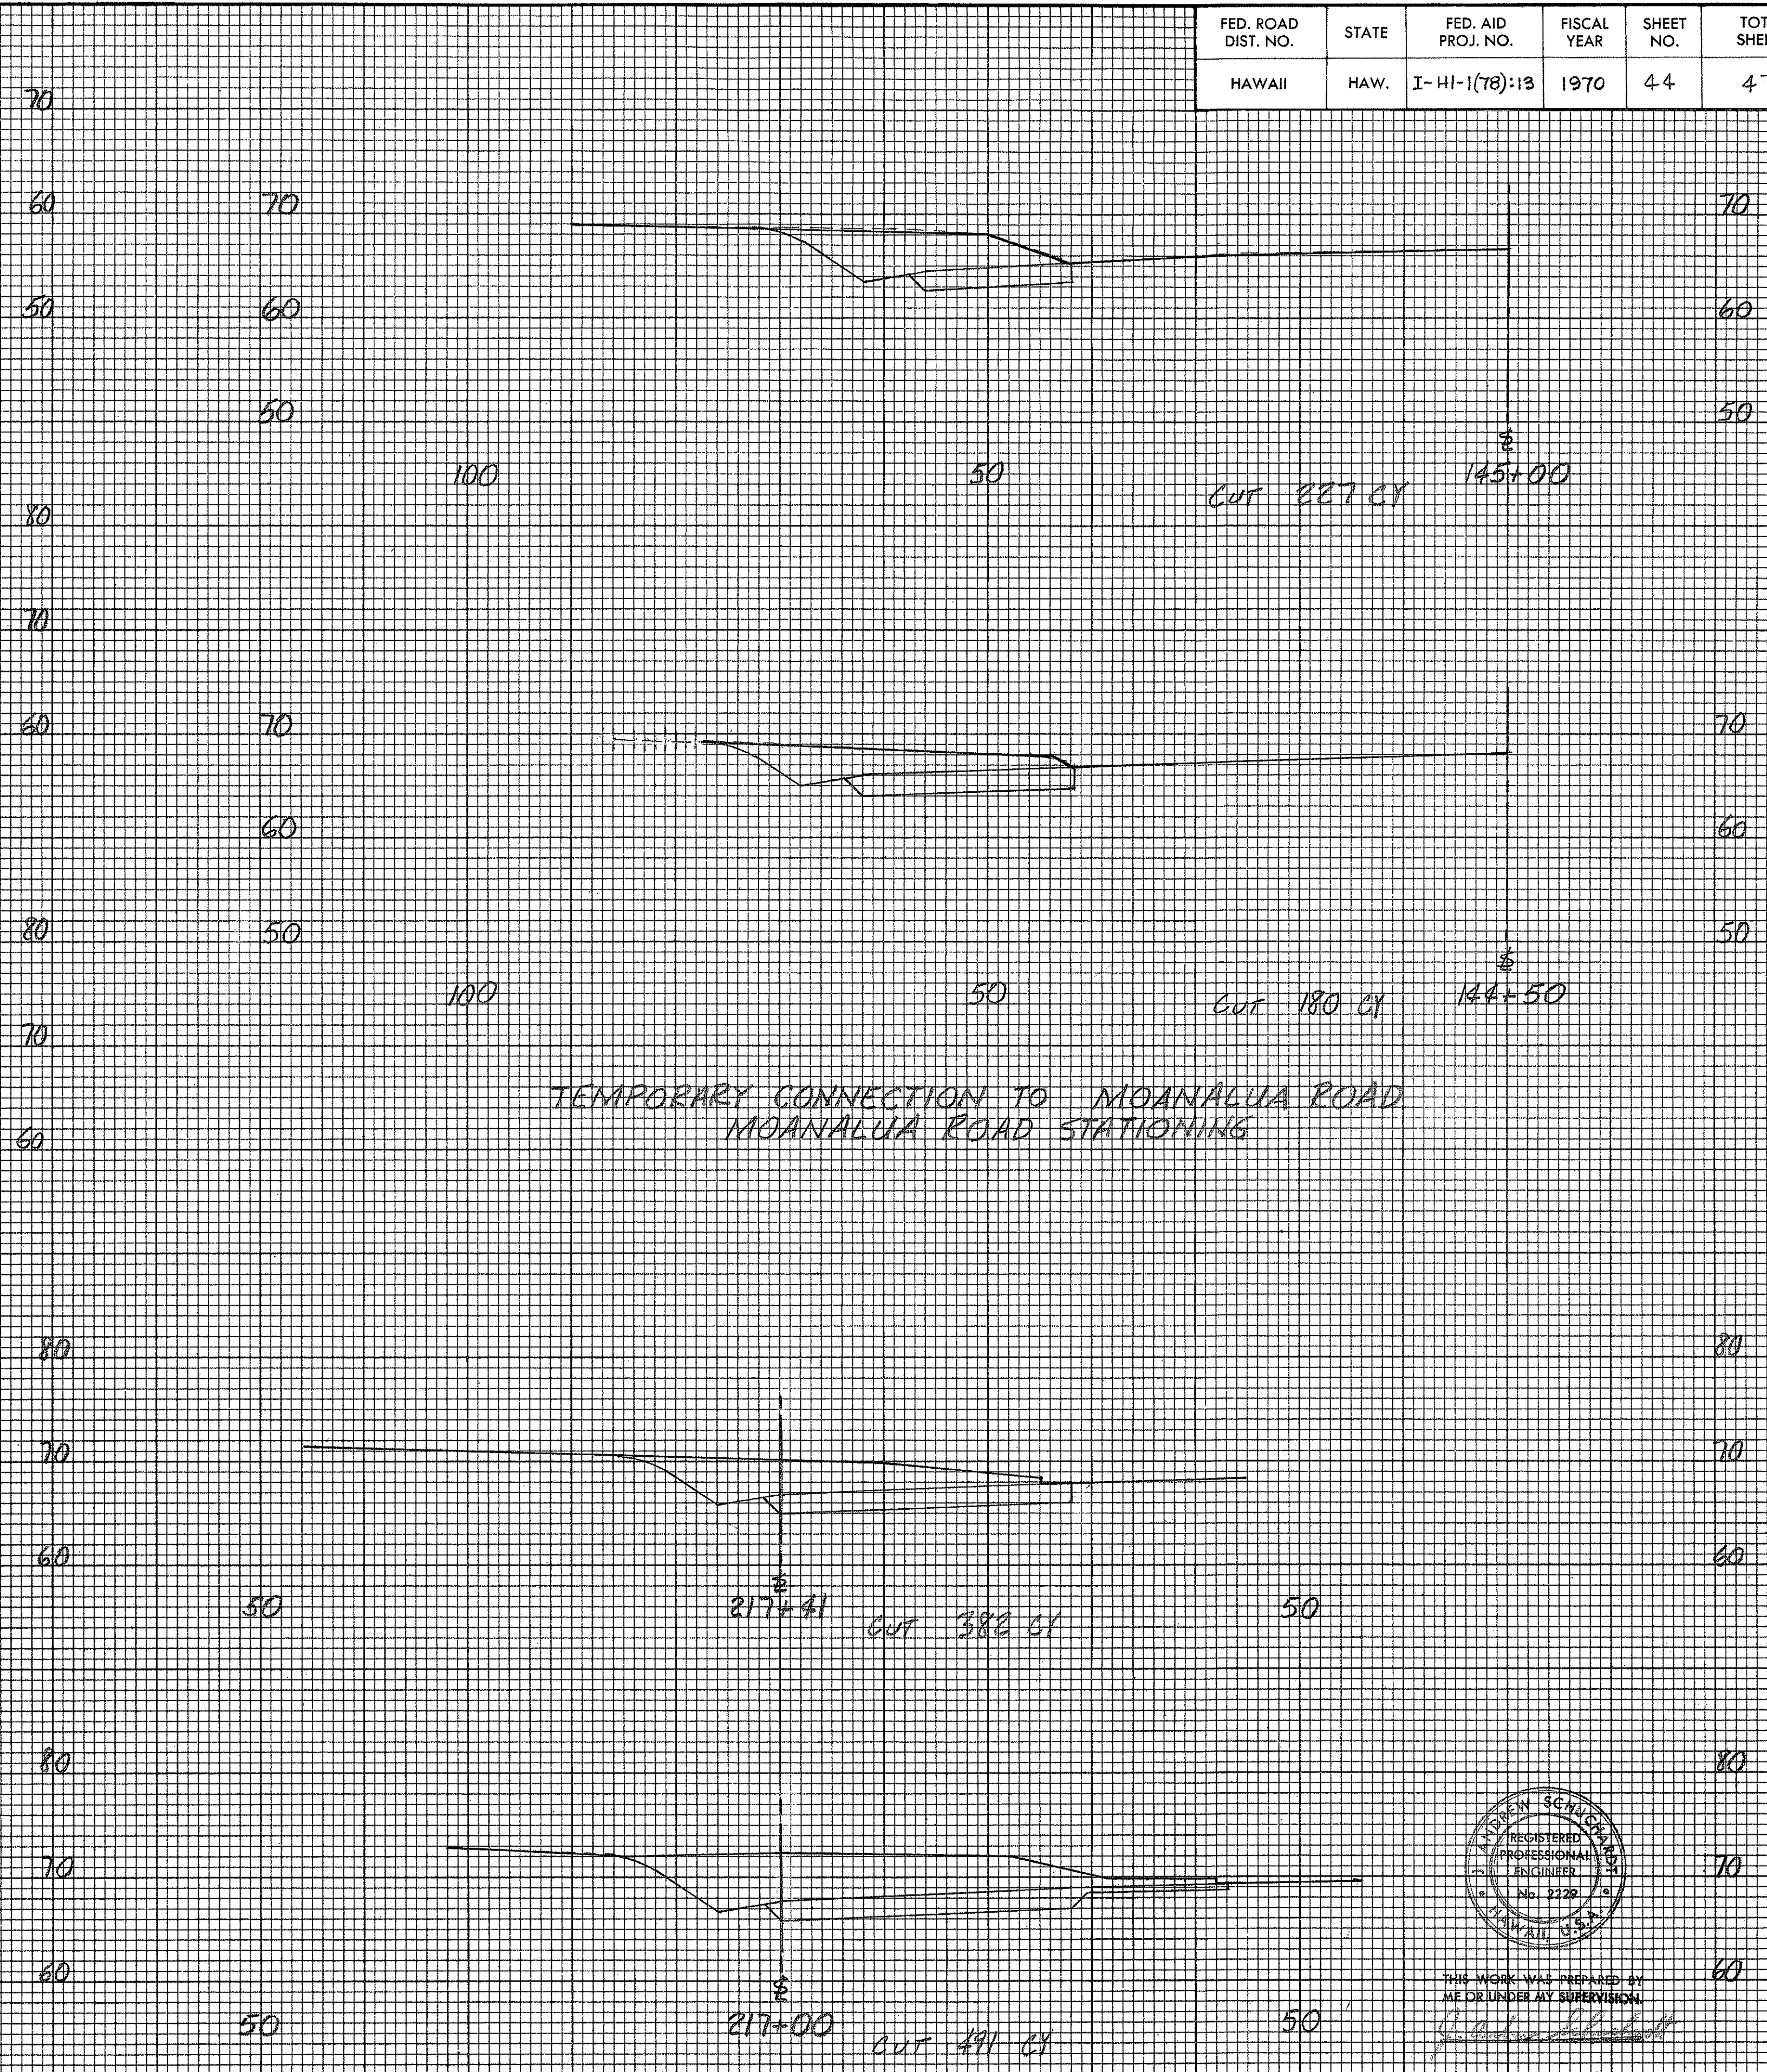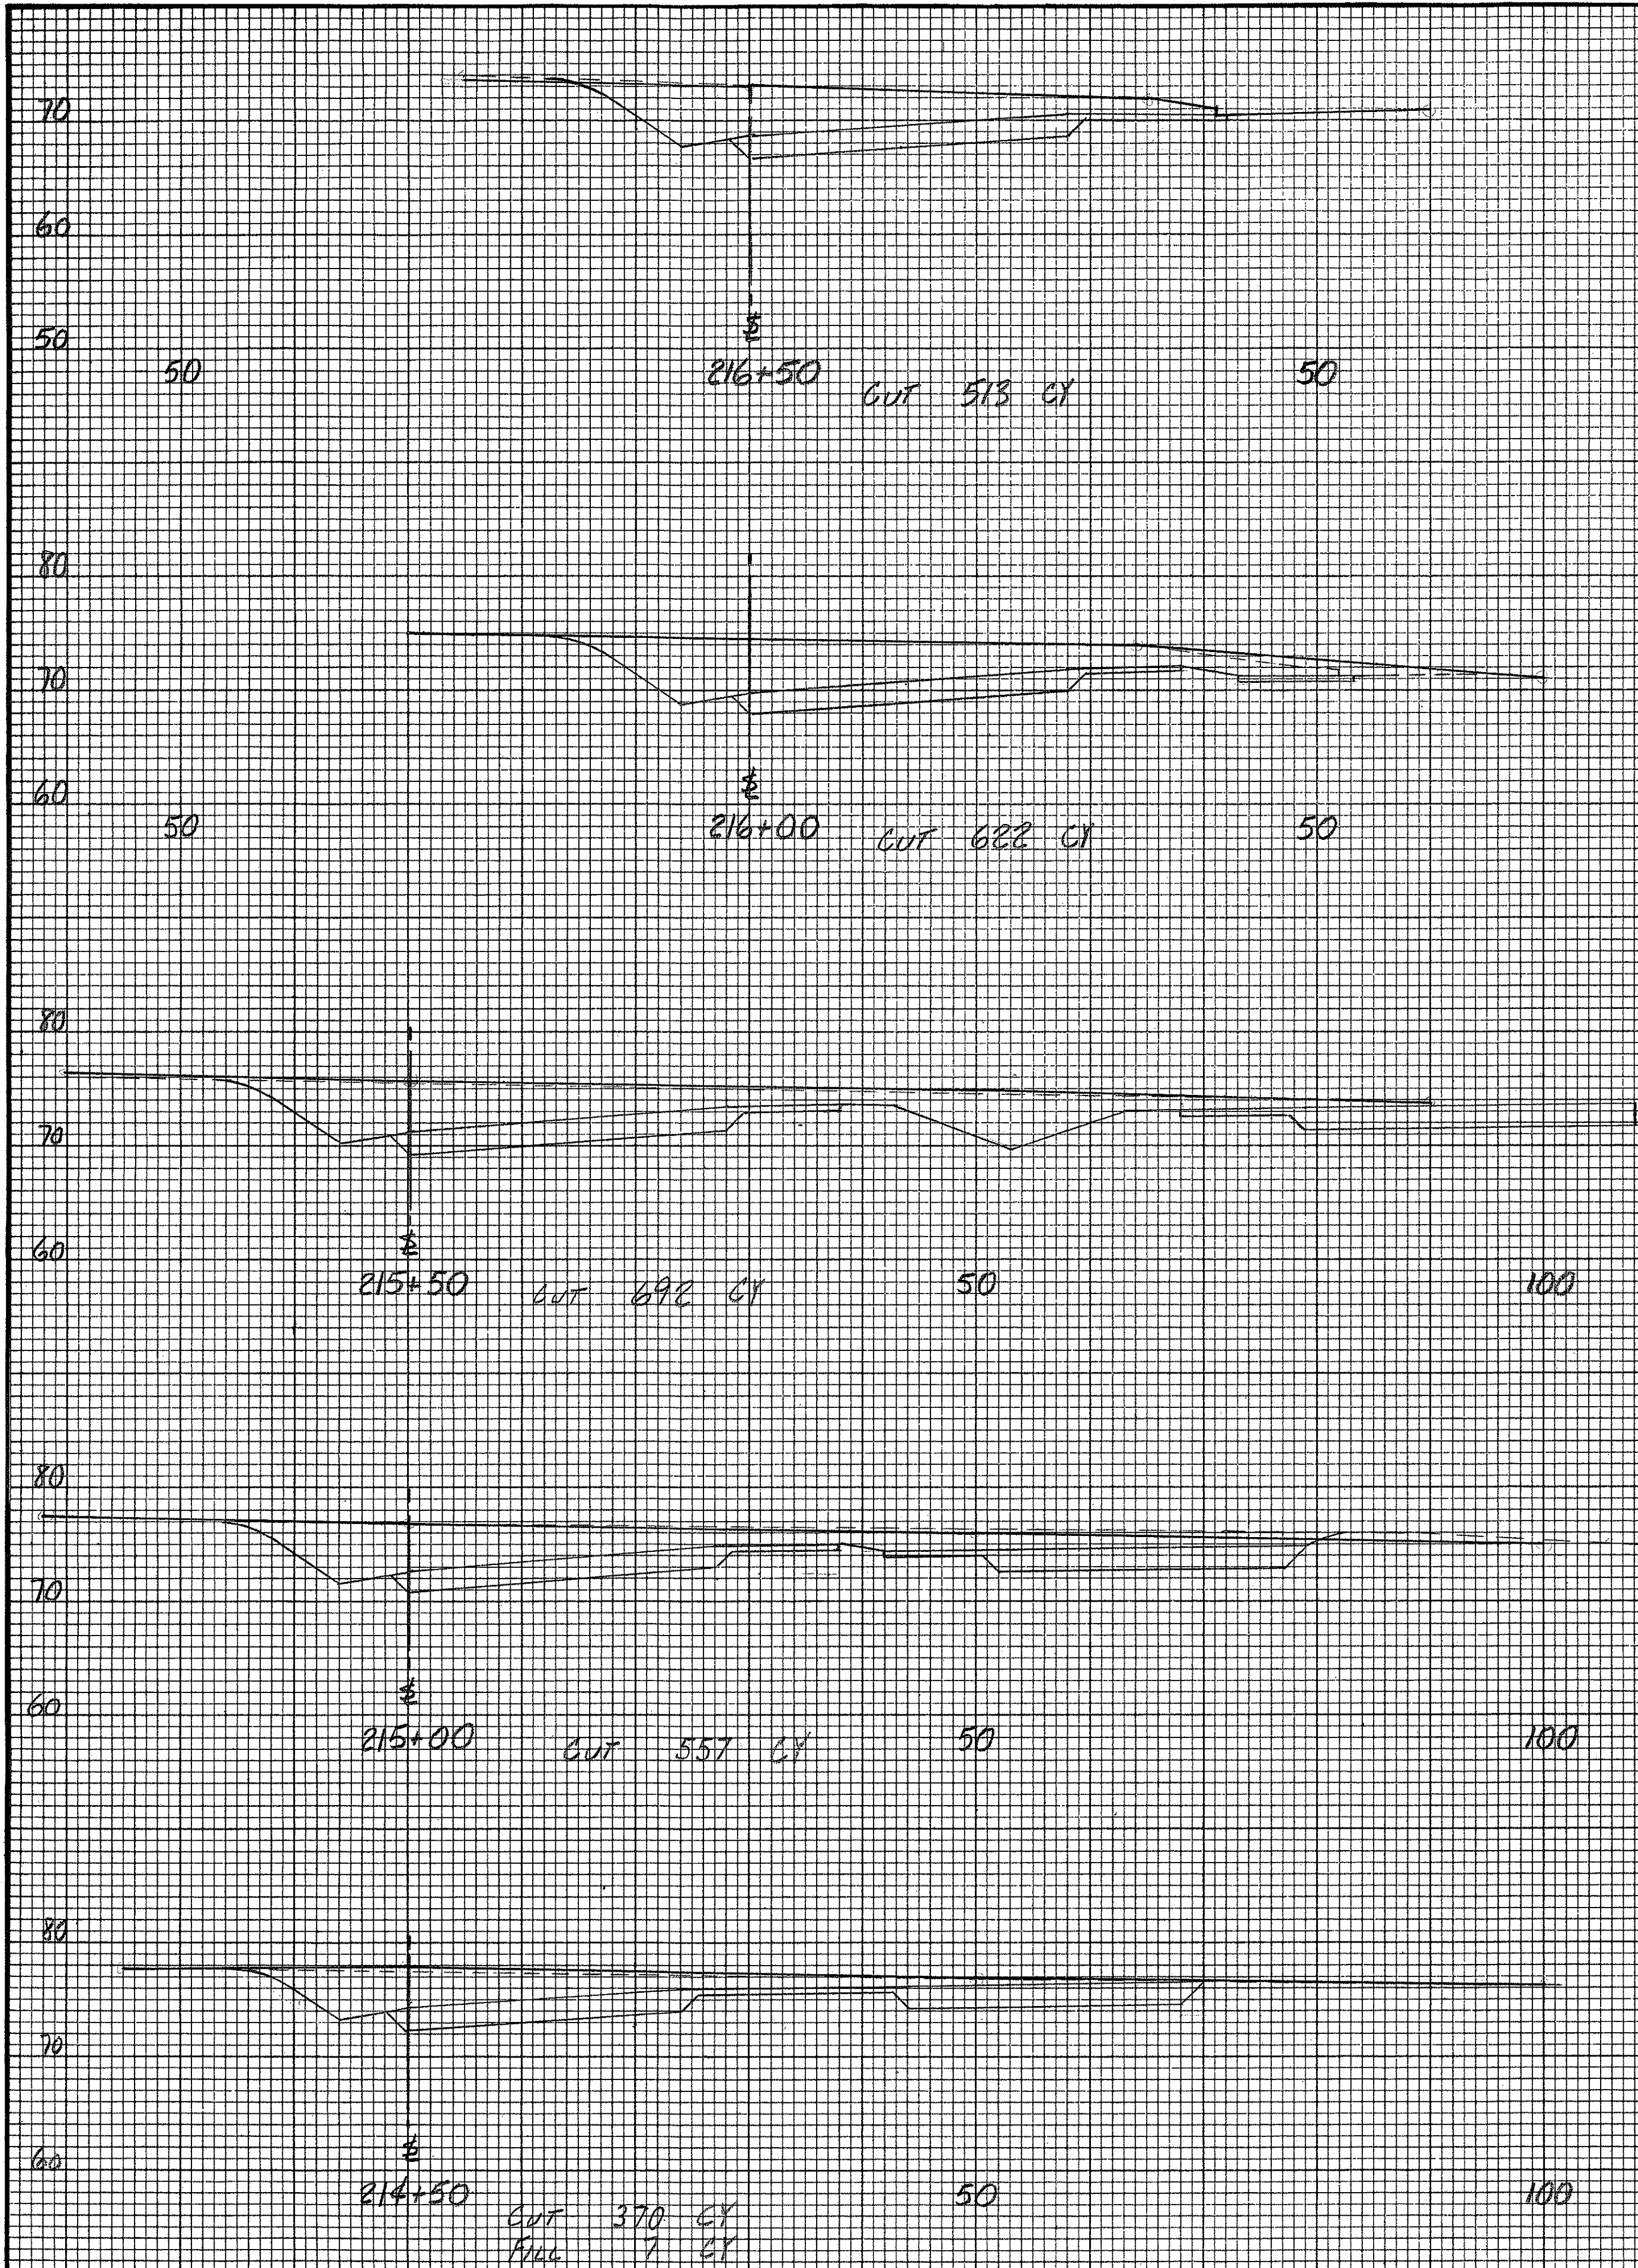

TEMPORARY CONNECTION TO MOANALUA ROAD
MOANALUA ROAD STATIONING

TEMPORARY CONNECTION TO MOANALUA ROAD
OUTBOUND STATIONING

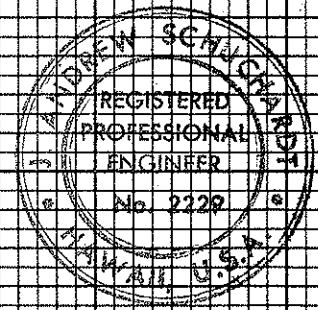

THIS WORK WAS PREPARED BY
ME OR UNDER MY SUPERVISION.



[Signature]

Scale: Horiz. 1"=10'
Vert. 1"=10'

FED. ROAD DIST. NO.	STATE	FED. AID PROJ. NO.	FISCAL YEAR	SHEET NO.	TOTAL SHEETS
HAWAII	HAW.	I-HI-1(78):13	1970	46	47

FINAL SURVEY NOTE BOOK NO.	SURVEYED PLOTTED TEMPLATE AREAS CHECKED	BY	DATE

ORIGINAL SURVEY NOTE BOOK NO.	SURVEYED PLOTTED TEMPLATE AREAS CHECKED	BY	DATE

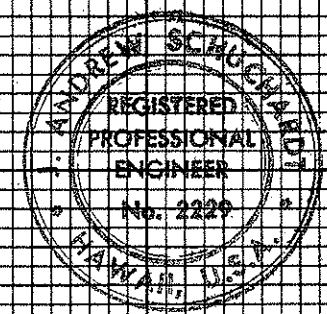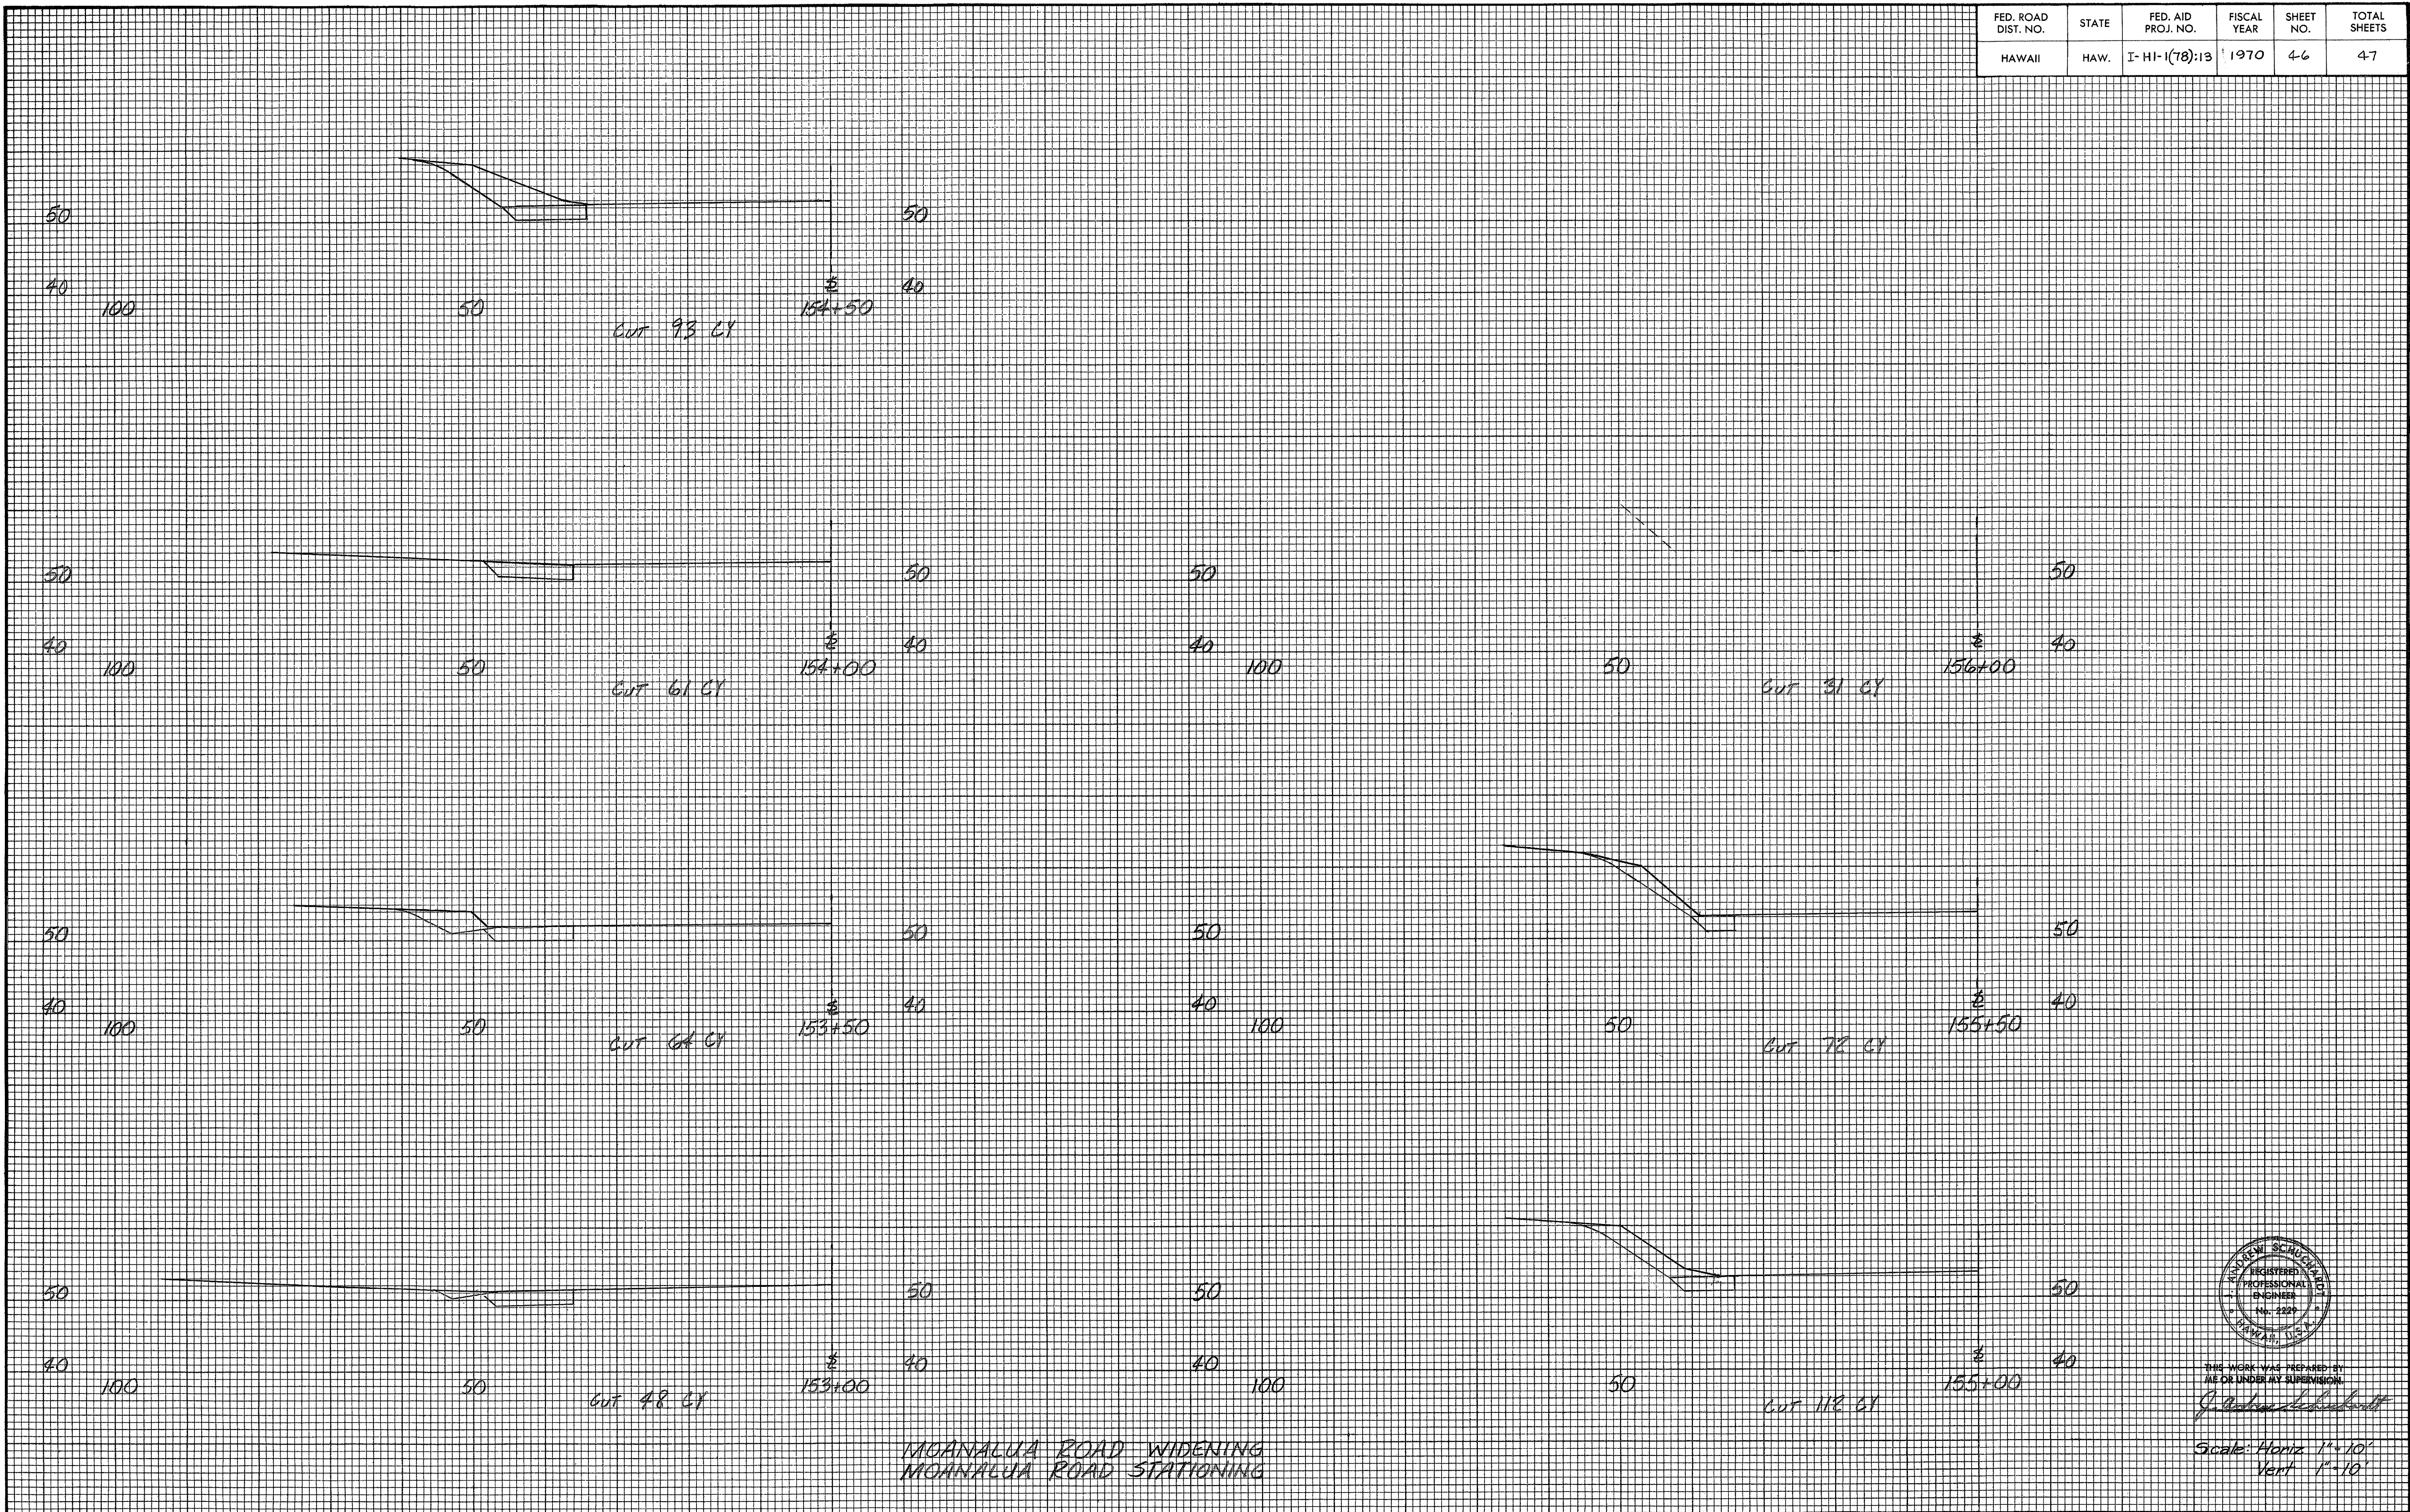

THIS WORK WAS PREPARED BY
ME OR UNDER MY SUPERVISION
J. Andrew Schuchman

Scale: Horiz 1"=10'
Vert 1"=10'