

DATE: _____ BY: _____

SURVEYED: _____

NOTED: _____

NO. _____

AREAS CHECKED: _____

DATE: _____ BY: _____




SURVEYED: _____

NOTED: _____

NO. _____

AREAS CHECKED: _____

FED. ROAD DIST. NO.	STATE	FED. AID PROJ. NO.	FISCAL YEAR	SHEET NO.	TOTAL SHEETS
HAWAII	HAW.	I-H-1(78)-13	1970	4	47

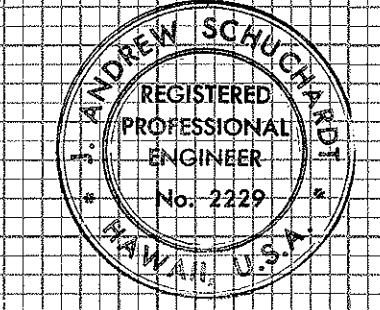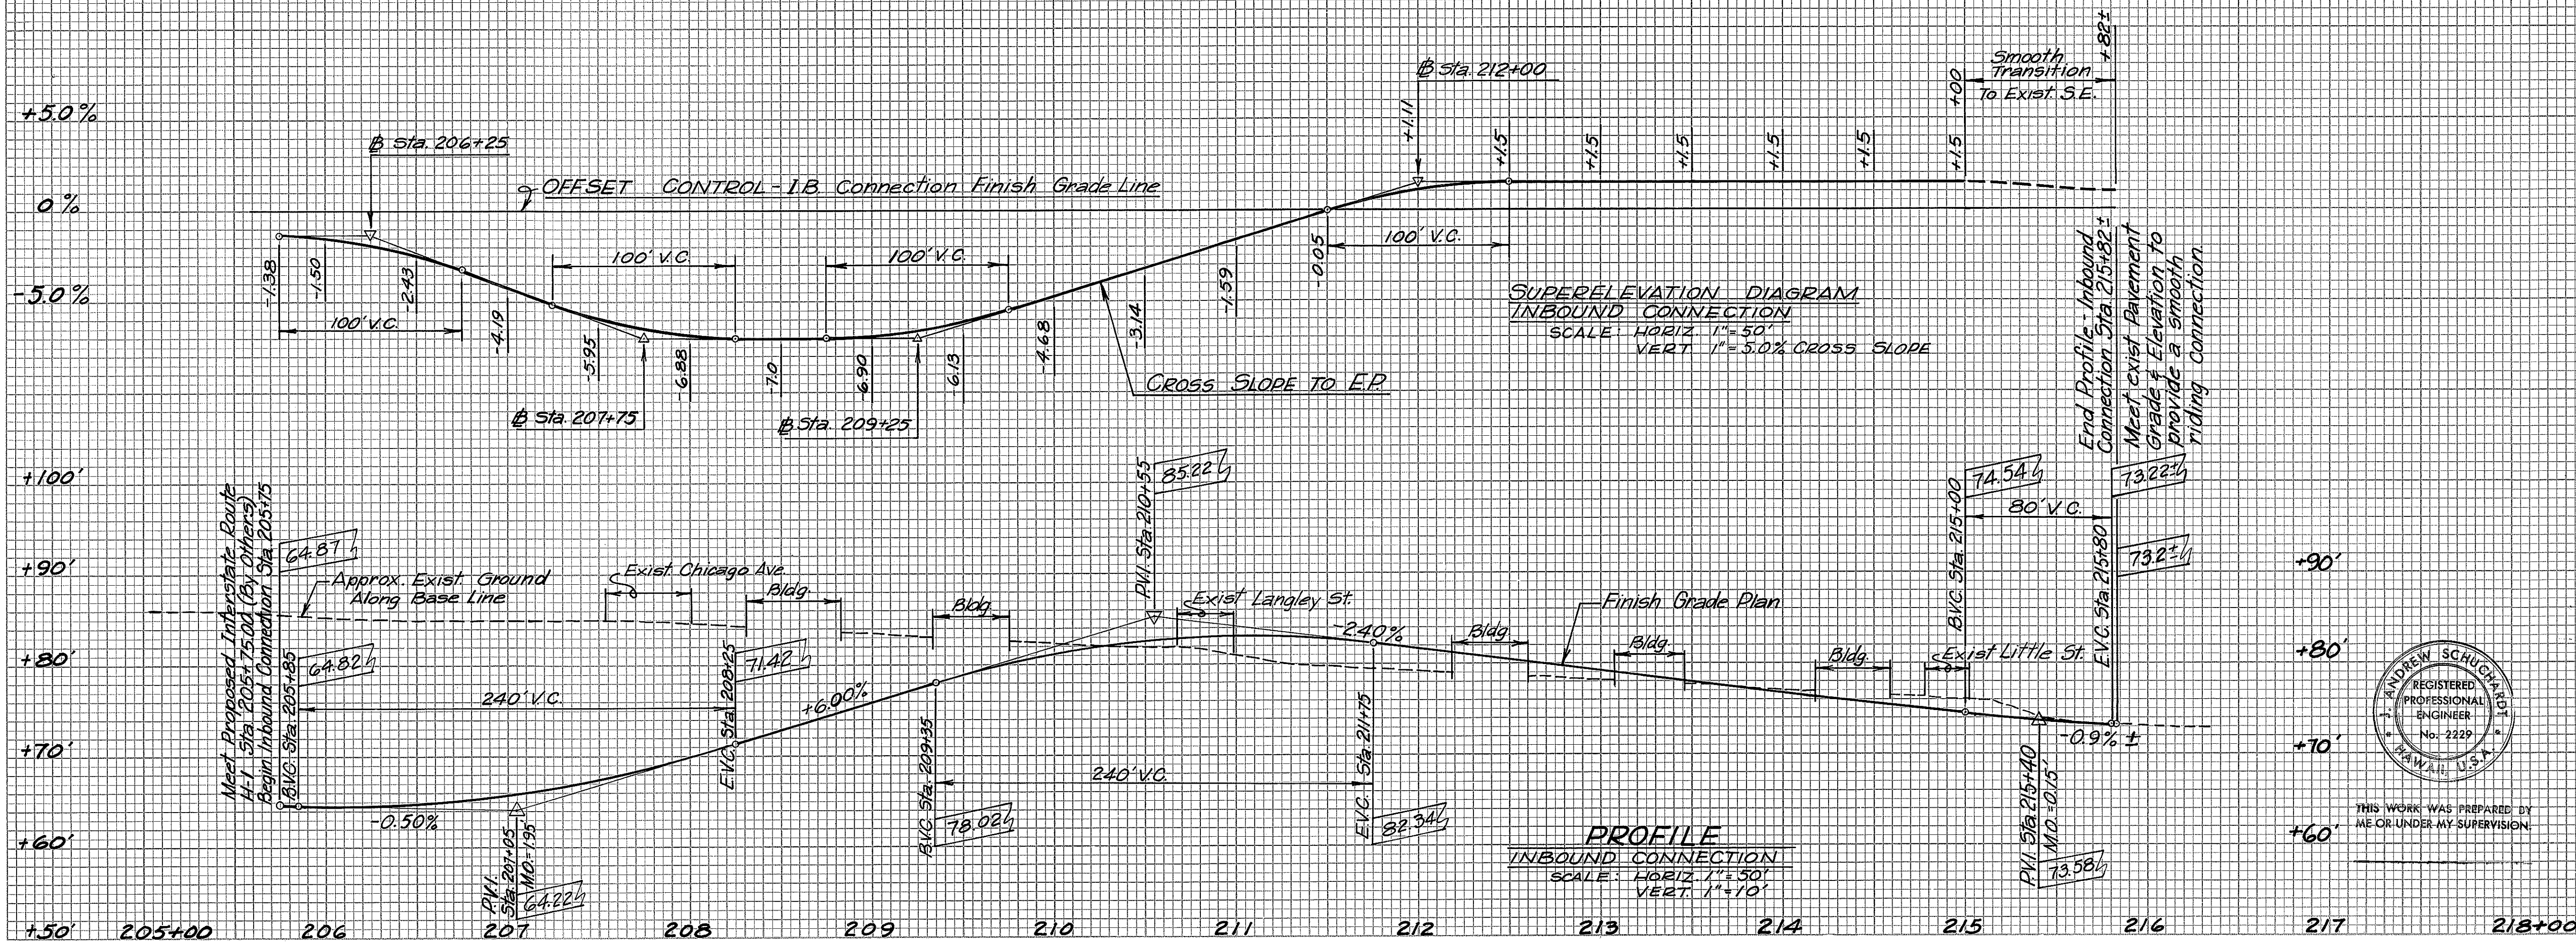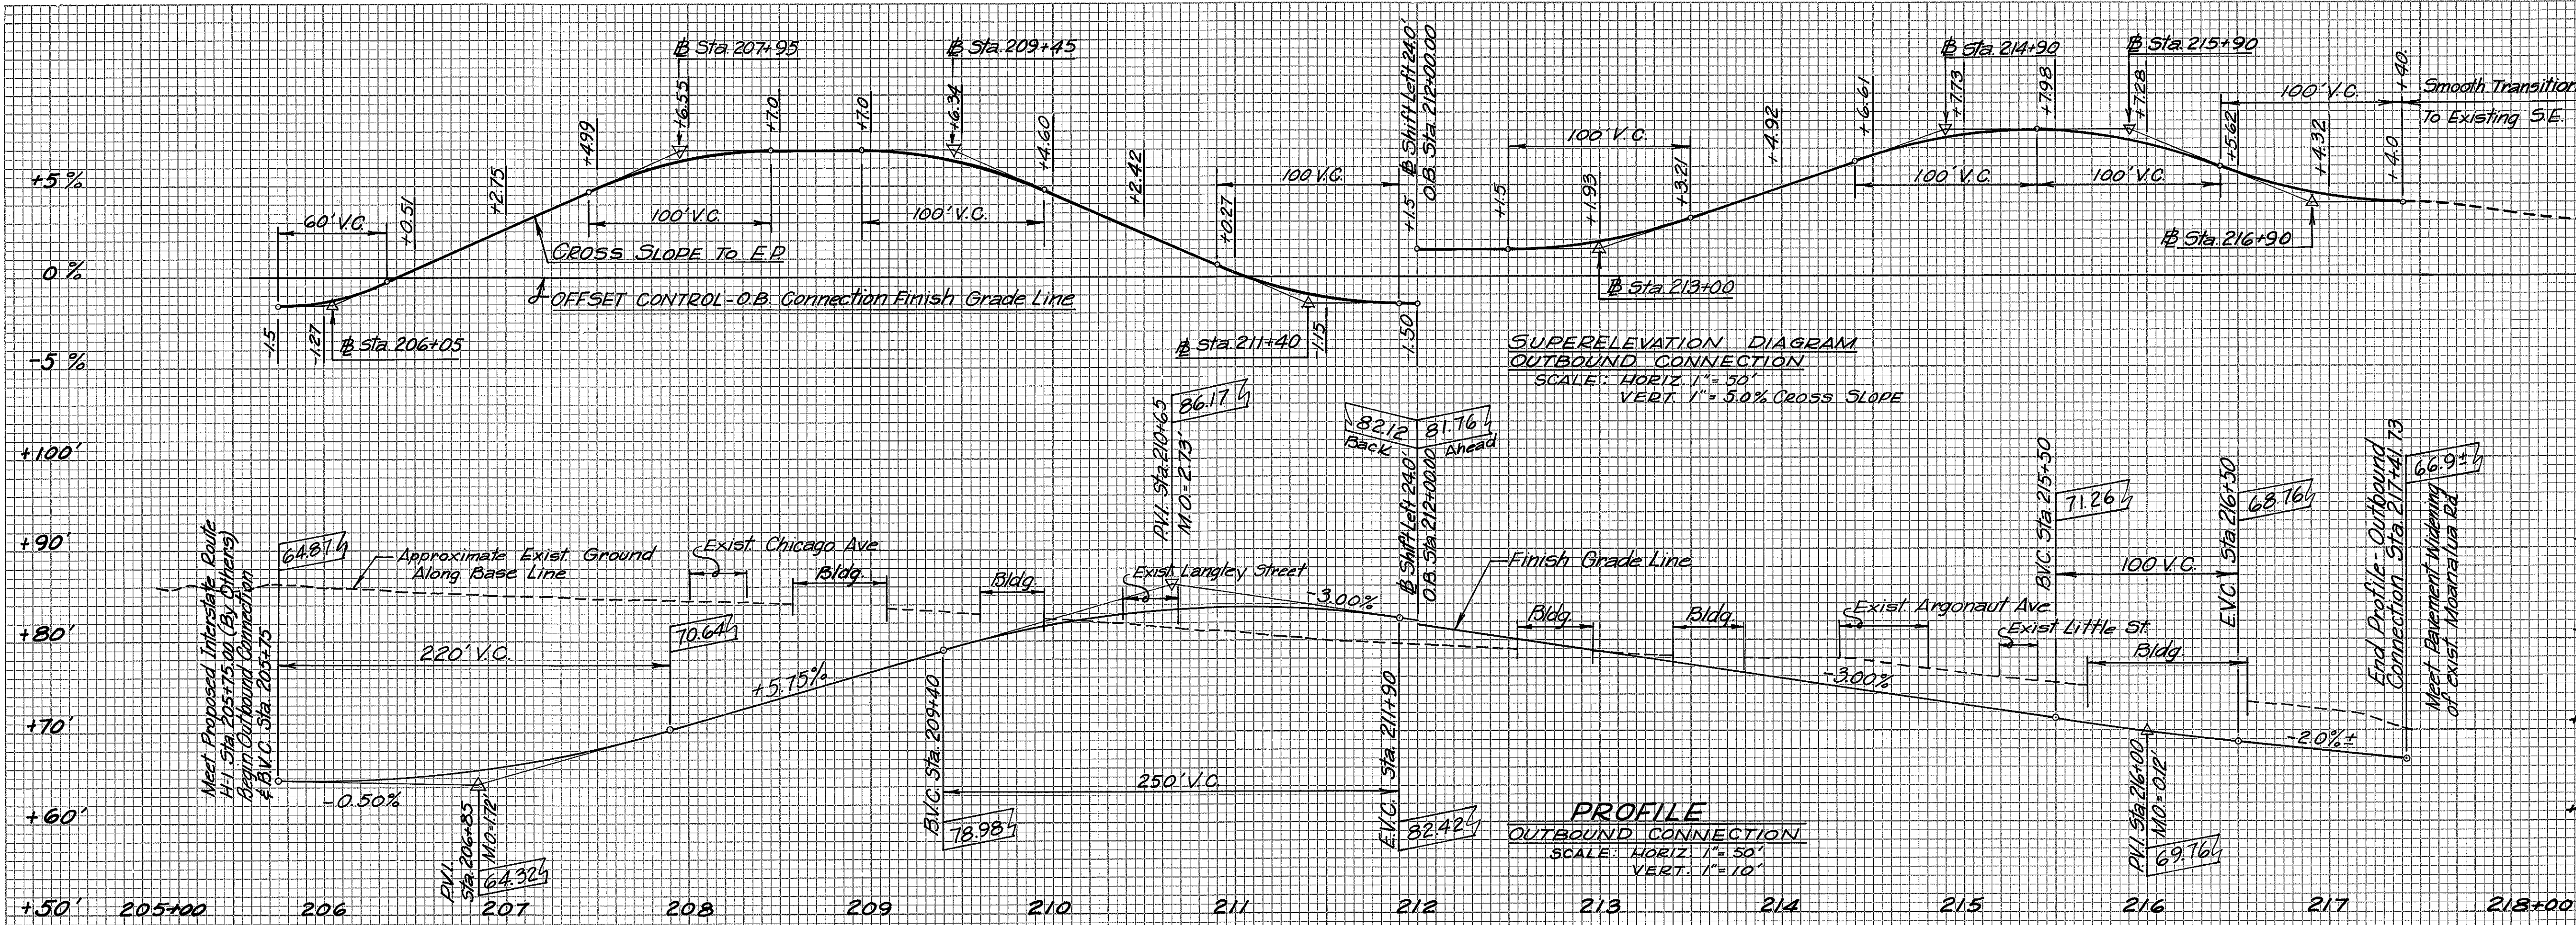

THIS WORK WAS PREPARED BY ME OR UNDER MY SUPERVISION.