98 E	IN	NDEX TO DRAWINGS
-	SHEET NO.	DESCRIPTION
-		TITLE SHEET
	2	LAYOUT PLAN
-	3	TYPICAL SECTIONS
	4 - 8	PLANS
***************************************		STANDARD AND
,	9 - 10	MISCELLANEOUS DETAILS
	<del>andiana apira ana ayan ayan ayan ayan ayan ayan a</del>	
	*	
		ta galang dan pangkanang ang ang ang ang ang ang ang ang an
-		
-		
-		
-		

STATE OF HAWAII


DEPARTMENT OF TRANSPORTATION
HIGHWAYS DIVISION
HONOLULU, HAWAII

"AS BUILT"
PLANS OF

## RESURFACING A PORTION OF H-I FREEWAY MIDDLE STREET TO PELE STREET

PROJECT No. HI-HI-01-71

DISTRICT OF HONOLULU
ISLAND OF OAHU

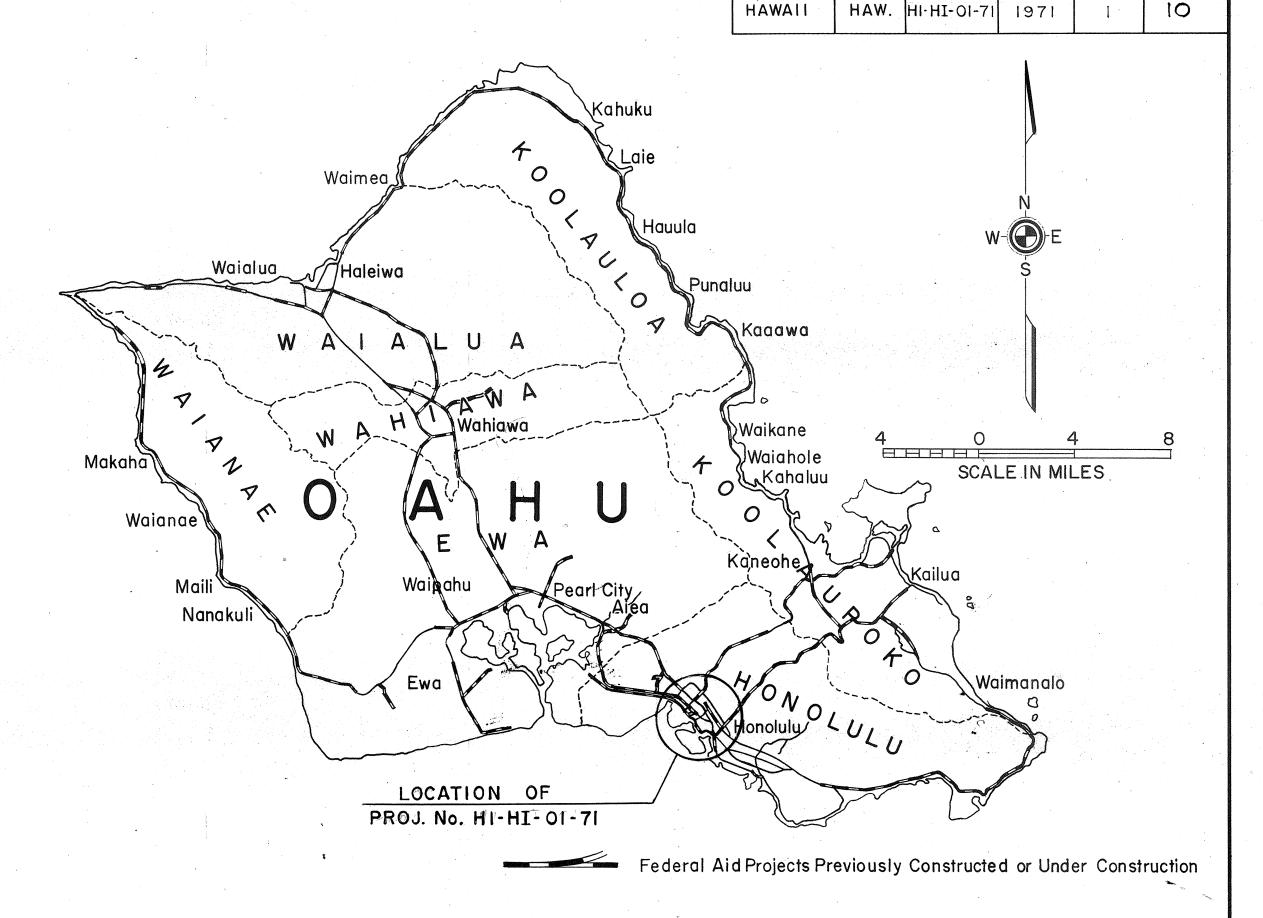

## NOTE:

ALL CHANGES MADE DURING CONSTRUCTION HAVE BEEN NOTED IN RED ON THESE TRACINGS AND CHECKED BY:

PROJECT ENGINEER

7/24/73
DATE

DEPARTMENT OF TRANSPORTATION
STATE OF HAWAII

APPROVED:

6. Olivery Haright 4/19/71

DIR. OF TRANSPORTATION DATE

Mikami Apri