



FED. ROAD DIST. NO.	STATE	FED. AID PROJ. NO.	FISCAL YEAR	SHEET NO.	TOTAL SHEETS
HAWAII	HAW.	I-H1-1(89):13	1971	201	362

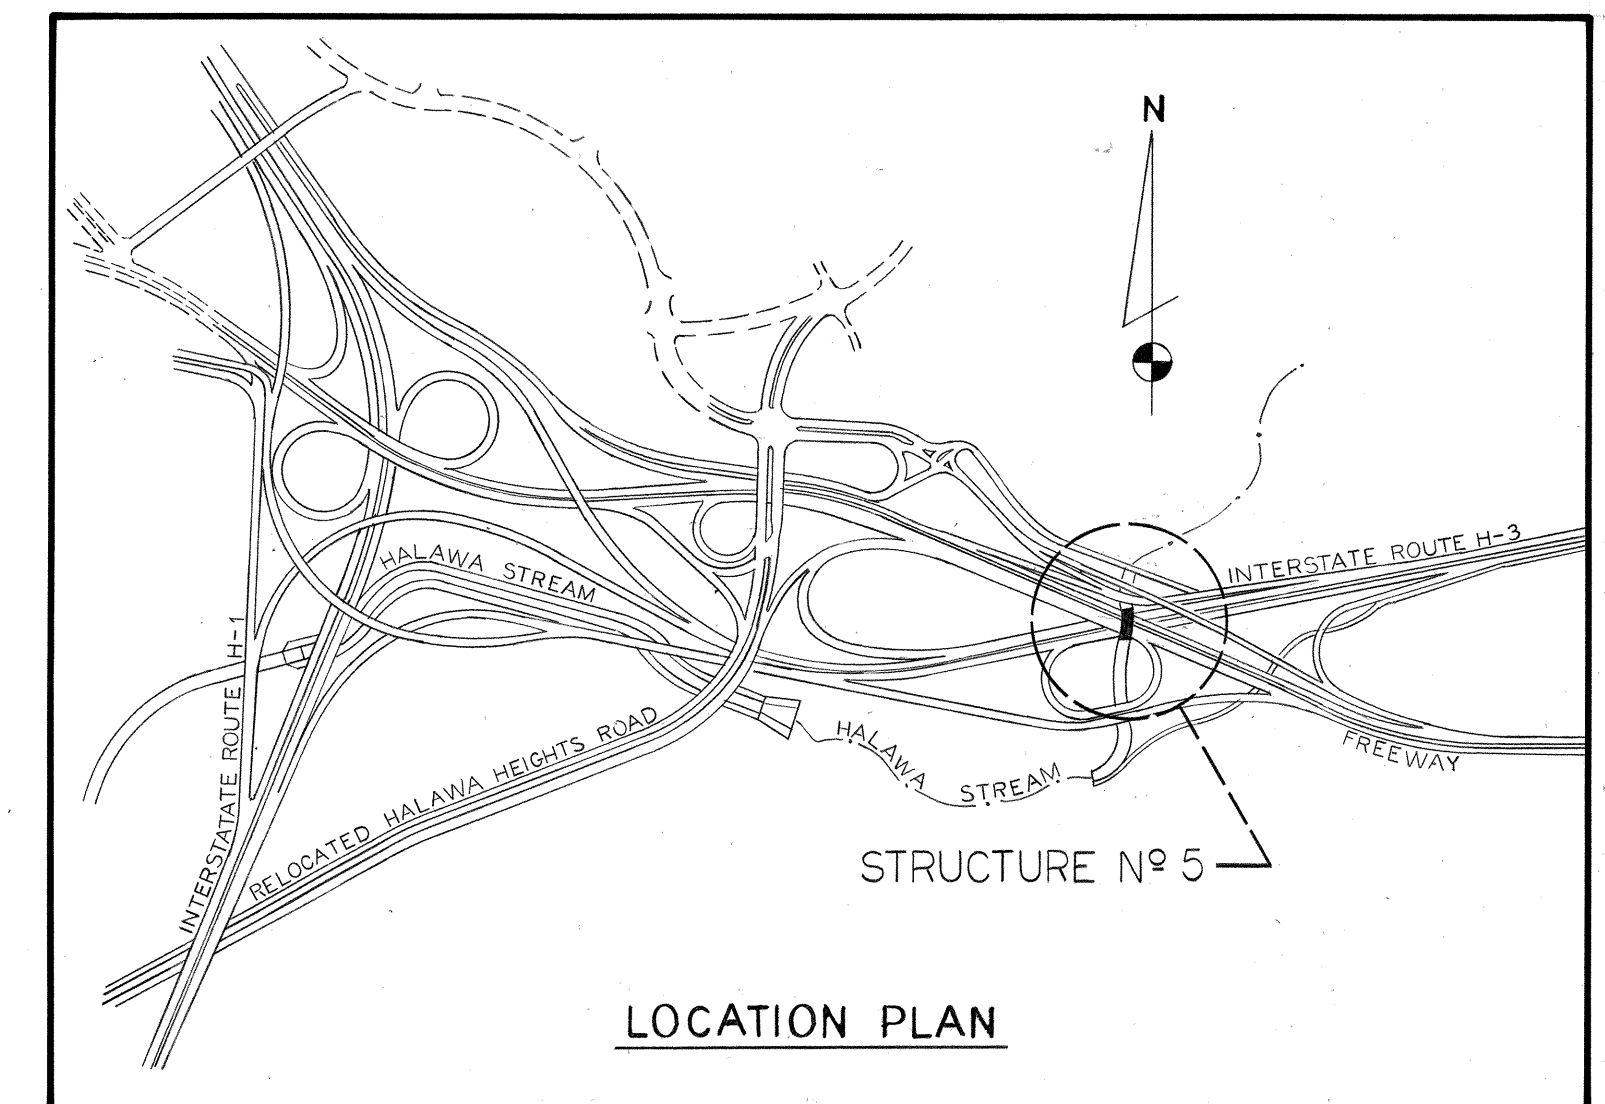

ESTIMATED QUANTITIES			
ITEM NO	ITEM	UNIT	QUANTITY
206.40	STRUCTURE EXCAVATION FOR BRIDGES	C.Y.	235
206.81	FILTER MATERIAL FOR STRUCTURES	C.Y.	200
503.073	CONCRETE IN STRUCTURE NO. 5 (EXCEPT FOOTING)	L.S.	(530 CY)
503.074	CONCRETE IN STRUCTURE NO. 5 FOOTINGS	L.S.	(231 CY)
504.321	TYPE II PRESTRESSED CONC. GIRDERS IN STRUCTURE NO. 5	L.S.	(582 L.F.)
507.10	METAL BRIDGE RAILING - ONE RAIL ON PARAPET	L.F.	89
507.10	CONCRETE BRIDGE PARAPET, INCLUDING END POST	L.F.	129
607.012	REINFORCING STEEL IN STRUCTURE NO. 5	L.S.	(116,200 lb.)
606.416	GUARD RAIL TYPE 4G	L.F.	84

BRIDGE NOTES:


- DESIGN SPECIFICATIONS:**
"Standard Specifications for Highway Bridges" A.A.S.H.O. 1963 with subsequent additions and modifications by the State of Hawaii Department of Transportation.
- DESIGN LIVE LOAD:** HS 20-44 or Interstate loading.
- DESIGN STRESSES:** $f_c = 3000$ psi See Sheet 55 for Prestressed Conc. Girder Design Stresses.
 $f_s = 20,000$ psi tension
 $n = 10$
- MATERIALS:**
All Reinf. Steel to be ASTM Designation A615 Grade 40.
- See Structure No. 4 for Construction Sequence.
- No backfill shall be placed behind abutments until conc. in deck slab, channel slab and struts has developed a strength of at least 3000 psi in compression. Backfilling shall be placed uniformly and simultaneously at each abutment to avoid unequal lateral earth pressure.
- For General Notes see sheet 241
- For Metal Bridge Railing Details, see sheets 242 & 243
- For End Post Details see Sheet 244
- For Struct. Exc. & Filter Mat'l. Payment Limits & Jt. Details see Sh. 8W.

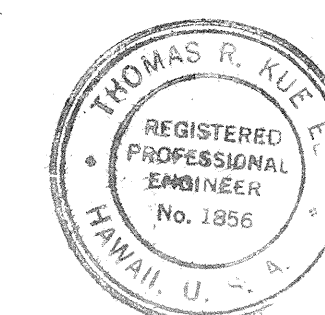


THIS WORK WAS PREPARED BY ME OR UNDER MY SUPERVISION

Thomas R. Kuehl

STATE OF HAWAII
DEPARTMENT OF TRANSPORTATION
HIGHWAYS DIVISION
**HALAWA INTERCHANGE
STRUCTURE NO. 5**
H-3 OVER NORTH HALAWA STREAM
GENERAL PLAN & PROFILE
PROJ. NO. I-H1-1(89):13 DATE: MAY 1971
SHEET No. 15 OF 55 SHEETS

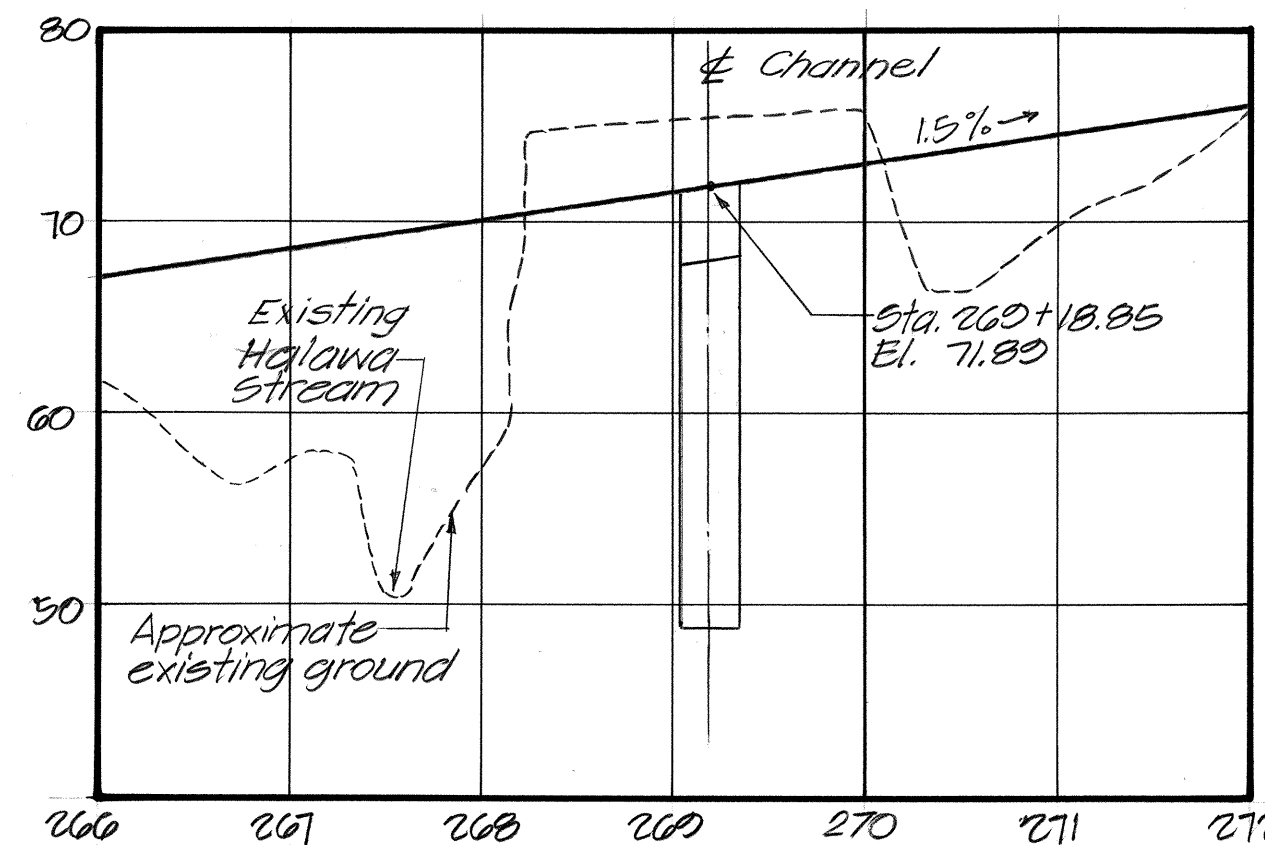


PROFILE- INTERSTATE ROUTE H-3
SCALES: HORIZ: 1"=100'; VERT: 1"=10'

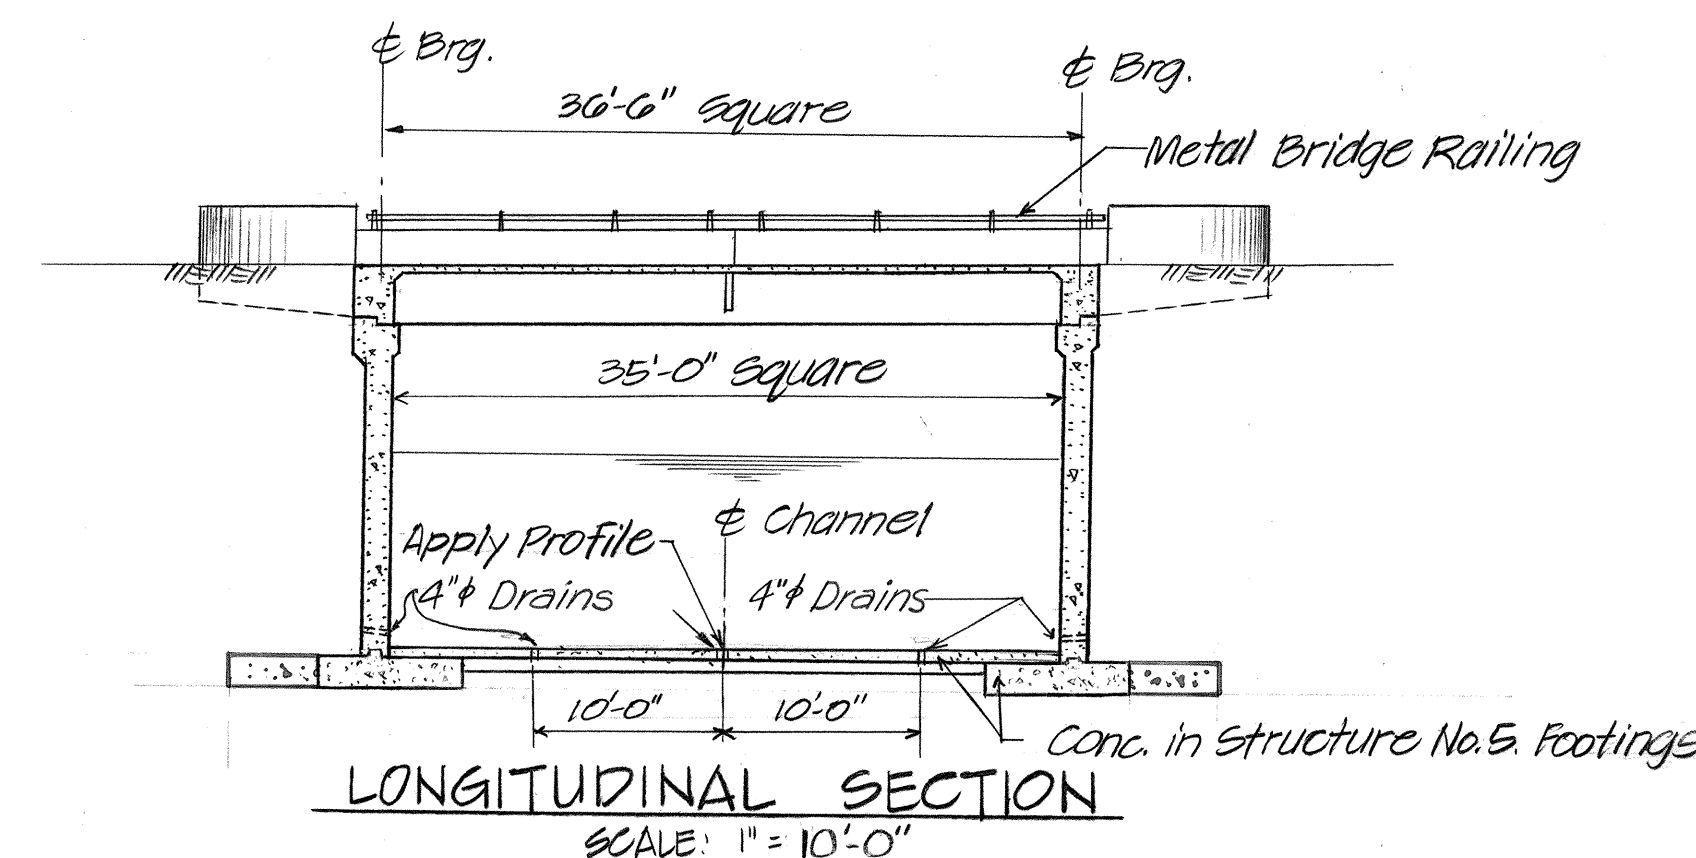


For Channel Profile see Drainage plans

CURVE DATA

CURVE NO.	115	116	117
Δ	5° 17' 00.0"	5° 37' 53.6"	5° 16' 59.9"
R	432.00	216.00	432.00
L	39.84	21.23	39.84
T	19.93	10.62	19.93

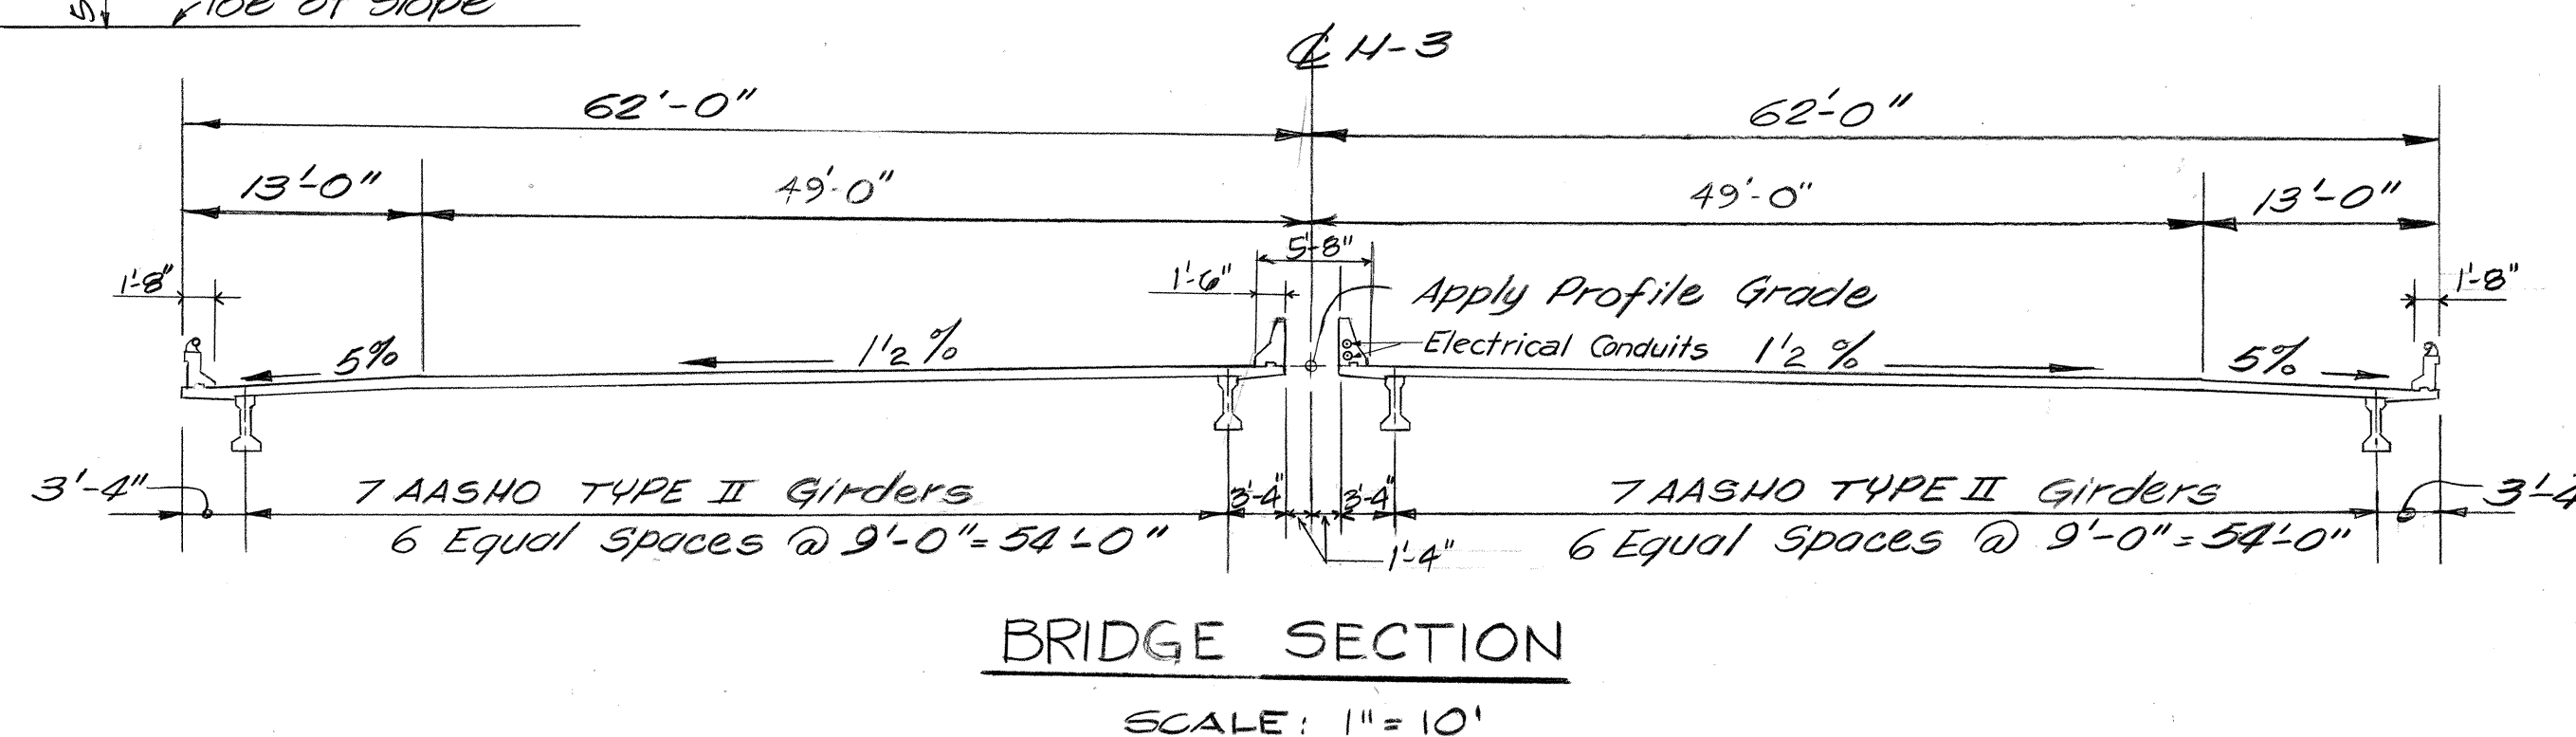

BRIDGE SECTION
SCALE: 1"=10'

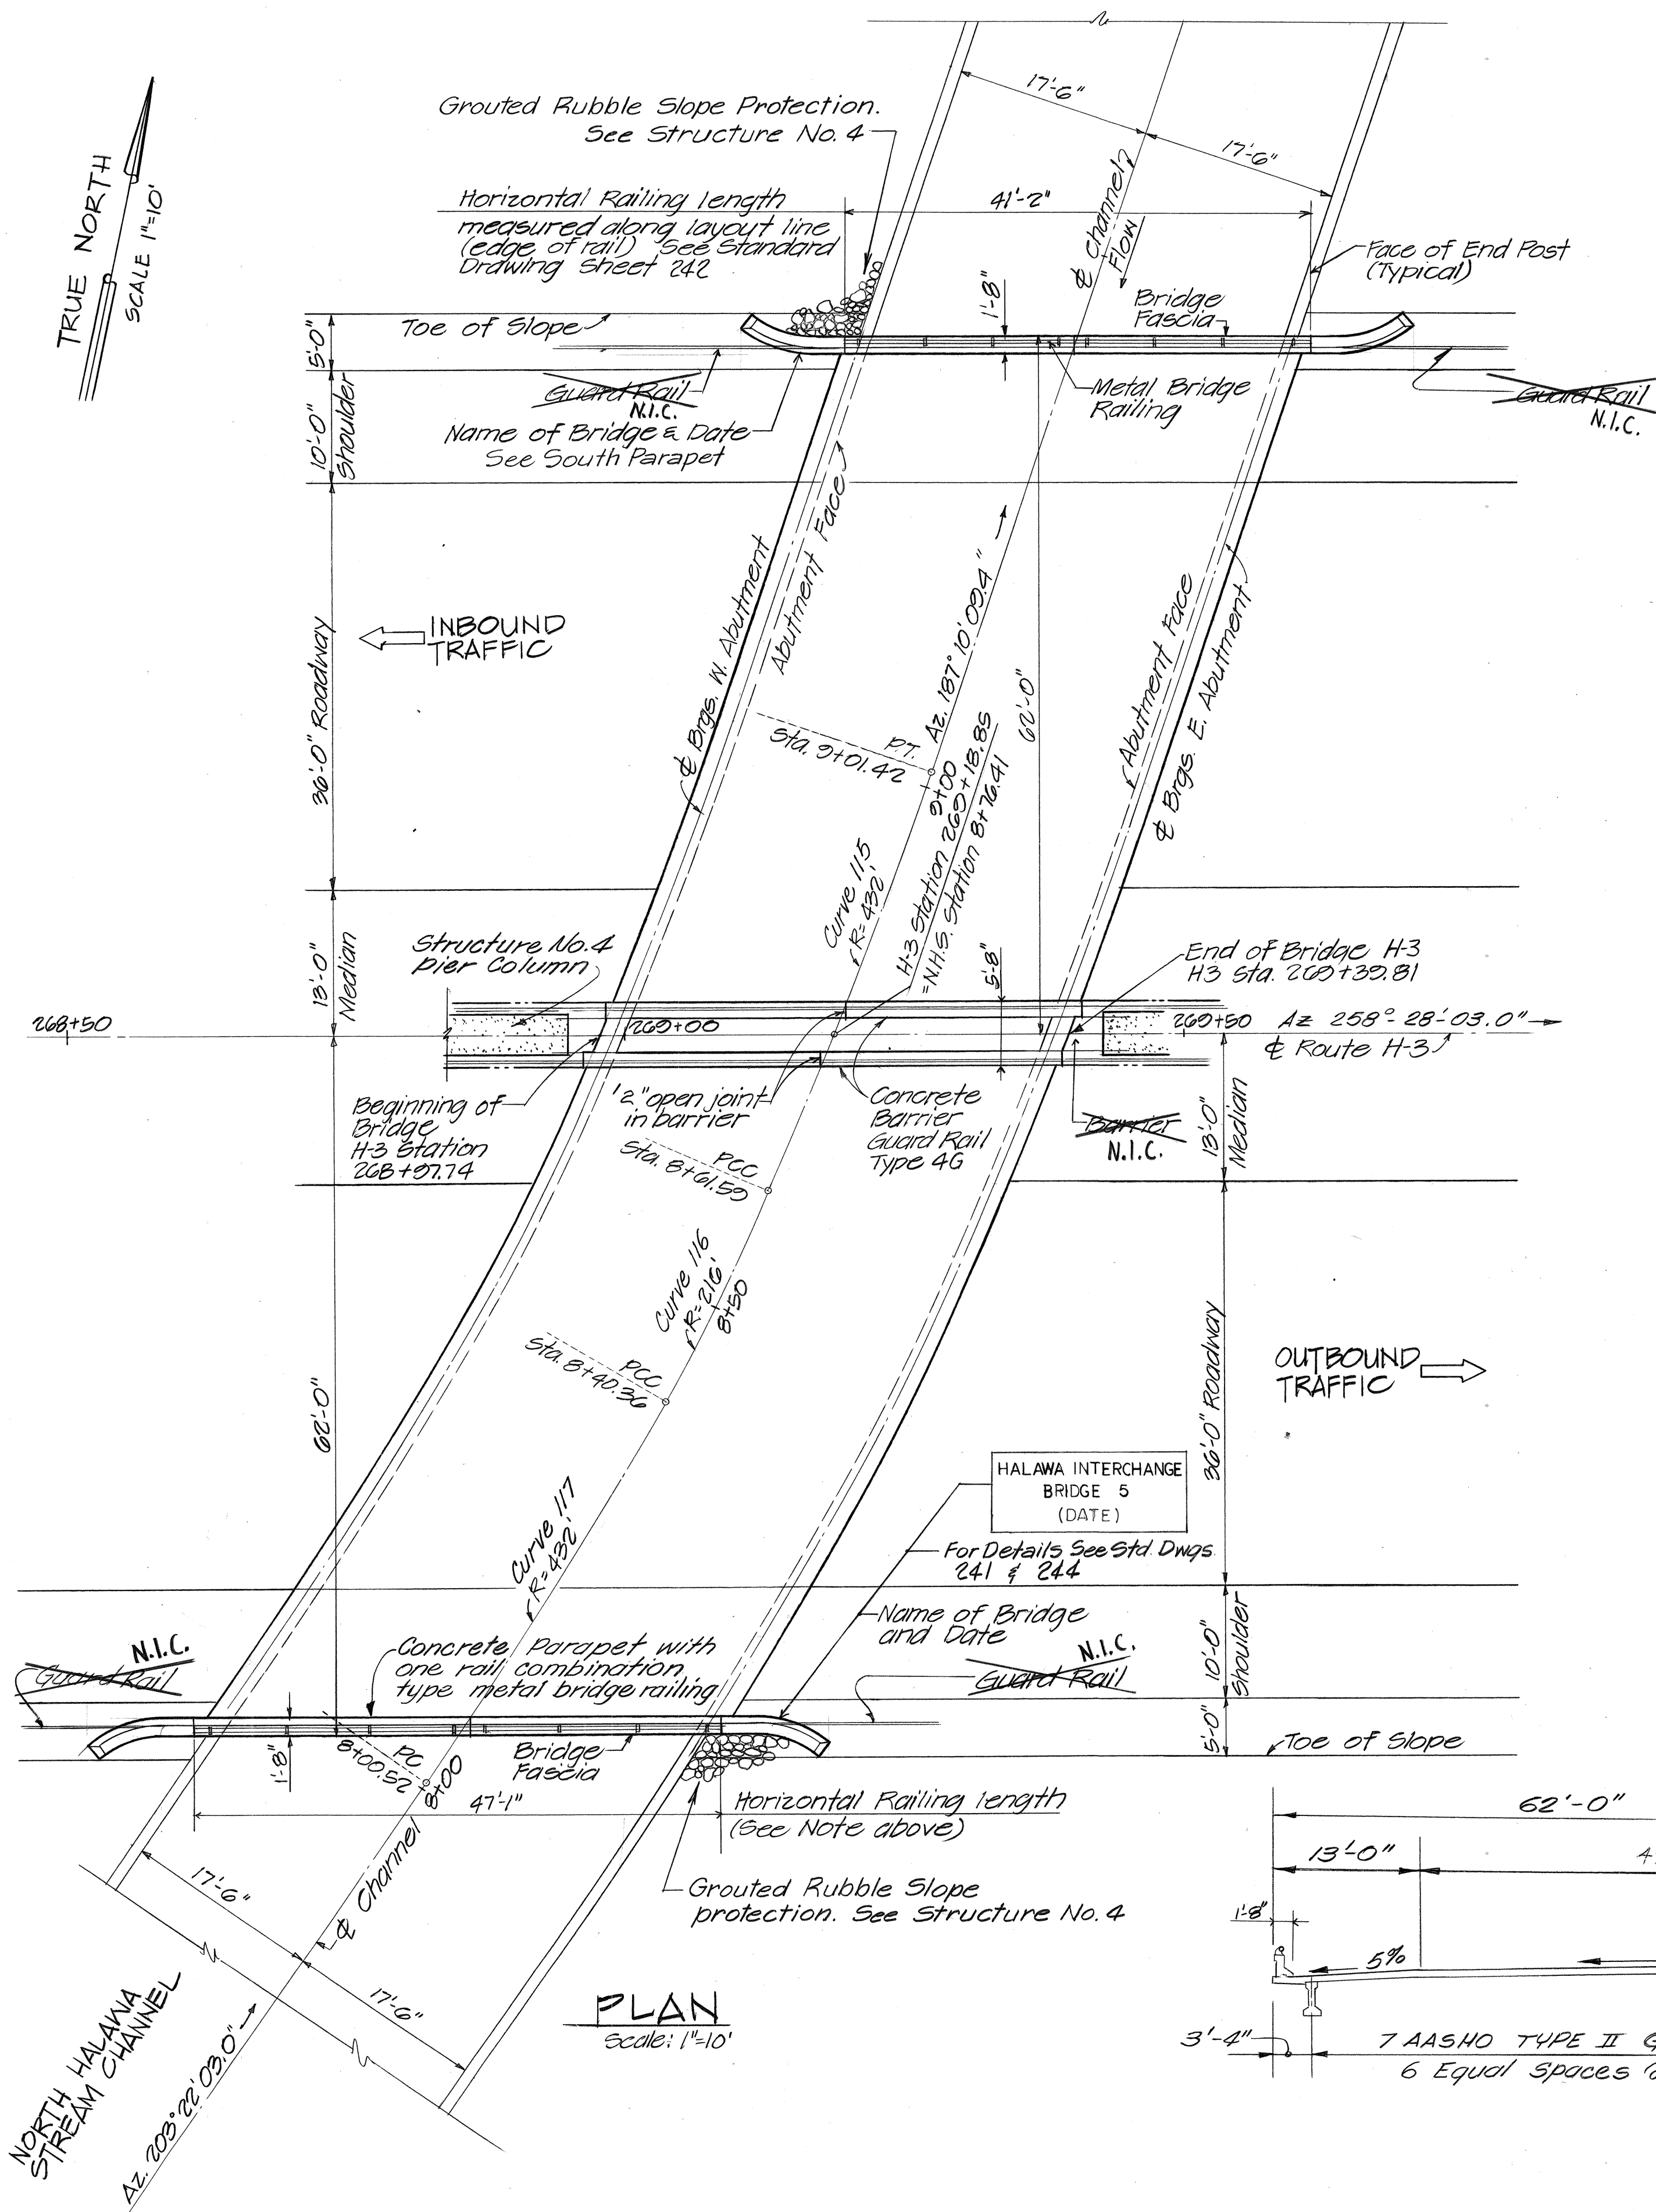


PLAN
Scale: 1"=10'

DESIGNED BY	DATE
DRAWN BY	
CHECKED BY	
NOTED BY	
ORIGINAL PLAN	
NOTE BOOK	
NO.	

GIRDER SEAT SCHEDULE

BEAM MARK	WEST ABUTMENT		EAST ABUTMENT	
	ELEV.	ANGLE A	ELEV.	ANGLE B
A-1	66.90	18°-42'	67.48	18°-42'
A-2	67.30	18°-42'	67.88	18°-42'
A-3	67.42	18°-42'	67.99	18°-42'
A-4	67.51	18°-42'	68.08	18°-42'
A-5	67.59	19°-40'	68.17	18°-42'
A-6	67.68	21°-00'	68.26	19°-14'
A-7	67.76	22°-21'	68.35	20°-27'
A-8	67.70	23°-45'	68.29	21°-43'
A-9	67.50	26°-22'	68.10	22°-58'
A-10	67.30	29°-19'	67.91	24°-25'
A-11	67.08	30°-55'	67.71	26°-51'
A-12	66.86	32°-23'	67.50	29°-21'
A-13	66.62	33°-52'	67.27	30°-48'
A-14	66.07	34°-54'	66.73	32°-09'

WORK POINTS		
NO.	STATION	OFFSET
W.P."A"	H-3 268 + 62.96	62.00'R
W.P."B"	H-3 269 + 07.04	62.00'R
W.P."C"	H-3 269 + 21.34	62.00'L
W.P."D"	H-3 269 + 59.87	62.00'L

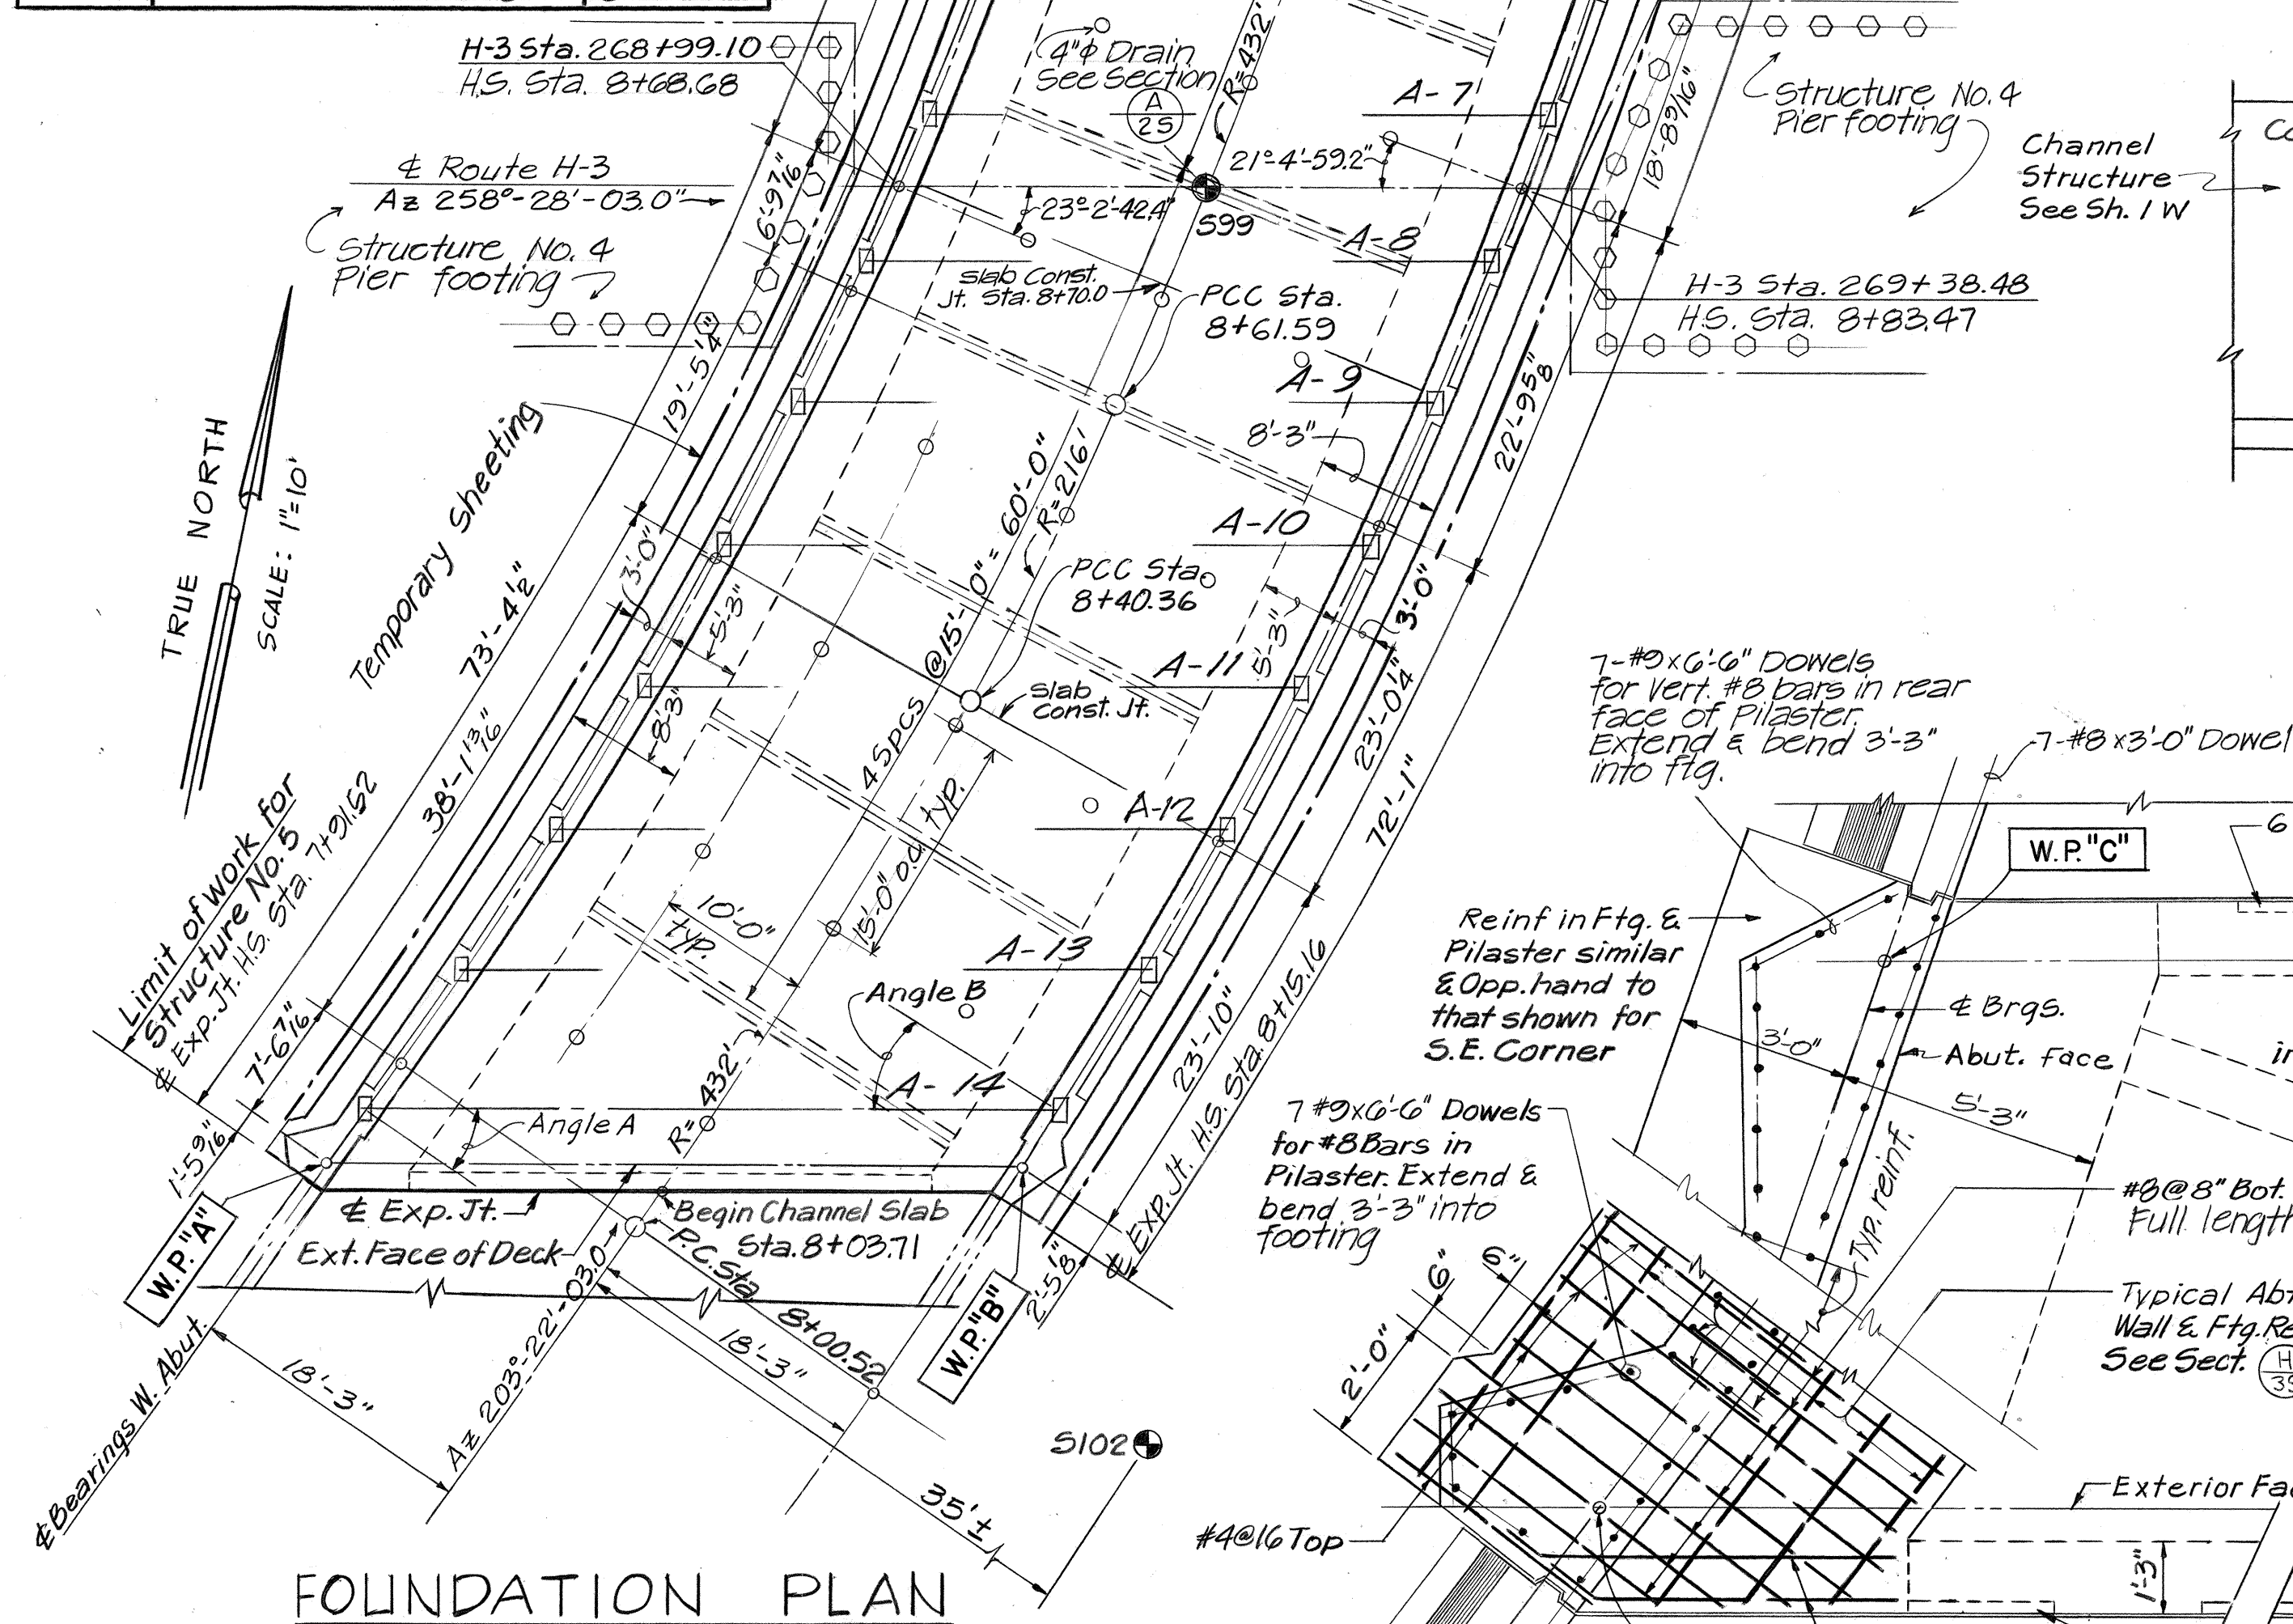


FOUNDATION PLAN

LEGEND


• Borings
For Additional Borings in vicinity of Bridge See Structure No. 4 Sheet

* NOTE: 1% Slope measured along ϕ of Channel
** NOTE: Elevation is Top of Deck at Intersection of inside face of Concrete Parapet & ϕ of Bearings.


FED. ROAD DIST. NO.	STATE	FED. AID PROJ. NO.	FISCAL YEAR	SHEET NO.	TOTAL SHEETS
HAWAII	HAW.	I-H-1(89):13	1971	202	362

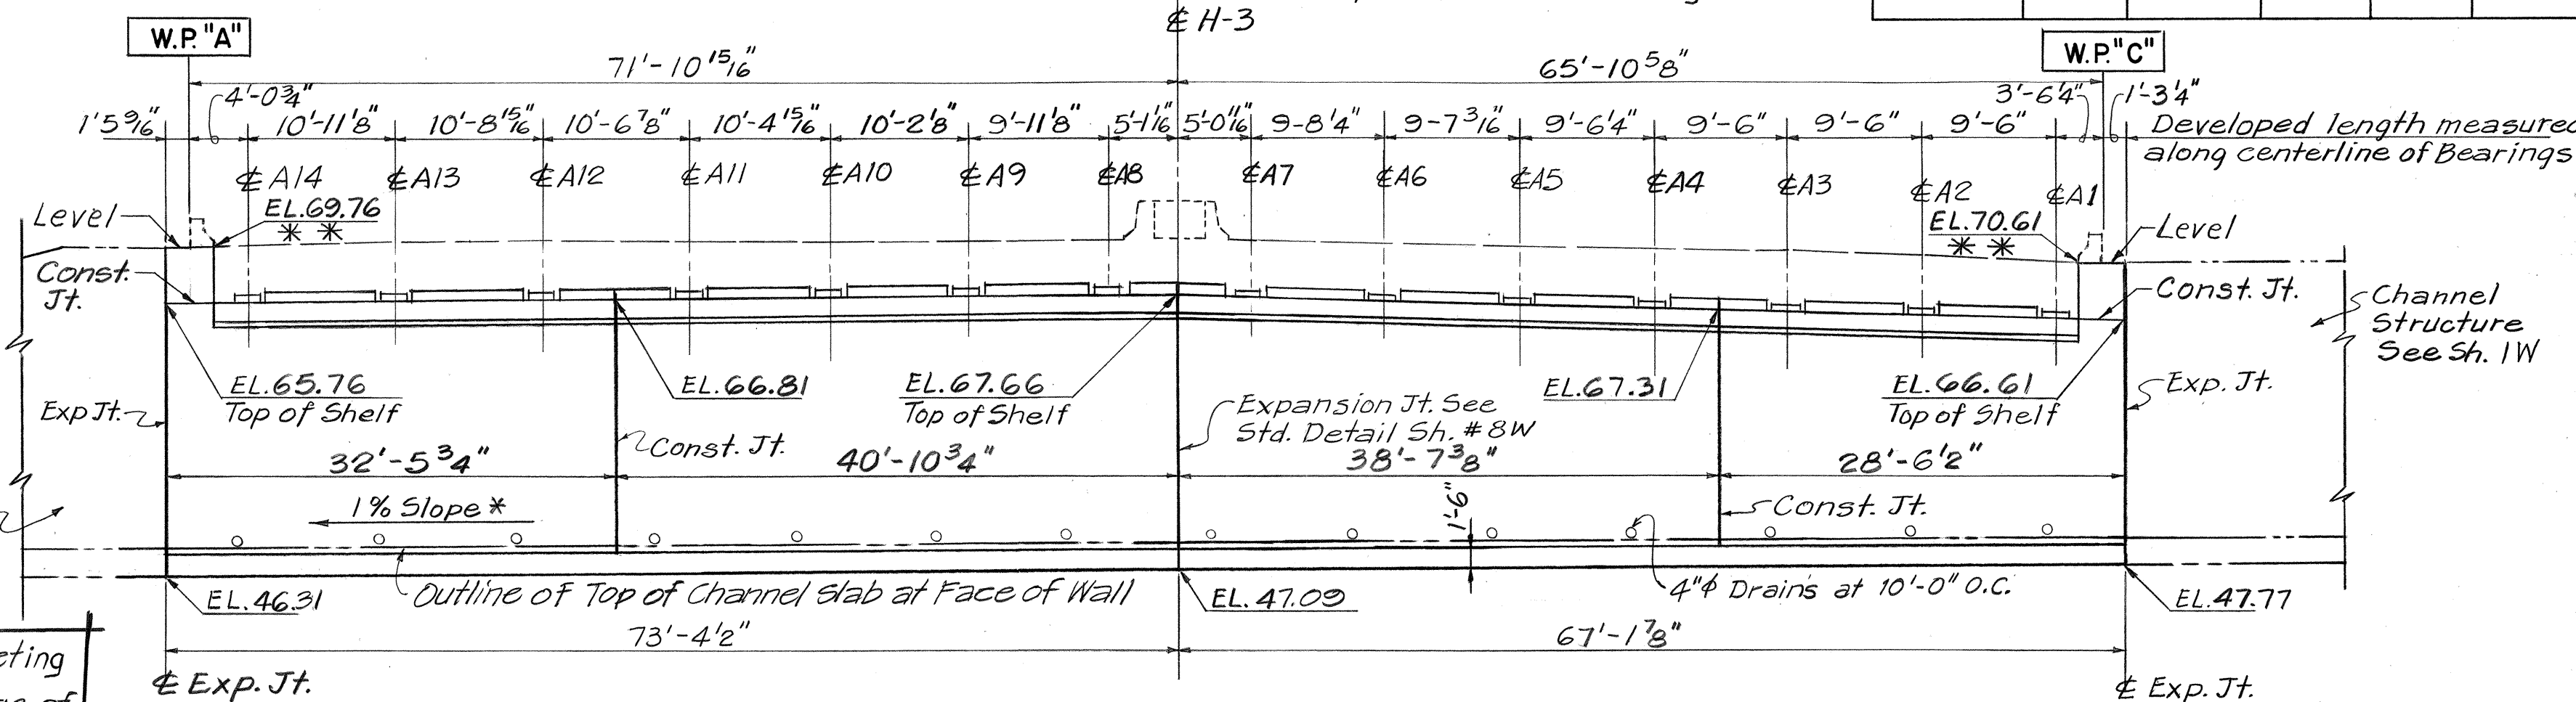

ELEVATION OF WEST ABUTMENT DEVELOPED VIEW

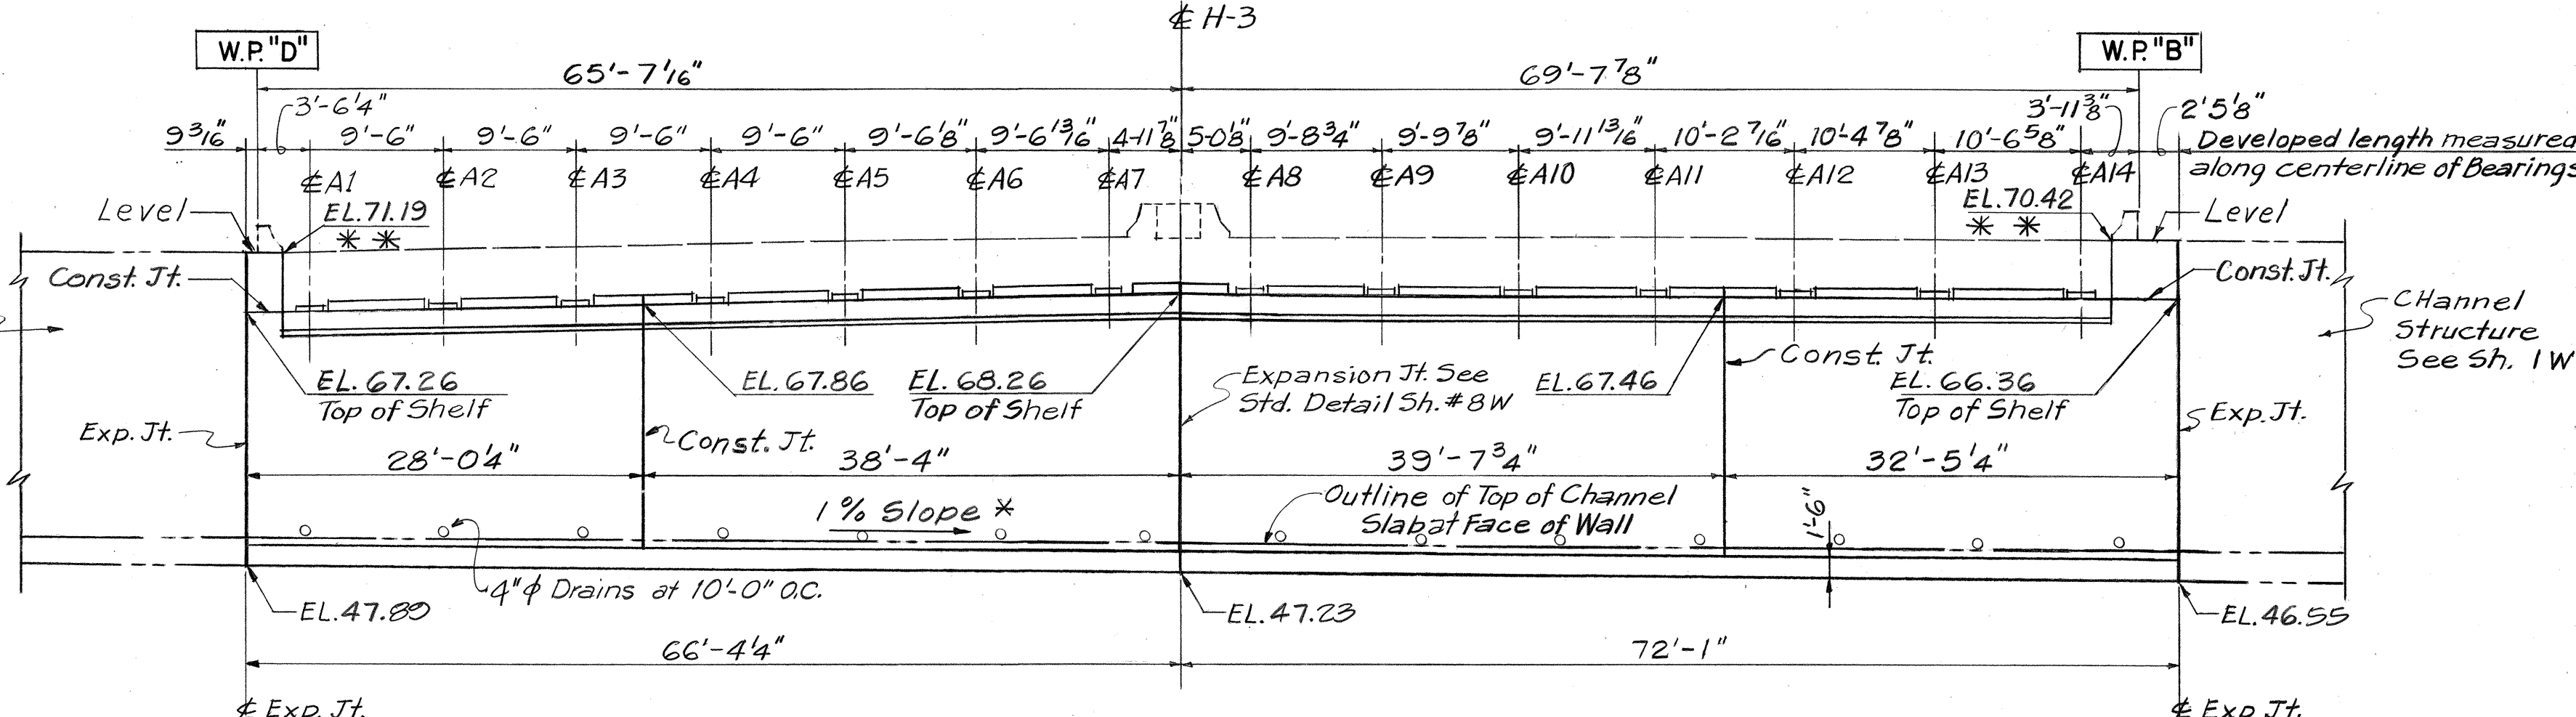

ELEVATION OF EAST ABUTMENT DEVELOPED VIEW

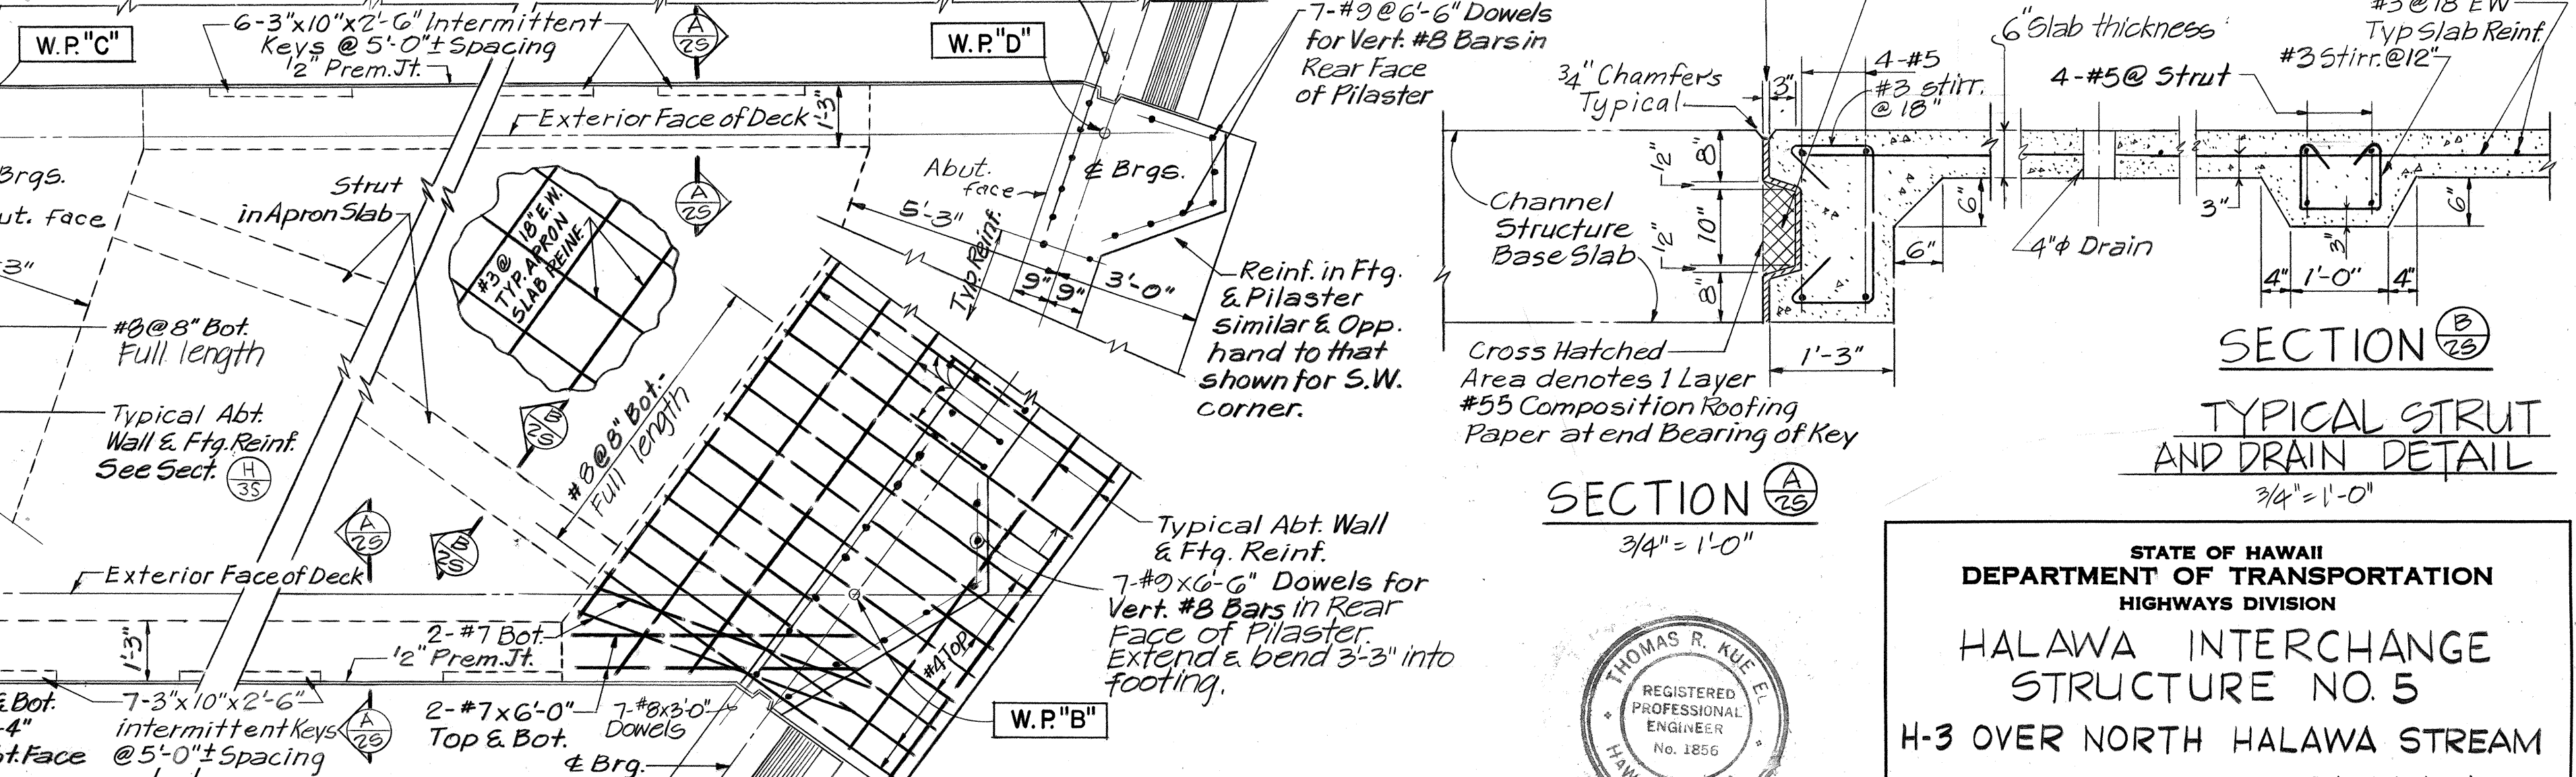


SECTION (A)

TYPICAL STRUT AND DRAIN DETAIL

PART PLAN OF FOOTINGS AT ABUTMENT CORNERS SHOWING JOINT CONNECTION TO CHANNEL STRUCTURE

SCALE: 3/8" = 1'-0"

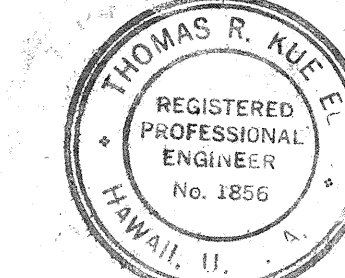


THIS WORK WAS PREPARED BY ME OR UNDER MY SUPERVISION.


Thomas R. Kuehl

STATE OF HAWAII
DEPARTMENT OF TRANSPORTATION
HIGHWAYS DIVISION
HALAWA INTERCHANGE
STRUCTURE NO. 5
H-3 OVER NORTH HALAWA STREAM
FOUNDATION PLAN &
ABUTMENT ELEVATIONS
PROJ. No. I-H-1(89):13 DATE: MAY 1971
SHEET No. 25 OF 55 SHEETS


FED. ROAD DIST. NO.	STATE	FED. AID PROJ. NO.	FISCAL YEAR	SHEET NO.	TOTAL SHEETS
HAWAII	HAW.	I-H-11(89):13	1971	203	362

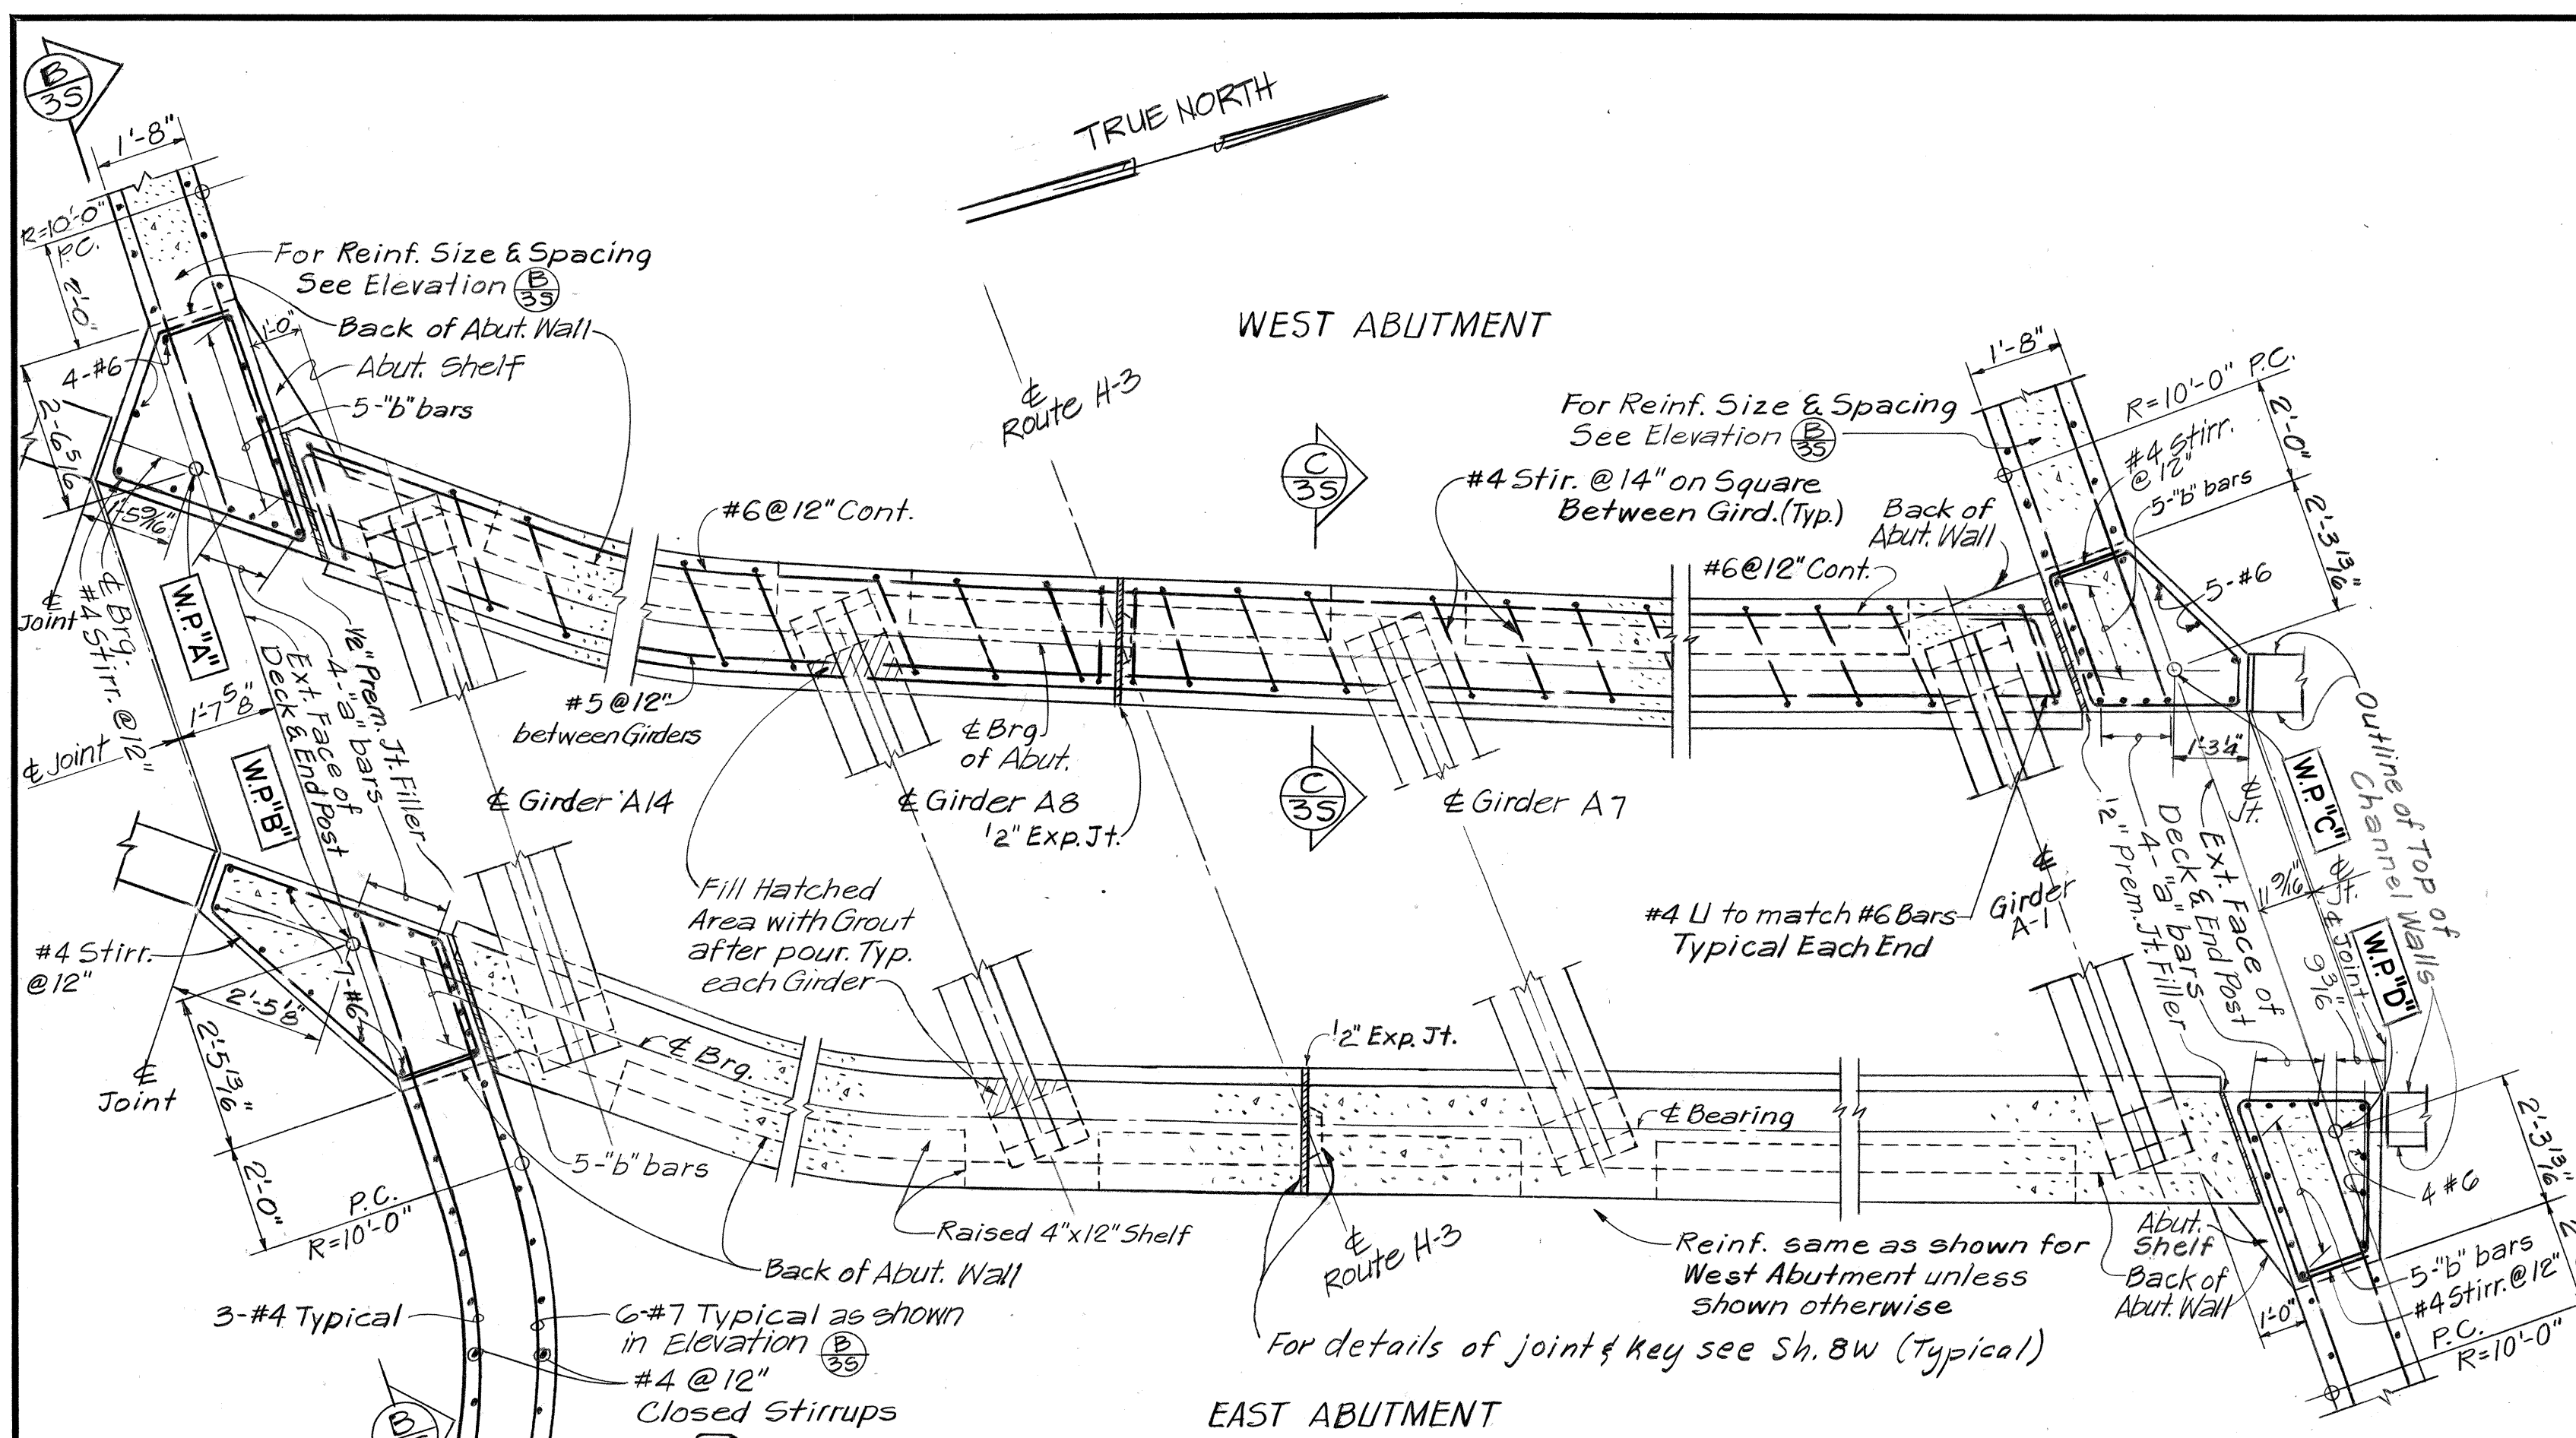


PART ABUTMENT PLAN @ SECTION A-33

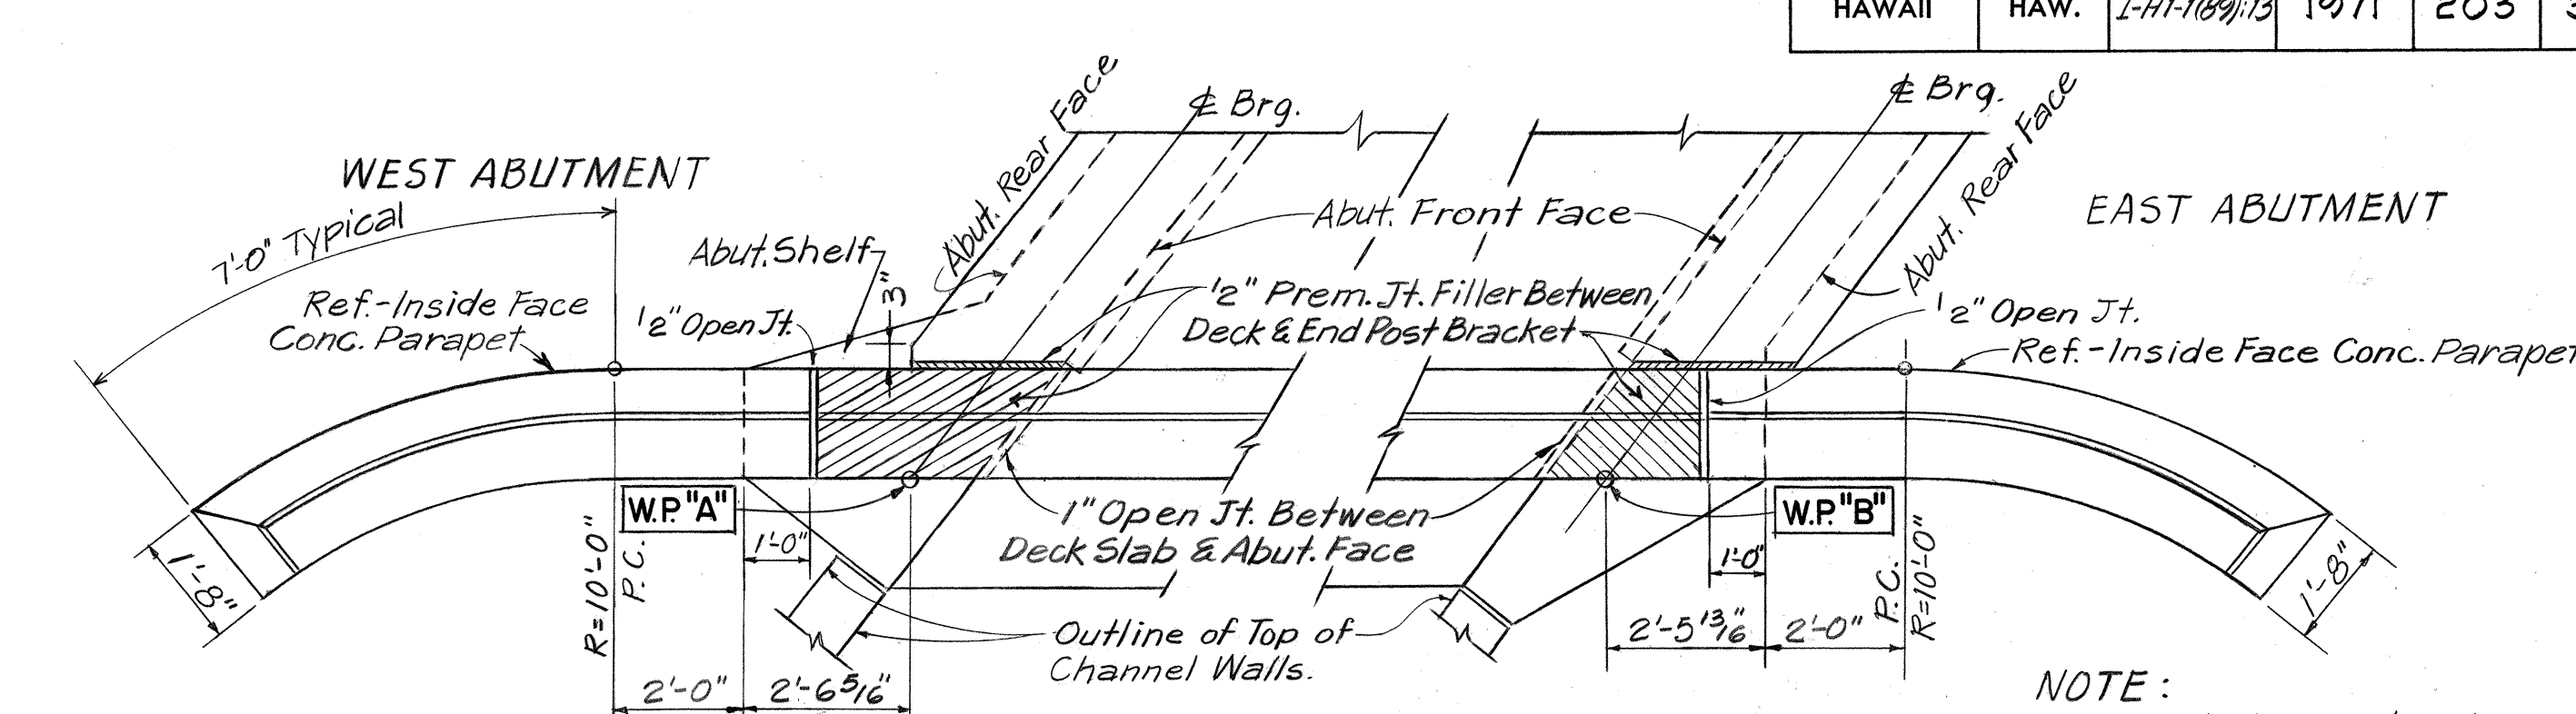


PLAN AT TOP OF END POSTS

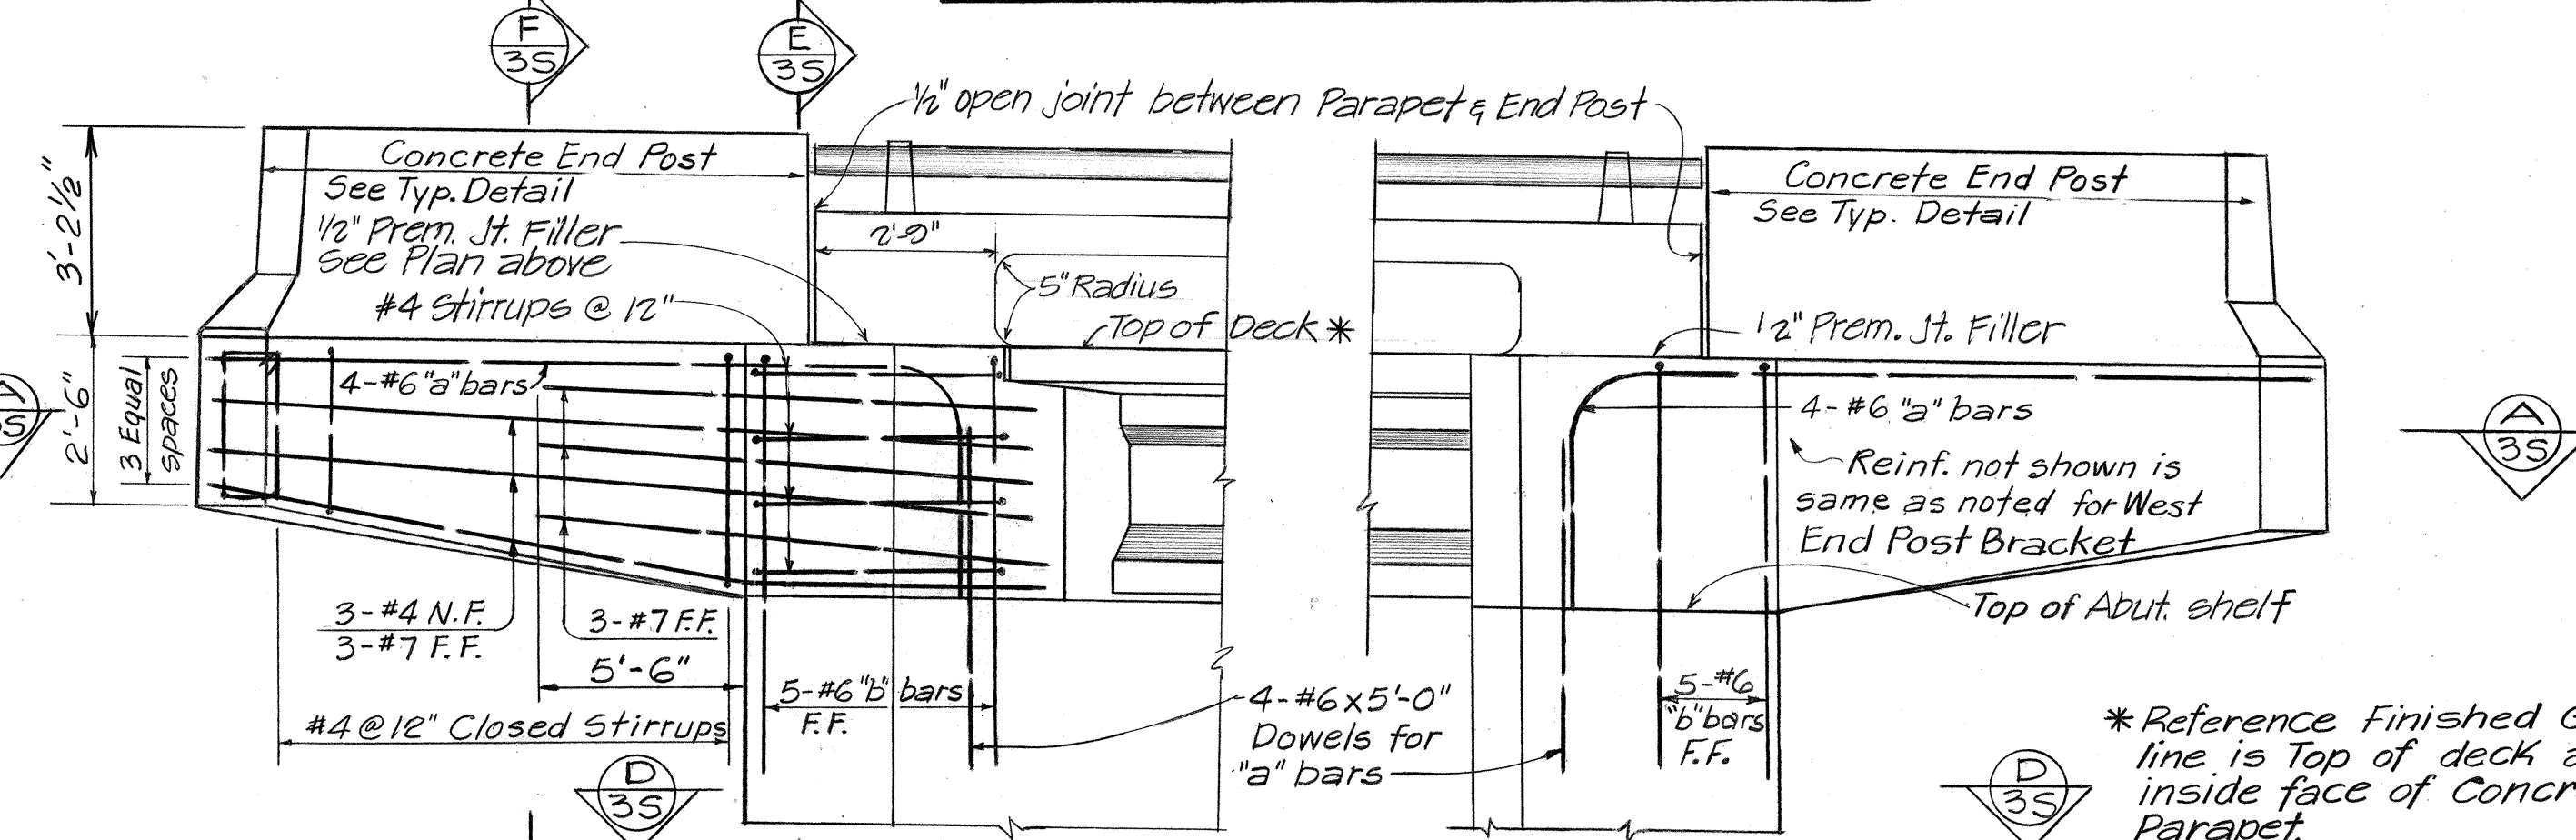


ELEVATION B-33 (SHOWING SOUTH END POST BRACKETS)

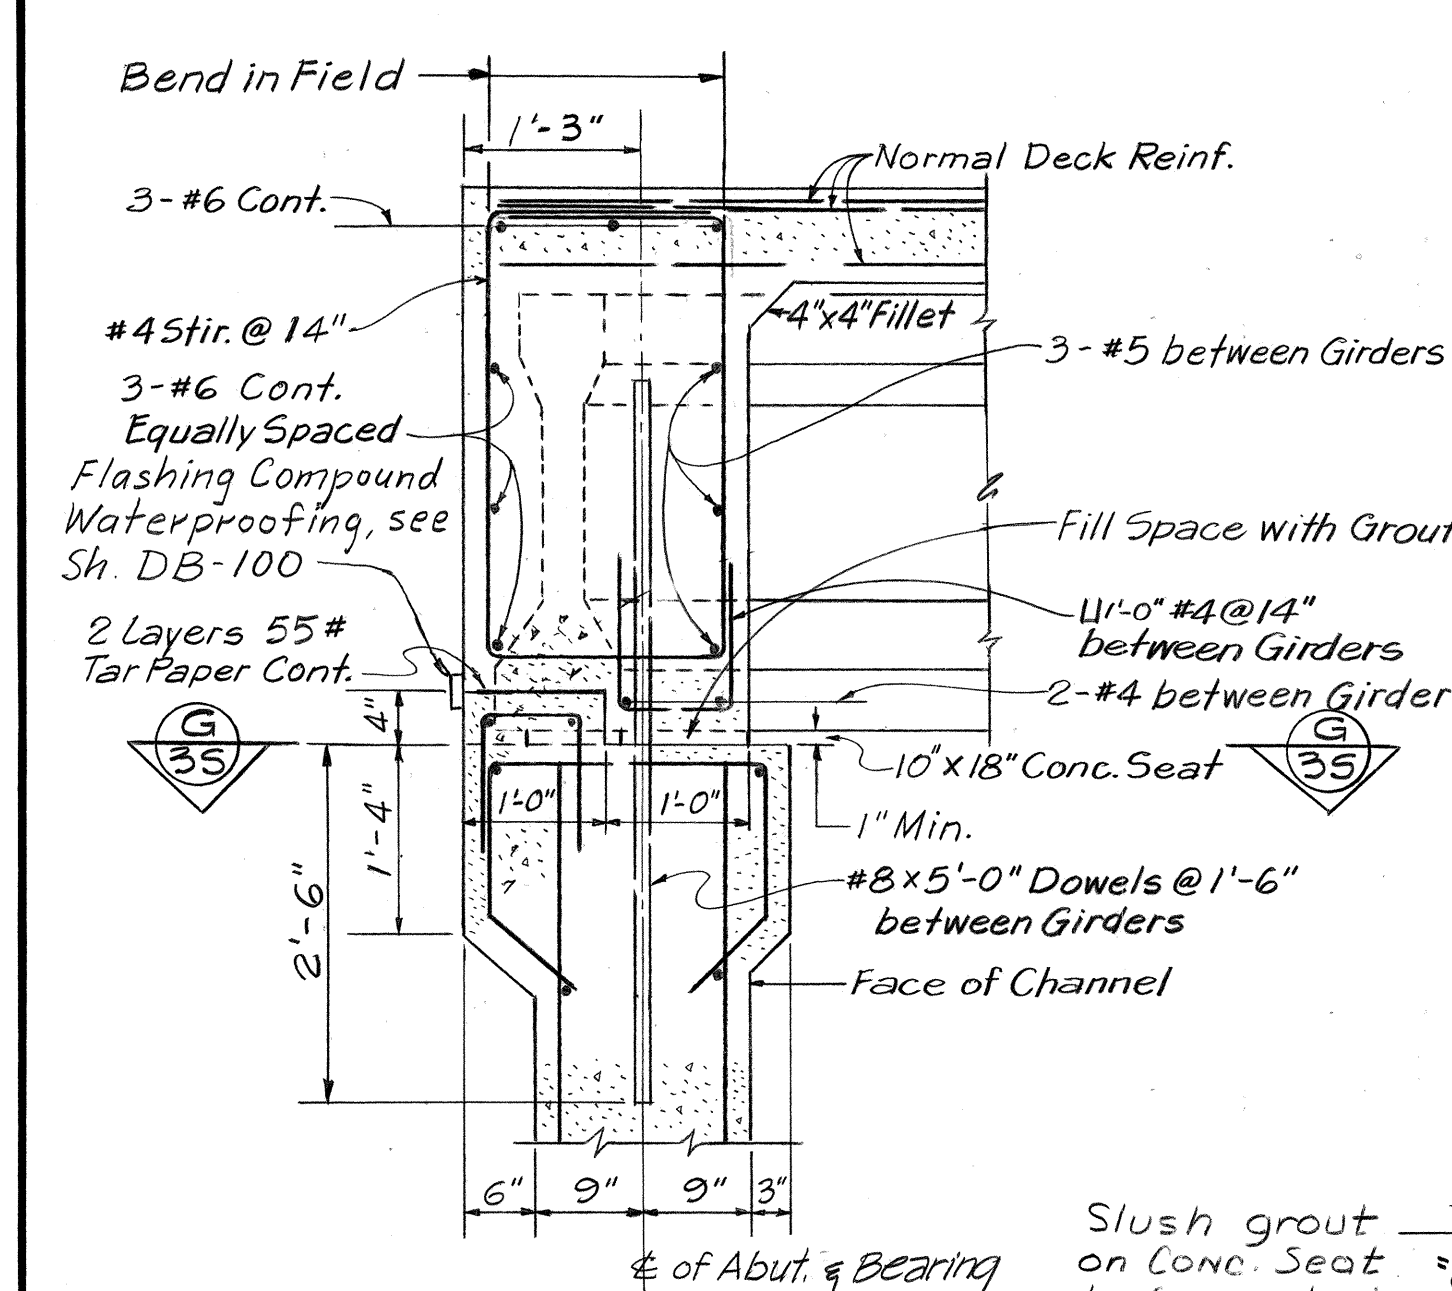


TYPICAL SECTION C-33 (NORMAL OR RADIAL TO ABT. E)
SCALE: 3/4" = 1'-0"

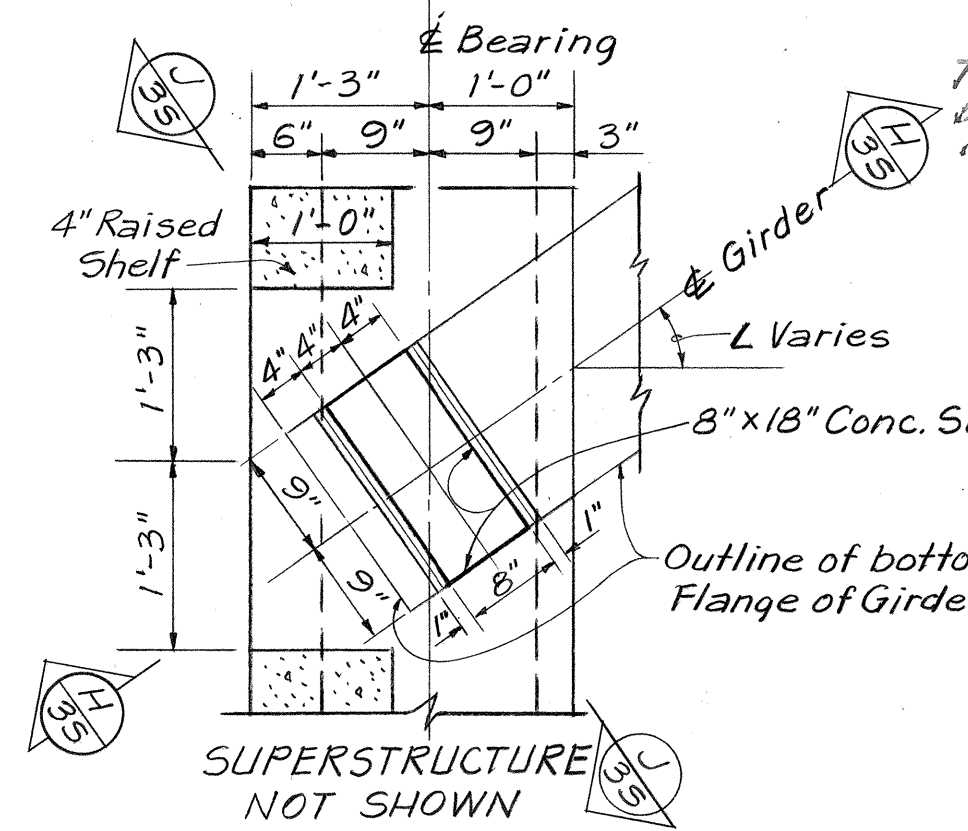

SECTION G-33 TYPICAL GIRDER SEAT
SCALE: 3/4" = 1'-0"

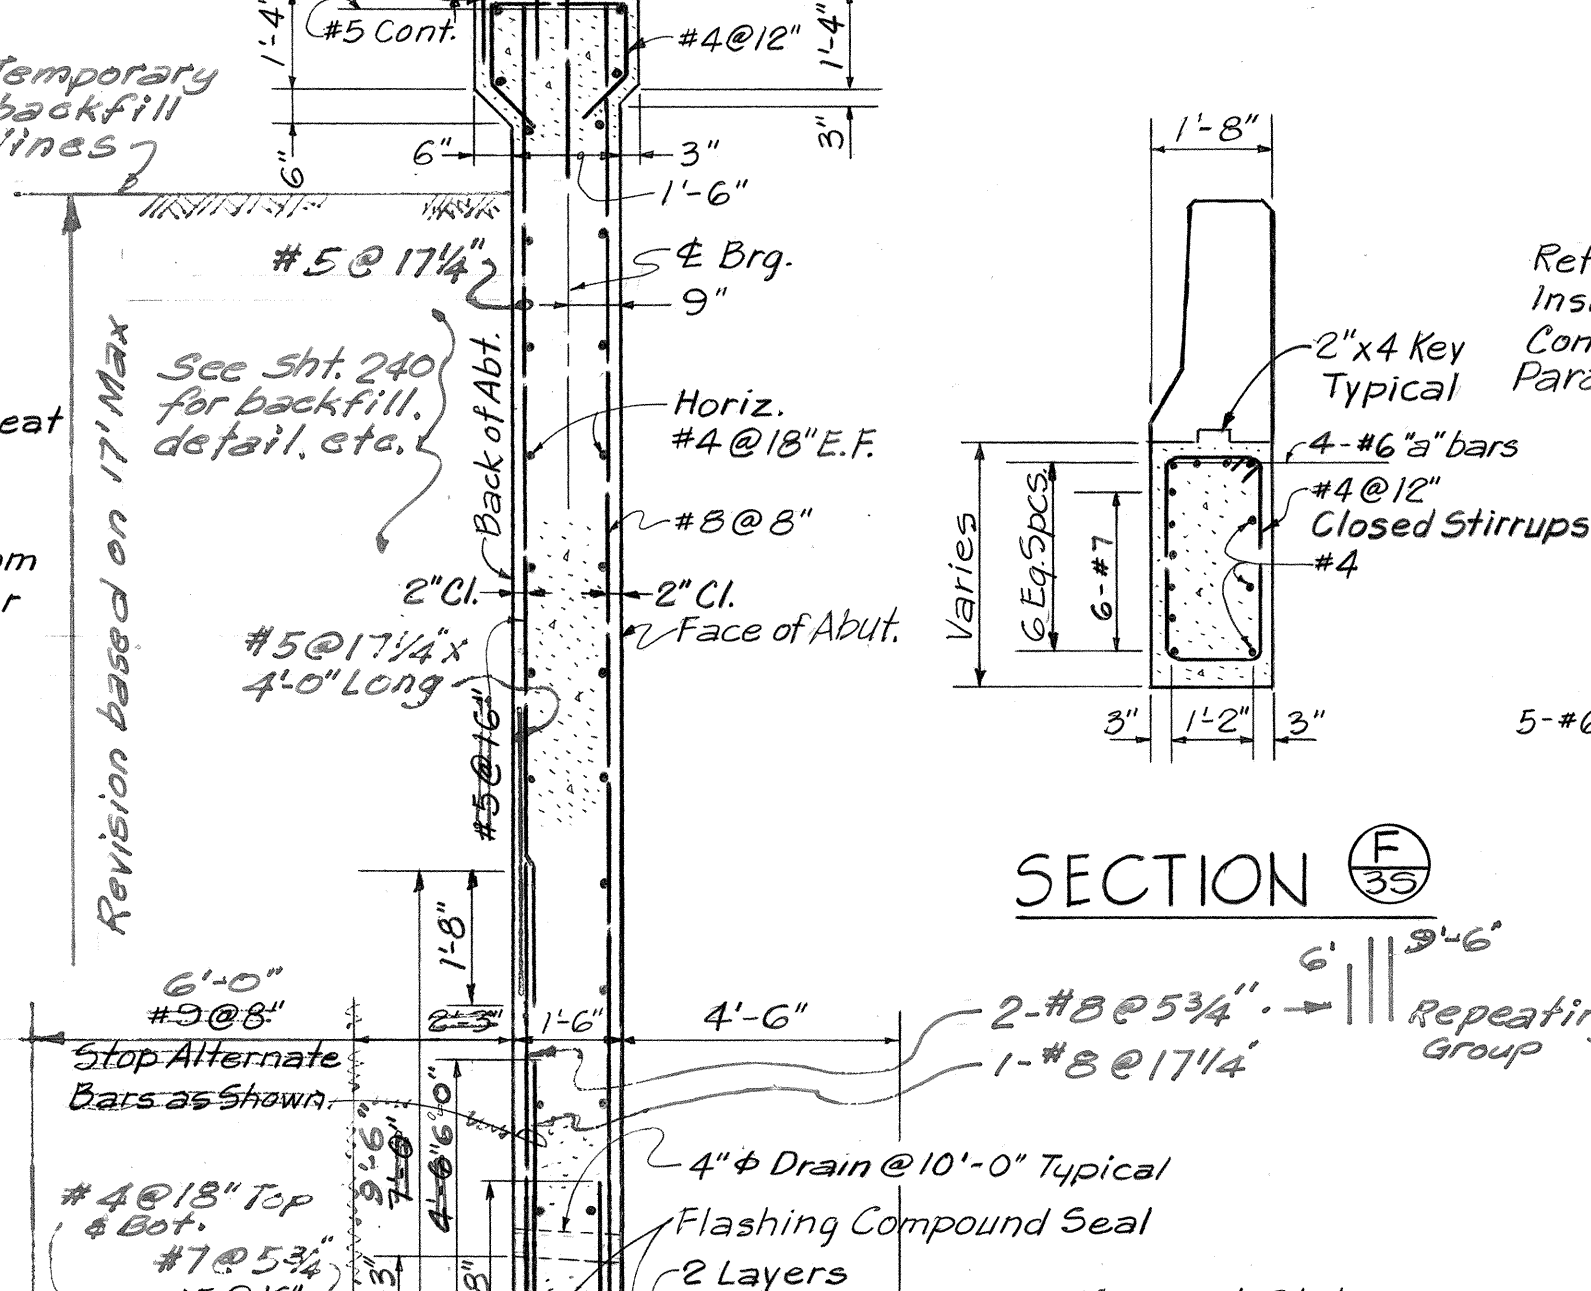


TYPICAL ABUTMENT SECTION (NORMAL OR RADIAL TO ABT. E)
SCALE: 3/4" = 1'-0"

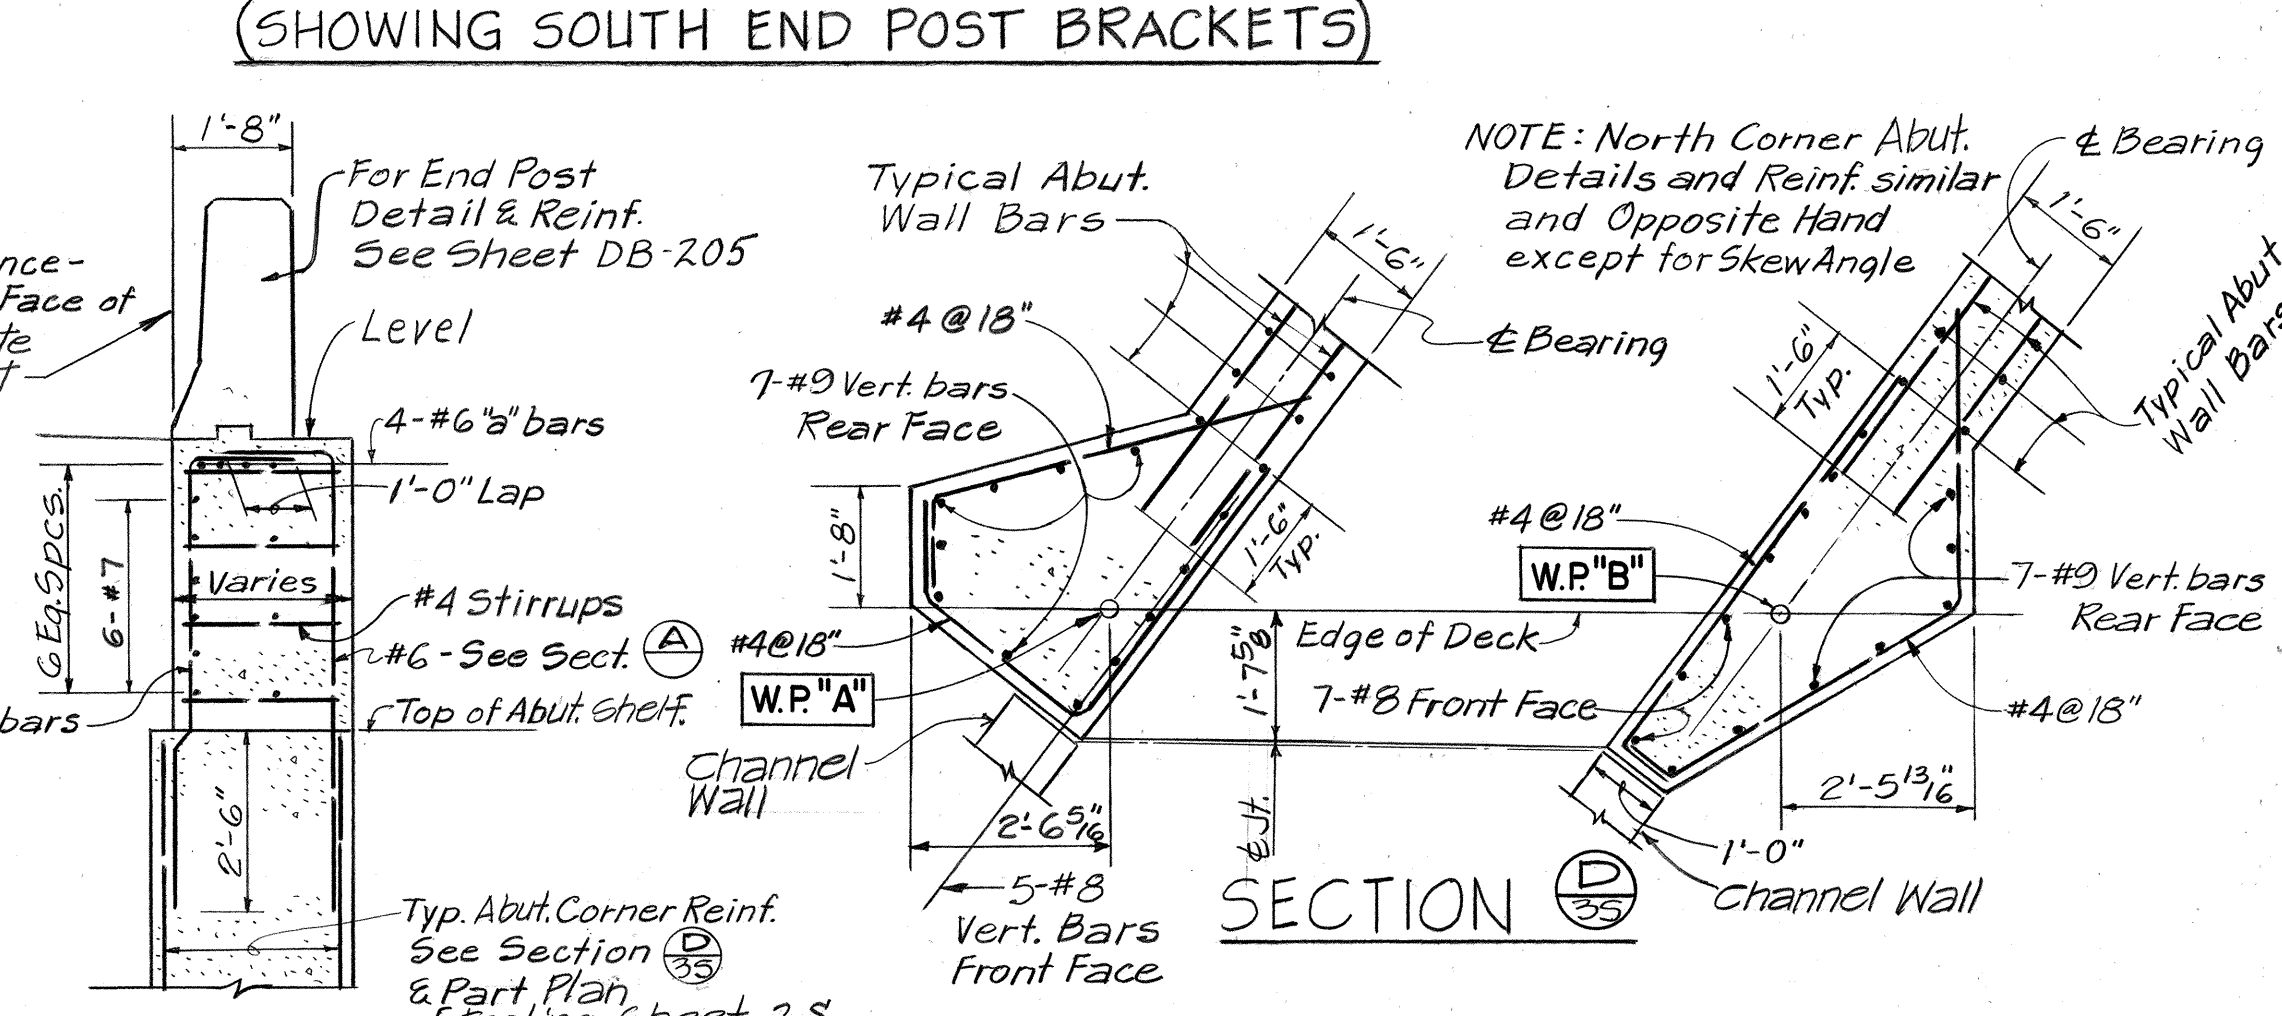

SECTION E-33




- NOTES:
1. Payment for excavation shall be made under the applicable contract item.
 2. Payment for placement of foundation material shall include all incidentals necessary for complete in place construction.
 3. For details not shown, see contract plans.
 4. Excavation and foundation materials beyond the original contract plan dimensions shall be borne by the contractor. (As shown.)

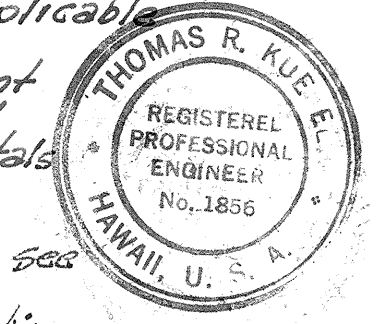

STATE OF HAWAII
DEPARTMENT OF TRANSPORTATION
HIGHWAYS DIVISION
HALAWA INTERCHANGE
STRUCTURE NO. 5
H-3 OVER NORTH HALAWA STREAM
ABUTMENT DETAILS
PROJ. No. I-H-11 (89):13 DATE: MAY 1971
SHEET No. 35 OF 55 SHEETS

DESIGNED BY	DATE
CHECKED BY	
NO.	


See Electrical Plans

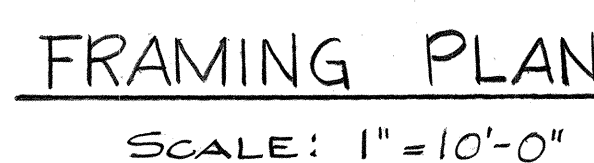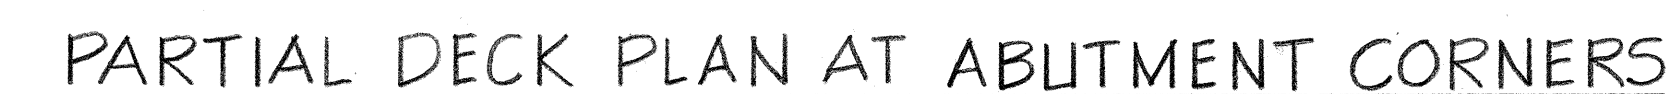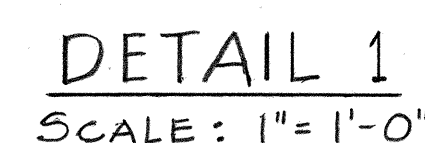

- ① Work point is the intersection of centerline of prestressed beam and centerline of bearings.
- ② For Details of Beams See Sheet 5S

* SW & NE corners of both Inbound and Outbound Roadway Decks.

SCALE : $3/8" = 1'-0"$

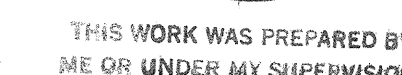

Thomas H. Kane

STATE OF HAWAII
DEPARTMENT OF TRANSPORTATION
HIGHWAYS DIVISION

HALAWA INTERCHANGE
STRUCTURE NO. 5

H-3 OVER NORTH HALAWA STREAM

FRAMING PLAN, BEAM SCHEDULE,
DECK REINF. & DETAILS






PROJ. No. I-H-1-1 (89) 13 DATE: MAY 1971

SHEET No. 45 OF 55 SHEETS

FED. ROAD DIST. NO.	STATE	FED. AID PROJ. NO.	FISCAL YEAR	SHEET NO.	TOTAL SHEETS
HAWAII	HAW.	I-41-1(89)13	1971	205	362

NOTES FOR PRESTRESSED BEAMS

- Pretensioned strands shall be 7 wire $\frac{1}{2}$ " stress-relieved steel strands (Area = 0.153 in²) with an ultimate strength of 270 KSI. See Specifications.
Initial Strand Stress = 189 KSI
Strand Design Stress = 154 KSI
- Non-prestressed reinforcing steel shall have a yield strength of 40 KSI.
- Concrete shall have a 28 day strength of 5500 P.S.I.
- Values of deflection based upon E_{beam} 3,800,000 P.S.I.
- The calculated camber includes the effects of the prestress force and the weight of the beam after removal from bed. See Note 15.
- The dead load deflection includes the combined effects of the weight of slab, haunch and diaphragm and the superimposed dead loads.
- Strands on any one line shall be placed symmetrically about ϕ of beam.
- Strands shall be placed starting on the outside points and shall be uniformly spaced across the beam.
- Final strand patterns shall be submitted to the Engineer for approval.
- Bundling of prestressing reinforcement shall comply with the notes and details shown on this drawing.
- Adjustment of slab haunch for camber shall be determined by the Engineer.
- Lifting devices, as approved by the Engineer shall be placed close to ϕ bearings. Location to be approved by the Engineer. In no case is a stirrup to be used as a lifting device.
- See Framing Plans for layout, type, mark numbers, and length of individual girders. See Framing Plan for locations of diaphragms.
- There shall be no change in the structural capacity of the prestressed girders as shown on the plans.
- Camber values shown in Tables assume no losses or any camber growth of the beam.

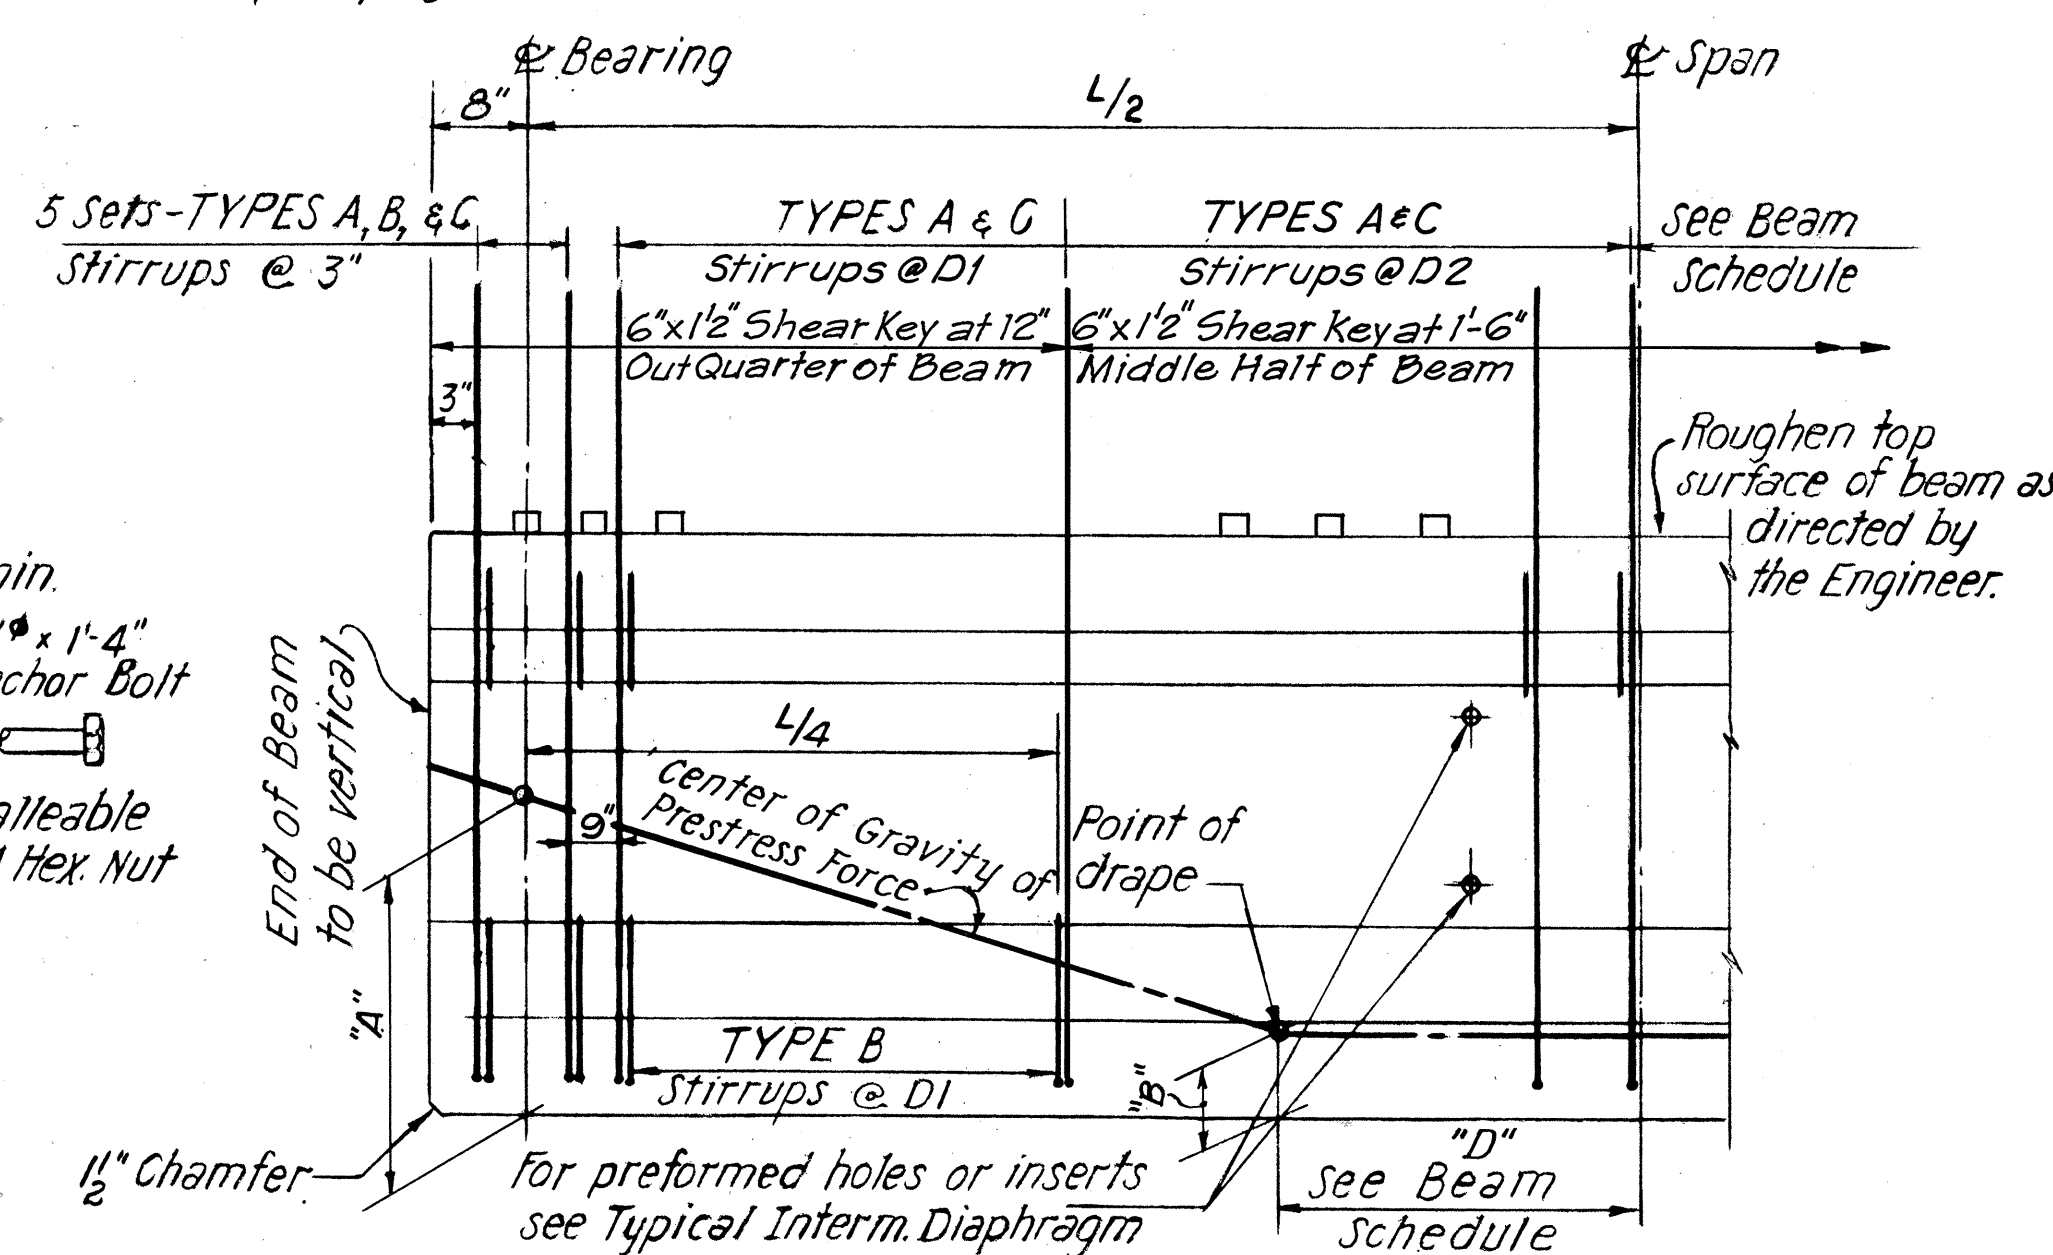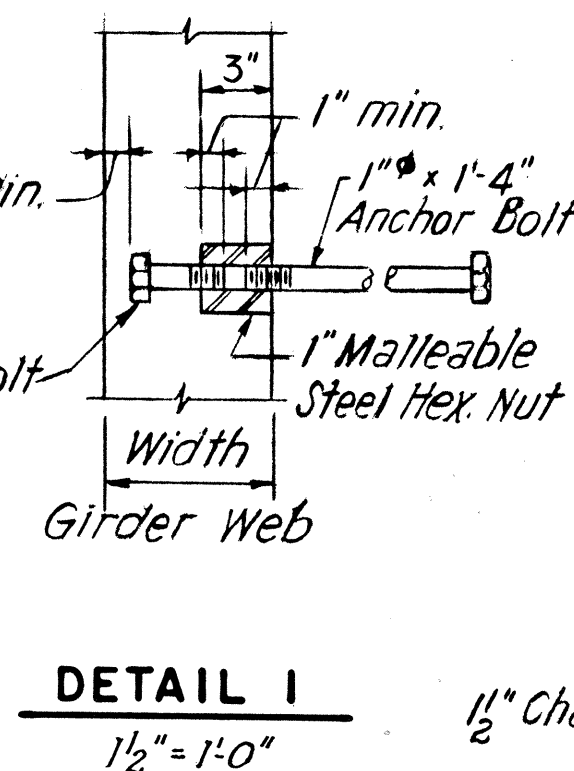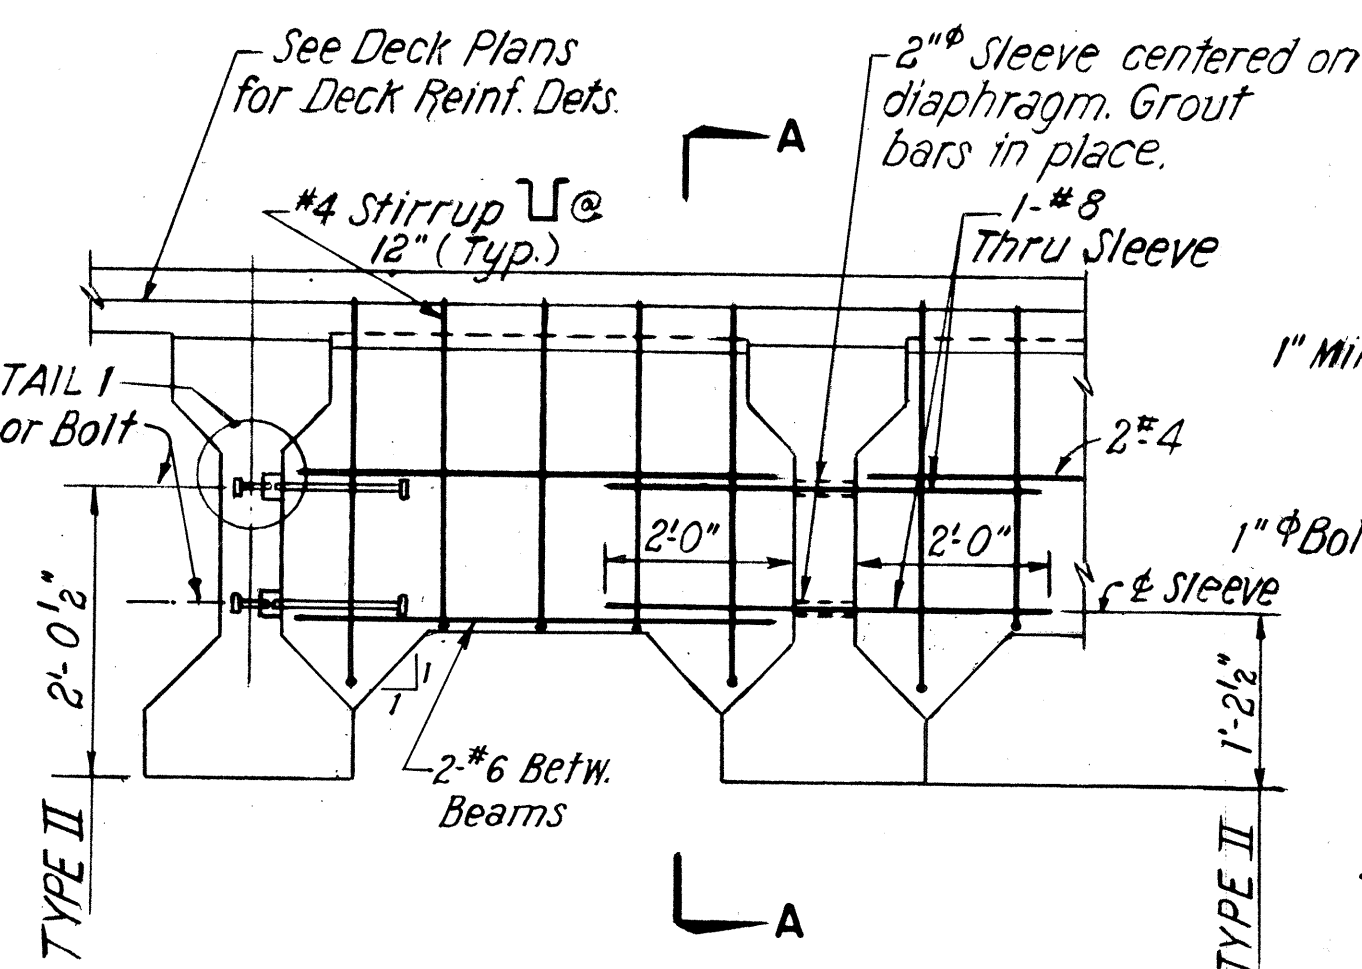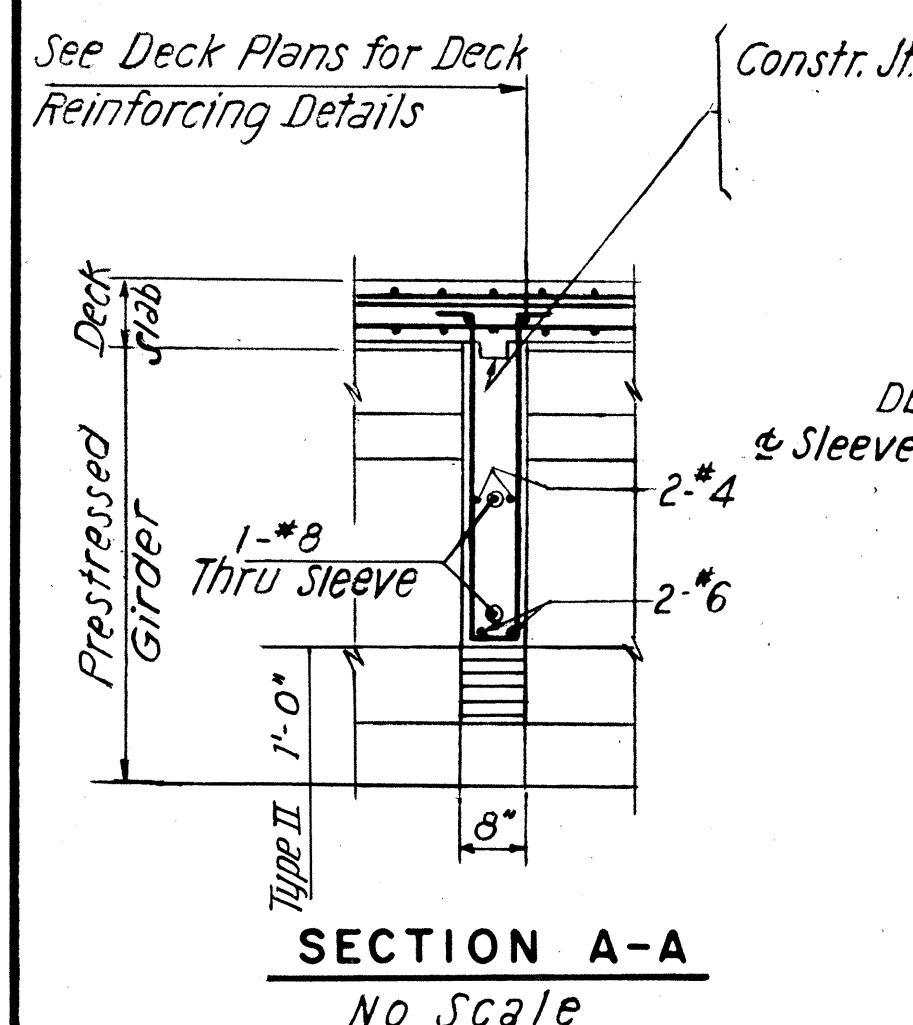
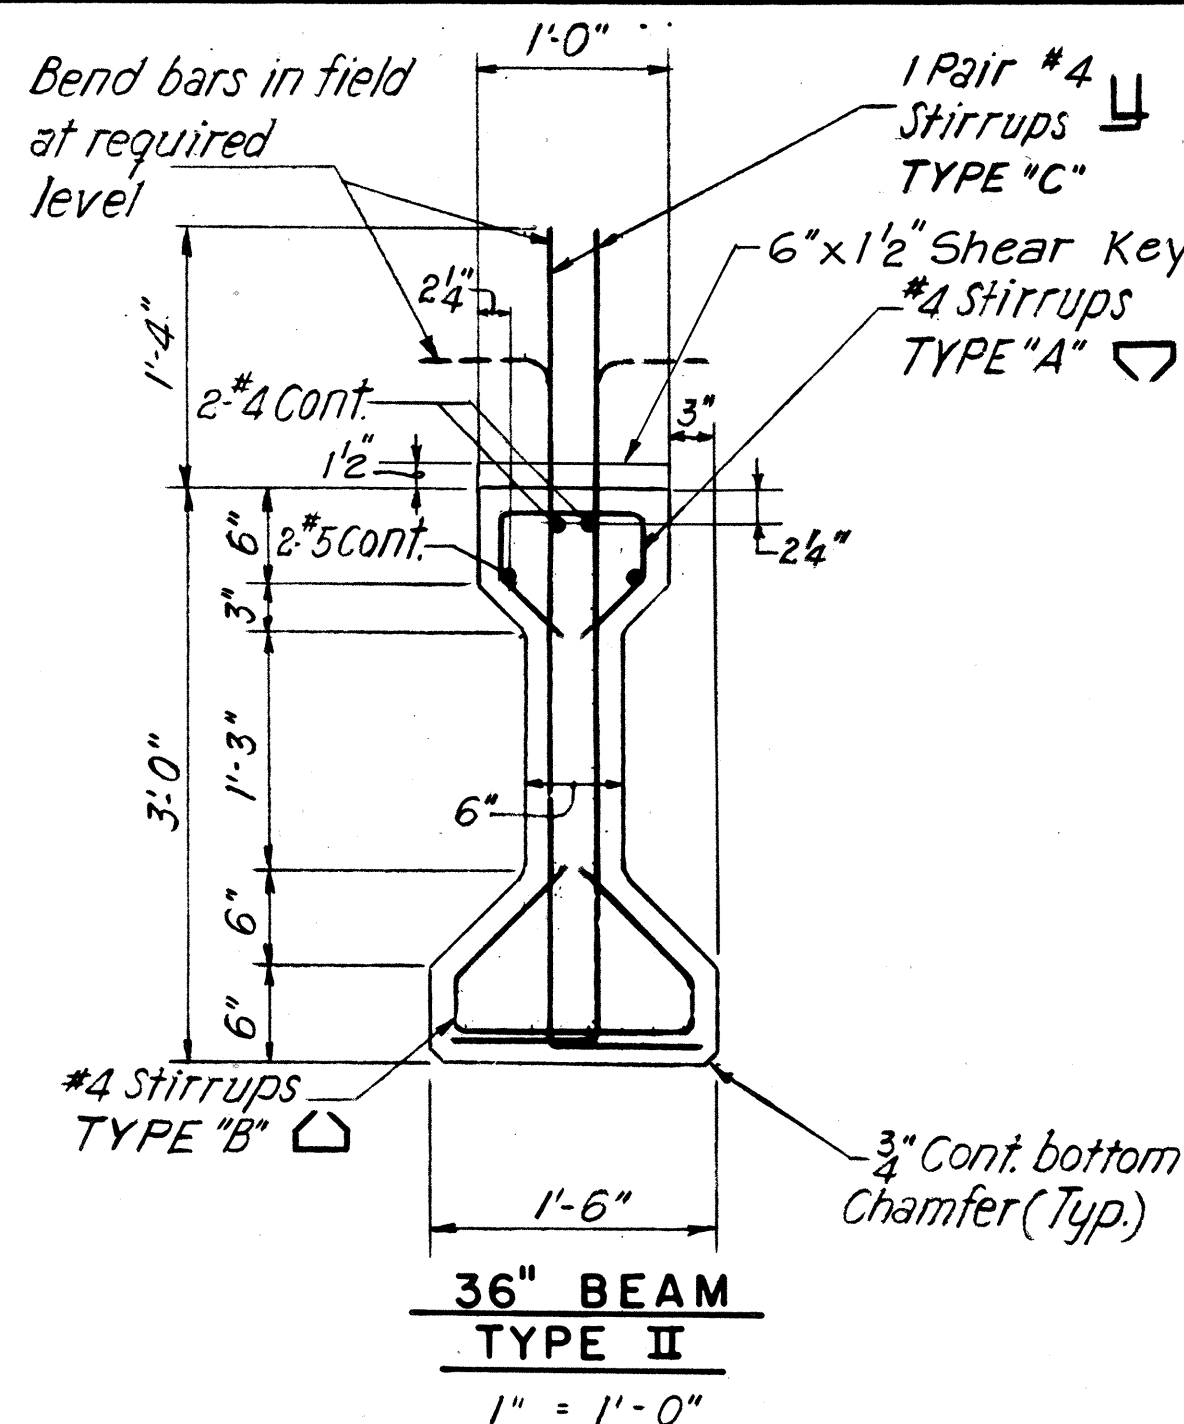


BEAM SCHEDULE

BEAM TYPE	WORKING FORCE P.F. (KIPS)	CALC. CAMBER (INCHES) (SEE NOTE 5)	DEAD LOAD DEFLECTION (IN.) (SEE NOTE 6)	LOCATION OF CENTER OF GRAVITY OF PRESTRESS FORCE			STIRRUPS TYPE "A" & "C"	NO. OF STIRRUPS AT SPCG. DI	SPCG. D2	REQUIRED MIN. ULTIMATE CONG. STRENGTH BEFORE RELEASE OF STRANDS (P.S.I.)	REMARKS
				DIST. TO PT. OF DRAPE "D"	DIST. "A" (IN)	DIST. "B" (IN)					
II A	353	7.16"	5.16"	6'-8"	9.98"	5.63"	12 @ 9"	18"	4000	1 1/2" x 6" Key Req'd.	
II B	424	5.8"	7.16"	7'-4"	9.98"	5.81"	14 @ 9"	18"	4000	1 1/2" x 6" Key Req'd.	

BUNDLING OF PRESTRESSING REINFORCEMENT

ARRANGEMENT AND CLEARANCE FOR POST TENSIONED UNITS	ARRANGEMENT AND CLEARANCE FOR PRETENSIONED STRANDS
- Horizontal clearance between units equals 2" min. - Units may be bundled vertically in groups of 3 maximum. - Vertical clearance between bundled units equals 3" min. - Approval of the Engineer is required for deviation.	- Strands may be bundled in groups as shown or in groups consisting of a maximum of 6 strands and separated at the ends. - The minimum distance "S" between groups or individual strands is 2" for 1/2" strands. "S" is measured between centers of adjacent strands. - Approval of the Engineer is required for deviation.

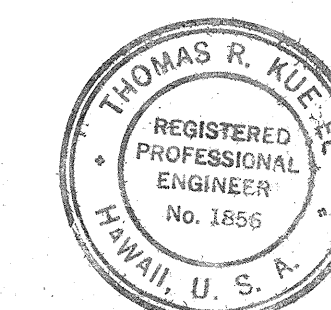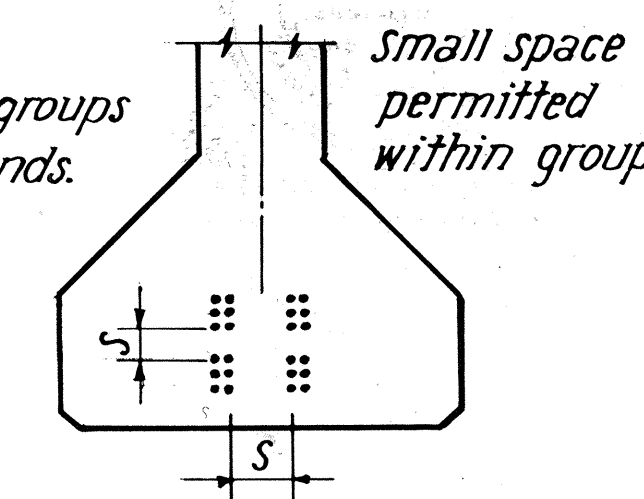

THIS WORK WAS PREPARED BY ME OR UNDER MY SUPERVISION.

Thomas R. Kuehl

STATE OF HAWAII
DEPARTMENT OF TRANSPORTATION
HIGHWAYS DIVISION

HALAWA INTERCHANGE
STRUCTURE NO. 5
H-3 OVER NORTH HALAWA STREAM
PRESTRESSED BEAMS
PROJ. No. I-41-1(89)13 DATE: MAY 1971
SHEET No. 55 OF 55 SHEETS