


| INDEX TO DRAWINGS  |                                               |
|--------------------|-----------------------------------------------|
| SHEET NO.          | DESCRIPTION                                   |
| 1                  | TITLE SHEET                                   |
| 2                  | GENERAL PLAN                                  |
| 3-5                | TYPICAL SECTIONS                              |
| 6-10               | ALIGNMENT PLANS                               |
| 11-19              | ROADWAY PROFILES AND SUPER-ELEVATION DIAGRAMS |
| 20-21              | RAMP TERMINAL DETAILS                         |
| 22-43              | ROADWAY CONSTRUCTION PLANS AND DETAILS        |
| 44-62*             | DRAINAGE PLANS AND DETAILS                    |
| 63-69              | BORING LOCATION PLAN AND BORING LOGS          |
| 70-89 <sup>A</sup> | SIGNING PLANS AND DETAILS                     |
| 90-101             | HIGHWAY LIGHTING AND ELECTRICAL               |
| 102-105            | UTILITY PLANS AND DETAILS                     |
| 106-129            | STRUCTURE NO. 3                               |
| 130-143            | STRUCTURE NO. 3A                              |
| 144-145            | SWE RAMP RETAINING WALL                       |
| 146-166            | STRUCTURE NO. 6                               |
| 167-177            | STRUCTURE NO. 8                               |
| 178-187            | STRUCTURE NO. 9                               |
| 188-197            | STRUCTURE NO. 12                              |
| 198-203            | STANDARD DETAILS (BRIDGE)                     |
| 204-211            | TYPICAL DETAILS (BRIDGE)                      |
| 212-225            | CROSS SECTION KEY AND CROSS SECTIONS          |
| 226-228            | SOIL STABILIZATION AREA                       |

STATE OF HAWAII  
DEPARTMENT OF TRANSPORTATION  
HIGHWAYS DIVISION  
HONOLULU, HAWAII  
"AS BUILT"  
PLANS FOR  
CONSTRUCTION OF A PORTION OF  
INTERSTATE ROUTE H-1  
HALAWA INTERCHANGE  
MOANALUA ROAD TO SALT LAKE BOULEVARD  
FEDERAL AID INTERSTATE PROJECT NO. I-HI-1(91):13

DISTRICT OF EWA  
ISLAND OF OAHU

**SCALES:**

PLANS ..... 1" = 50'  
PROFILES ..... HOR. 1" = 50'  
VER. 1" = 10'  
DETAIL ROADWAY PLANS ..... 1" = 50'  
CROSS SECTIONS ..... HOR. 1" = 10'  
VER. 1" = 10'

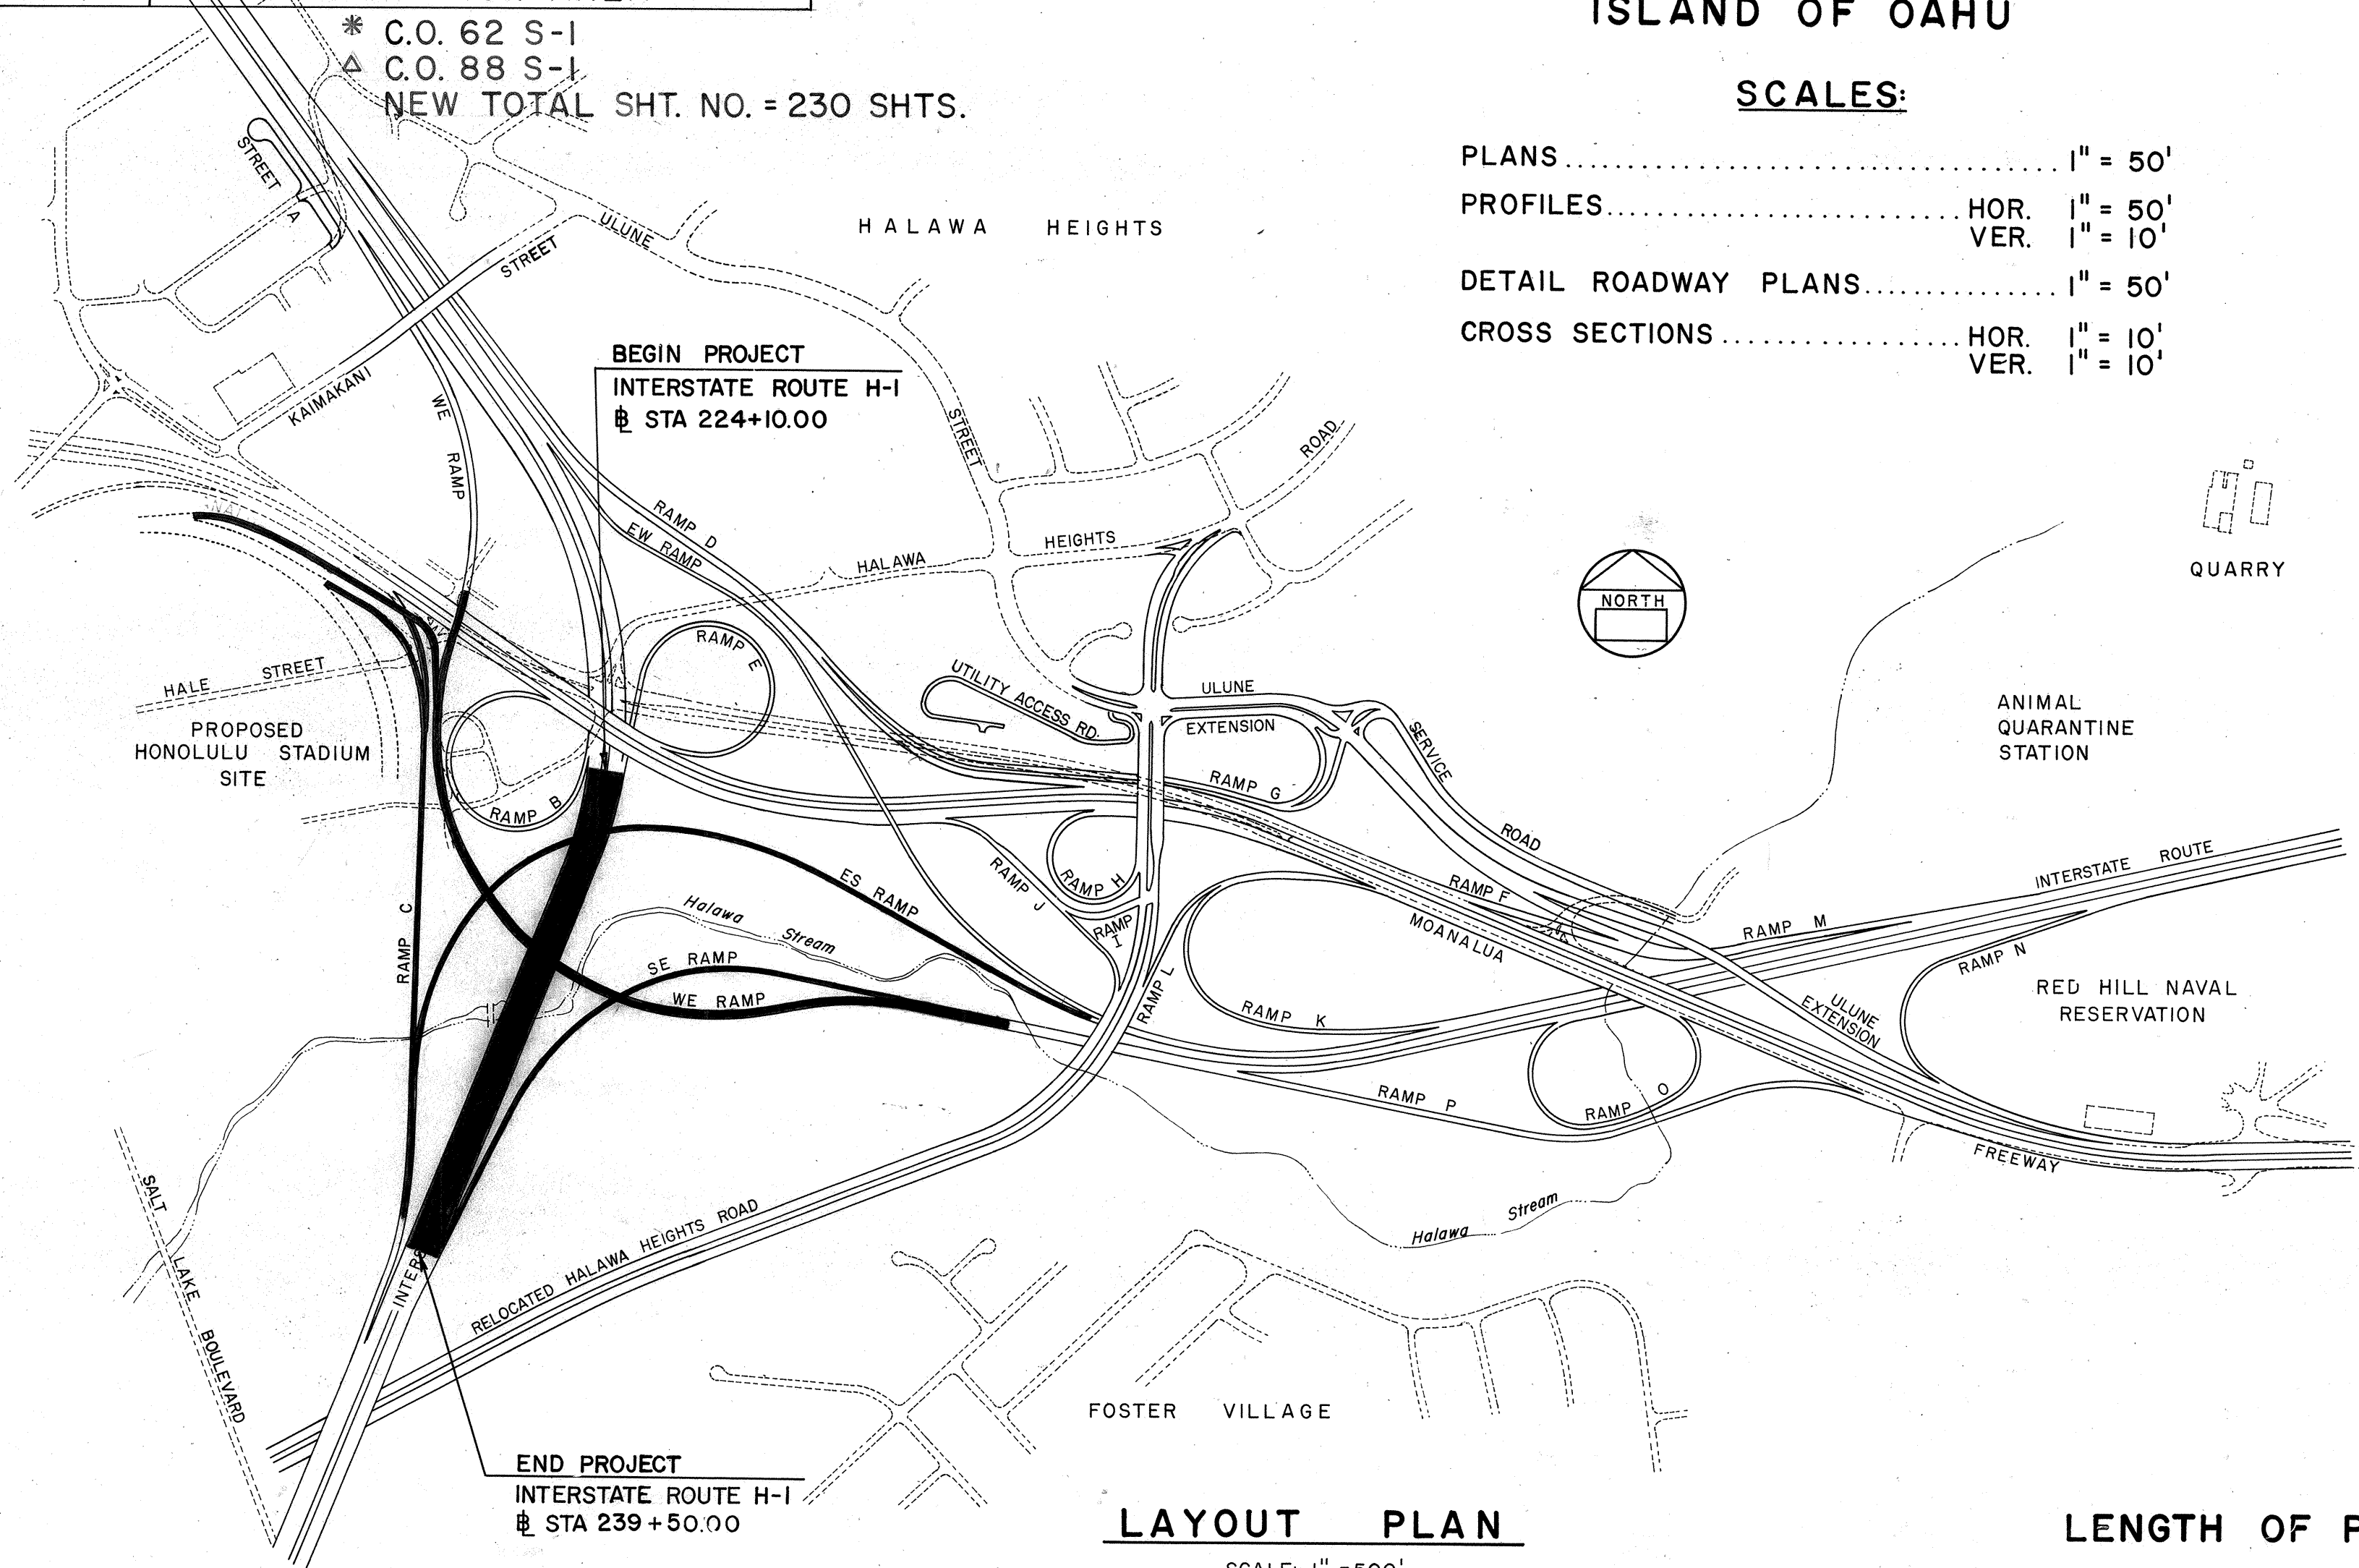


**LAYOUT PLAN**

SCALE: 1" = 500'

LENGTH OF PROJECT.....0.301 MILES

| FED. ROAD DIST. NO. | STATE | FED. AID PROJ. NO. | FISCAL YEAR | SHEET NO. | TOTAL SHEETS |
|---------------------|-------|--------------------|-------------|-----------|--------------|
| HAWAII              | HAW.  | I-HI-1(91):13      | 1972        | 1         | 228          |

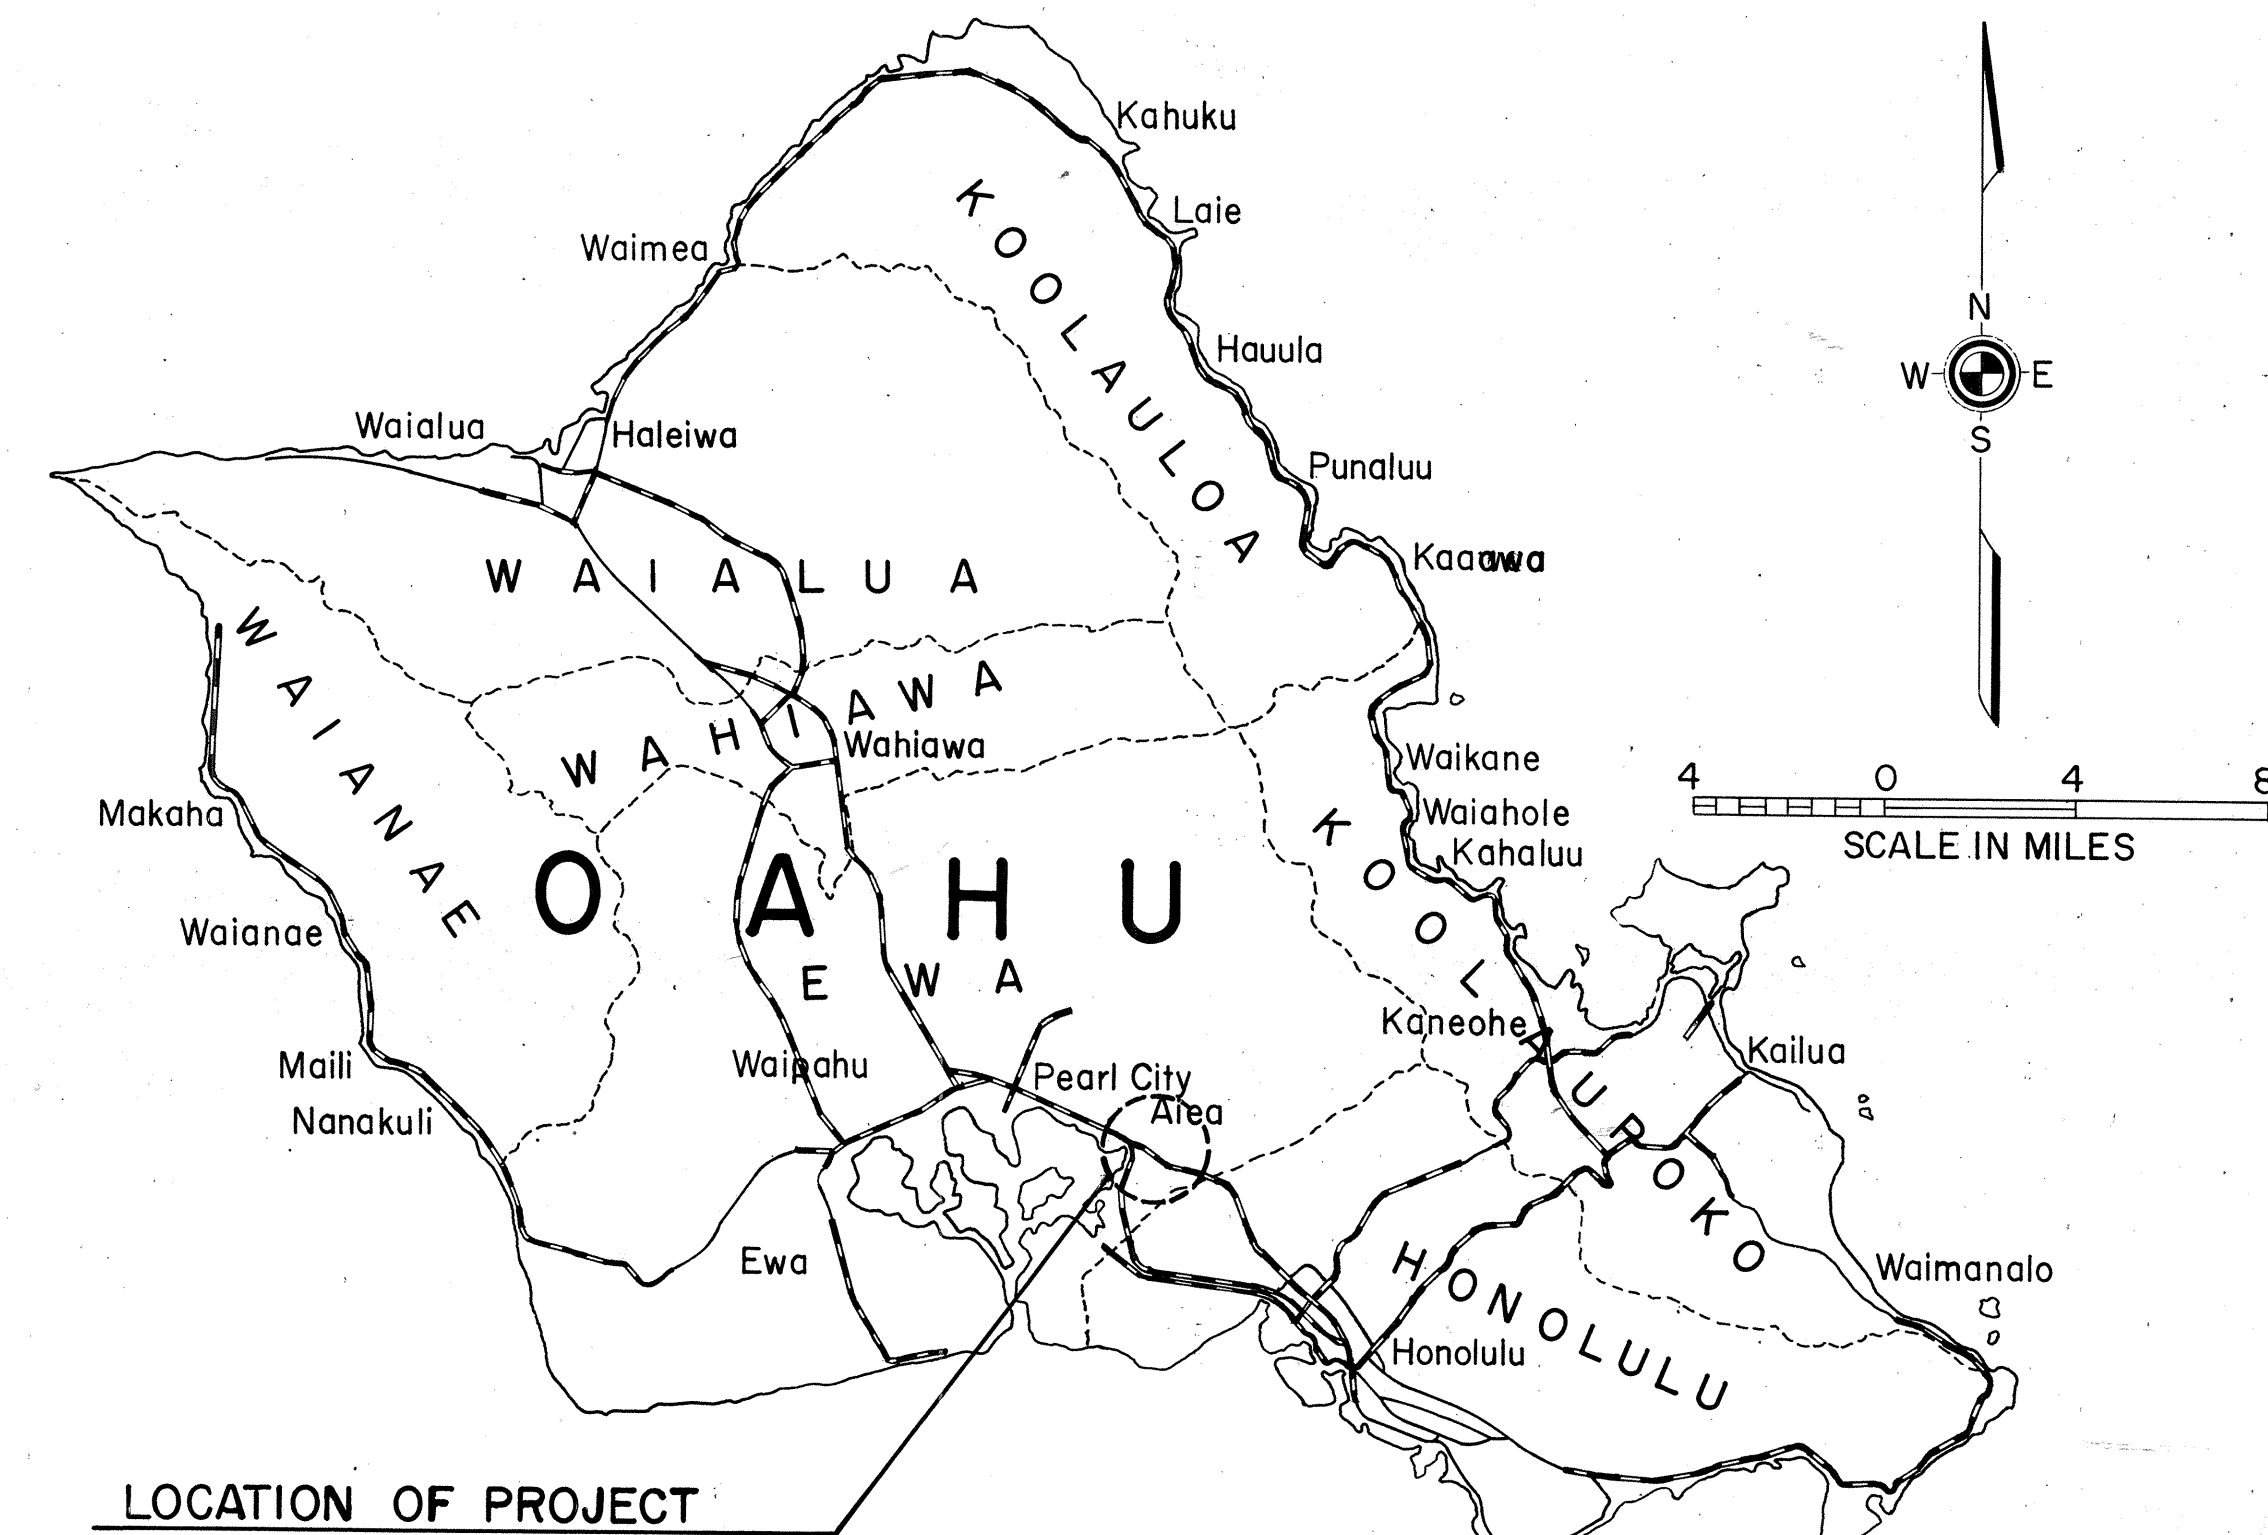

LOCATION OF PROJECT

**NOTE:**

ALL CHANGES MADE DURING CONSTRUCTION HAVE BEEN INCORPORATED ON THESE PLANS IN RED EXCEPT CHANGES IN THE ORIGINAL THEORETICAL QUANTITIES. FOR ACTUAL QUANTITIES, REFER TO PROJECT LEDGER AND/OR COMPUTATION BOOK.

**DESIGN CLASSIFICATION**

DESIGN ADT (1990)..... 56,704  
DHV..... 5,858  
D..... 60/40  
T..... 5%  
V..... 60 MPH

*Spind Spind*  
PROJECT ENGINEER

Apr. 22, 1977  
DATE

DEPARTMENT OF TRANSPORTATION  
FEDERAL HIGHWAY ADMINISTRATION  
APPROVED: *[Signature]*  
DIVISION ENGINEER DATE 4-25-72

DEPARTMENT OF TRANSPORTATION  
STATE OF HAWAII  
APPROVED: *[Signature]*  
FOR DIR. OF TRANSPORTATION DATE 4/5/72

D. Lee June, 1971