

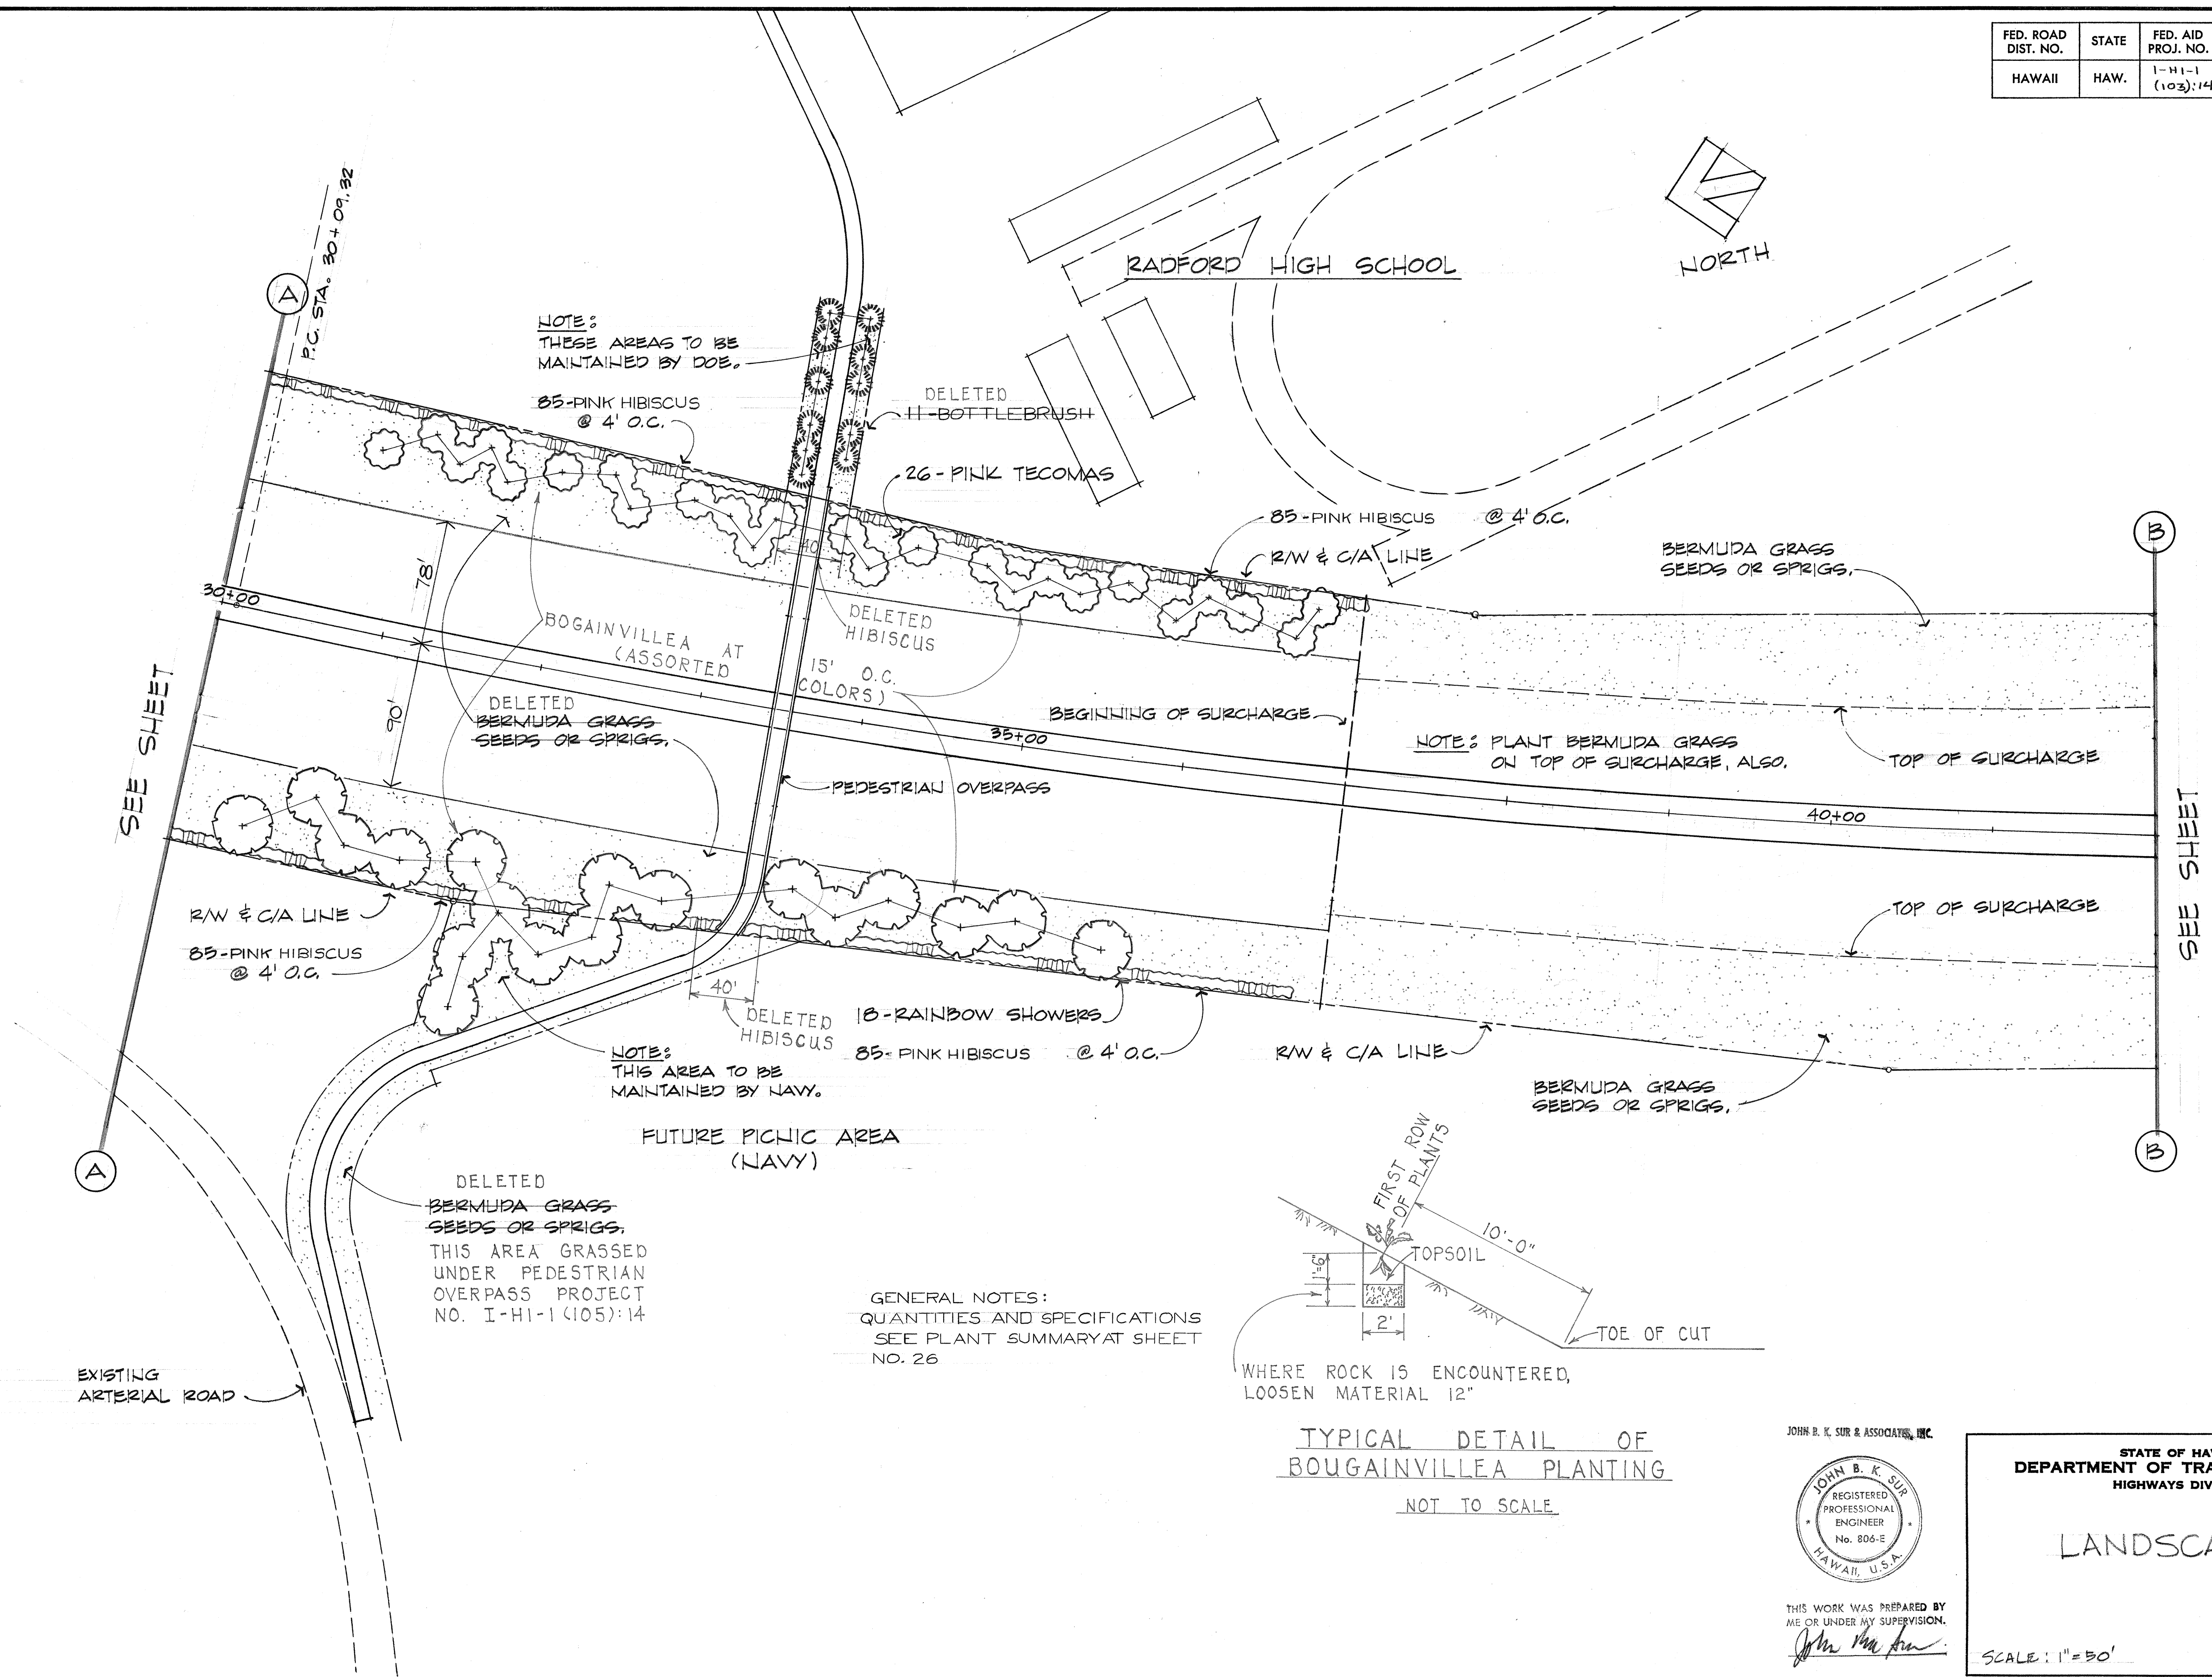


FED. ROAD DIST. NO.	STATE	FED. AID PROJ. NO.	FISCAL YEAR	SHEET NO.	TOTAL SHEETS
HAWAII	HAW.	1-H-1-1 (103):14	1972	27	46

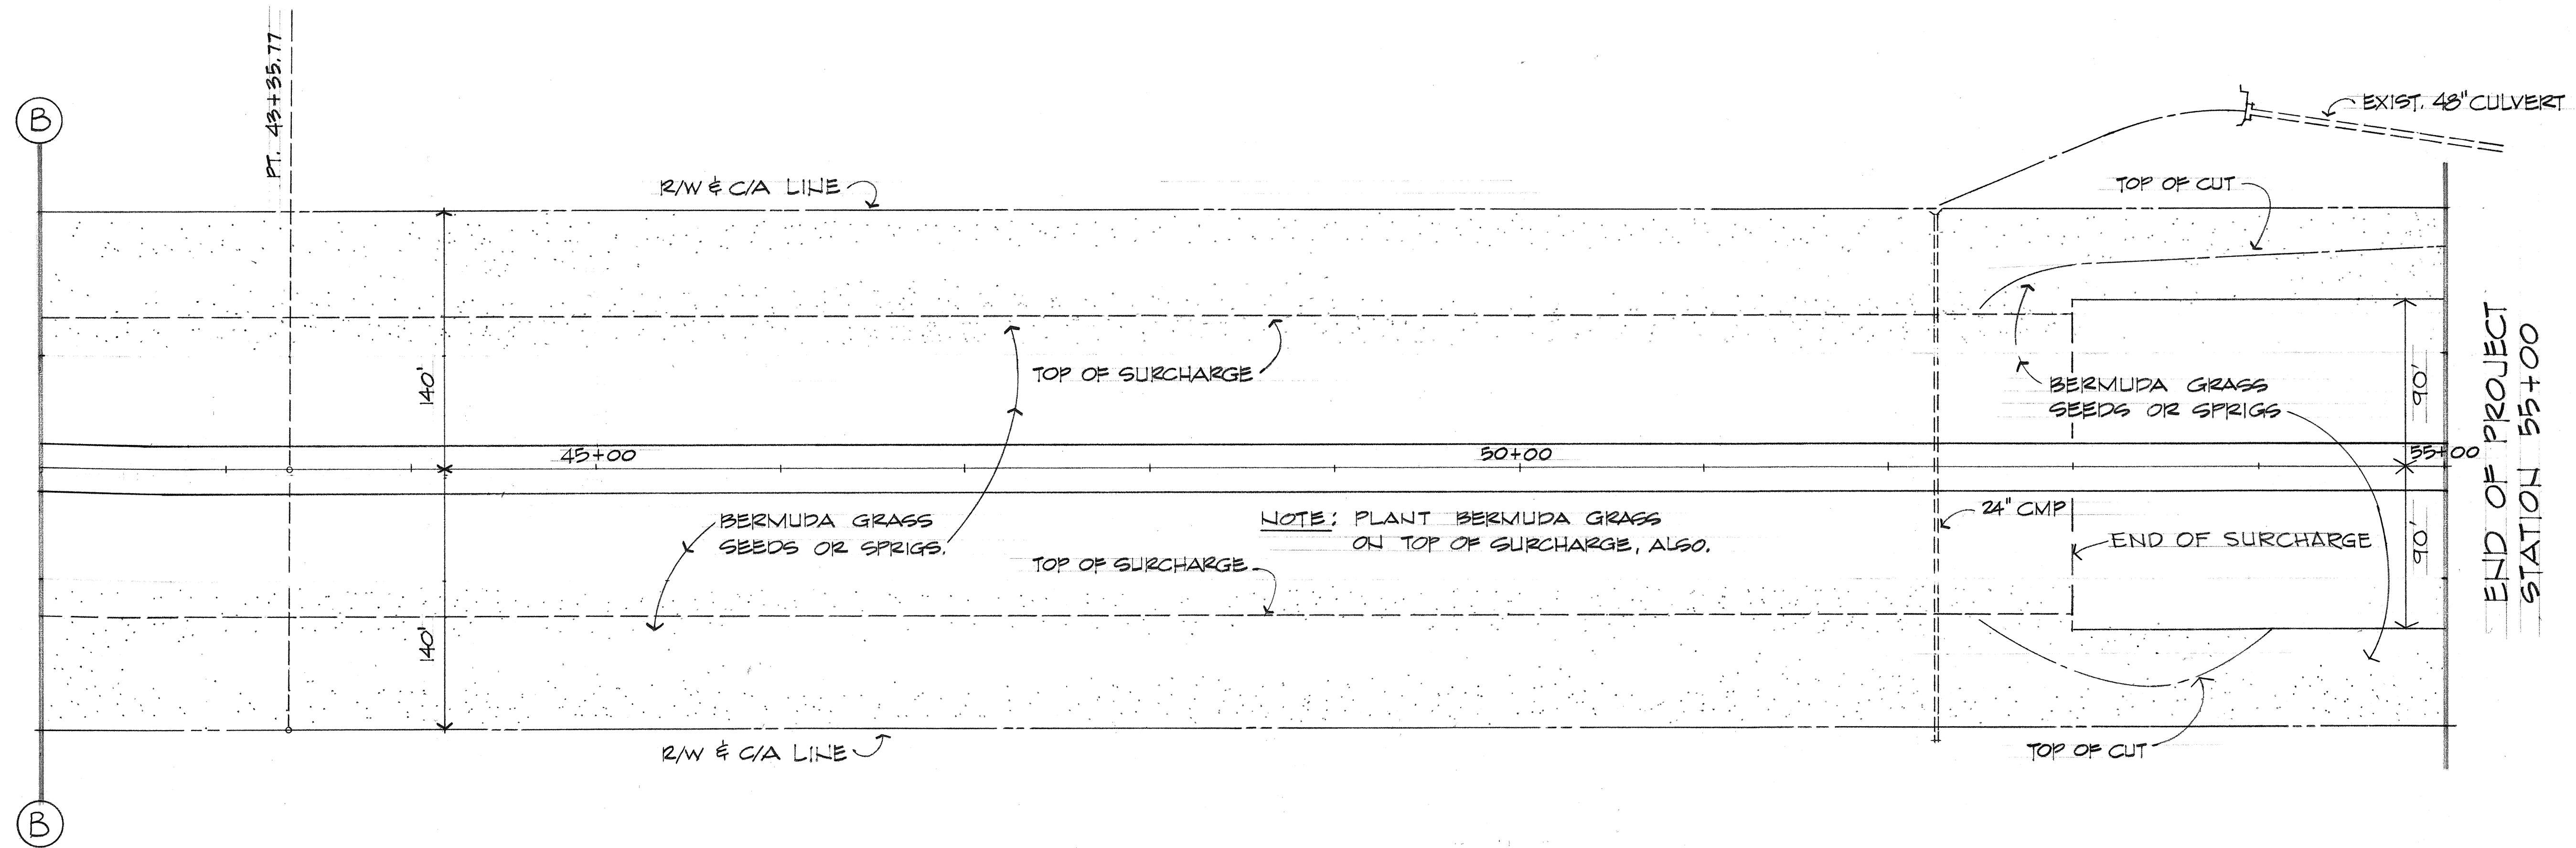

SURVEY PLOTTED BY	DATE
DRAWN BY	
DESIGNED BY	
QUANTITIES BY	
CHECKED BY	
ORIGINAL PLAN	
NOTE BOOK	
No.	

FED. ROAD DIST. NO.	STATE	FED. AID PROJ. NO.	FISCAL YEAR	SHEET NO.	TOTAL SHEETS
HAWAII	HAW.	1-41-1 (103)14	1972	28	46

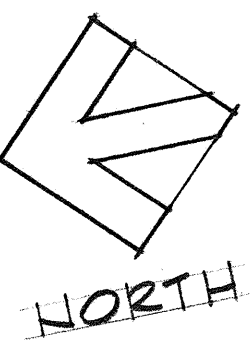

GENERAL NOTES:
QUANTITIES AND SPECIFICATIONS
SEE PLANT SUMMARY AT SHEET
NO. 26

ORIGINAL PLAN	SURVEY PLOTTED BY	DATE
NOTE BOOK	DRAWN BY	
No.	DESIGNED BY	
	QUANTITIES BY	
	CHECKED BY	

JOHN B. K. SUR & ASSOCIATES, INC.



THIS WORK WAS PREPARED BY
ME OR UNDER MY SUPERVISION.

John B. K. Sur

STATE OF HAWAII
DEPARTMENT OF TRANSPORTATION
HIGHWAYS DIVISION

LANDSCAPING

SCALE: 1"=50'

SHEET No. OF SHEETS