

FED. ROAD DIST. NO.	STATE	FED. AID PROJ. NO.	FISCAL YEAR	SHEET NO.	TOTAL SHEETS
HAWAII	HAW.	I-H1-1 (104) : 13	1972	182	183

LINE LEGEND

- EXISTING GROUND
- FINISHED GRADE & SUBGRADE
- ▭ PAVEMENT STRUCTURE SECTION
- GAUDDRAIL
- S&B REM. SURCHARGE AND BERM REMOVAL

DATE _____ BY _____

FINAL SURVEY SURVEYED PLOTTED TEMPLATE NO. _____

NO. _____

DATE _____ BY _____


ORIGINAL SURVEY SURVEYED PLOTTED TEMPLATE NO. _____

NO. _____

JOHN B. K. SUR
REGISTERED PROFESSIONAL ENGINEER
No. 806 E
HAWAII, U.S.A.

THIS WORK WAS PREPARED BY ME OR UNDER MY SUPERVISION.

[Signature]

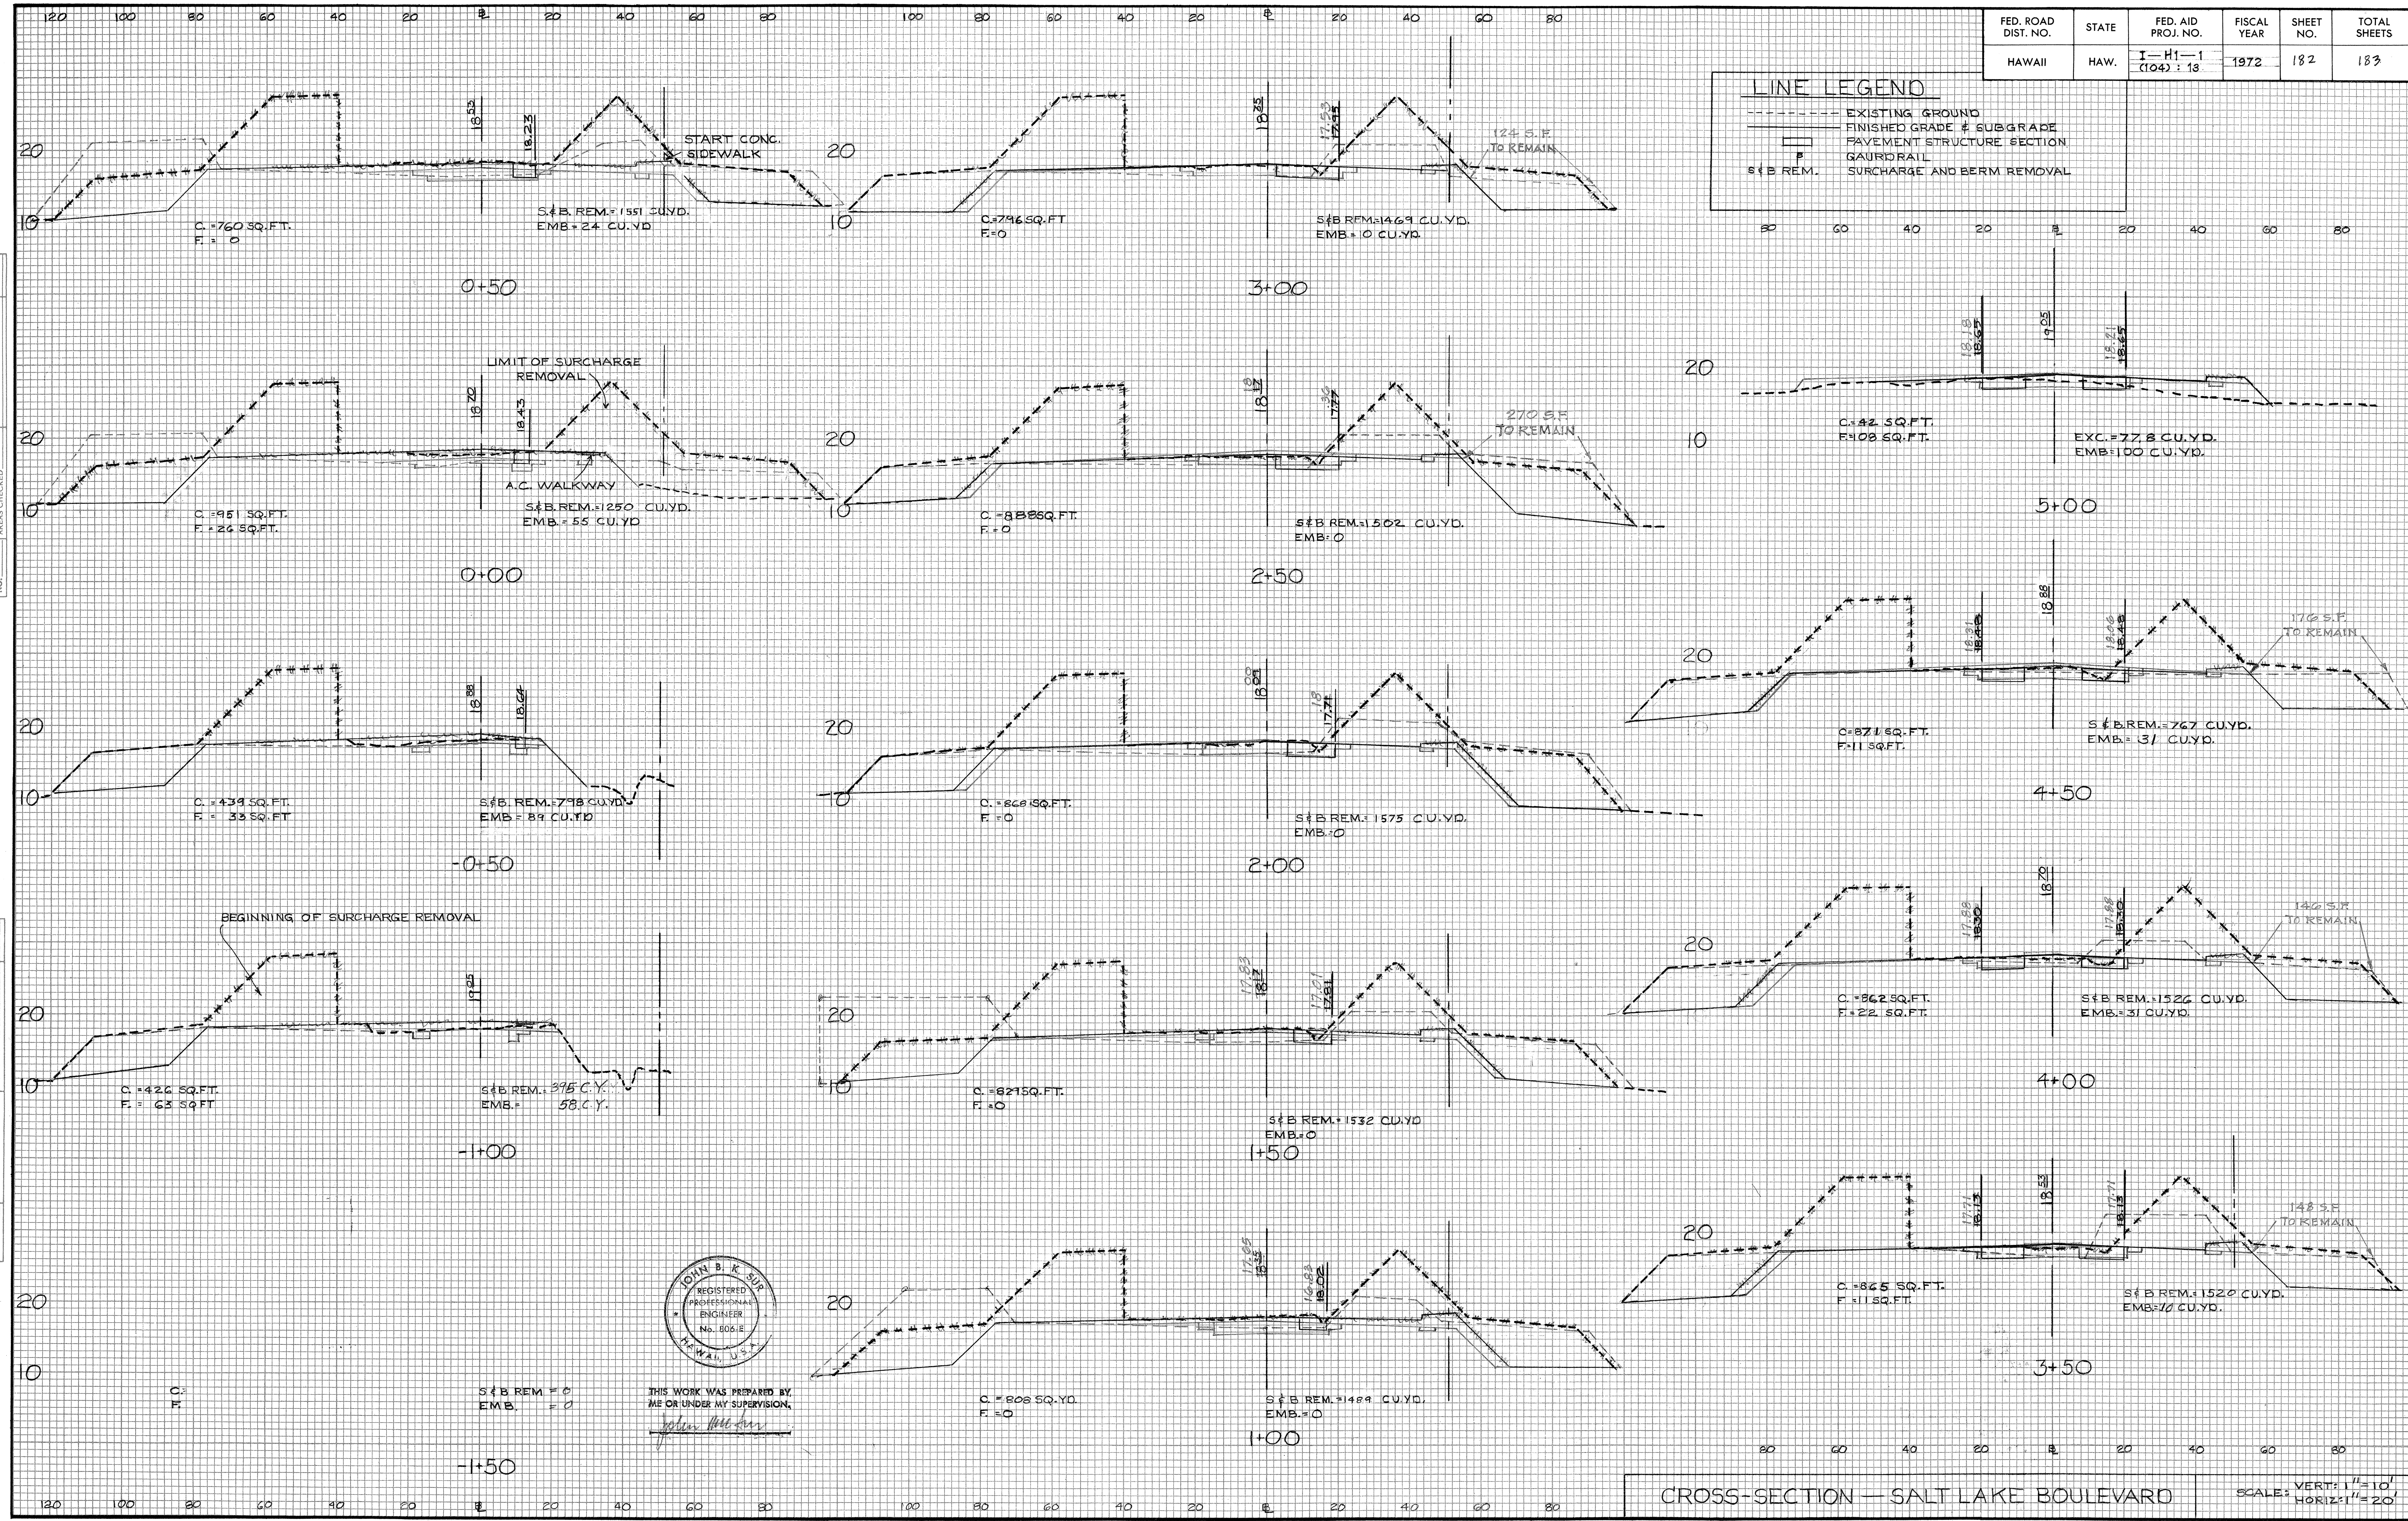


FED. ROAD DIST. NO.	STATE	FED. AID PROJ. NO.	FISCAL YEAR	SHEET NO.	TOTAL SHEETS
HAWAII	HAW.	I-41-1 (104): 13	1972	183	183

NOTE: FOR LINE LEGEND SEE SHEET NO. 180

FINAL SURVEY NOTE BOOK NO.	SURVEYED PLOTTED TERMINATE AREAS CHECKED	BY	DATE

ORIGINAL SURVEY NOTE BOOK NO.	SURVEYED PLOTTED TERMINATE AREAS CHECKED	BY	DATE

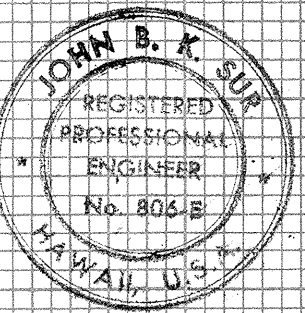

THIS WORK WAS PREPARED BY
ME OR UNDER MY SUPERVISION.
[Signature]

CROSS-SECTION — SALT LAKE BOULEVARD SCALE: VERT: 1"=10' HORIZ: 1"=20'