




FED. ROAD DIST. NO.	STATE	FED. AID PROJ. NO.	FISCAL YEAR	SHEET NO.	TOTAL SHEETS
HAWAII	HAW.	I-HI-1 (104):13	1972	36	183

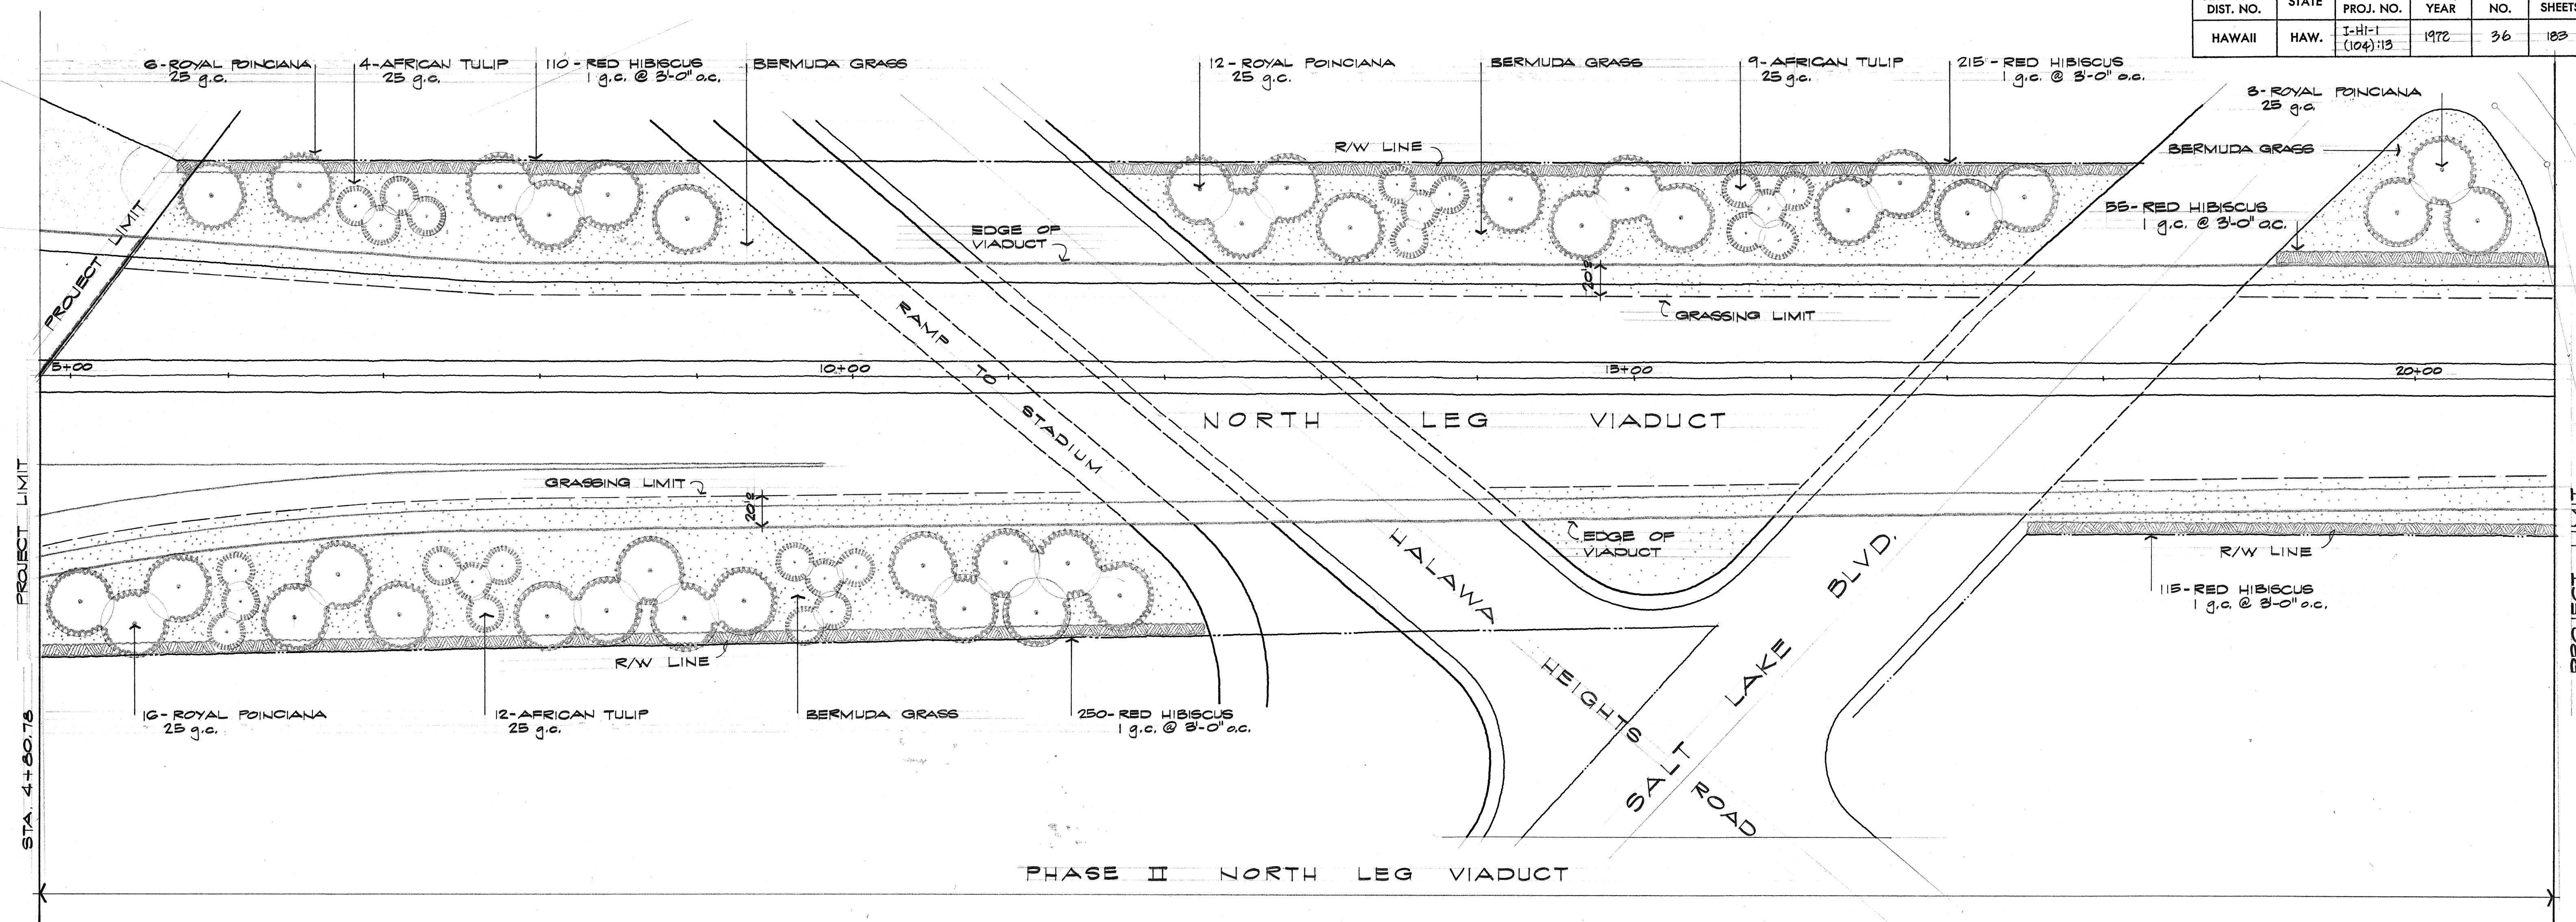


PHASE II NORTH LEG VIADUCT

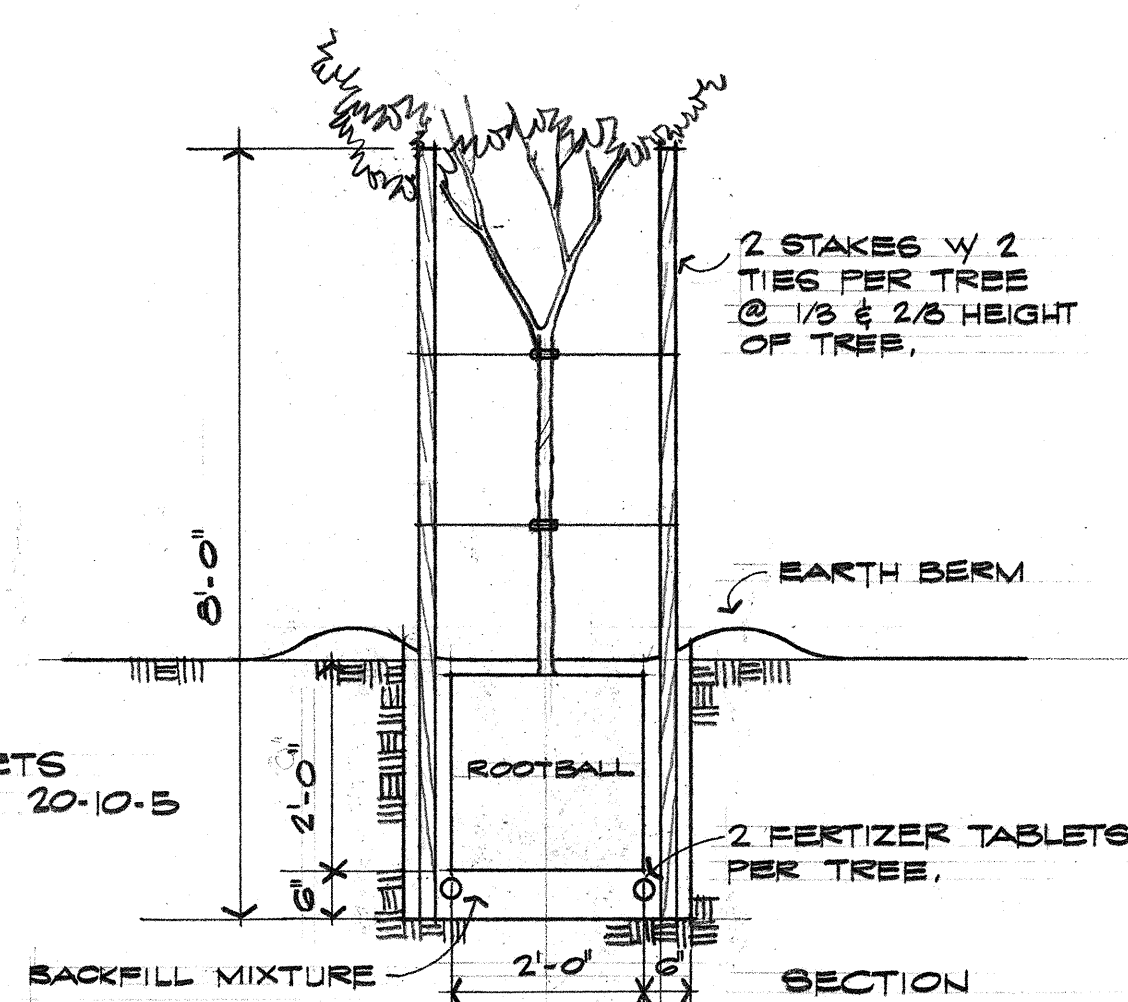

TYP. TREE PLANTING DETAIL
NO SCALE

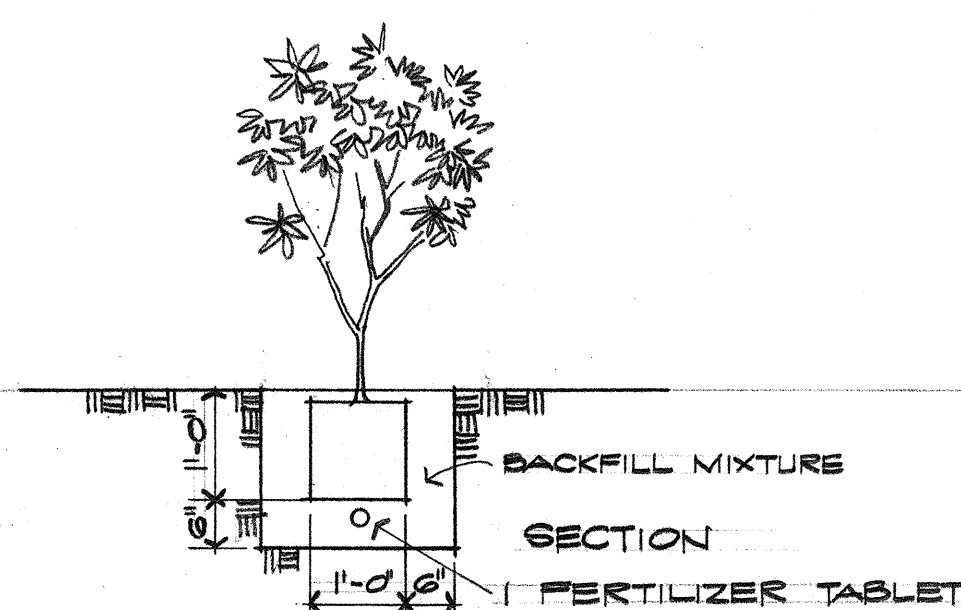


SHRUB PLANTING DETAIL
NO SCALE

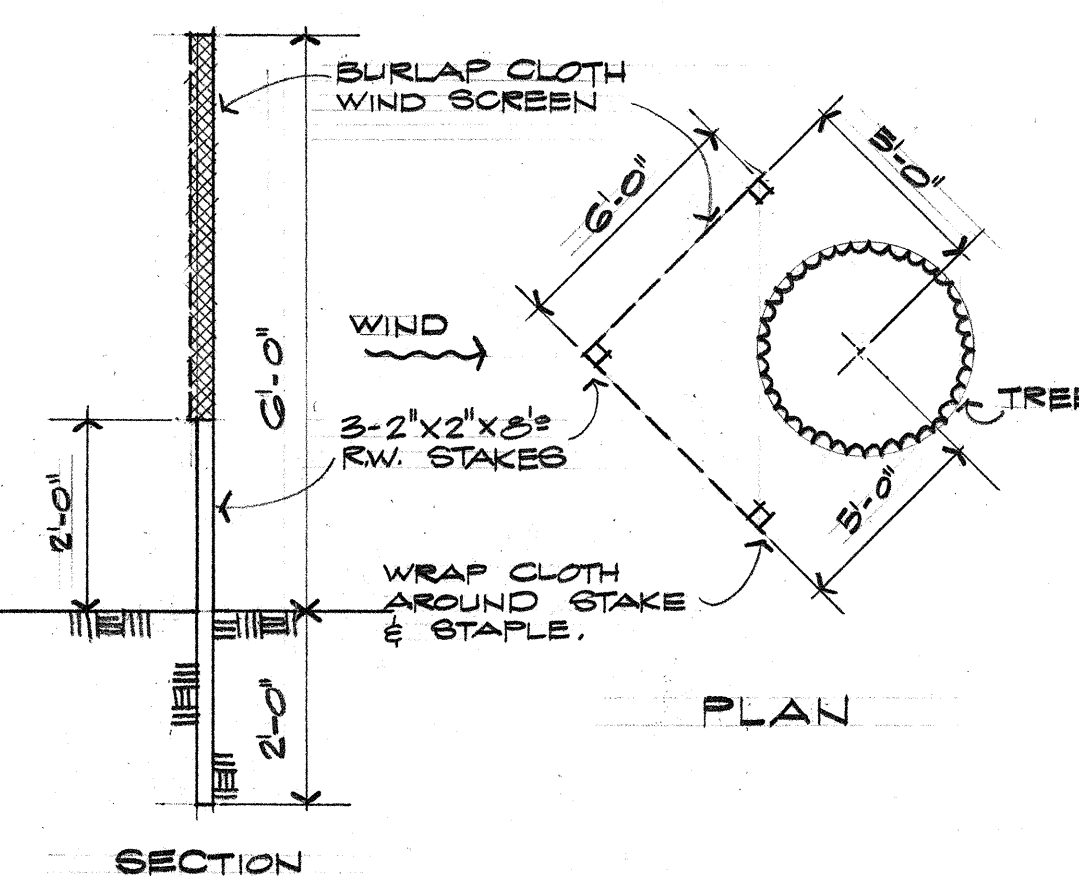

TYP. WIND SCREEN DETAIL
NO SCALE

QUAN.	NAME	SIZE
25	AFRICAN TULIP - SPATHODEA CAMPANULATA	25 g.c., 10' HT.
37	ROYAL POINCIANA - DELONIX REGIA	25 g.c., 10' HT.
745	RED HIBISCUS - HIBISCUS ROSA-SINENSIS	1 g.c., 24" HT.
19,400 S.F.	BERMUDA - CYNODON DACTYLON	CERTIFIED SEEDS
	NOTE: NO GIANT BERMUDA, MIX IN 2 BUSHELS OF TIFTON 419 "TIFWAY" SPRIGS PER 1000 S.F. OF BERMUDA.	TIFWAY STOLONS

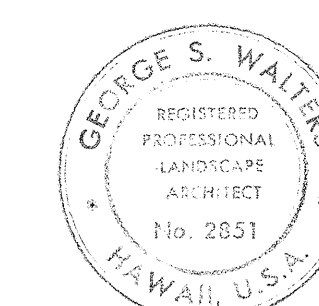

THIS WORK WAS PREPARED BY ME OR UNDER MY SUPERVISION.

STATE OF HAWAII DEPARTMENT OF TRANSPORTATION HIGHWAYS DIVISION
LANDSCAPE PLANTING PLAN PHASE II - NORTH LEG VIADUCT
INTERSTATE ROUTE 4-1 F.A.I. PROJECT NO. I-HI-1 (104): 13
SCALE: 1" = 50'-0" MAY 4, 1972
SHEET No. OF SHEETS