




FED. ROAD DIST. NO.	STATE	FED. AID PROJ. NO.	FISCAL YEAR	SHEET NO.	TOTAL SHEETS
HAWAII	HAW.	I-11-1 (104): 13	1972	2	103

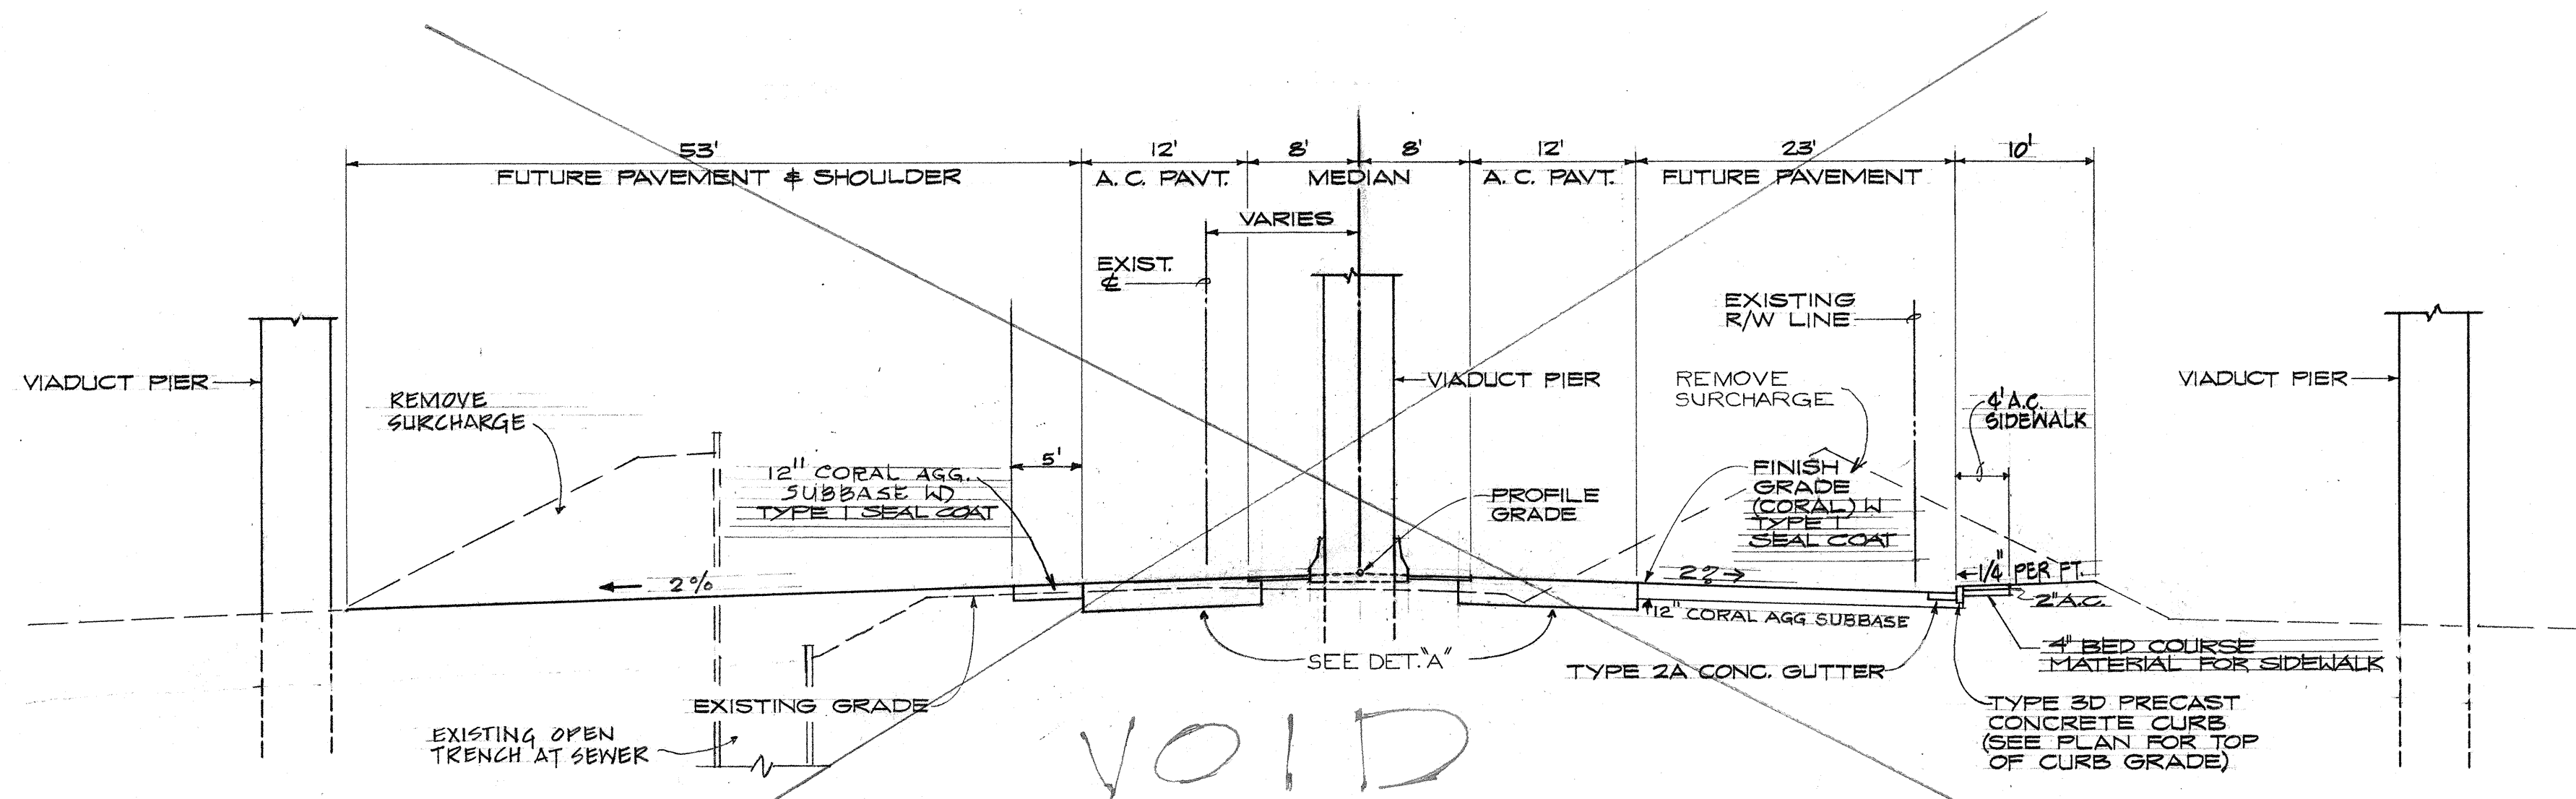


SALT LAKE BLVD. AT NORTH LEG VIADUCT CROSSING
STA. 3+30 TO 5+10
SCALE: 1"=10'-0"

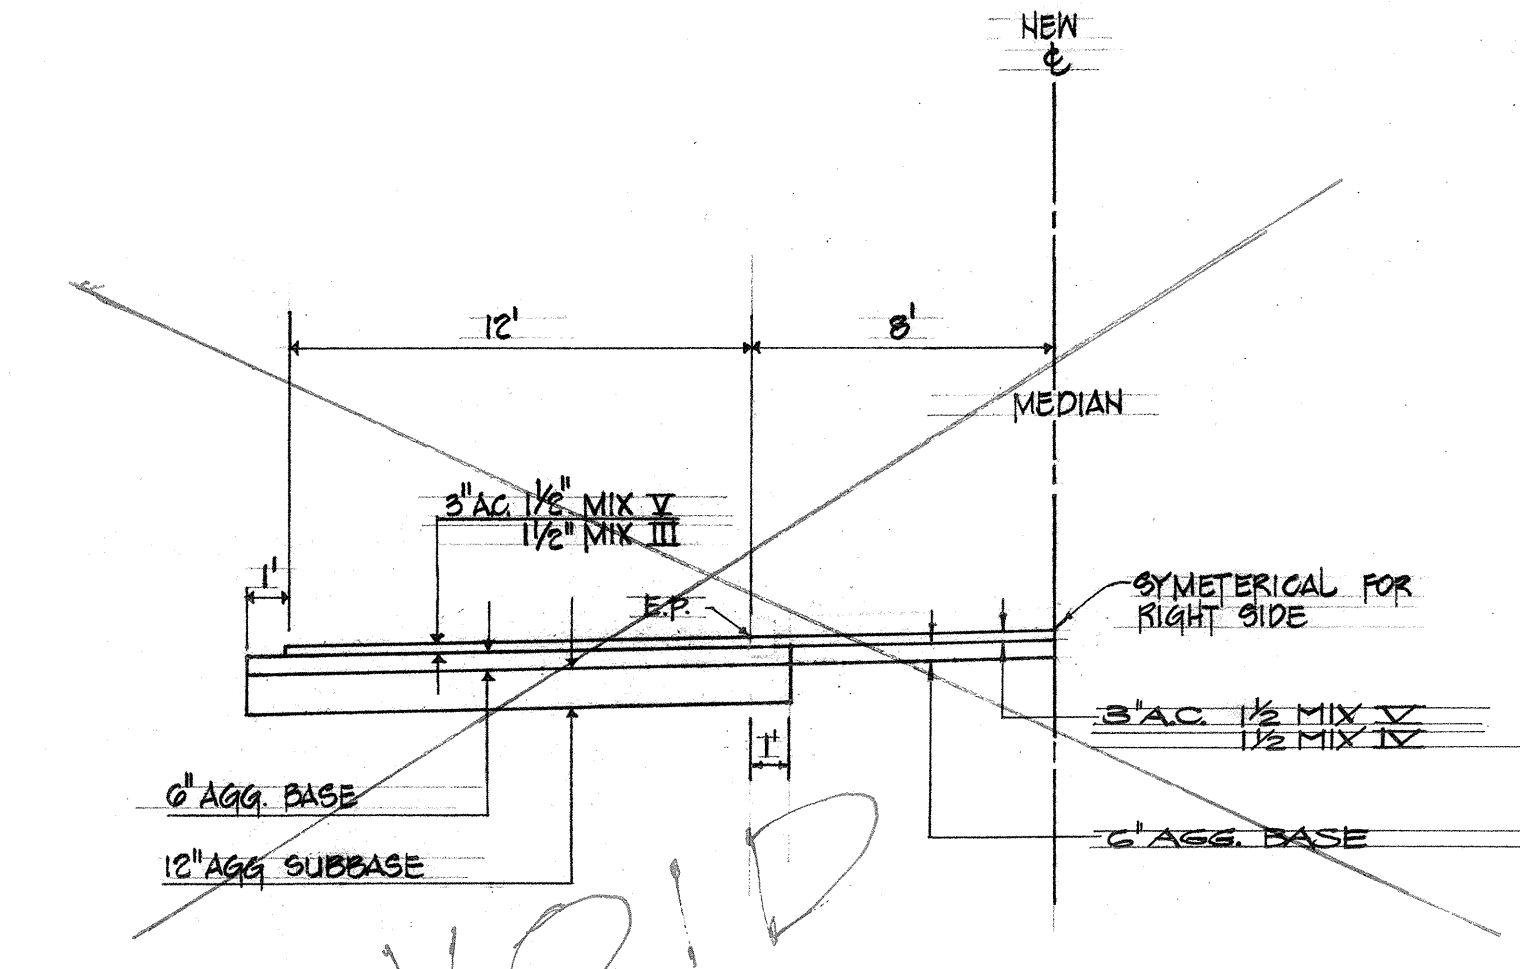

DETAIL "A"
PAVEMENT STRUCTURE SECTION AT SALT LAKE BLVD.
SCALE: 1"=5'-0"

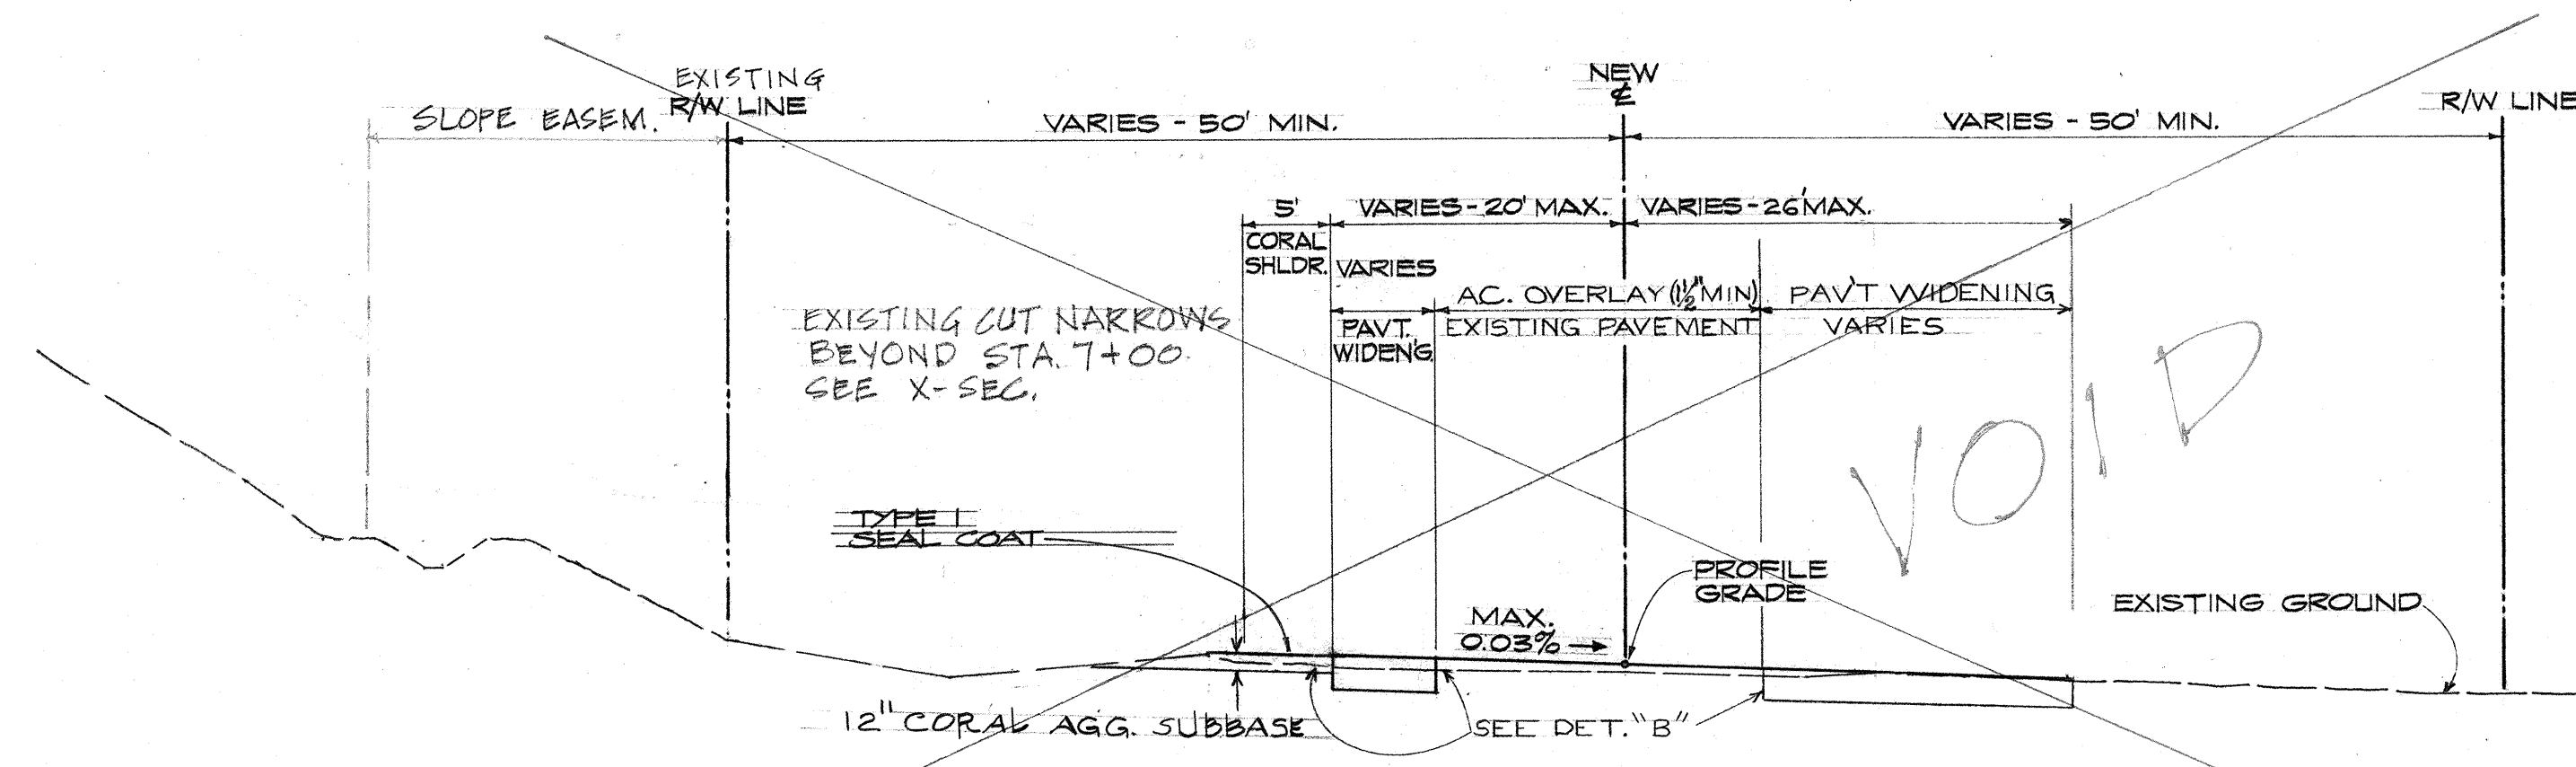


TYPICAL SECTION IN CUT AND ON CURVE (BEYOND VIADUCT CROSSING)
STA. 5+20 TO 10+00
SCALE: 1"=10'-0"

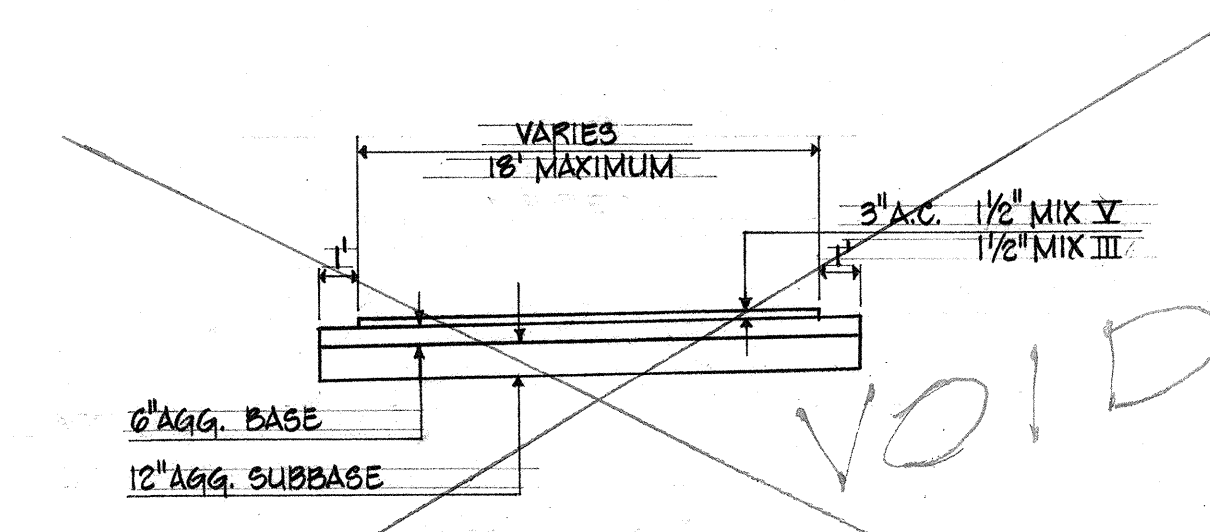


DETAIL "B"
PAVEMENT STRUCTURE SECTION
SCALE: 1"=5'-0"

- GENERAL NOTES**
1. THE OPEN SEWER TRENCH SHALL BE BACKFILLED WITH APPROVED SELECTED MATERIAL & THOROUGHLY TAMPED IN UNIFORM HORIZONTAL LAYERS NOT EXCEEDING 8" LOOSE THICKNESS.
 2. FOR TRENCH BACKFILL MATERIAL SEE STANDARD SPECIFICATION FOR ROAD & BRIDGE CONSTRUCTION SECTION 703.21.

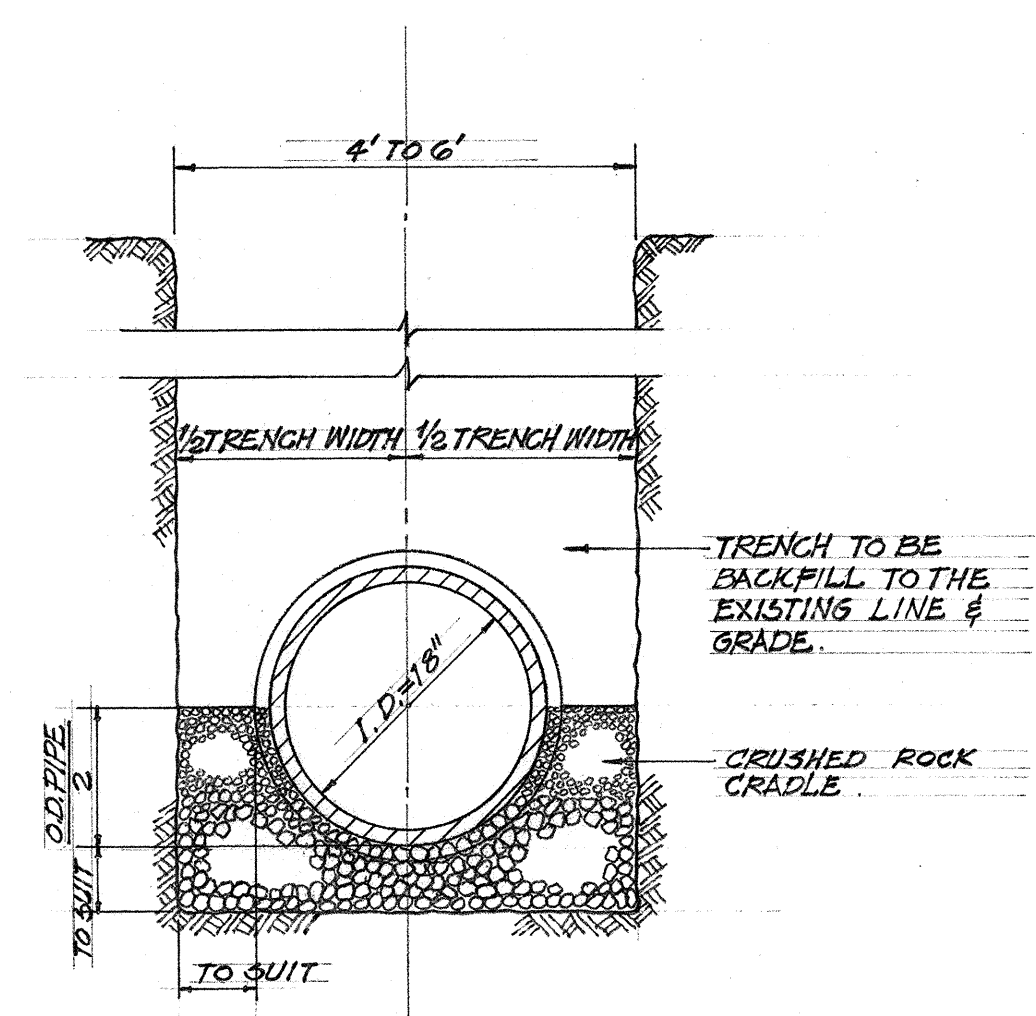

SEWER TRENCH DETAIL
SCALE: 1/2"=1'-0"

NOTE:
See Plan sheet No. 2A-9 for Revised Typical Road Sections.

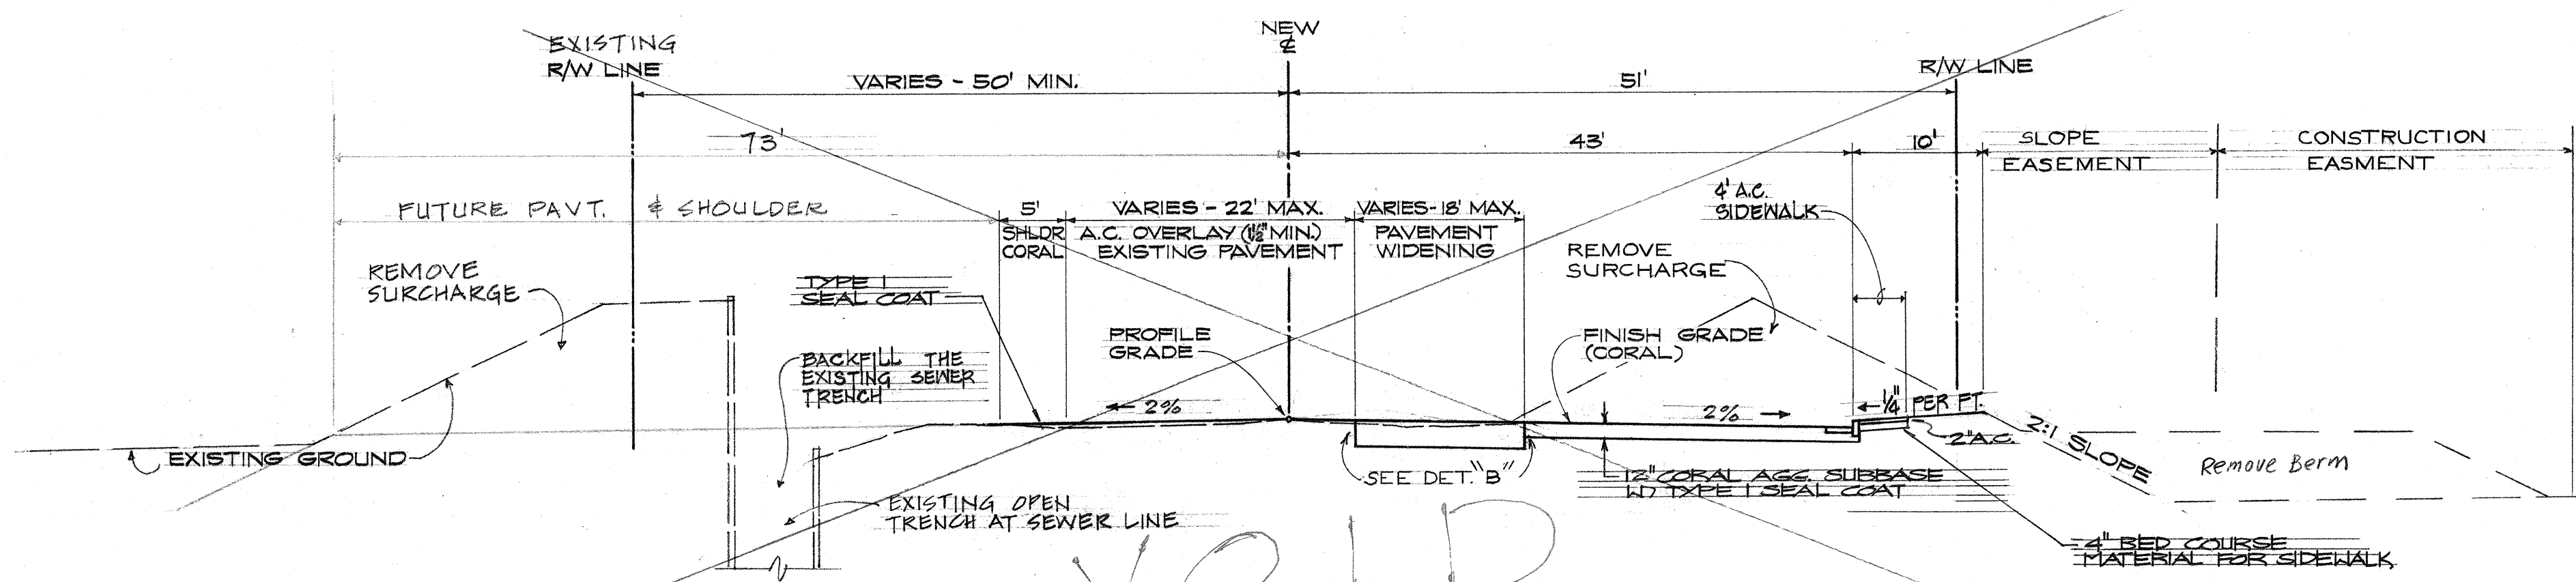

TYPICAL SECTION ON FILL AND ON TANGENT (IN FRONT OF VIADUCT CROSSING)
STA. -1+50 TO 3+20
SCALE: 1"=10'-0"

THIS WORK WAS PREPARED BY
ME OR UNDER MY SUPERVISION
John M. ...



STATE OF HAWAII
DEPARTMENT OF TRANSPORTATION
HIGHWAYS DIVISION

TYPICAL SECTIONS
SALT LAKE BLVD. ADJUSTMENT




FAI PROJECT No. I-11-1(103):14

SCALE: AS SHOWN DATE: _____





SHEET No. OF SHEETS

SURVEY PLOTTED BY	DATE
DESIGNED BY	
TRACED BY	
DESIGNED BY	
QUANTITIES BY	
CHECKED BY	
ORIGINAL PLAN	
NOTE BOOK	
No.	

FED. ROAD DIST. NO.	STATE	FED. AID PROJ. NO.	FISCAL YEAR	SHEET NO.	TOTAL SHEETS
HAWAII	HAW.	1-11-1 (104)13	1972	2A-5	

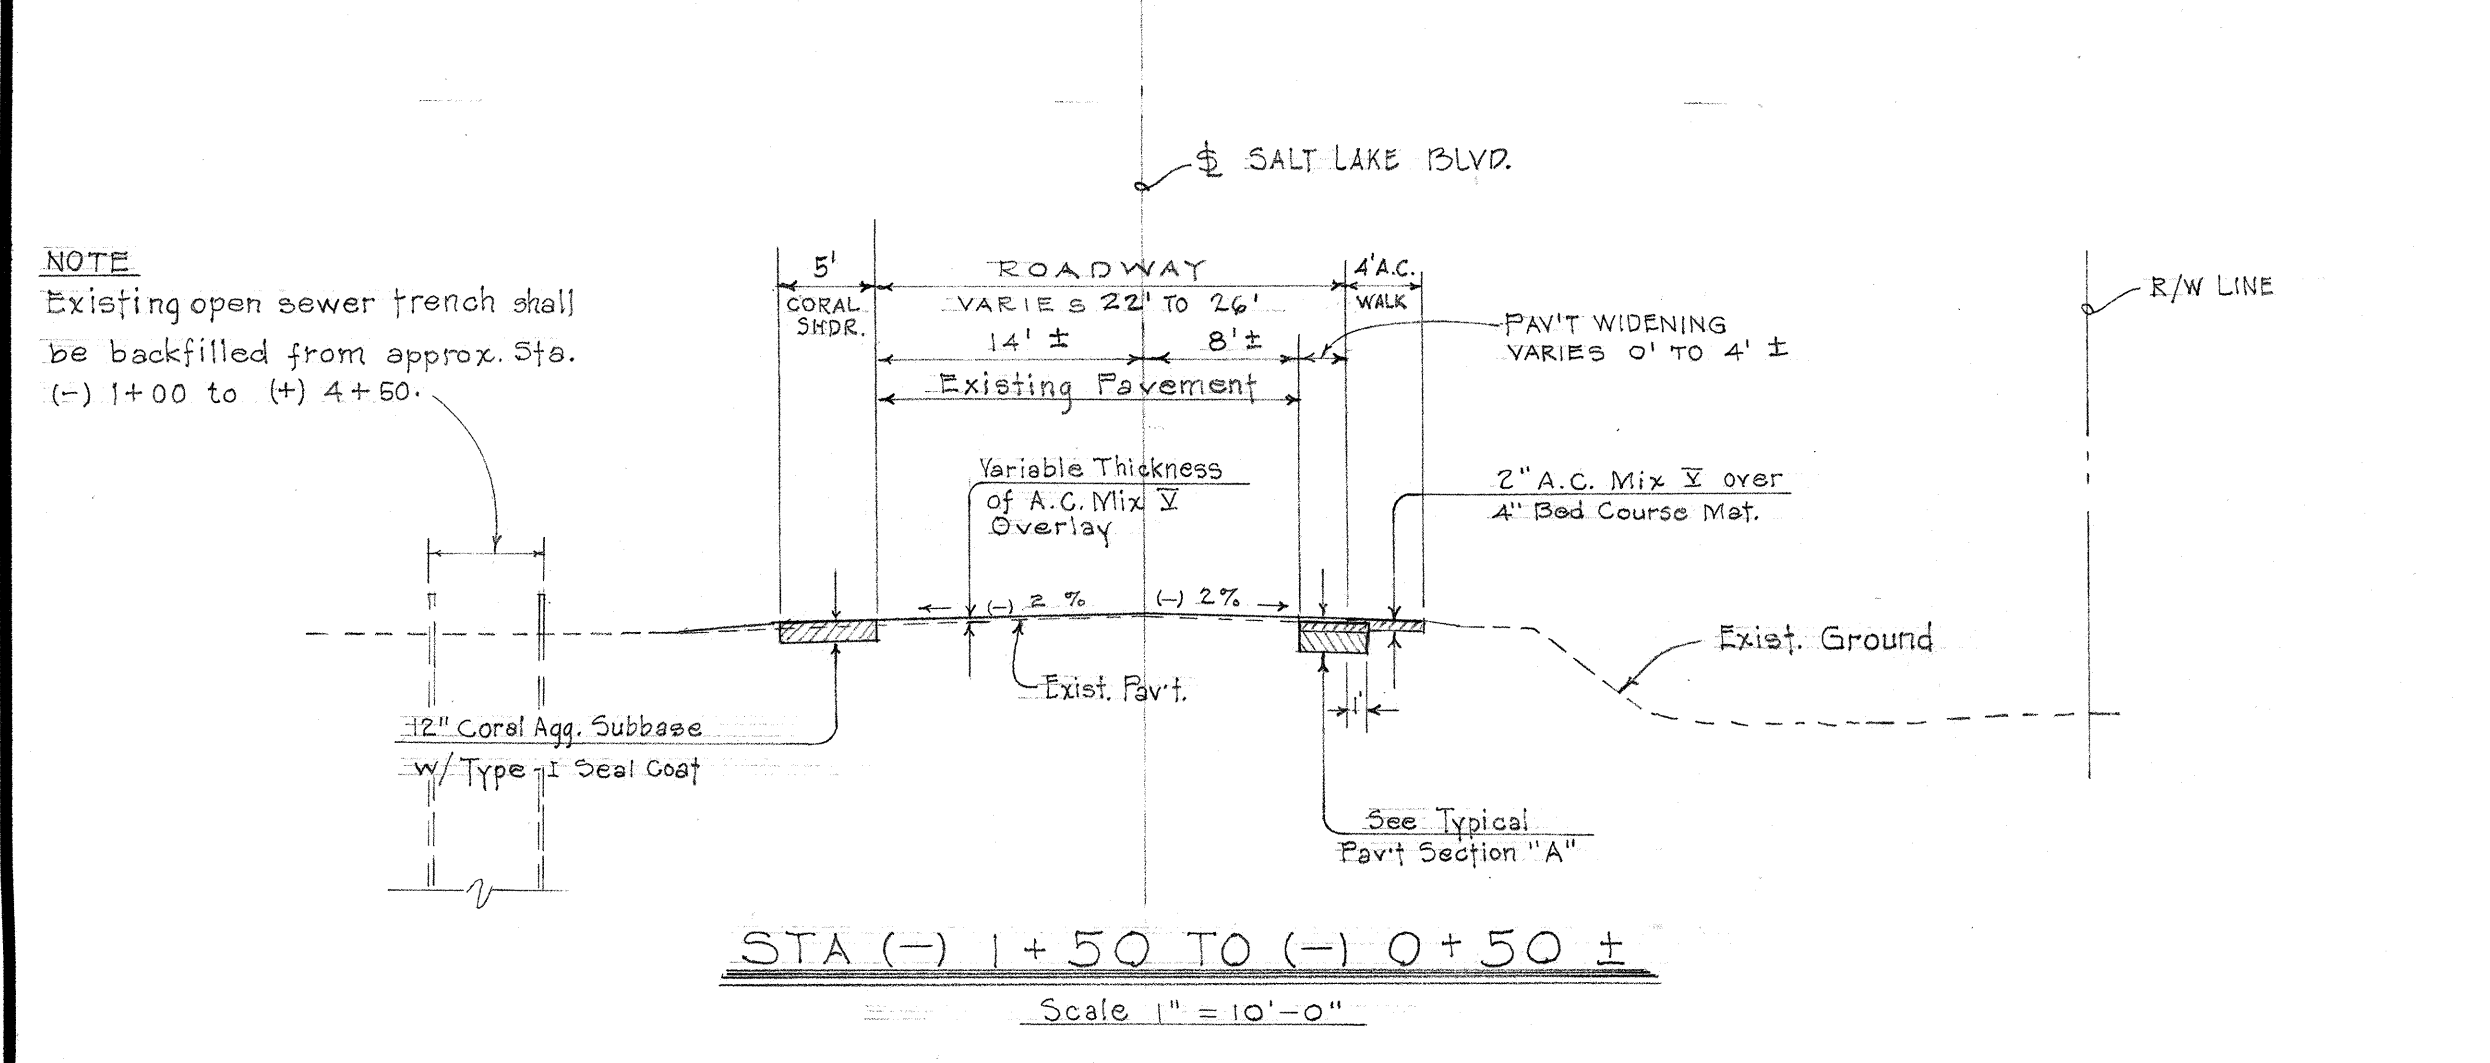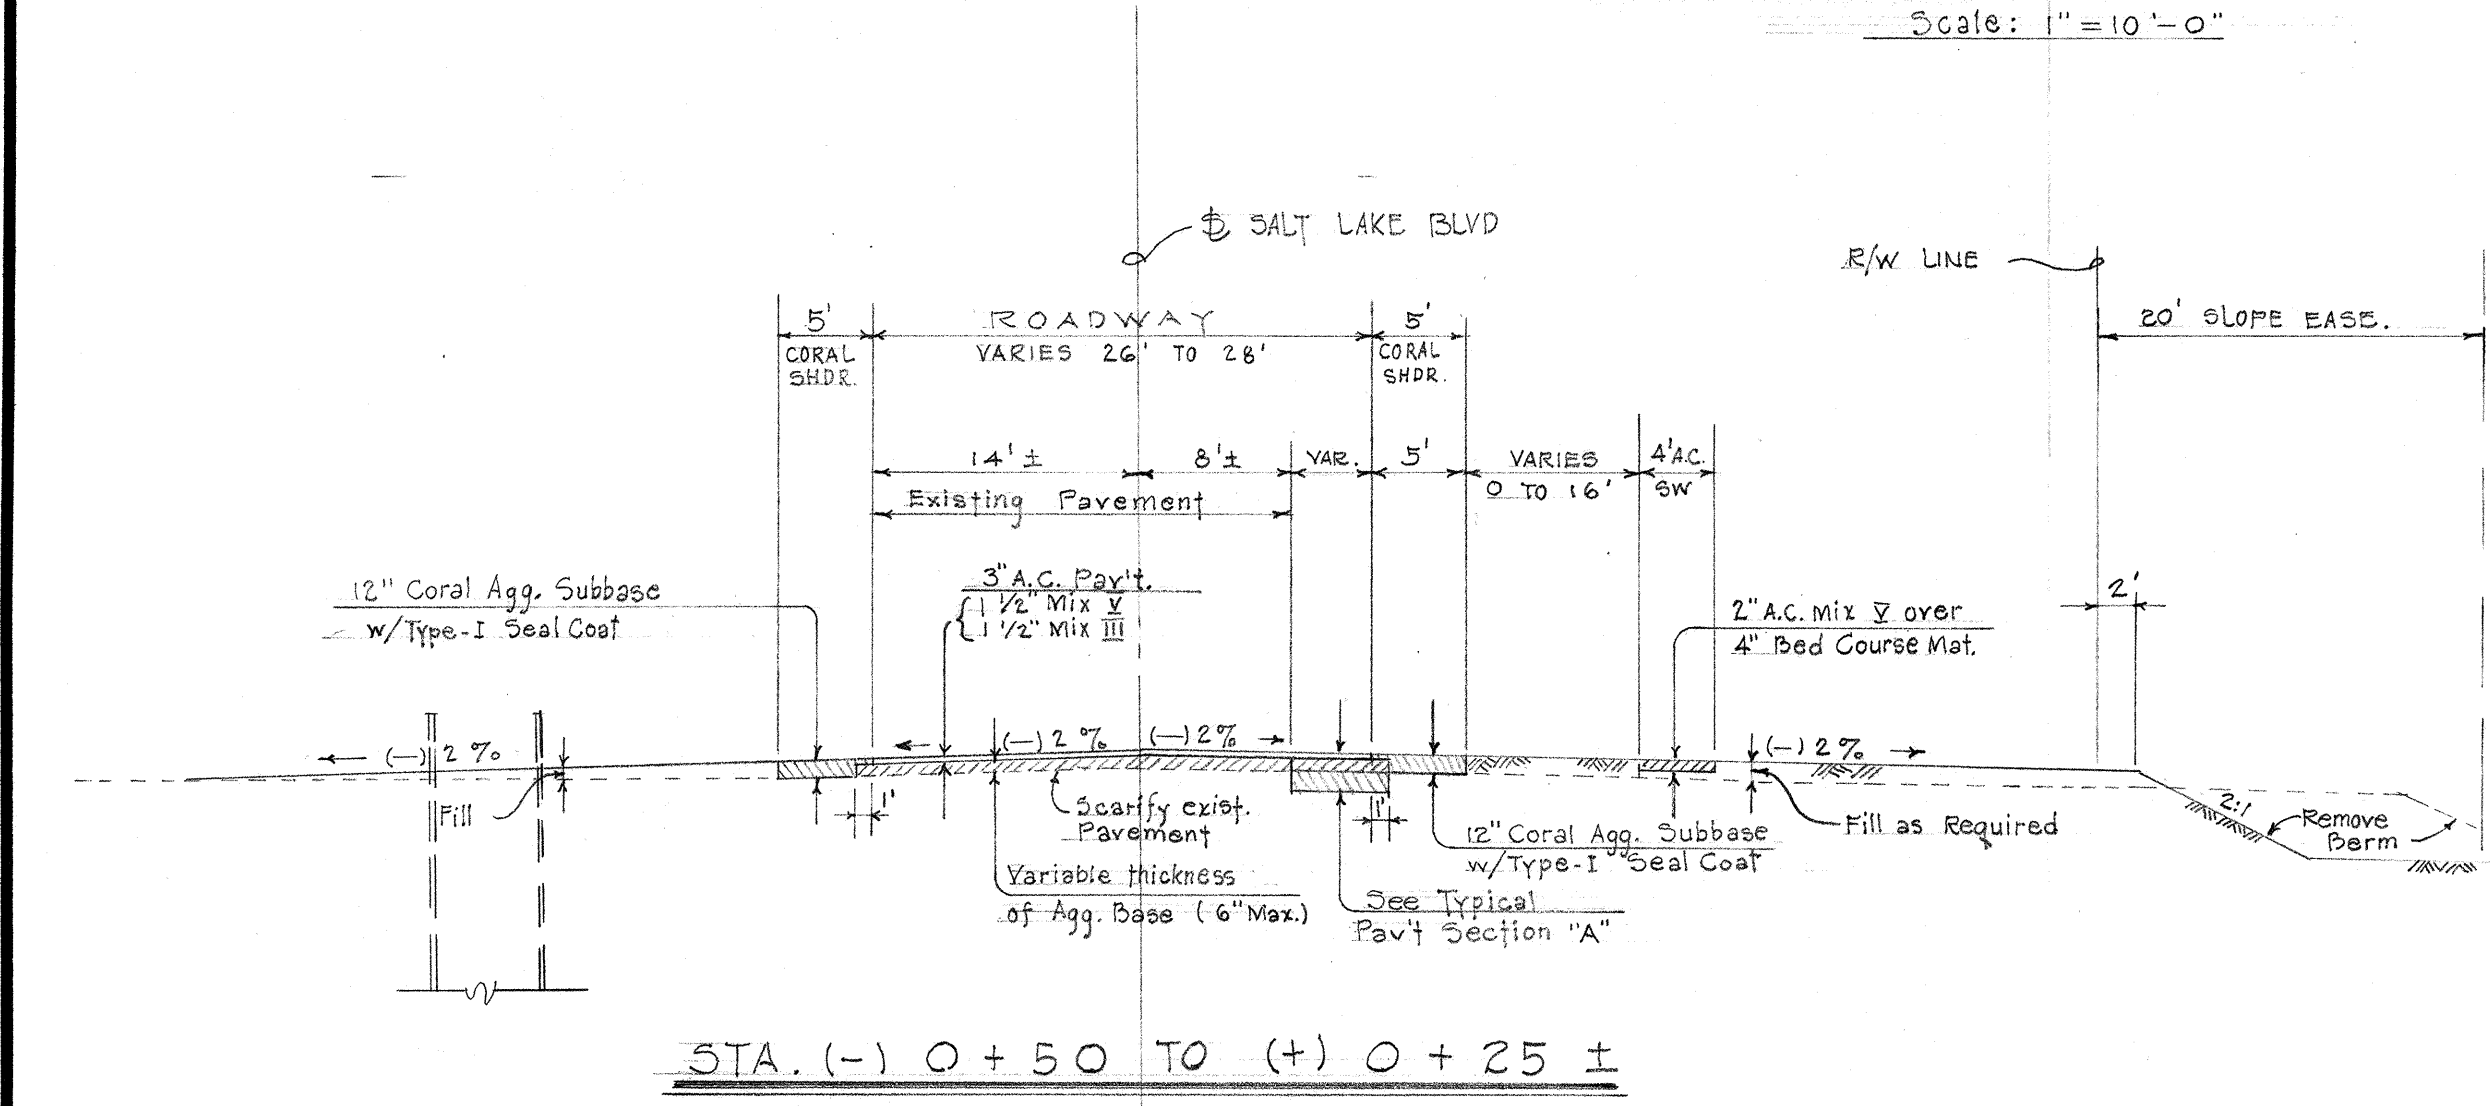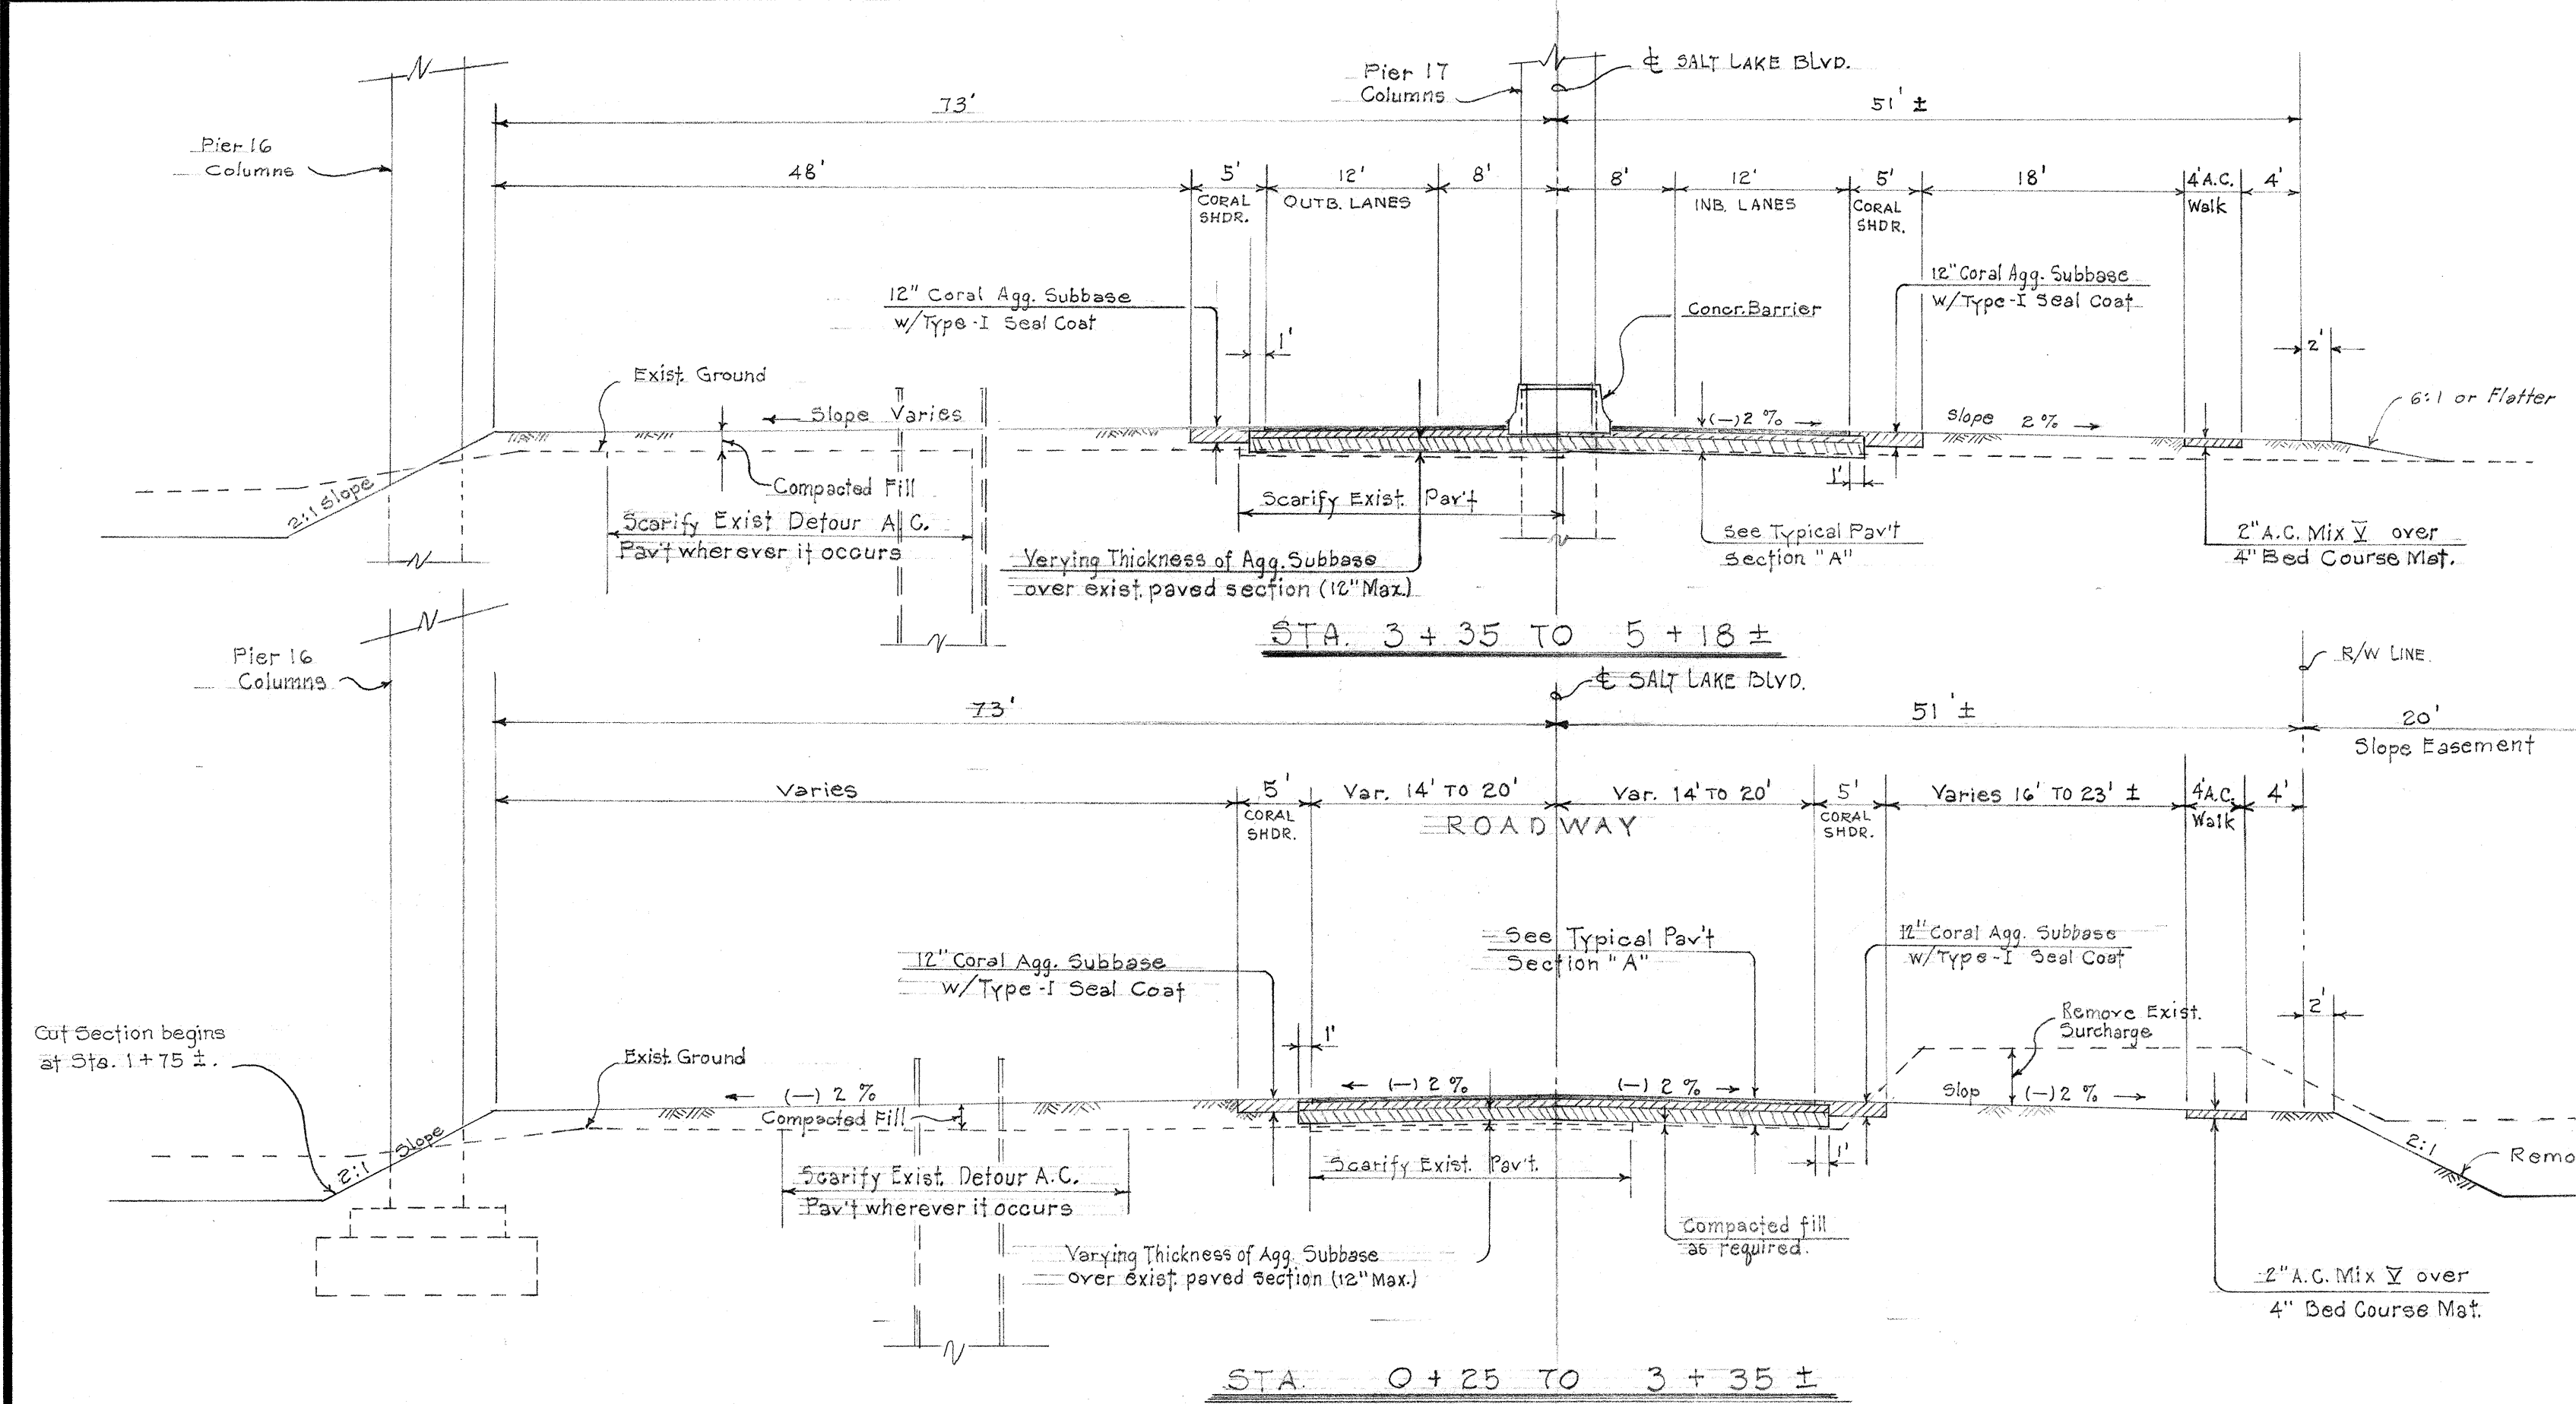

NOTE
Existing open sewer trench shall be backfilled from approx. Sta. (-) 1+00 to (+) 4+50.

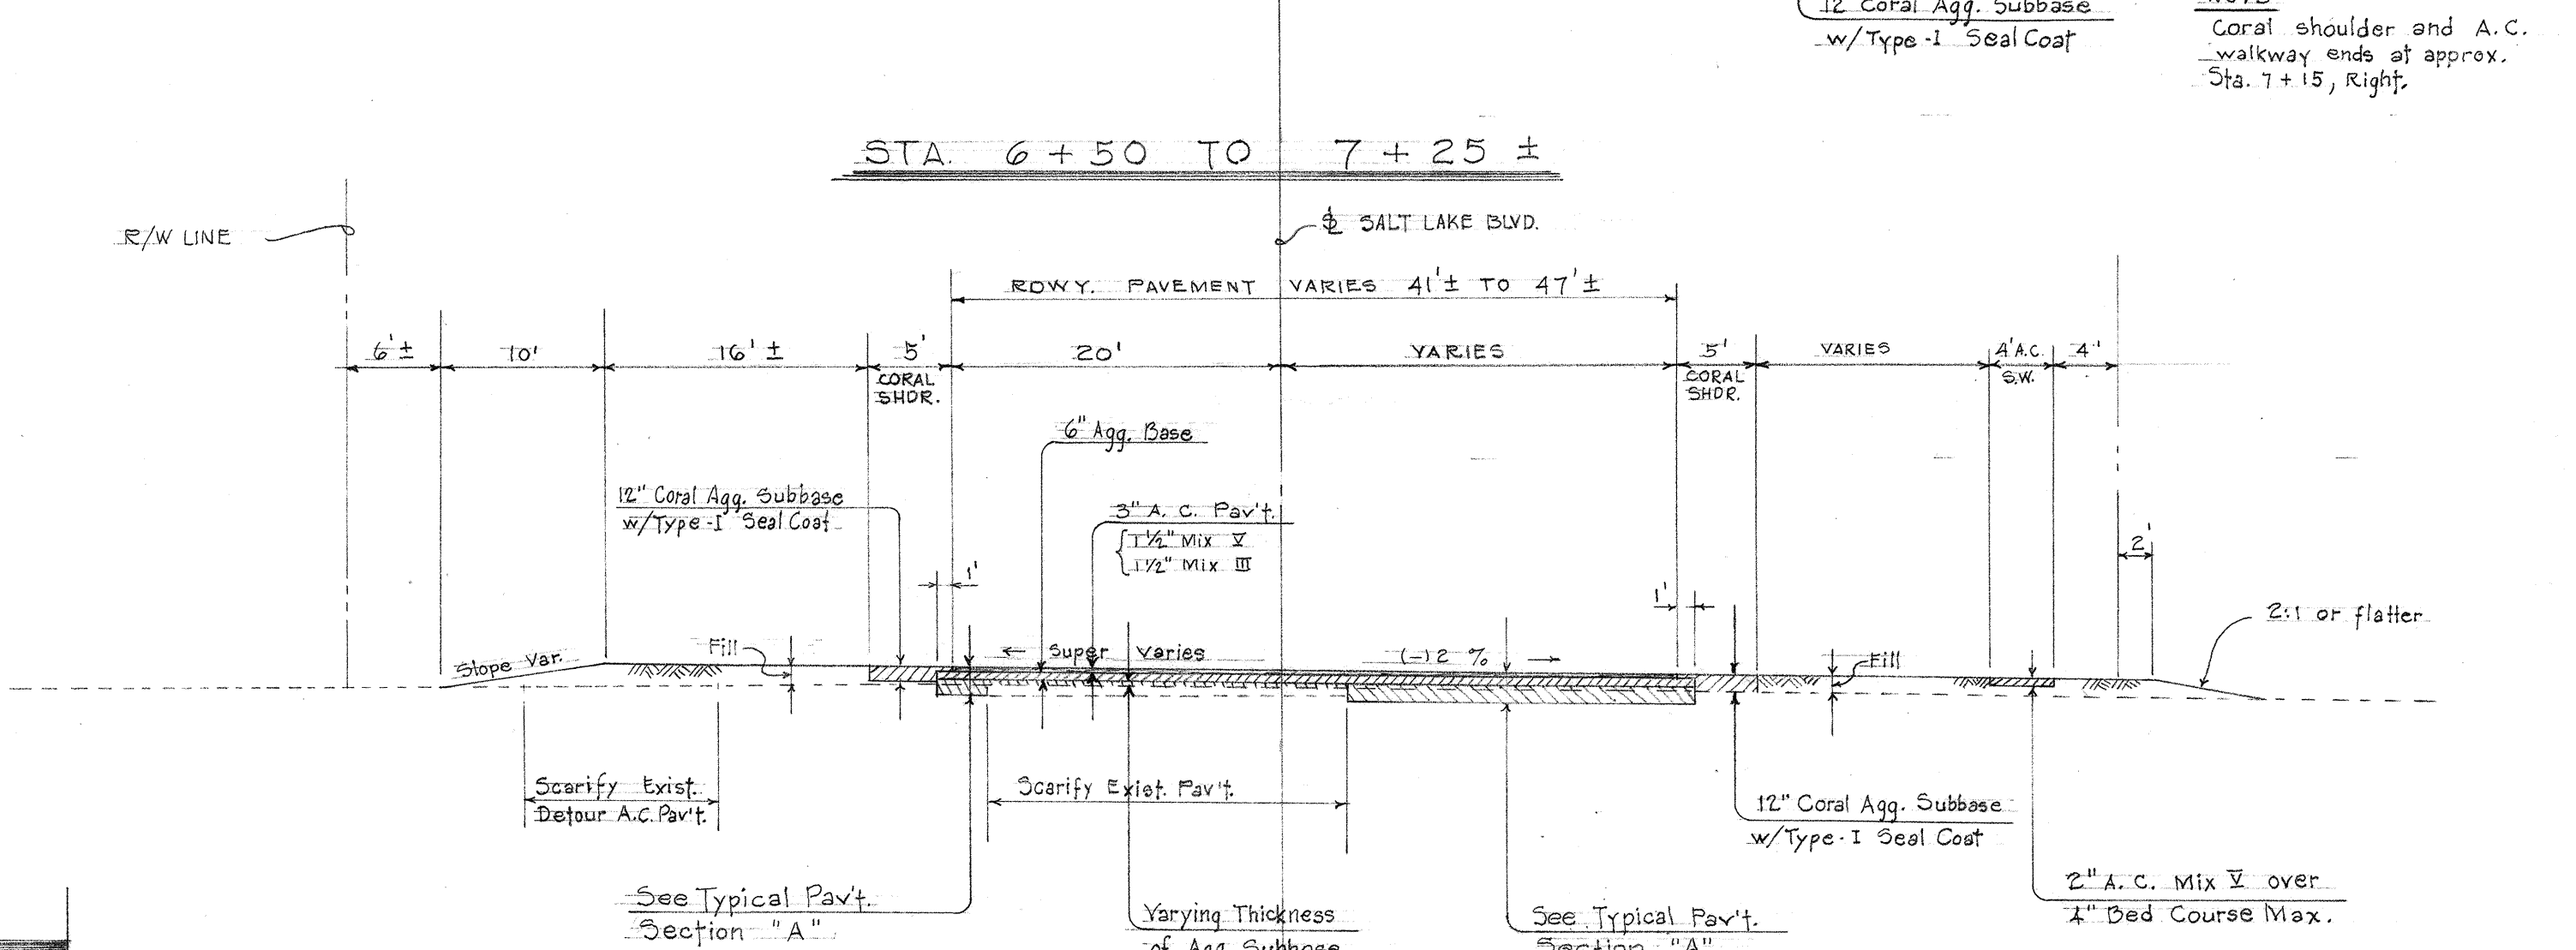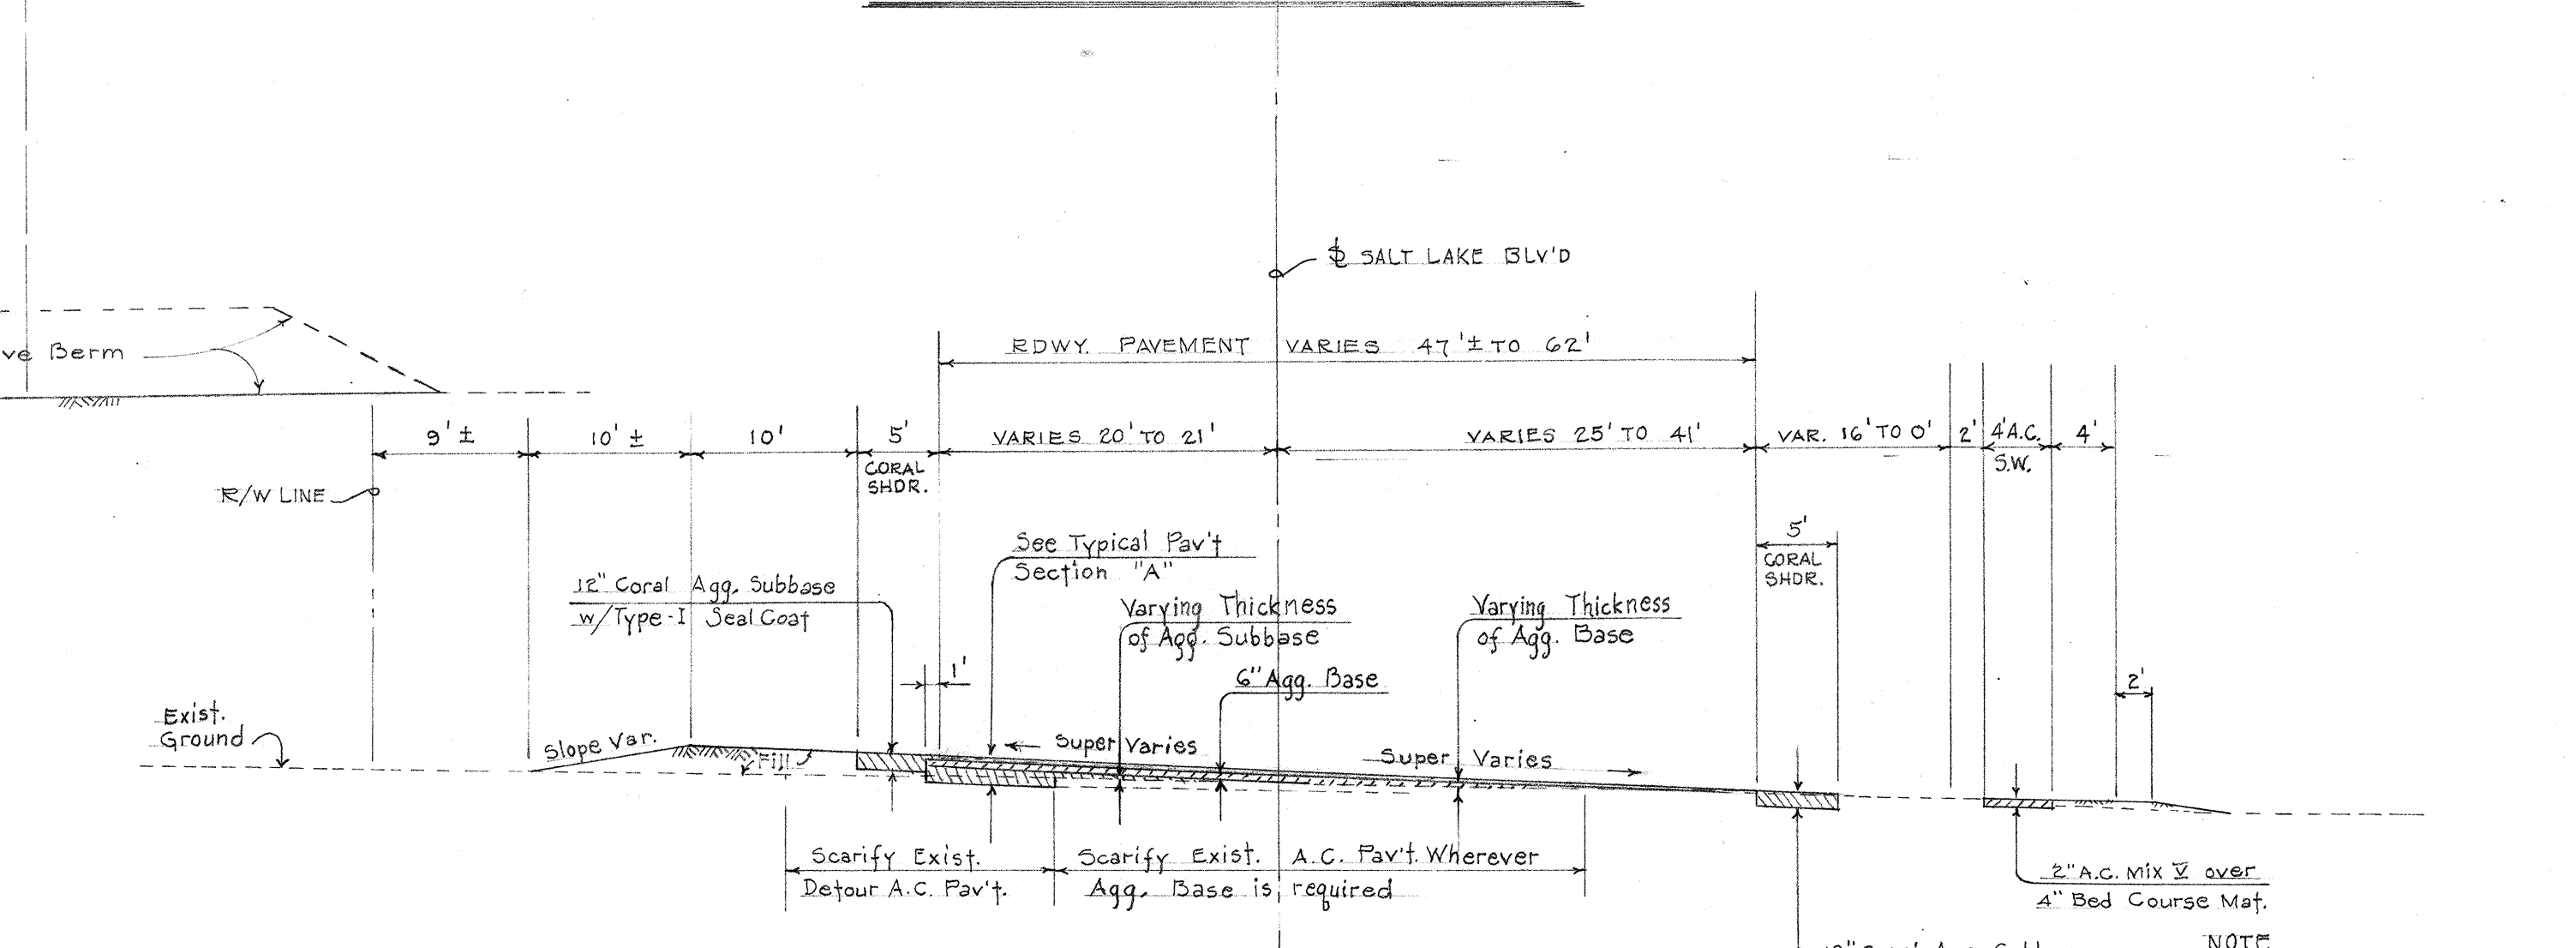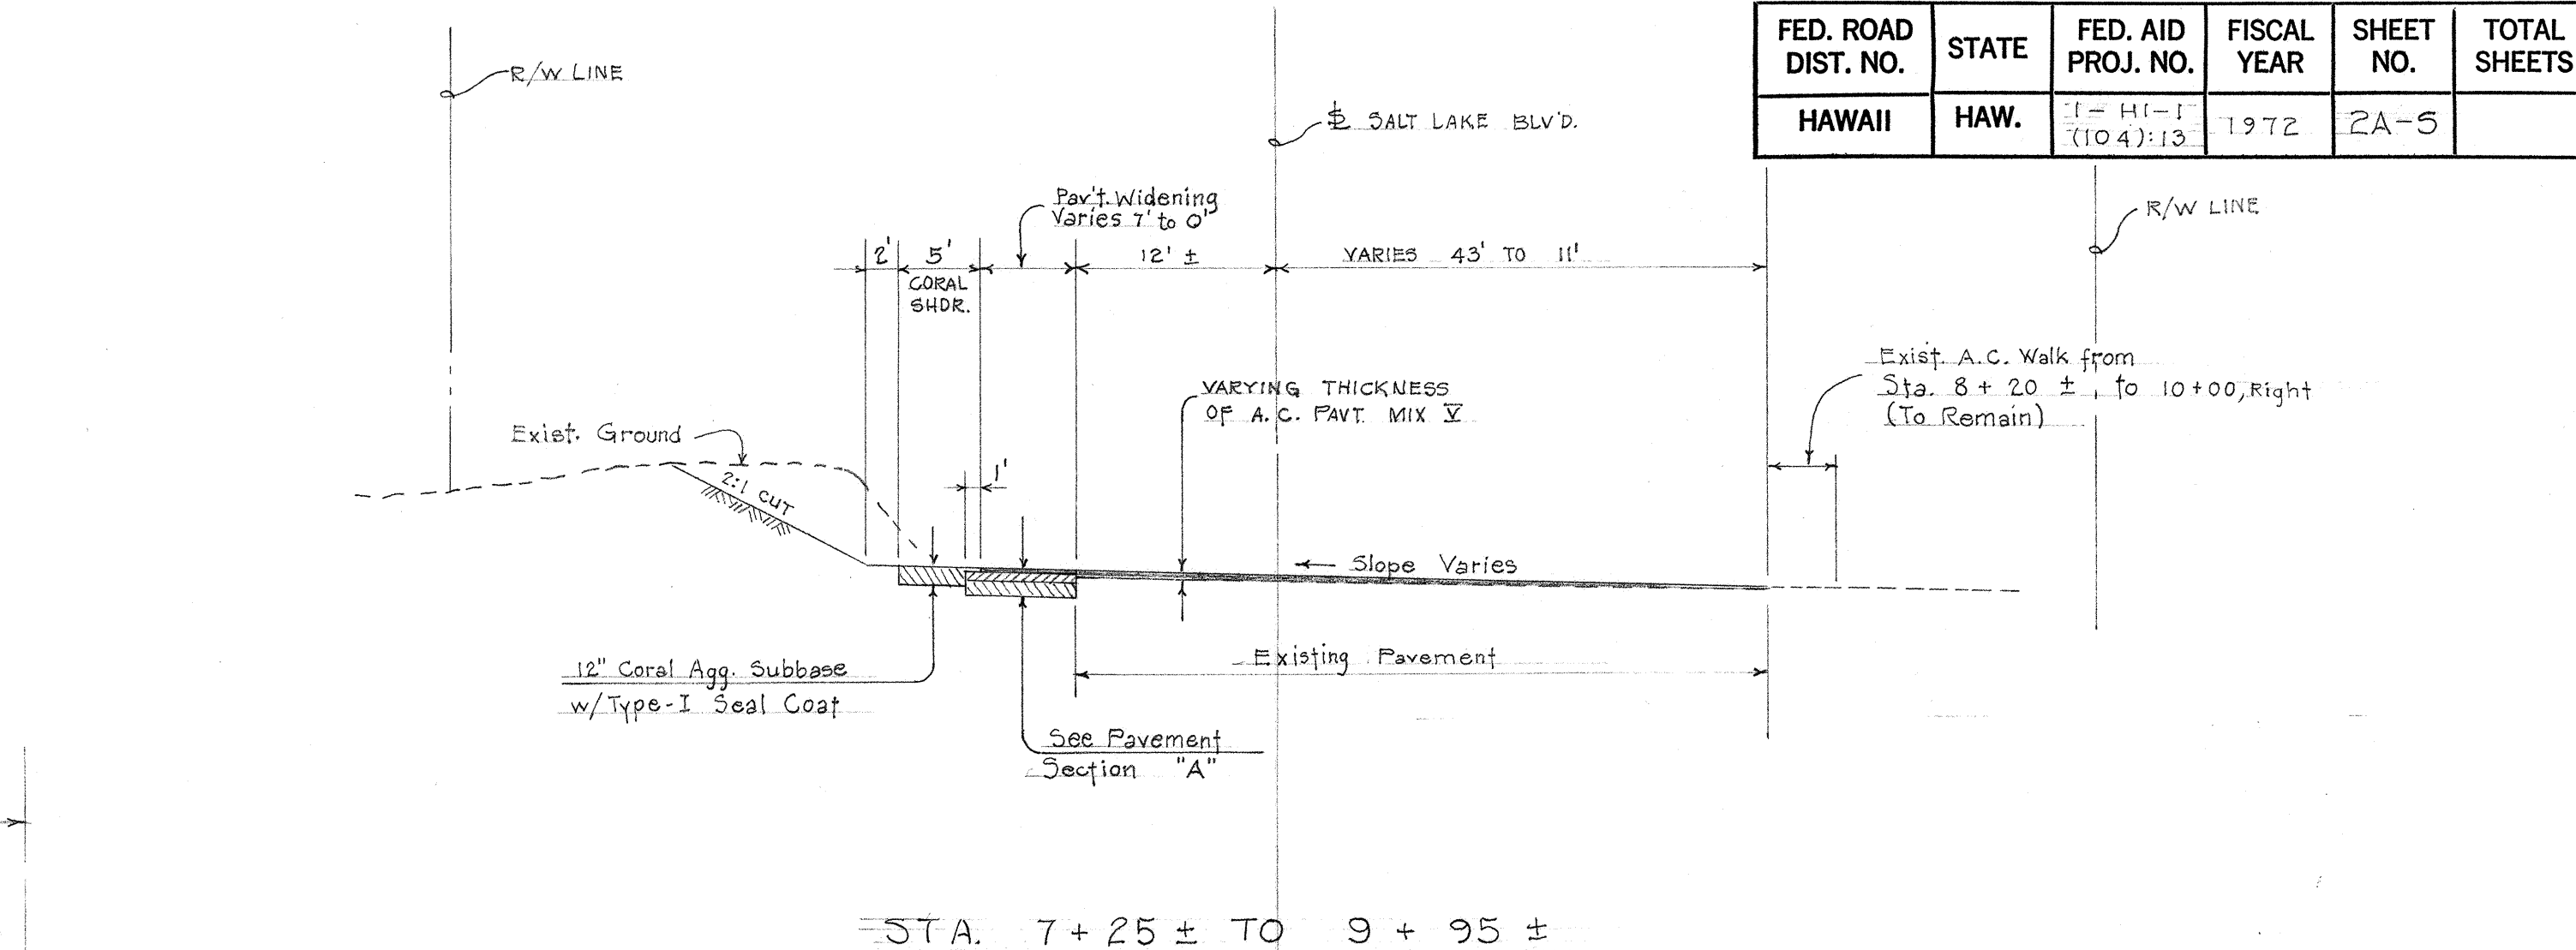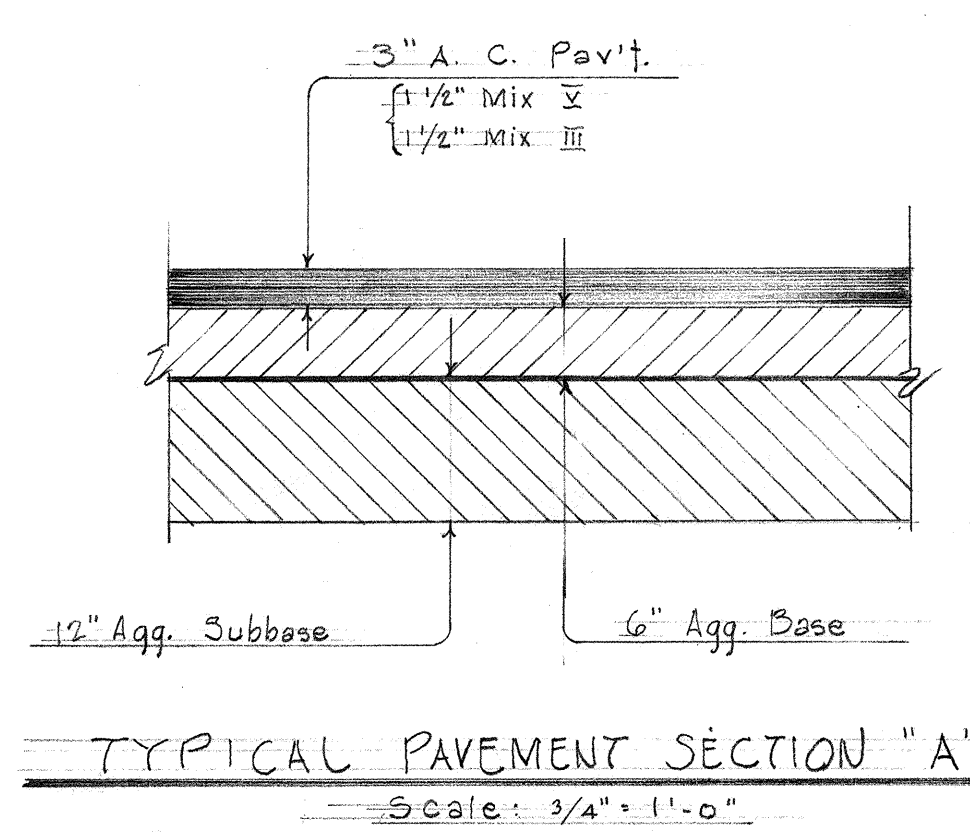

STATE OF HAWAII
DEPARTMENT OF TRANSPORTATION
HIGHWAYS DIVISION

REVISED TYPICAL SECTIONS
SALT LAKE BLVD ADJUSTMENT

H-1, NORTH LEG VIADUCT
FAI PROJECT NO. 1-11-1(104)13

SCALE: AS NOTED DATE: APRIL 30, 1975

SHEET NO. OF SHEETS
2A-5

DATE	*****
SURVEY PLOTTED BY	
DRAWN BY	
DESIGNED BY	
NOTED BY	
CHECKED BY	
NO.	