



FED. ROAD DIST. NO.	STATE	FED. AID PROJ. NO.	FISCAL YEAR	SHEET NO.	TOTAL SHEETS
HAWAII	HAW.	I-H-1(46):8	1973	27	104

Revised: Feb 1973

True North
Scale: 1" = 20'

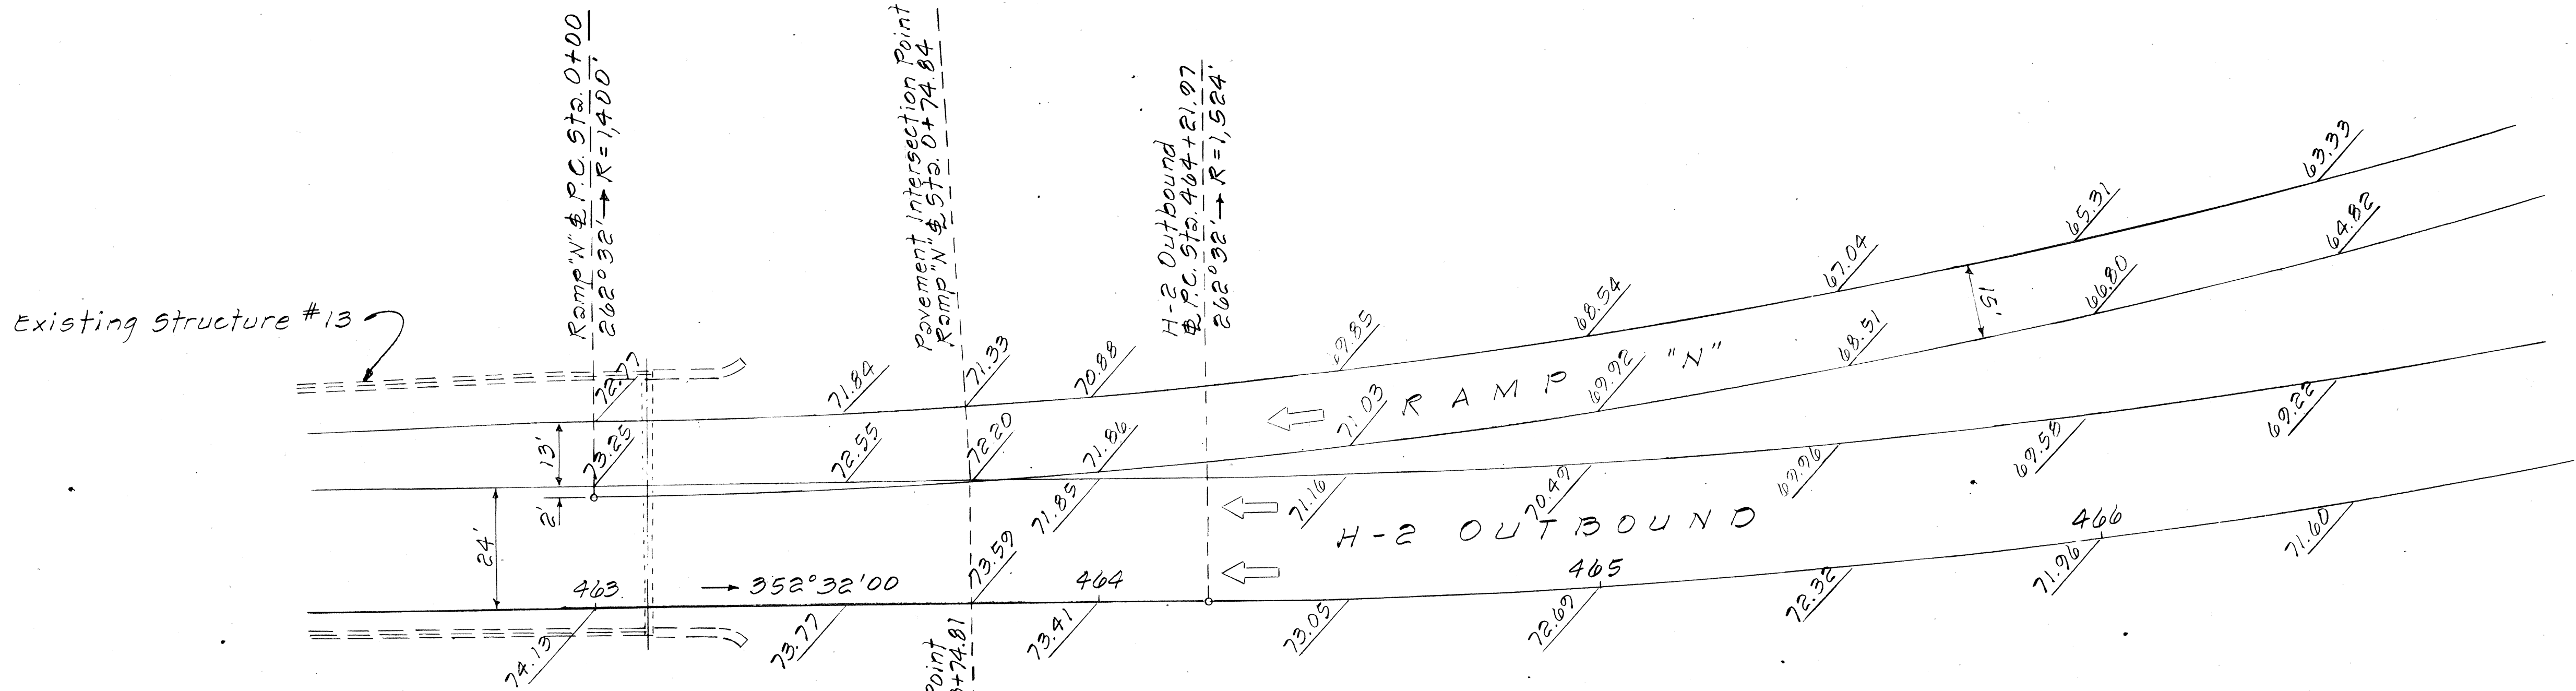


RAMP "N" AND H-2 OUTBOUND INTERSECTION
SCALE: 1" = 20'

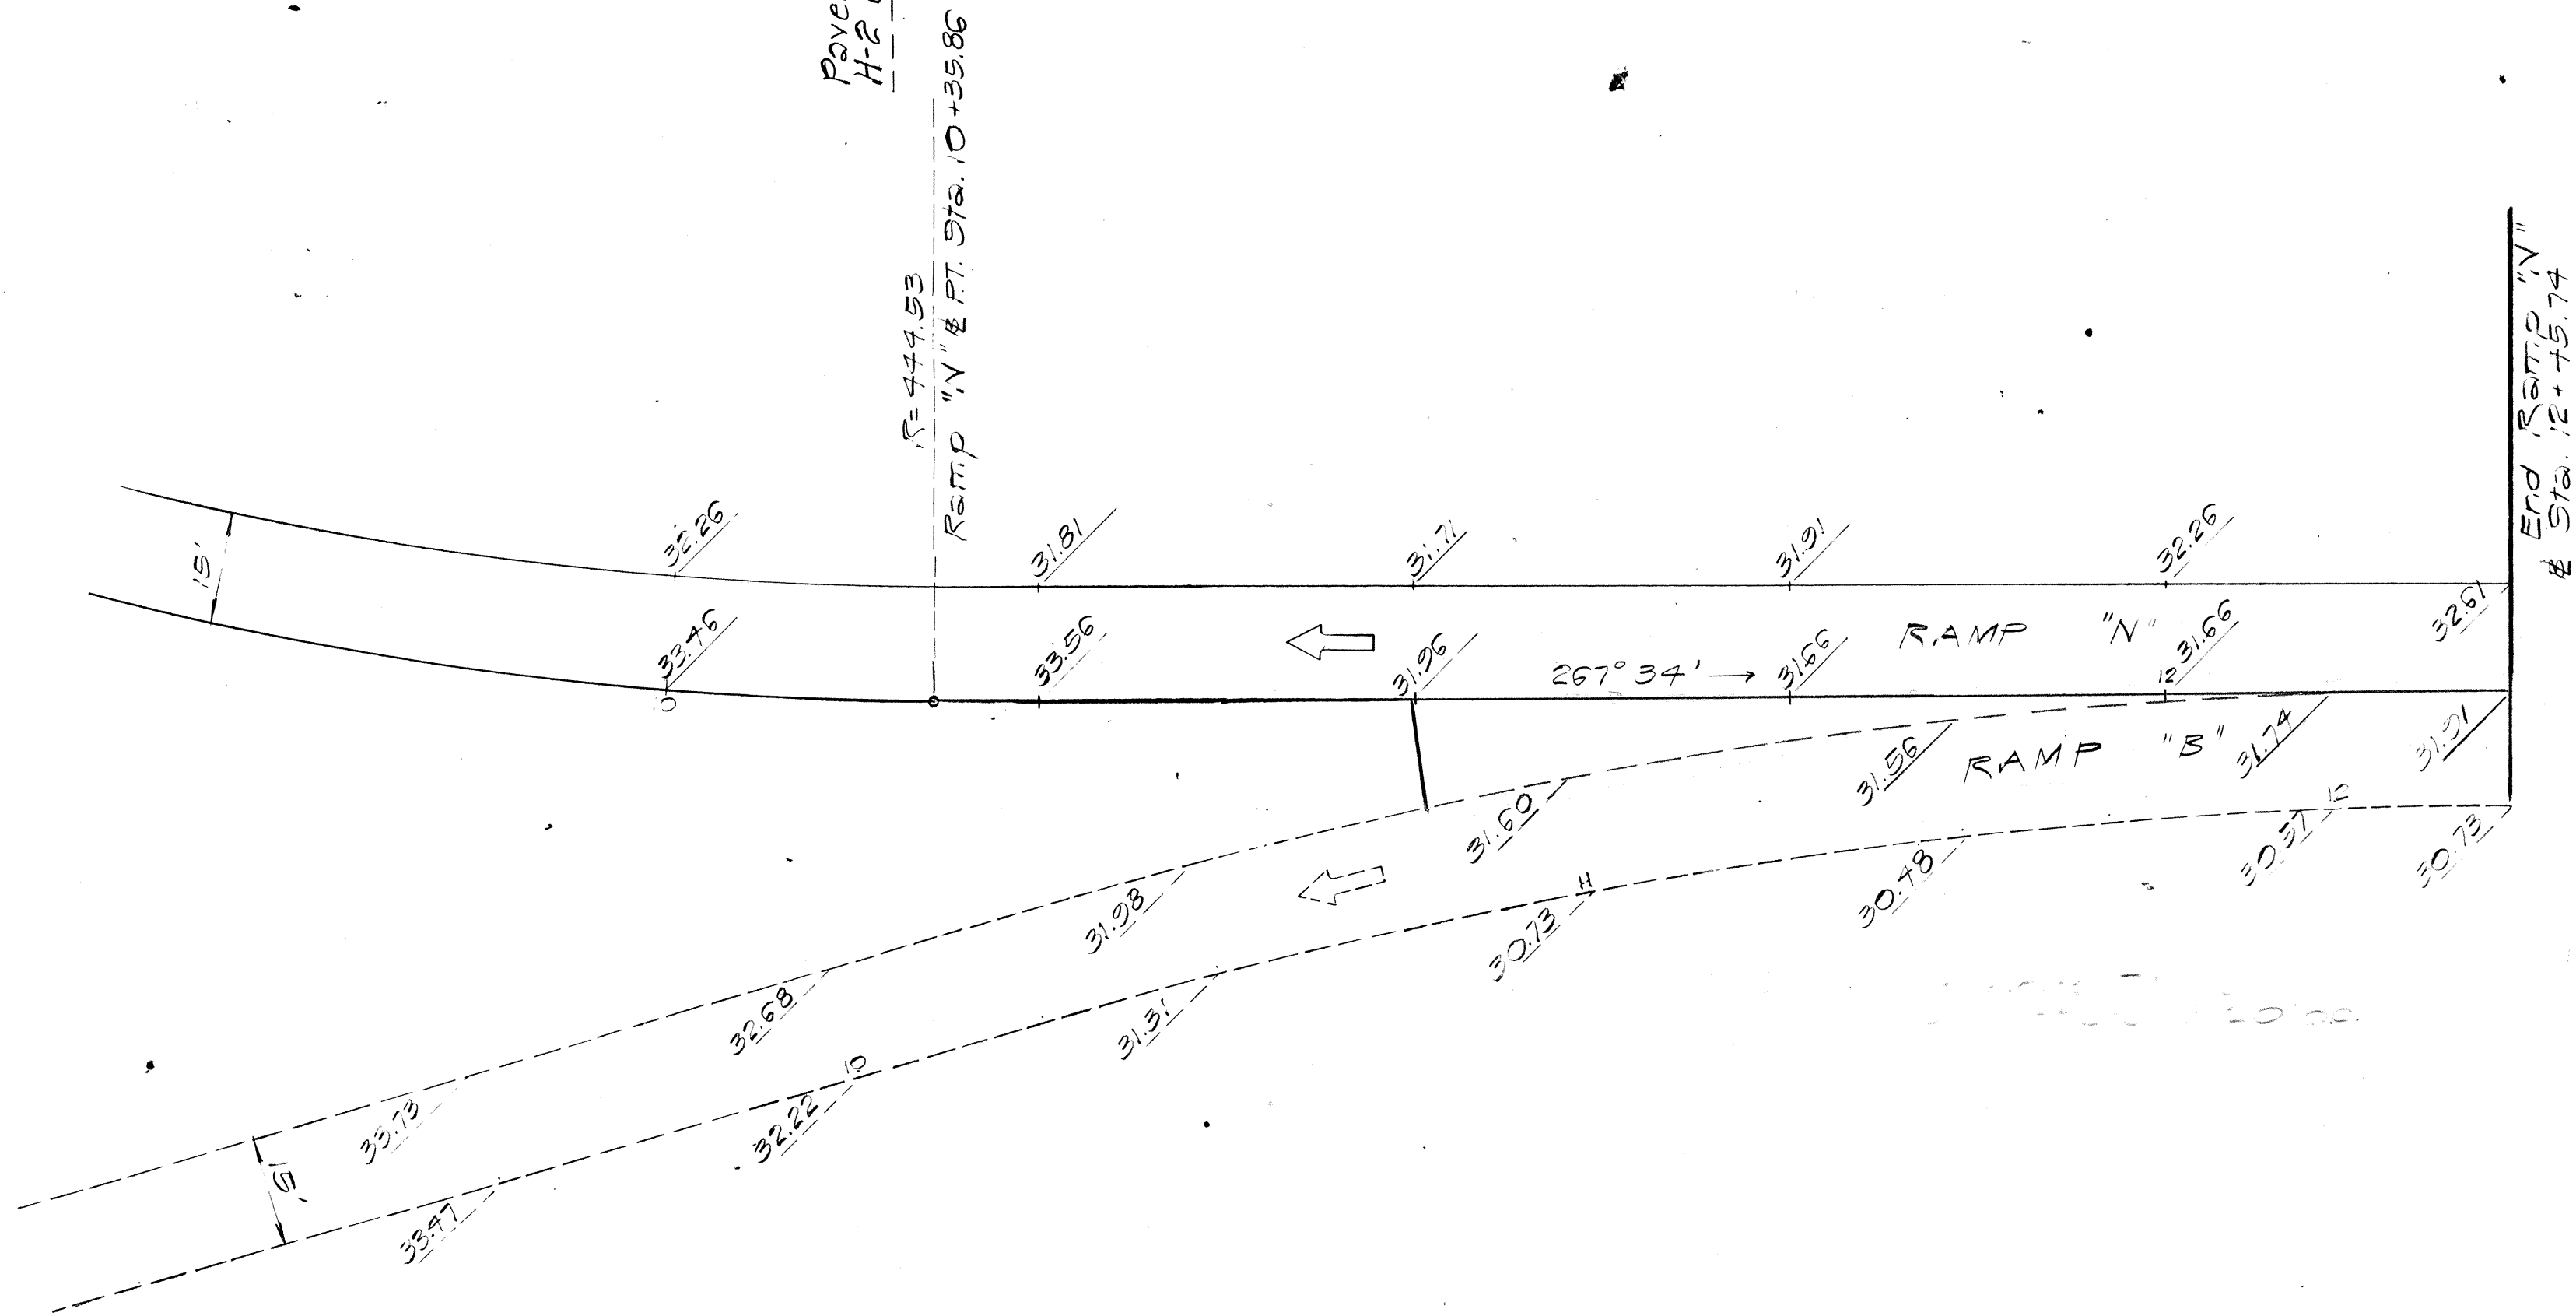

RAMP "N", RAMP "B" & EXISTING KAMEHAMEHA HIGHWAY INTERSECTIONS
SCALE: 1" = 20'

True North
Scale: 1" = 20'



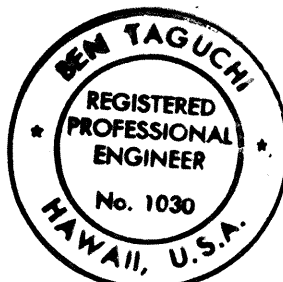


Ben Taguchi
THIS WORK WAS PREPARED BY ME
OR UNDER MY SUPERVISION.

STATE OF HAWAII
DEPARTMENT OF TRANSPORTATION
HIGHWAYS DIVISION
INTERSECTION DETAILS
Ramp N and H-2 Outbound
Ramp N, Ramp B and Existing Kam Hwy.
INTERSTATE ROUTE H-1
WAIKANA INTERCHANGE
F.A.I. Proj. No. I - H-1 - (46):8
(PAVING OF H-2 CONNECTION)
Scale: As shown
Date: NOV. 1969
SHEET No. 1 OF 2 SHEETS

Revised: Feb. 1973

$\Delta = 109^{\circ} 29' 30''$
 $\frac{1}{2} \Delta = 54^{\circ} 44' 45''$
 $R = 75.00$
 $T = 106.11$
 $LC = 143.32$
 $Ch = 122.49$

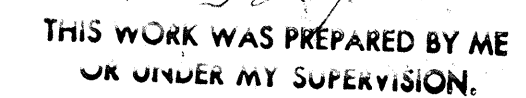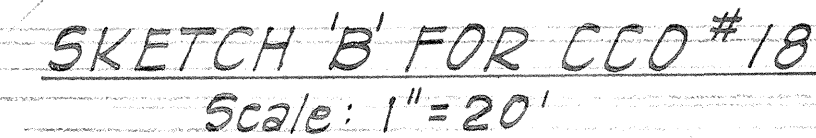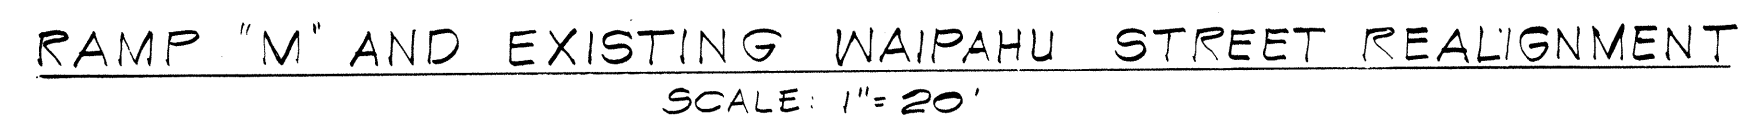

SHEET No. 2 OF 2 SHEETS