

NOTE: EXIT NUMBER PANELS

- Exit Number Panels installed on existing signs shall conform to plans and specification for the type sign (ground mounted or overhead) it is installed with.
- Letters, numerals, symbols, and borders shall be aluminum cutouts with high intensity reflective sheeting on green reflective background (ground mounted signs) or green porcelain enamel background (overhead signs)
- For Details see Sheet No. 78

EXPRESSWAY & DESTINATION SIGN CONVERSION

FED. ROAD DIST. NO.	STATE	FED. AID PROJ. NO.	FISCAL YEAR	SHEET NO.	TOTAL SHEETS
HAWAII	HAW.	IHI-1(46):8	1973	35	104

LEGEND:

- (A) Refers to "A" below

 - Remove Existing Legend
 - Install Milepost Exit Number Panel On Exist. Sign. Payment under Item Nos. 621.01 & 621.02.
 - Install New Ground-Mounted Exit Gore Sign. Payment under Item Nos. 621.02 & 621.13.
 - Remove Sign, Posts, and foundation (if any) when H-2 connection is opened to traffic.
 - Install Aluminum Cutout Legend. See Note 5 below.
 - Install New Overlay Panel (1) through (13). See Details, sheet No. 210
 - To be covered until H-2 connection is opened to traffic.
- Portion of Existing Sign to be worked on.

GENERAL NOTES:

- Existing legend to be removed not shown. Only final sign legend shown.
- Material to be removed shall be stockpiled at the direction of the Engineer.
- Sign panels shall be cleaned before installation of cutouts or overlay panels.
- Rivet holes not used in sign panels shall be plugged.
- Aluminum cutout legend and details shall be State-furnished.
- All work will be paid for under Contract Item No. 621.70, Expressway and Destination Sign Conversion except as noted.

INTERCHANGE OPENING


LEGEND:

- New H-2 Ramp Connection to be opened to traffic.

GENERAL NOTES:

- All work involved in the removal and stockpiling of existing detour signing and barricades, removal of existing striping, painting of new striping, and furnishing all other labor, materials, and equipment necessary to open the new portion of the interchange to traffic, will be paid for under Contract Item No. 690.01, Construction and Maintenance of Special Detours (F.A.I. Proj. No. IHI-1(46):8).

NOTE:
All signs installed in accordance to this sheet, except sign BC modified.

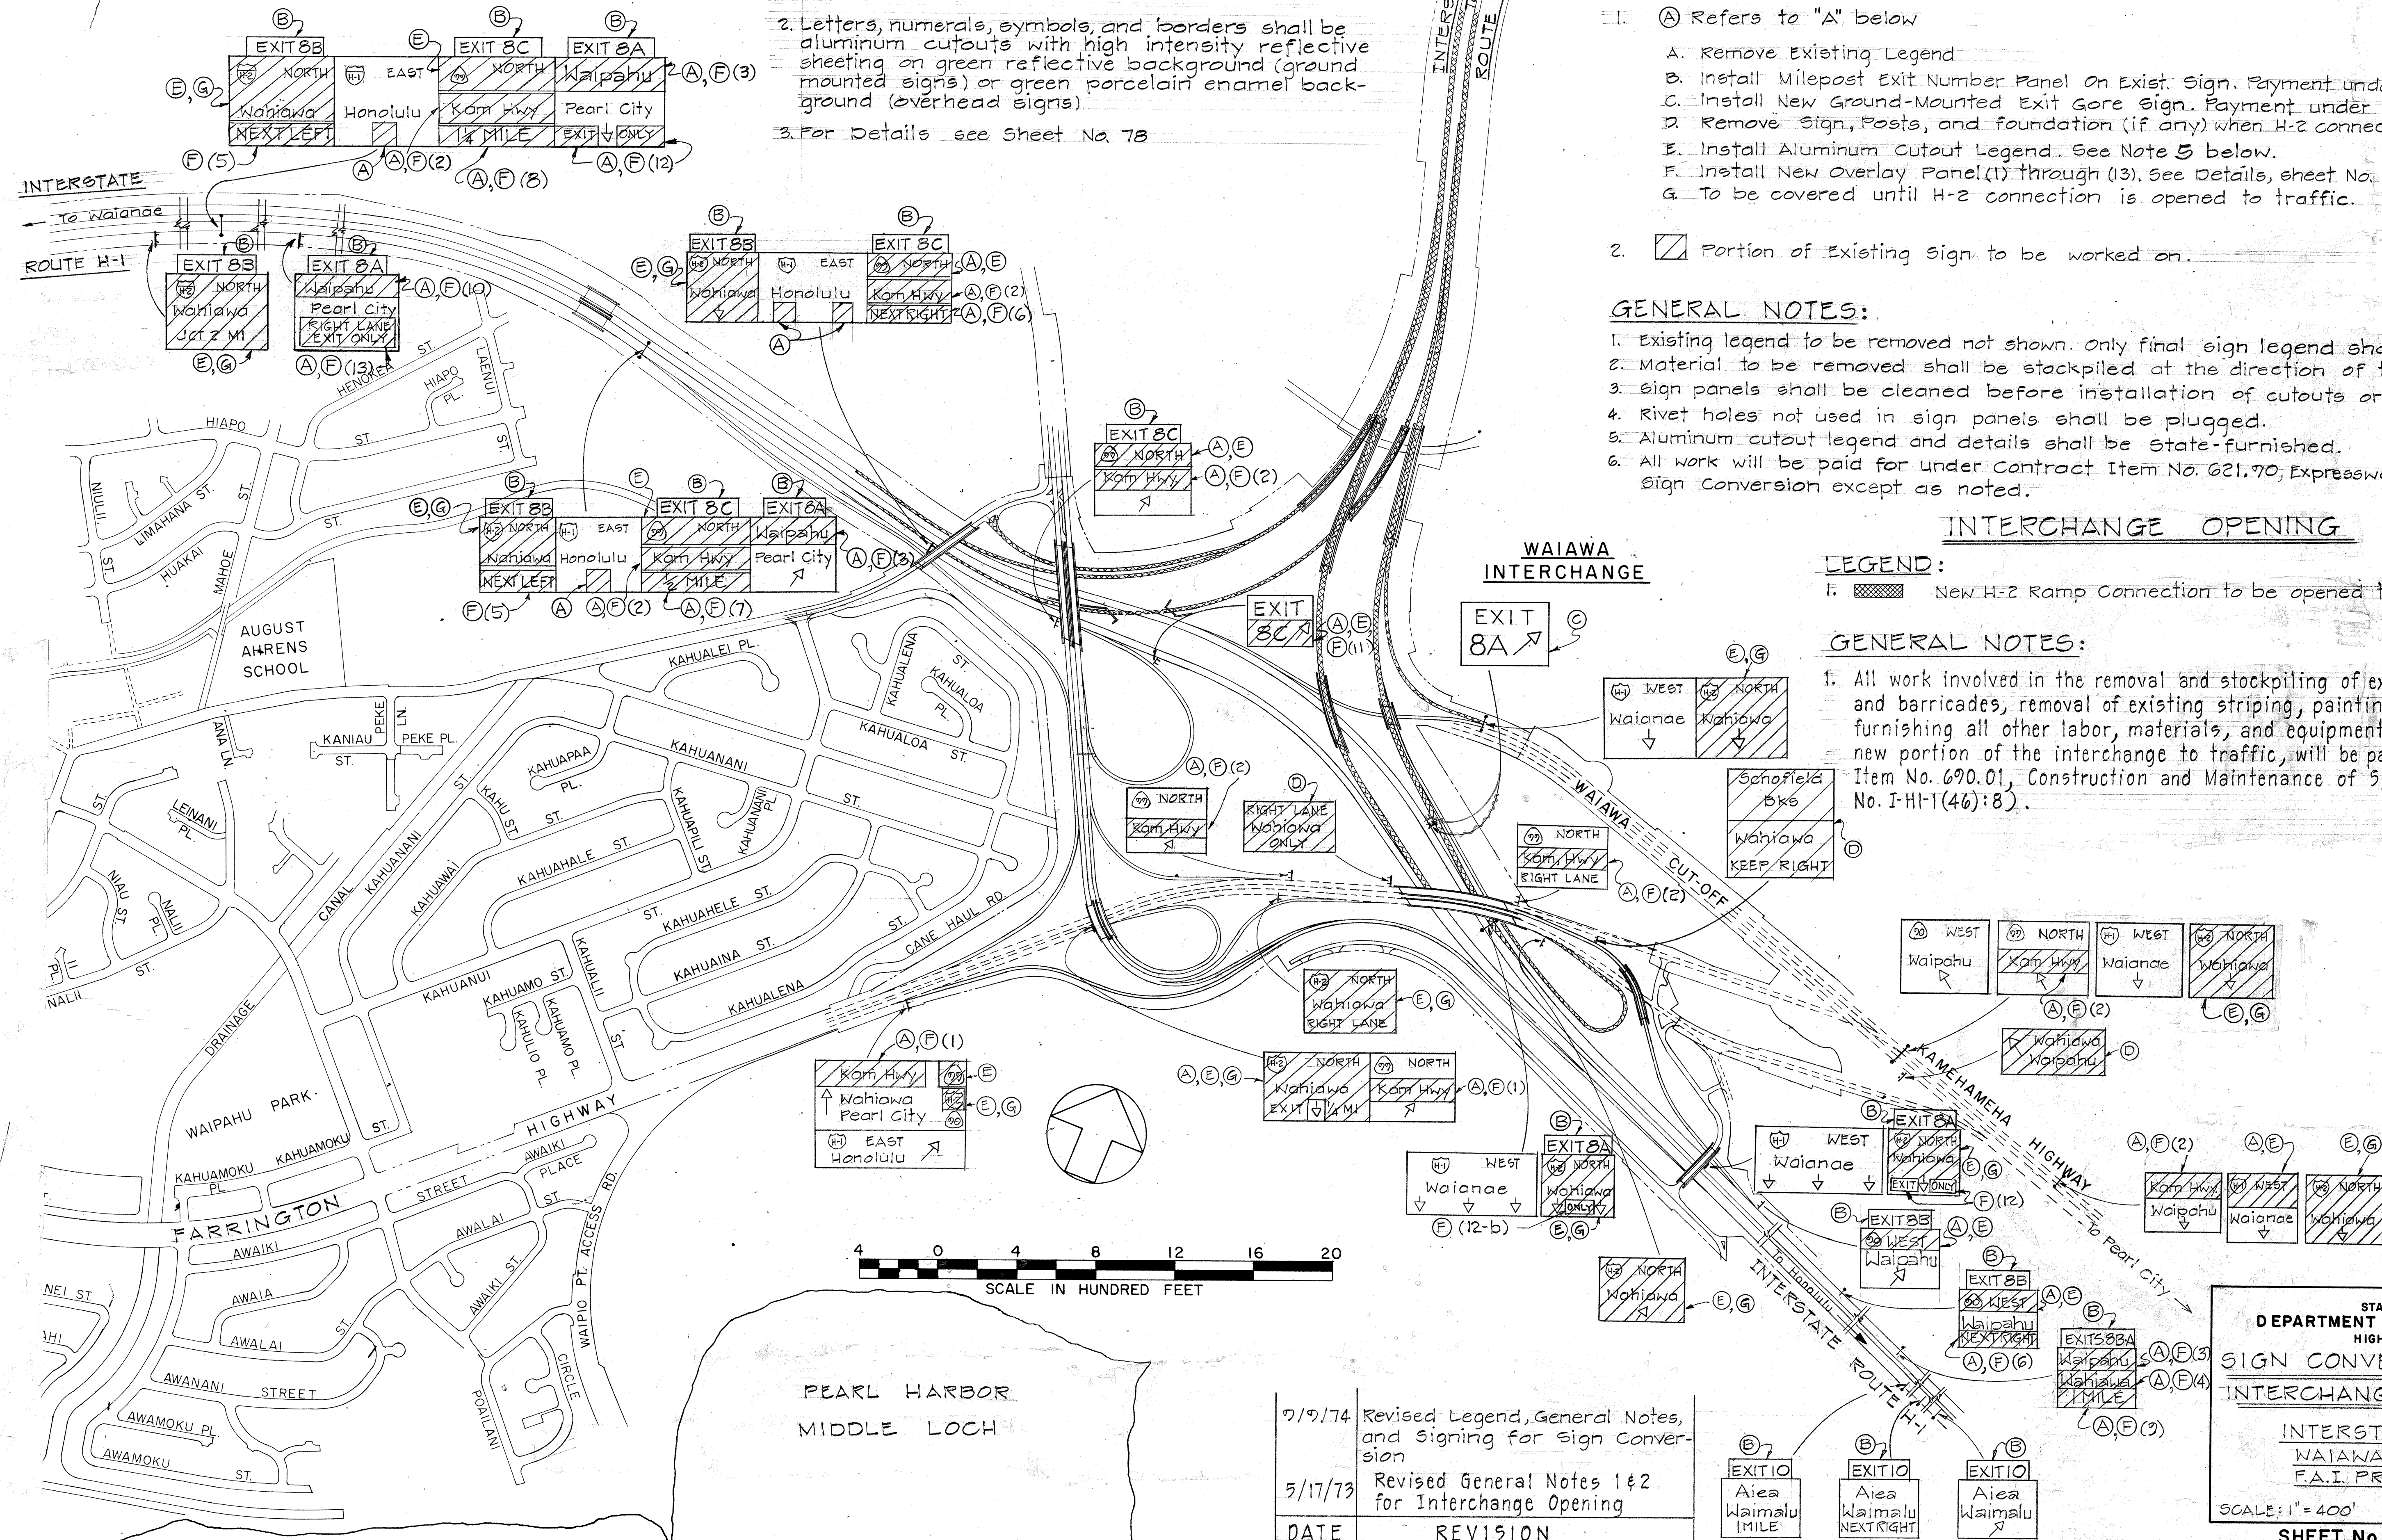

7/9/74	Revised Legend, General Notes, and Signing for Sign Conversion
5/17/73	Revised General Notes 1 & 2 for Interchange Opening
DATE	REVISION

EXIT 10	Aiea Waimalu 1 MILE
EXIT 10	Aiea Waimalu NEXT RIGHT
EXIT 10	Aiea Waimalu

C.O. A D D . 2 0 6