



FED. ROAD DIST. NO.	STATE	FED. AID PROJ. NO.	FISCAL YEAR	SHEET NO.	TOTAL SHEETS
HAWAII	HAW.	I-H1-1(46)8	1973	5	107

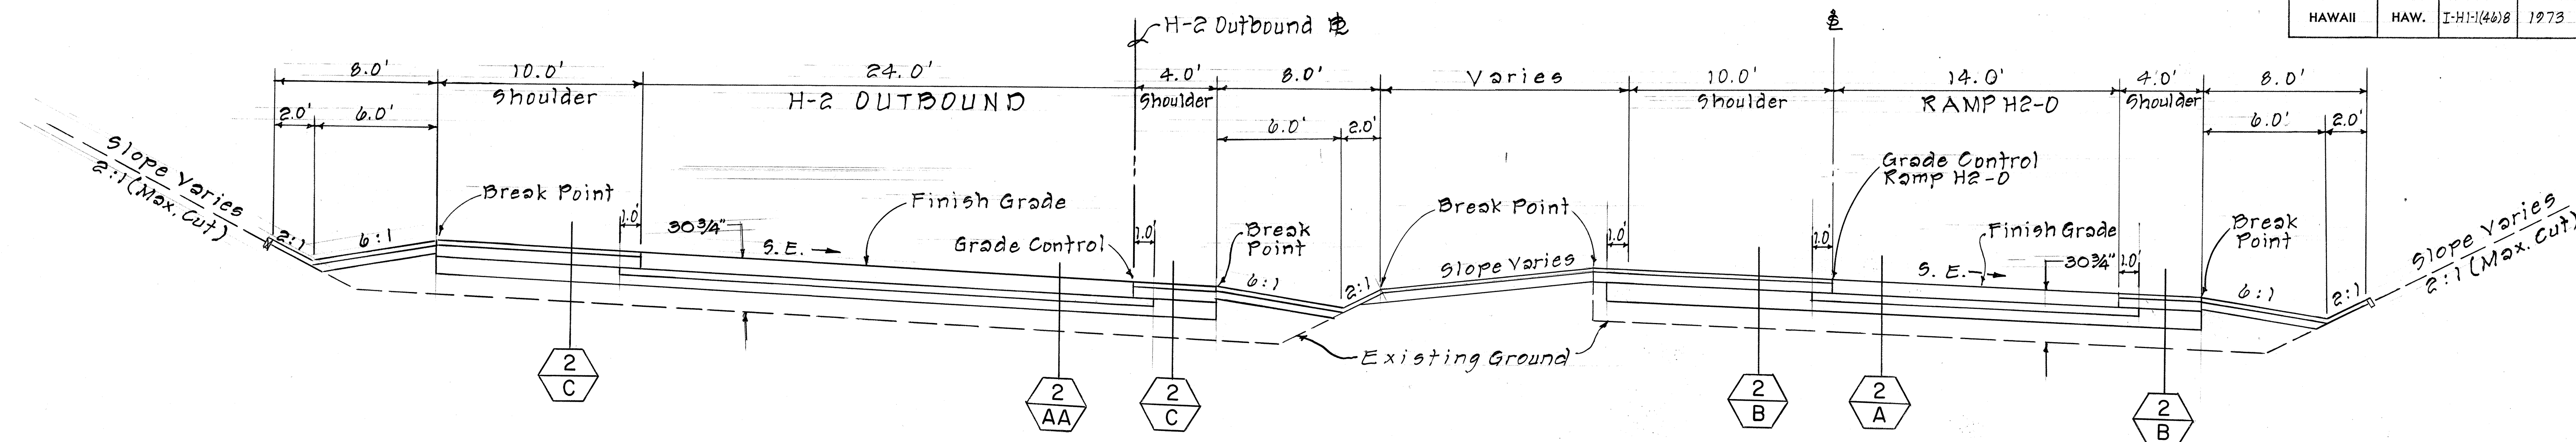


H-2 OUTBOUND Sta. 449+50 To 457+65.53

Scale: 1/4" = 1'-0"

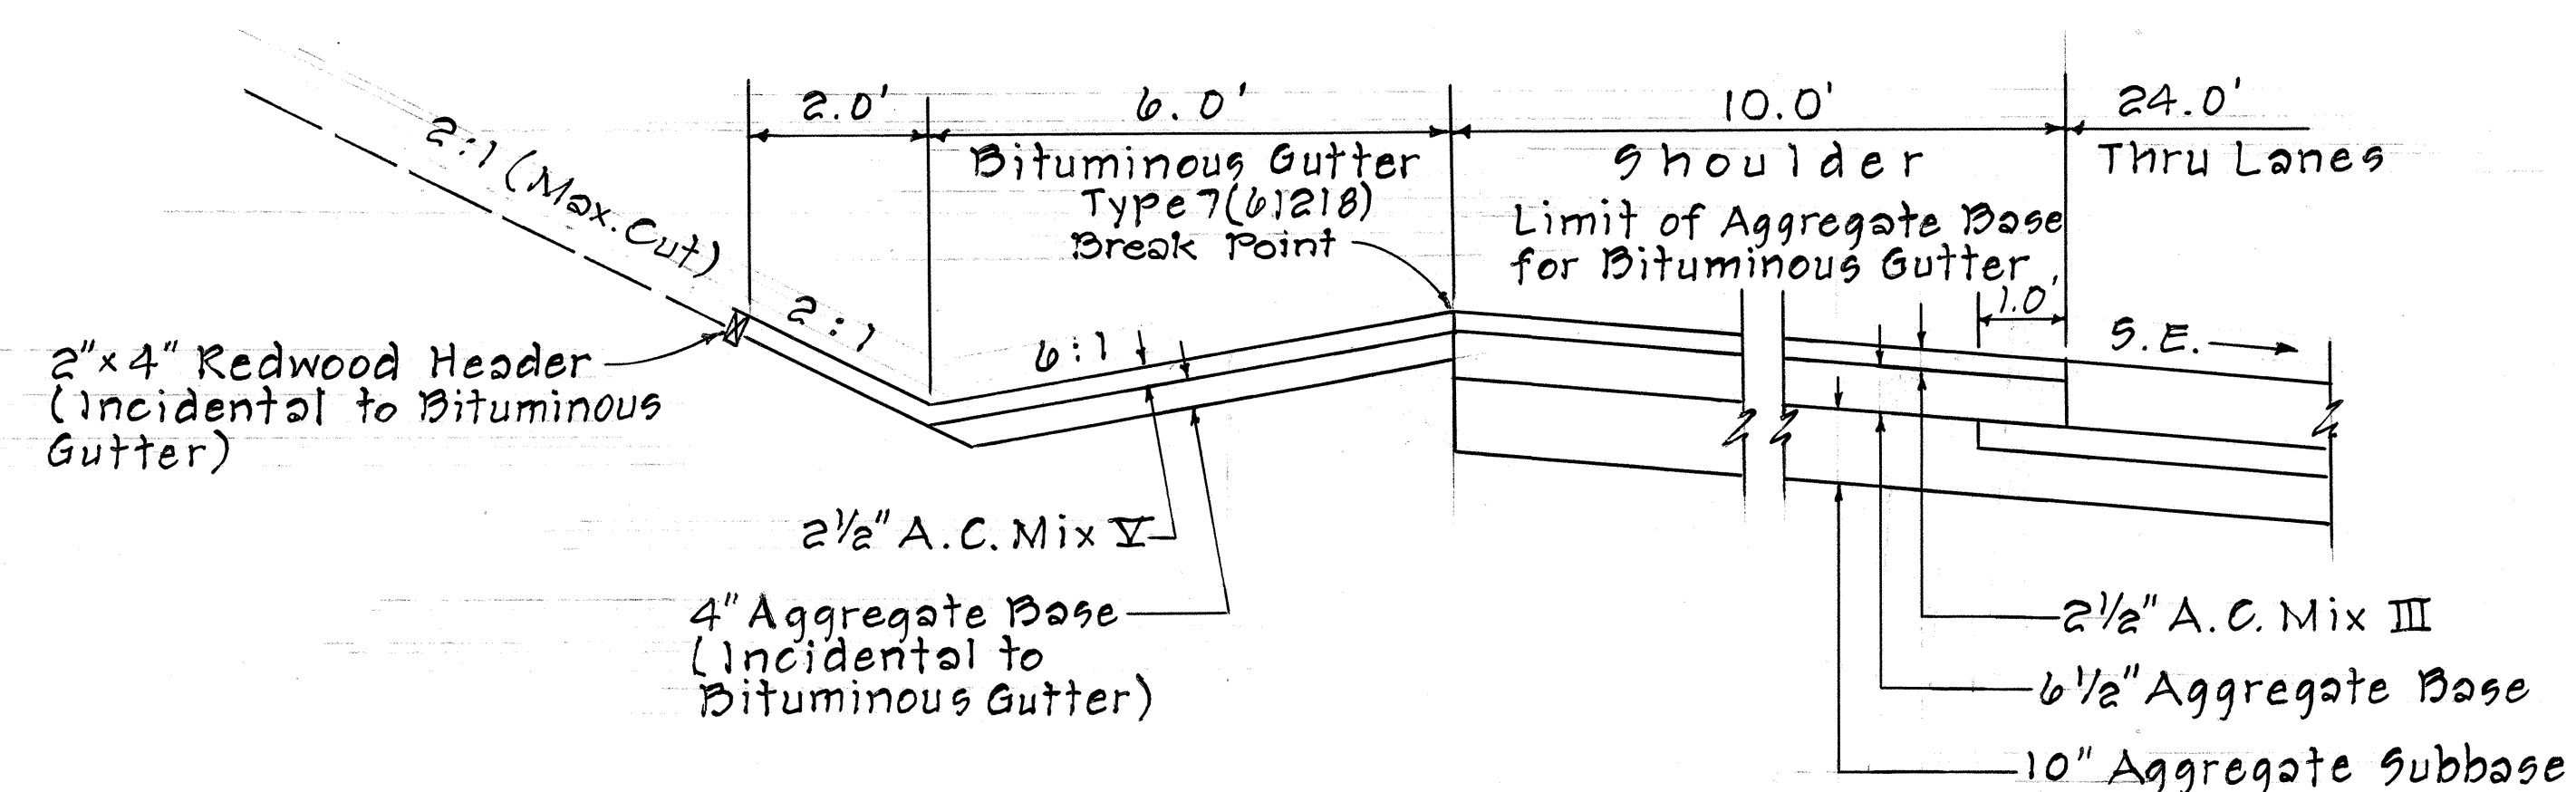


CUT SECTION (HIGH SIDE)

Scale: 1/2" = 1'-0"

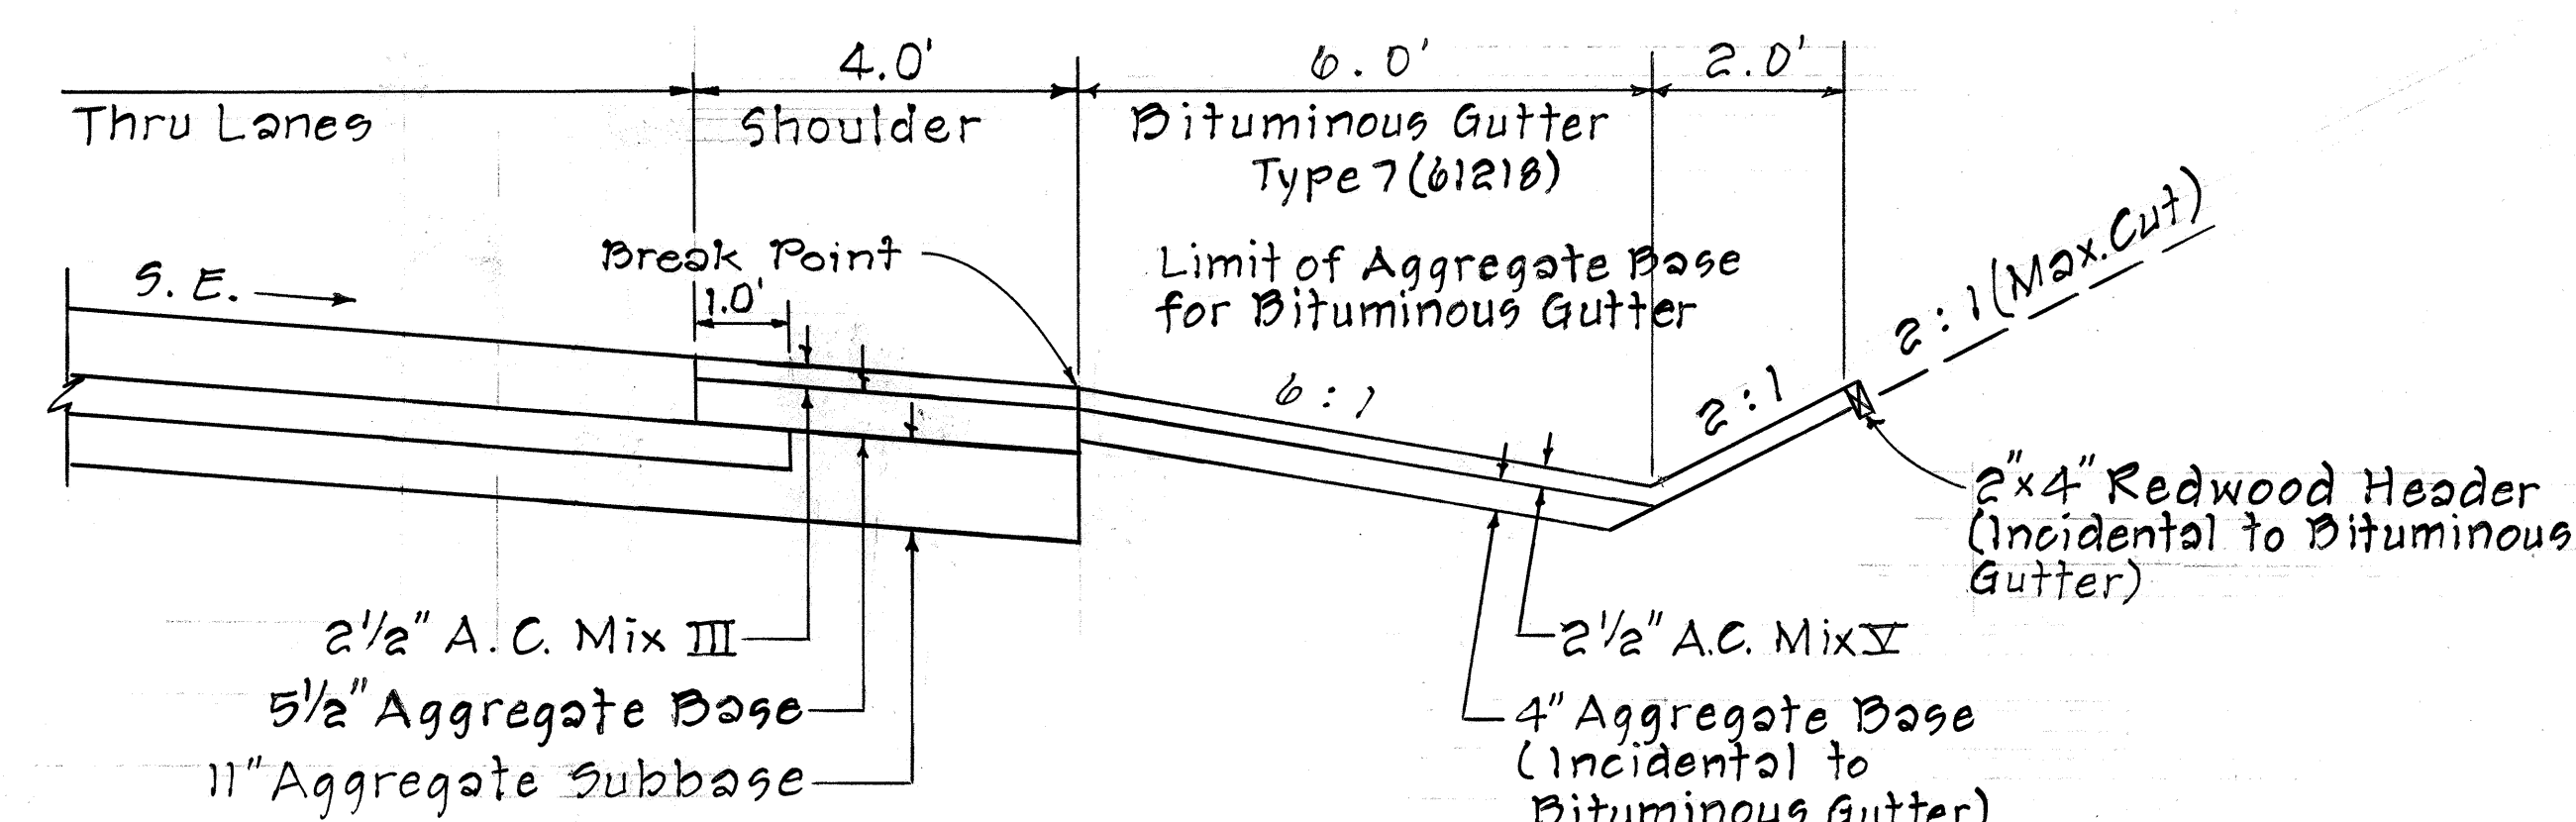


CUT SECTION (LOW SIDE)


Scale: 1/2" = 1'-0"

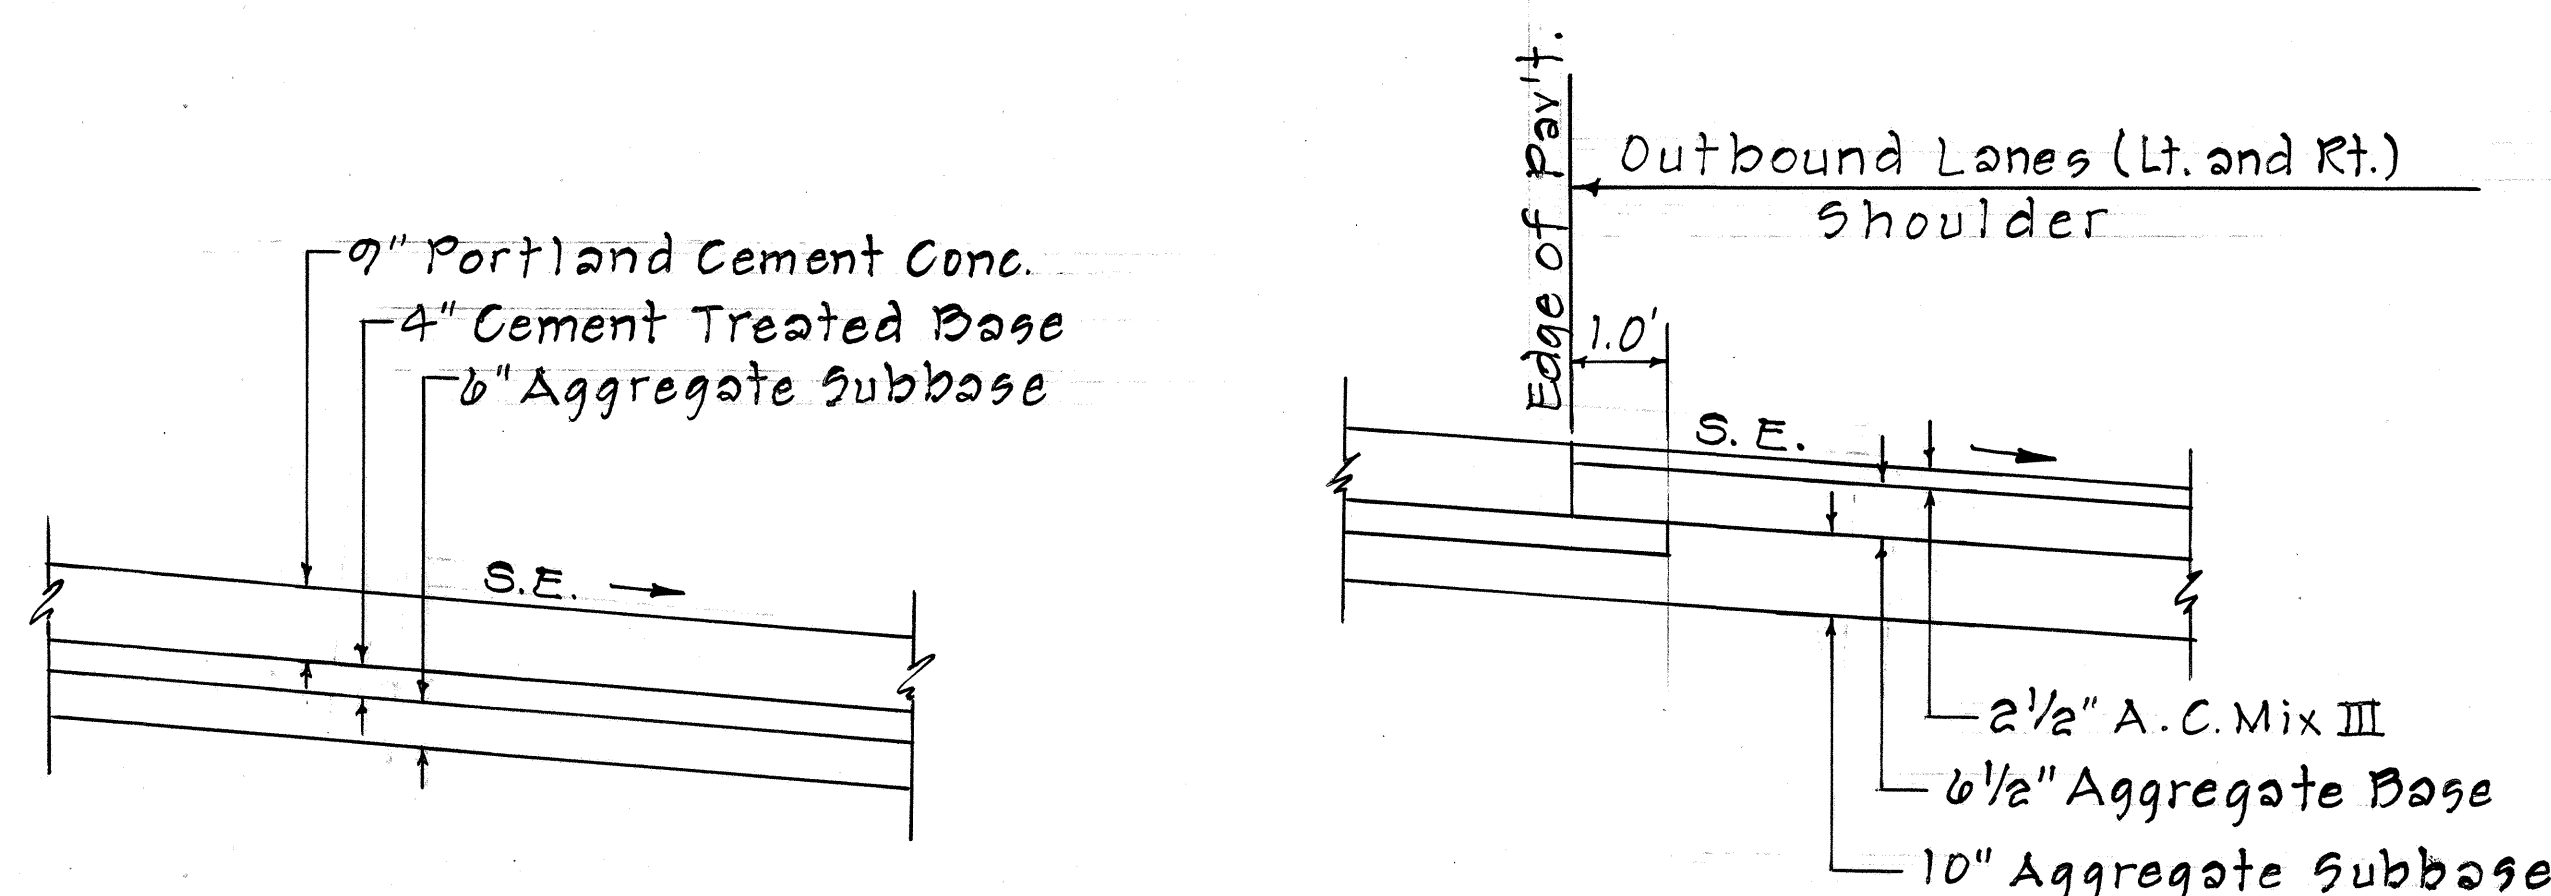


2
AA
Scale: 1/2" = 1'-0"

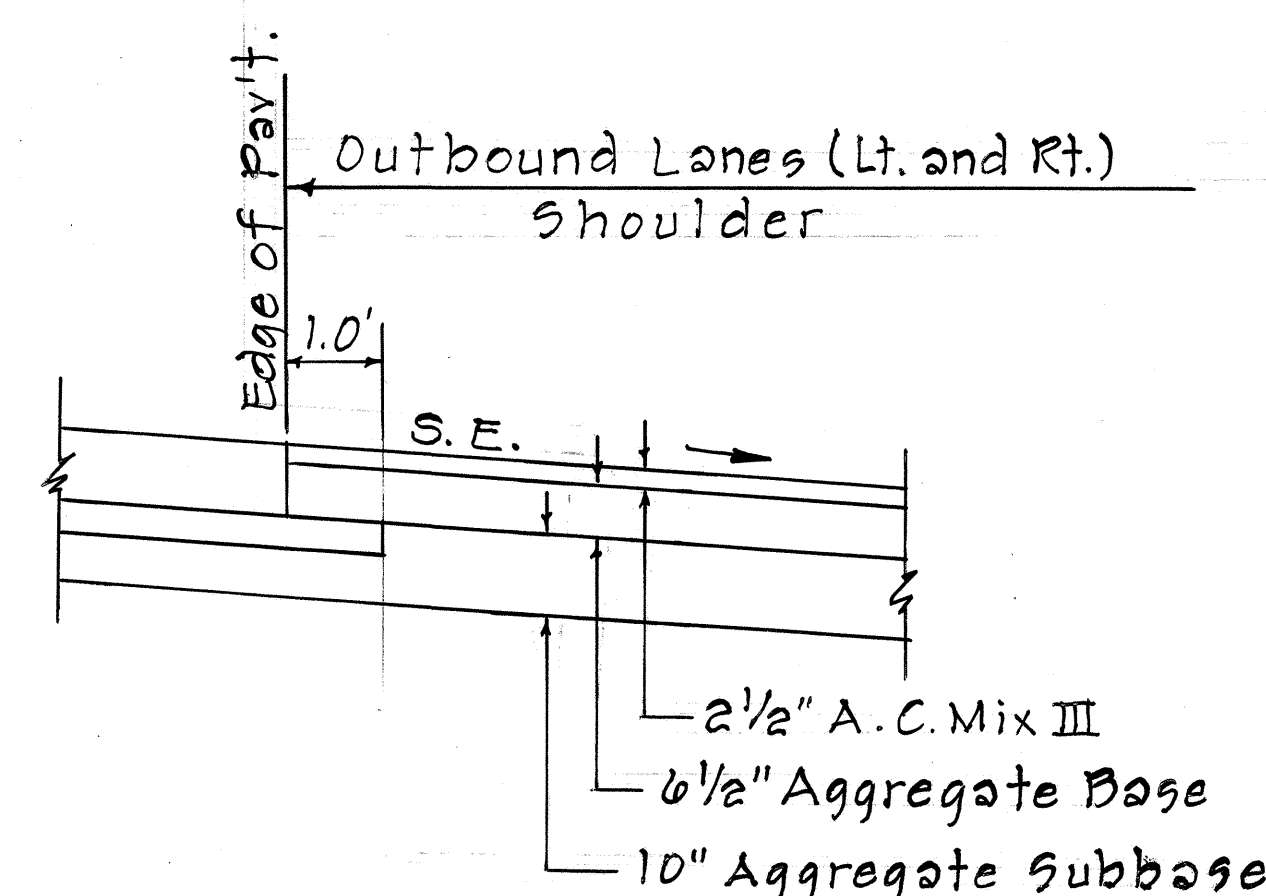

2
C
Scale: 1/2" = 1'-0"

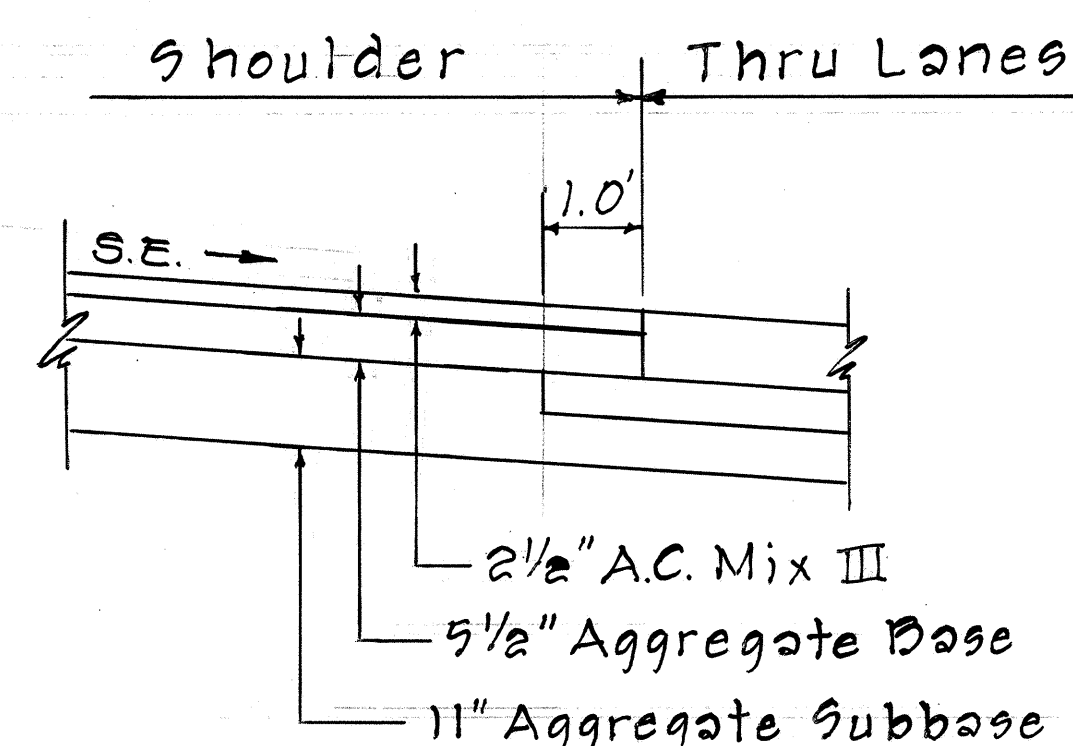

2
B
Scale: 1/2" = 1'-0"

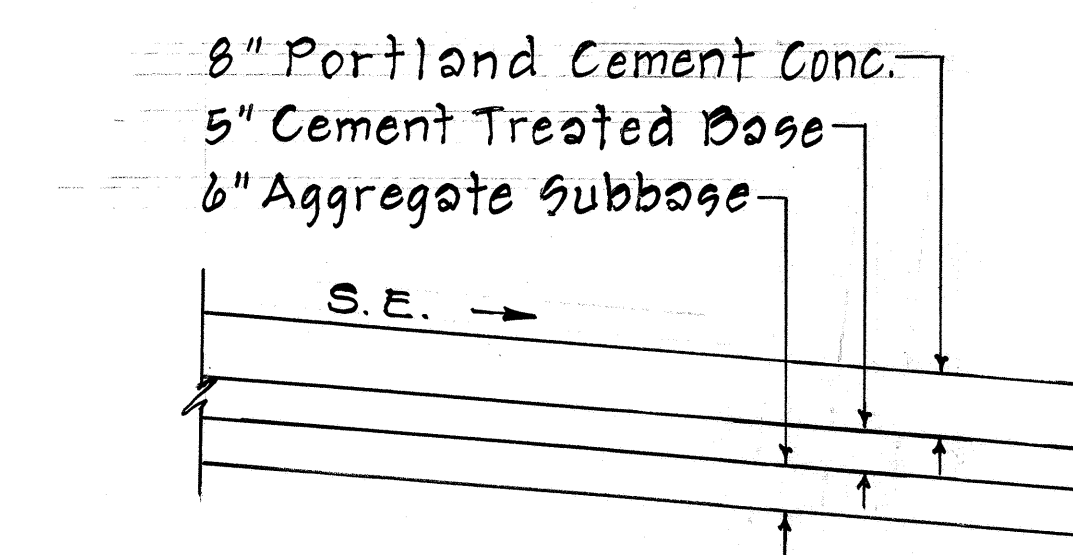

2
A
Scale: 1/2" = 1'-0"

STATE OF HAWAII
DEPARTMENT OF TRANSPORTATION
HIGHWAYS DIVISION


TYPICAL ROADWAY SECTIONS
H-2 OUTBOUND Sta. 449+50 to 457+65.53

INTERSTATE ROUTE H-1
WAIKAWA INTERCHANGE
F.A.I. Proj No. I-H1-1(46):8
(PAVING OF H-2 CONNECTION)

Scale: As shown


SHEET No. 2 OF 5 SHEETS

FED. ROAD DIST. NO.	STATE	FED. AID PROJ. NO.	FISCAL YEAR	SHEET NO.	TOTAL SHEETS
HAWAII	HAW.	I-H-1(46):8	1979	6	104

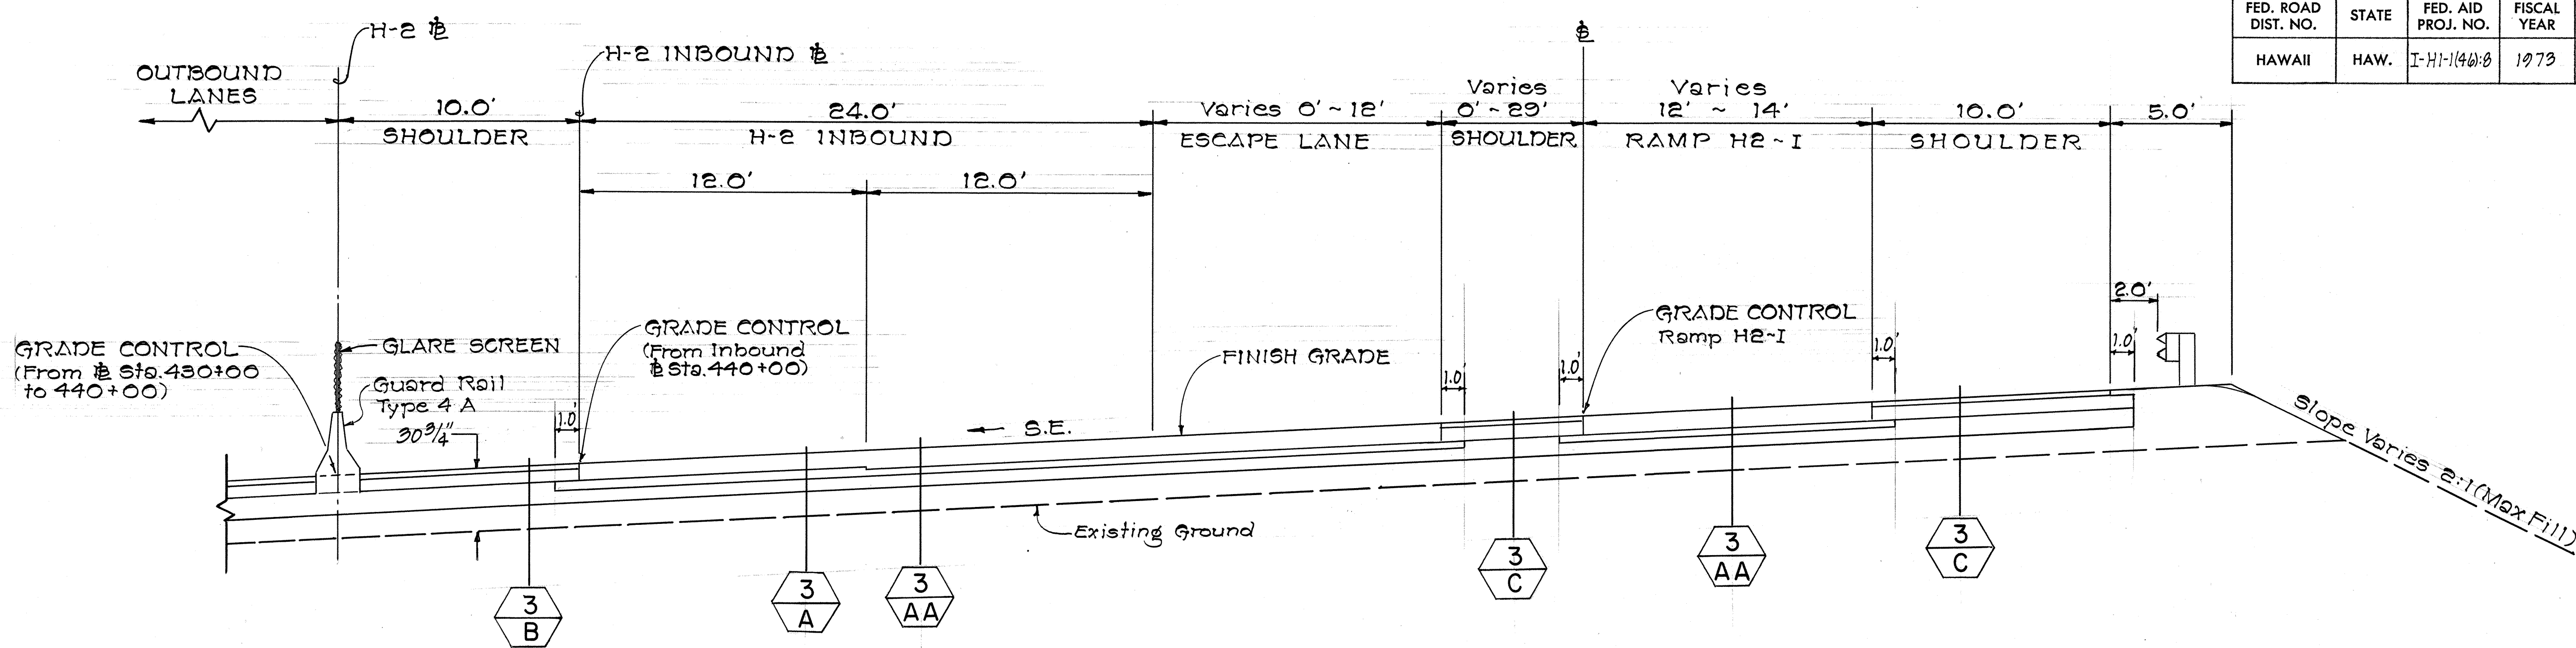


H-2 INBOUND Sta. 431+71.61 To 445+80

Scale: 1/4" = 1'-0"

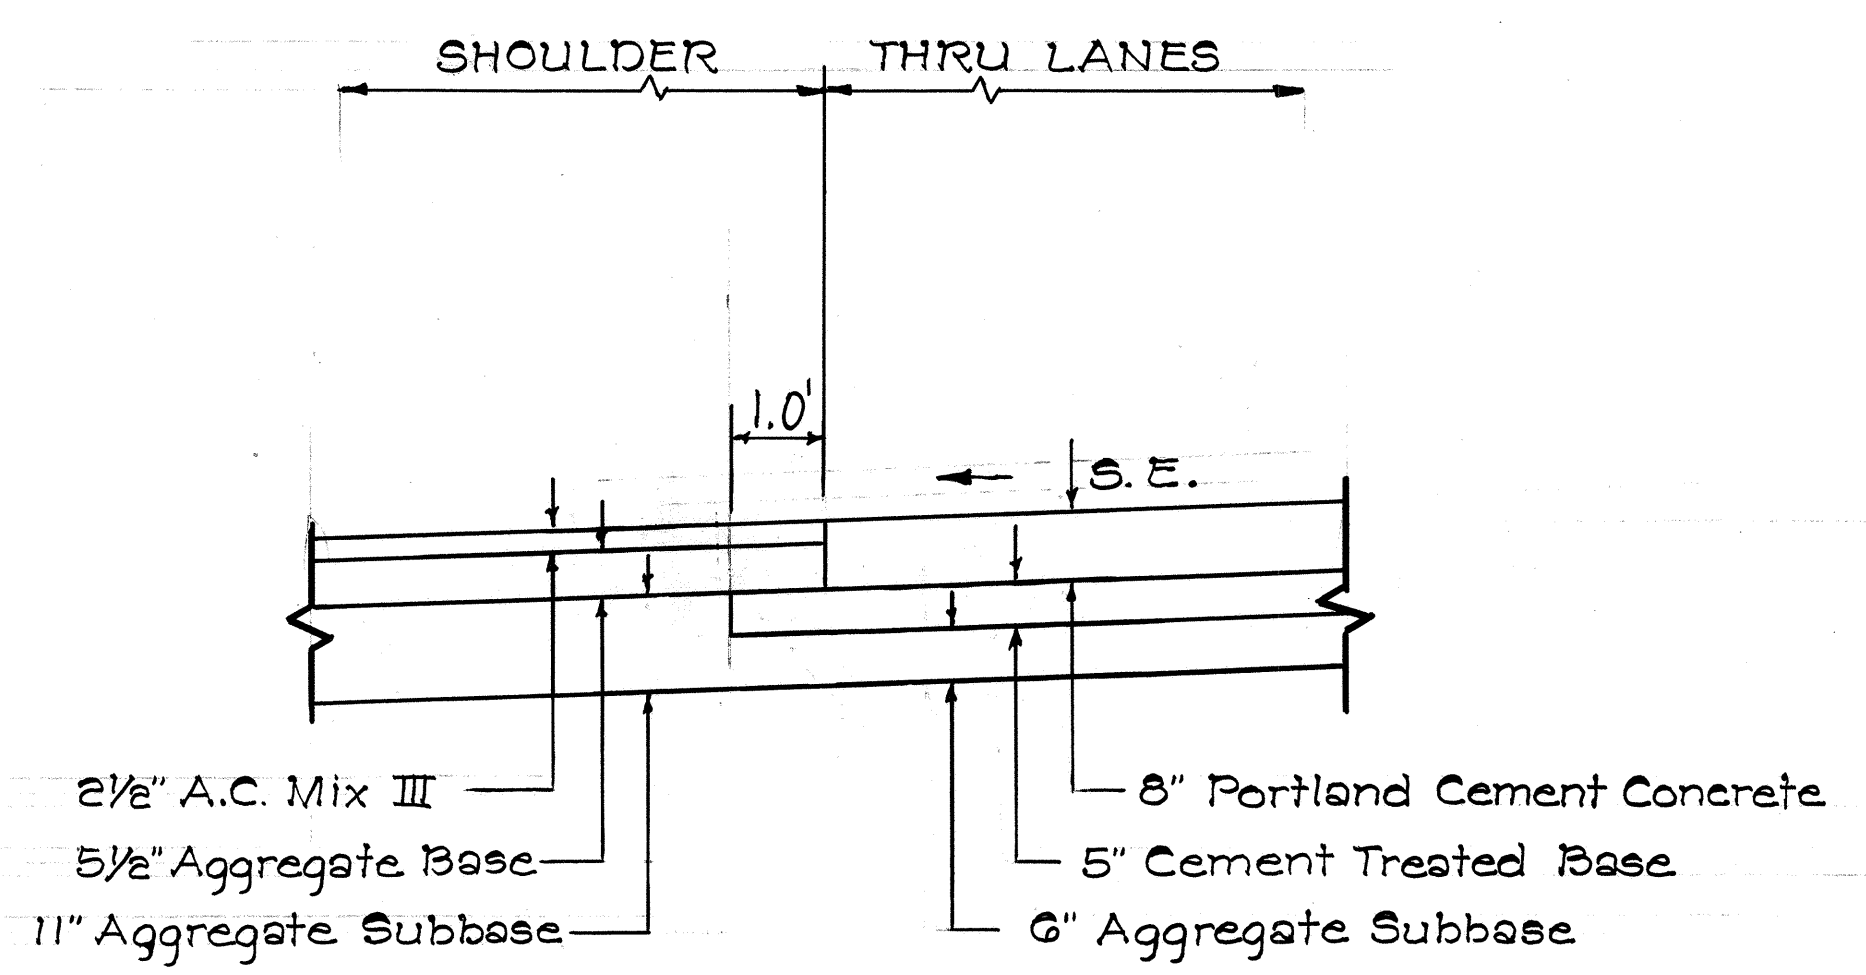


3 B

Scale: 1/2" = 1'-0"

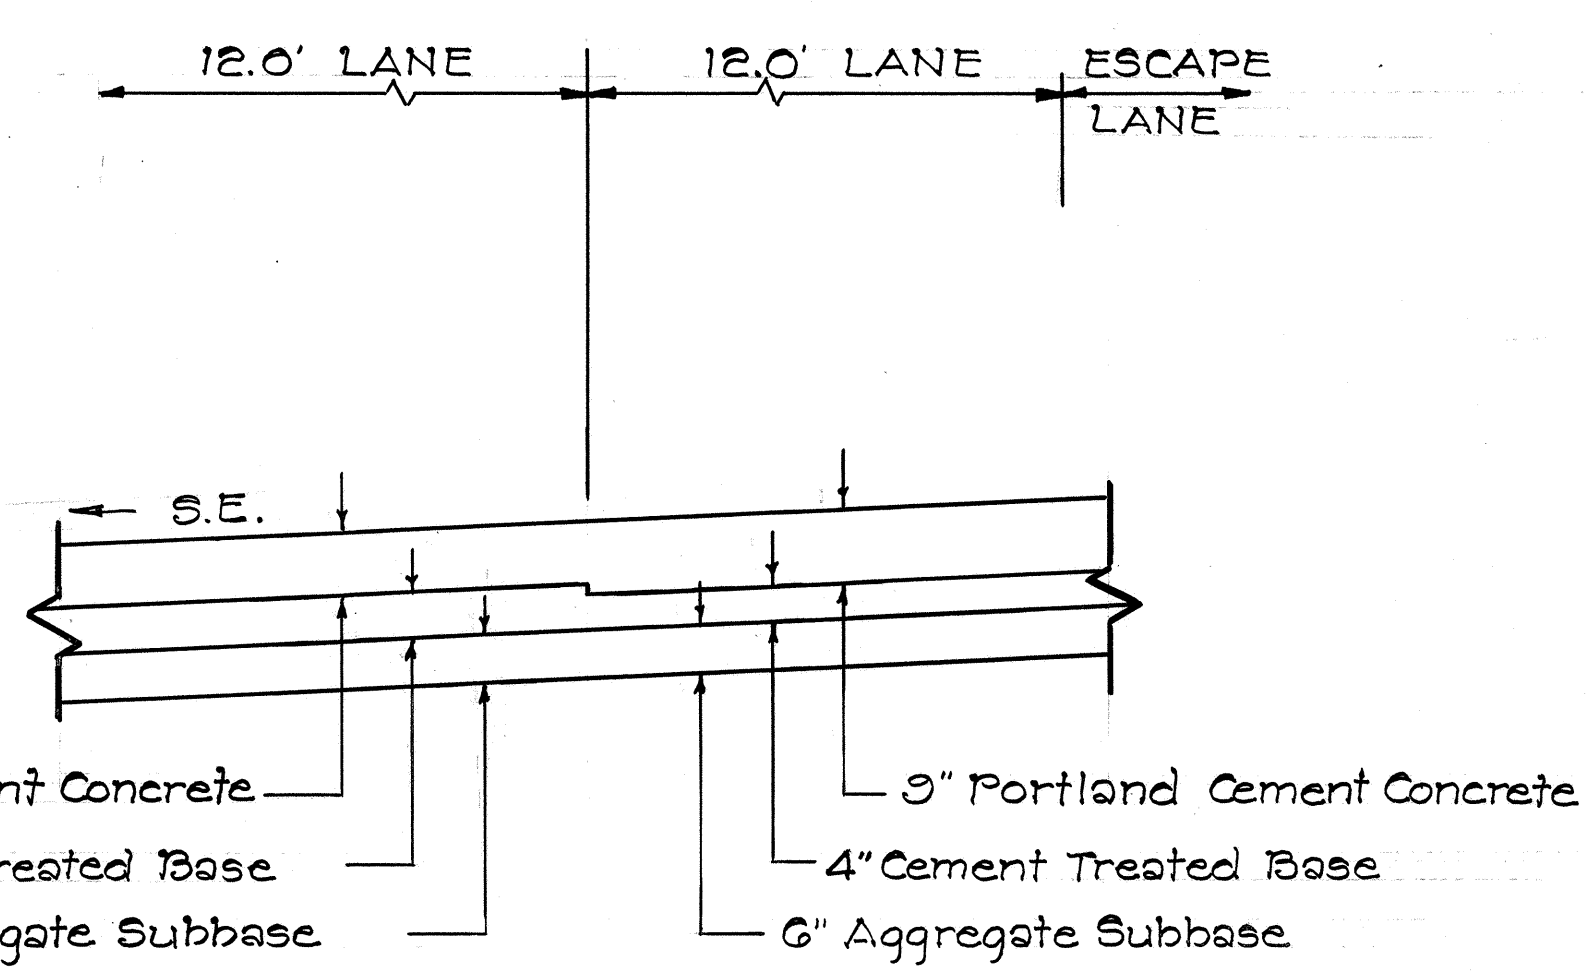


3 A

Scale: 1/2" = 1'-0"

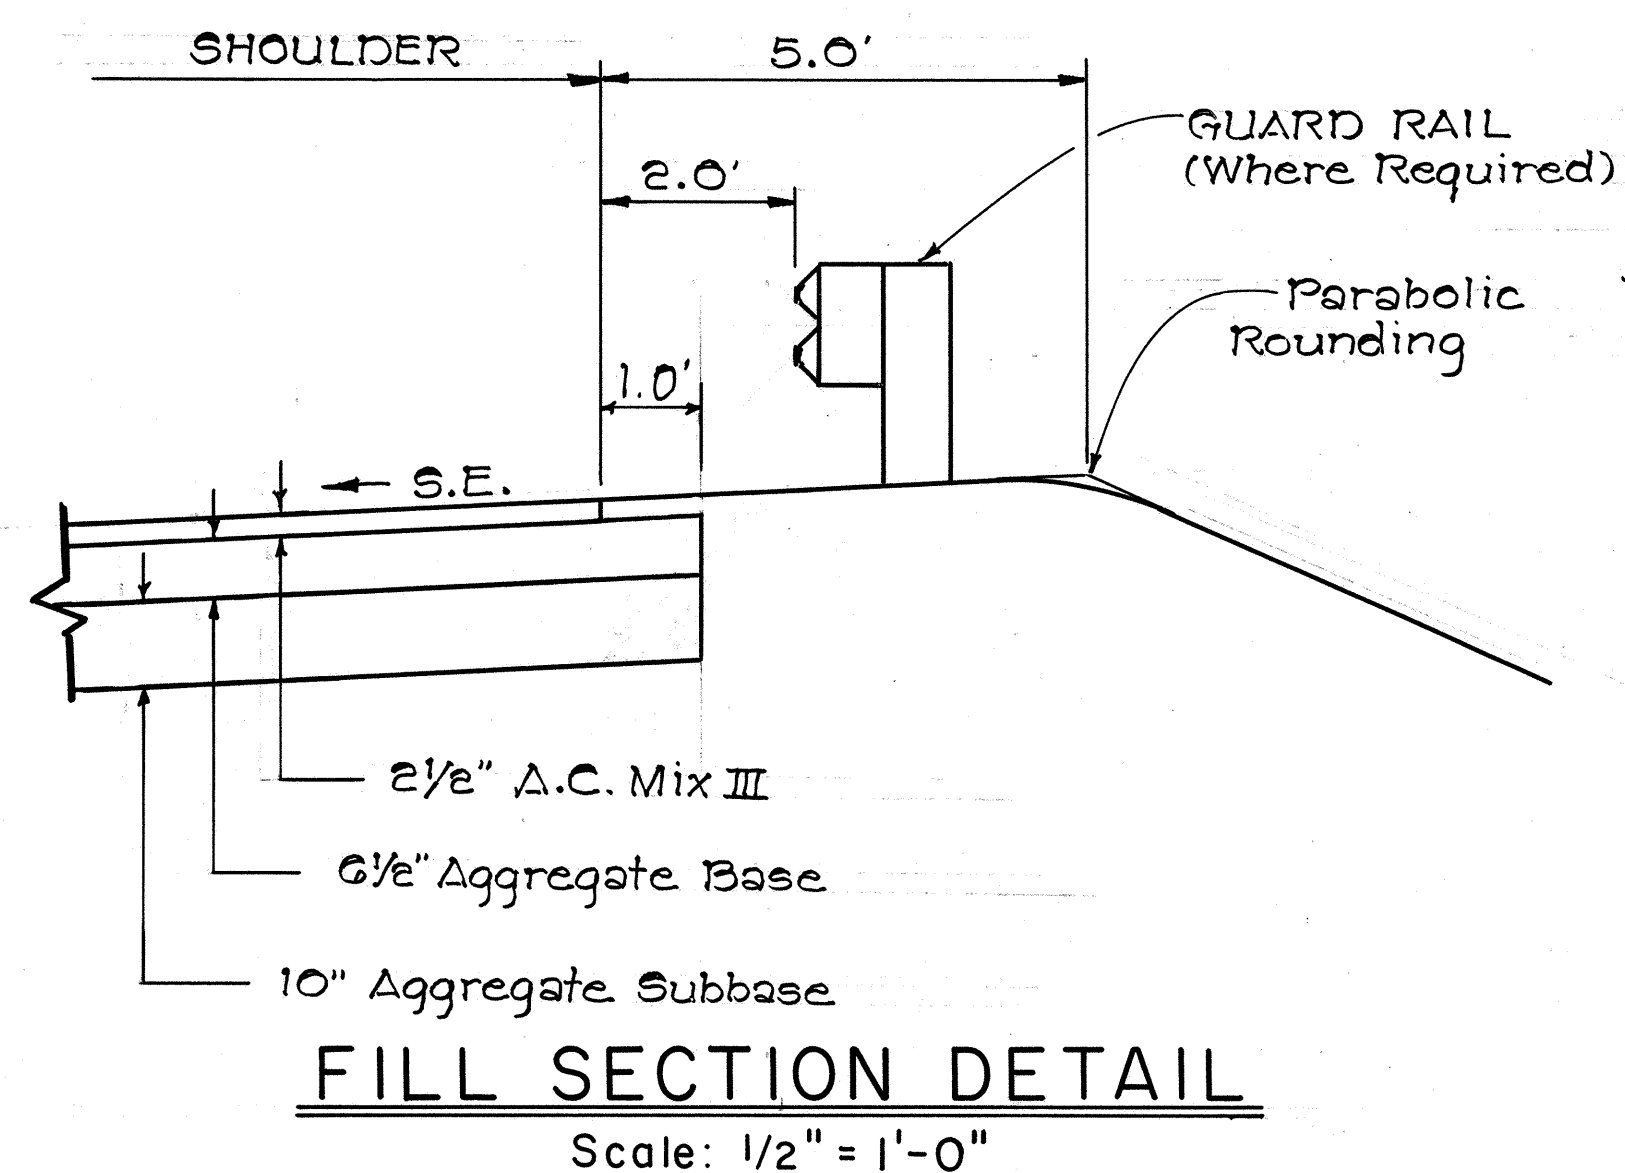


FILL SECTION DETAIL

Scale: 1/2" = 1'-0"

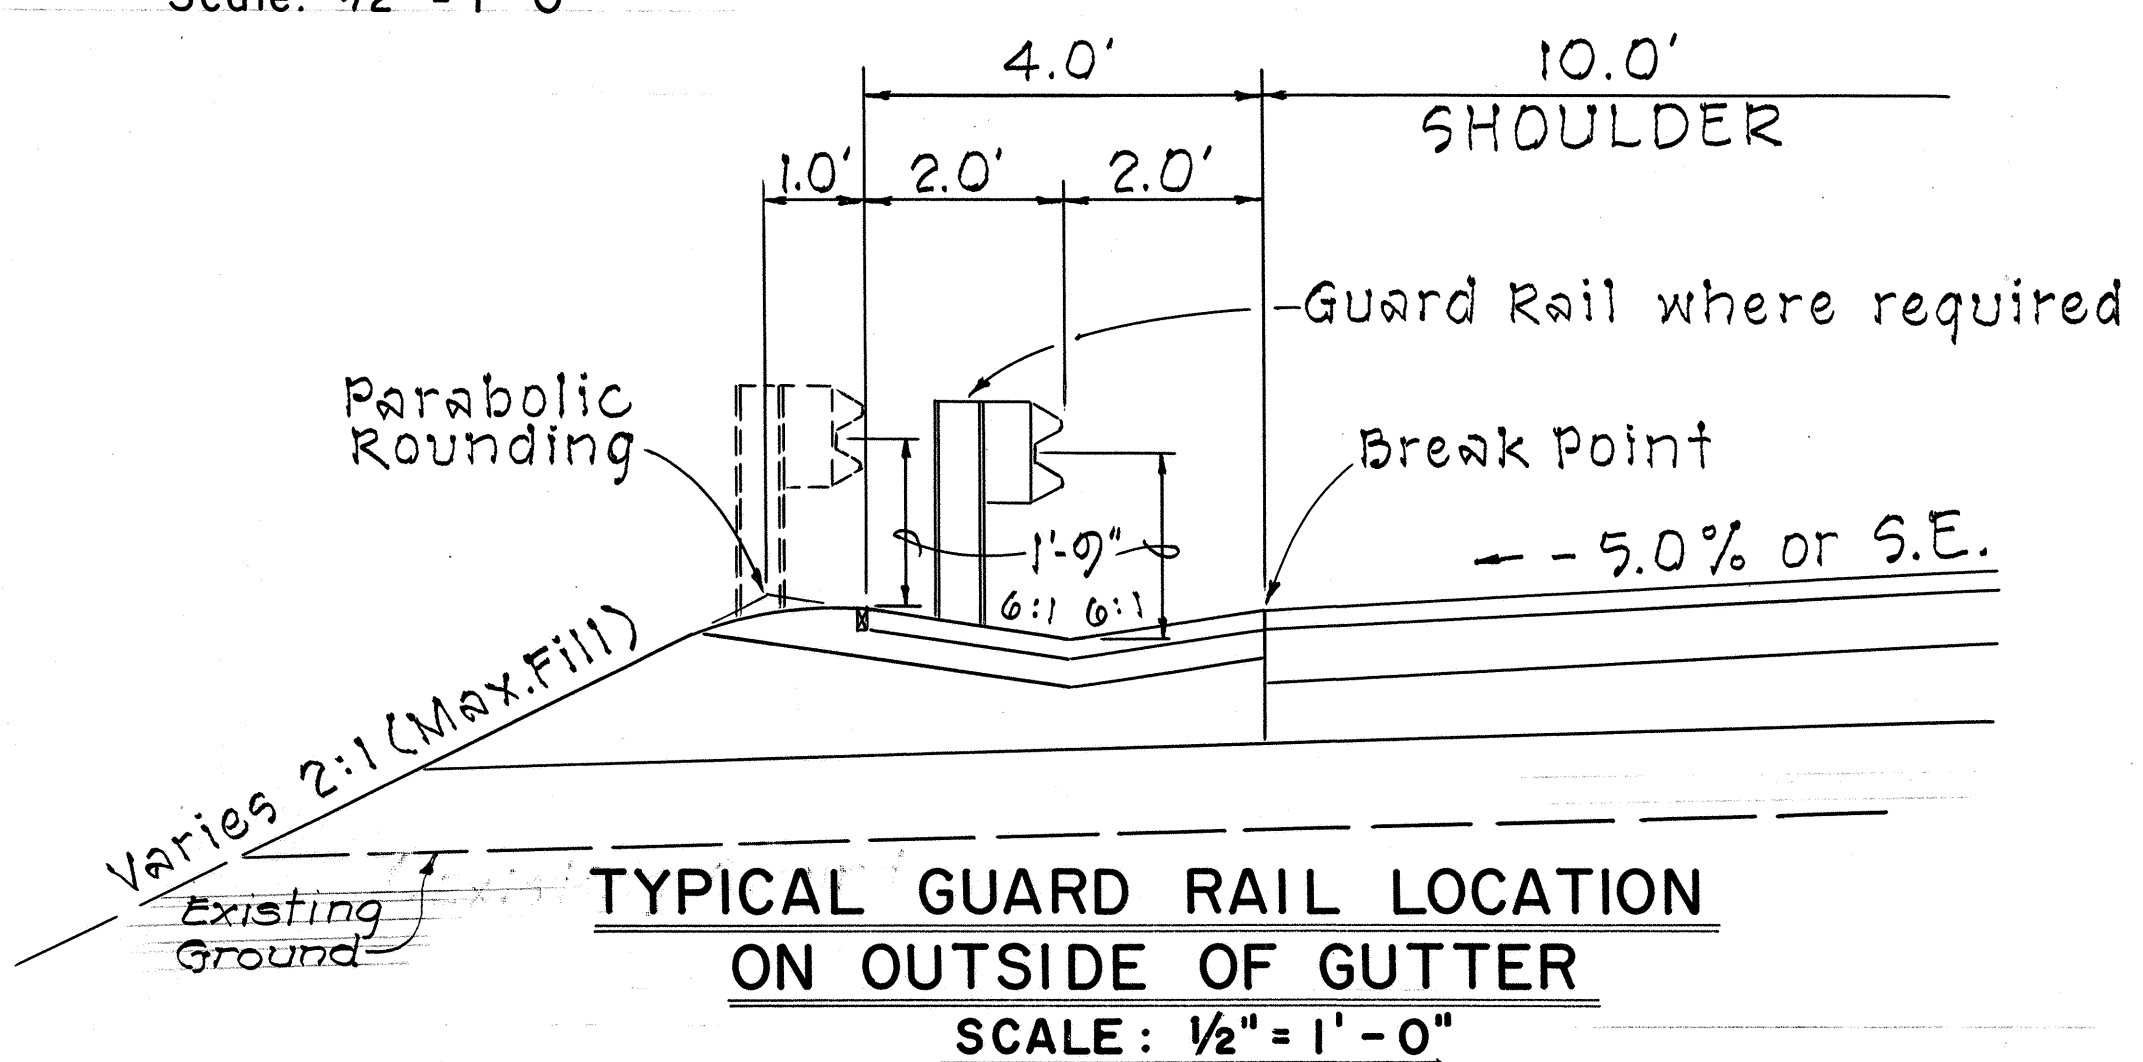

TYPICAL GUARD RAIL LOCATION ON OUTSIDE OF GUTTER

SCALE: 1/2" = 1'-0"

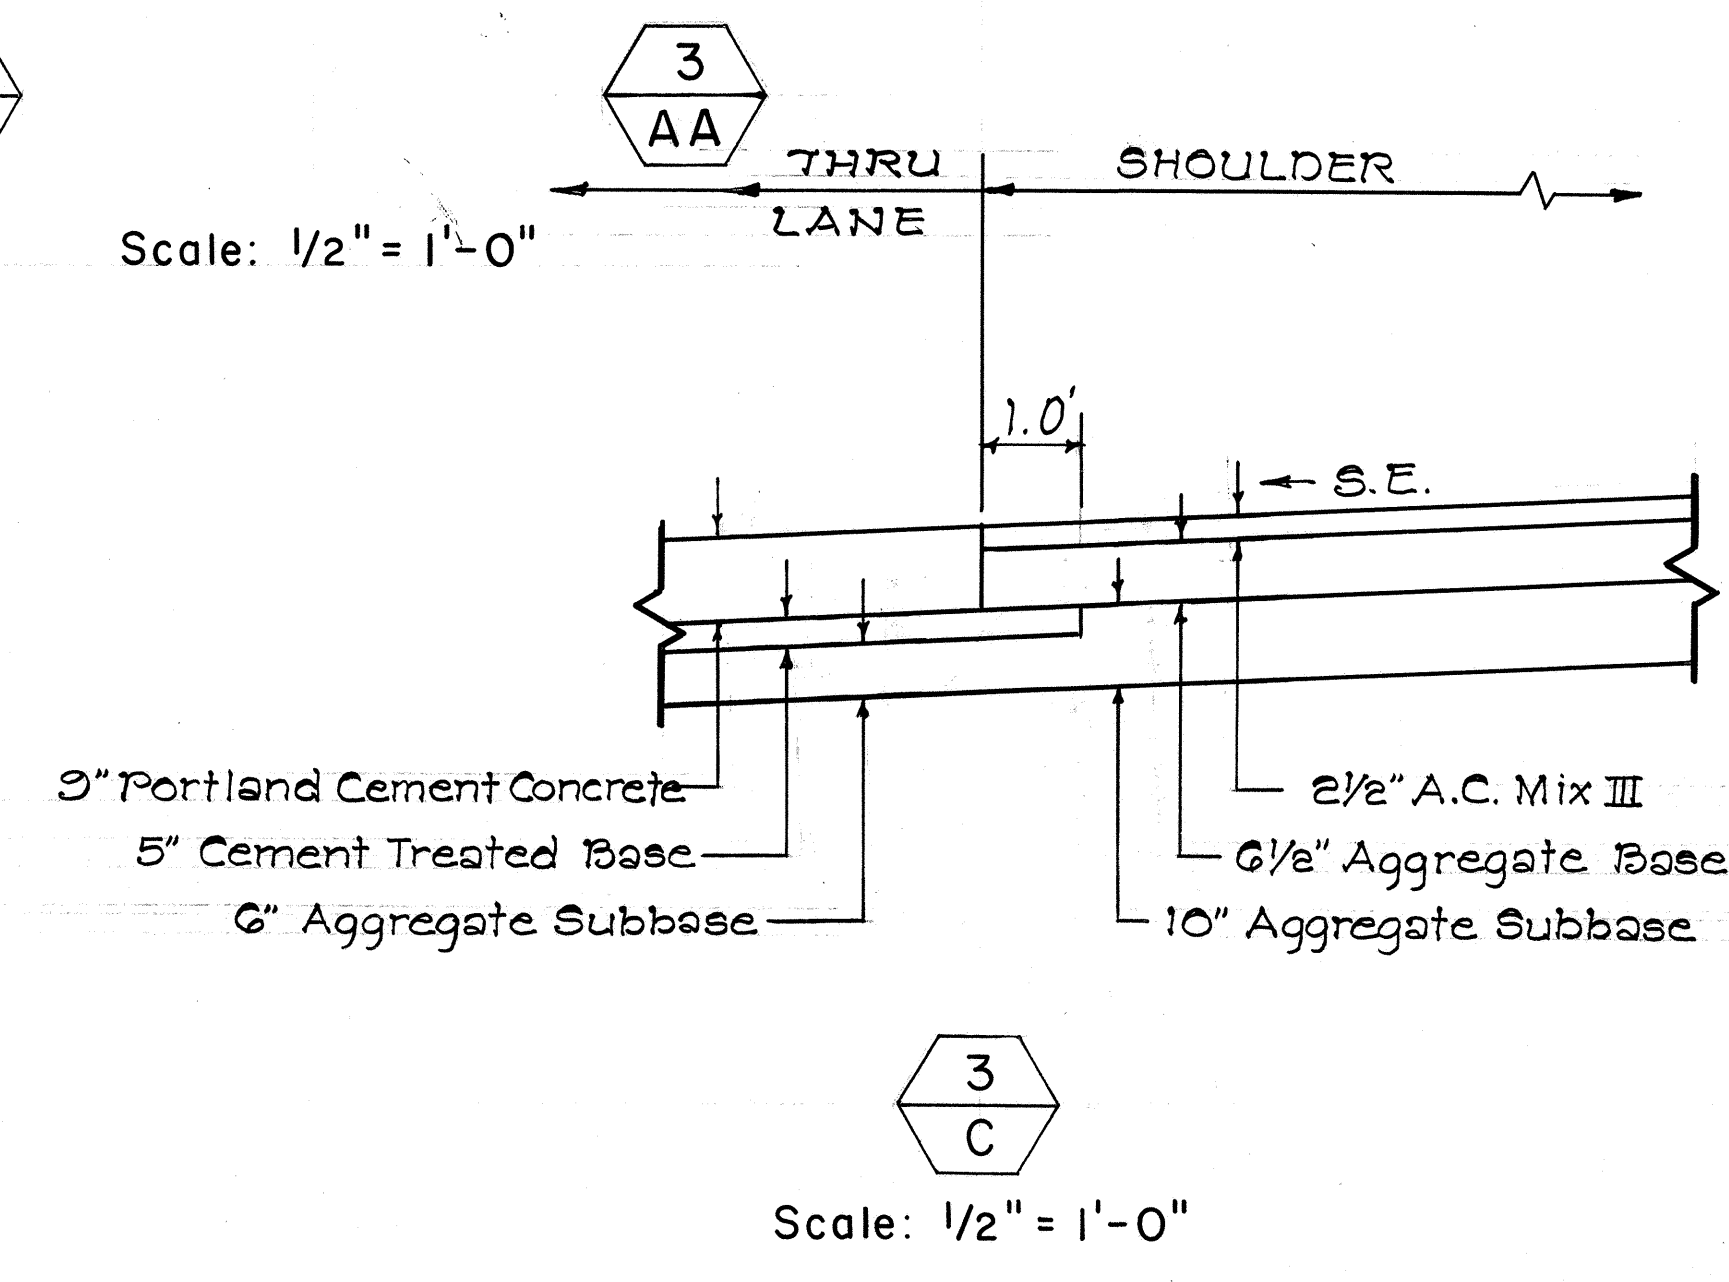

3 C

Scale: 1/2" = 1'-0"

STATE OF HAWAII
DEPARTMENT OF TRANSPORTATION
HIGHWAYS DIVISION

TYPICAL ROADWAY SECTIONS
H-2 INBOUND - Sta. 431+71.61 to 445+80


INTERSTATE ROUTE H-1
WAI'AWA INTERCHANGE
F.A.I. Proj. No. I-H-1(46):8
(PAVING OF H-2 CONNECTION)

Scale: As shown

SHEET No. 3 OF 5 SHEETS


DATE	_____
SURVEY PLOTTED BY	_____
DRAWN BY	_____
DESIGNED BY	_____
CHECKED BY	_____
ORIGINAL PLAN	_____
NOTE BOOK	_____
No.	_____

FED. ROAD DIST. NO.	STATE	FED. AID PROJ. NO.	FISCAL YEAR	SHEET NO.	TOTAL SHEETS
HAWAII	HAW.	I-HI-1(46)8	1973	7	104

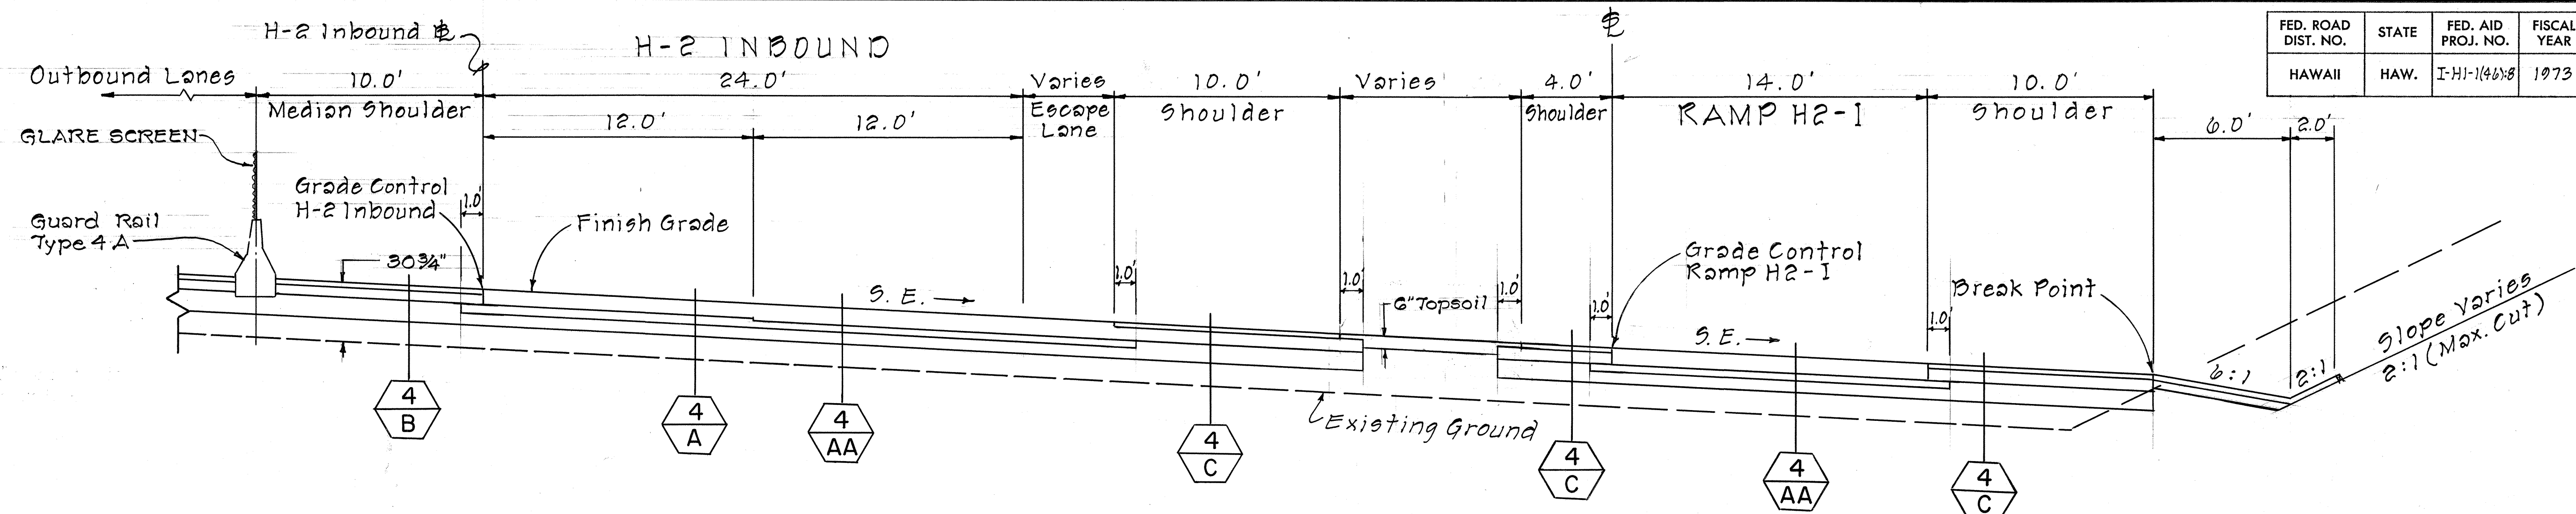


H-2 INBOUND Sta. 445+80 To 457+76.47


Scale: $1/4" = 1'-0"$

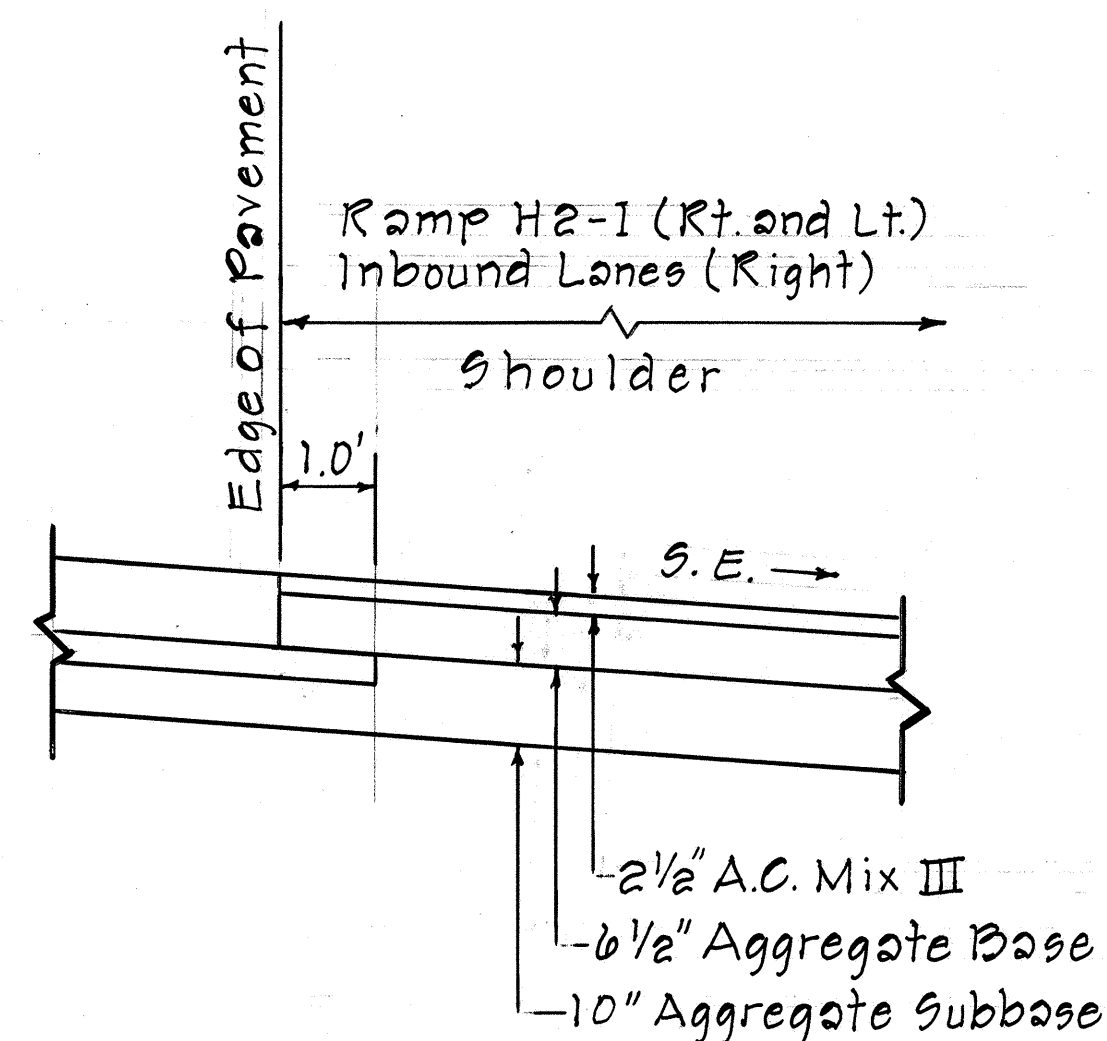

Scale: 1/2" = 1'-0"

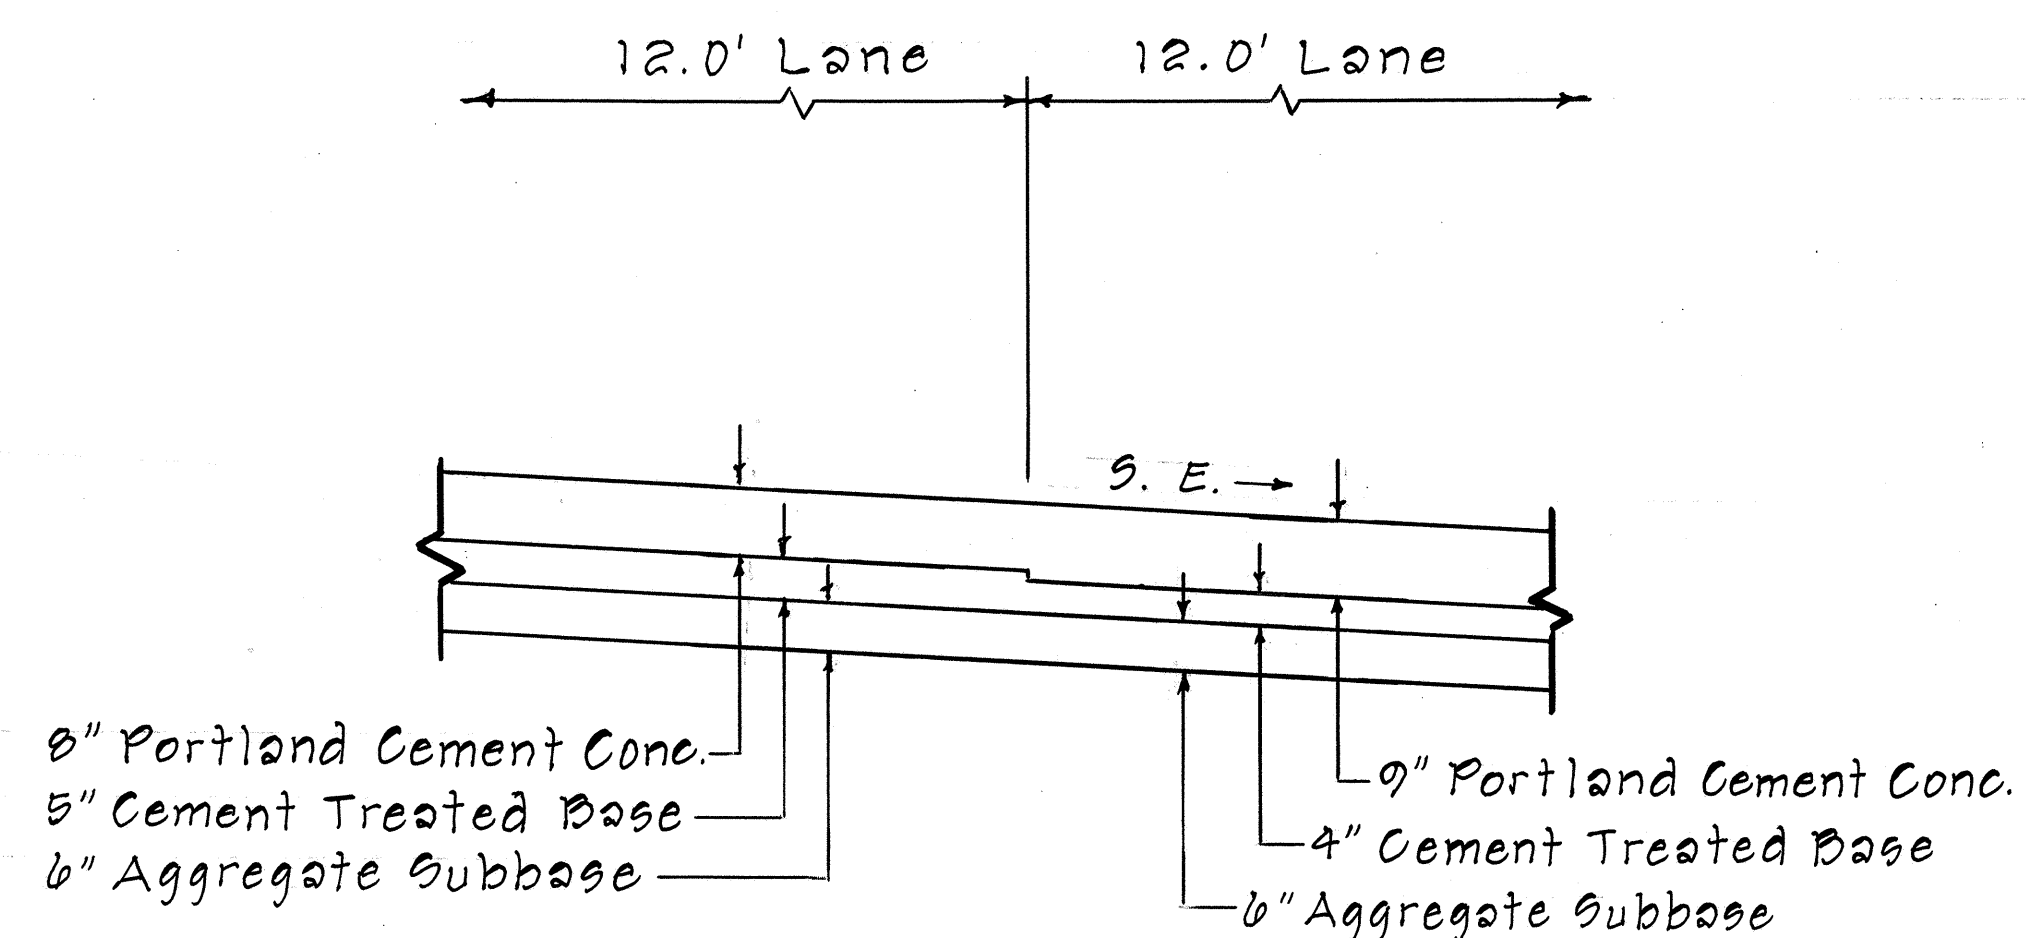


Scale: $1/2" = 1'-0"$

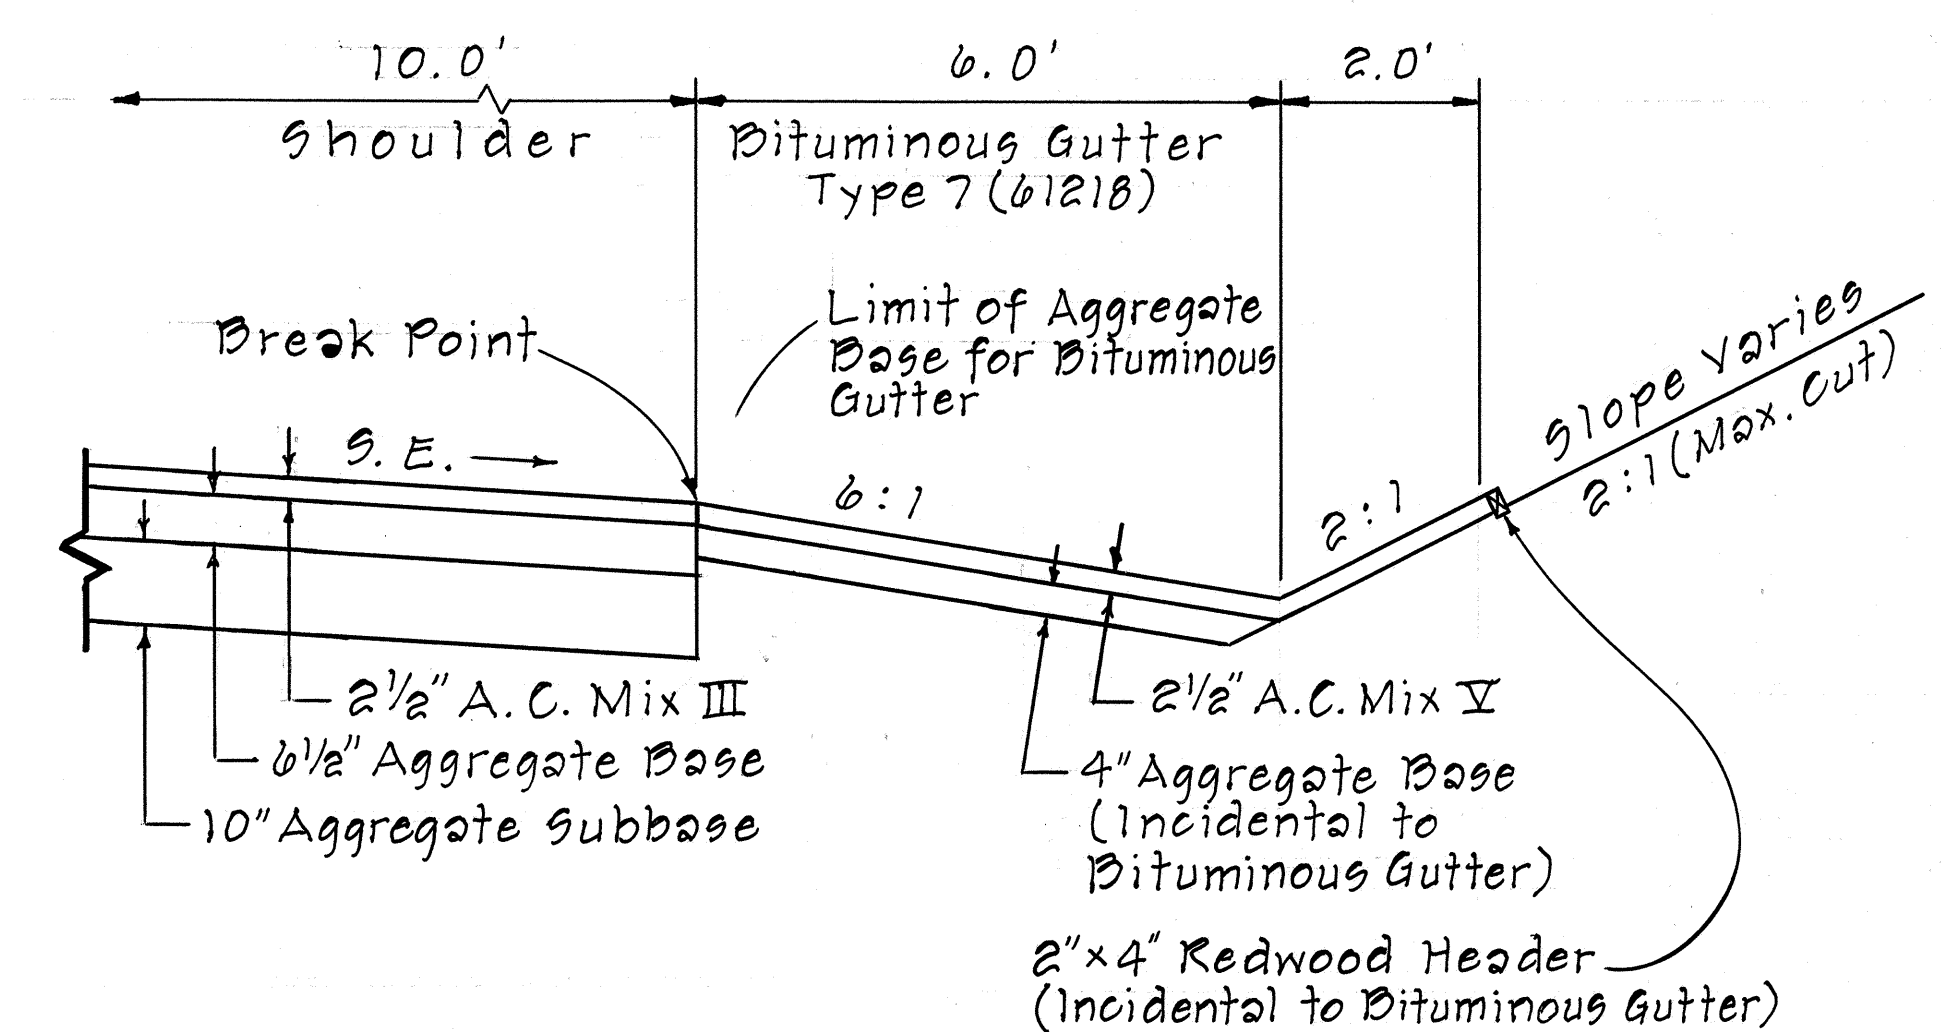

CUT SECTION DETAIL


Scale: $1/2'' = 1'-0''$

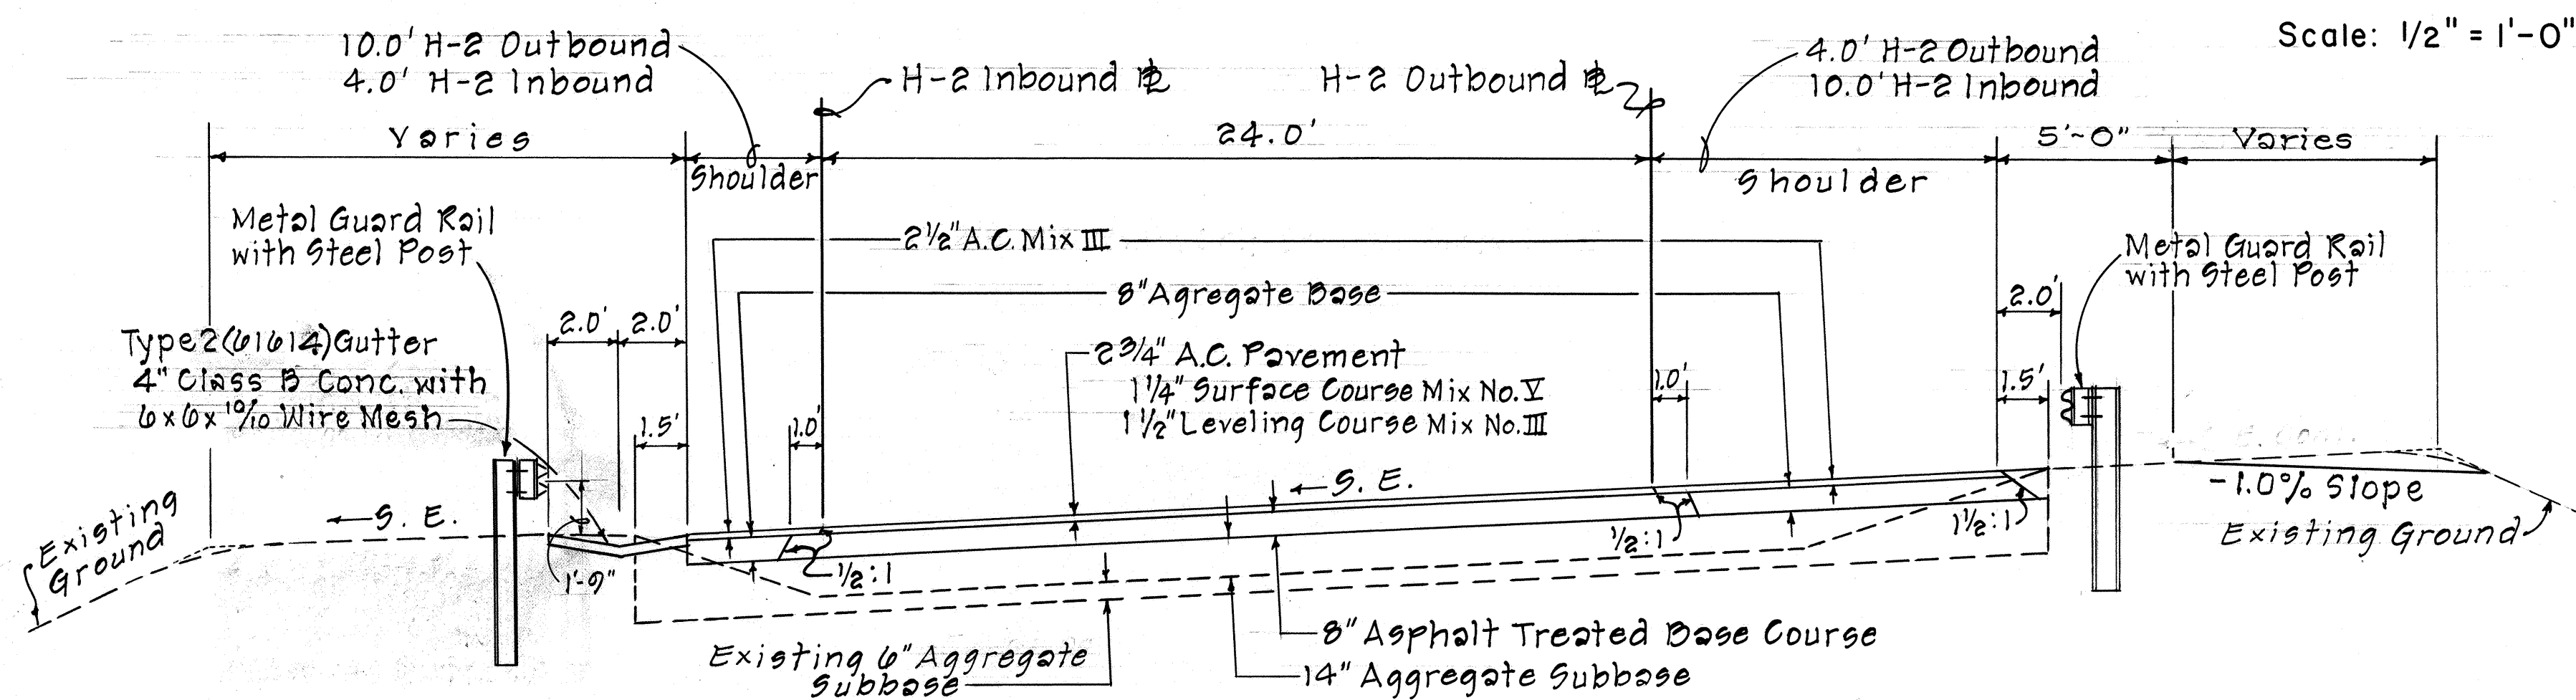

H-2 OUTBOUND - From O.B. ~~B~~ Sta. 463+10 To 471+98.40

H-2 INBOUND - From I.B. @ Sta. 465+25 To 471+47.99

Scale: $1/4" = 1'-0"$

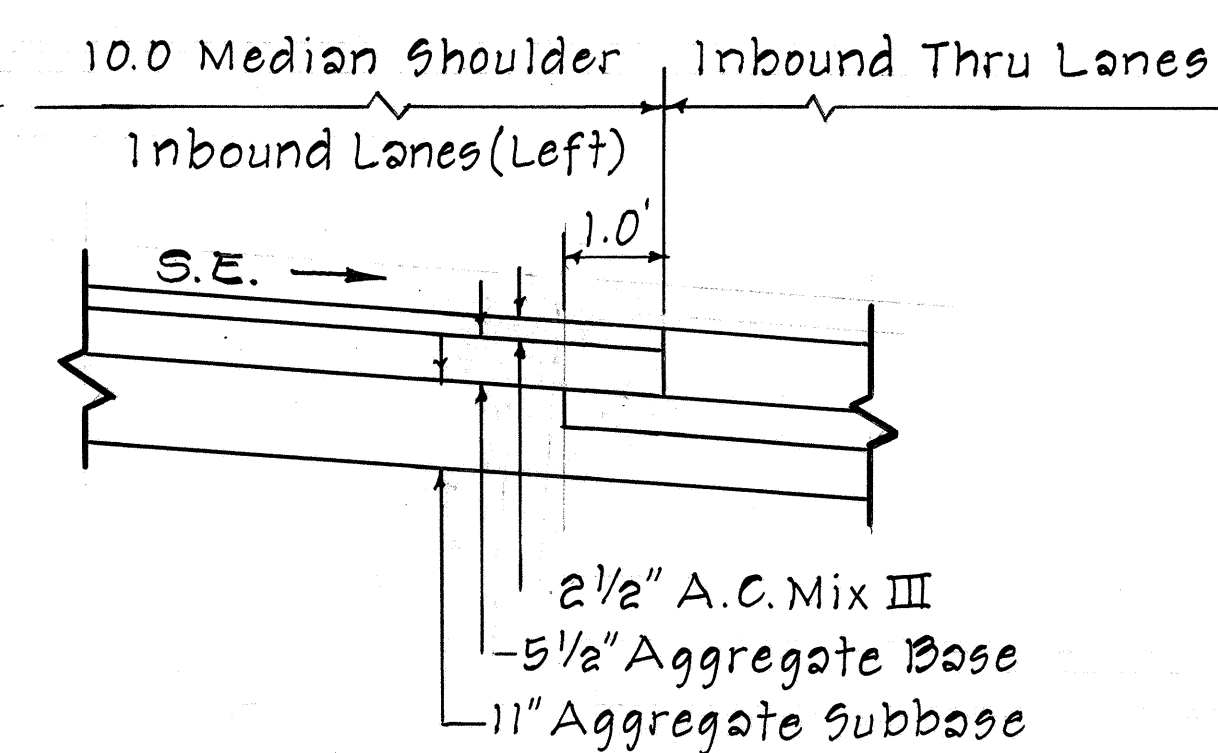

Scale: $\frac{1}{2}'' = 1'-0''$

STATE OF HAWAII
DEPARTMENT OF TRANSPORTATION
HIGHWAYS DIVISION

TYPICAL ROADWAY SECTIONS

H-2 INBOUND - Sta. 445+80 to 457+76.47

H-2 OUTBOUND - Sta. 463+10 to 471+98.40

H-2 INBOUND - Sta. 465+25 to 471+47.99

INTERSTATE ROUTE H-1

WAIAWA INTERCHANGE

F. A. I. Proj. No. I-HI-1(46):8







(PAVING OF H-2 CONNECTION)

Scale: As shown

SHEET No. 4 OF 5 SHEETS

FED. ROAD DIST. NO.	STATE	FED. AID PROJ. NO.	FISCAL YEAR	SHEET NO.	TOTAL SHEETS
HAWAII	HAW.	IHH(46):8	1973	8	104

Revised: Feb. 1973

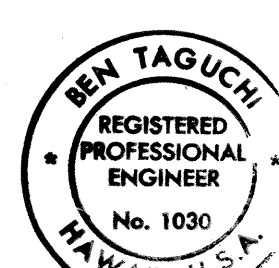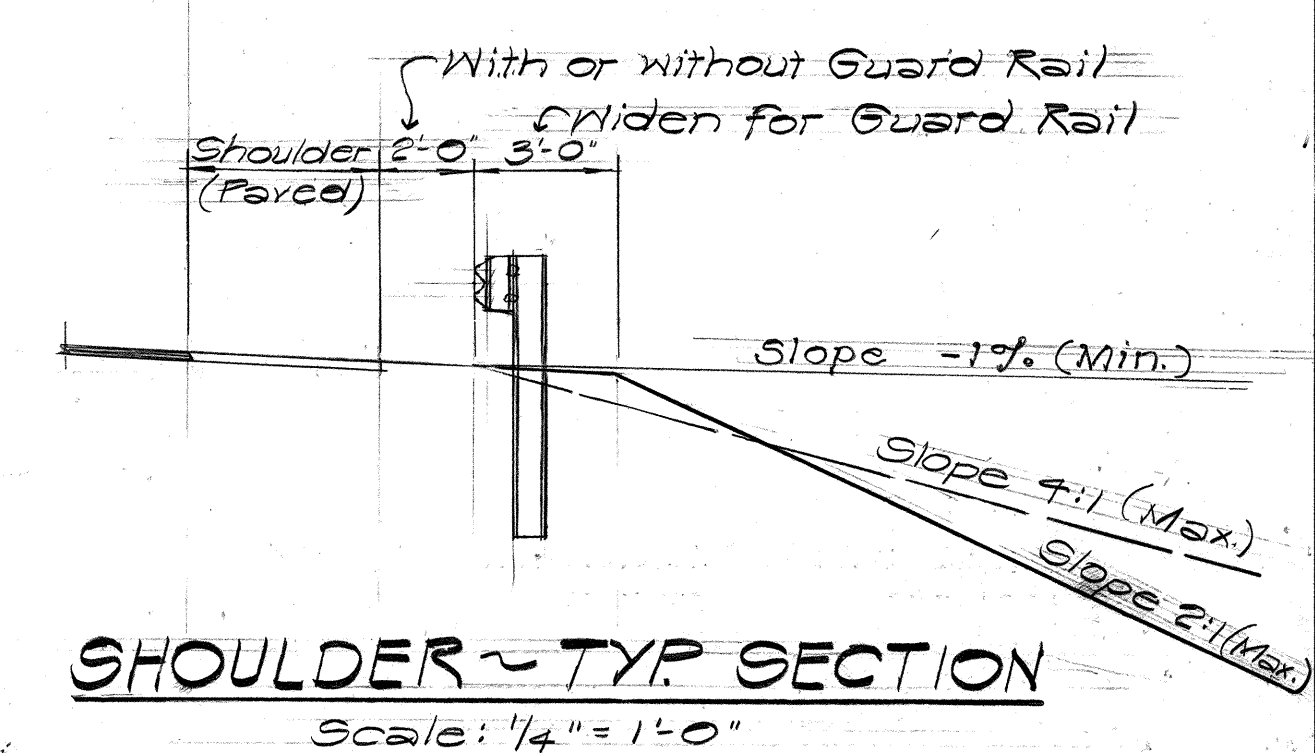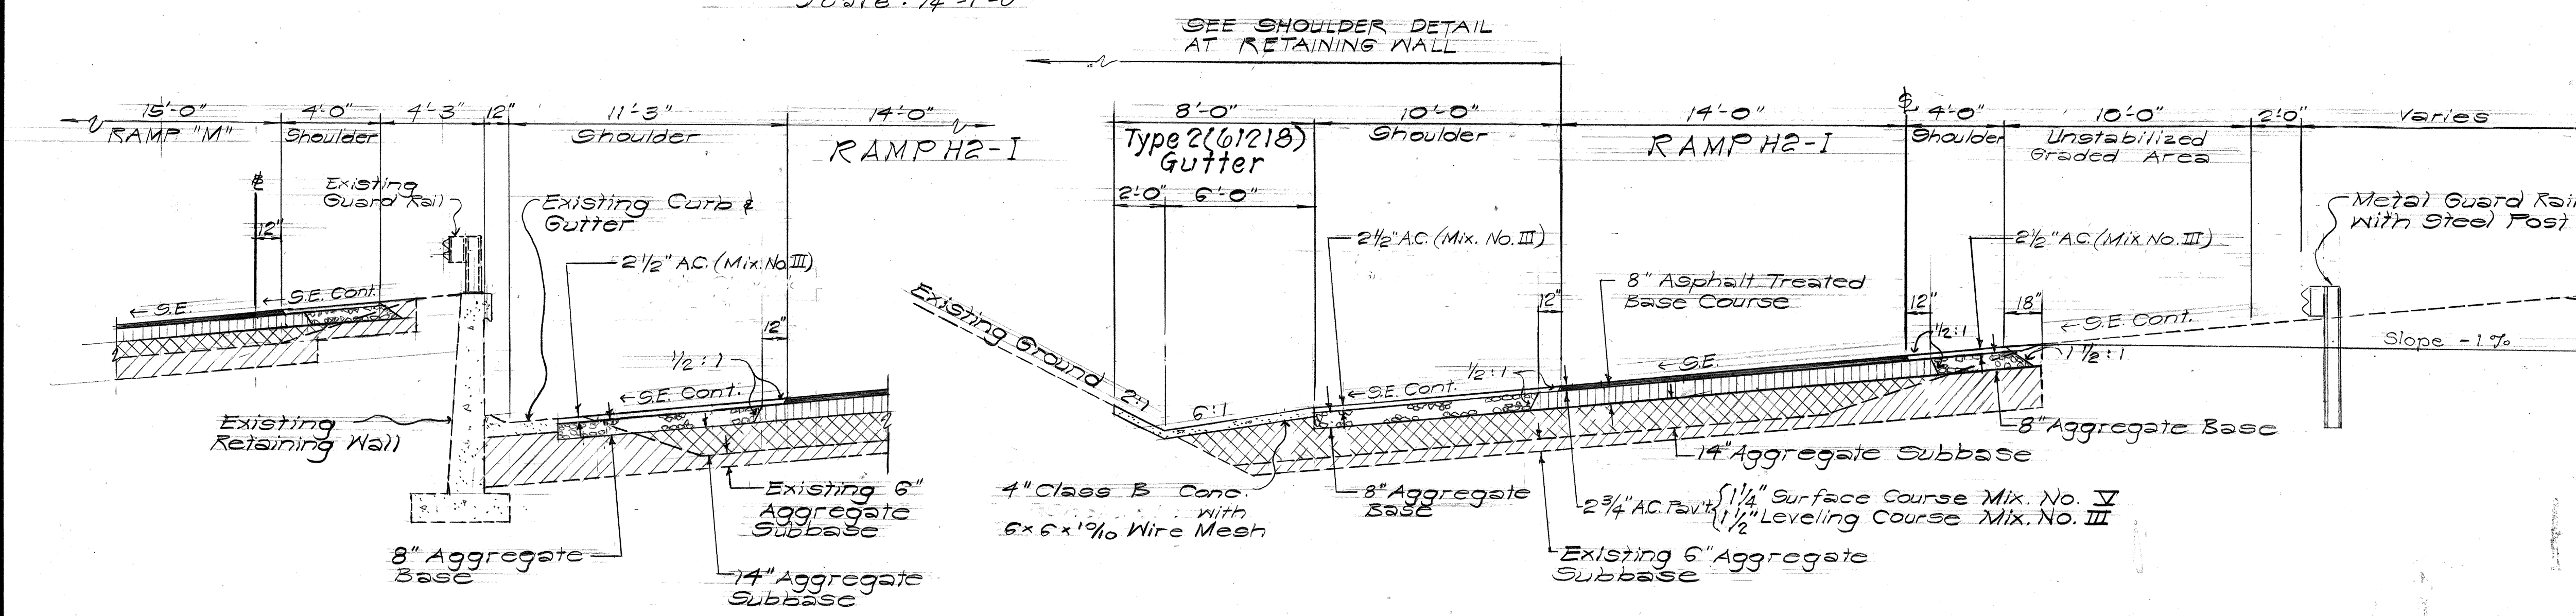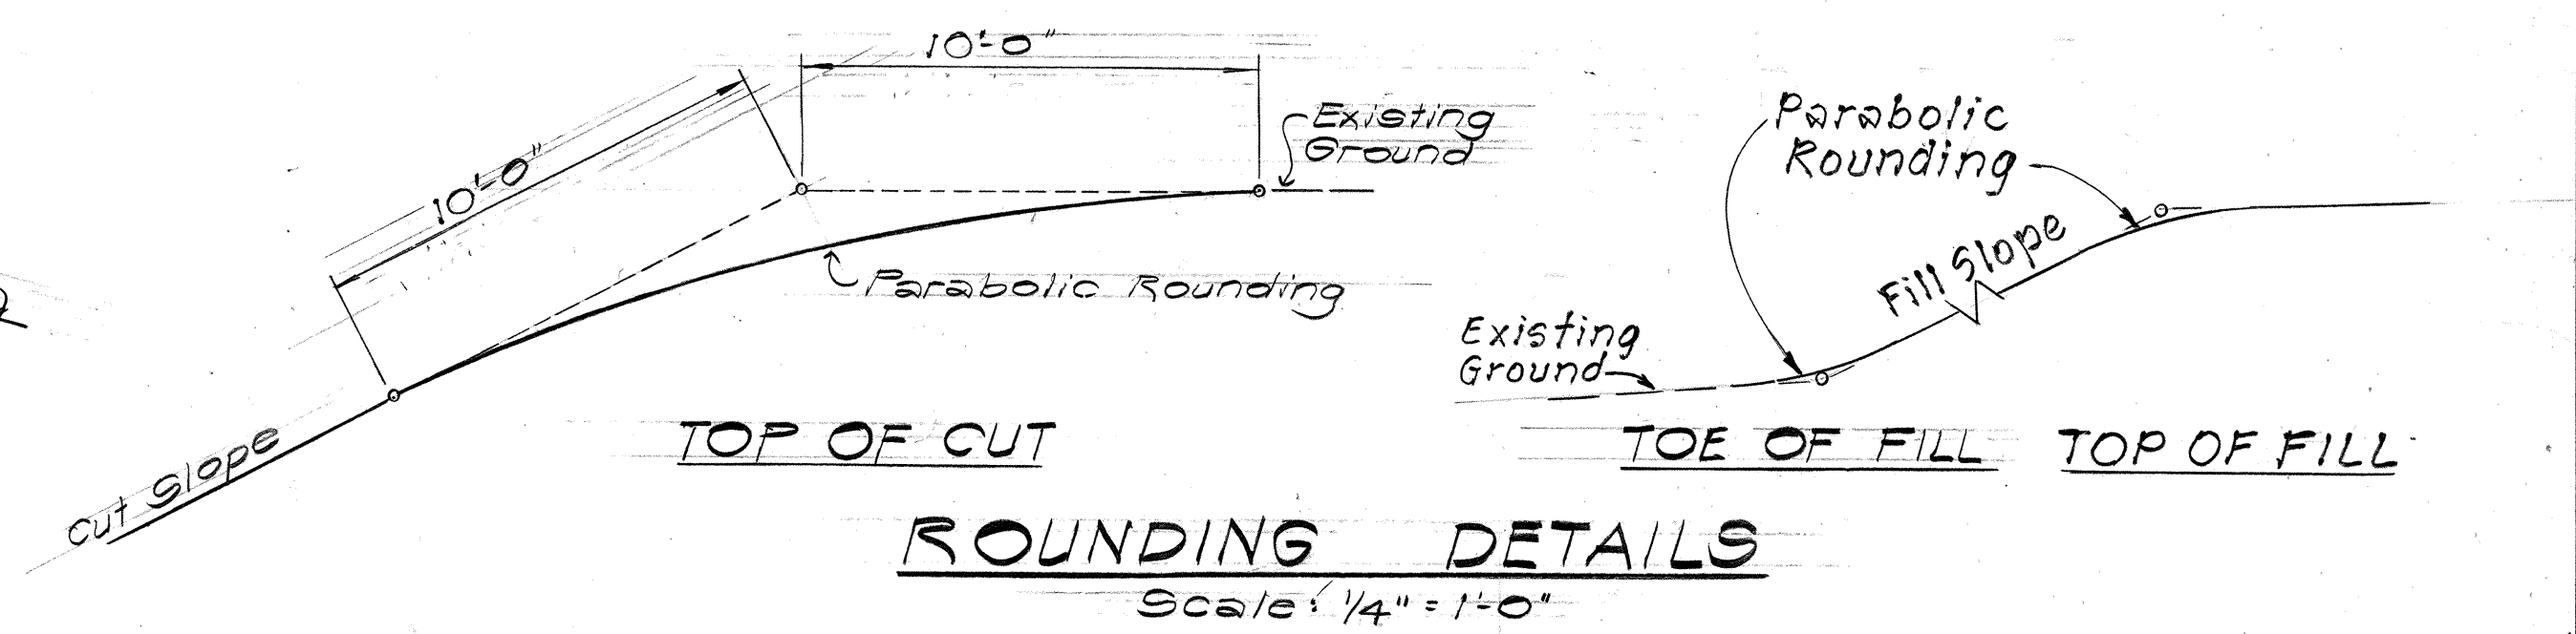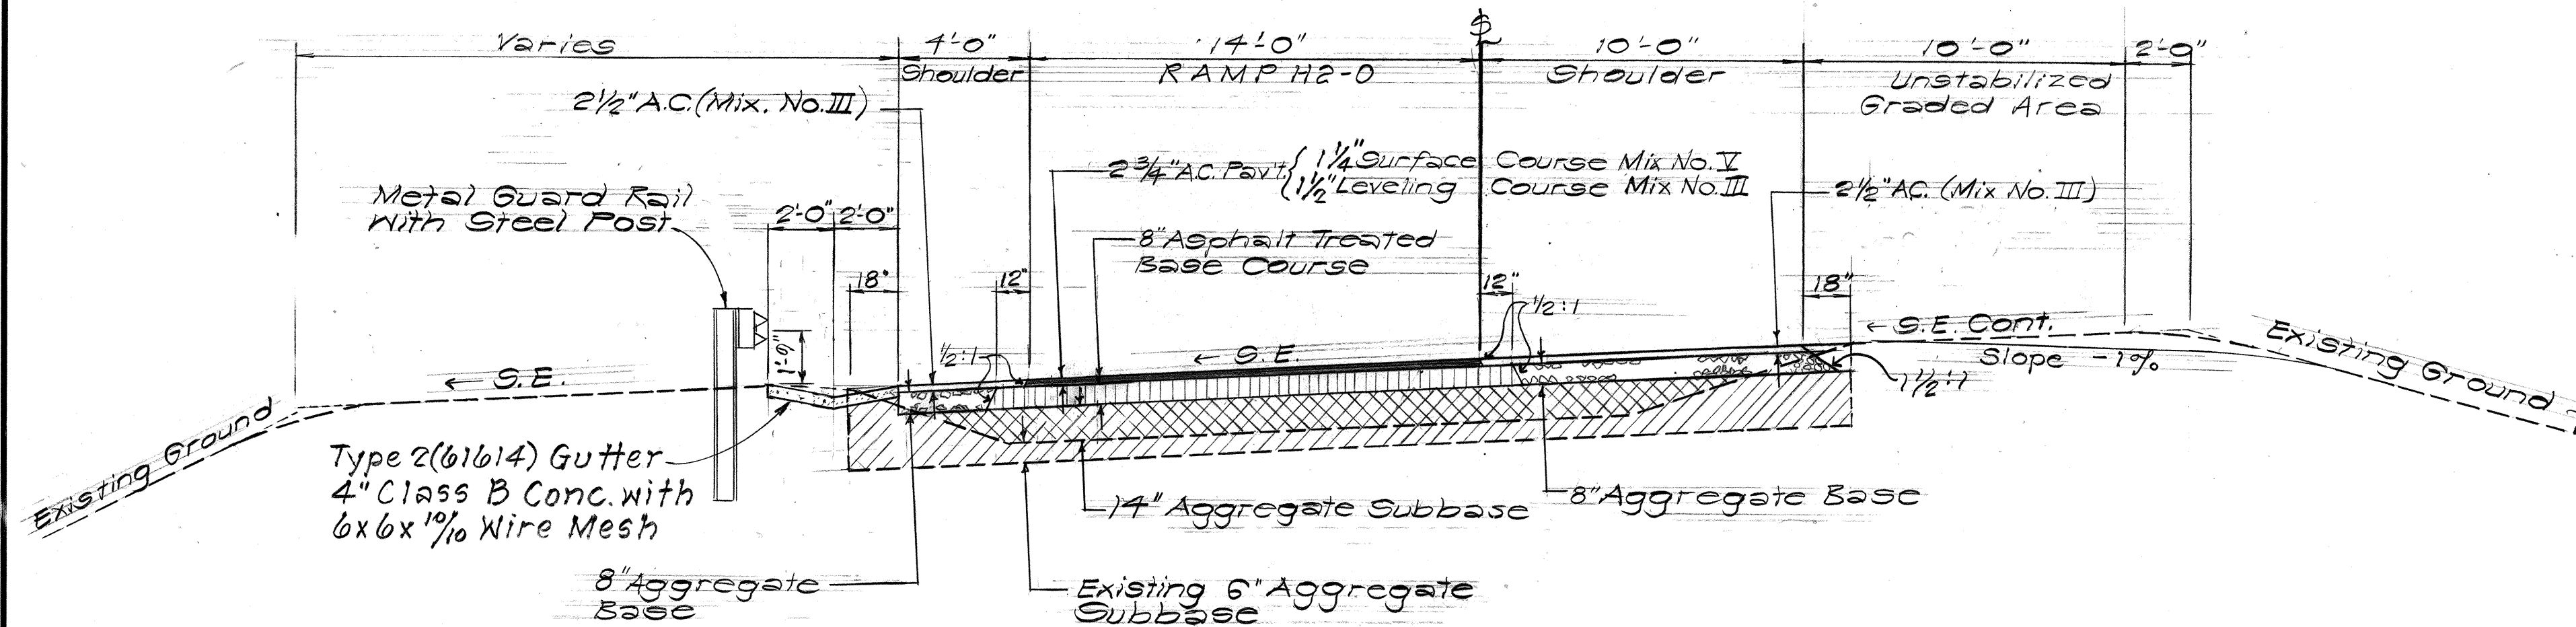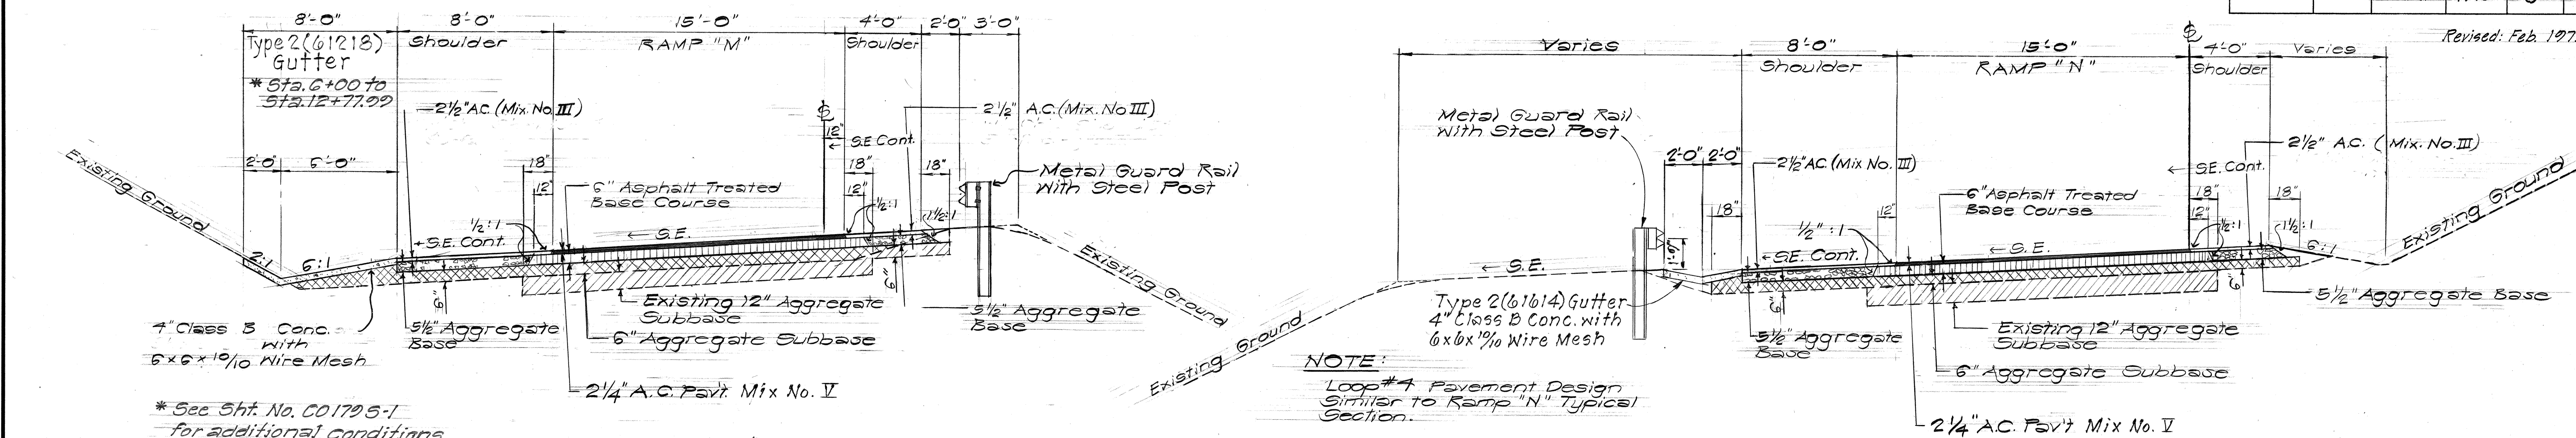

THIS WORK WAS PREPARED BY ME
OR UNDER MY SUPERVISION.

STATE OF HAWAII
DEPARTMENT OF TRANSPORTATION
HIGHWAYS DIVISION

TYPICAL ROADWAY SECTIONS
RAMP H2-I, RAMP H2-O, RAMP M, & RAMP N


INTERSTATE ROUTE H-1
WALAWA INTERCHANGE
F.A.I. Proj. No. I-HI-1(46):8
(PAVING OF H-2 CONNECTION)

Scale: As shown Date: NOV. 1969


SHEET No. 5 OF 5 SHEETS

DATE	
SURVEYED BY	
DRAWN BY	
CHECKED BY	
ORIGINAL PLAN	
NOTE BOOK	
No.	


FED. ROAD DIST. NO.	STATE	FED. AID PROJ. NO.	FISCAL YEAR	SHEET NO.	TOTAL SHEETS
HAWAII	HAW.	I-HI-1(46):8	1973	85-1	104

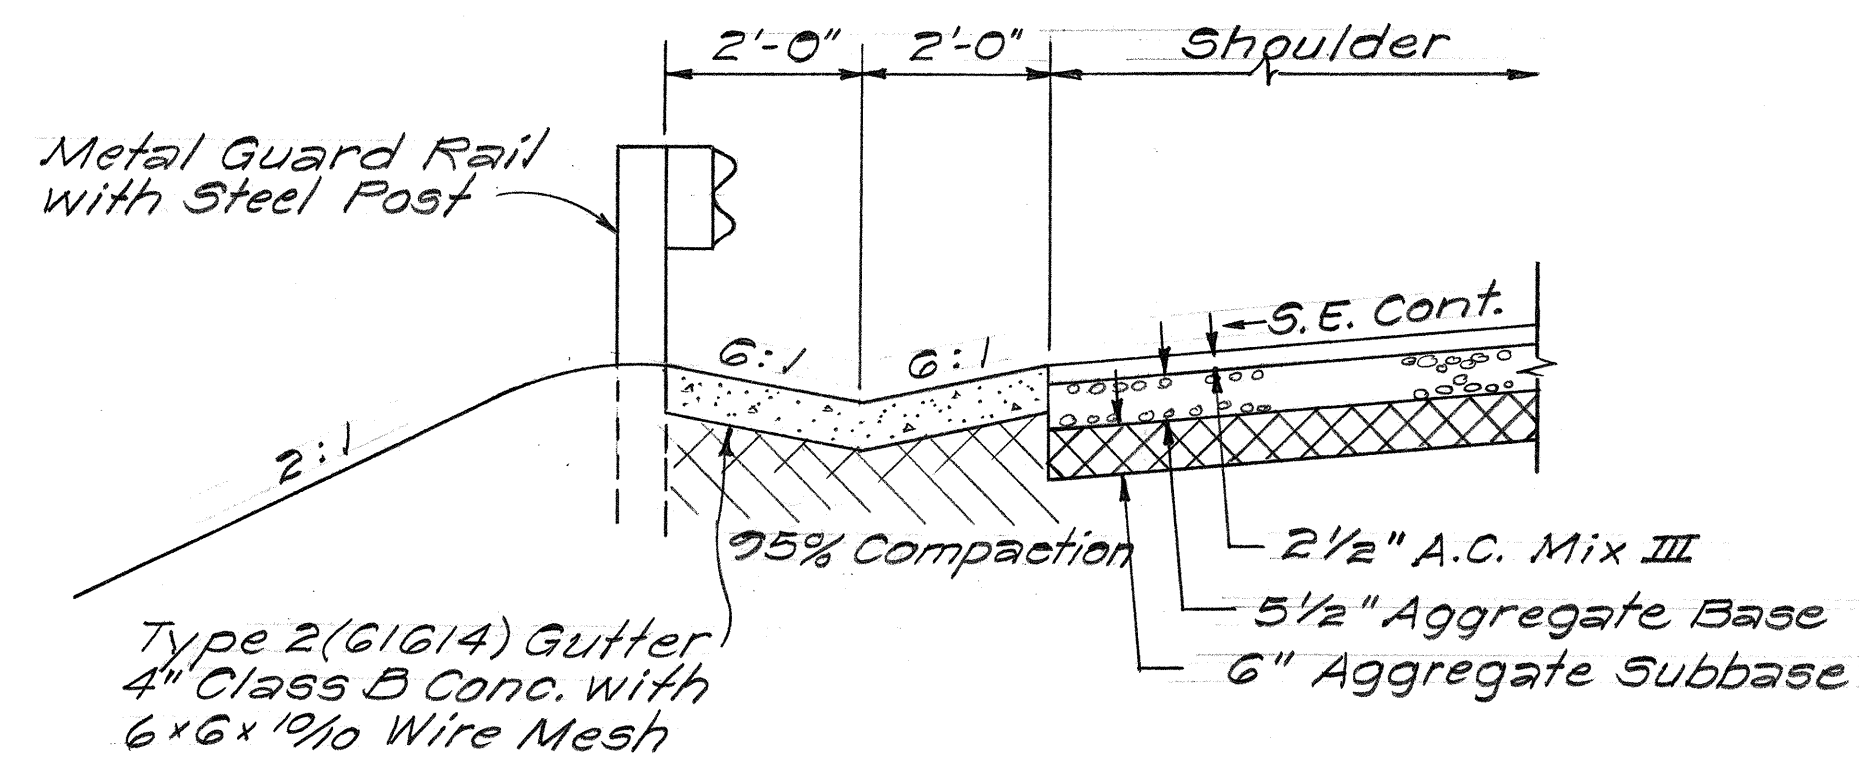

TYPICAL ~ RAMP "M"
± STA. 0+25 TO ± STA. 3+75 (L.T.)

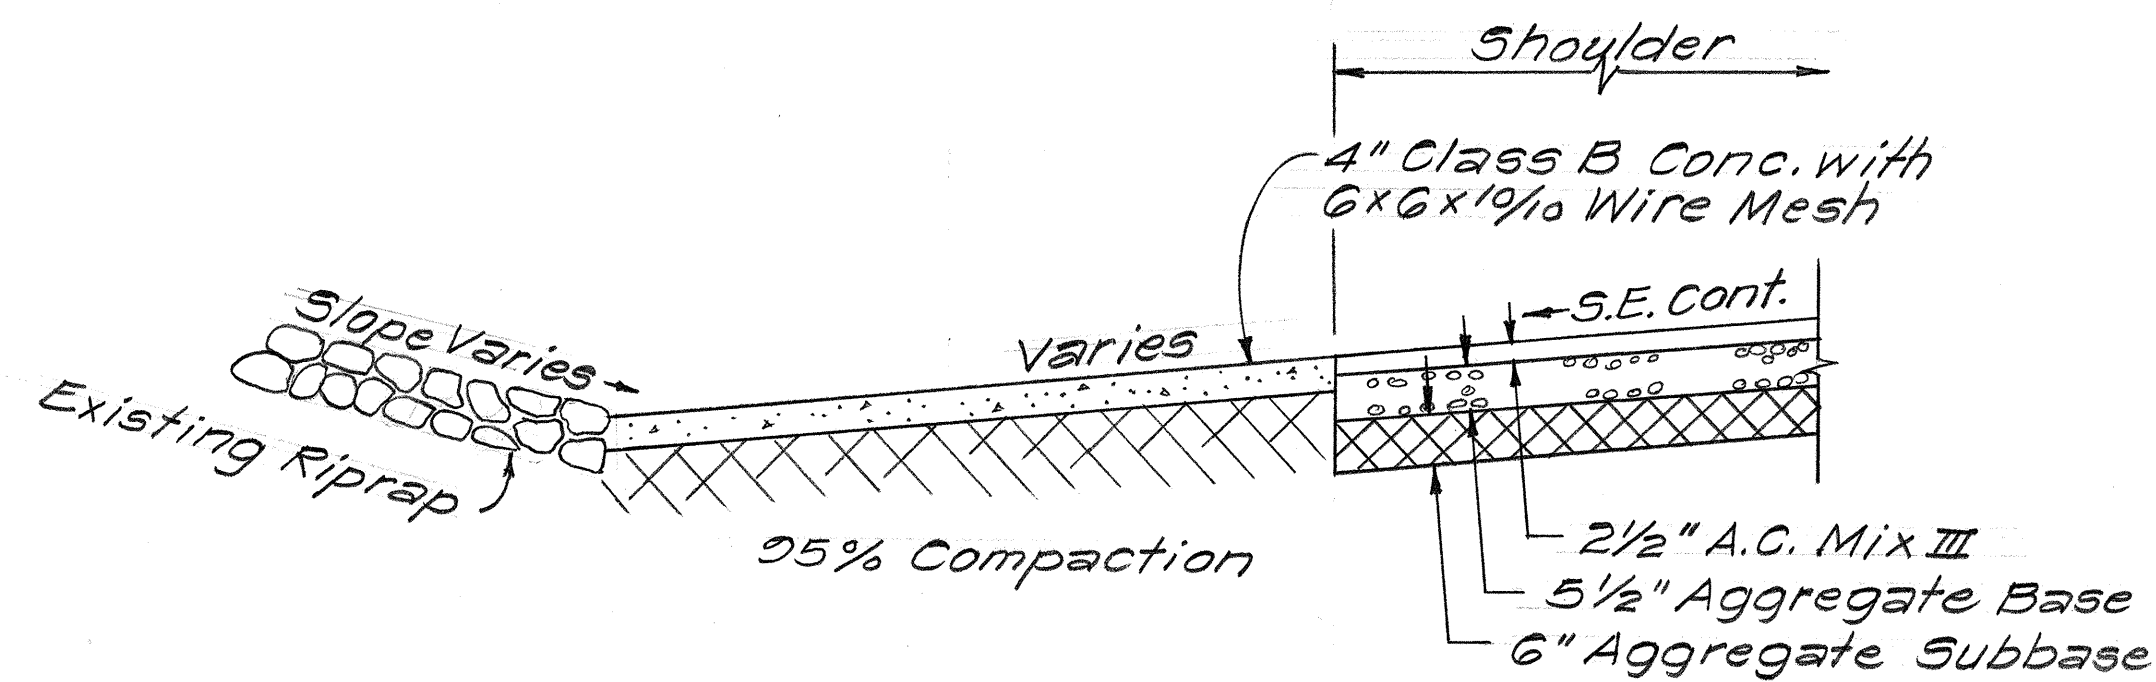

TYPICAL ~ RAMP "M"
± STA. 4+50 TO ± STA. 4+75 (L.T.)

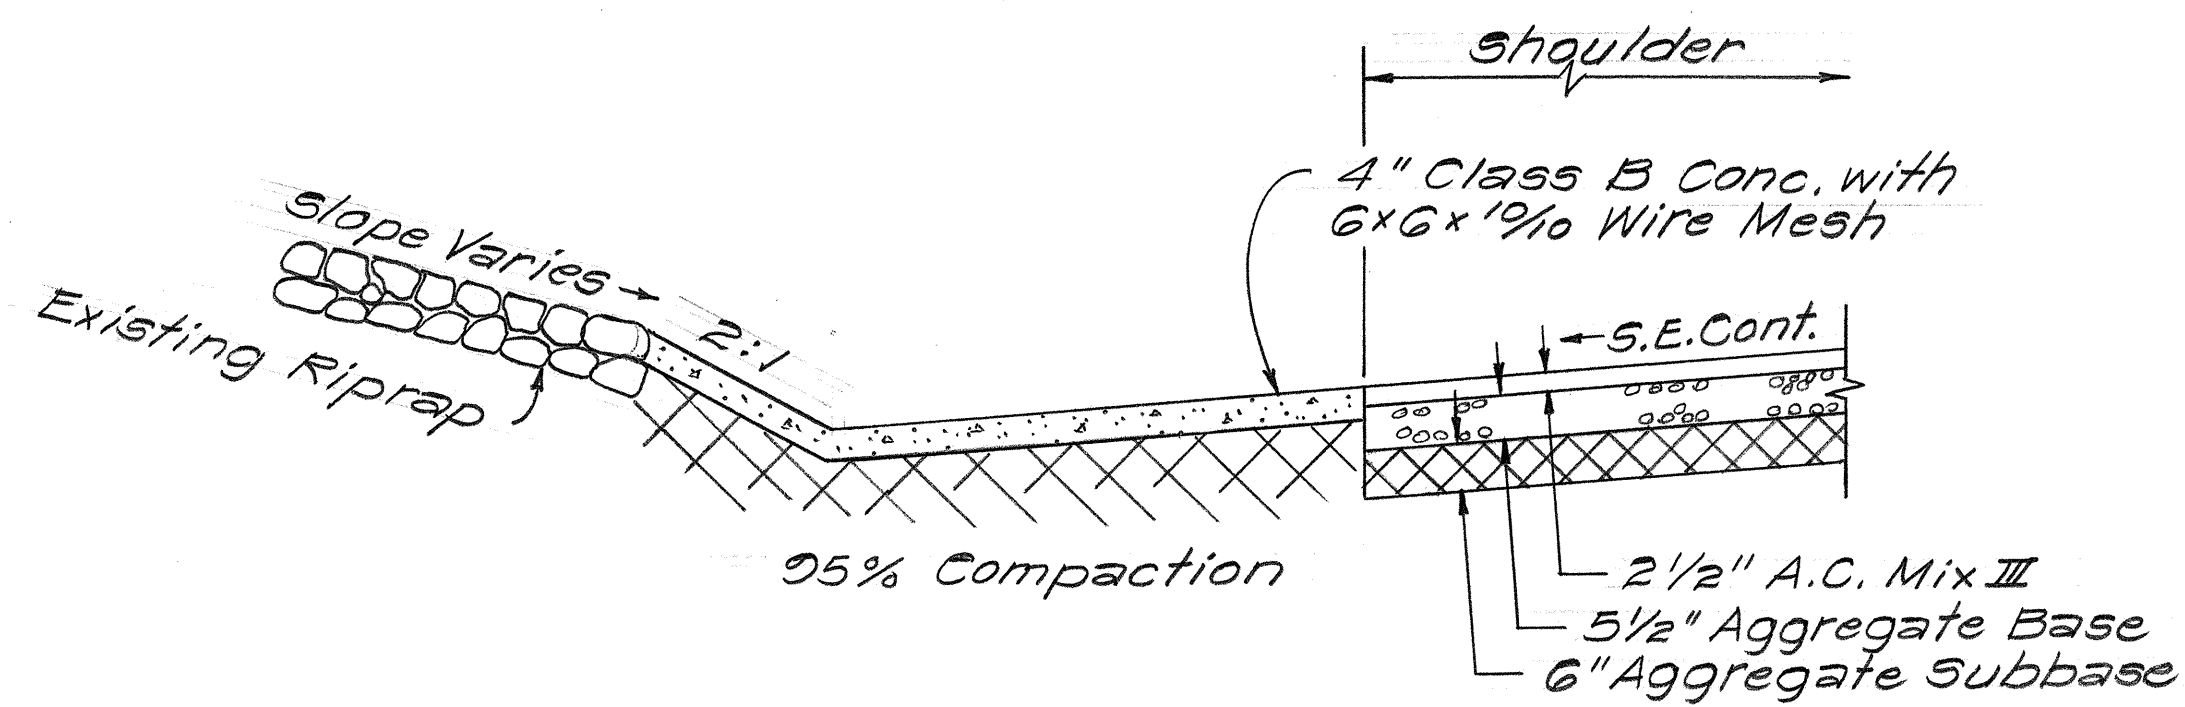

TYPICAL ~ RAMP "M"
± STA. 5+00 TO ± STA. 5+25 (L.T.)

SKETCH "C"
CCO #18

STATE OF HAWAII
DEPARTMENT OF TRANSPORTATION
HIGHWAYS DIVISION

TYPICAL ROADWAY SECTIONS
RAMP "M"

INTERSTATE ROUTE H-1
WAIKAWA INTERCHANGE
F.A.I. Proj. No. I-HI-1(46):8
(PAVING OF H-2 CONNECTION)

Scale: 1/2" = 1'-0" Date: Nov., 1969

SHEET No. 5A OF 5 SHEETS

CO 179 S-1

ORIGINAL PLAN	DATE
SURVEY PLOTTED BY	
DRAWN BY	
TRACED BY	
DESIGNED BY	
QUANTITIES BY	
CHECKED BY	
No.	