


FED. ROAD DIST. NO.	STATE	FED. AID PROJ. NO.	FISCAL YEAR	SHEET NO.	TOTAL SHEETS
HAWAII	HAW.	I-HI-1(10)15	1973	23	220


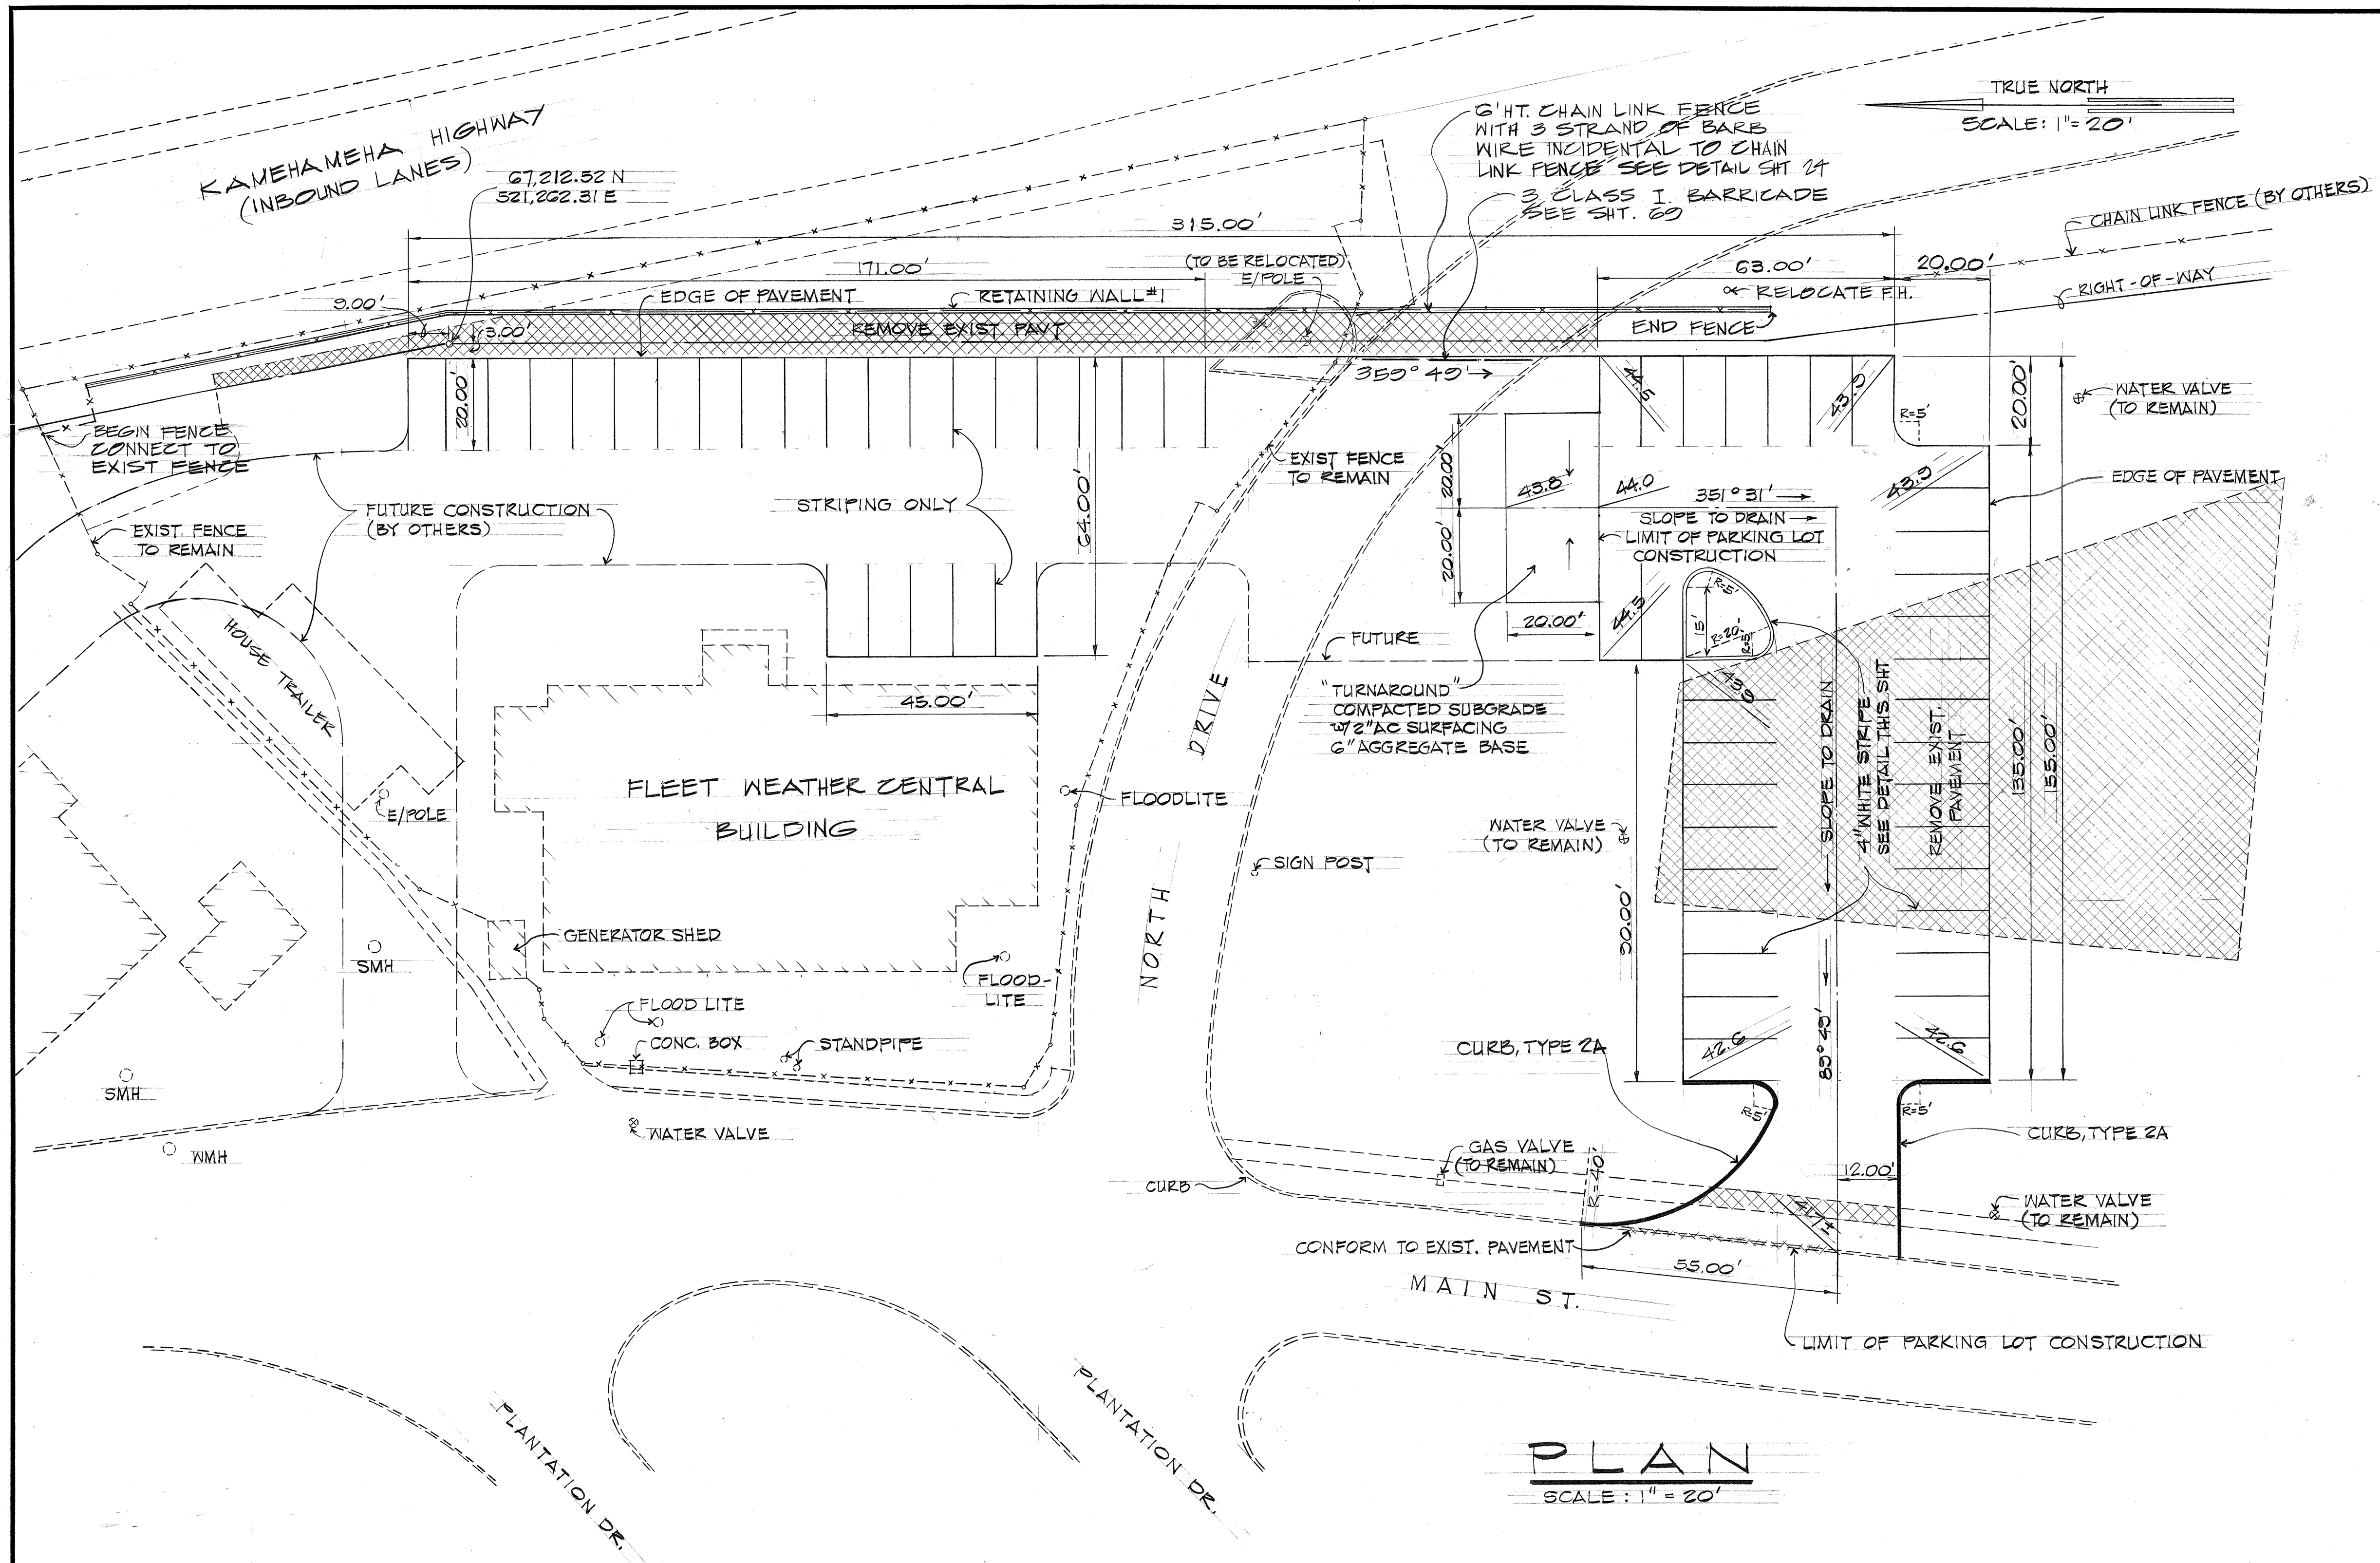


GENERAL NOTES:

1. THE CONTRACTOR SHALL MAKE CERTAIN THAT THE SECURITY FENCE WHICH ENCIRCLES THE FLEET WEATHER CENTRAL BUILDING IS KEPT INTEGRAL AT ALL TIMES.
2. DIMENSIONS SHOWN ARE TO THE EDGE OF PAVEMENT.
3. EXACT LOCATION OF EXISTING UTILITIES TO BE VERIFIED BY CONTRACTOR.
4. PORTIONS OF CONCRETE CURBS, GUTTER, SIDEWALKS AND PAVEMENTS WHICH ARE TO REMAIN SHALL BE CUT WITH A POWER DRIVE ABRASIVE SAW. THIS OPERATION SHALL BE PERFORMED WITHOUT DAMAGE TO ANY PORTION OF THE CONCRETE THAT IS TO REMAIN IN PLACE.
5. FOR THIS CONTRACT THE 6-FT. CHAIN LINK FENCE SHALL EXTEND THE LIMIT OF RETAINING WALL #1. SEE DETAIL SHEET 105 FOR FENCE ON RETAINING WALL DETAIL.

LEGEND

- REMOVE EXISTING PAVEMENT
- FINISH GRADE

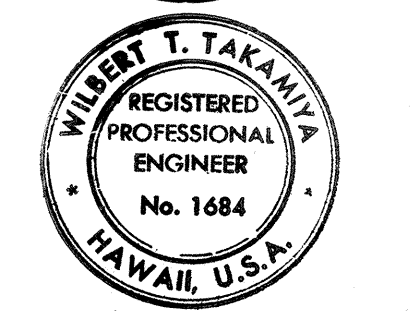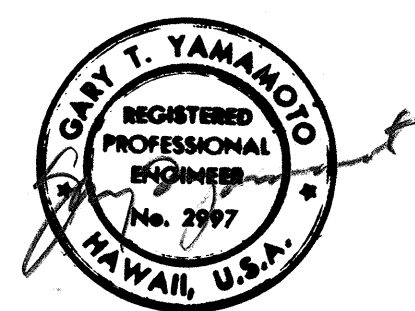

THIS WORK WAS PREPARED BY ME OR UNDER MY SUPERVISION

STATE OF HAWAII
DEPARTMENT OF TRANSPORTATION
HIGHWAYS DIVISION

**FLEET WEATHER CENTRAL
PARKING LOT**

PEARL HARBOR INTERCHANGE
F.A.I. Proj. No. I-HI-1(10)15

Scale: As Shown Date: MAY 28, 1973

SHEET NO. 23 OF 23 SHEETS

SURVEY PLOTTED BY	DATE
DRAWN BY	
DESIGNED BY	
CHECKED BY	
ORIGINAL PLAN	
NOTE BOOK	
No.	

TYPICAL SECTION

SCALE: 1/4" = 1'-0"

STRIPING DETAIL

NOT TO SCALE

EXISTING ADOBE MATERIAL REMOVED AS PER CO#14.