

FED. ROAD DIST. NO.	STATE	FED. AID PROJ. NO.	FISCAL YEAR	SHEET NO.	TOTAL SHEETS
HAWAII	HAW.	I-HI-1(110)15	1973	20	220

CURVE DATA		
	(X)	(Y)
Δ	121°38'00"	64°57'00"
4/8	60°49'00"	32°28'30"
R	50.00	80.00
T	89.33	50.92
Ch	87.31	85.91
Lc	106.15	90.69

SECTION
SCALE: 1/2" = 1'-0"

VALKENBURGH STREET &
MAUKA FRONTAGE ROAD INTERSECTION
SCALE: 1" = 20'

LEGEND

- FINISH GRADE ELEVATION
- DETOUR CONSTRUCTION - EXTEND TYPICAL FRONTAGE ROAD PAVEMENT SECTION (SEE DETOUR PLANS FOR TRAFFIC PATTERNS).

11/3/73
C.O.#15
ADDED DRIVEWAY CURB FOR BIKEWAY
DELETED TYPE 2AGM CURB AND
GUTTER ON MAUKA F.R. FROM
STA. 39+88.88 TO 41+56.14 RT.



DATE REVISION

STATE OF HAWAII
DEPARTMENT OF TRANSPORTATION
HIGHWAYS DIVISION

INTERSECTION DETAILS

PEARL HARBOR INTERCHANGE
F.A.I. Proj. No. I-HI-1(110)15

Scale: As Shown Date: MAY 28 1973
SHEET No. 2 OF 2 SHEETS

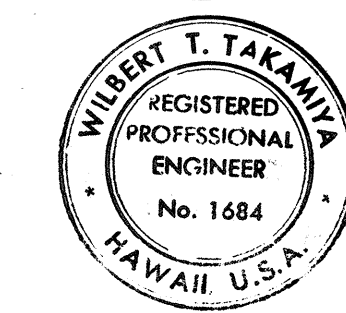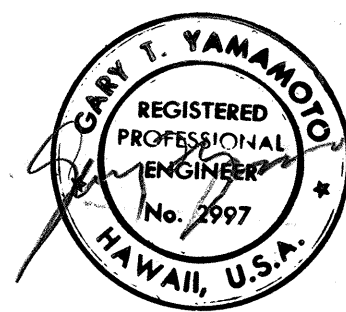

Willbert T. Takahira
THIS WORK WAS PREPARED BY ME
OR UNDER MY SUPERVISION