




| FED. ROAD DIST. NO. | STATE | FED. AID PROJ. NO. | FISCAL YEAR | SHEET NO. | TOTAL SHEETS |
|---------------------|-------|--------------------|-------------|-----------|--------------|
| HAWAII              | HAW.  | I-HI-1(110):15     | 1973        | 21        | 220          |

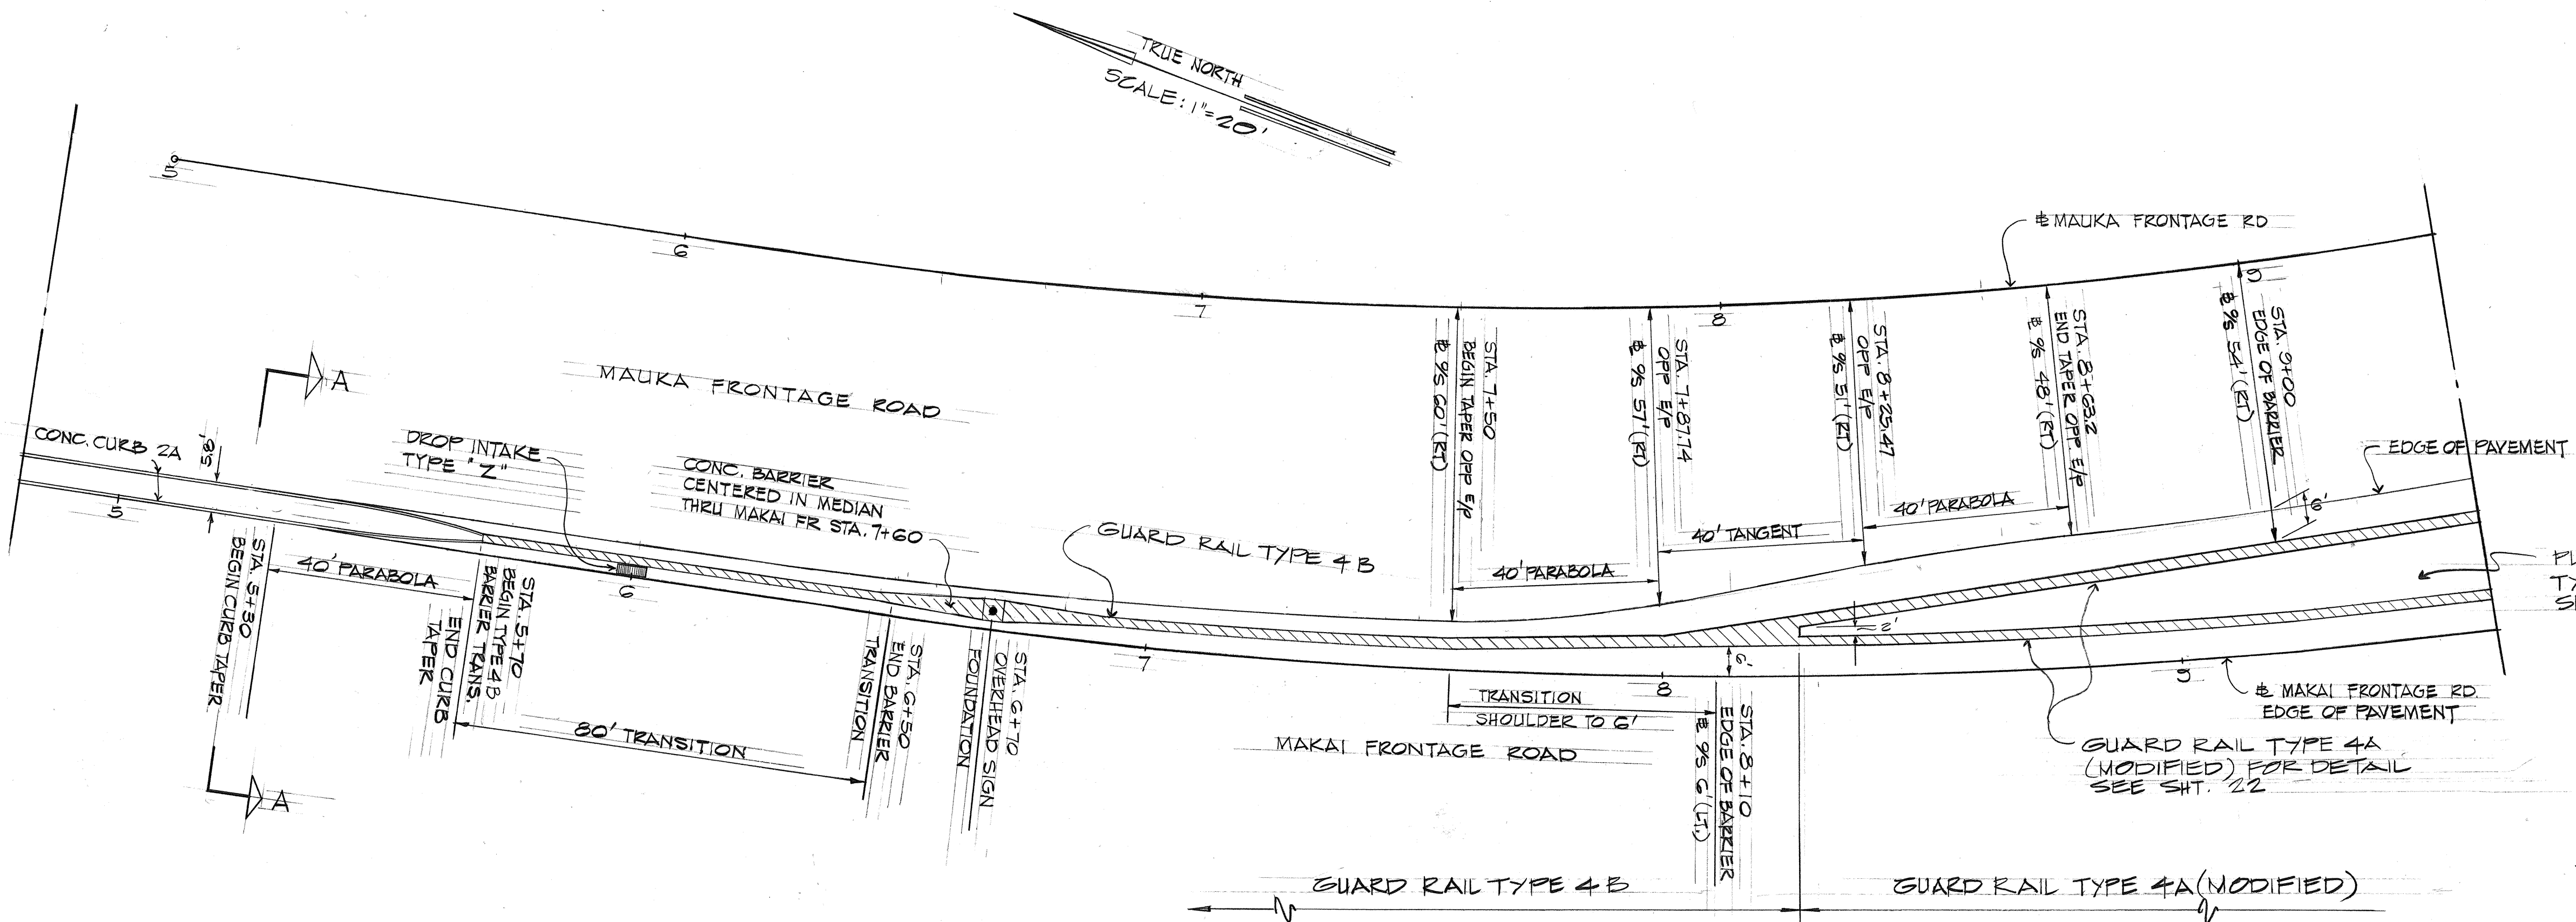


**PLAN**  
SCALE: 1" = 20'

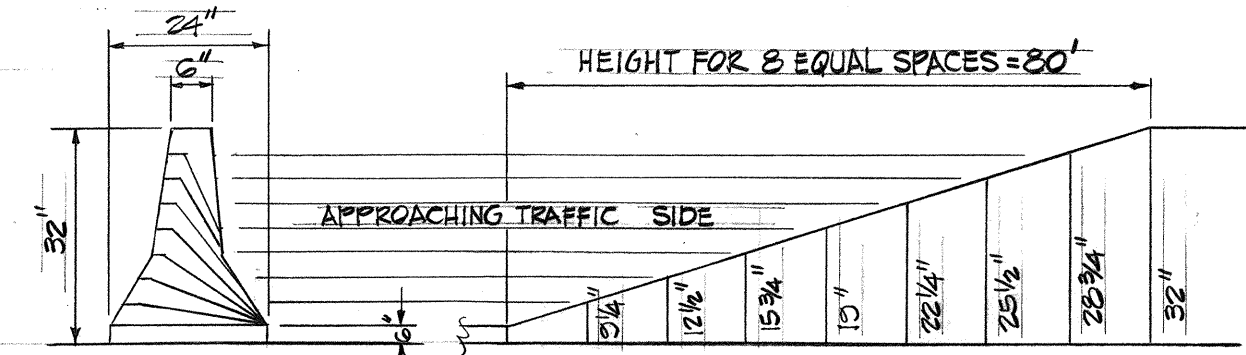


**CONC. BARRIER VERTICAL TRANSITION DETAIL**  
NO SCALE

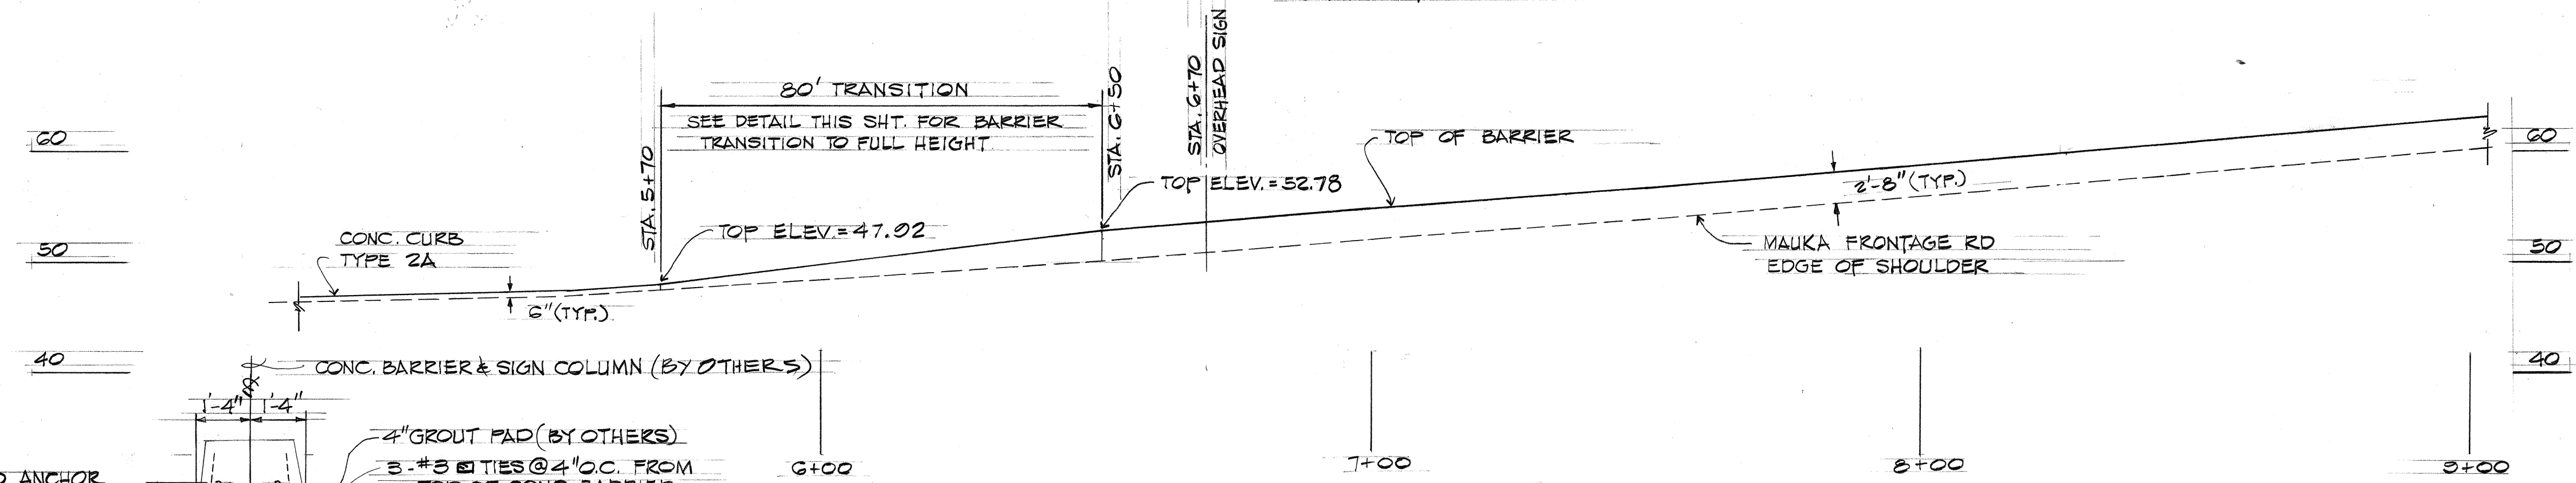

**PROFILE**  
SCALE: HORIZ. - 1" = 20'  
VERT. - 1" = 10'

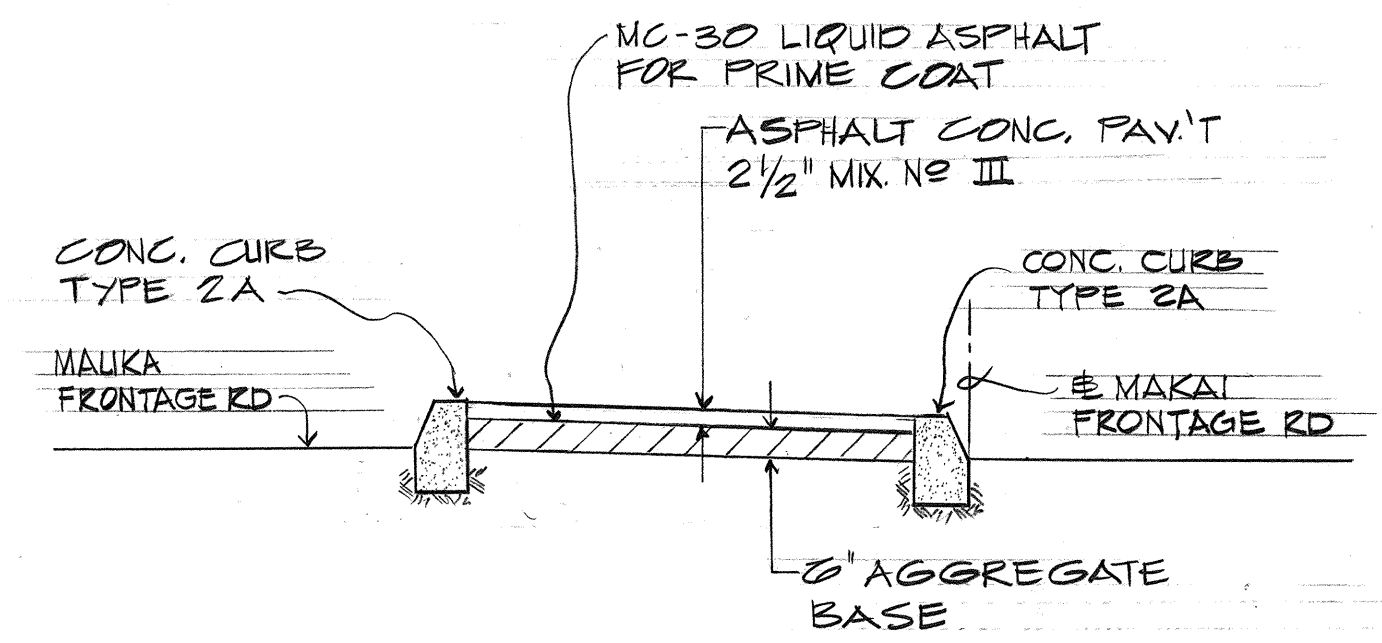


**SECTION A-A**  
SCALE: 1/2" = 1'-0"


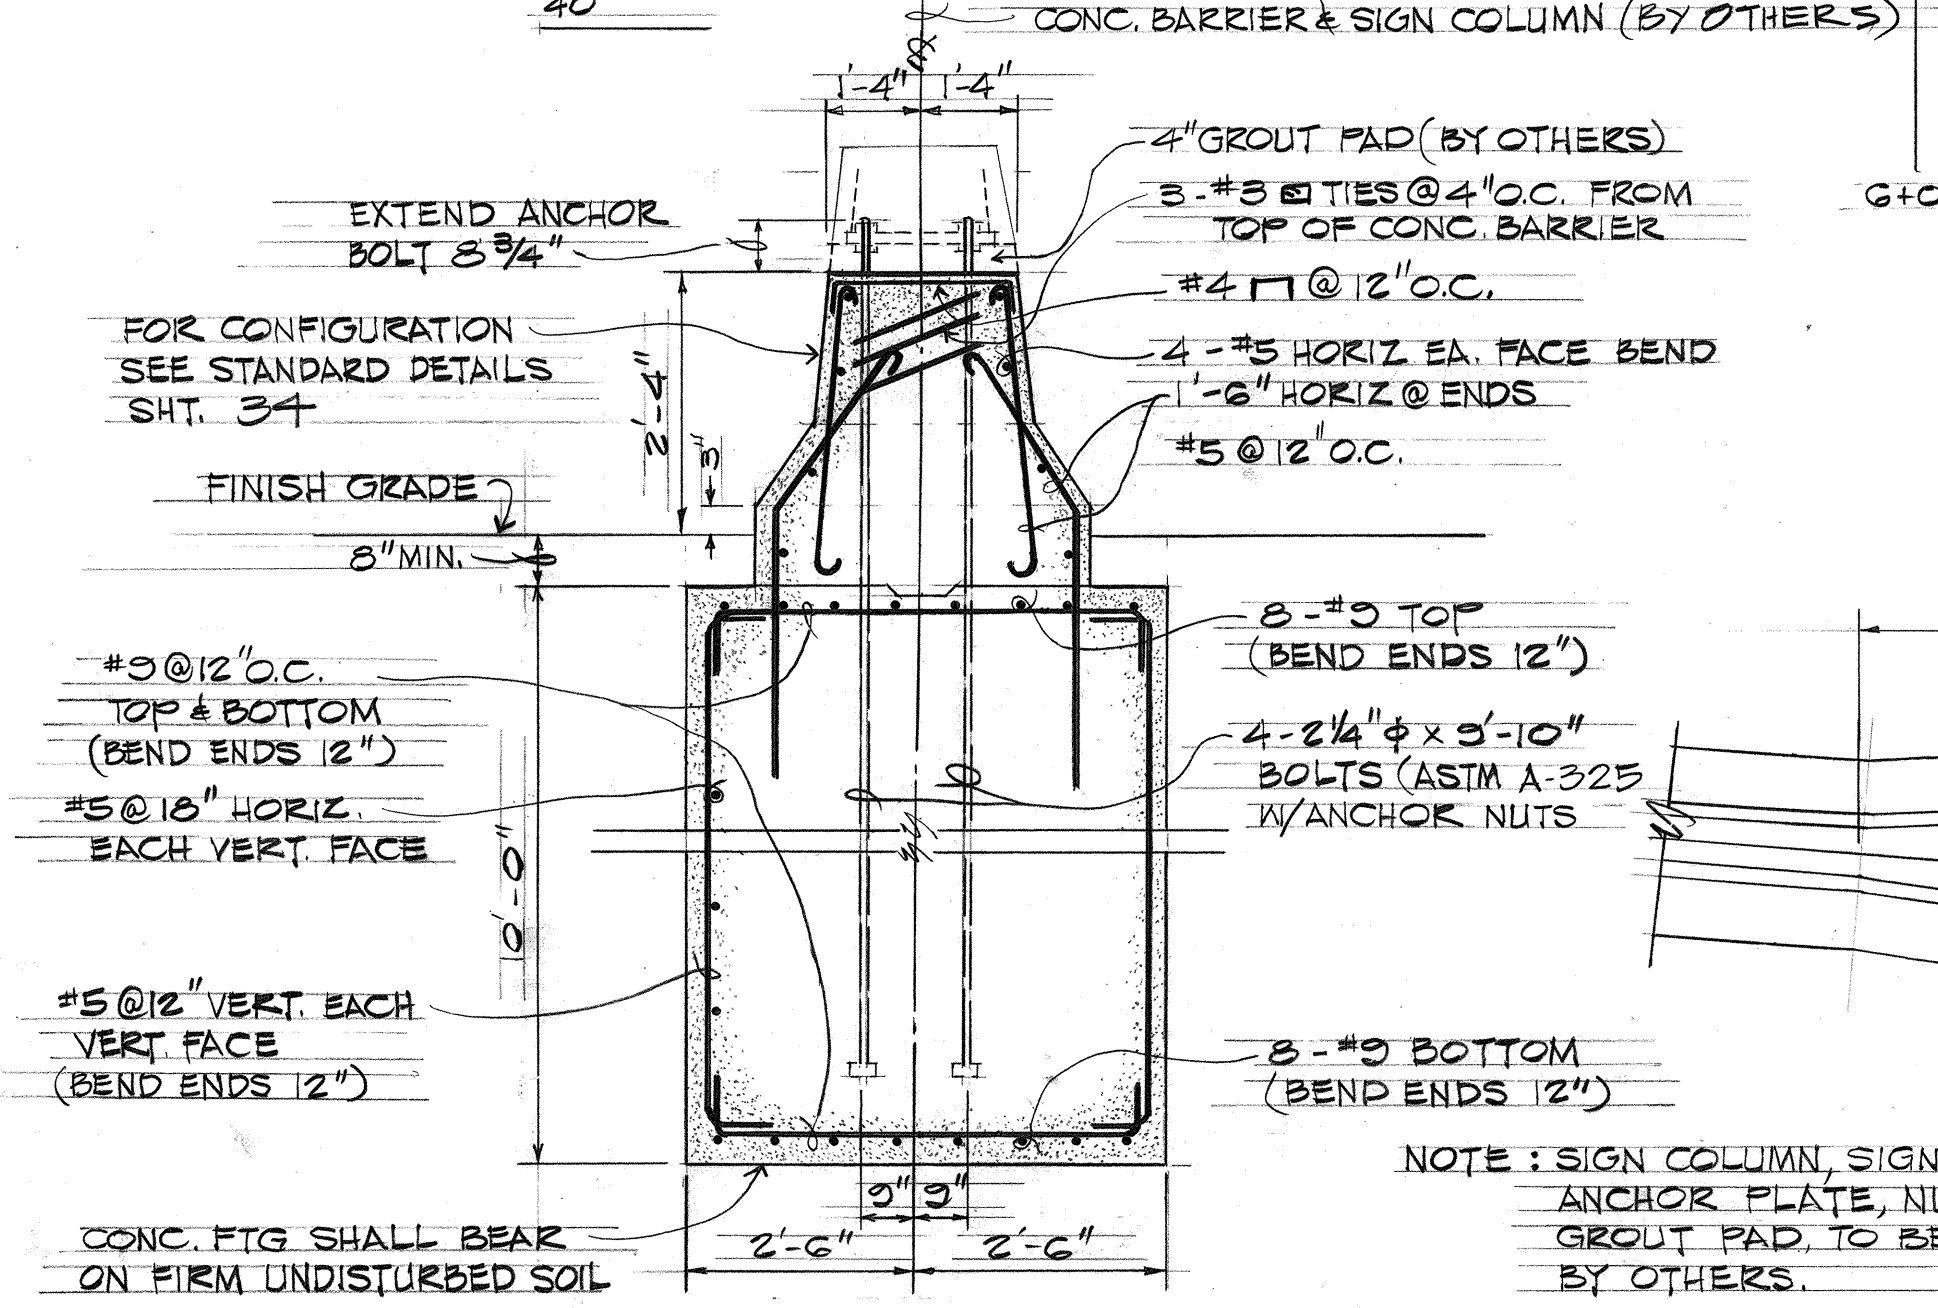


**SECTION**  
NO SCALE

**SIGN E2 SUPPORT ON CONC. BARRIER DETAILS**

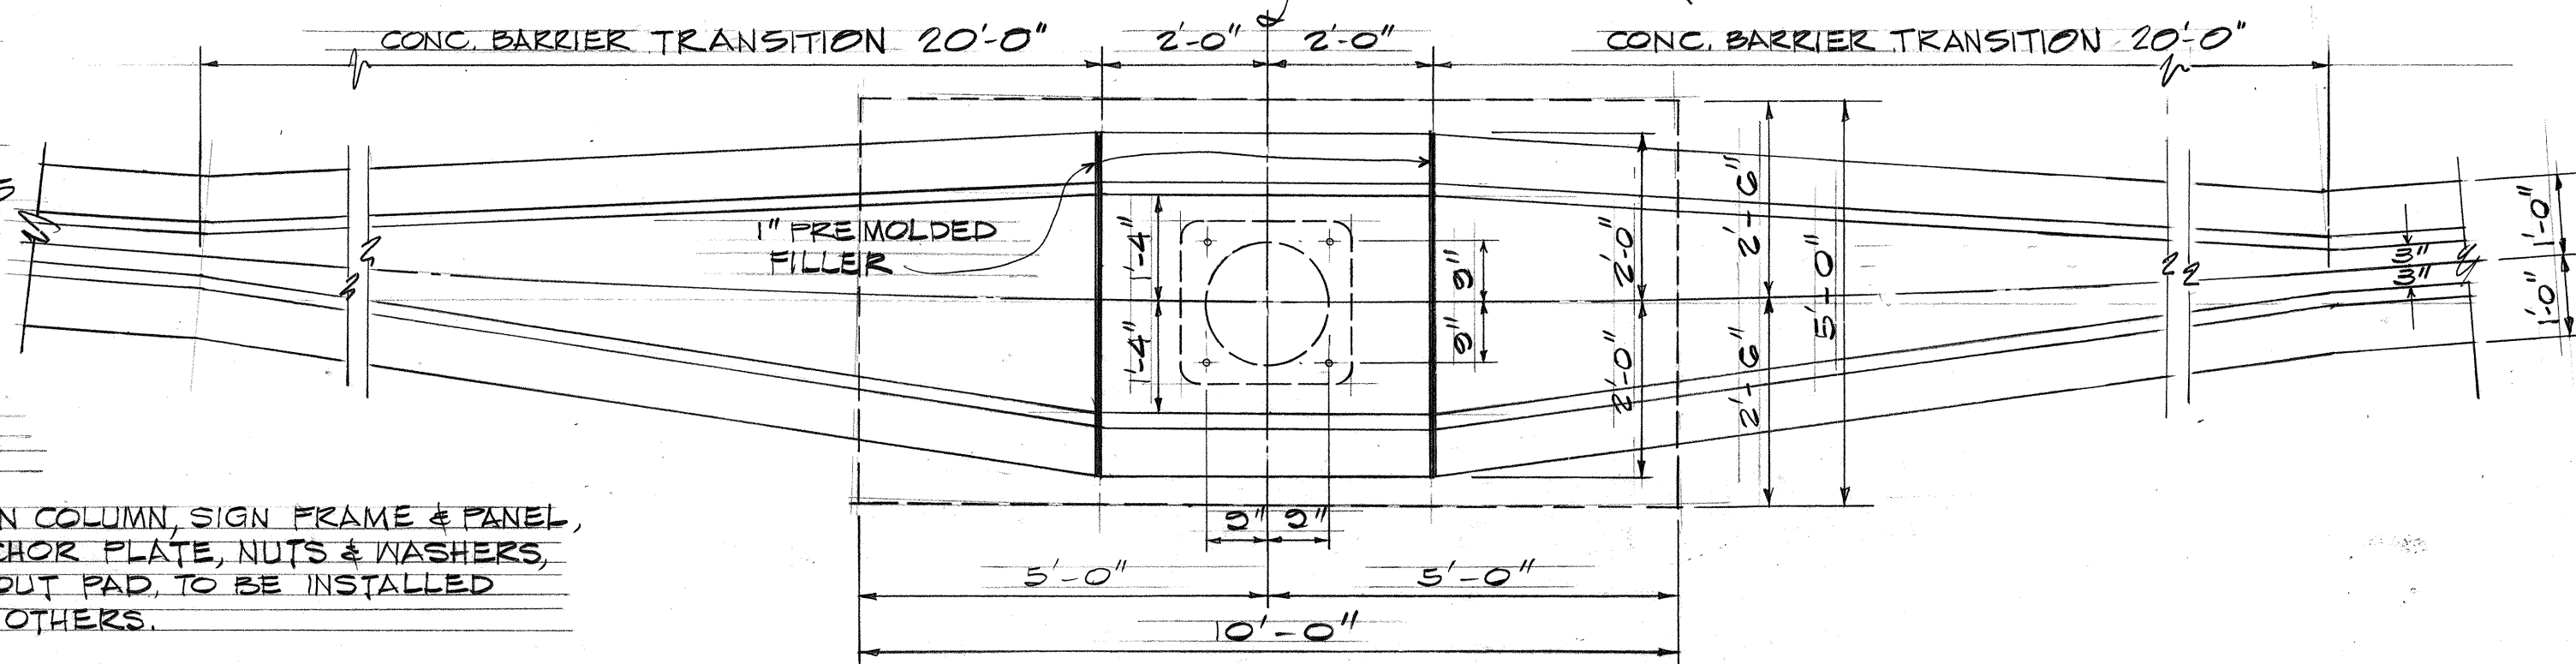

**PLAN**  
SCALE: 1/2" = 1'-0"

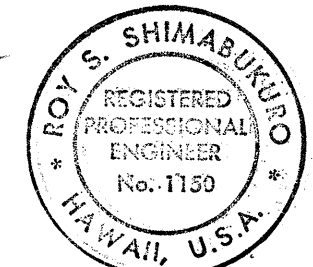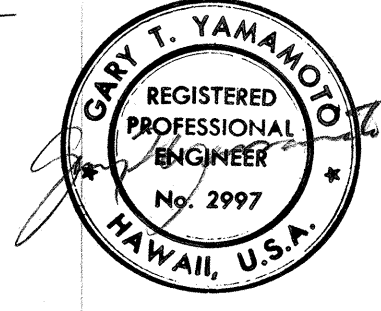

THIS WORK WAS PREPARED BY ME  
OR UNDER MY SUPERVISION

STATE OF HAWAII  
DEPARTMENT OF TRANSPORTATION  
HIGHWAYS DIVISION

FRONTAGE ROADS  
MEDIAN DETAILS

PEARL HARBOR INTERCHANGE  
F.A.I. Proj. No. I-HI-1(110):15

Scale: As Shown  
SHEET NO. 1 OF 2 SHEETS

|                   |       |
|-------------------|-------|
| DATE              | ..... |
| SURVEY PLOTTED BY | ..... |
| DRAWN BY          | ..... |
| DESIGNED BY       | ..... |
| CHECKED BY        | ..... |
| NO.               | ..... |