
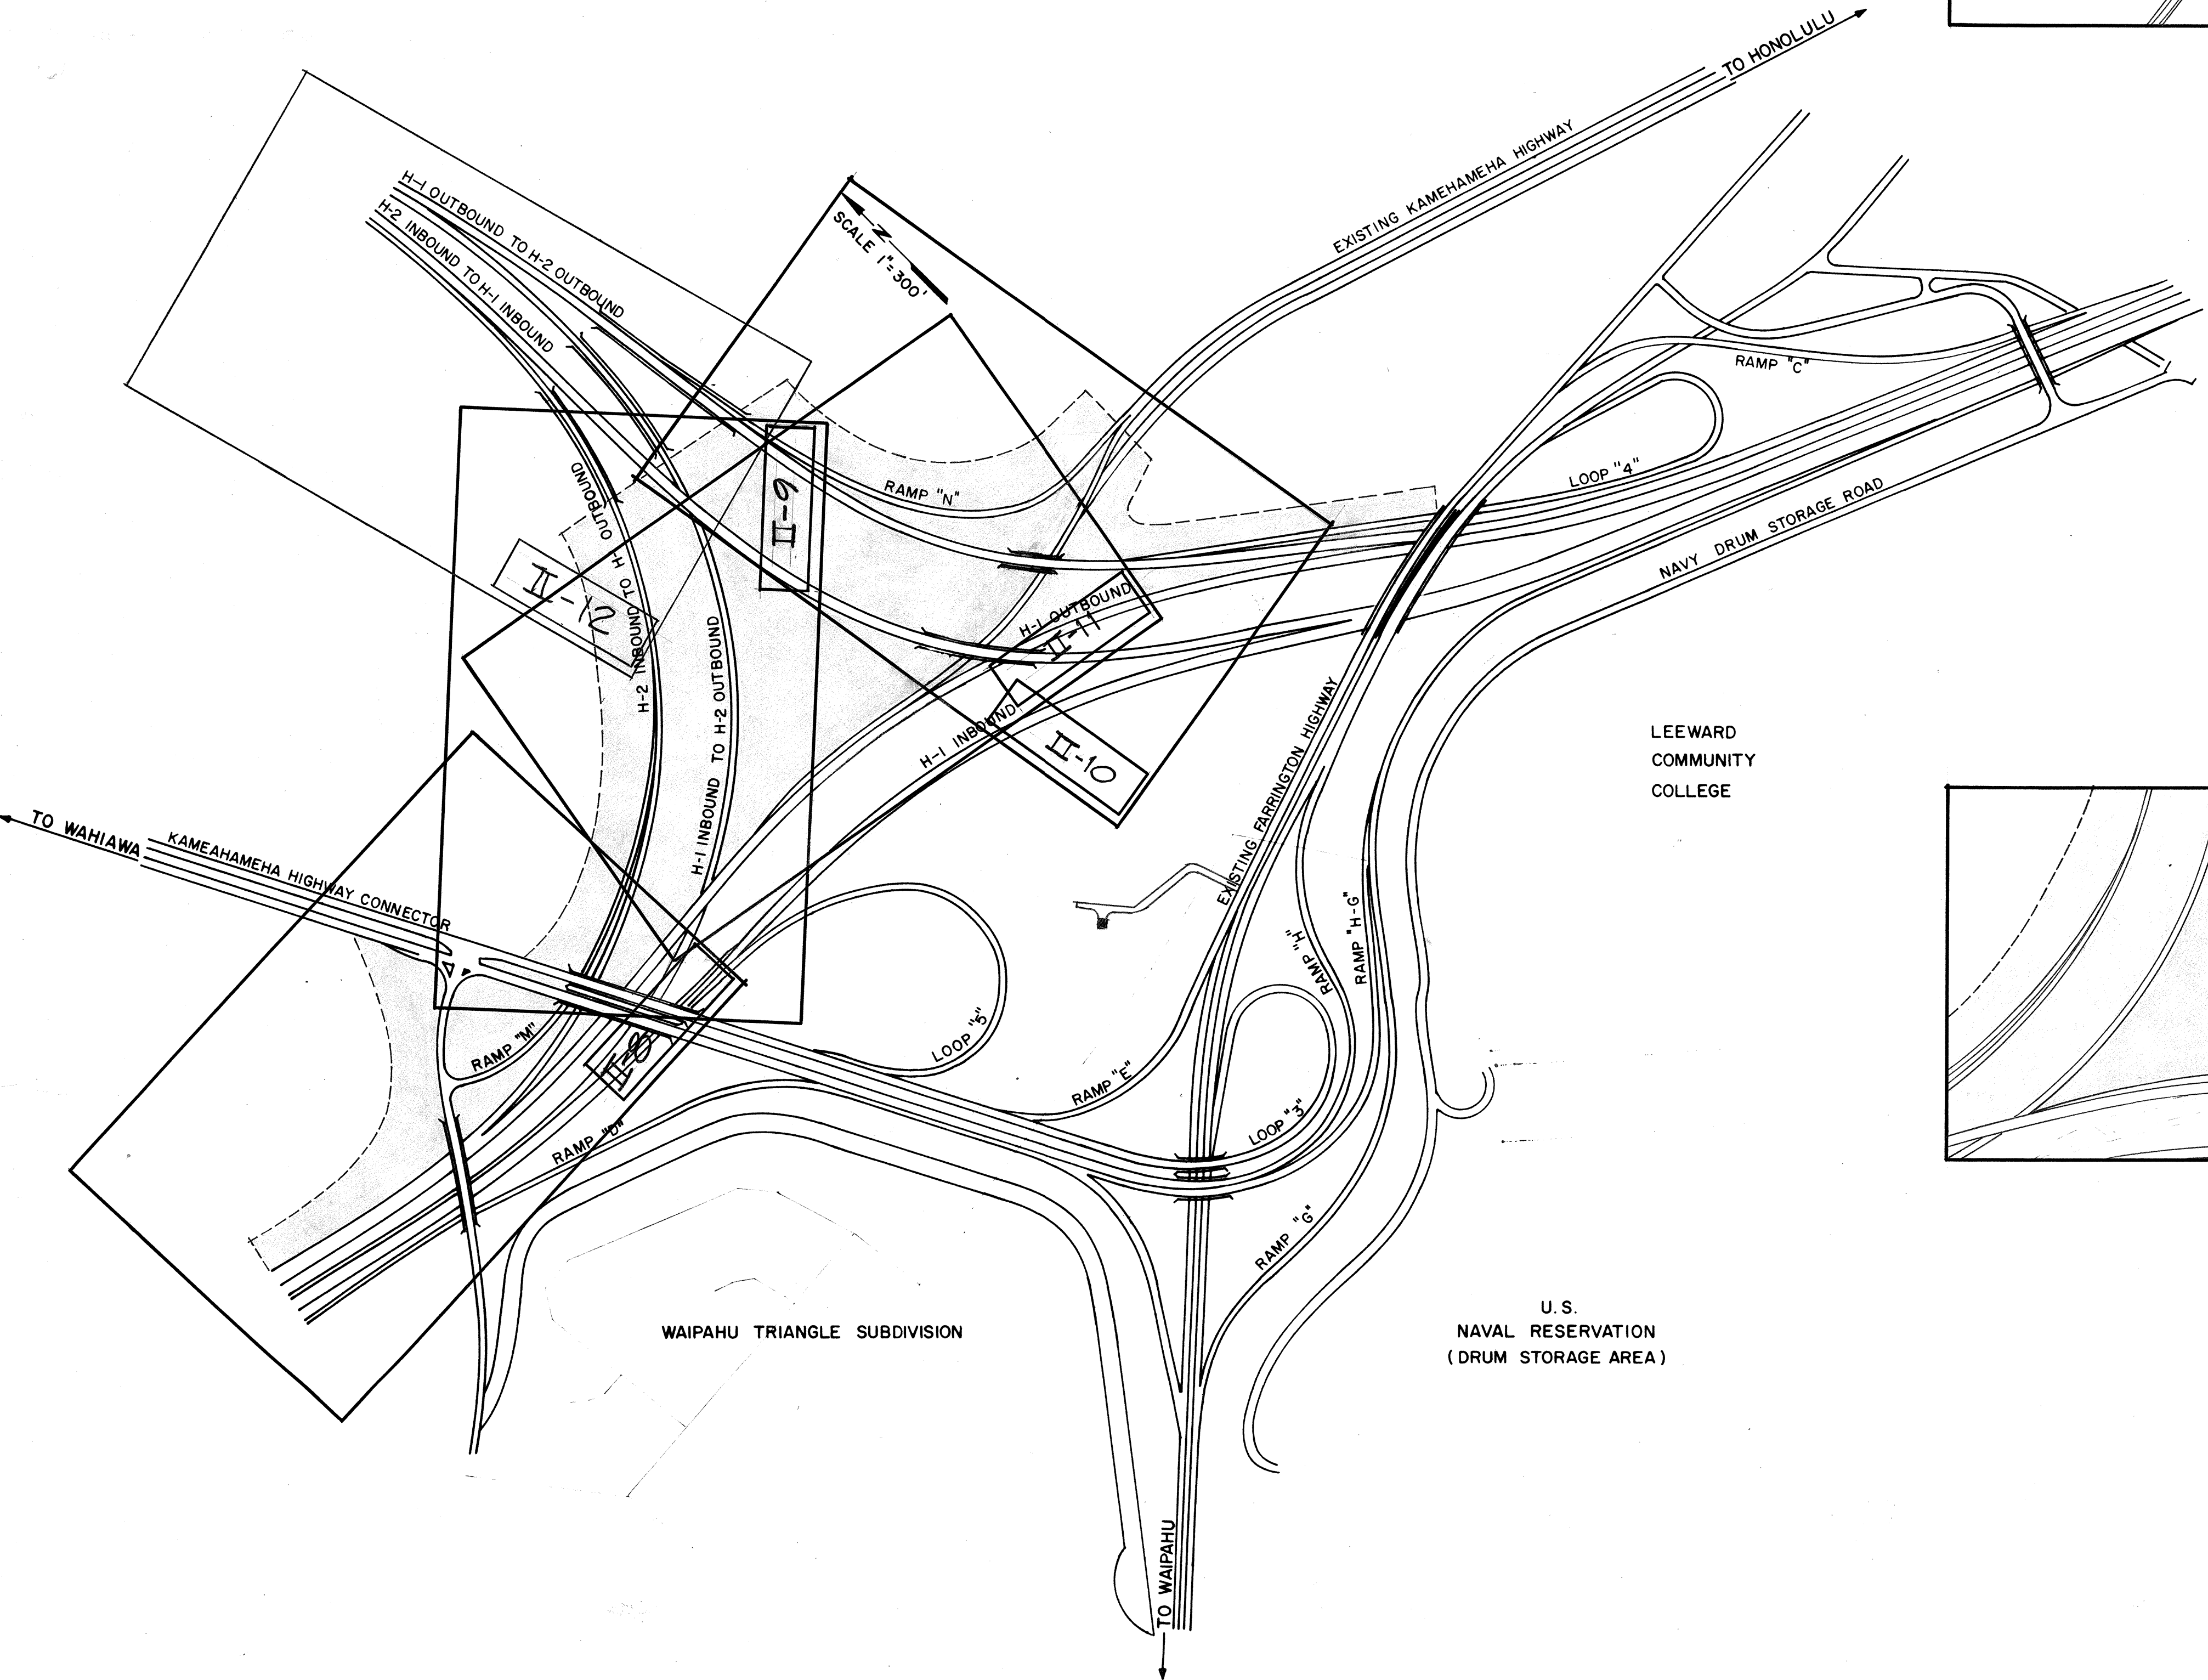
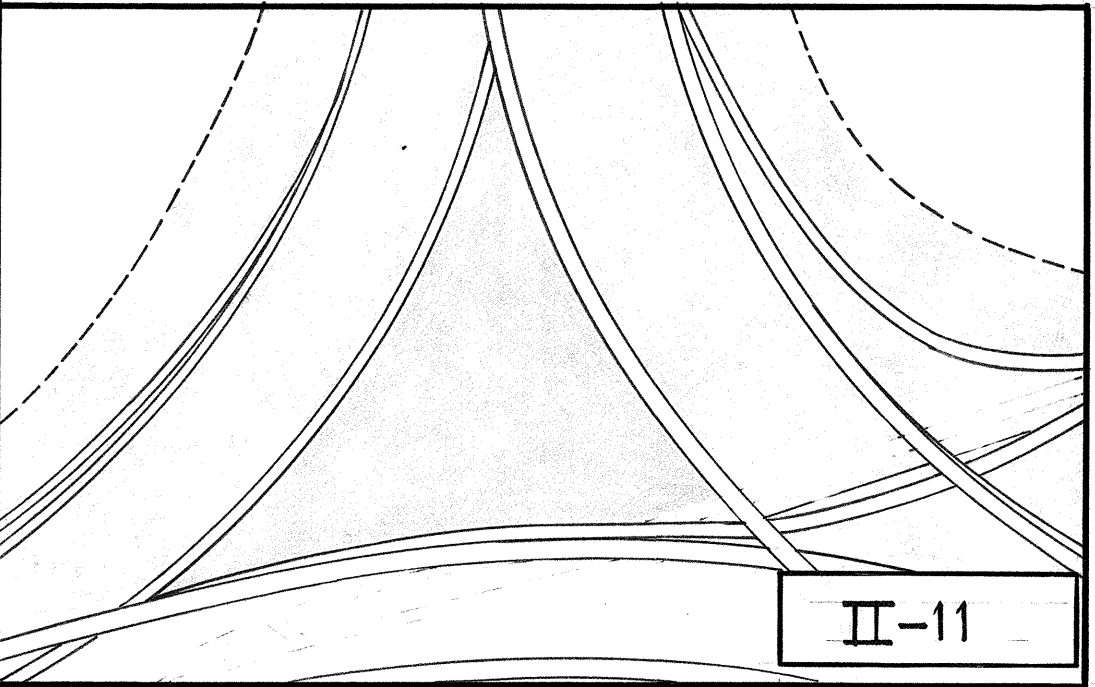
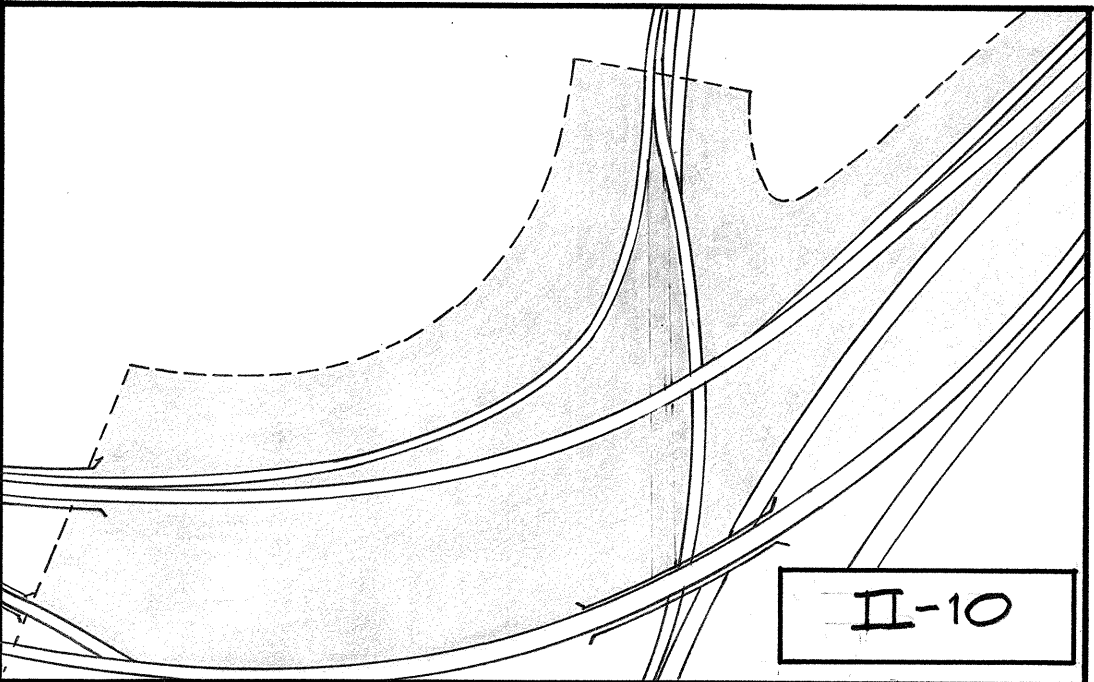
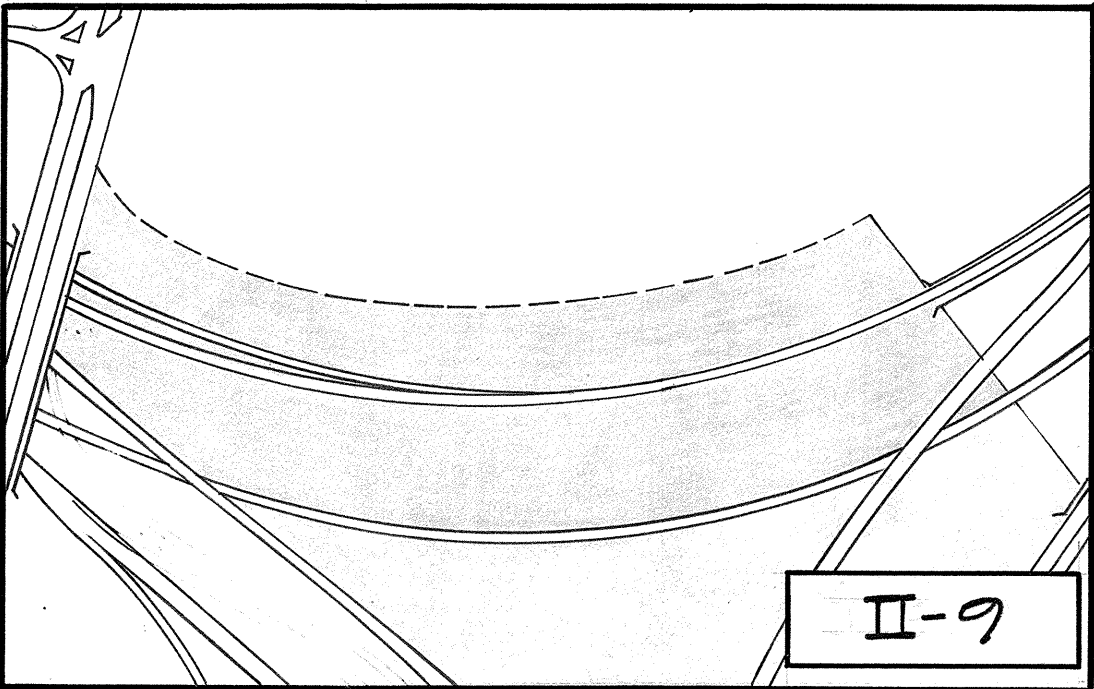


FED. ROAD DIST. NO.	STATE	FED. AID PROJ. NO.	FISCAL YEAR	SHEET NO.	TOTAL SHEETS
HAWAII	HAW.	7-41-(97)-8	1973	2	27

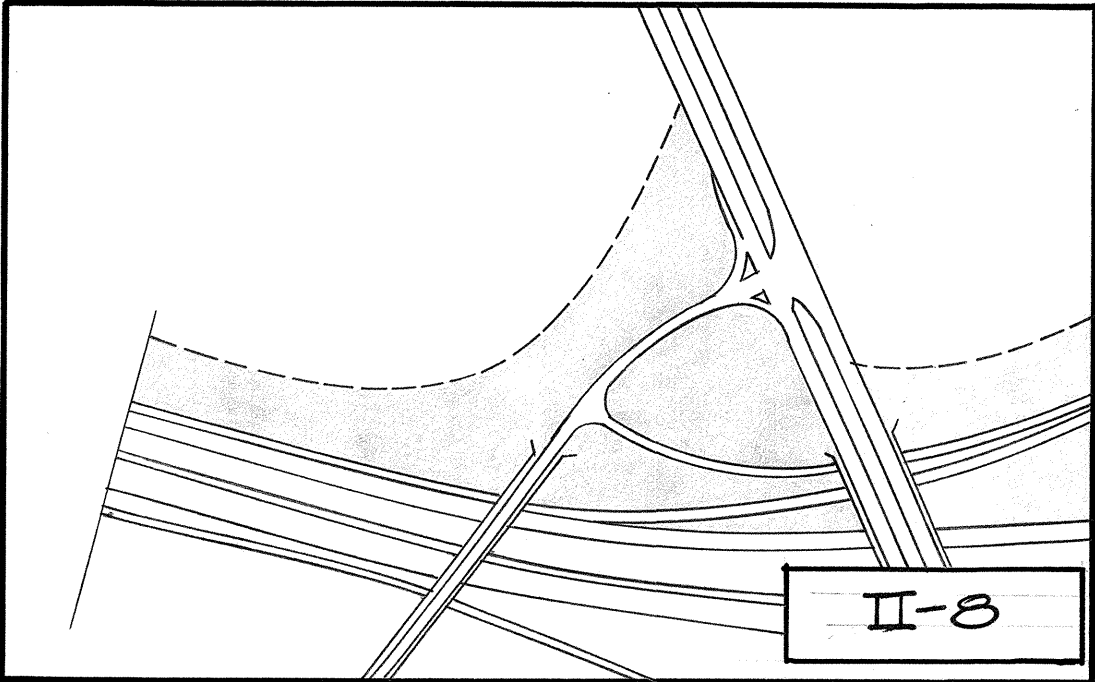

PHILLIP K. H. YEE & ASSOCIATES  
CONSULTING ENGINEERS  
243 Liliuokalani Ave., Rm. 101  
Honolulu, Hawaii 96813

THIS WORK WAS PREPARED BY ME  
OR UNDER MY SUPERVISION.

STATE OF HAWAII  
DEPARTMENT OF TRANSPORTATION  
HIGHWAYS DIVISION

**WAIAWA INTERCHANGE**  
WATER SPRINKLER SYSTEM  
PROJ # 7-41-(97)-8

AREA LOCATION  
KEY SHEET - PH. II

DESIGNED BY	DATE
DRAWN BY	
CHECKED BY	
INCHES BY	
NOTES BY	
REVISIONS BY	