


FED. ROAD DIST. NO.	STATE	FED. AID PROJ. NO.	FISCAL YEAR	SHEET NO.	TOTAL SHEETS
HAWAII	HAW.				

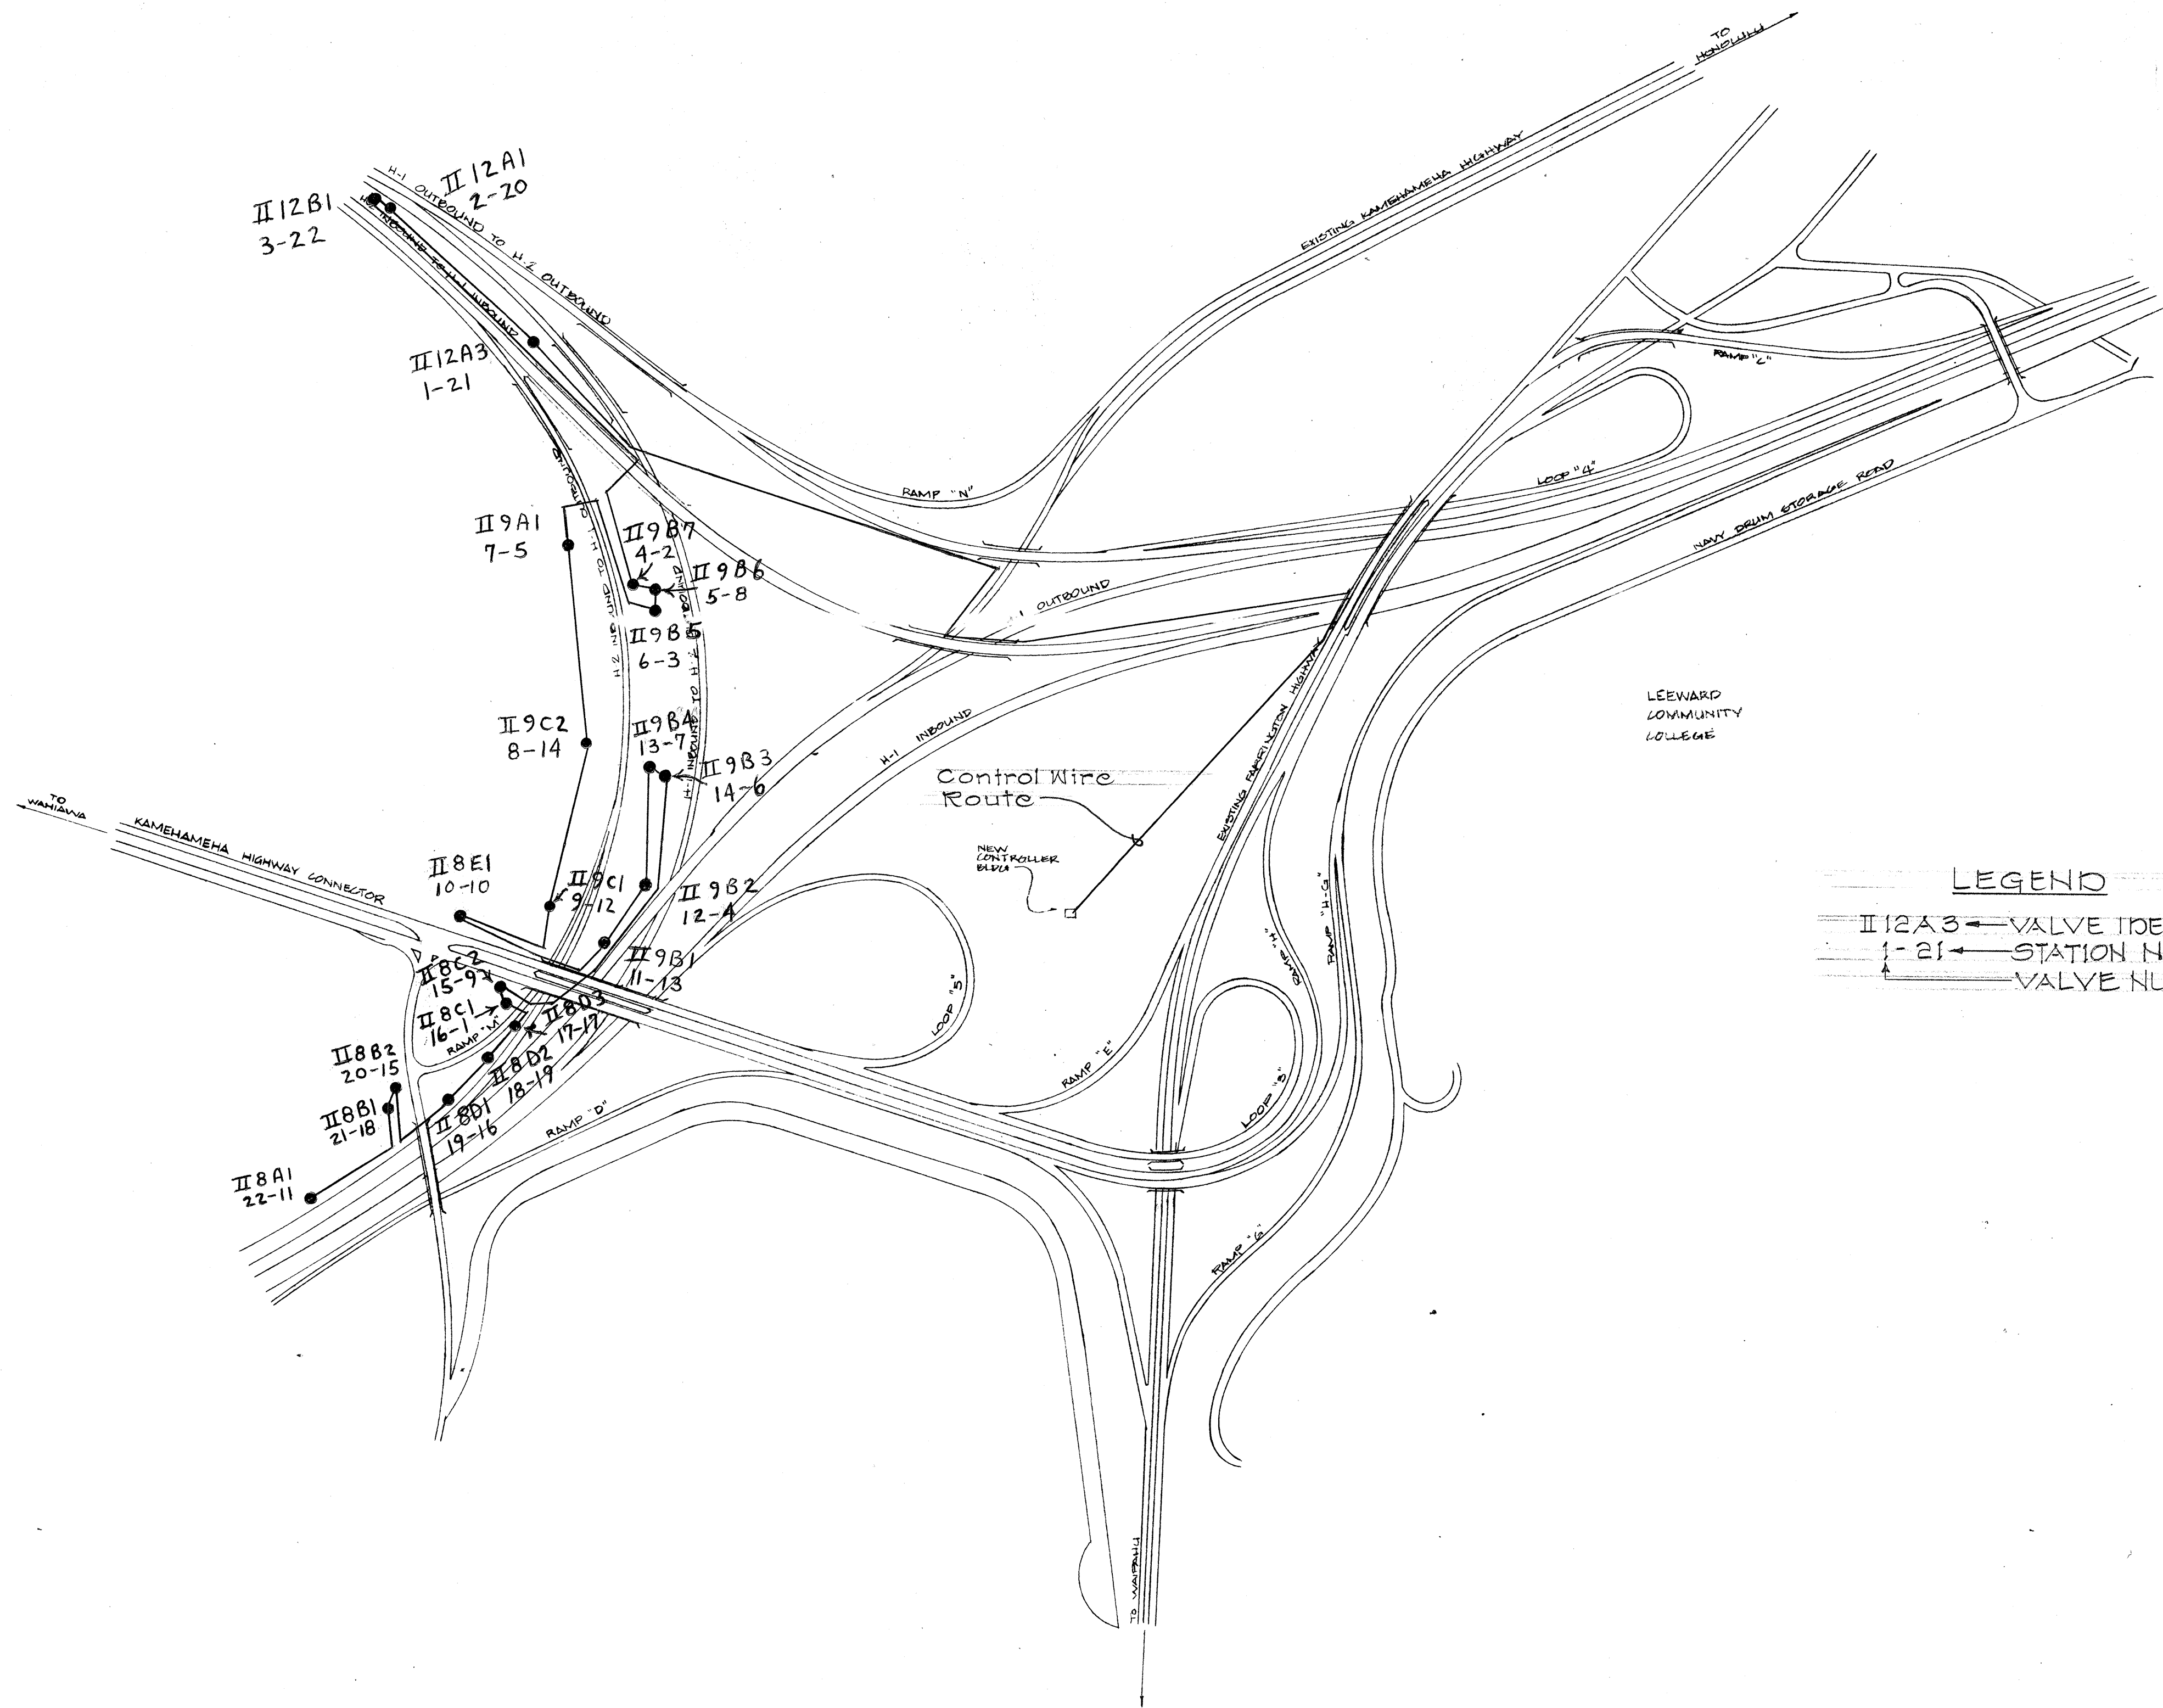

LEGEND
 II 12 A 3 VALVE IDENTIFICATION
 1-21 STATION NUMBER
 VALVE NUMBER

CONTROLLER J
 START TIME: 8:00 AM
 DAYS RUN: MONDAY, WEDNESDAY, FRIDAY

IDENTI.	VALVE NO.	STATION NO.	TIME (MIN)
II 12 A 3	1	21	5
II 12 A 1	2	20	15
II 12 B 1	3	22	5
II 9 B 7	4	2	20
II 9 B 6	5	8	20
II 9 B 5	6	3	20
II 9 A 1	7	5	20
II 9 C 2	8	14	15
II 9 C 1	9	12	15
II 8 E 1	10	10	5
II 9 B 1	11	13	15
II 9 B 2	12	4	30
II 9 B 4	13	7	20
II 9 B 3	14	6	20
II 8 C 2	15	0	20
II 8 C 1	16	1	30
II 8 D 3	17	17	5
II 8 D 2	18	19	20
II 8 D 1	19	16	30
II 8 B 2	20	15	20
II 8 B 1	21	18	20
II 8 A 1	22	11	20


STATE OF HAWAII
DEPARTMENT OF TRANSPORTATION
HIGHWAYS DIVISION

Waiawa Interchange
Control Wire Route location for
"J" Controller
Proj No. I-HI-1(97):8

SHEET NO. 1451 OF 18 SHEETS

ORIGINAL PLAN	SURVEY PLOTTED BY	DATE
NOTE BOOK No.	DRAWN BY	
	TRACED BY	
	DESIGNED BY	
	QUANTITIES BY	
	CHECKED BY	

FED. ROAD DIST. NO.	STATE	FED. AID PROJ. NO.	FISCAL YEAR	SHEET NO.	TOTAL SHEET
HAWAII	HAW.				

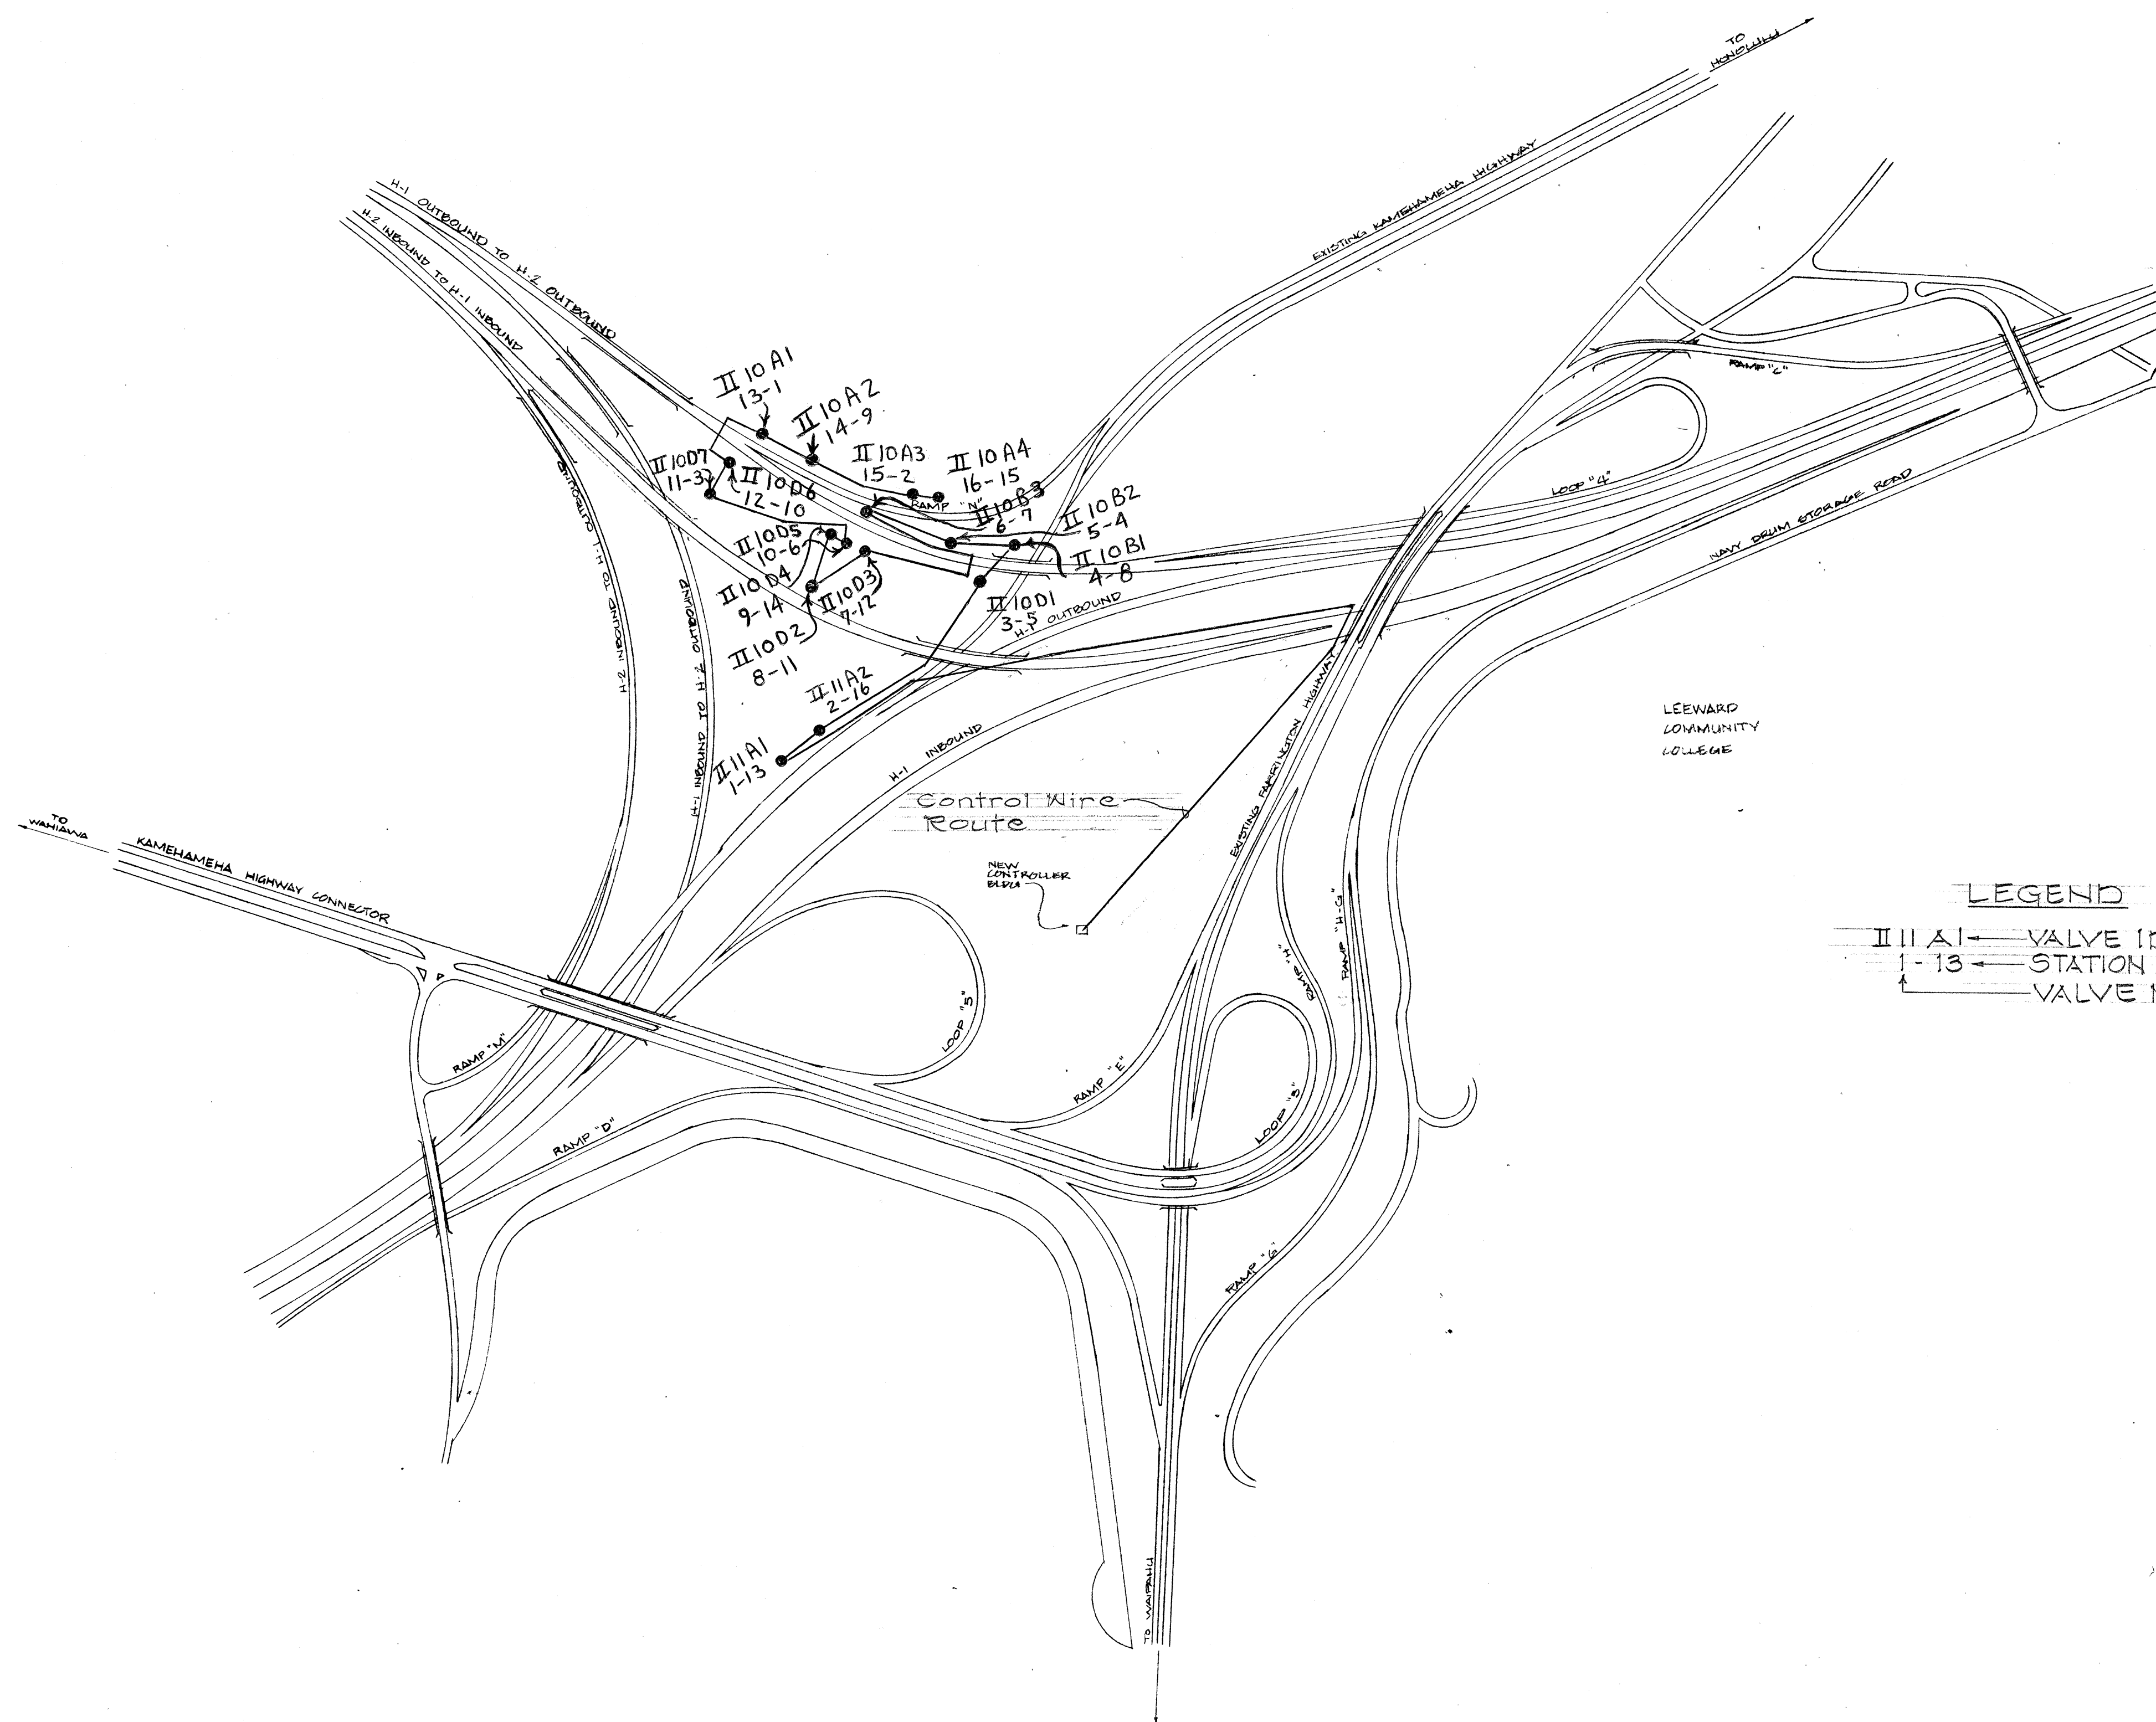

CONTROLLER K
STARTTIME: 8:00 A.M.
DAYS RUN: MONDAY, WEDNESDAY,
FRIDAY

LEGEND

III A1 — VALVE IDENTIFICATION
1 - 13 — STATION NUMBER
↑ — VALVE NUMBER

IDENT.	VALVE NO	STATION NO.	TIME (MIN)
II11A1	1	13	30
II11A2	2	16	20
II10D1	3	5	30
II10B1	4	8	30
II10B2	5	4	15
II10B3	6	7	5
II10D3	7	12	30
II10D2	8	11	30
II10D4	9	14	30
II10D5	10	6	5
II10D7	11	3	15
II10D6	12	10	30
II10A1	13	1	30
II10A2	14	9	30
II10A3	15	2	30
II10A4	16	15	20


ORIGINAL PLAN	SURVEY PLOTTED BY _____ DATE _____
	DRAWN BY _____
	TRACED BY _____
	DESIGNED BY _____
	QUANTITIES BY _____
	CHECKED BY _____
	No. _____

STATE OF HAWAII
DEPARTMENT OF TRANSPORTATION
HIGHWAYS DIVISION

Waiawa Interchange
Control Wire Route location for
"K" Controller
Proj No. I-HI-1(97):8

SHEET No. 145-2 OF 18 SHEETS

FED. ROAD DIST. NO.	STATE	FED. AID PROJ. NO.	FISCAL YEAR	SHEET NO.	TOTAL SHEETS
HAWAII	HAW.				

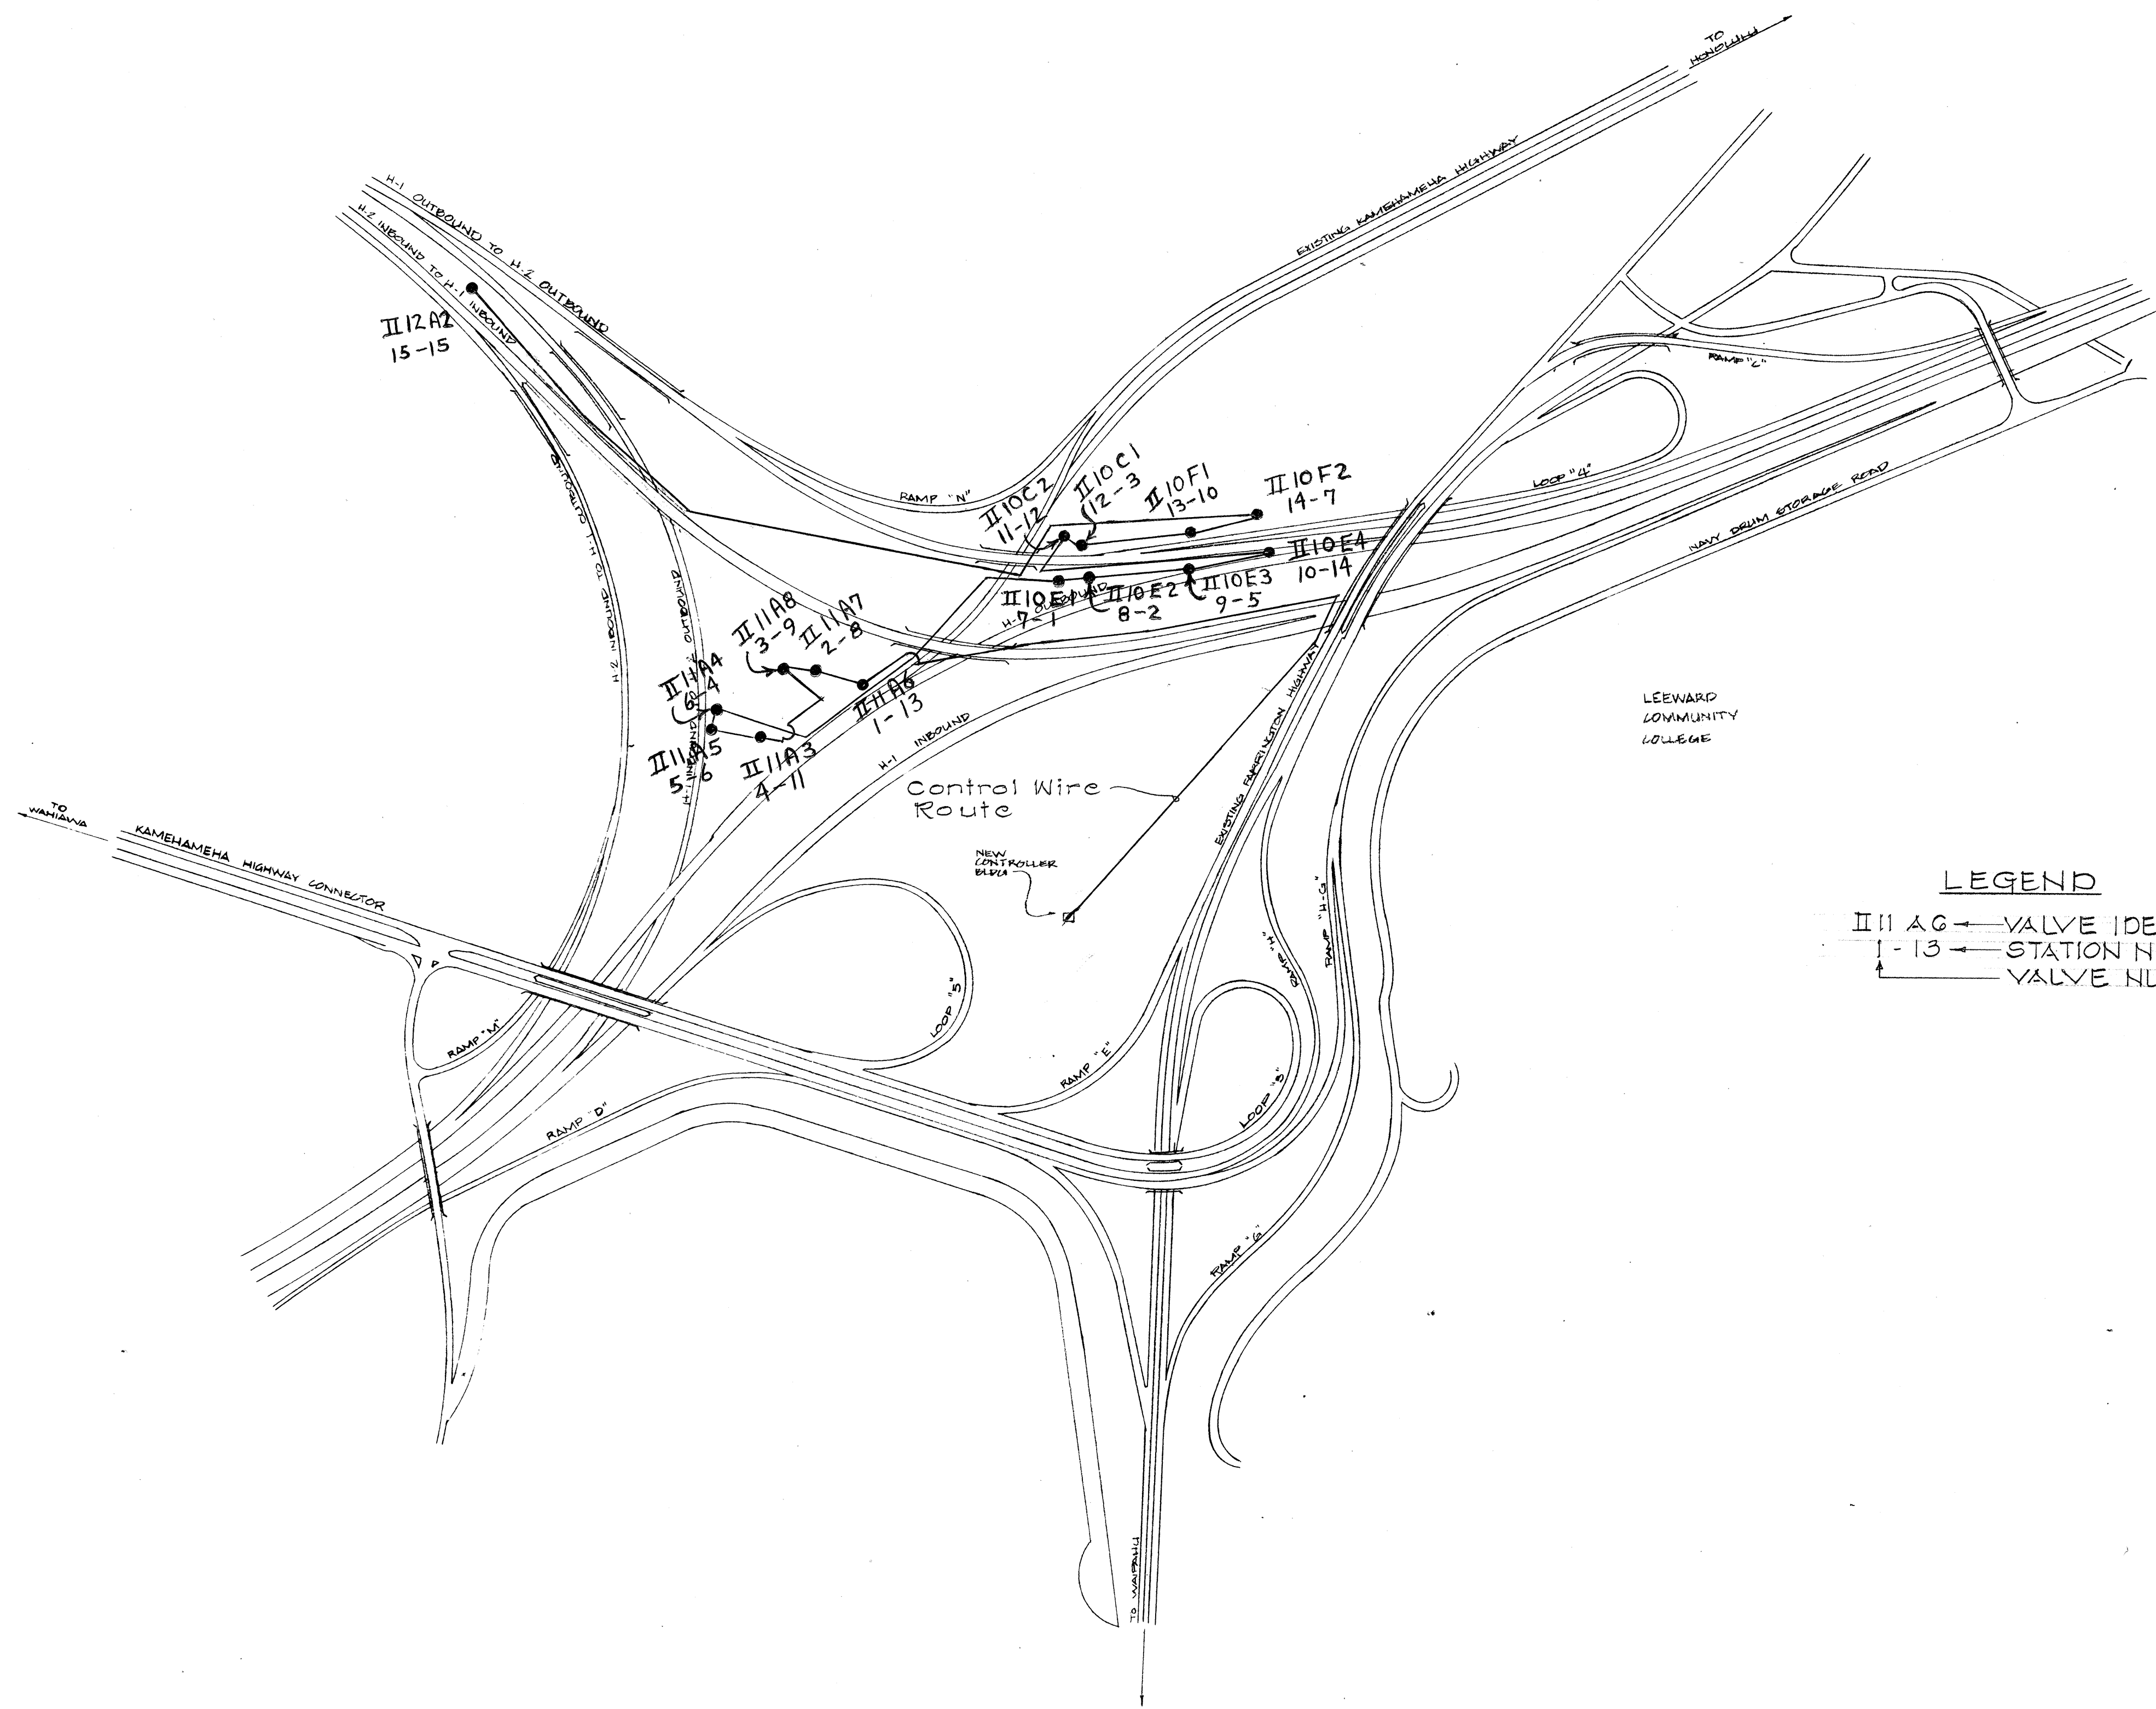

LEGEND
 II 11 A G ← VALVE IDENTIFICATION
 1 - 13 ← STATION NUMBER
 ← VALVE NUMBER

CONTROLLER L
 START TIME: 8:00 AM
 DAYS RUN: MONDAY, WEDNESDAY, FRIDAY

IDENTI.	VALVE NO.	STATION NO.	TIME (MIN)
II 11 A 6	1	13	5
II 11 A 7	2	8	30
II 11 A 8	3	9	30
II 11 A 3	4	11	30
II 11 A 5	5	6	20
II 11 A 4	6	4	30
II 10 E 1	7	1	30
II 10 E 2	8	2	30
II 10 E 3	9	5	20
II 10 E 4	0	14	5
II 10 C 2	11	12	20
II 10 C 1	12	3	30
II 10 F 1	13	10	30
II 10 F 2	14	7	30
II 10 A 2	15	15	20

STATE OF HAWAII
DEPARTMENT OF TRANSPORTATION
HIGHWAYS DIVISION

Waiawa Interchange
Control Wire Route location for
"L" Controller
Proj No. I-HI-1(97):8

SHEET NO. 1453 OF 18 SHEETS

ORIGINAL PLAN	SURVEY PLOTTED BY	DATE
NOTE BOOK	DESIGNED BY	
QUANTITIES BY	CHECKED BY	
NO.		