
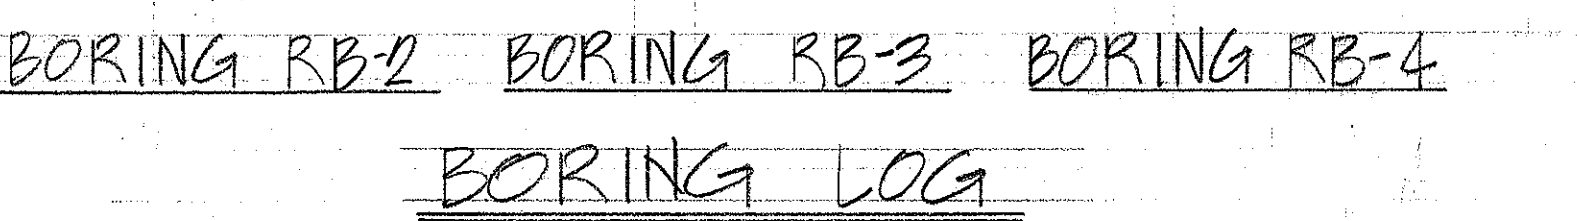
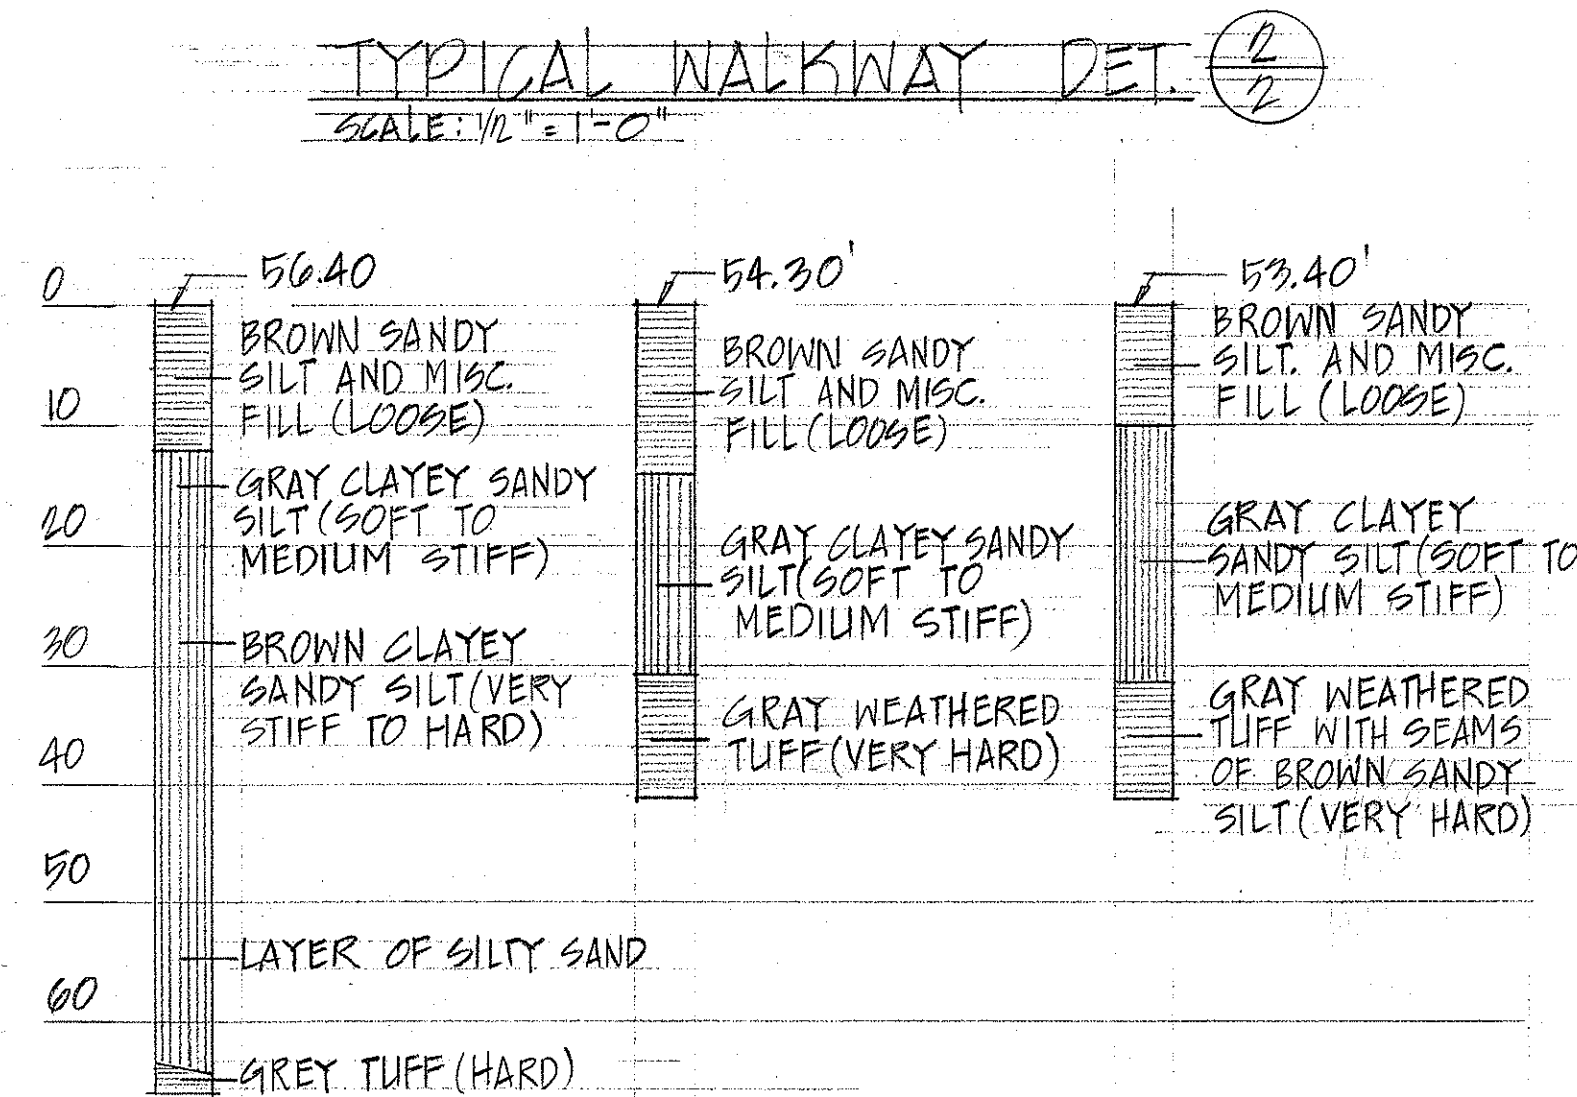


ORIGINAL	SURVEY PLOTTED BY	DATE
PLAN	DRAWN BY	"
	TRACED BY	"
NOTE BOOK	DESIGNED BY	"
	QUANTITIES BY	"
No.	CHECKED BY	"

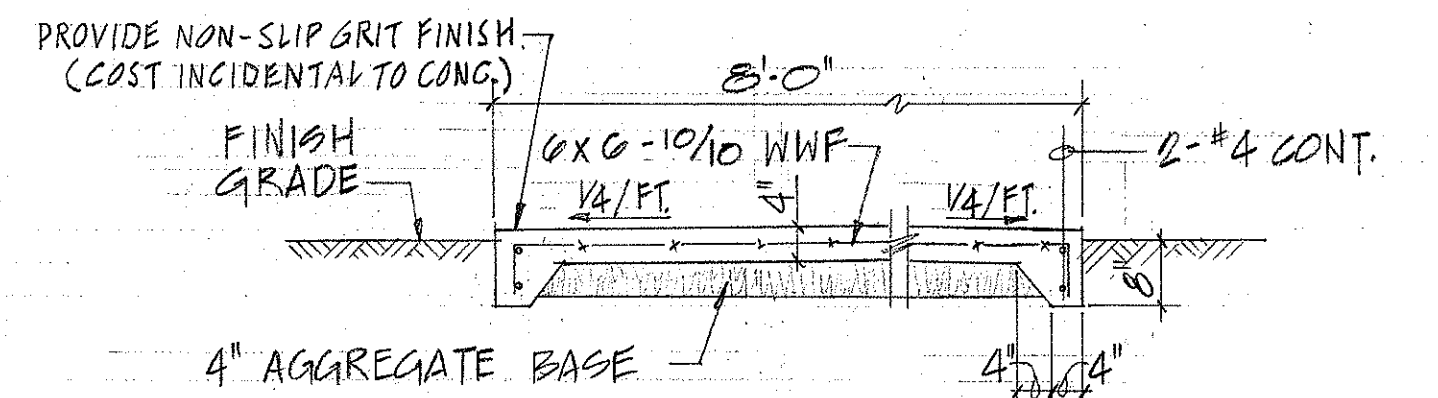

LAYOUT PLAN AND E PROFILE

SCALE: AS SHOWN DATE: 1/29/13

SHEET No. 2 OF 10 SHEETS

THIS WORK WAS PREPARED BY
ME OR UNDER MY SUPERVISION.

John M. Lee