



| FED. ROAD<br>DIST. NO. | STATE | FED. AID<br>PROJ. NO. | FISCAL<br>YEAR | SHEET<br>NO. | TOTAL<br>SHEETS |
|------------------------|-------|-----------------------|----------------|--------------|-----------------|
| HAWAII                 | HAW.  | I-41-(105)-14         | 1973           | 4            | 16              |

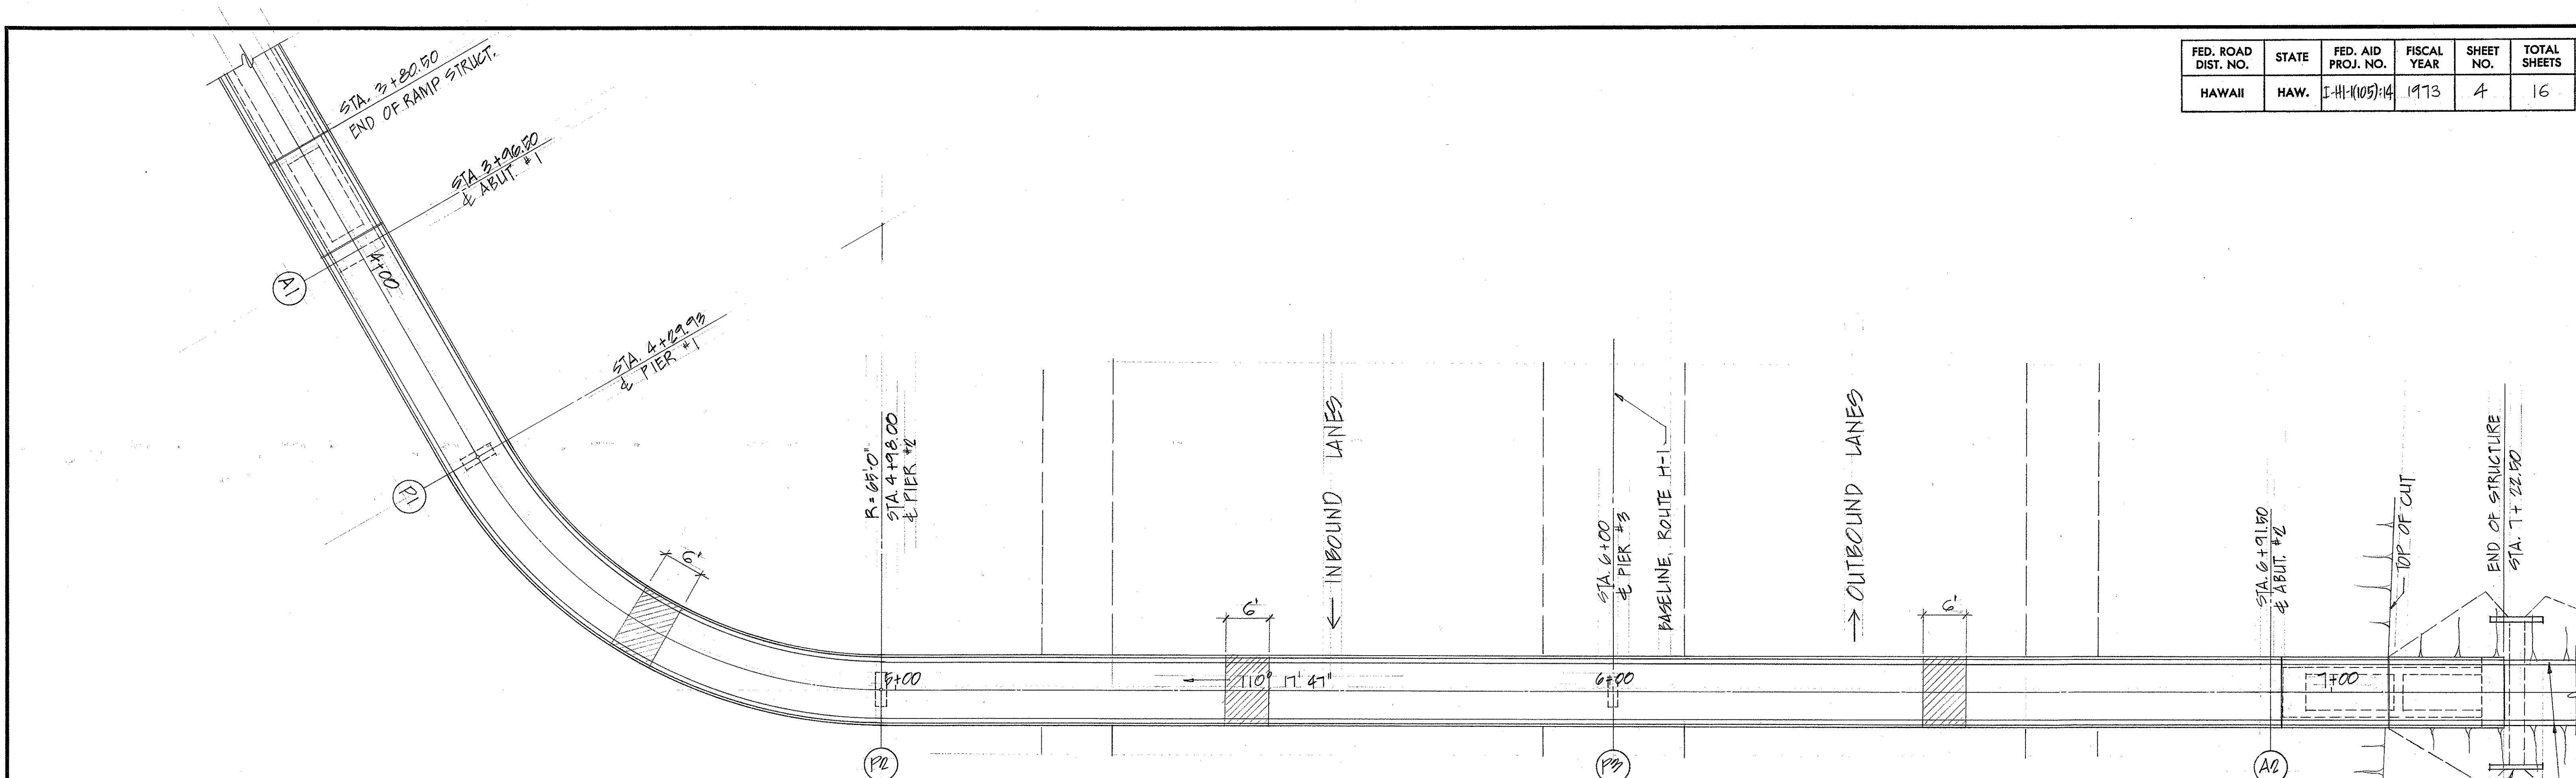

## PARTIAL PLAN

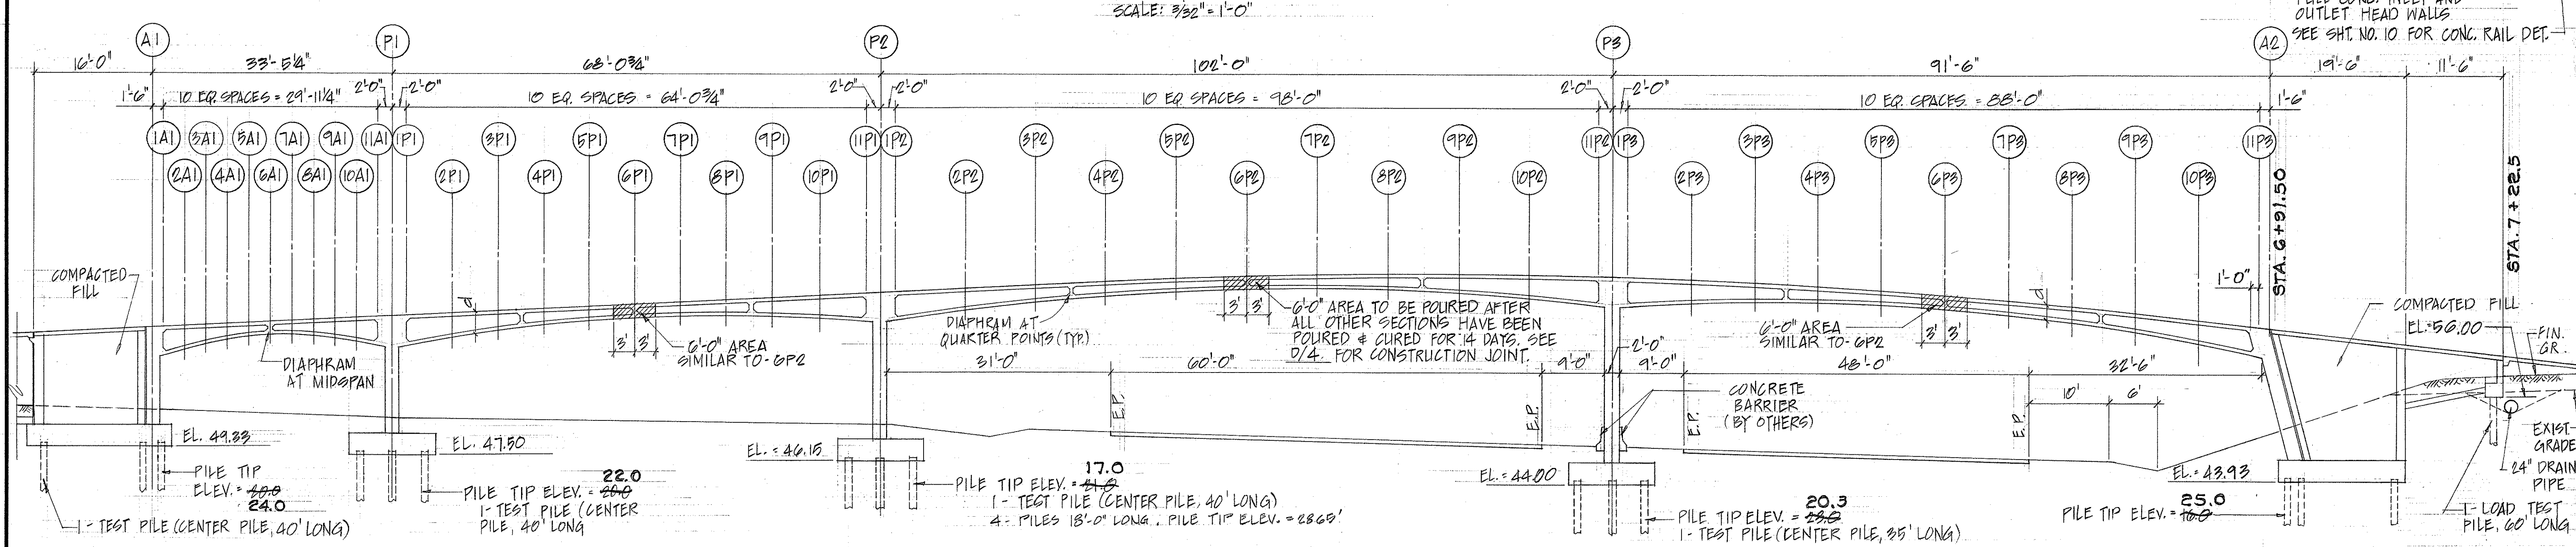

LONGITUDINAL SECTION

NOTE:  $d = 48$  IN. AT FACE OF ABUTMENTS AND PIERS.

[illegible]

**STATE OF HAWAII  
DEPARTMENT OF TRANSPORTATION  
HIGHWAYS DIVISION**

OVERPASS PLAN &  
LONGITUDINAL SECTION

INTERSTATE ROUTE M-1  
PEDESTRIAN OVERPASS AT MAKALAPA  
F.A.I. PROJ. NO. I-HI-1(105):14

SCALE: AS SHOWN DATE: 1/29/73  
SHEET No. 3 OF 10 SHEETS