

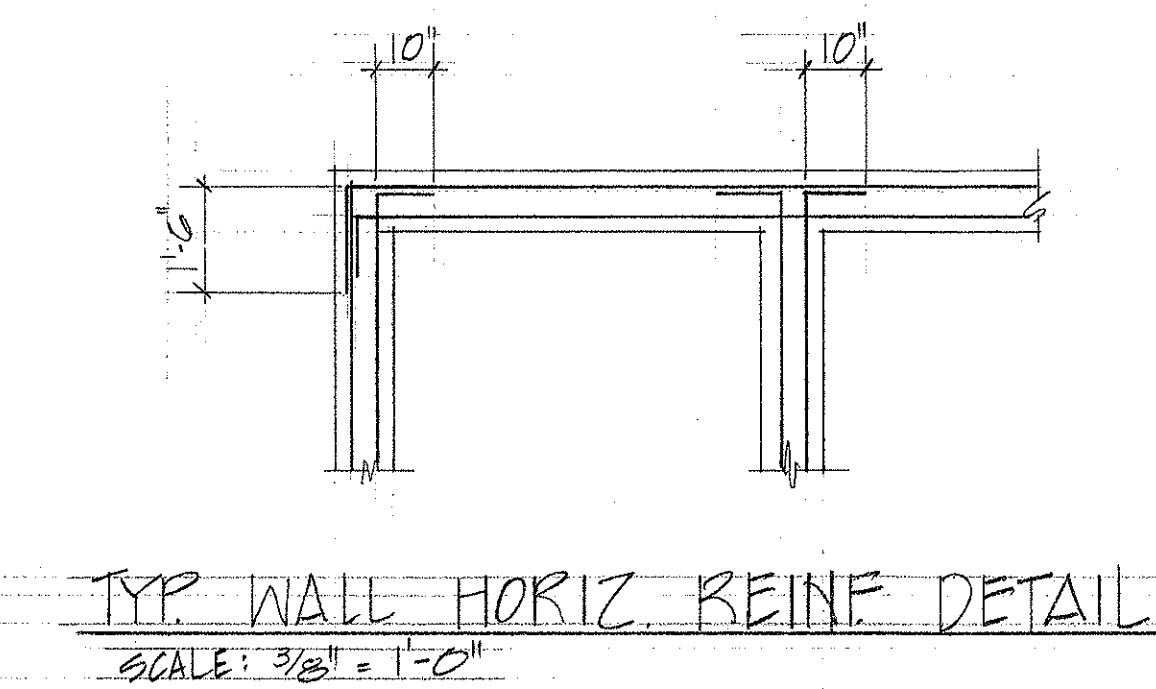
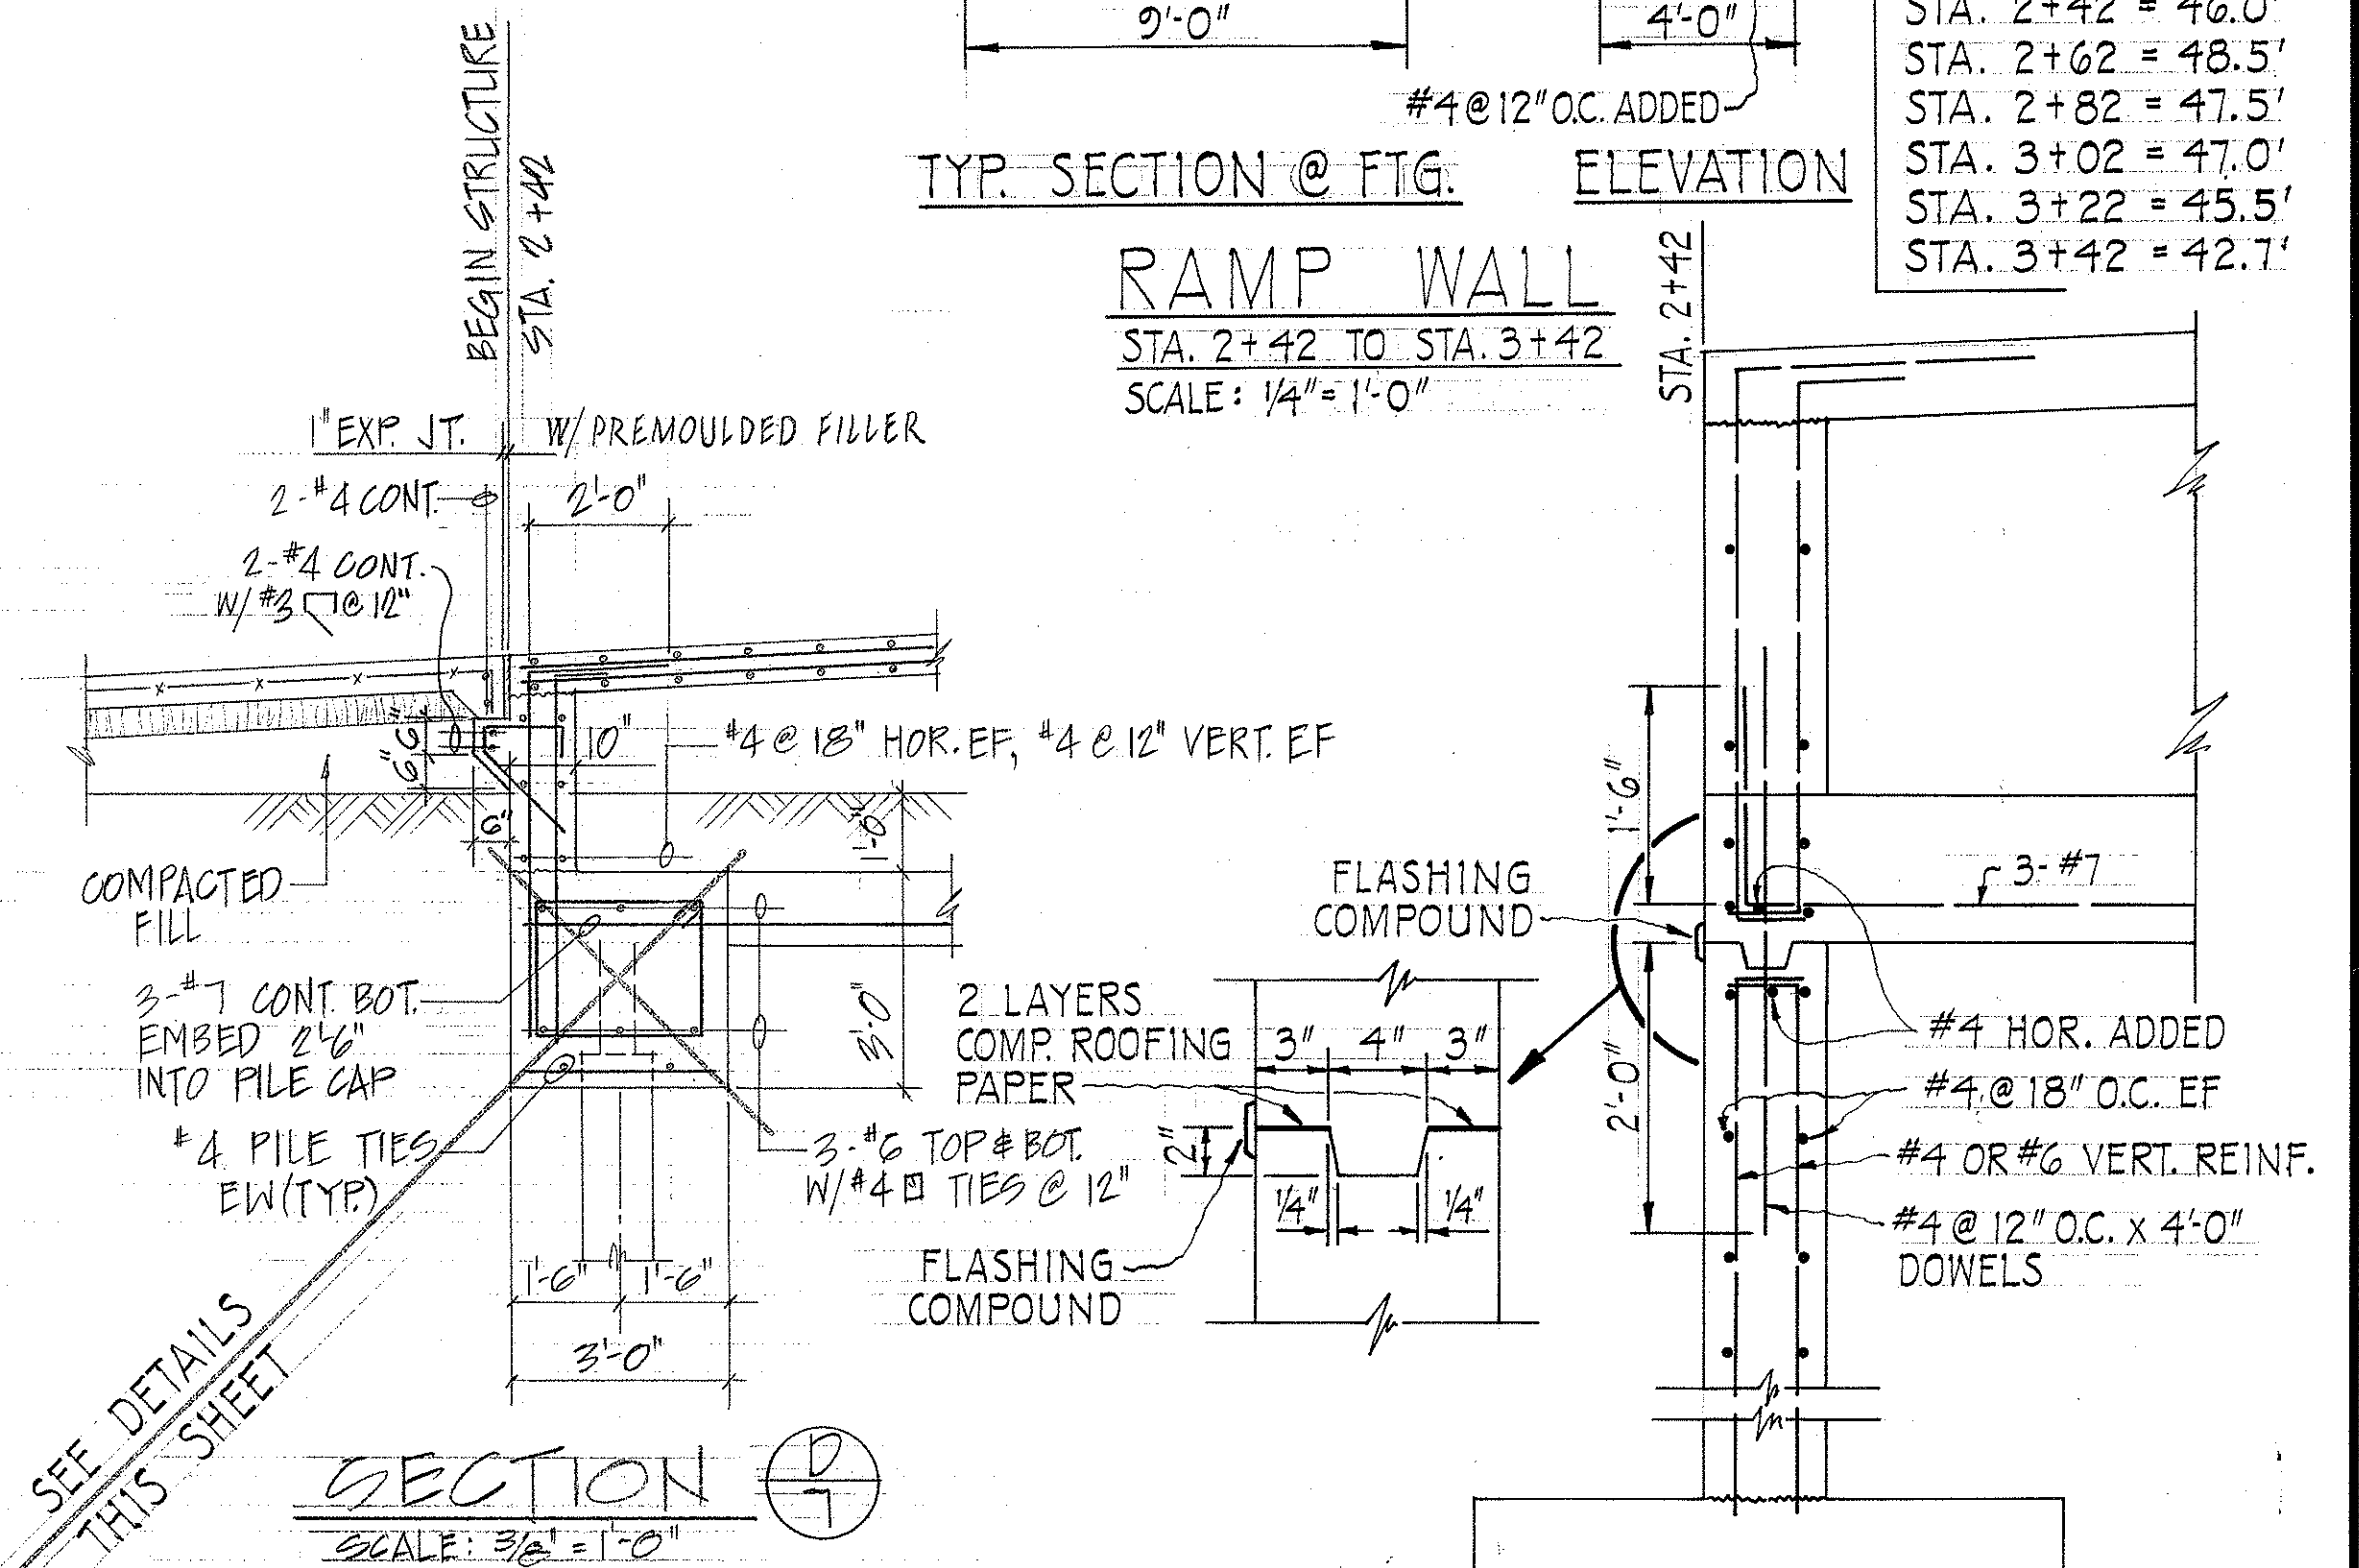
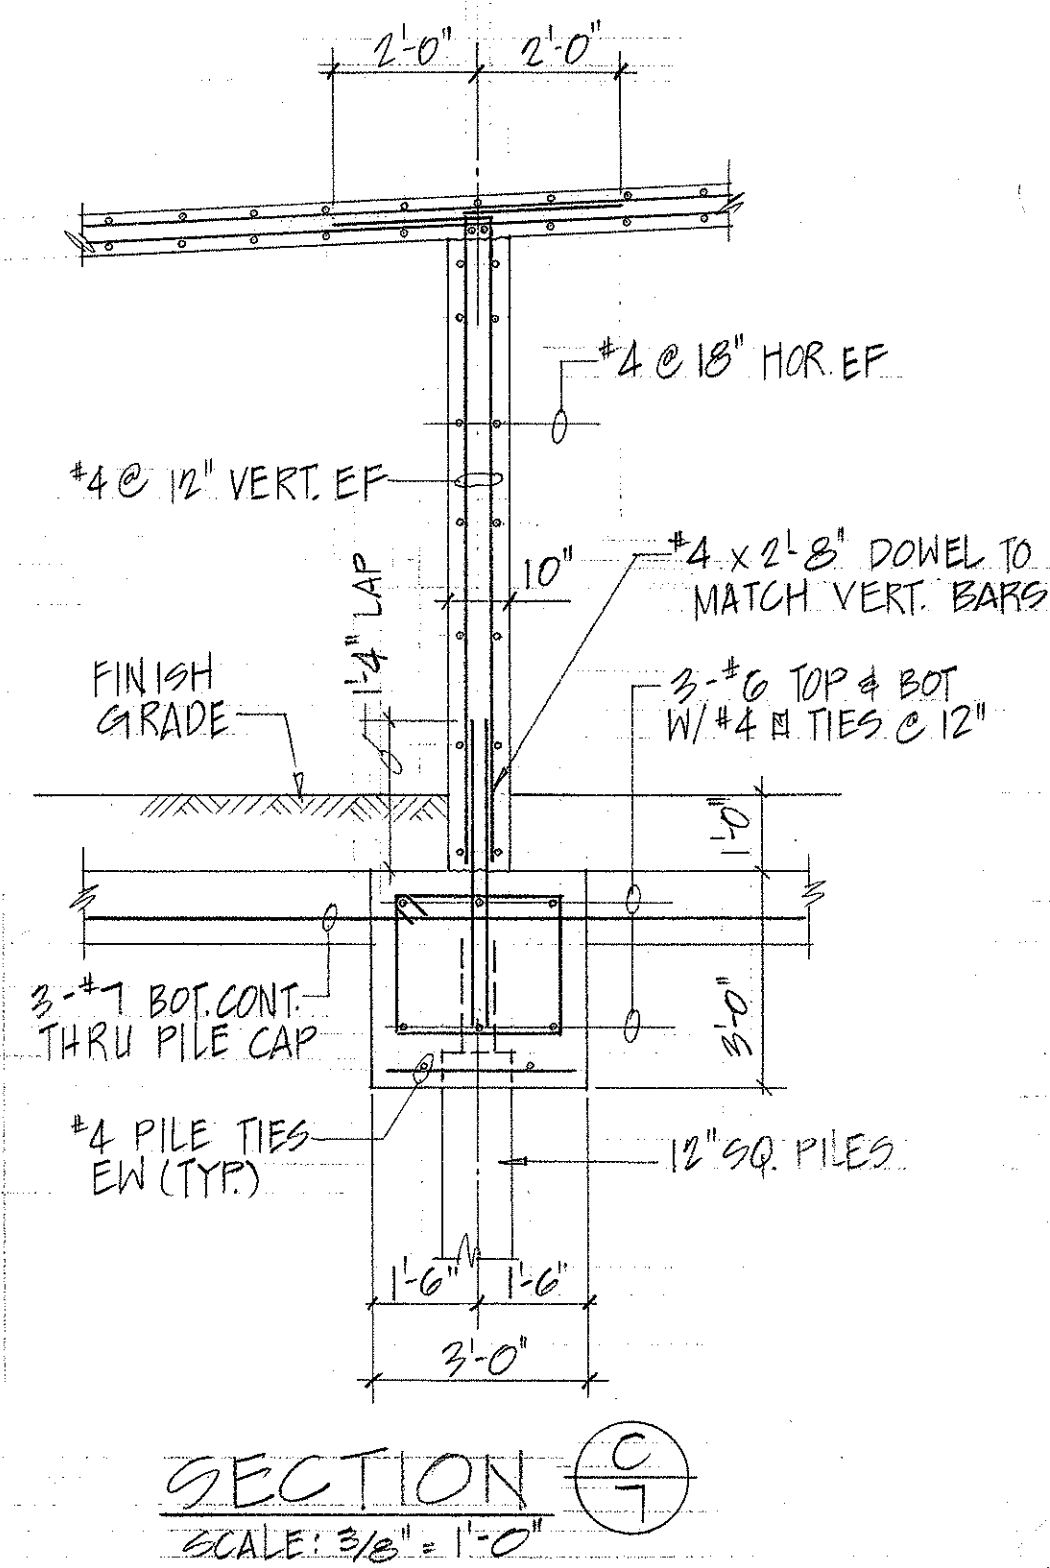
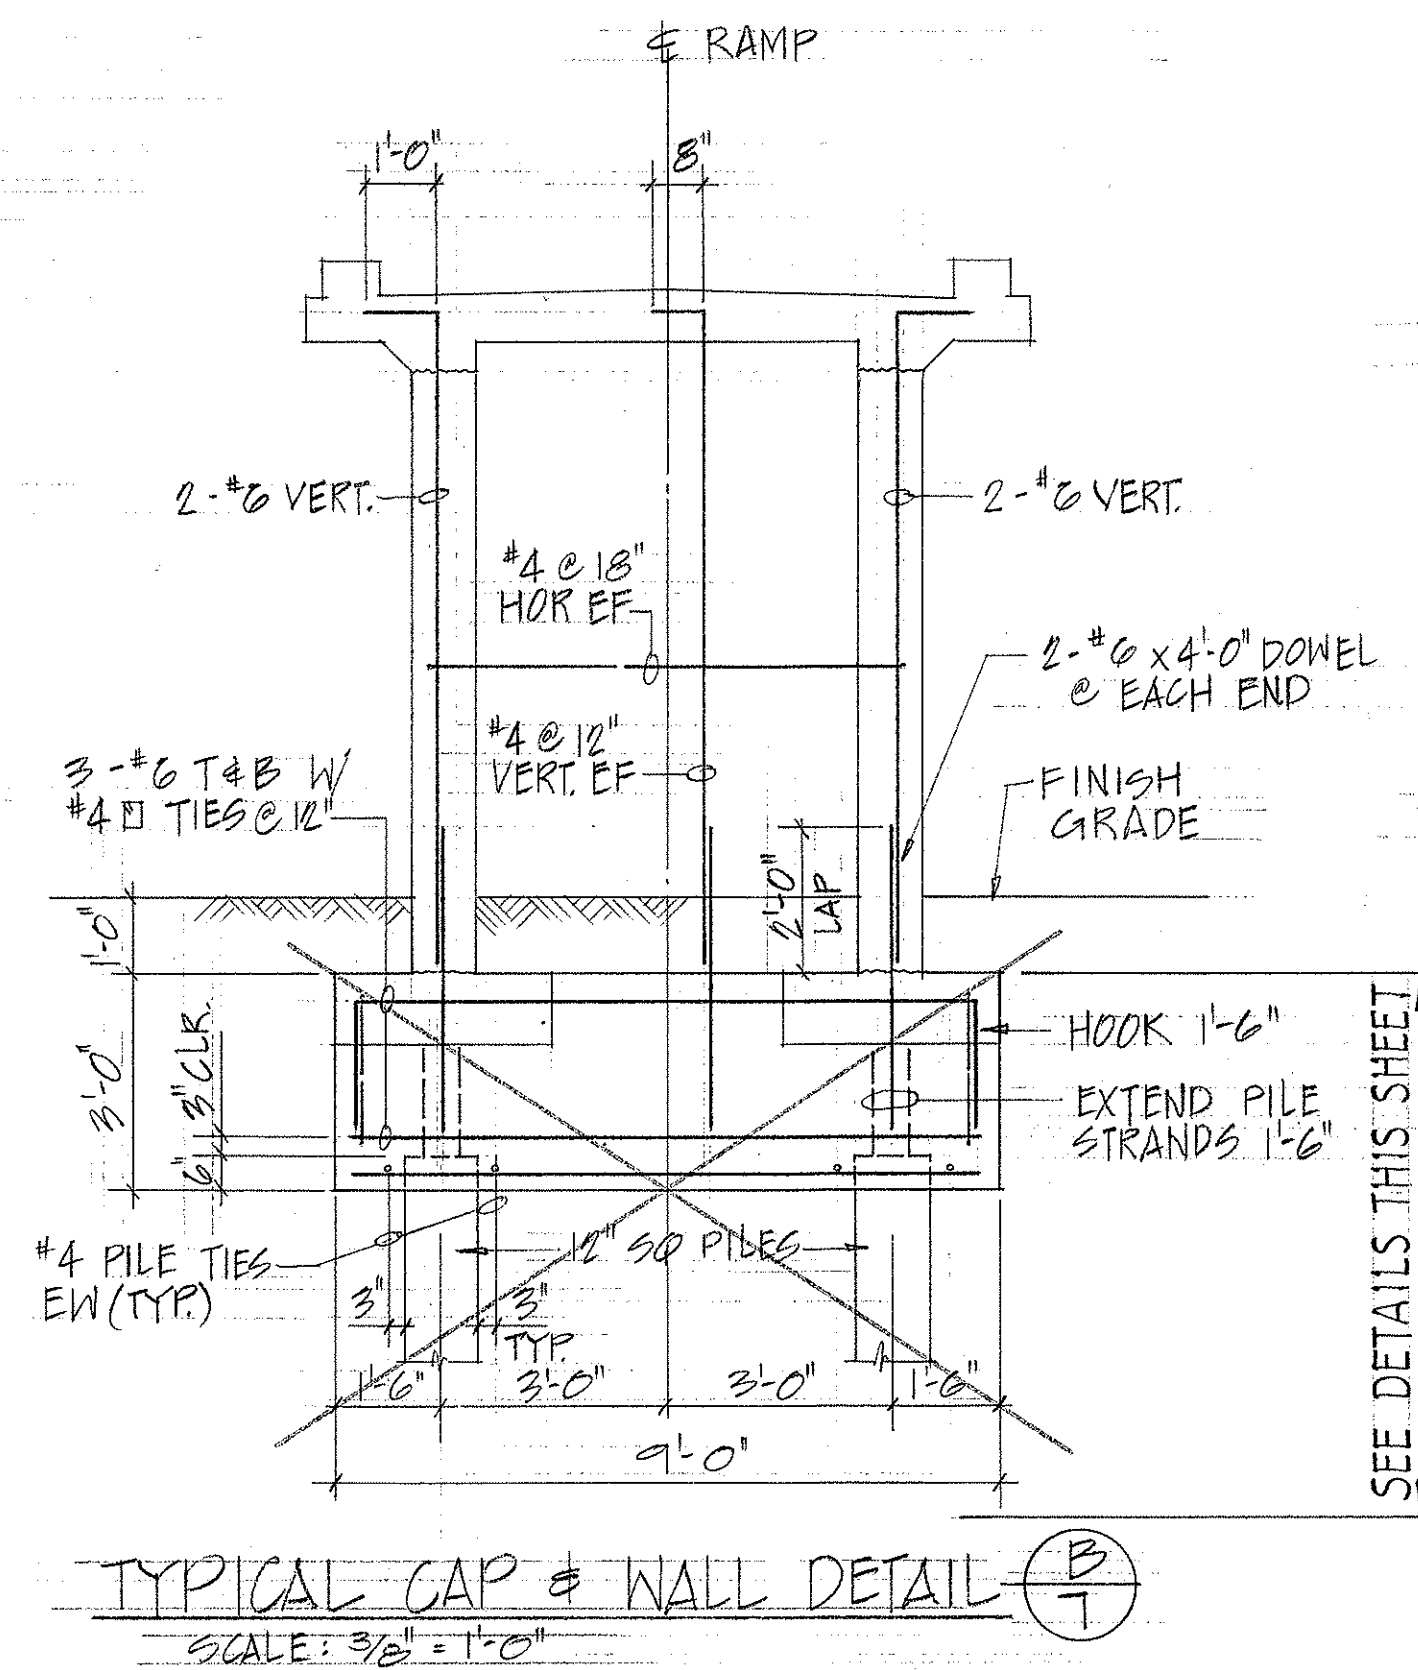
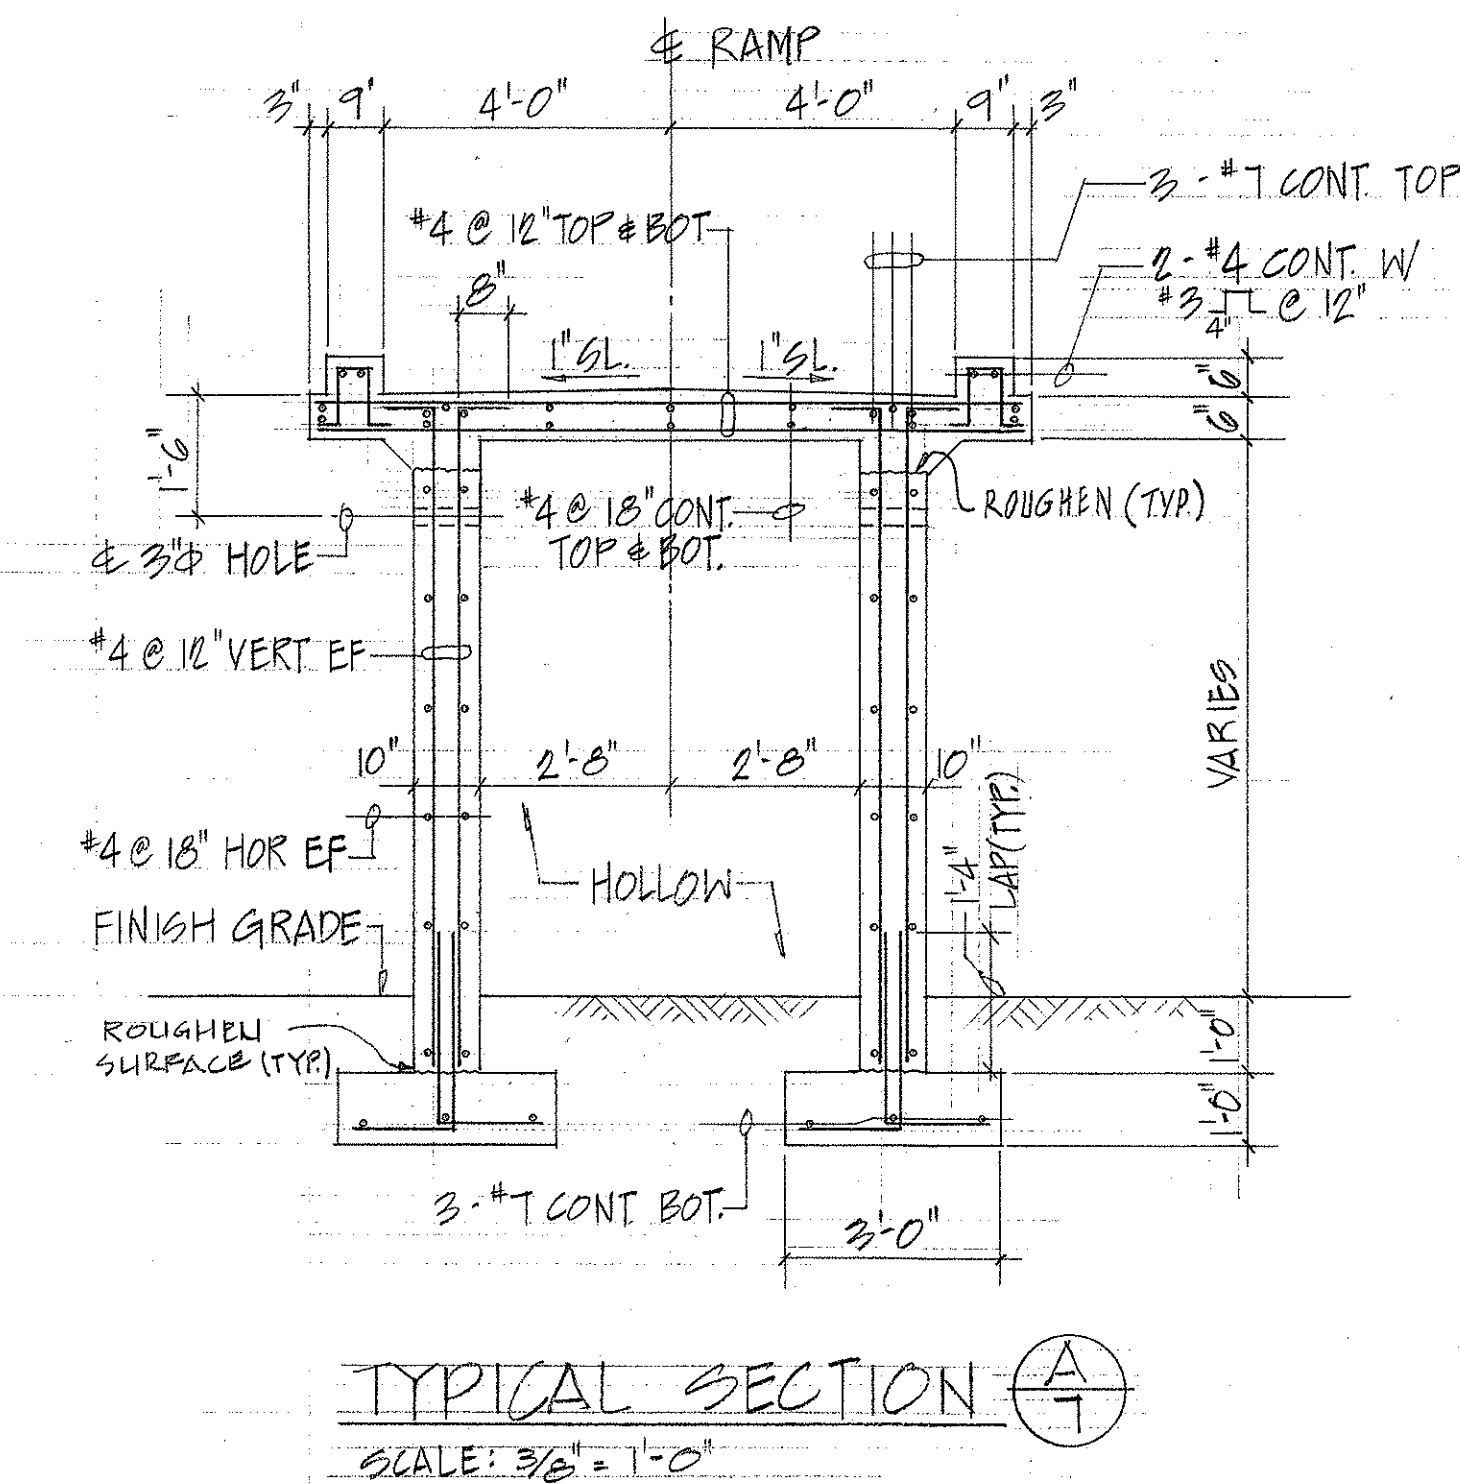
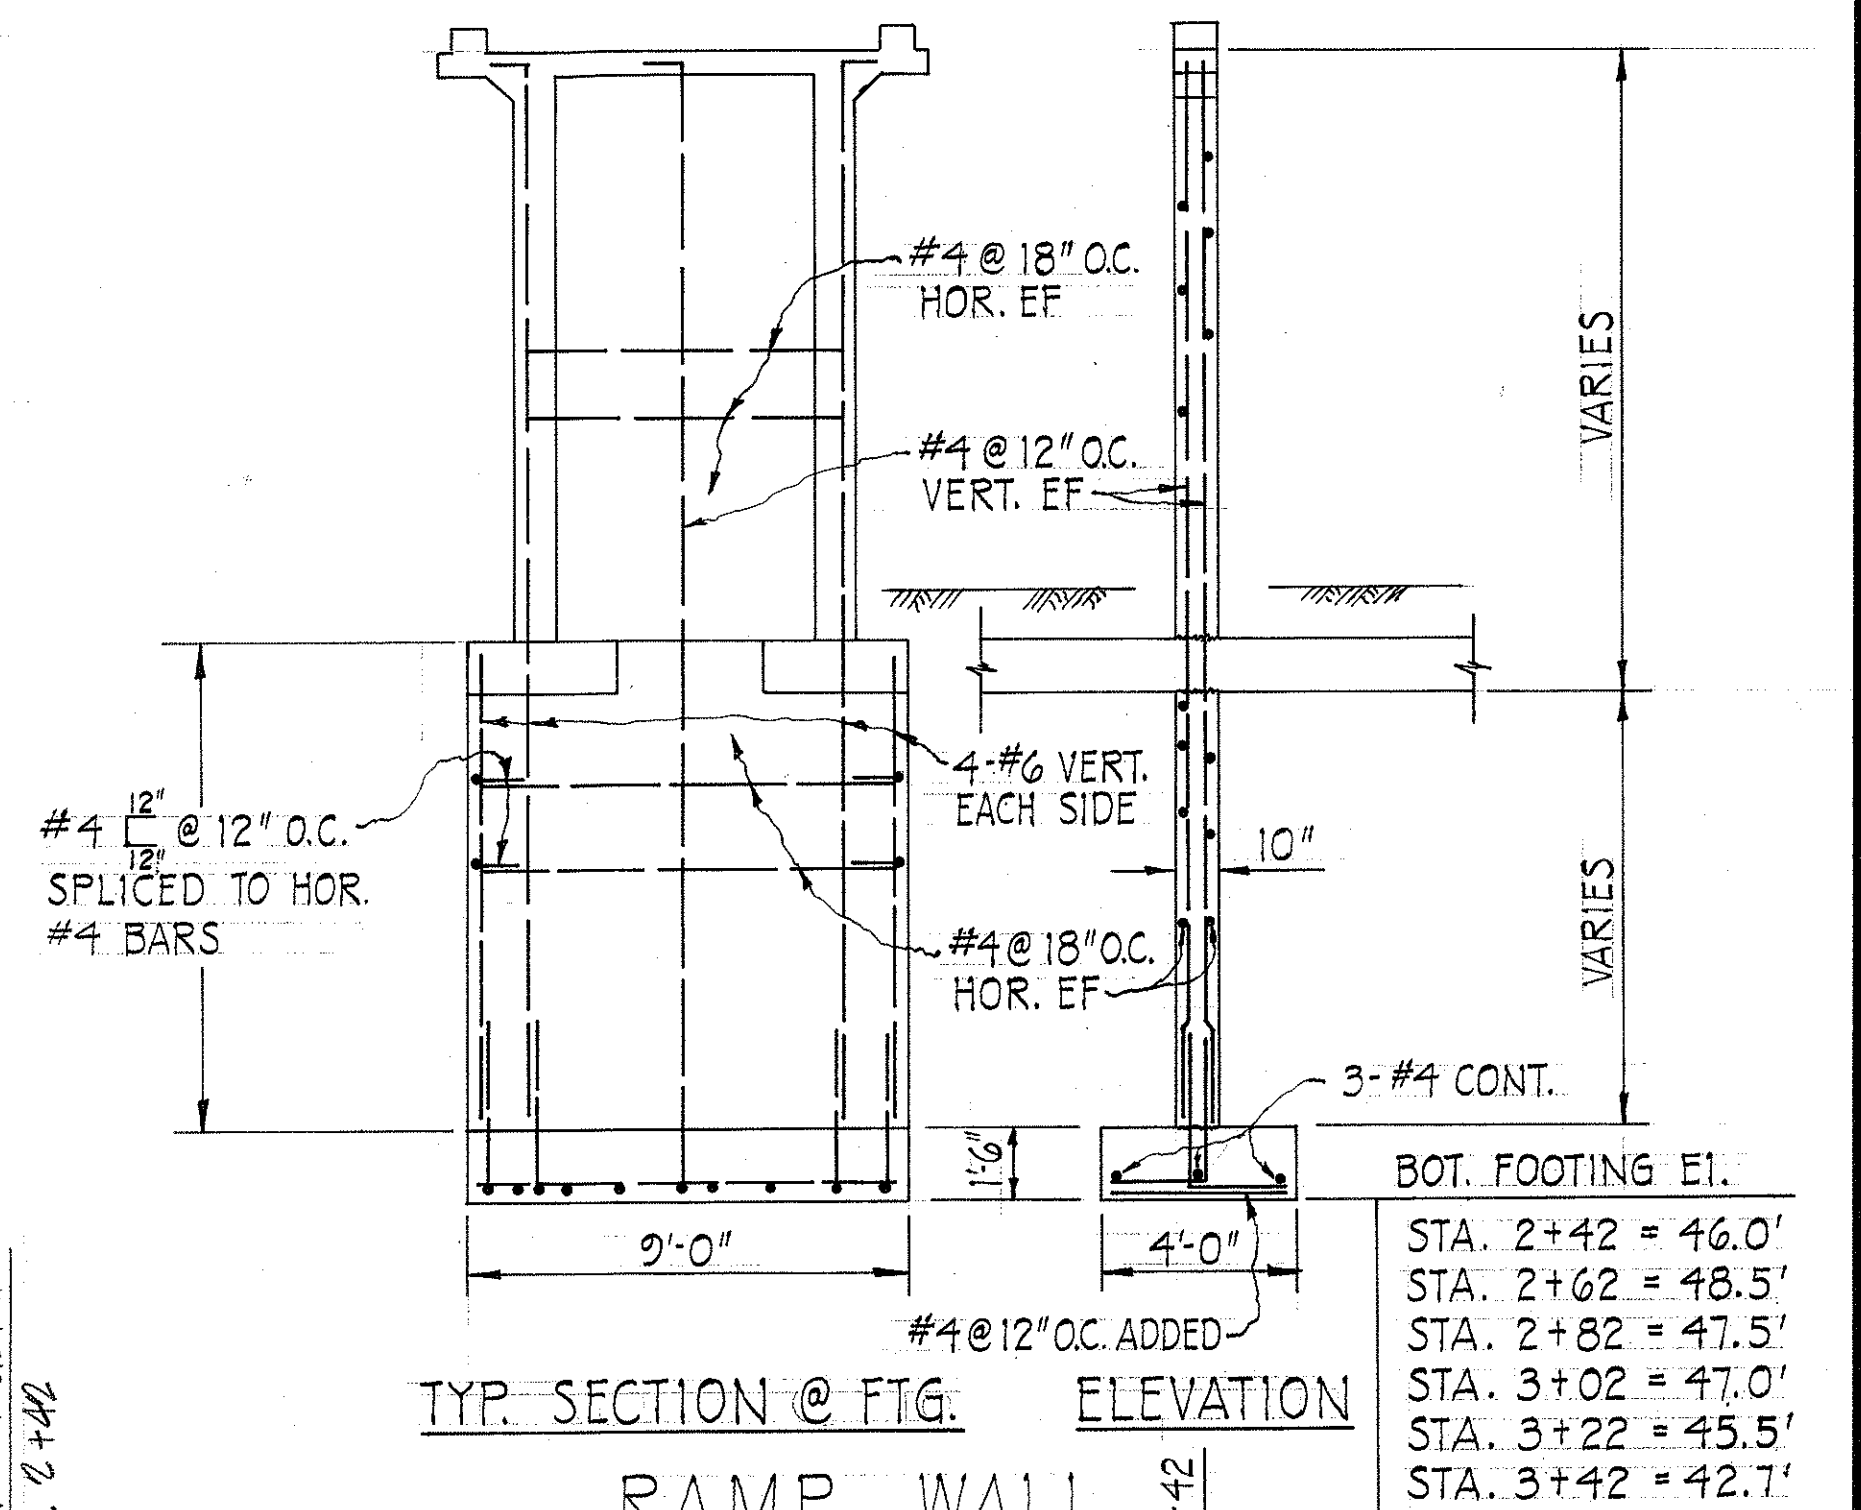


FED. ROAD DIST. NO.	STATE	FED. AID PROJ. NO.	FISCAL YEAR	SHEET NO.	TOTAL SHEETS
HAWAII	HAW.	141-1(105)14	1973	8	16

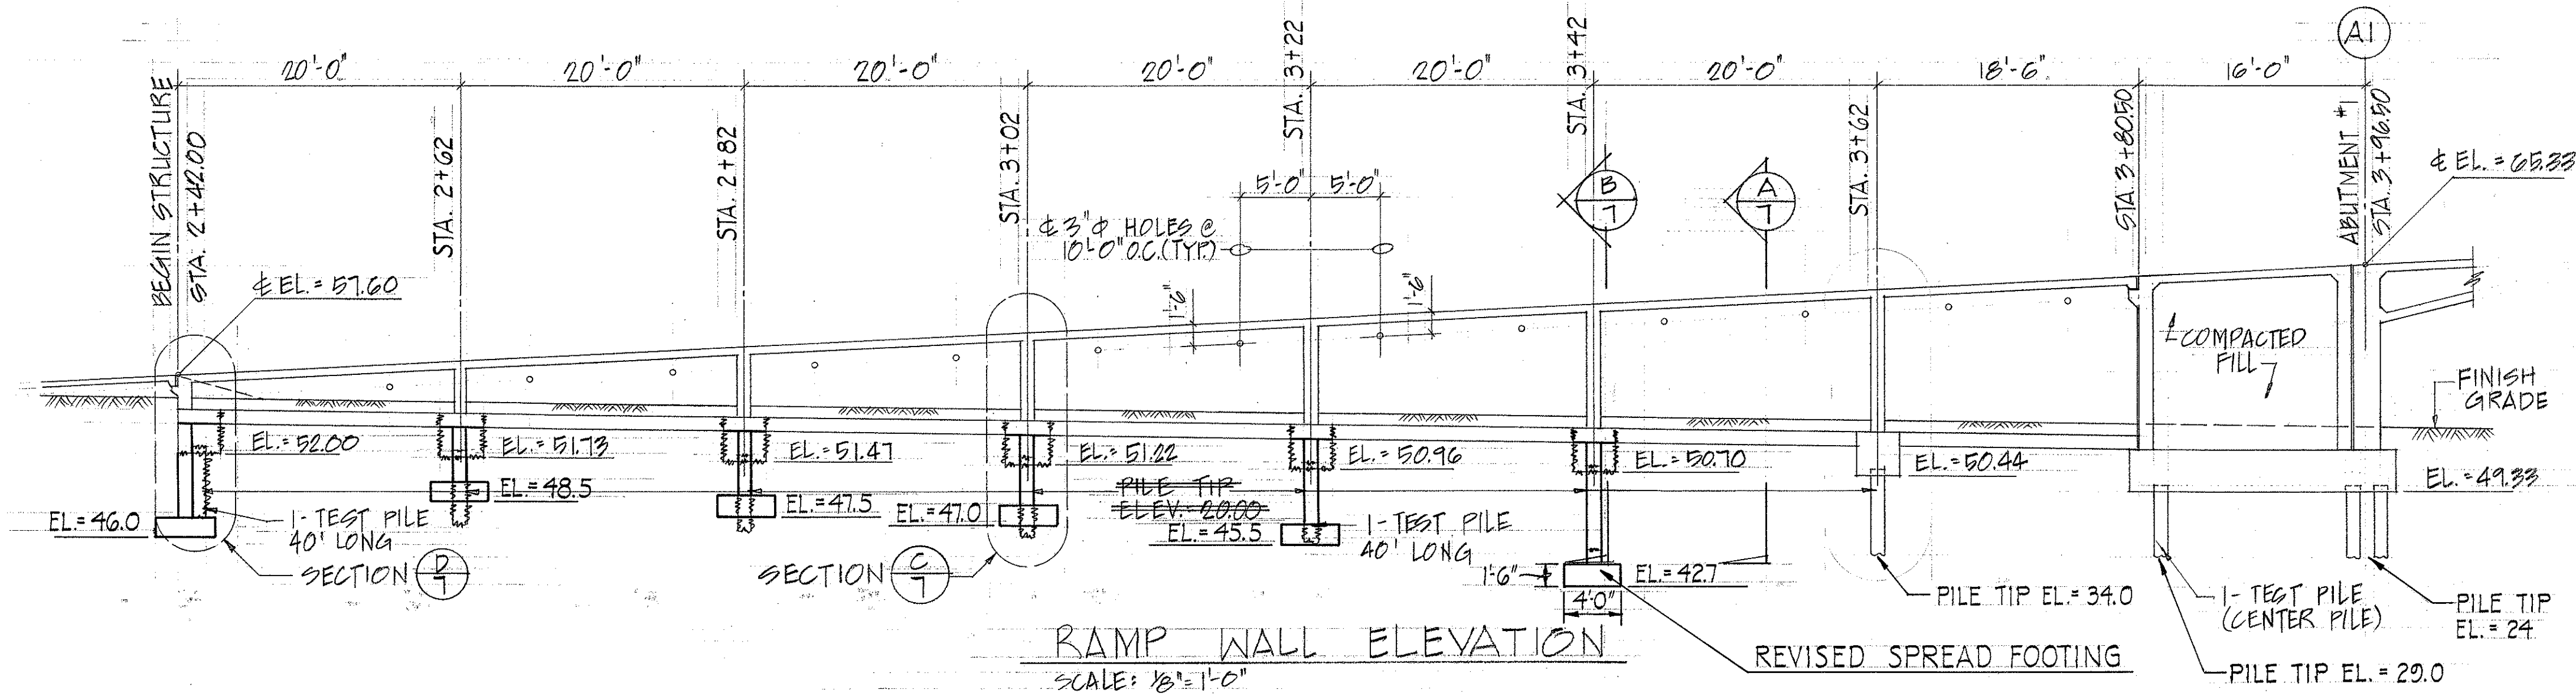

DATE	DESIGNED BY	CHECKED BY
PLAN	NOTED BY	QUANTITIES BY
NOTE BOOK		
No.		

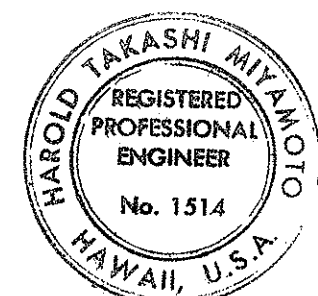

THIS WORK WAS PREPARED BY ME
OR UNDER MY SUPERVISION
Harold Takashi Miyamoto

STATE OF HAWAII
DEPARTMENT OF TRANSPORTATION
HIGHWAYS DIVISION
**RAMP WALL
ELEVATION & DETAILS**
INTERSTATE ROUTE H-1
PEDESTRIAN OVERPASS AT MAKALAPA
F.A.I. PROJ. NO. I-HI-105)14
SCALE: AS SHOWN DATE: 1/29/73
SHEET No. 7 OF 10 SHEETS