INDEX TO DDAMINOC	
INDEX TO DRAWINGS	
SHEET NO.	DESCRIPTION
	TITLE SHEET
2	GENERAL NOTES & QUANTITIES
3	LAYOUT PLAN & PROFILE
4	OVERPASS PLAN & SECTION
5	ABUTMENT NO. 1 & DETAILS
6	ABUTMENT NO. 2 & DETAILS
7	PIER PLAN & DETAILS
8	RAMP WALL ELEV. & DETAILS
9	OVERPASS SLAB REINFORCING
IO <sub>;</sub>	GIRDER STIRRUP DETAILS
11	RAILING LAYOUT & DETAILS
12-16	STANDARD DETAILS
The conditions	
/	
Mary	
	·



STATE OF HAWAII


DEPARTMENT TRANSPORTATION OF HIGHWAYS DIVISION


> HONOLULU, HAWAII "AS-BUILT" PLAN FOR

## INTERSTATE ROUTE H-I PEDESTRIAN OVERPASS

F.A.I. PROJ. NO. I-HI-I(105):14

DISTRICT OF EWA ISLAND OF OAHU

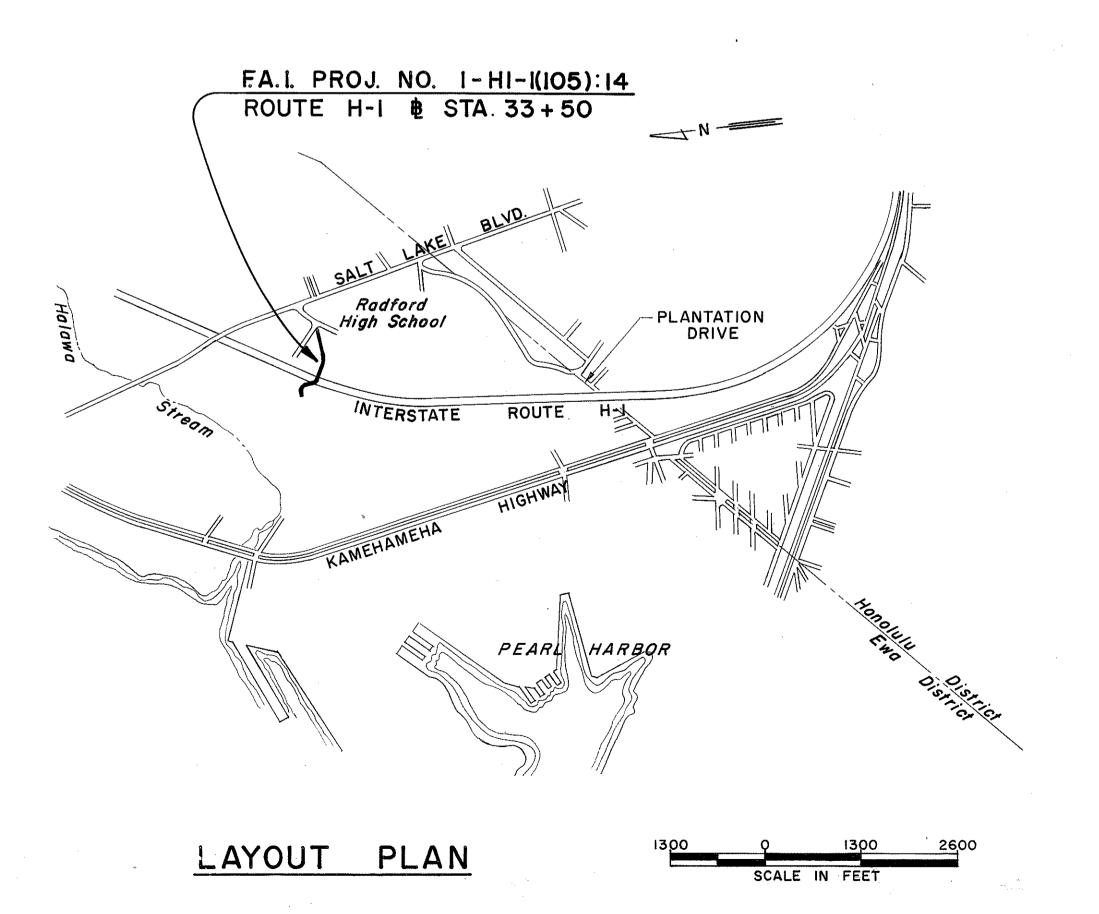

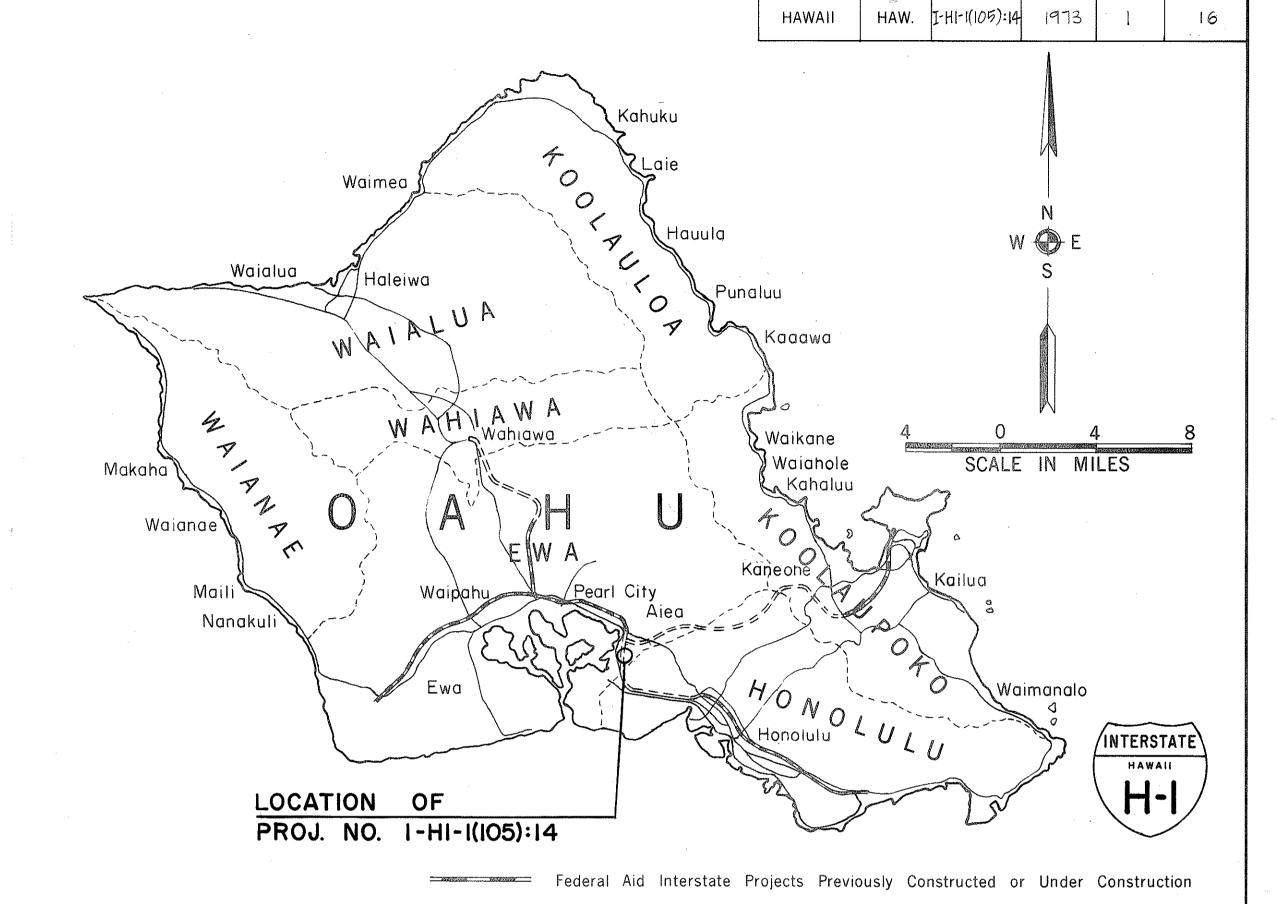

## NOTE:

ALL CHANGES MADE DURING CONSTRUCTION HAVE BEEN INCORPORATED ON THESE PLANS EXCEPT CHANGES IN THE ORIGINAL THEORETICAL QUANTITIES.

2/11/75 DATE RESIDENT ENGINEER

EMCHMEER

STATE FED. AID FISCAL SHEET TOTAL PROJ. NO. YEAR NO. SHEETS

THIS WORK WAS PREPARED BY ME OR UNDER MY SUPERVISION

Hauld 2 Myann

DEPARTMENT OF TRANSPORTATION FEDERAL HIGHWAY ADMINISTRATION APPROVED: 3·19·**15** DATE

&DIVISION ENGINEER

DEPARTMENT OF TRANSPORTATION STATE OF HAWAII APPROVED:

PORDIR. OF TRANSPORTATION