

ELECTRICAL SYMBOLS

EXST.	NEW.	DESCRIPTION
○	○	HWY. LT. SHOWN IN NEW LOCATION UNLESS NOTED OTHERWISE. ALSO SEE NOTE 1, SH. 1.
○(○)		HWY. LT. NO CHANGE. UNLESS NOTED OTHERWISE
○(○)		HWY. LT., ASSY & FOUNDATION TO BE REMOVED.
□(○)	□○	HWY. LT., MT. ON CONC. RETAINING WALL.
—○		HWY. LT., NEW POLE & BRACKET, NEW LUMINAIRE AS NOTED
□—X		REPLACE ST. LT. — HANHOLE INDICATED
—		HANHOLE, STATE HWY. DIV. TYP. TYPE "C", NOTE #8
—		HWY. SIGN W/ SHD FLUOR., STATE HWY. DIV. STD. SH. 105 TO 109
—○		400W Hg. VAPOR
—●		700W. Hg. VAPOR
—◆		1000W Hg. VAPOR
—X—		DIRECT BURIED CABLES TO BE ABANDON.
—		DIRECT BURIED SERIES CKT. 1/2 CABLE
—2—		DIRECT BURIED SERIES CKT. 2 1/2 CABLE
—		DIRECT BURIED PVC SCH'D. 40 OR ABS CONDUIT, SH. 101 CONG. ENCASED 2" CONDUIT, SH. 101 OR W/ IN CONG. STRUC., SH. 101
1 2 3 4 5 6 7	INDICATOR	1. POLE NUMBER 2. CIRCUIT ASSIGNMENT NUMBER 3. LETTERS: SEE REFERENCE 4. LUMINAIRE MTG. HT. FOR NEW POLE ONLY 5,6,7 SEE REFERENCES
W		INDICATES - POLE TO BE MTD. ON CONC. WALL, DET. 8/1
BH		INDICATES - POLE TO BE MTD. ON GR. BACK OF CONC. WALL, DET. 8/1
T		INDICATES - NEW BREAK-AWAY TRANSFORMER BASE
R		INDICATES - REINSTALL HWY. LT. ASSY
M/R		INDICATES - PROVIDE POLE HANHOLE MODIFICATION, ADD S/B & REINSTALL HWY. LT. ASSY.
S/B		INDICATES - SLIP BASE, SH. 14
T/R		INDICATES - NEW TRANS. BASE & REINSTALL HWY. LT. ASSY.
B		INDICATES - HWY. LT. ASSY MTD. ON CONC. BARRIER, SH. 101
A		INDICATES - MODIFY POLE FOR NEW TRUSS ARM, BRACKET, SEE SH. 151
N/C		INDICATES - NO CHANGES FOR POLE. ASSY.
700W		INDICATES - NEW 700W. Hg. VAPOR LUMINAIRE
C		INDICATES - NEW TRUSS ARM BRACKET LENGTH AS NOTED
PL/A		INDICATES - HWY. LT. INSTALLATION, SEE PLAN A/SH. 81
—X—		HANHOLE, STATE HWY. DIV. TYP. TYPE "C", SH. 111
(K)		INDICATES - HWY RAMP IDENTIFICATION.
—		DIRECT BURIED MULTI. CKT. 1/2 CABLE
—2—		DIRECT BURIED MULTI. CKT. 2 1/2 CABLE
□		PULLBOX, STATE HWY DIV. TYP. "X", SH. 121
HO		PHOTO ELEC. SW. W/ ROPT., STATE HWY DIV. STR. SH.
HO		FLUOR. BALLAST IN NEHA-3R ENCL.
—		CONDUIT CONN. BETWEEN NEW & EXST. SH. 101
N.I.C.		NOT IN CONTRACT.
—○		RE-USE LUMINAIRE
HT:		INDICATES-NEW POLE HEIGHT
S/R		INDICATES-PROVIDE S/B & REINSTALL POLE ASSY.
WR		INDICATES-REINSTALL POLE ASSY IN WALL.
E/R		INDICATES-REINSTALL POLE ASSY IN CONC. BARRIER.
(.176)		INDICATES-ITEM NUMBERS IN THE 622 SERIES OF PROPOSAL ITEMS

FED. ROAD DIST. NO.	STATE	FED. AID PROJ. NO.	FISCAL YEAR	HEET NO.	TOTAL SHEETS
HAWAII	HAW.	I-HI-10219	1973	111	175

GENERAL NOTES

1. SYMBOLS (—○—) DENOTE RELocation OF LIGHT ASSEMBLY DIRECTLY OUTBOARD OF EXST LIGHT POLE, UNLESS OTHERWISE NOTED.
2. FOR LIGHT POLE SET BACK DISTANCE SEE SITE 7LG8L. ALL OTHER SET BACK TO 11'-0" FROM EDGE OF PAVEMENT UNLESS OTHERWISE NOTED.
3. HWY LTS. 159, 161 (SH. 1.) TO BE LOCATED BETWEEN EXST. GUARD RAIL & CONC. RETAINING WALL.
4. FOR BARRIER TYPES SEE STRUCTURAL DWS. & PROVIDE 3-FOOT SECTION FOR MOUNTING OF POLES. ALSO PROVIDE #6 TIE BARS BETWEEN 3-FOOT SECTION & ADJACENT WALLS PER STRUCTURAL DWS.
5. FOR HWY. ILLUM. SIGN WIRING SEE STATE HWY. DIV. STD. SH. 101 THRUD.
6. FOR HWY. LTS. #63 & #25, MODIFY EXST. CHAIN LINK FENCE & RETAINING WALL TO ACCOMMODATE POLES. SEE STATE HWY. DIV. SH. 105 & SH. 91.
7. OF THESE PLANS FOR REFERENCES.
8. PROVIDE 10 EA/SERIES & 20 BY MULT. 40W BALLAST FOR REPLACEMENT DUE TO CORROSION AS DIRECTED BY ENGINEER IN THE FIELD & WILL BE CONSIDERED INCIDENTAL TO THE CONTRACT.
9. ALL PULLBOXES TO BE 11'-0" MIN. FROM EXST. EDGE OF PAVEMENT UNLESS OTHERWISE NOTED, SEE SH. 7.
10. ALL MERCURY-VAPOUR LAMPS AFFECTED BY POLE REINSTALLATION SHALL BE REPLACED WITH NEW FOR SERIES AND MULTIPLE CIRCUITS & WILL BE CONSIDERED INCIDENTAL TO THE CONTRACT.
11. HWY LIGHTING SYSTEMS PARTS, HARDWARE AND COMPONENTS DAMAGED SHALL BE REPLACED W/ NEW AND CONSIDERED INCIDENTAL TO THE CONTRACT.
12. STUB-OUT 2" PVC, 5 FEET LONG, TERMINATE W/ DUCT SEAL & BUSHING, FOR ALL STUB-OUTS.
13. PROVIDE 3 EA/TWIN 400W SERIES CKT. BALLAST FOR REPLACEMENT AT CONC. BARRIER POLE MTG. & WILL BE CONSIDERED INCIDENTAL TO THE CONTRACT.
14. ALL REMOTE BALLAST LOCATED IN PB. TO BE EPOXY ENCAPSULATED TYPE.

STATE OF HAWAII
DEPARTMENT OF TRANSPORTATION
HIGHWAYS DIVISION
HIGHWAY LIGHTING SYMBOLS


SAFETY IMPROVEMENT

KALIHI STREET TO PALI HIGHWAY

FAI PROJECT NO. I-HI-1(1E)-19

SCALE: NO SCALE DATE: APR 1973


SHEET NO. 11 OF 182 SHEETS

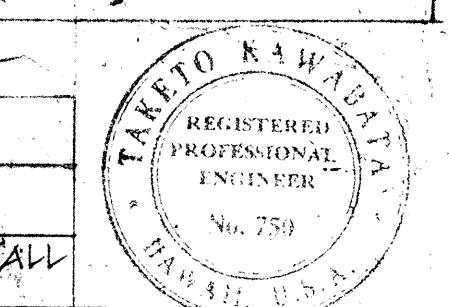


THIS WORK WAS PREPARED BY
ME OR UNDER MY SUPERVISION
Robert K. Kunkel

DATE: _____
SURVEY PLOTTED BY _____
DRAWN BY _____
TRACED BY _____
DESIGNED BY _____
QUANTITY DRAWN _____
CHECKED BY _____
No. _____
ORIGINAL PLAN
NOTE BOOK
PRINTED ON NO. 1000H CLEARPRINT


FED. ROAD DIST. NO.	STATE	FED. AID PROJ. NO.	FISCAL YEAR	SHEET NO.	TOTAL SHEETS
HAWAII	HAW.	I-HI-1(112)19	1973	112	176

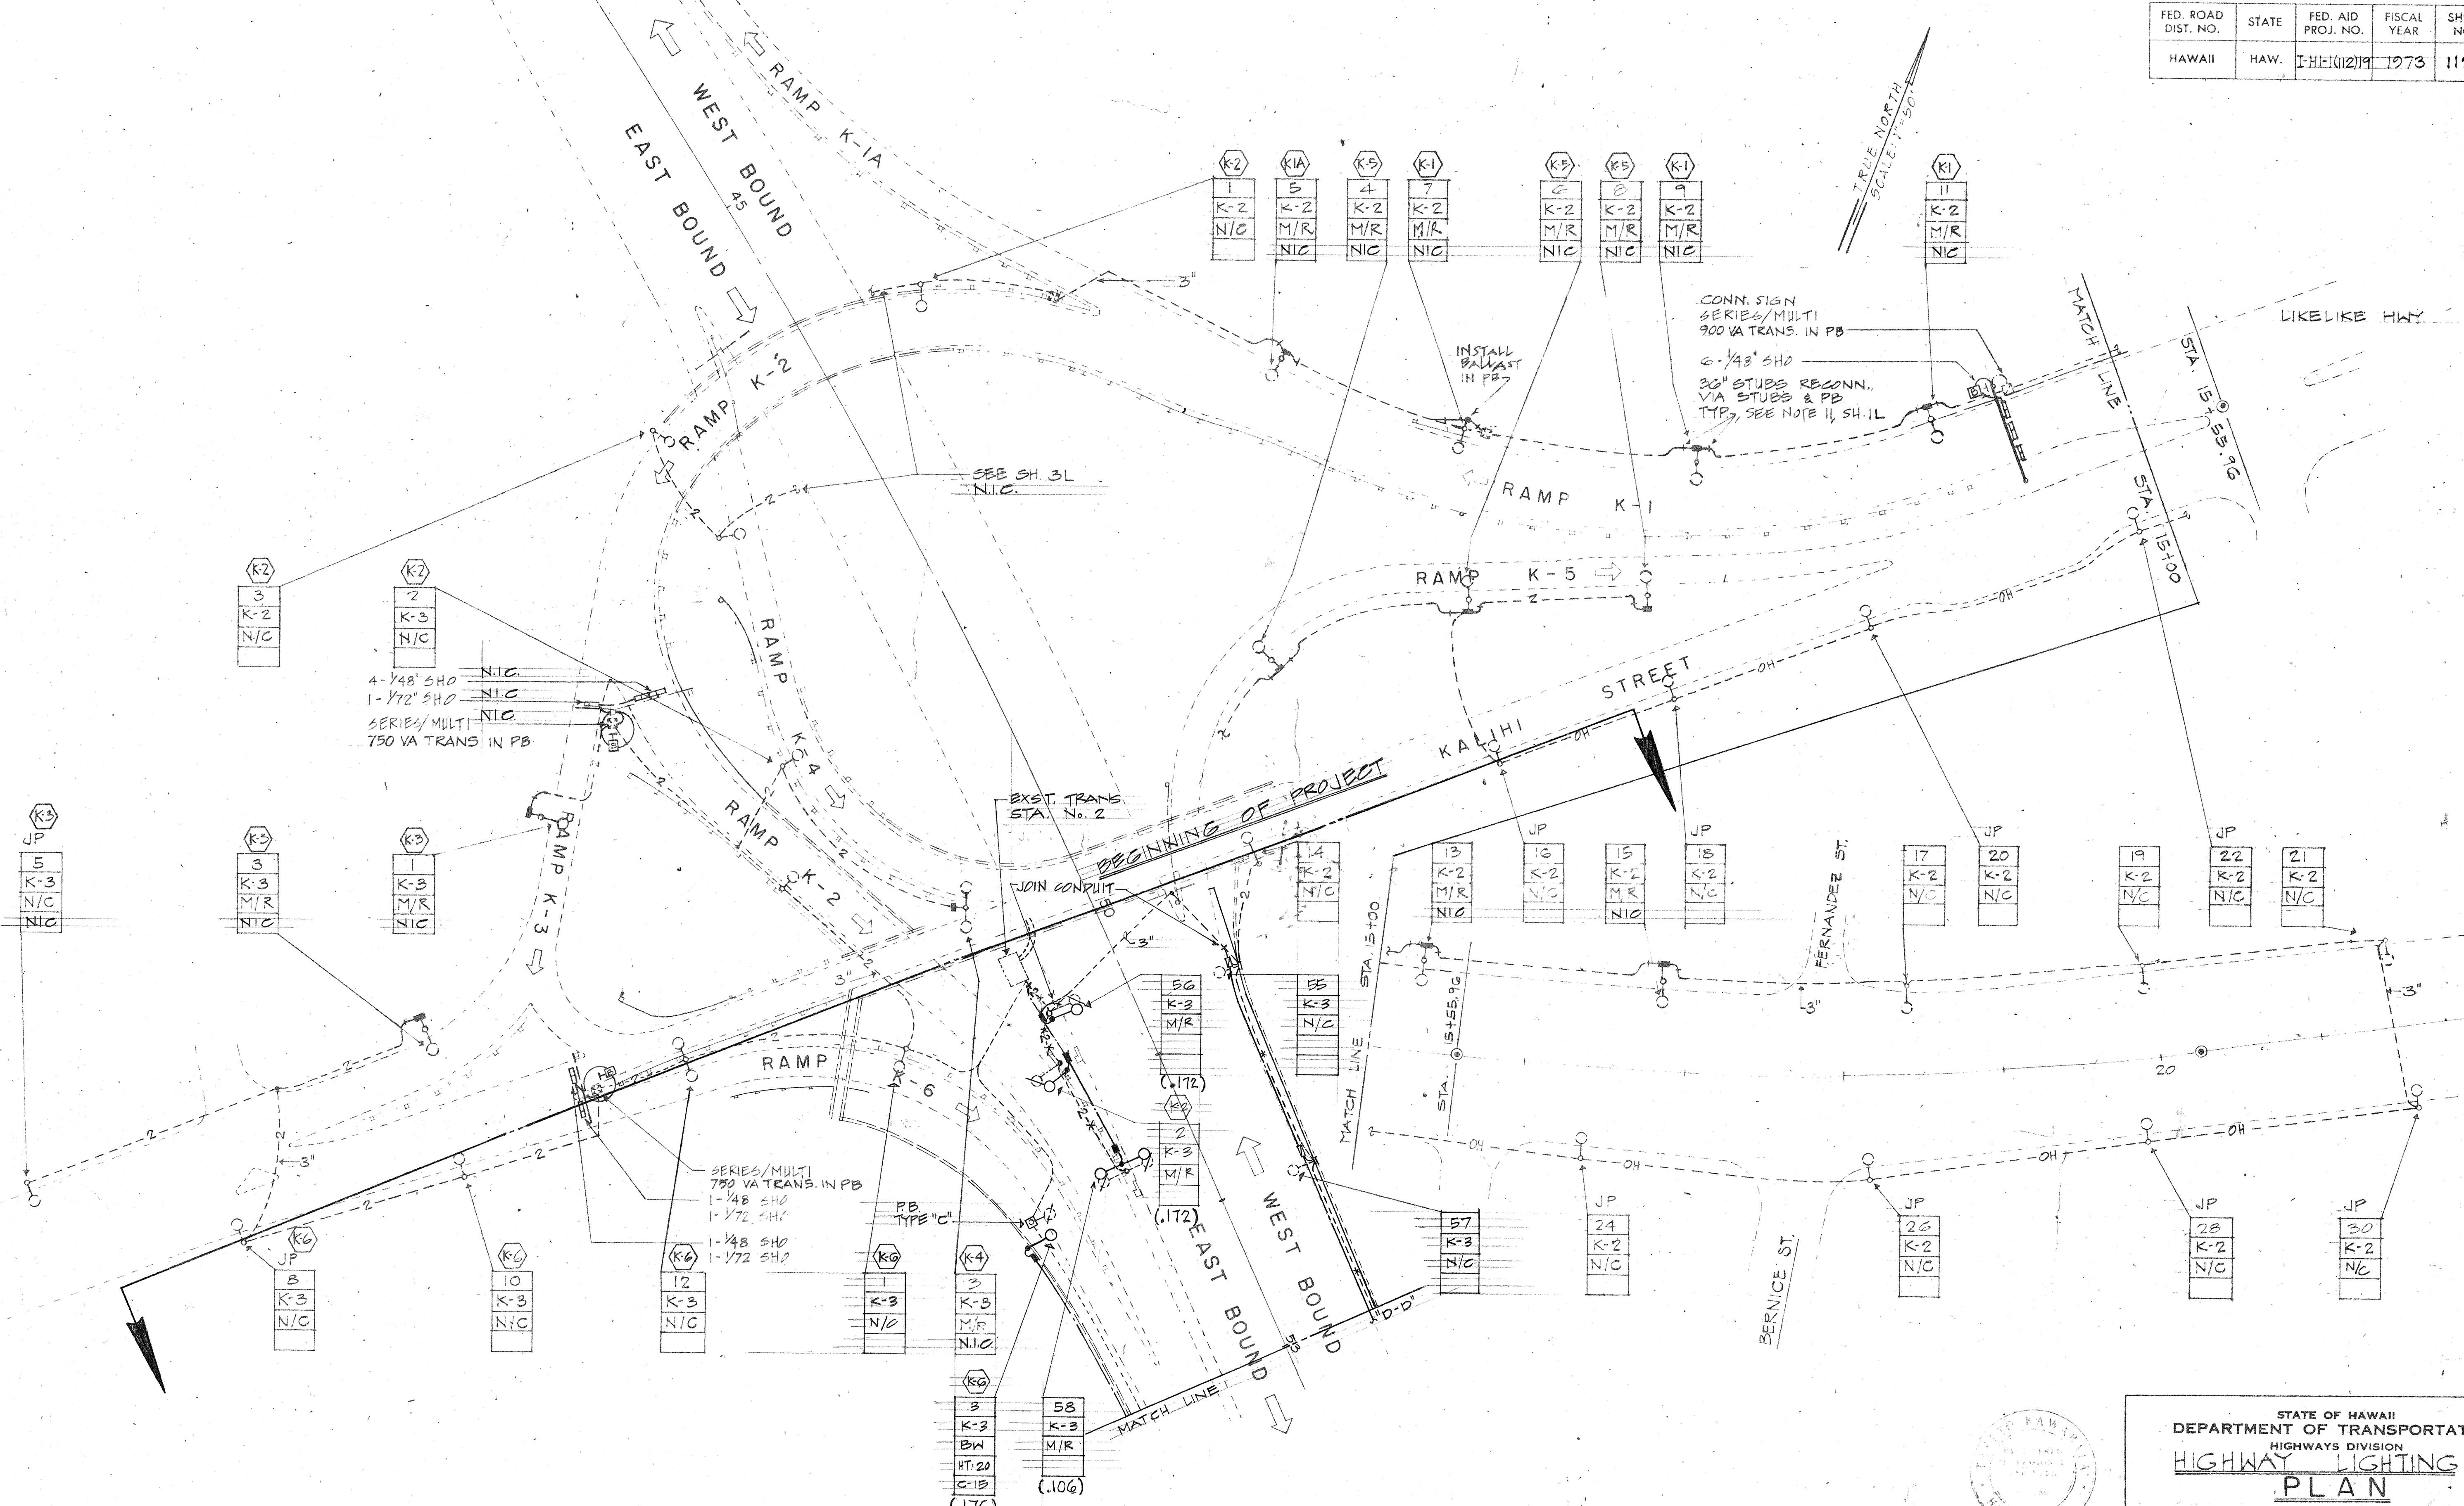

FED. ROAD DIST. NO.	STATE	FED. AID PROJ. NO.	FISCAL YEAR	SHEET NO.	TOTAL SHEETS
HAWAII	HAW.	I-HI(12)9	1973	113	176

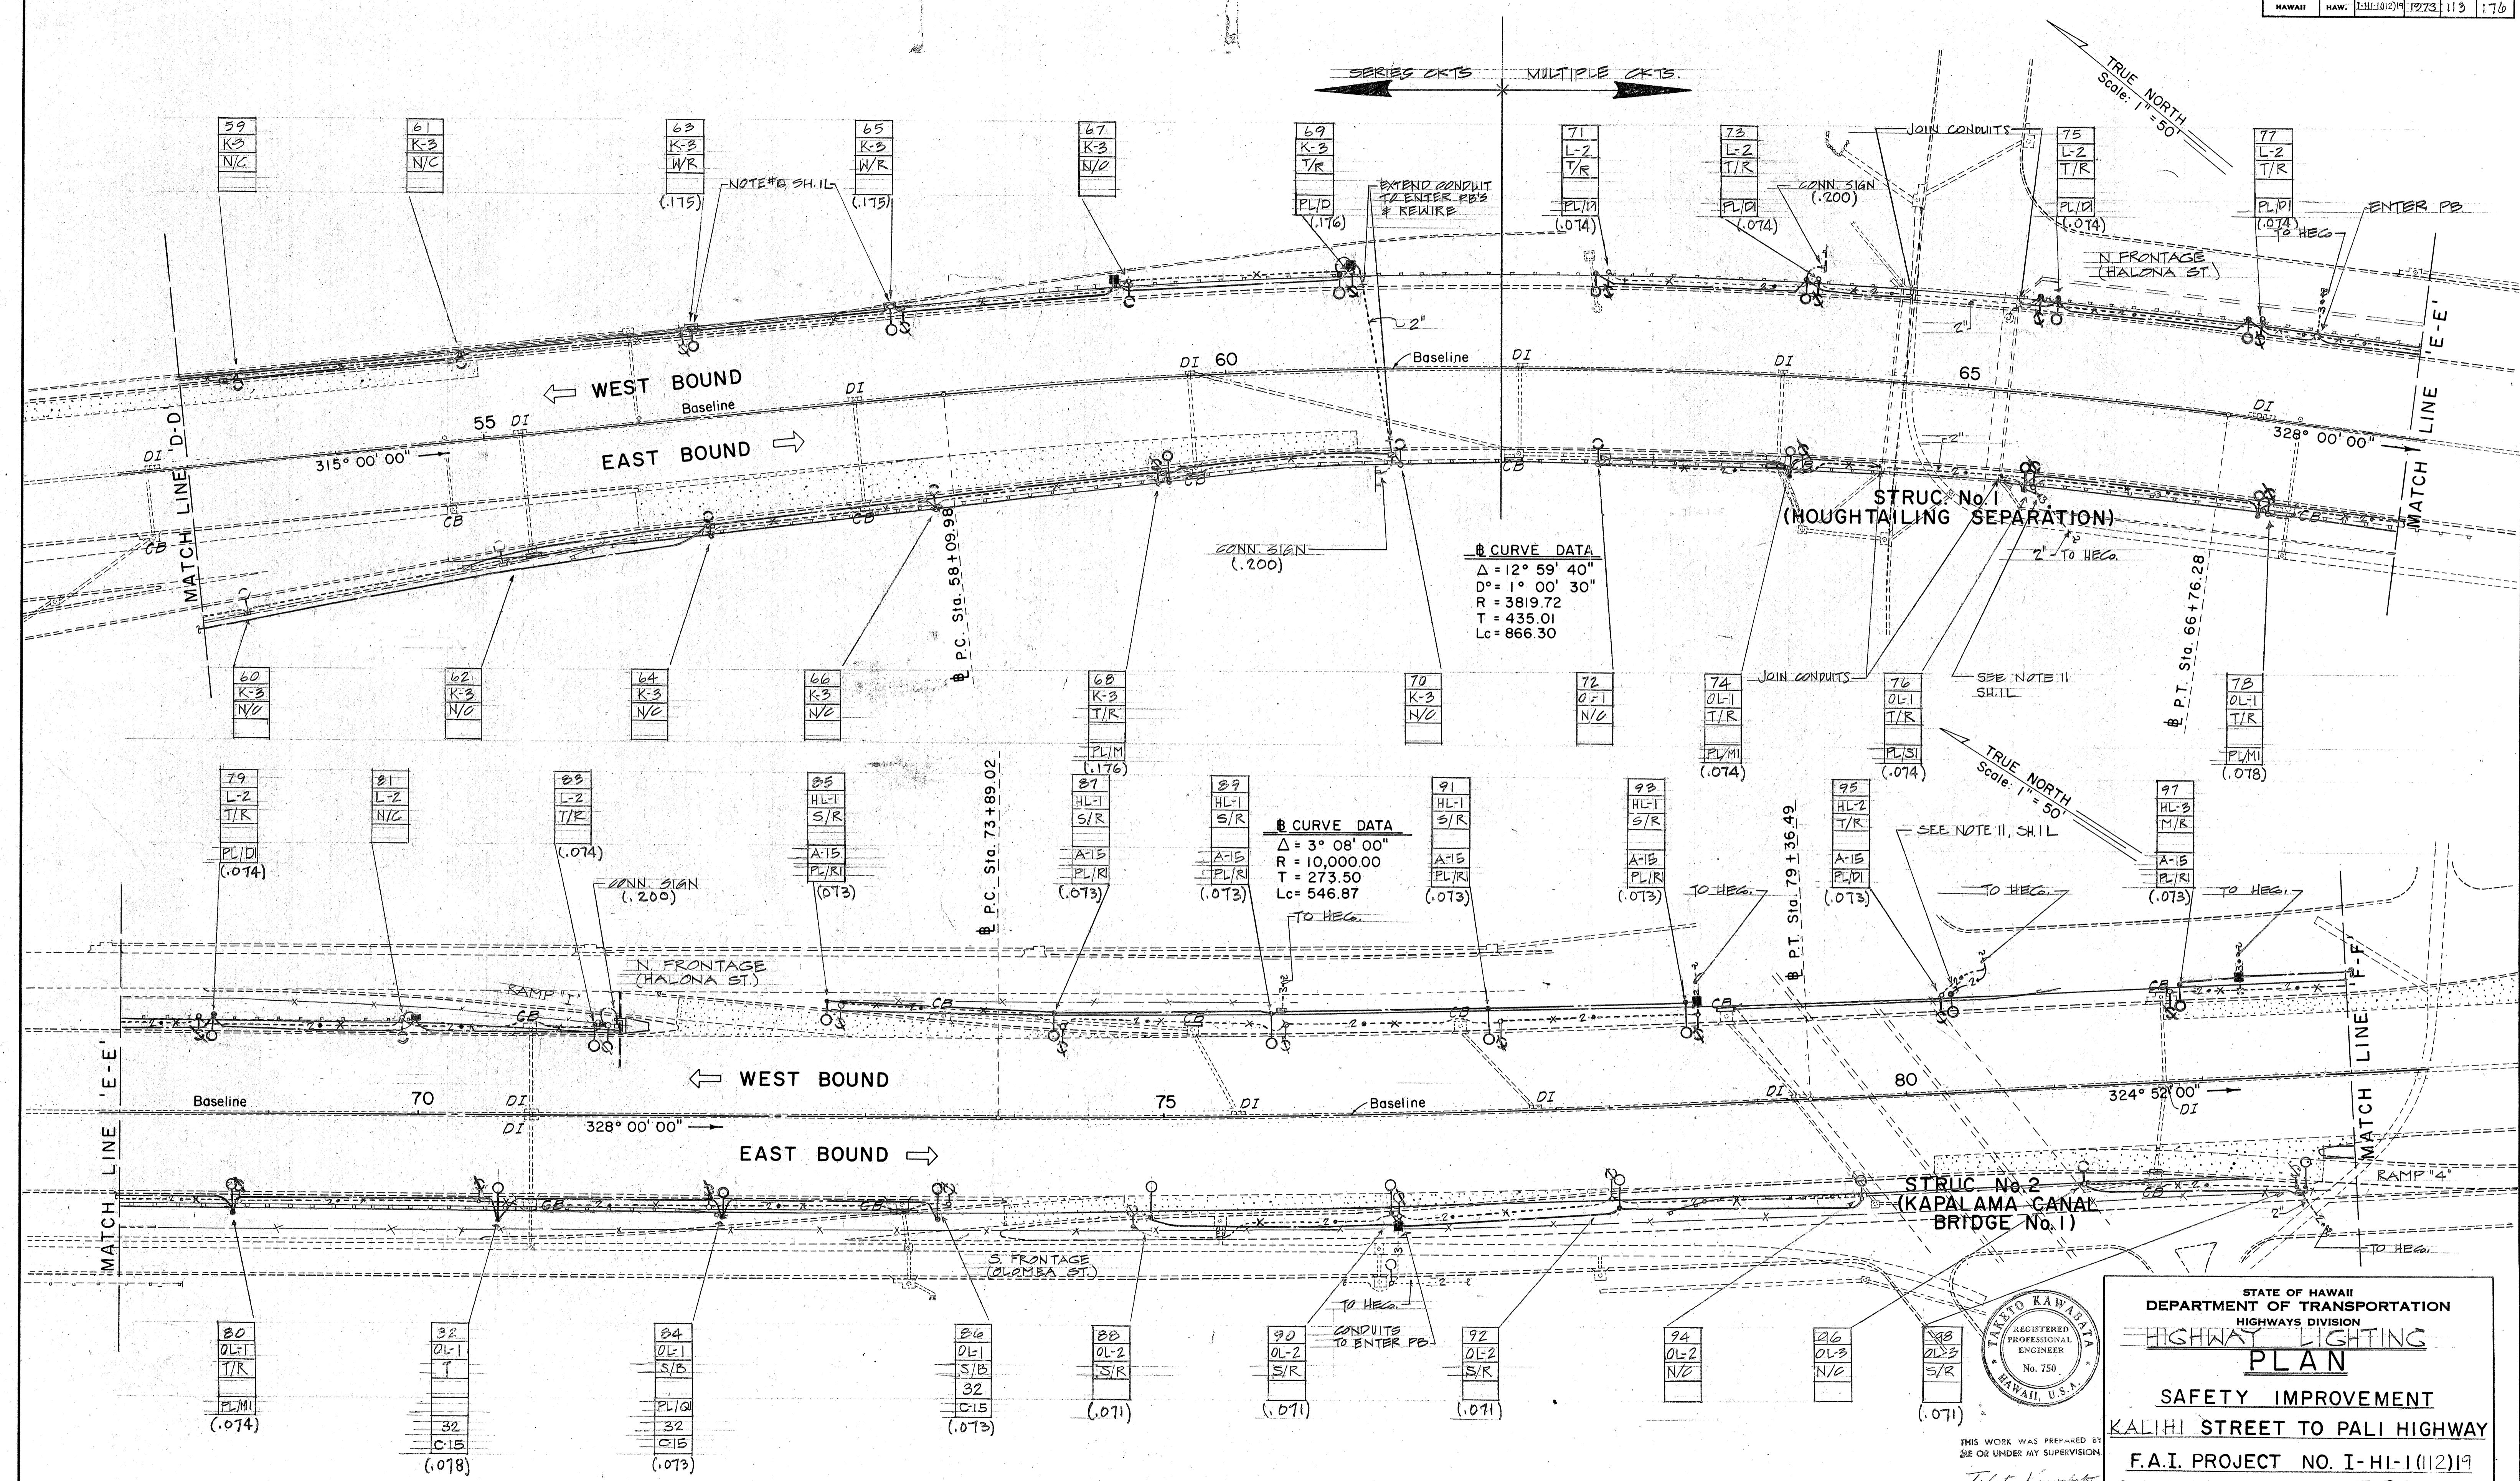

STATE OF HAWAII
DEPARTMENT OF TRANSPORTATION
HIGHWAYS DIVISION
HIGHWAY LIGHTING PLAN
SAFETY IMPROVEMENT
KALIHI STREET TO PALI HIGHWAY
F.A.I. PROJECT NO. I-HI-1(12)19

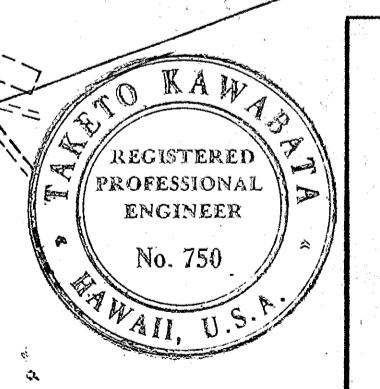



THIS WORK WAS PREPARED BY
ME OR UNDER MY SUPERVISION.
Tateki Kawabe
Scale as noted

DATE: APR. 1973

SHEET No. 3L OF 13L SHEETS

1163
Q3

	STATE	FED. AID PROJ. NO.	FISCAL YEAR	SHEET NO.	TOTAL SHEETS
	HAW.	EHH(12)19	1973	114	174

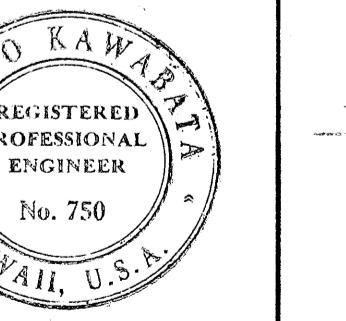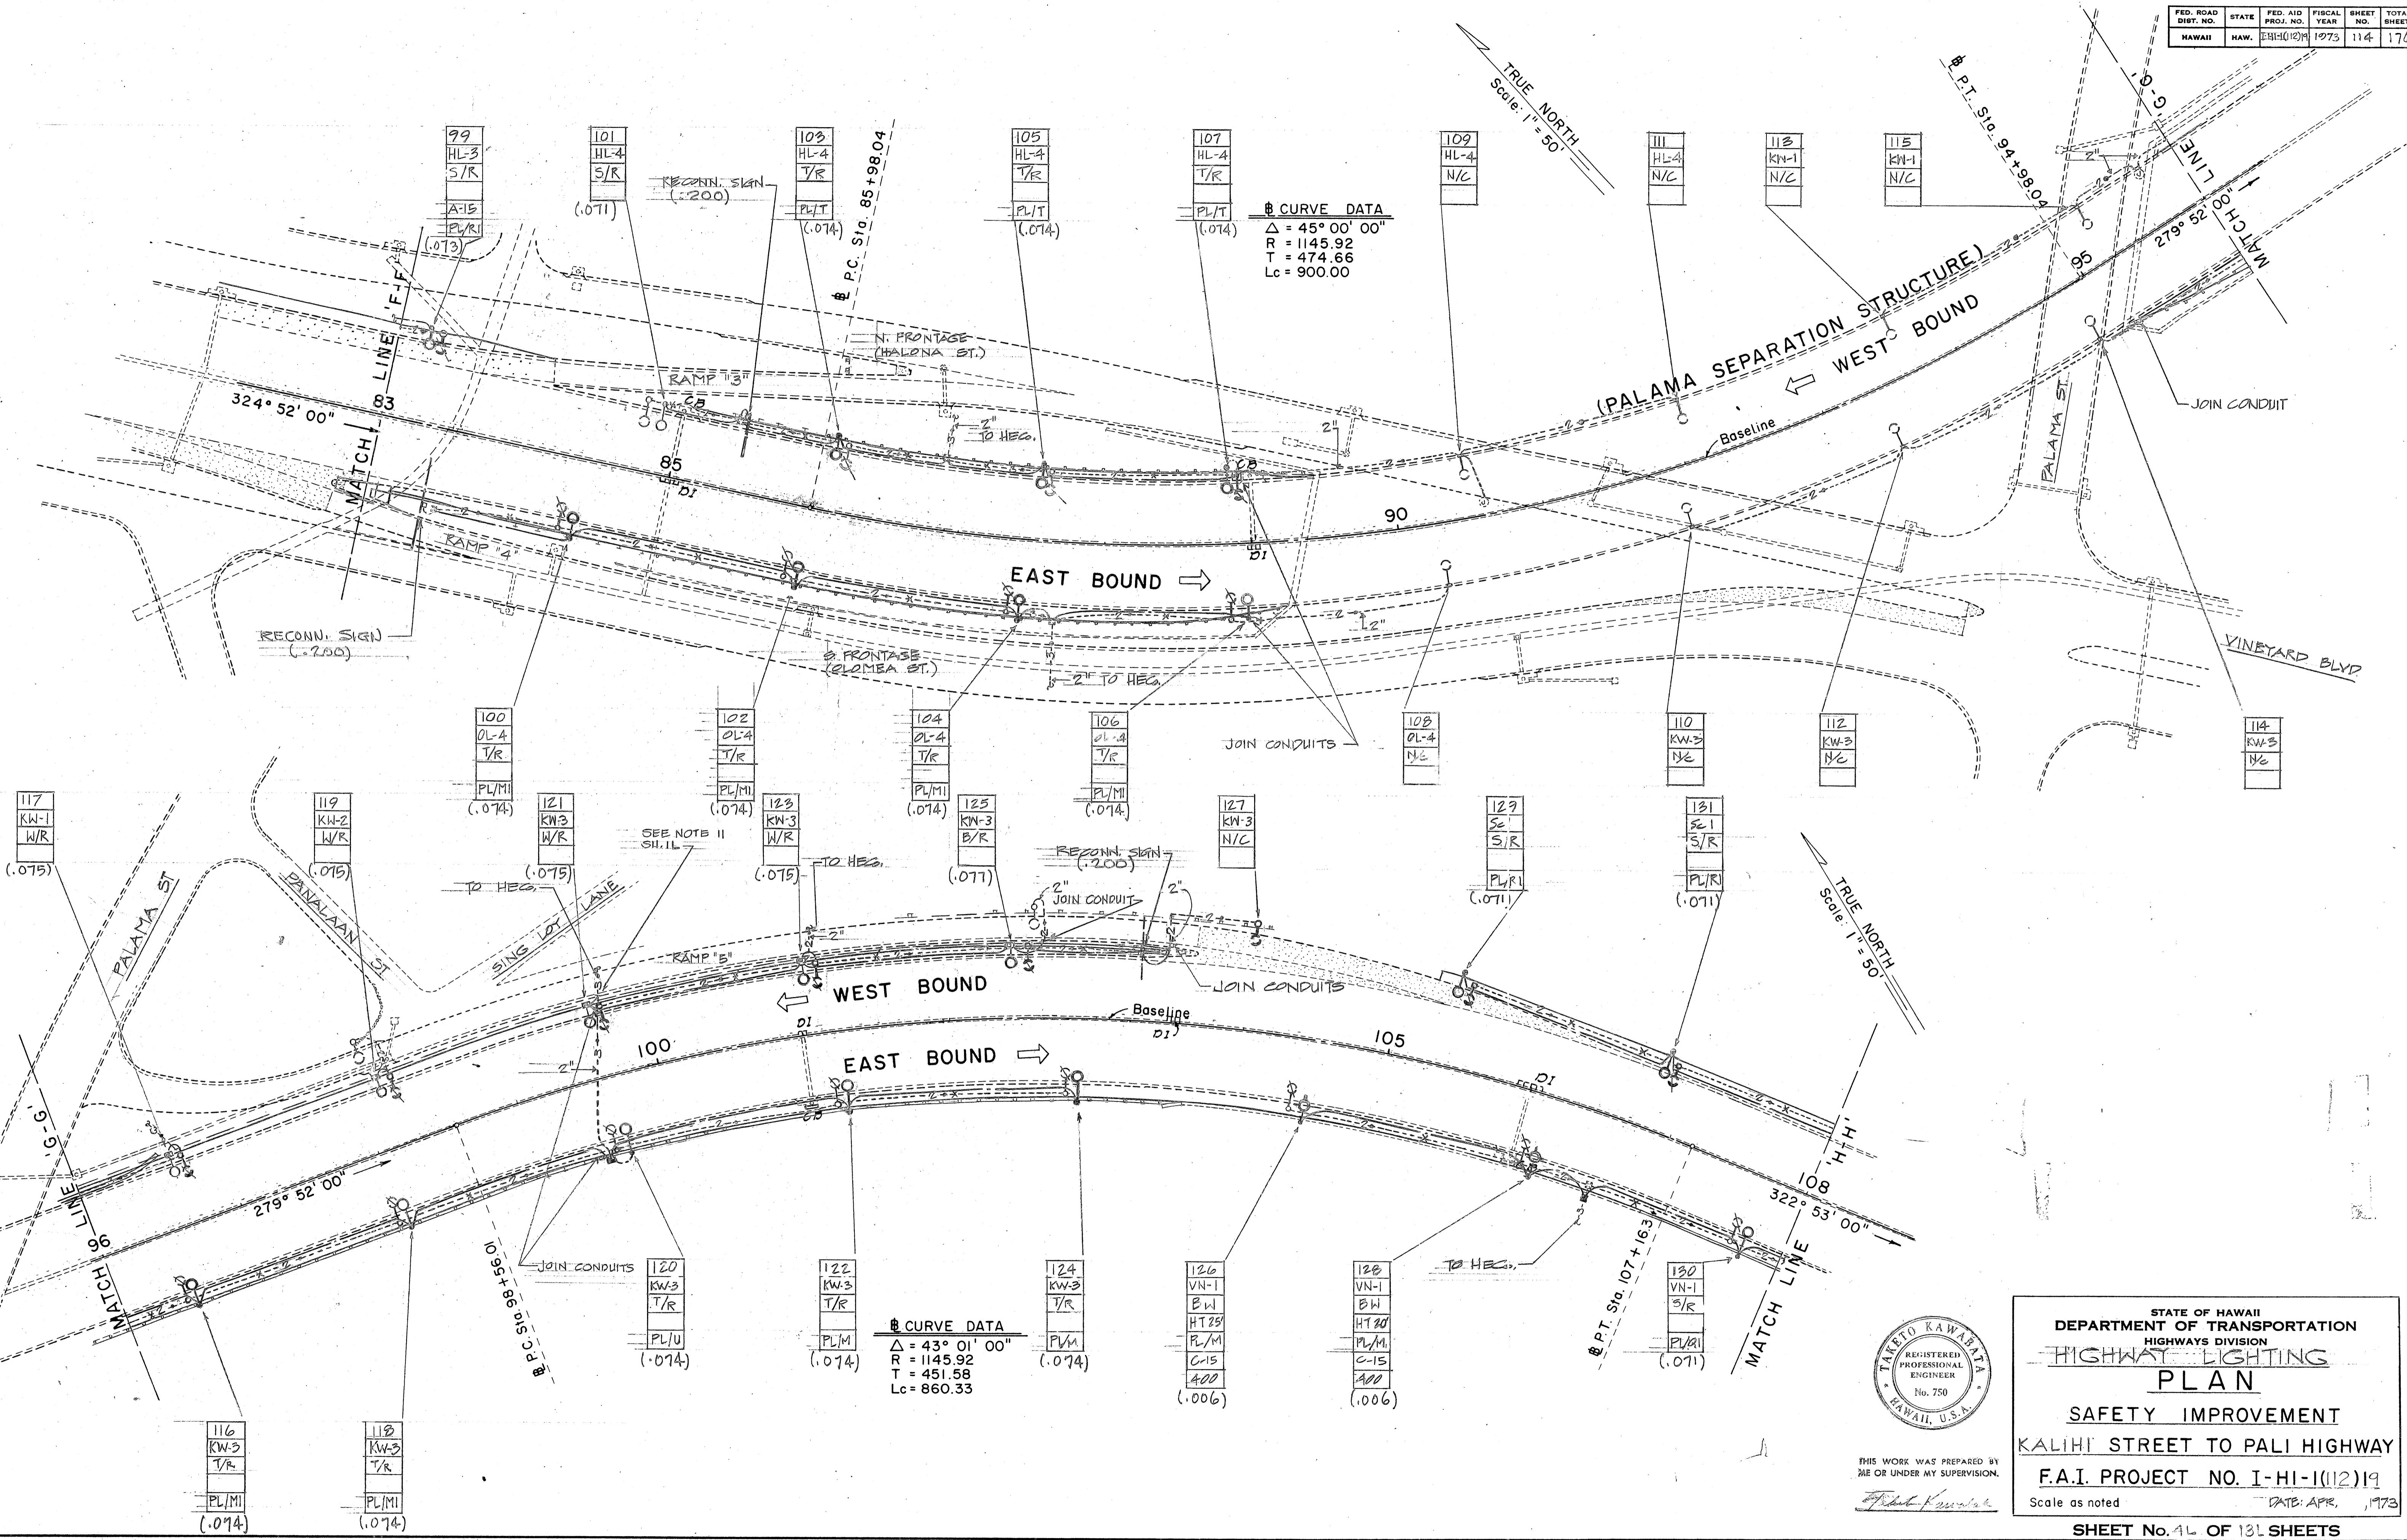

WORK WAS PREPARED BY
R UNDER MY SUPERVISION.

STATE OF HAWAII
DEPARTMENT OF TRANSPORTATION
HIGHWAYS DIVISION
HIGHWAY LIGHTING
PLAN

SAFETY IMPROVEMENT

HI STREET TO PALI HIGHWAY


I. PROJECT NO. I-HI-1(12)19

as noted DATE: APR., 1973


SHEET No. 46 OF 131 SHEETS

1 1 4

FED. ROAD DIST. NO.	STATE	FED. AID PROJ. NO.	FISCAL YEAR	SHEET NO.	TOTAL SHEETS
HAWAII	HAW.	EBB(12)19	1973	115	176

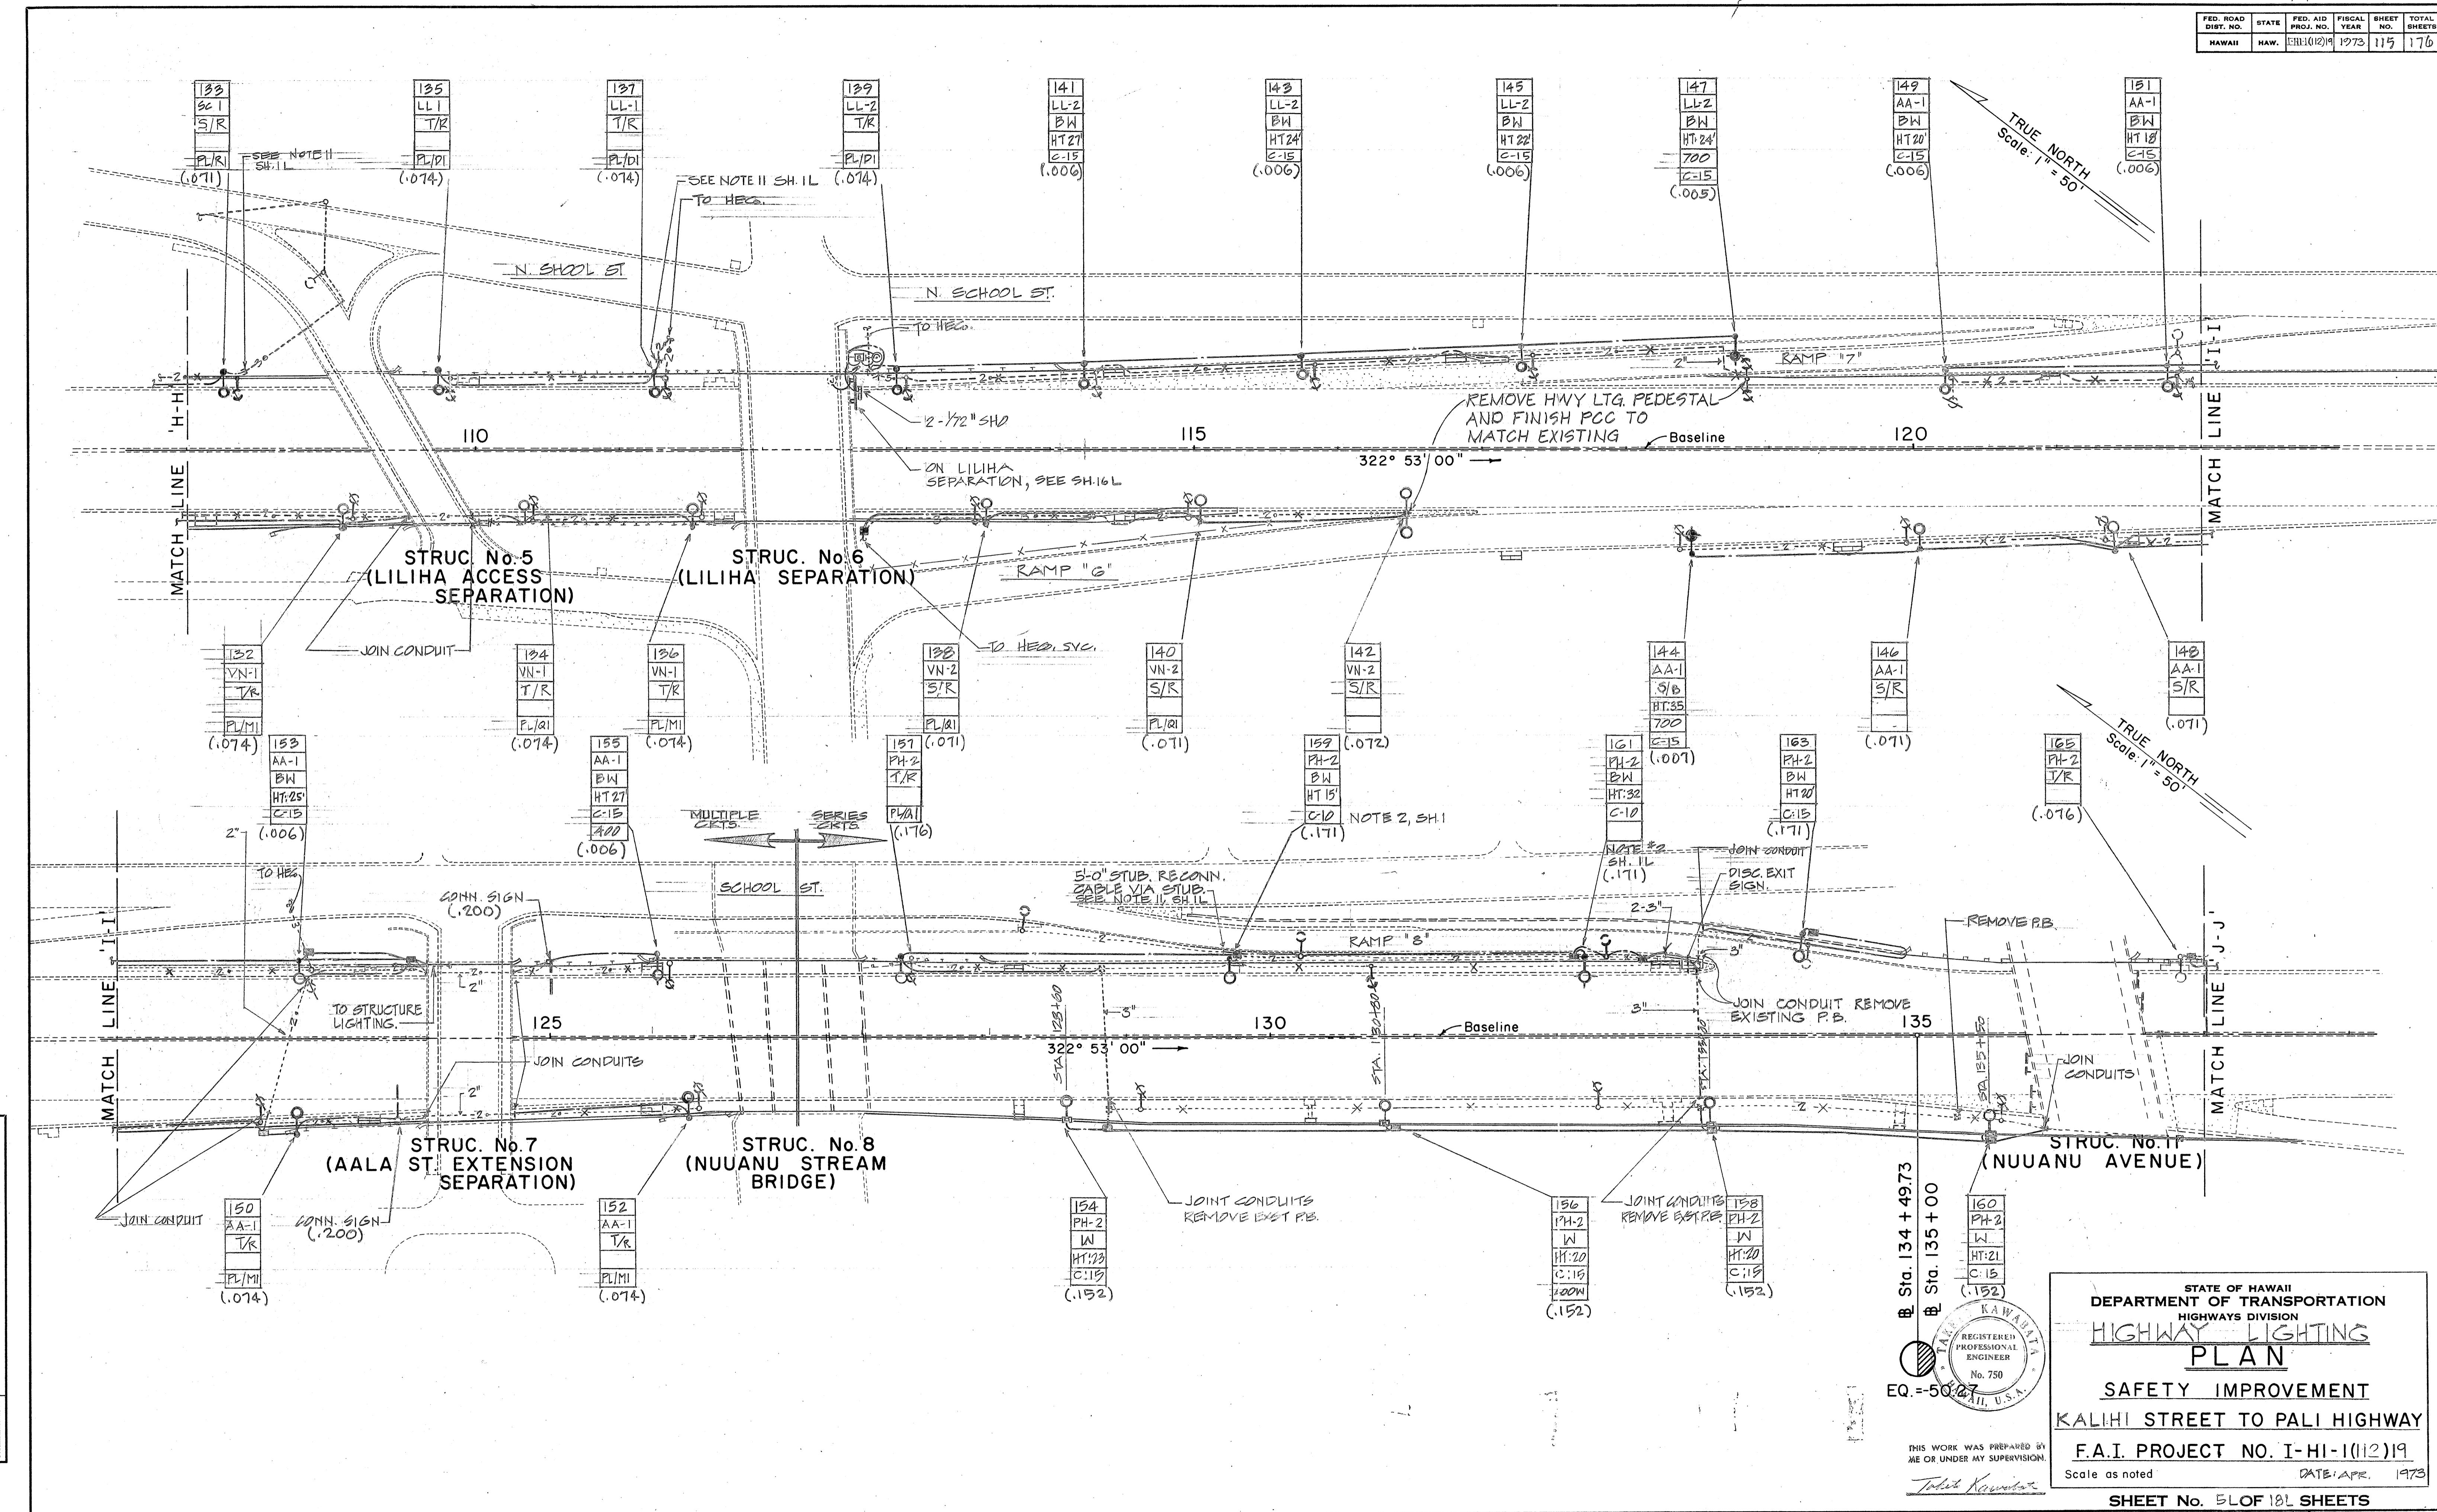









FED. ROAD DIST. NO.	STATE	FED. AID PROJ. NO.	FISCAL YEAR	SHEET NO.	TOTAL SHEETS
HAWAII	HAW	BR-1012019	1973	116	176

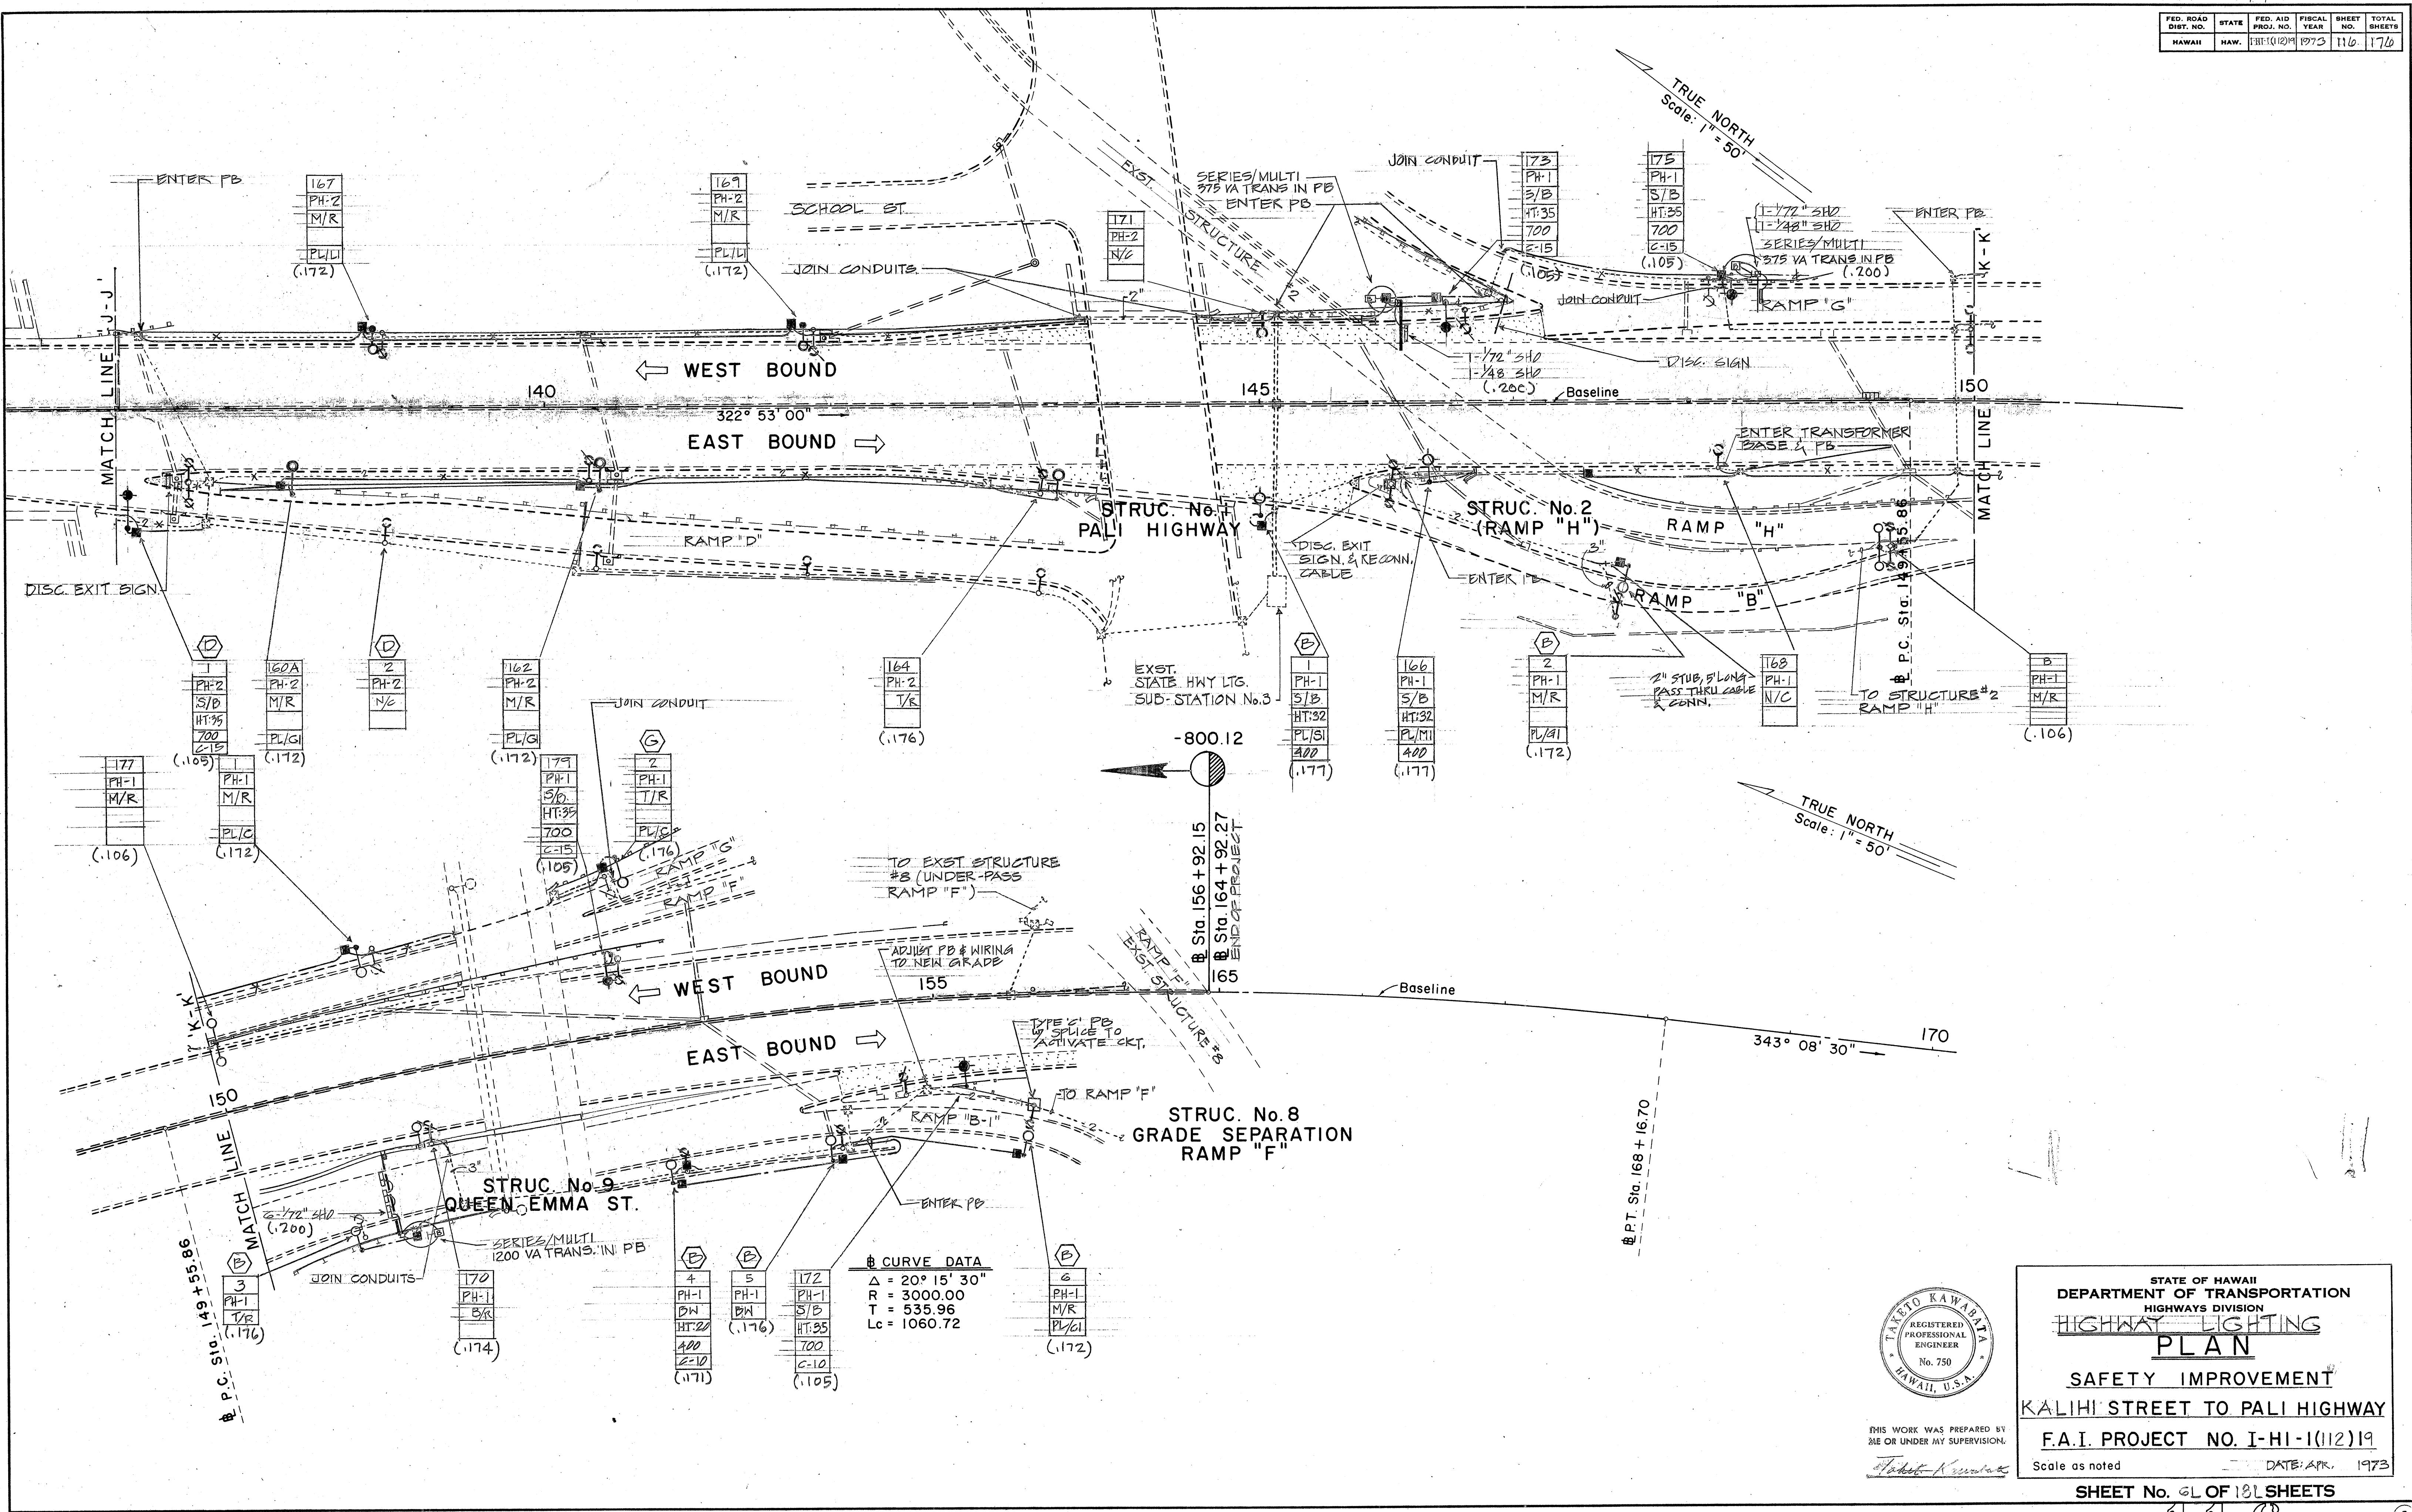


FED. ROAD DIST. NO.	STATE	FED. AID PROJ. NO.	FISCAL YEAR	SHEET NO.	TOTAL SHEETS
HAWAII	HAW.	I-HI-1(112)19	1973	117	176

NOTES

- (1) EXST. HWY. LIGHT ASS'Y.
- (2) NEW HWY LIGHT ASS'Y.
- (3) EXST. DIRECT BURIED CABLE TRENCH, LOCATION VARIES, ALL OTHER AREA, CABLE ROUTE DEPTH UNKNOWN.
- (4) NEW STATE HWY TYP. "G" PULL BOX W/2" CONDUIT TO LIGHT POLE ASS'Y BALLAST IN PB FOR SERIES-CKT. SEAL CONDUIT OPENING W/ SEAL COMPOUND.
- (5) NEW "CUT" AT HWY LIGHT ASS'Y.
- (6) RAIL
- (7) ALL ABANDONED HWY. LIGHT CONC. FOUNDATIONS TO BE REMOVED UNLESS OTHERWISE DIRECTED BY ENGINEER.
- (8) ABANDON DIRECT BURIED CABLE
- (9) SERIES CKT. CABLES
- (10) SERIES CKT. CABLES W/ EPOXY RESIN SPLICE TO EXST.
- (11) MULTI-CKT CABLES W/ EPOXY RESIN SPLICE W/ EXISTING UNLESS OTHERWISE SHOWN.
- (12) SERIES CKT. CABLE
- (13) WEST BOUND H-1
- (14) EAST BOUND H-1
- (15) INSIDE FACE OF CURB
- (16) UNASSIGNED
- (17) FOR CKT. ASSIGNMT., SEE PLANS & DIAGRAM.
- (18) POLE ACCESS HANDHOLE
- (19) TRANS. BASE ACCESS COVER,
- (20) 2" PVC, SCH'D 40 CONDUIT
- (21) 2" PVC, SCH'D 40 CONDUIT TO ADJACENT HWY LTG.
- (22) SHOULDER PAVEMENT
- (23) REFER TO HWY. LTG. PLAN
- (24) FOR POLE FOUNDATION DET. SEE SH. 13L.
- (25) BITUMINOUS CURB
- (26) BITUMINOUS GUTTER
- (27) BITUMINOUS GUTTER OUTBOARD EDGE.

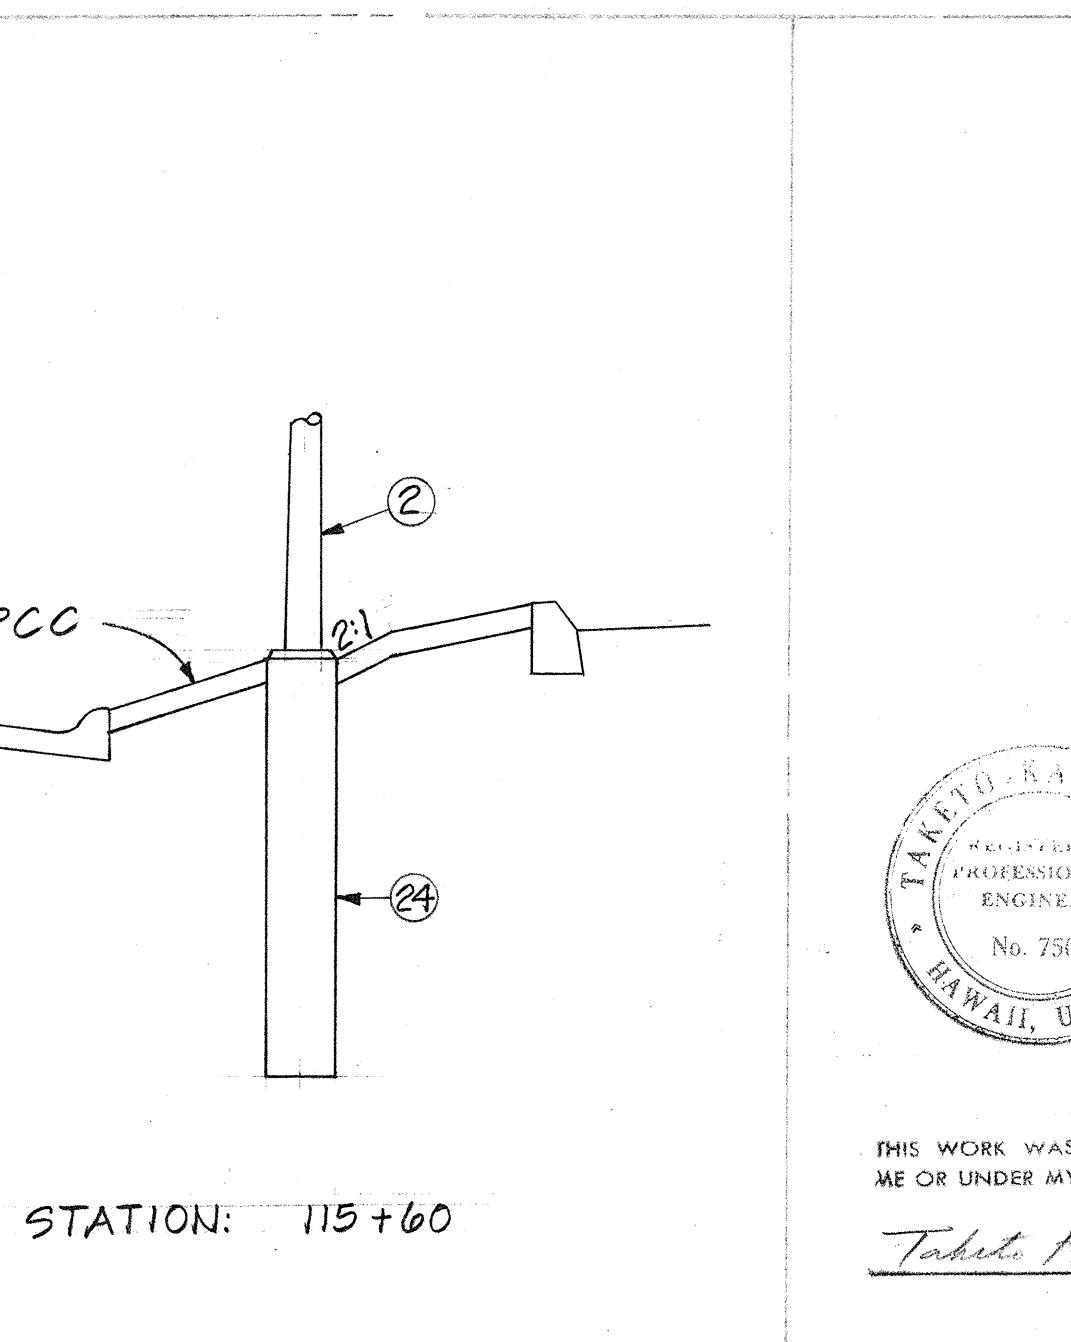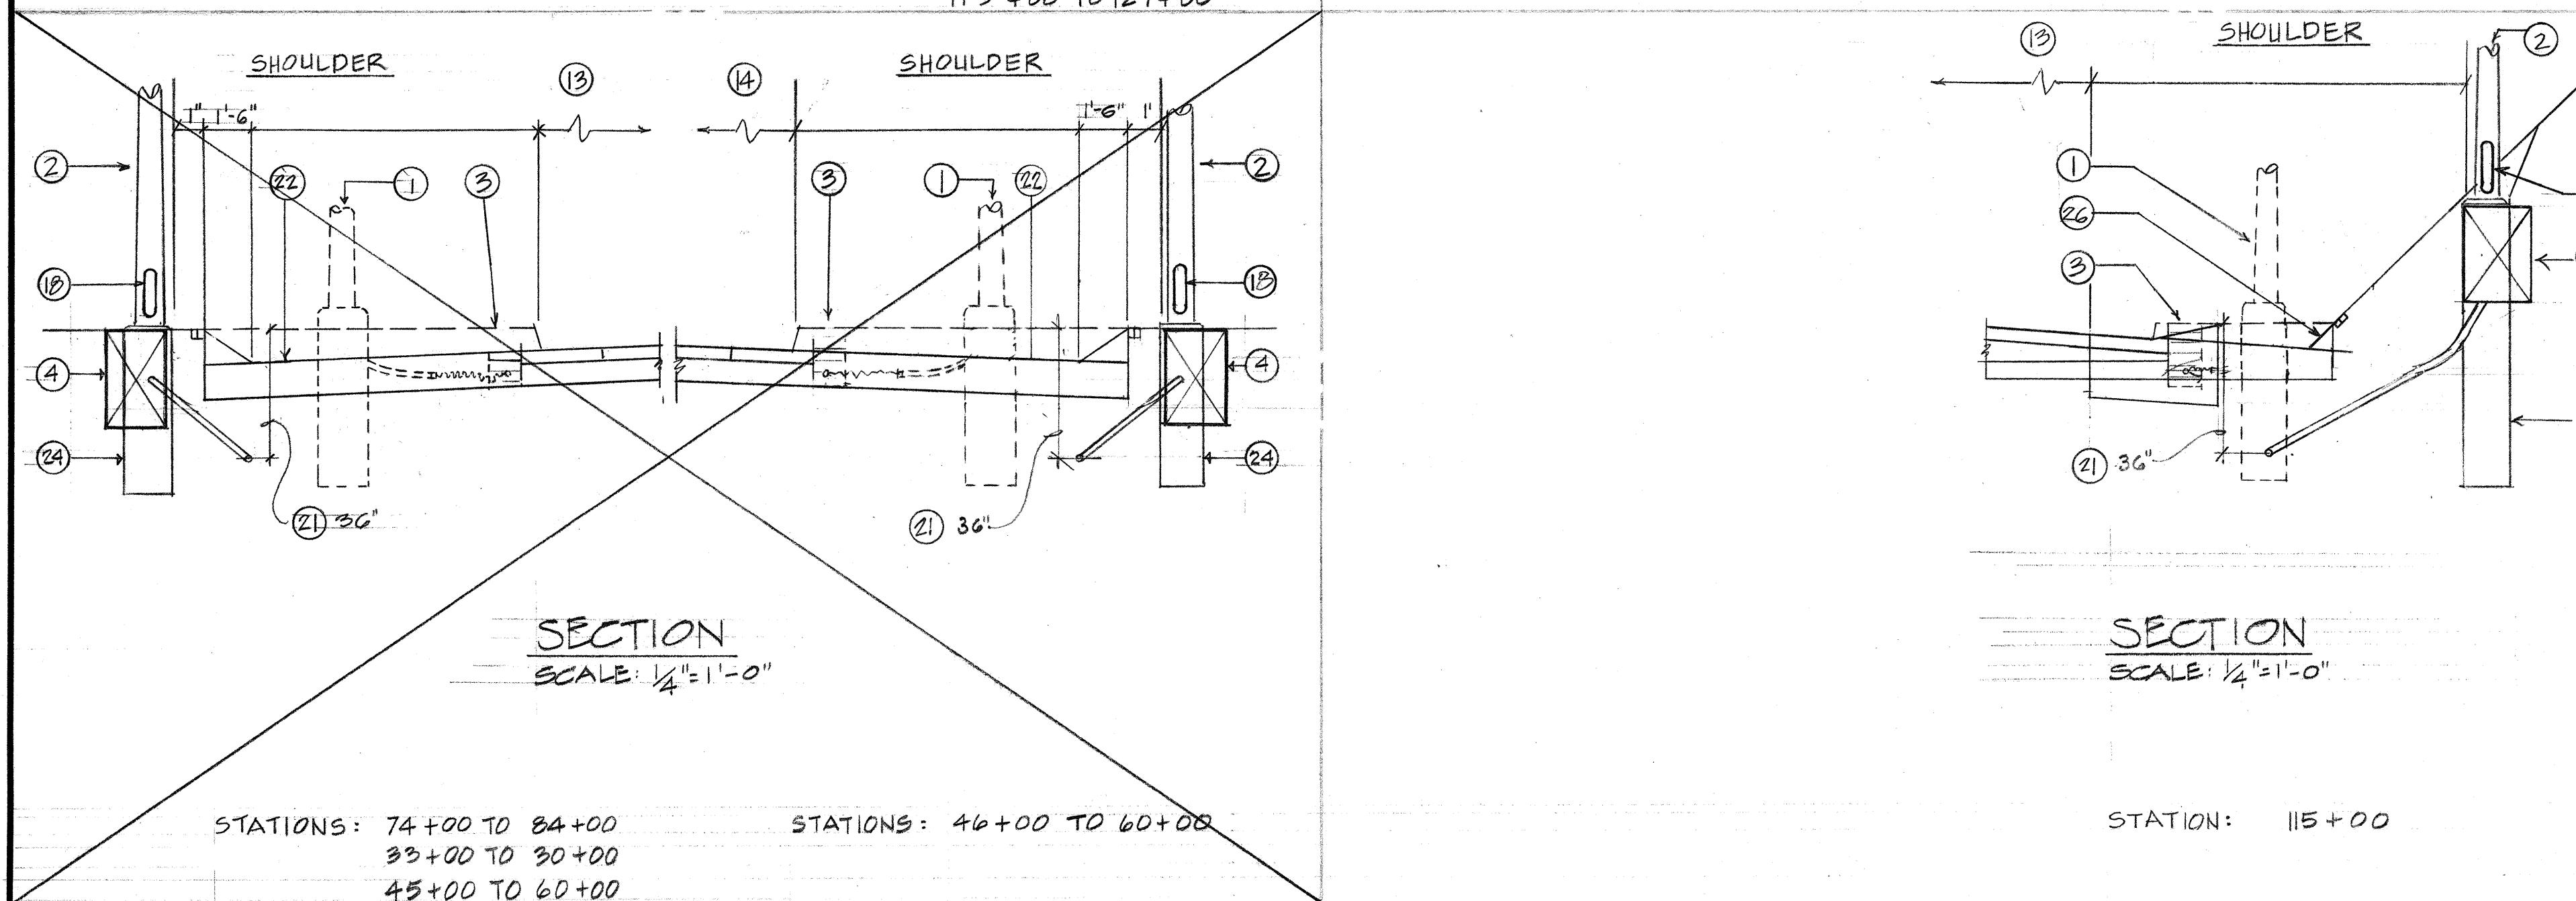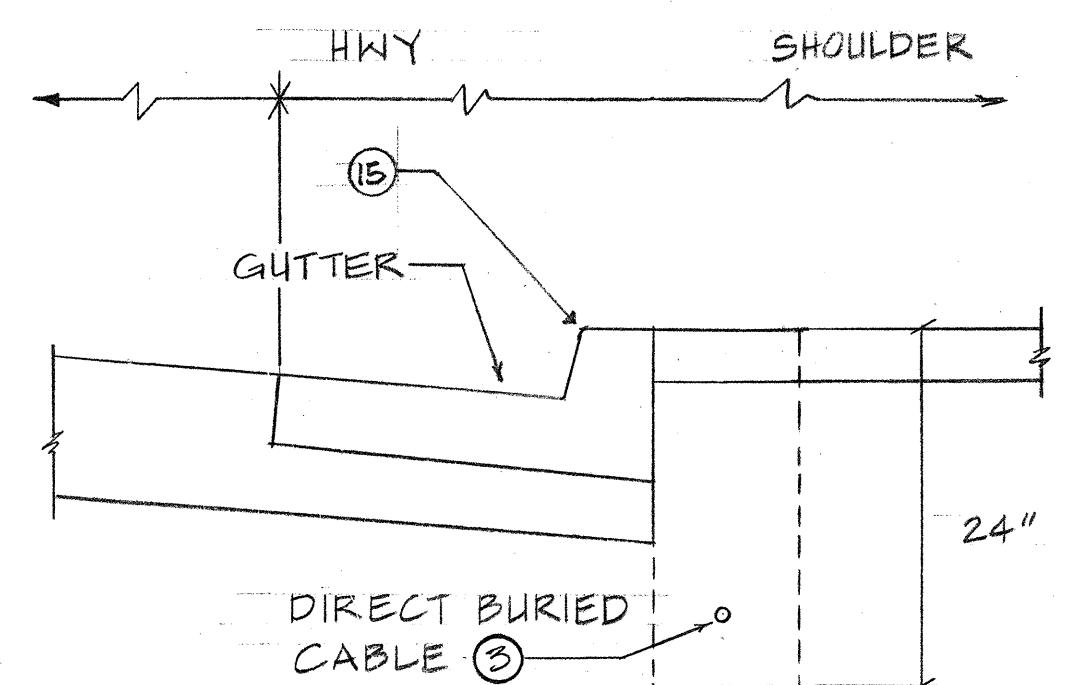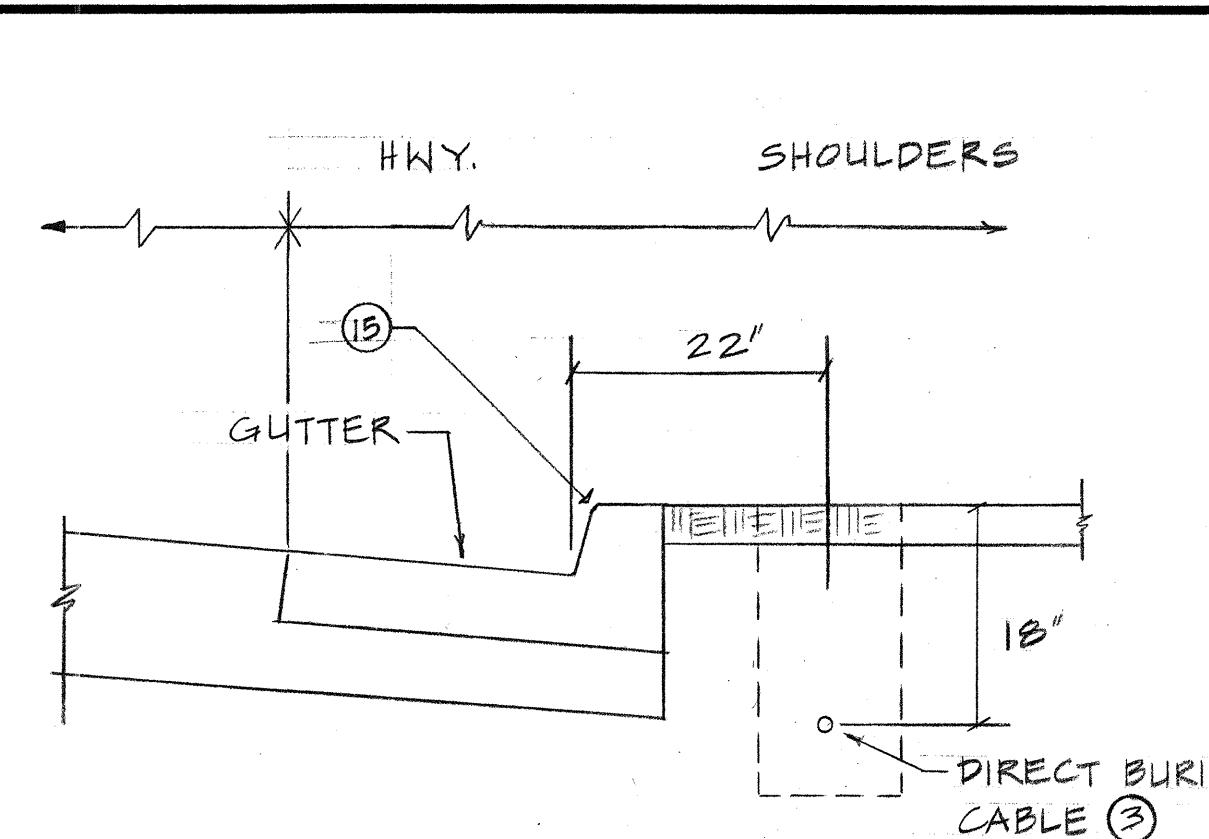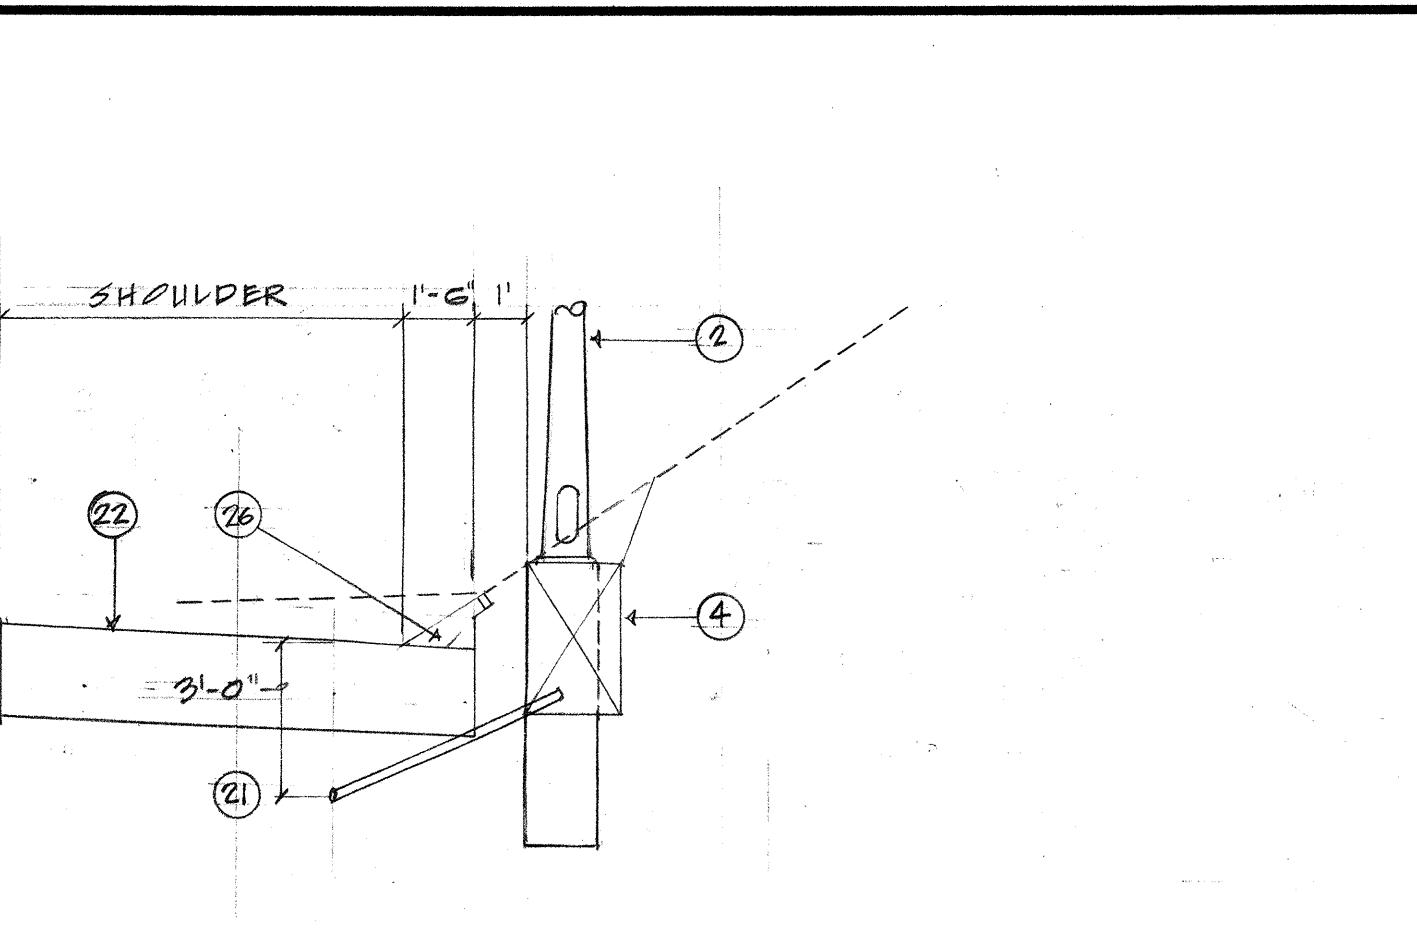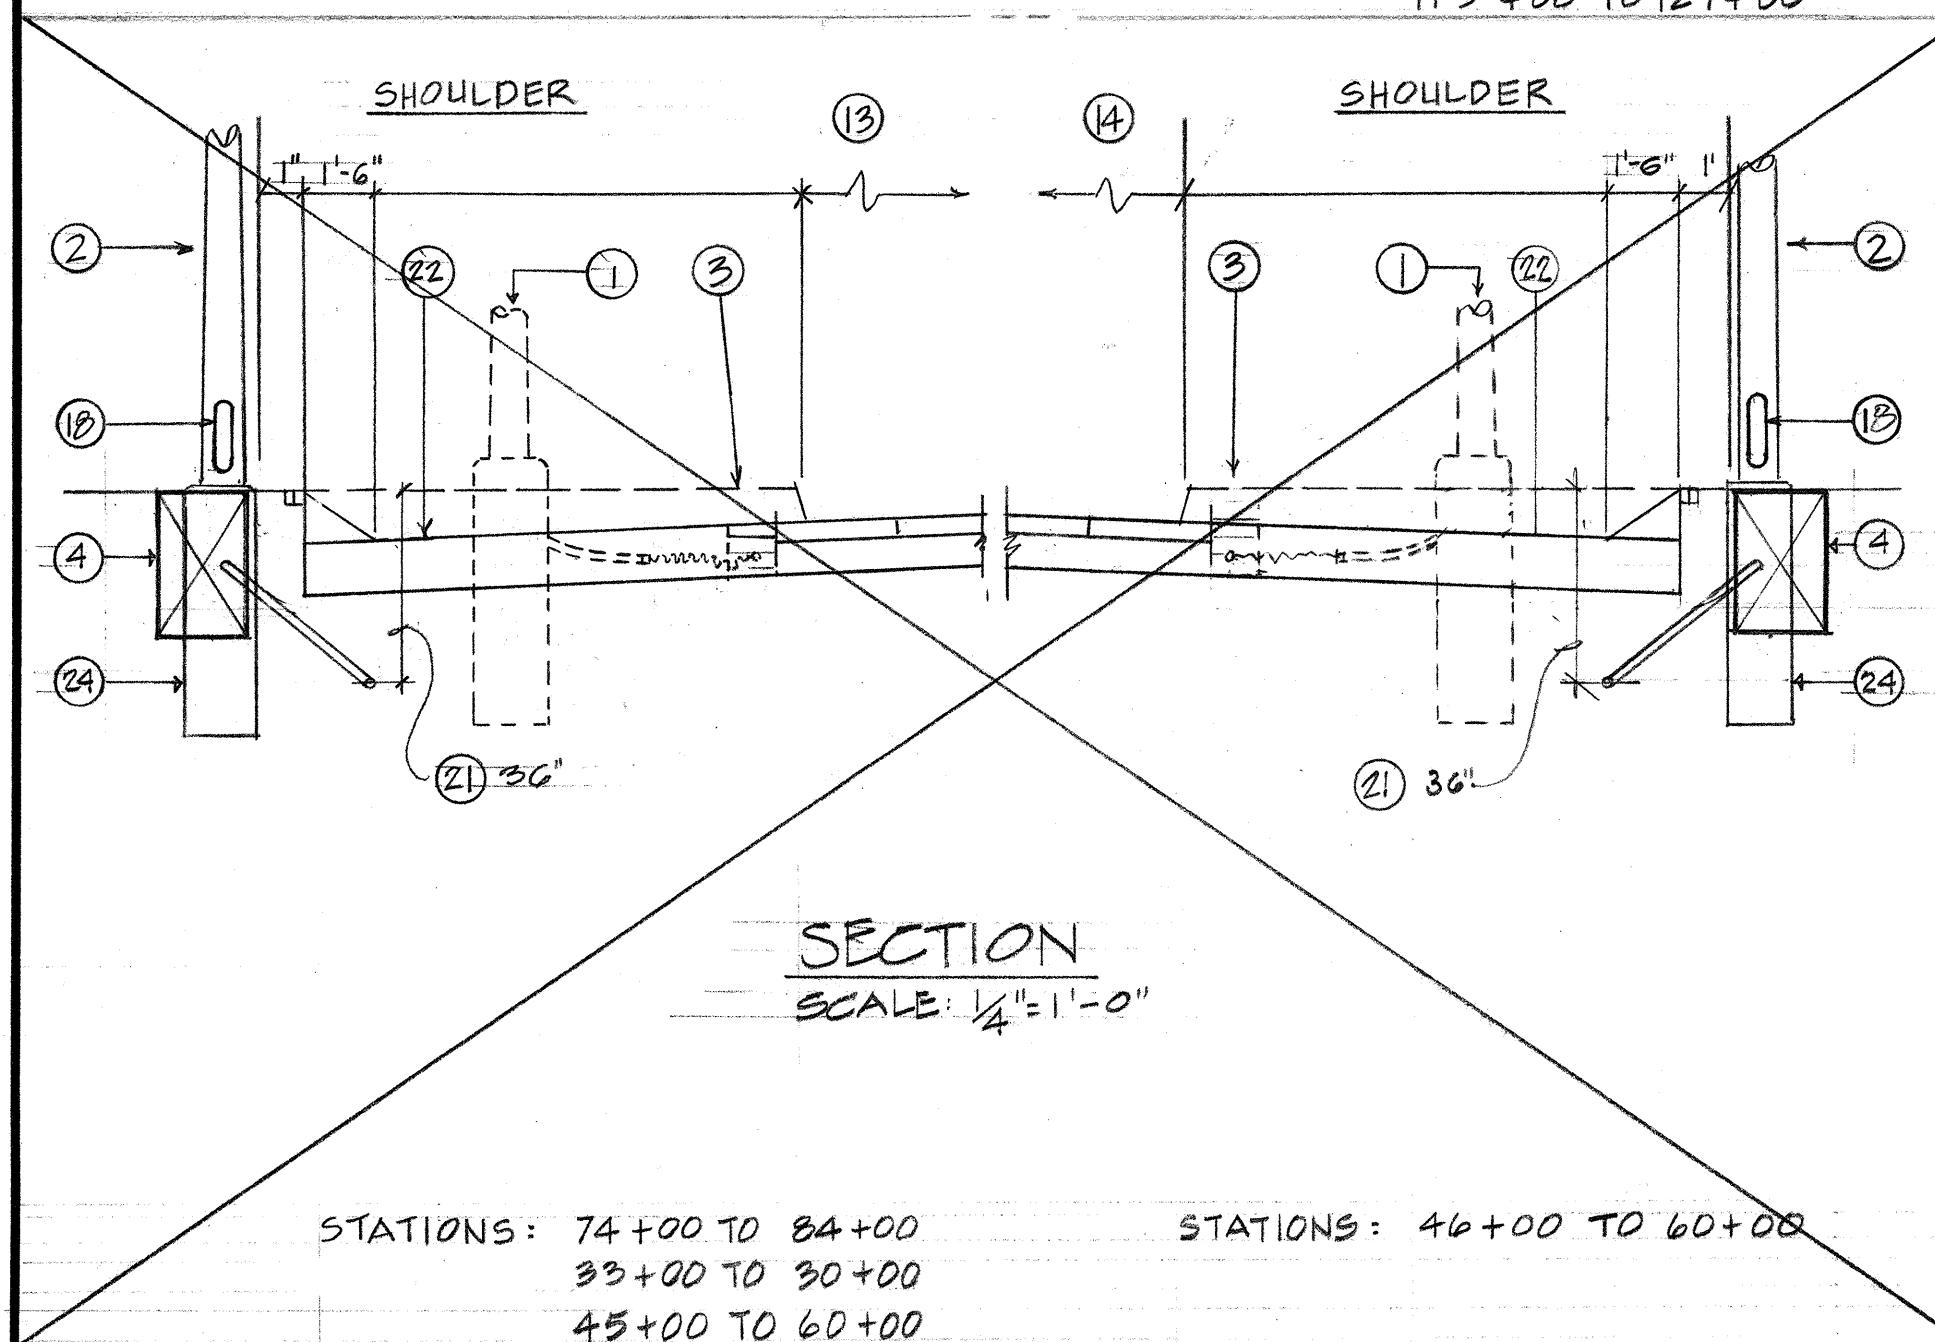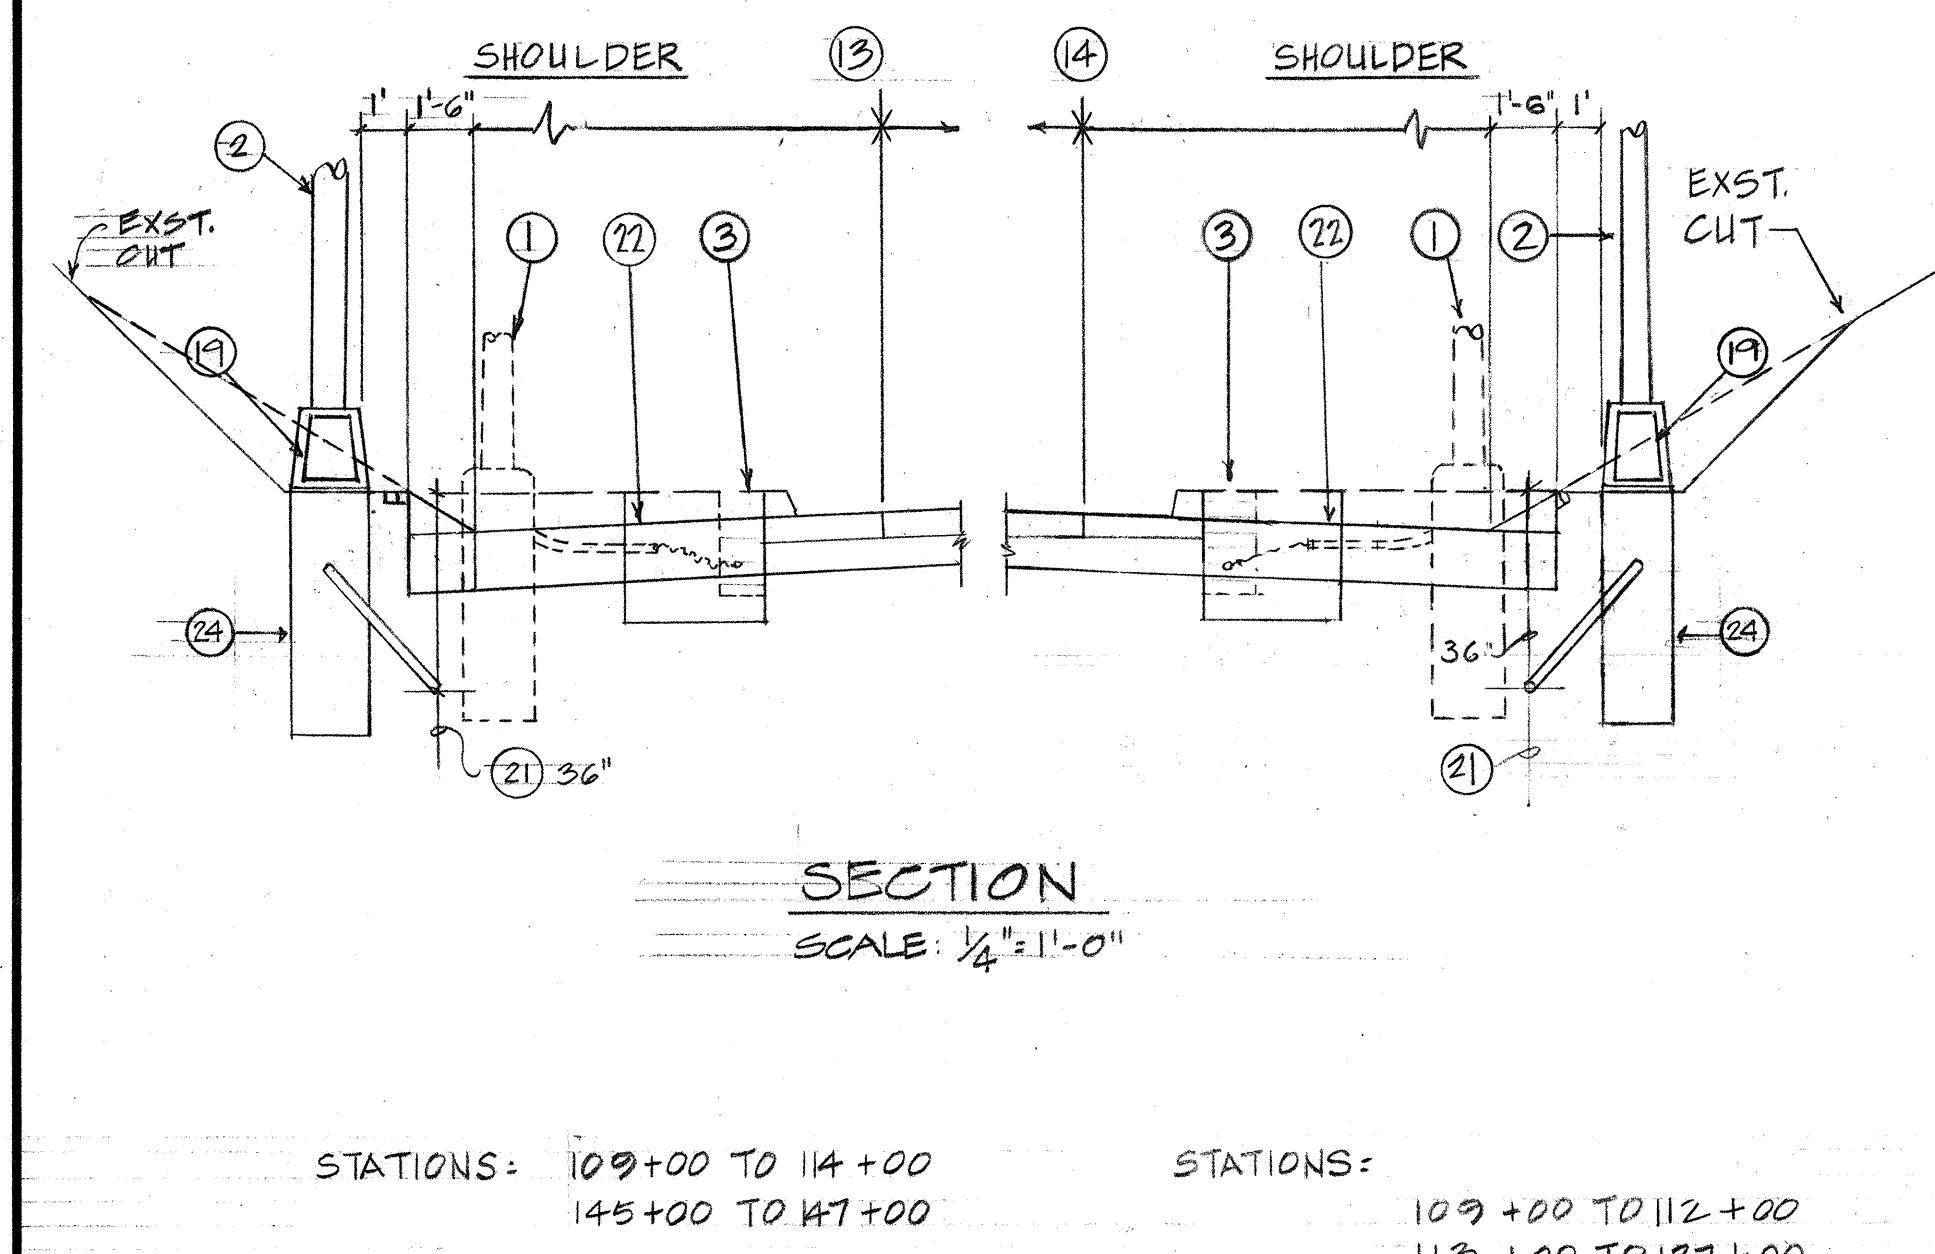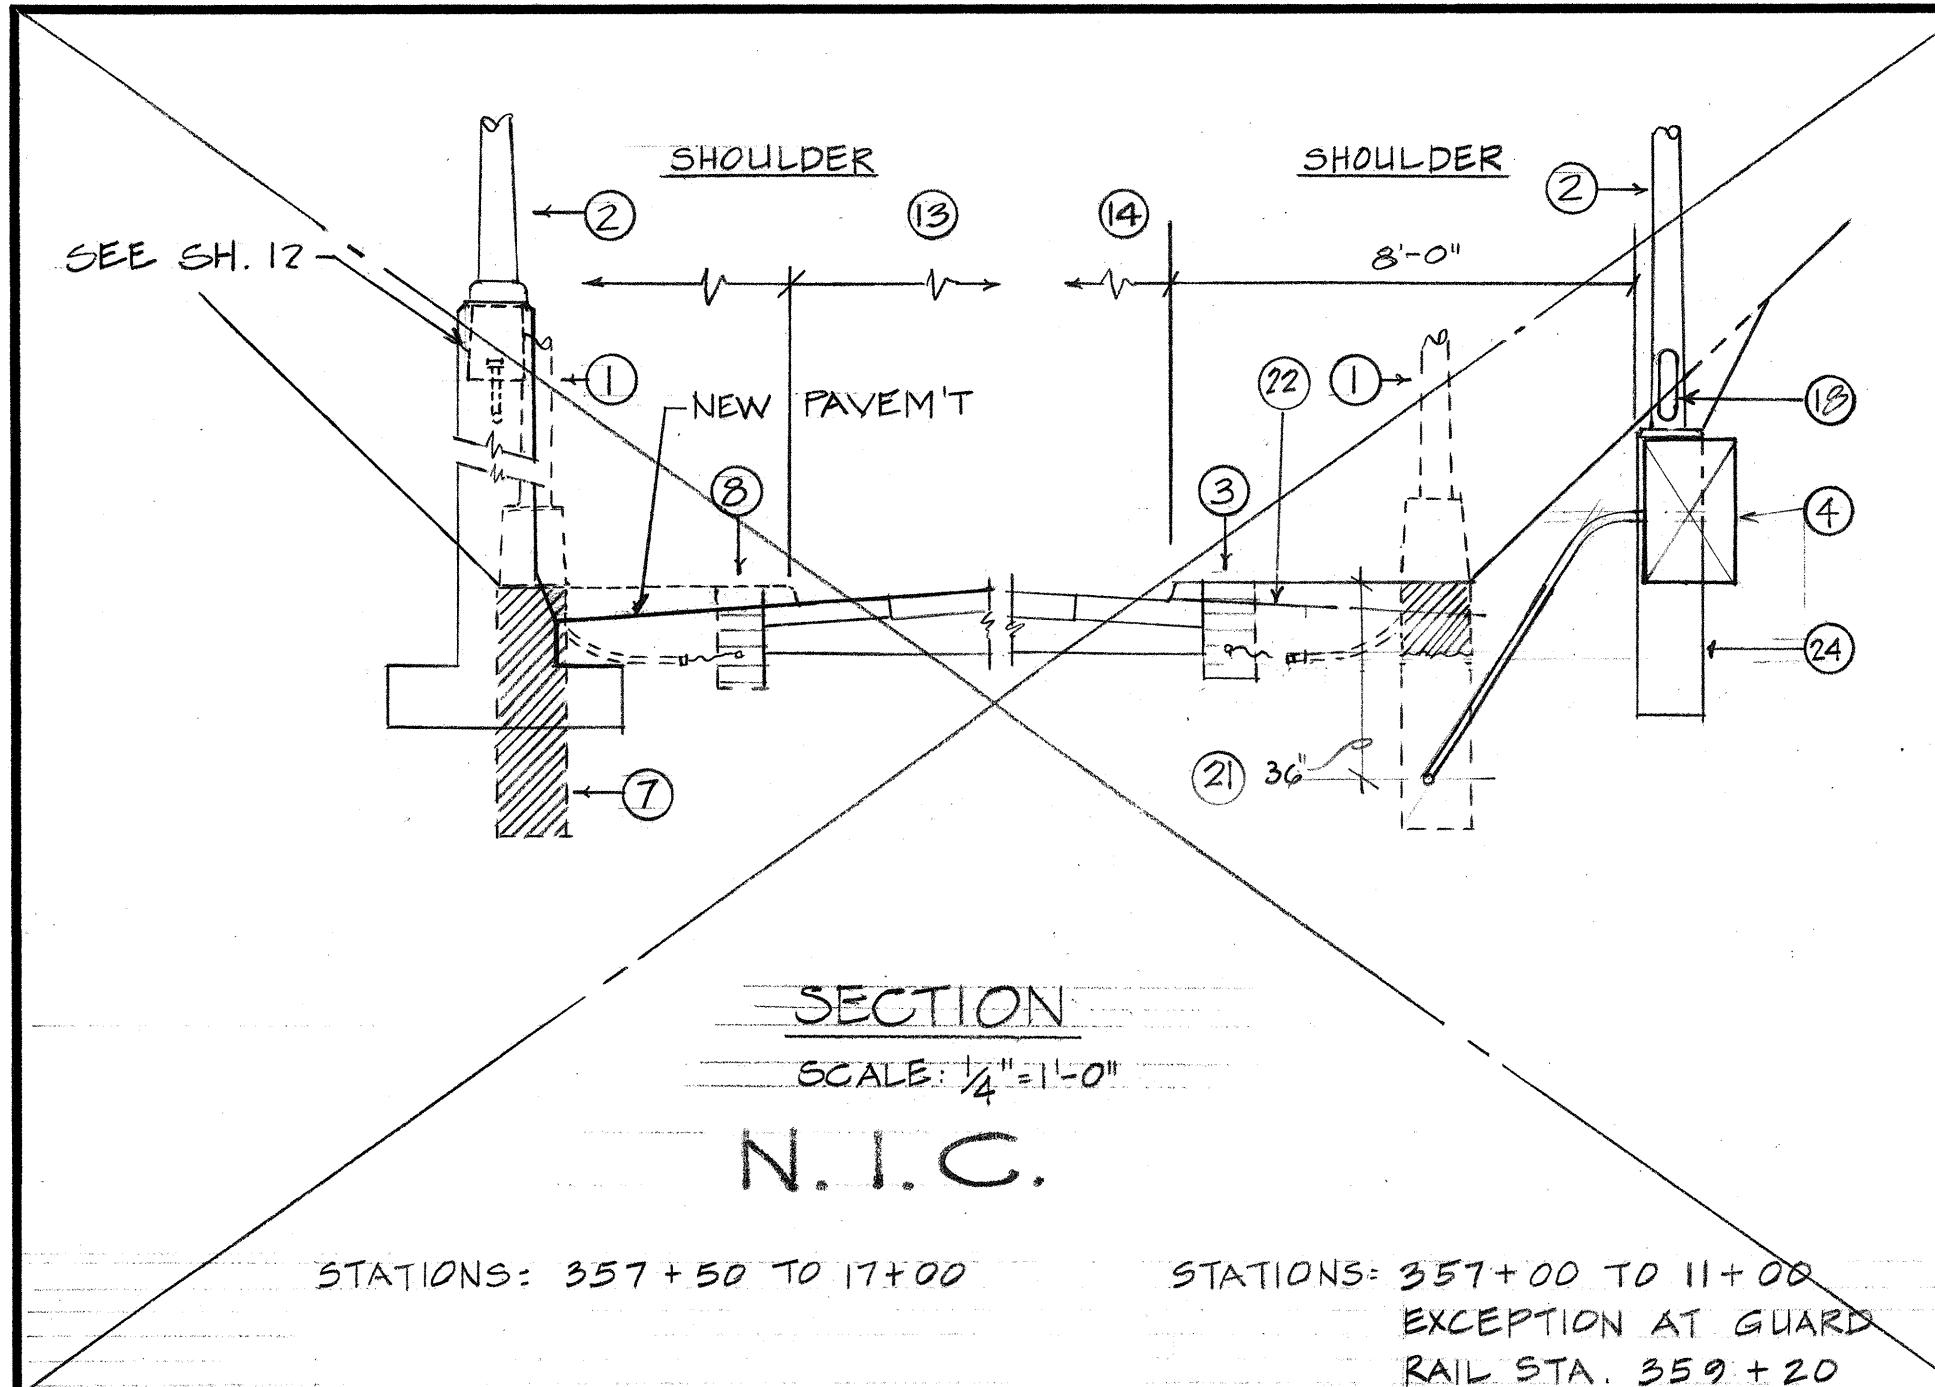


STATE OF HAWAII
DEPARTMENT OF TRANSPORTATION
HIGHWAYS DIVISION
HIGHWAY LIGHTING
POLE INSTALLATION SECTIONS
SAFETY IMPROVEMENT
KALIHI STREET TO PALI HIGHWAY
F.A.I. PROJECT NO. I-HI-1(112)19
SCALE AS NOTED DATE: APR. 1973
SHEET No. 7L OF 18L SHEETS

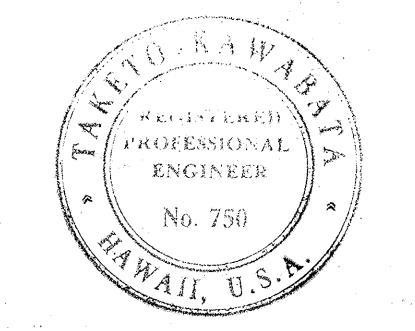


This work was prepared by
me or under my supervision.
Takao Kawanabe

FED. ROAD DIST. NO.	STATE	FED. AID PROJ. NO.	FISCAL YEAR	SHEET NO.	TOTAL SHEETS
HAWAII	HAW.	I-HI-1(II2)19	1973	118	176


NOTES:
1. (1) INDICATES — NOTE #1, FOR NOTE REFERENCE
SEE SH #7L

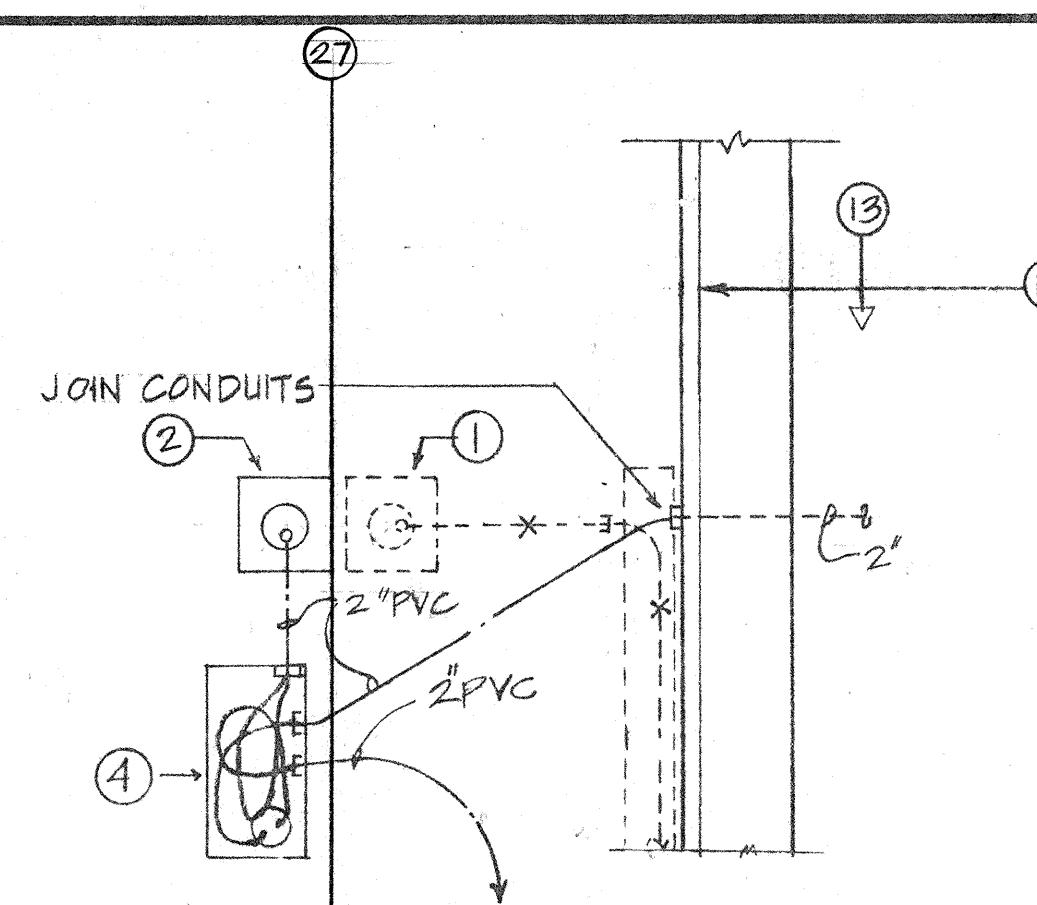


PLAN A
PLAN A SIMILAR
NOTE: 23

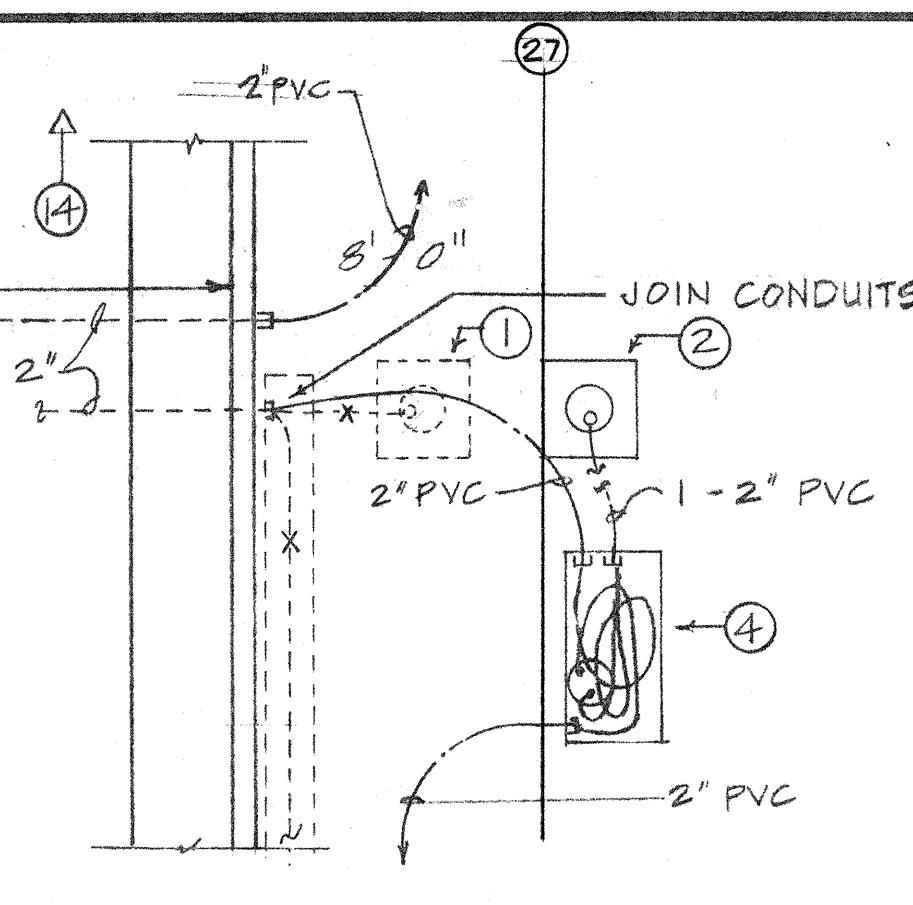


PLAN E

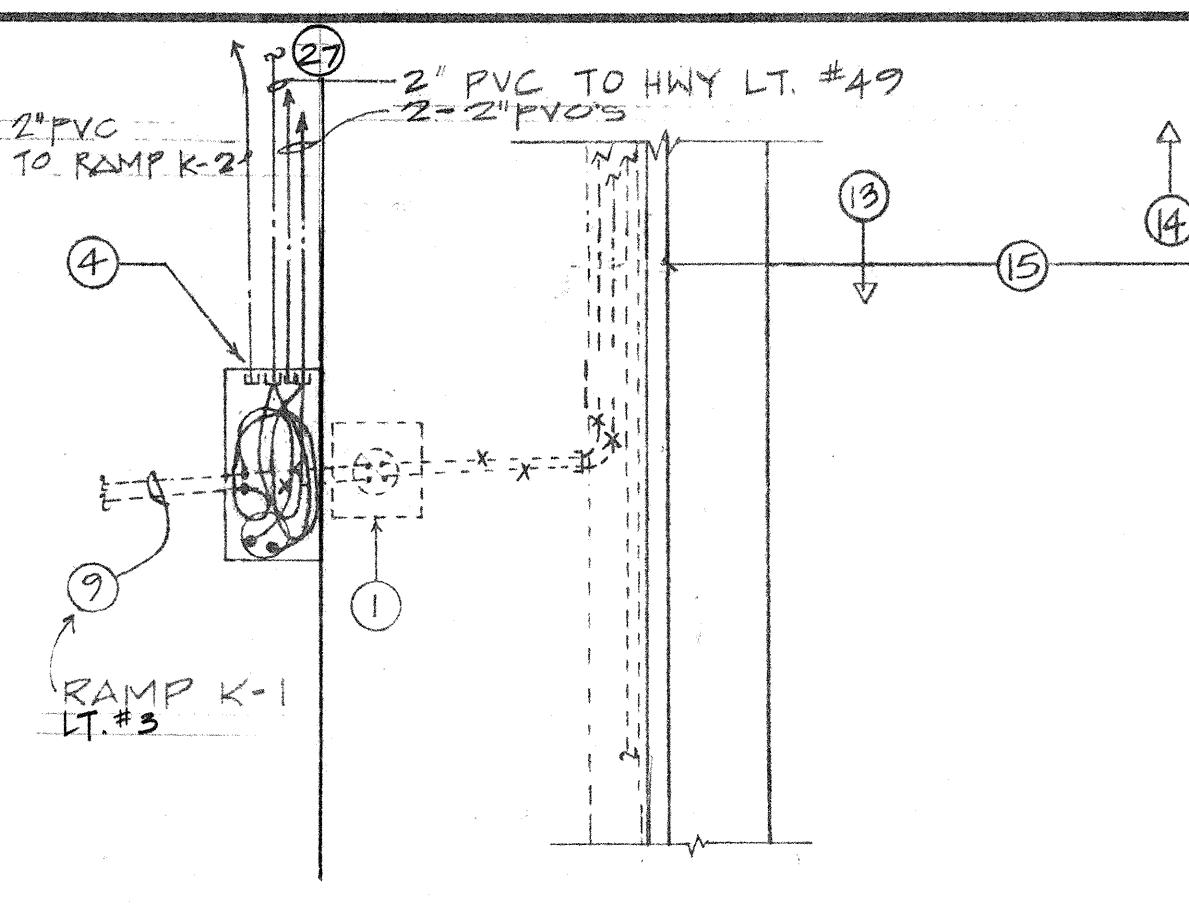


PLAN I

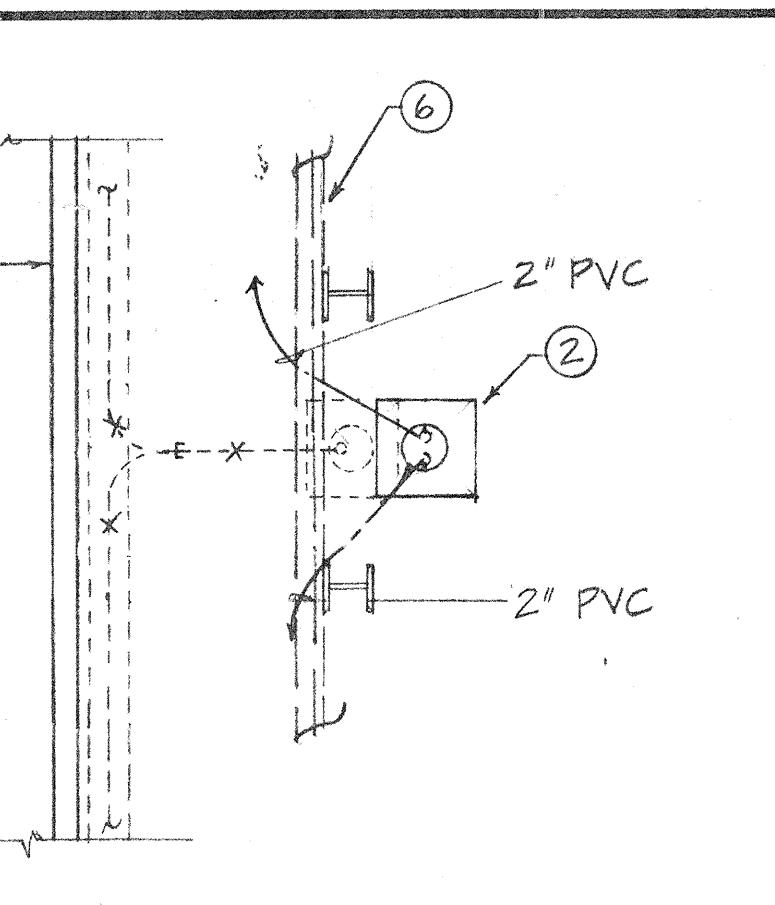


PLAN M
PLAN M SIMILAR
NOTE: 23

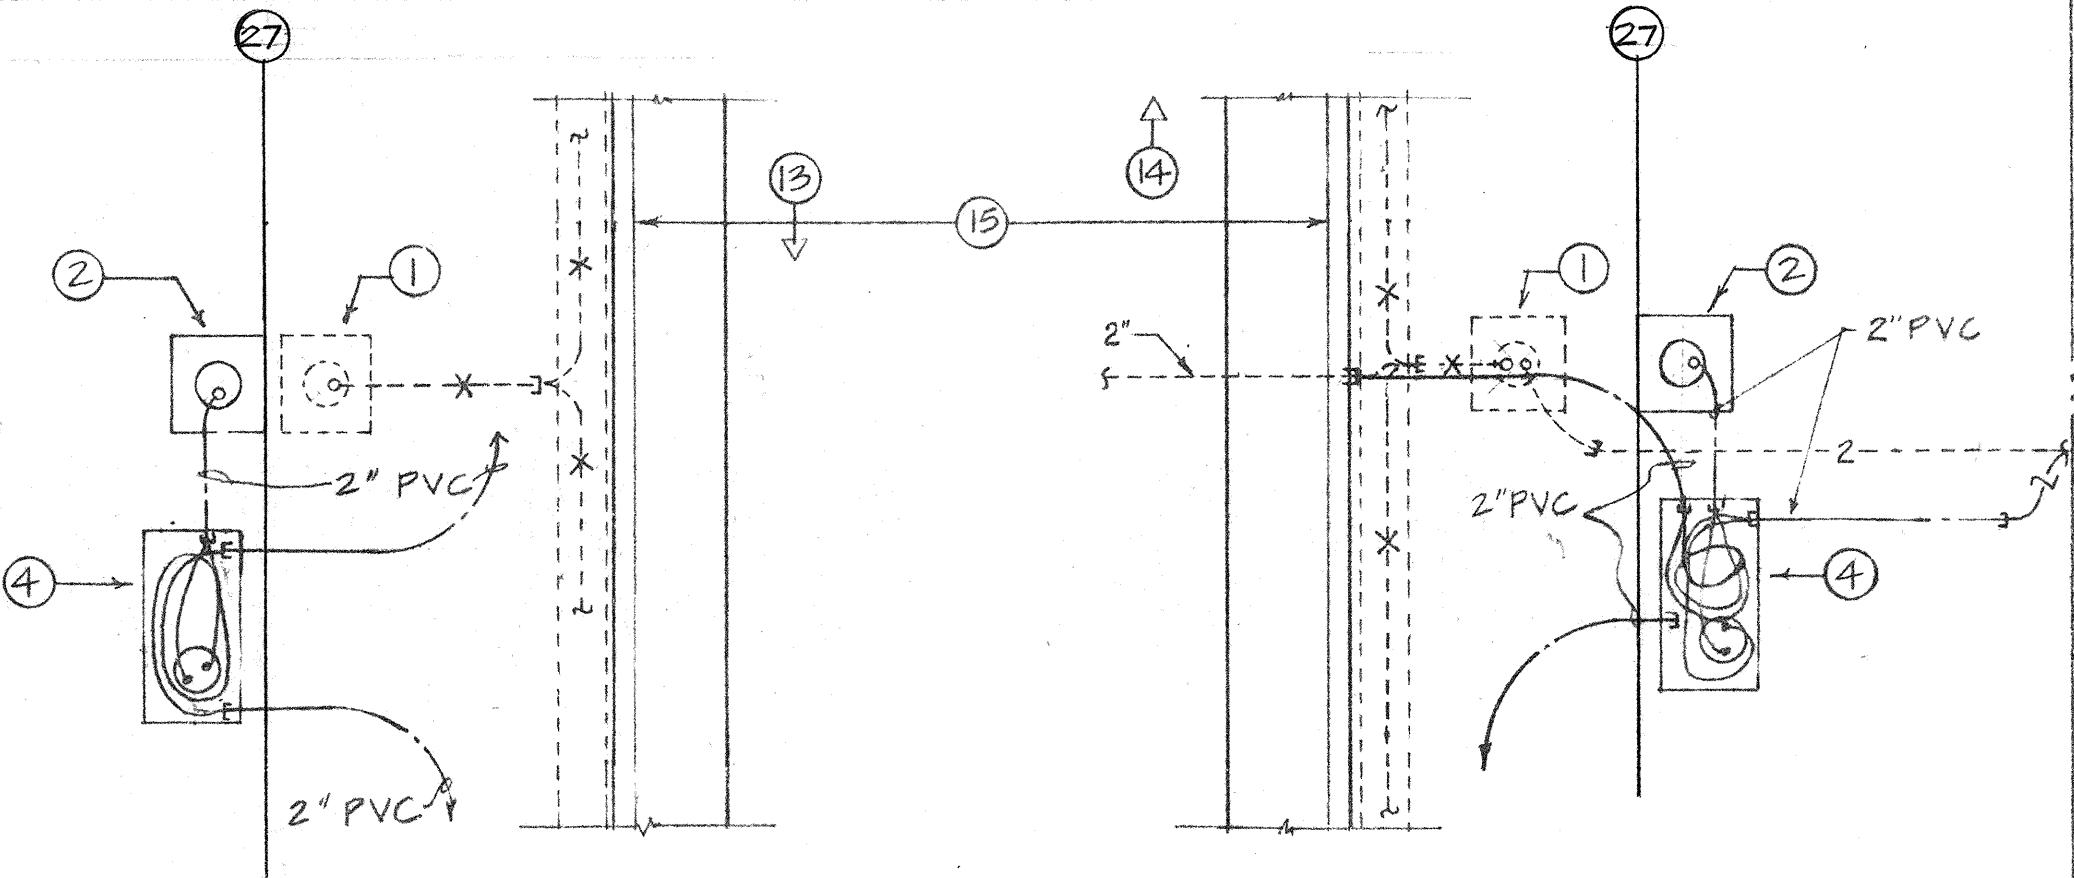


PLAN B

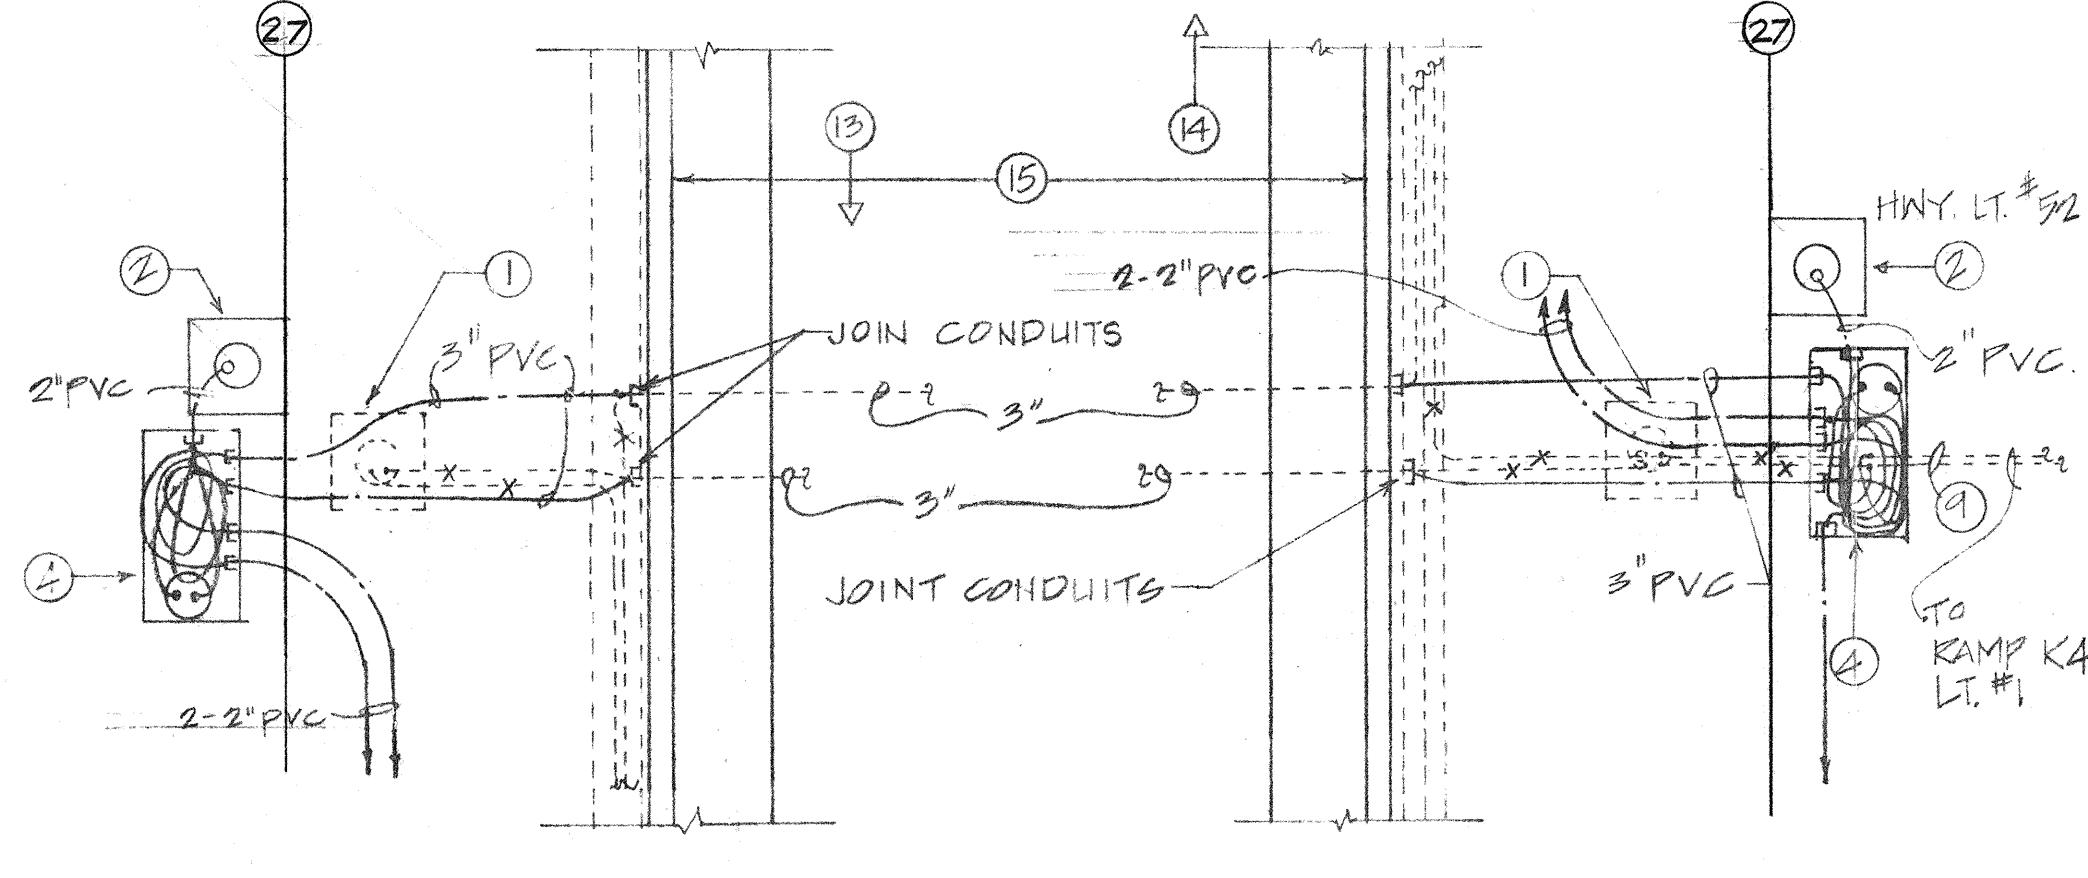


PLAN J

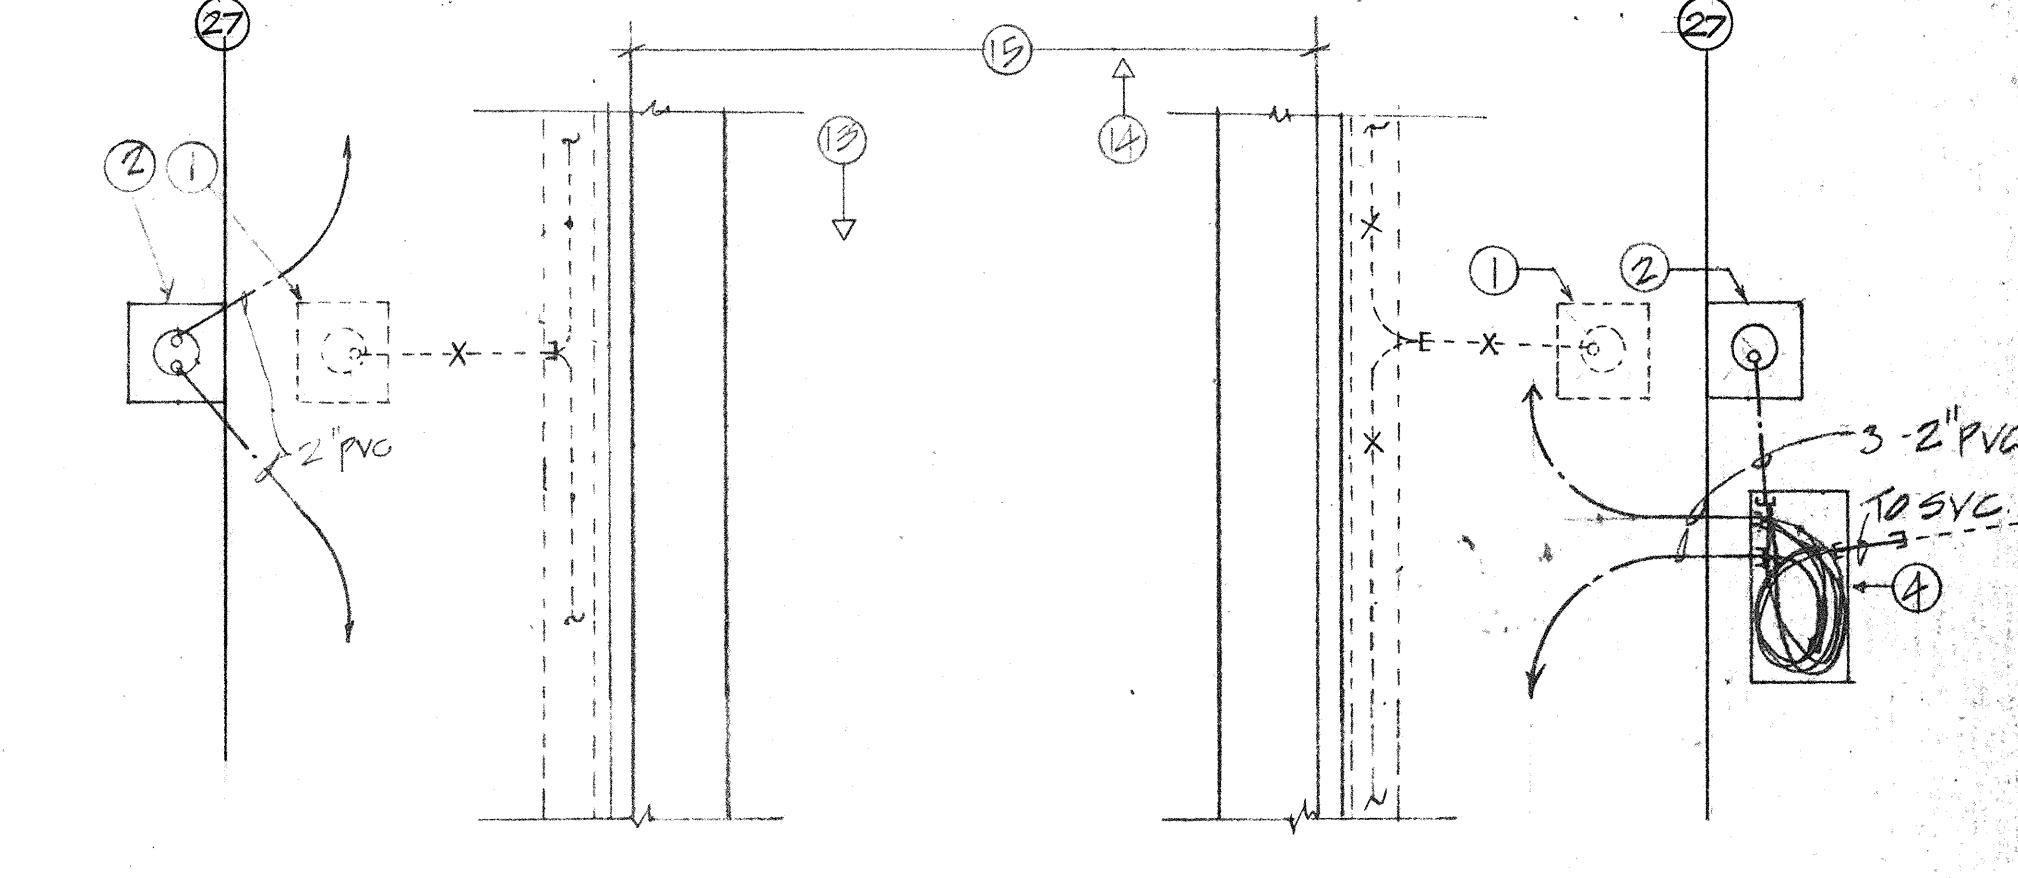


PLAN R
PLAN R SIMILAR
NOTE: 23

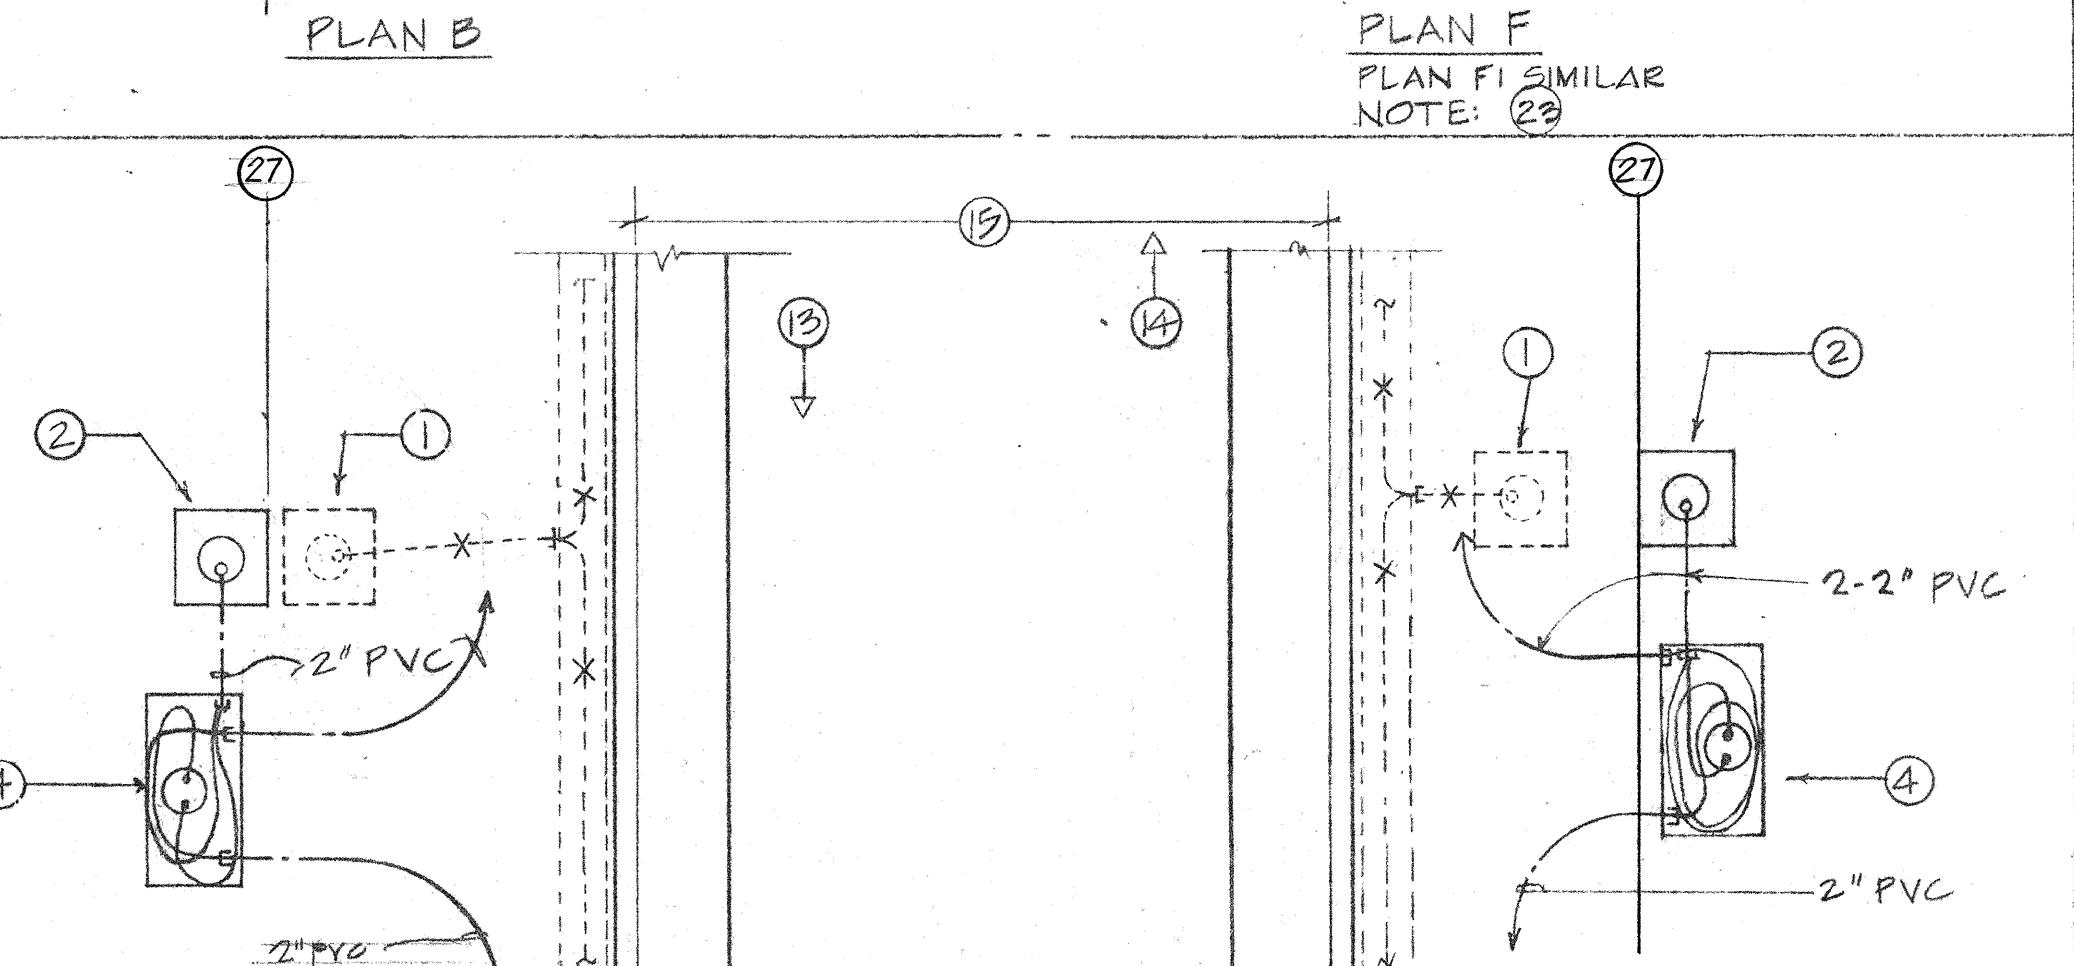


PLAN C
PLAN C SIMILAR
NOTE: 23

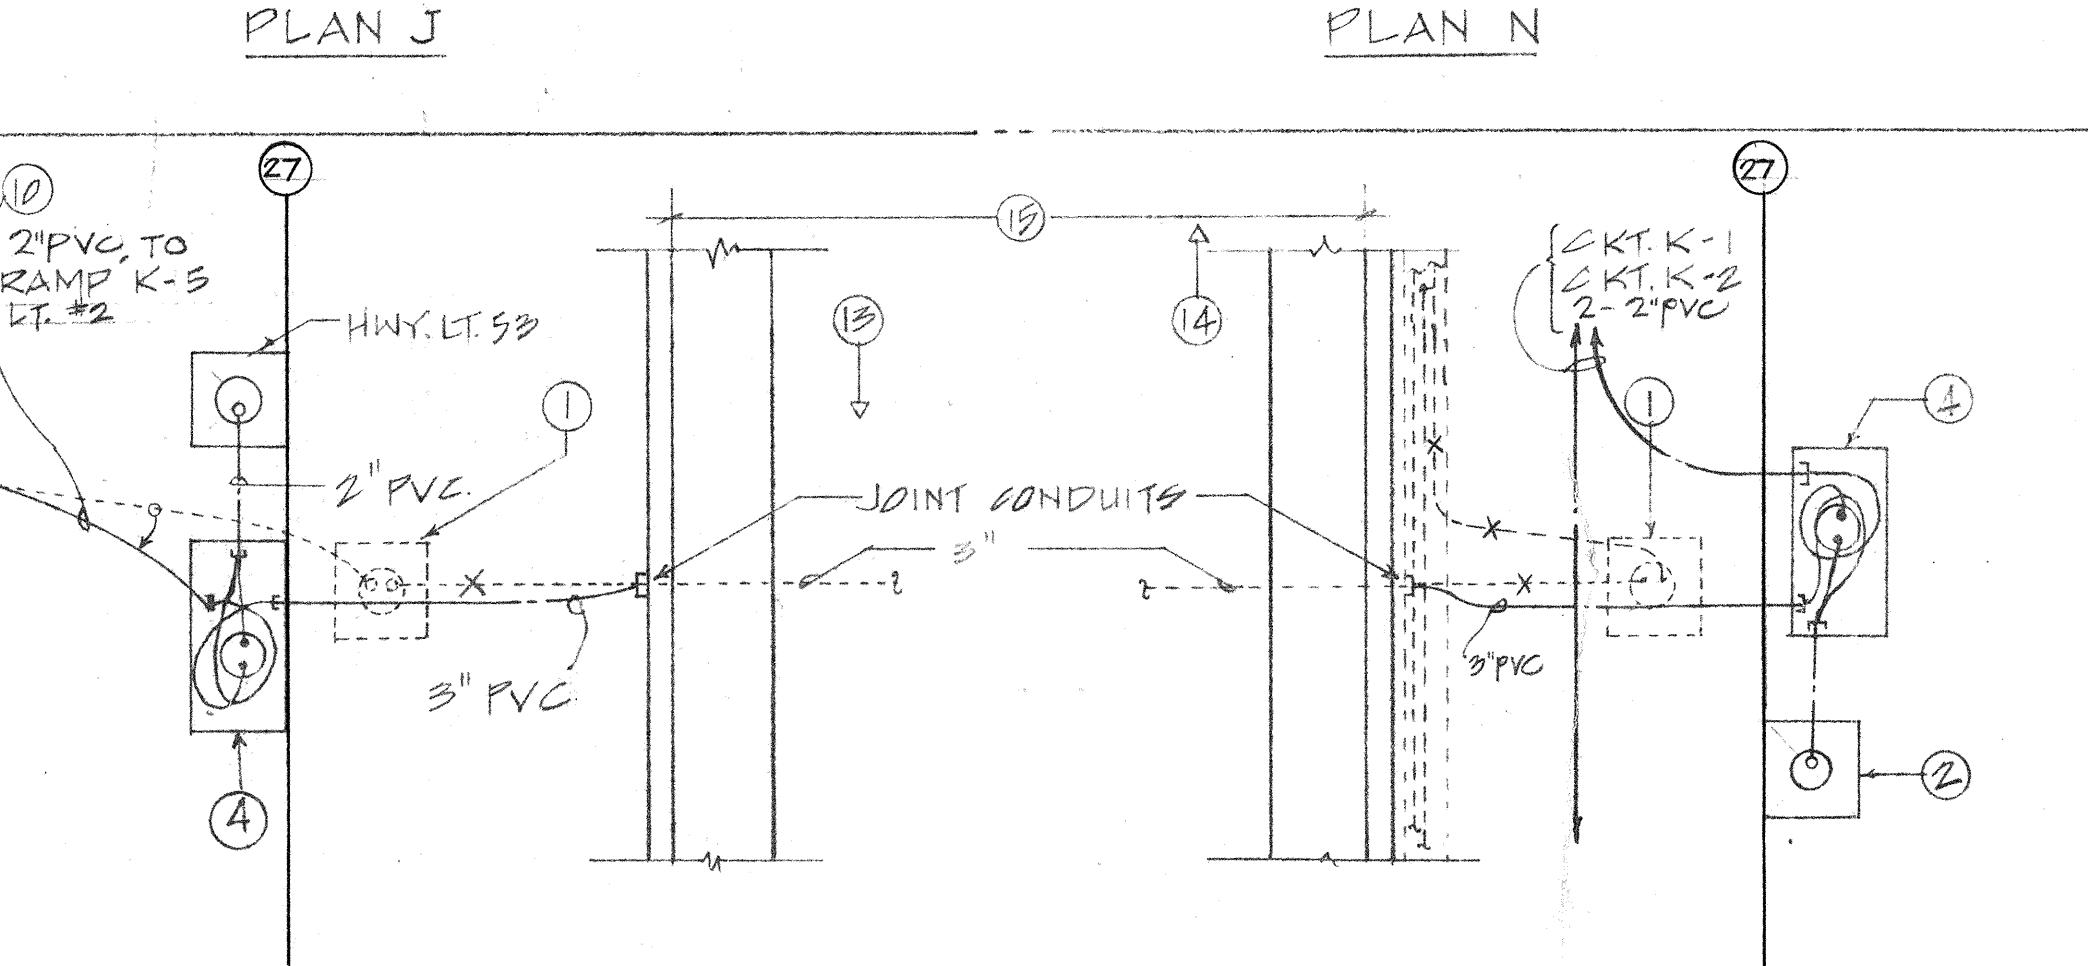


PLAN K

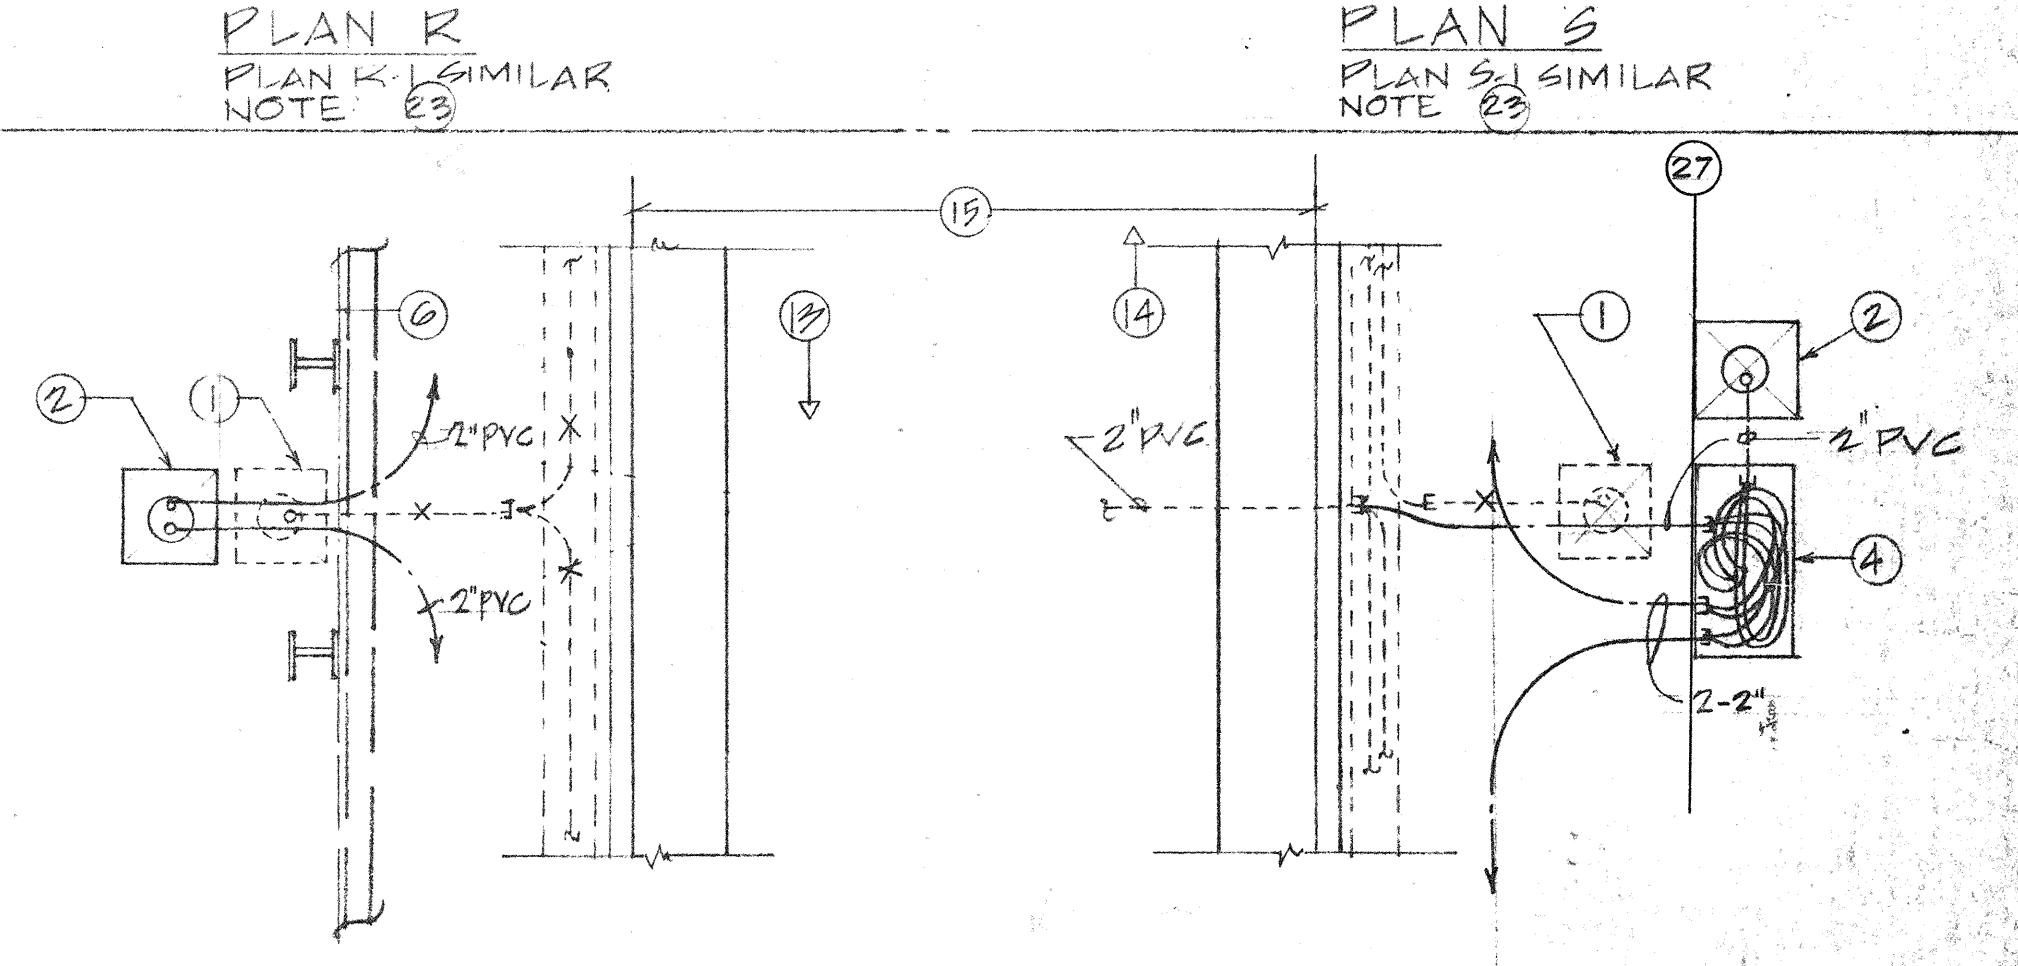


PLAN S
PLAN S SIMILAR
NOTE: 23

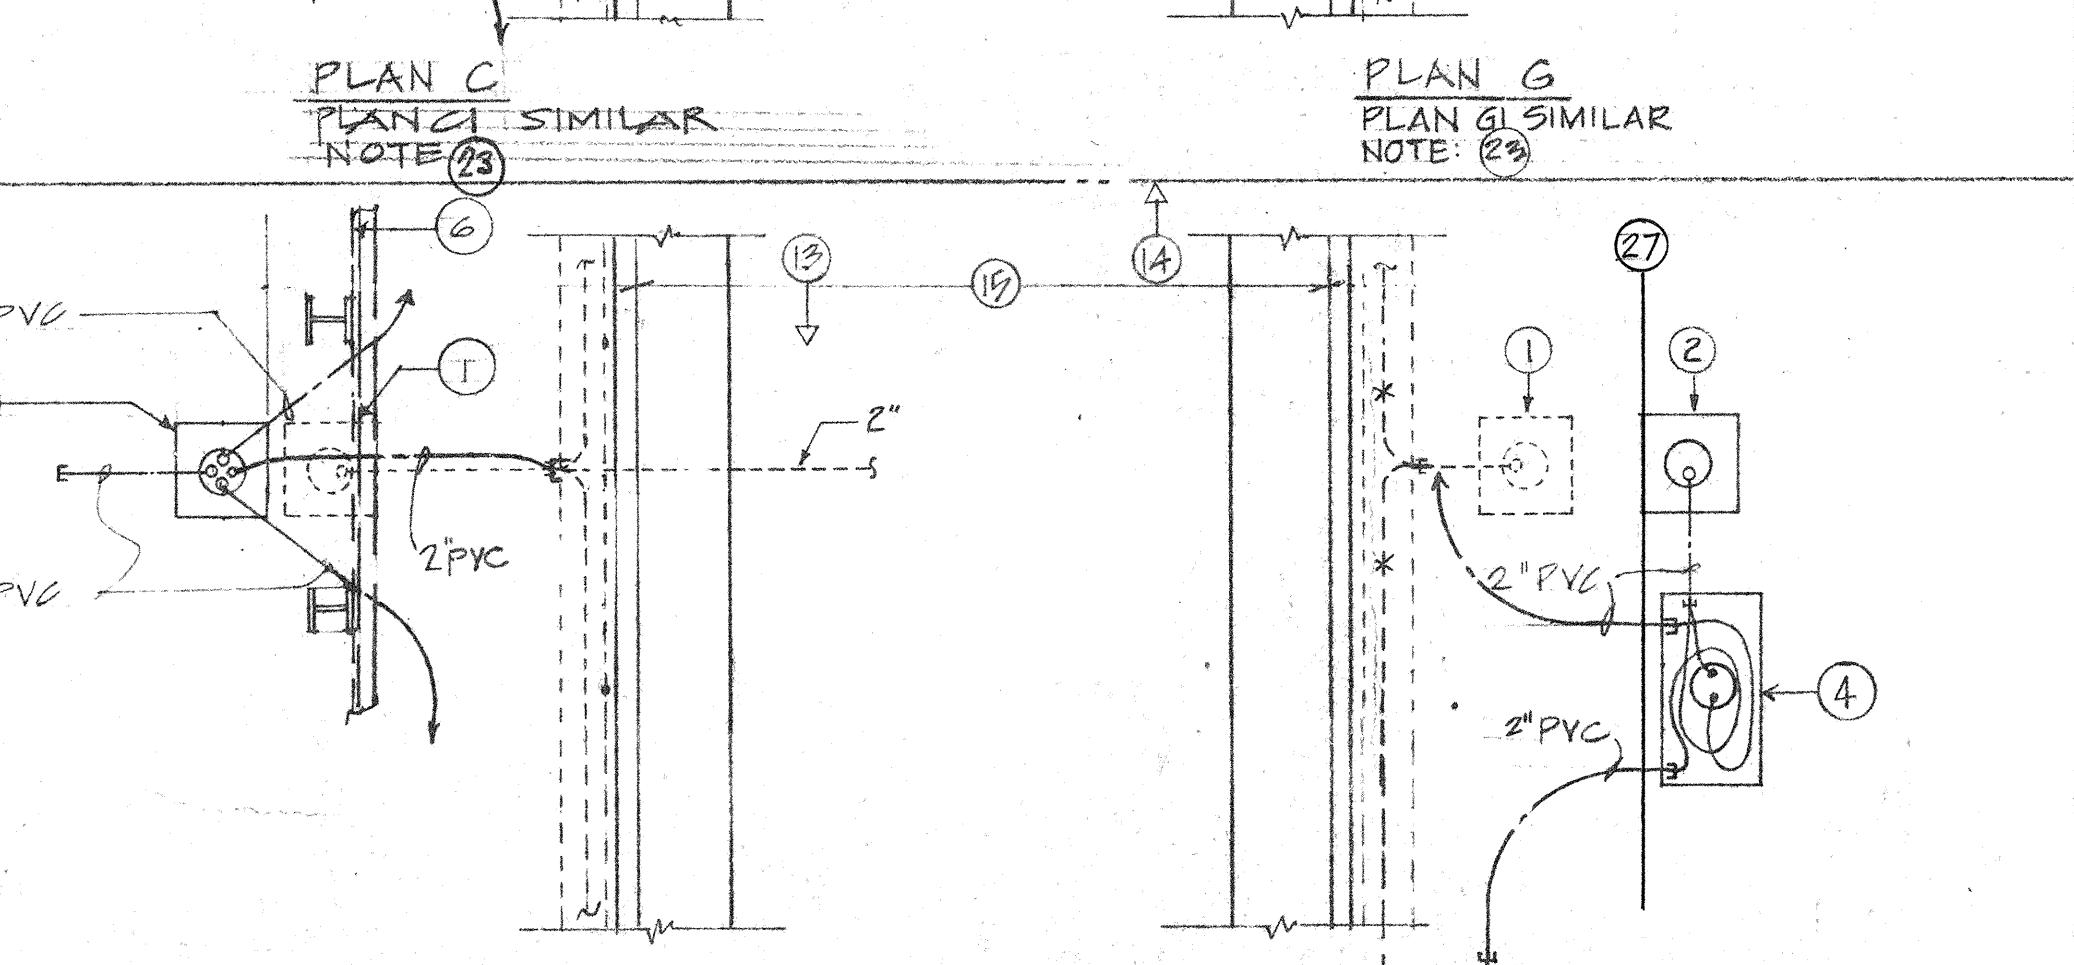

PLAN D
PLAN D SIMILAR
NOTE: 23

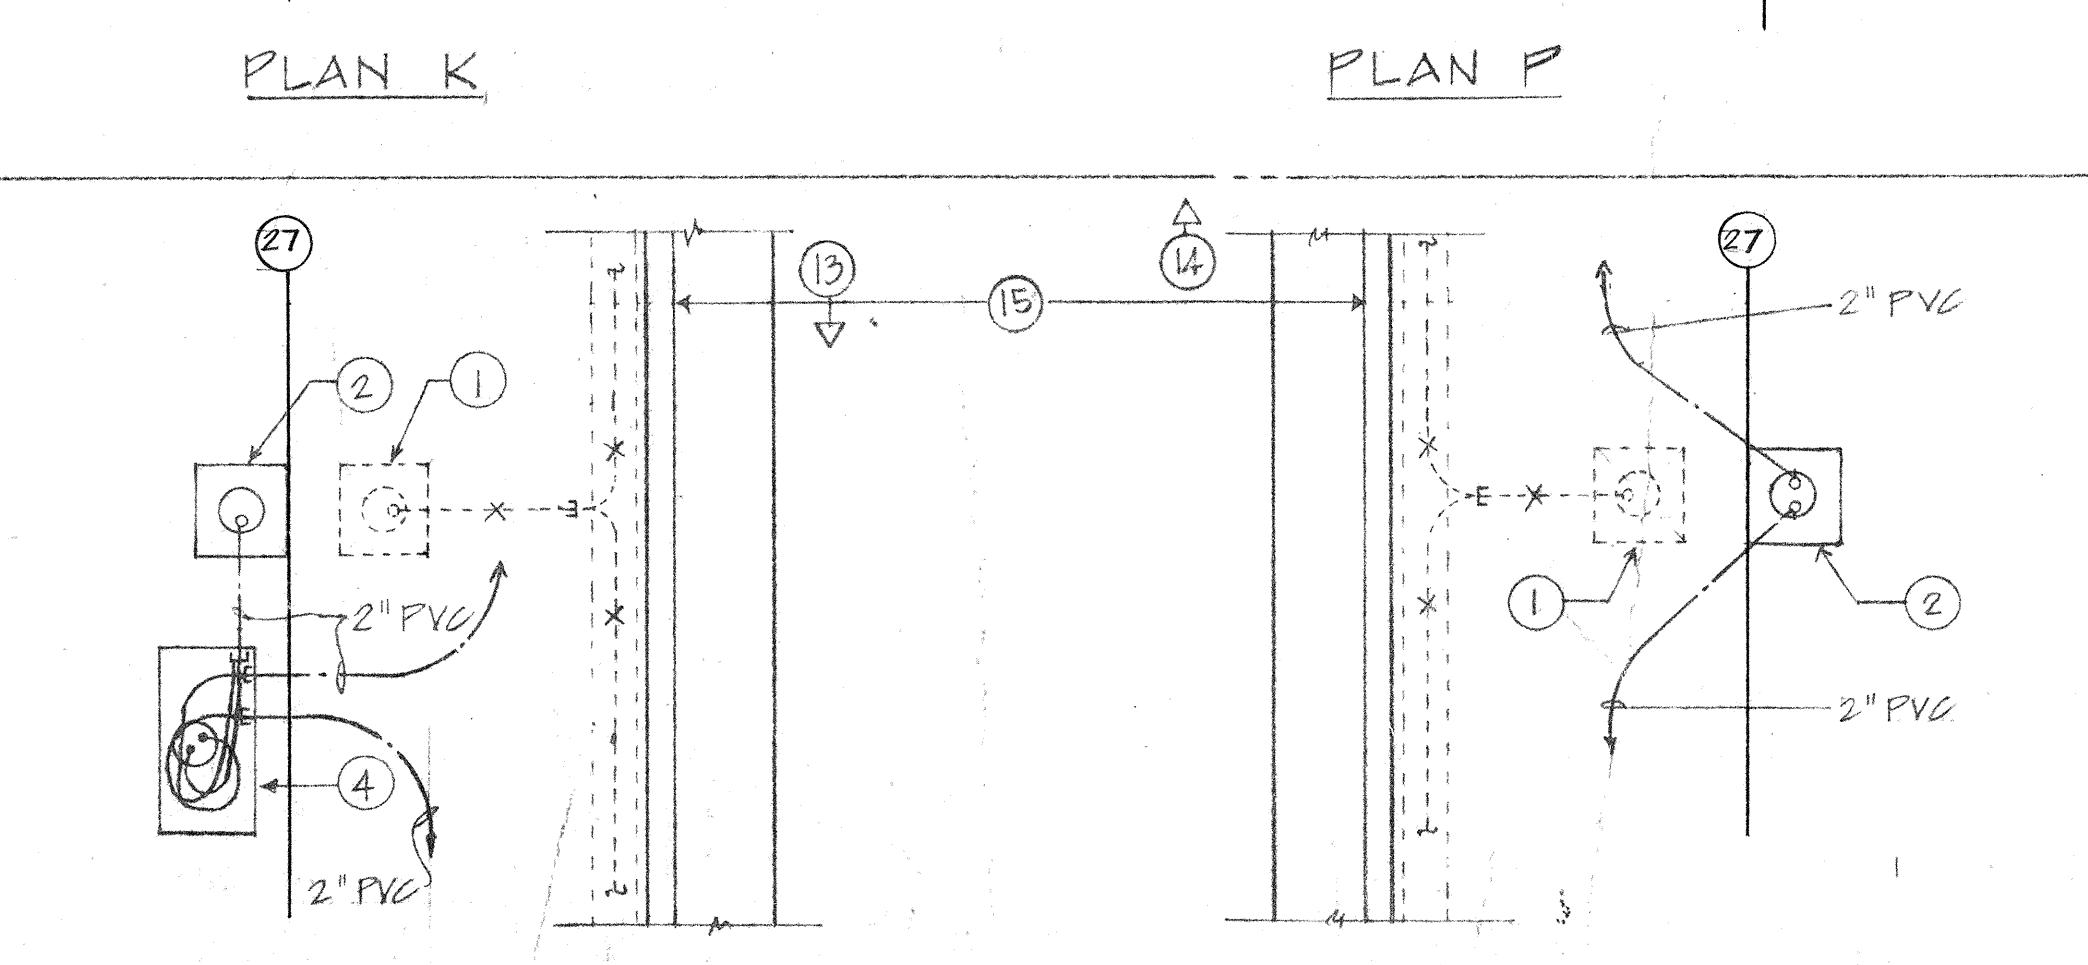

PLAN H


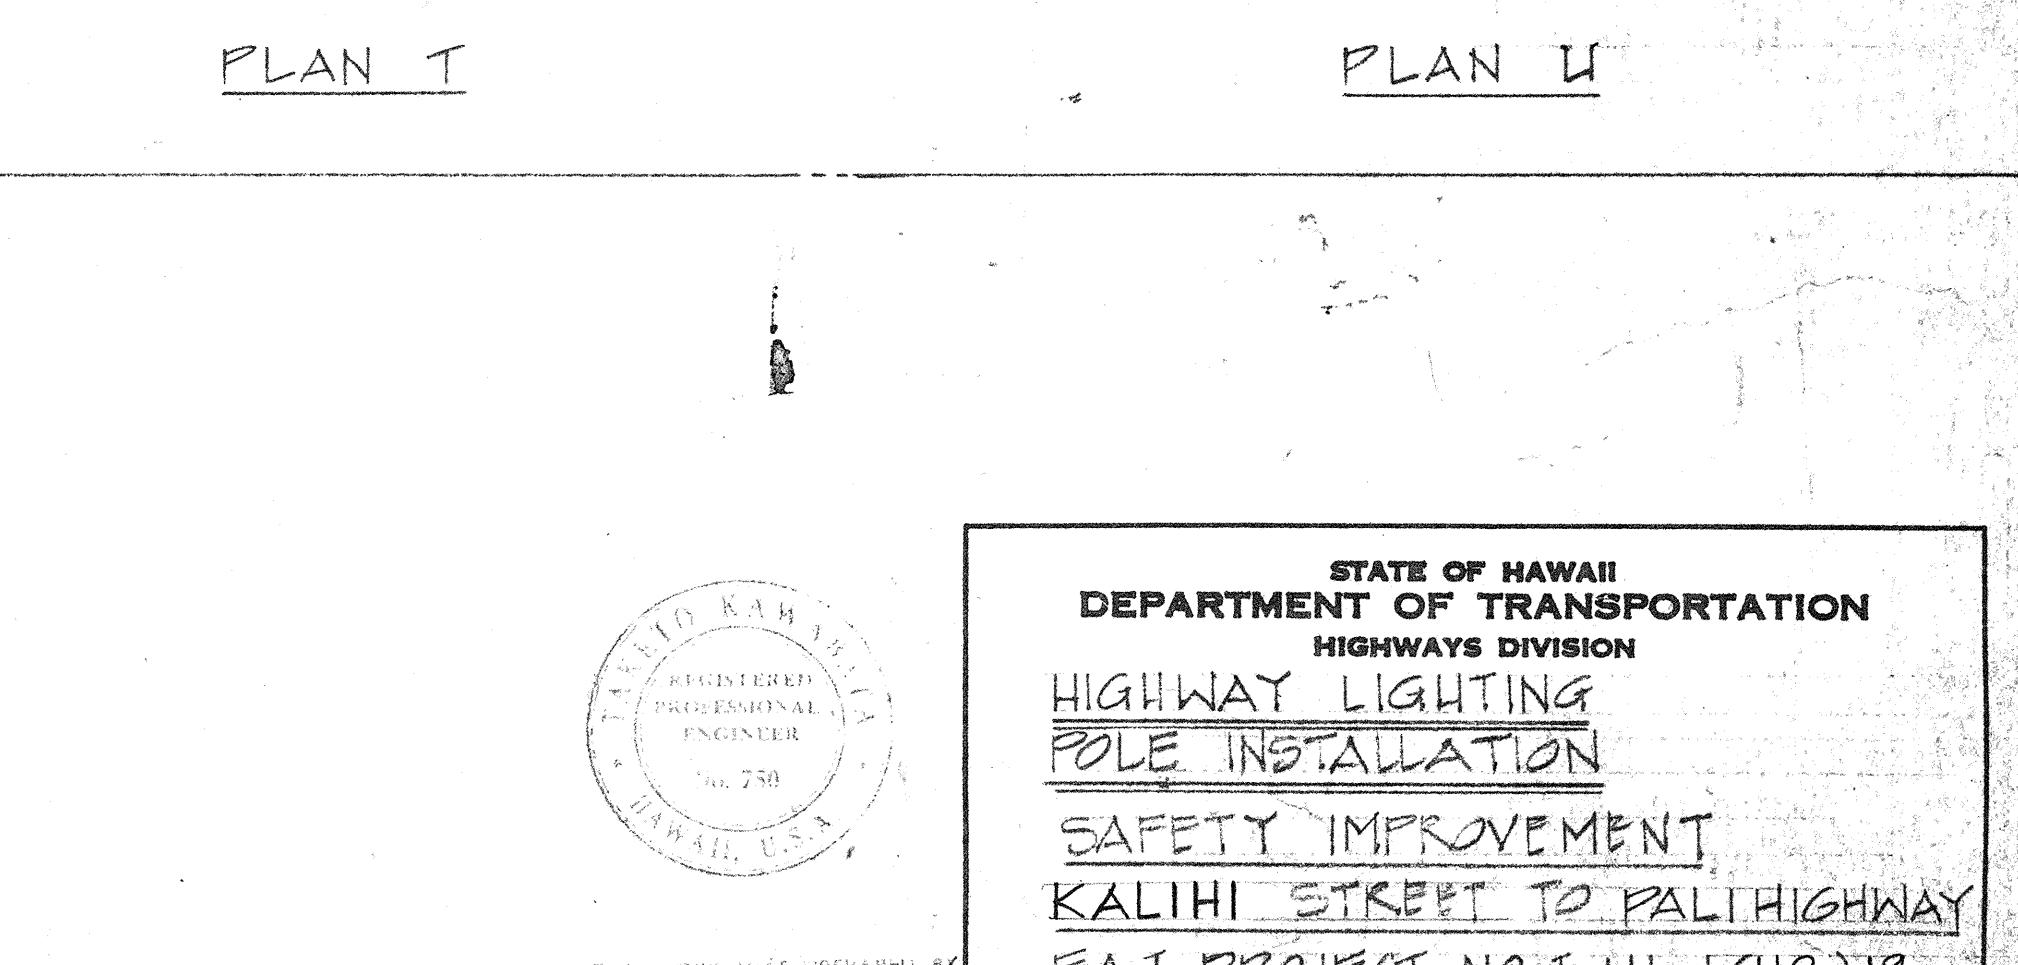


PLAN L
PLAN L SIMILAR
NOTE: 23

PLAN Q
PLAN Q SIMILAR
NOTE: 23

ORIGINAL	DRAWN BY
STAMPED	TRACED BY
DRAWN	DESIGNED BY
BOOK	QUANTITIES BY
No.	CHECKED BY

PRINTED ON NO. 1000 CLEARPRINT

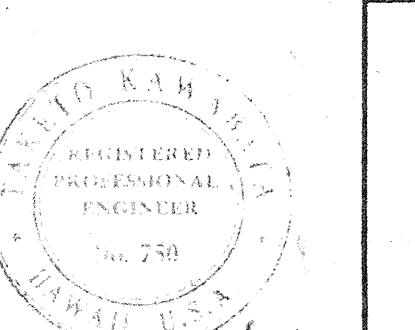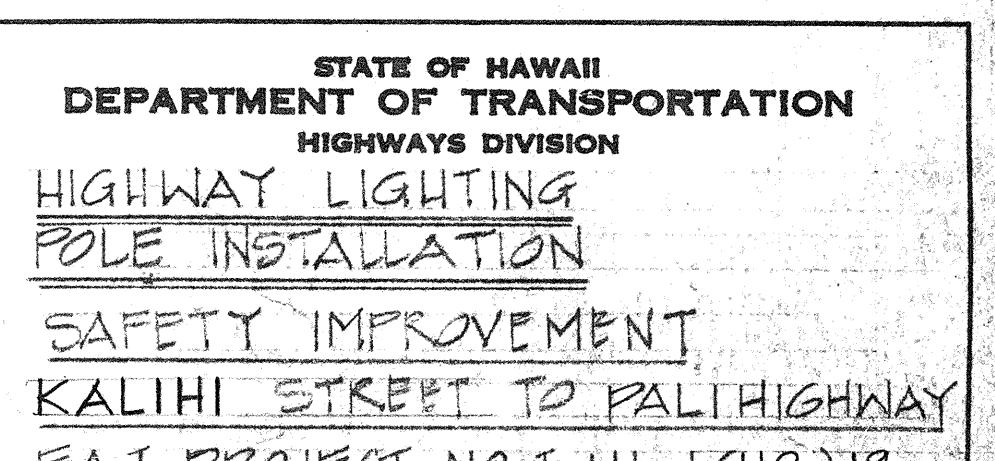

This work was prepared by
me or under my supervision

Taketa Kanahata

DATE: APR 1 1973


SHEET NO. 81 OF 181 SHEETS

118

FED. ROAD DIST. NO.	STATE	FED. AID PROJ. NO.	FISCAL YEAR	SHEET NO.	TOTAL SHEETS
HAWAII	HAW.	I-HI-1(12)19	1973	110	176

NOTES:

1. (1) INDICATES - NOTE # 1, FOR NOTE REFERENCES SEE SHT. 7L..
 2. CENTER LINE OF LT. STD. 3'-0" MIN. FROM ANY JTS. & TO BE PLACED AT $\frac{1}{2}$ OF EXIST. INTERM. RAIL POST. POSTS AT APPROX. STA. SHOWN ON HWY. LTG. PLAN.
 3. EXST. STRUC., LIMITS OF REMOVAL OF EXST. CONC. WALL SHOWN HATCHED AREA. REMOVE CONC. ONLY. ALL EXST. EXPOSED REINF. TO REMAIN & CLEANED. EXST. REINF. NOT SHOWN IN DETAILS.
 4. EXST. STRUC., SAW CUT TOP & BOTH FACES OF EXST. WALL IN A STRAIGHT & CLEAN LINE TO THE PLANE OF THE OUTER EDGE OF THE REINF..
 5. RET. B/G/L APPLICABLE HWY. LTG. POLE NOS. 117, 119, 121, 123.
 6. REMOVE & RELOCATE EXIST. INTERM. RAIL POST AS SHOWN IN DETAIL (B).

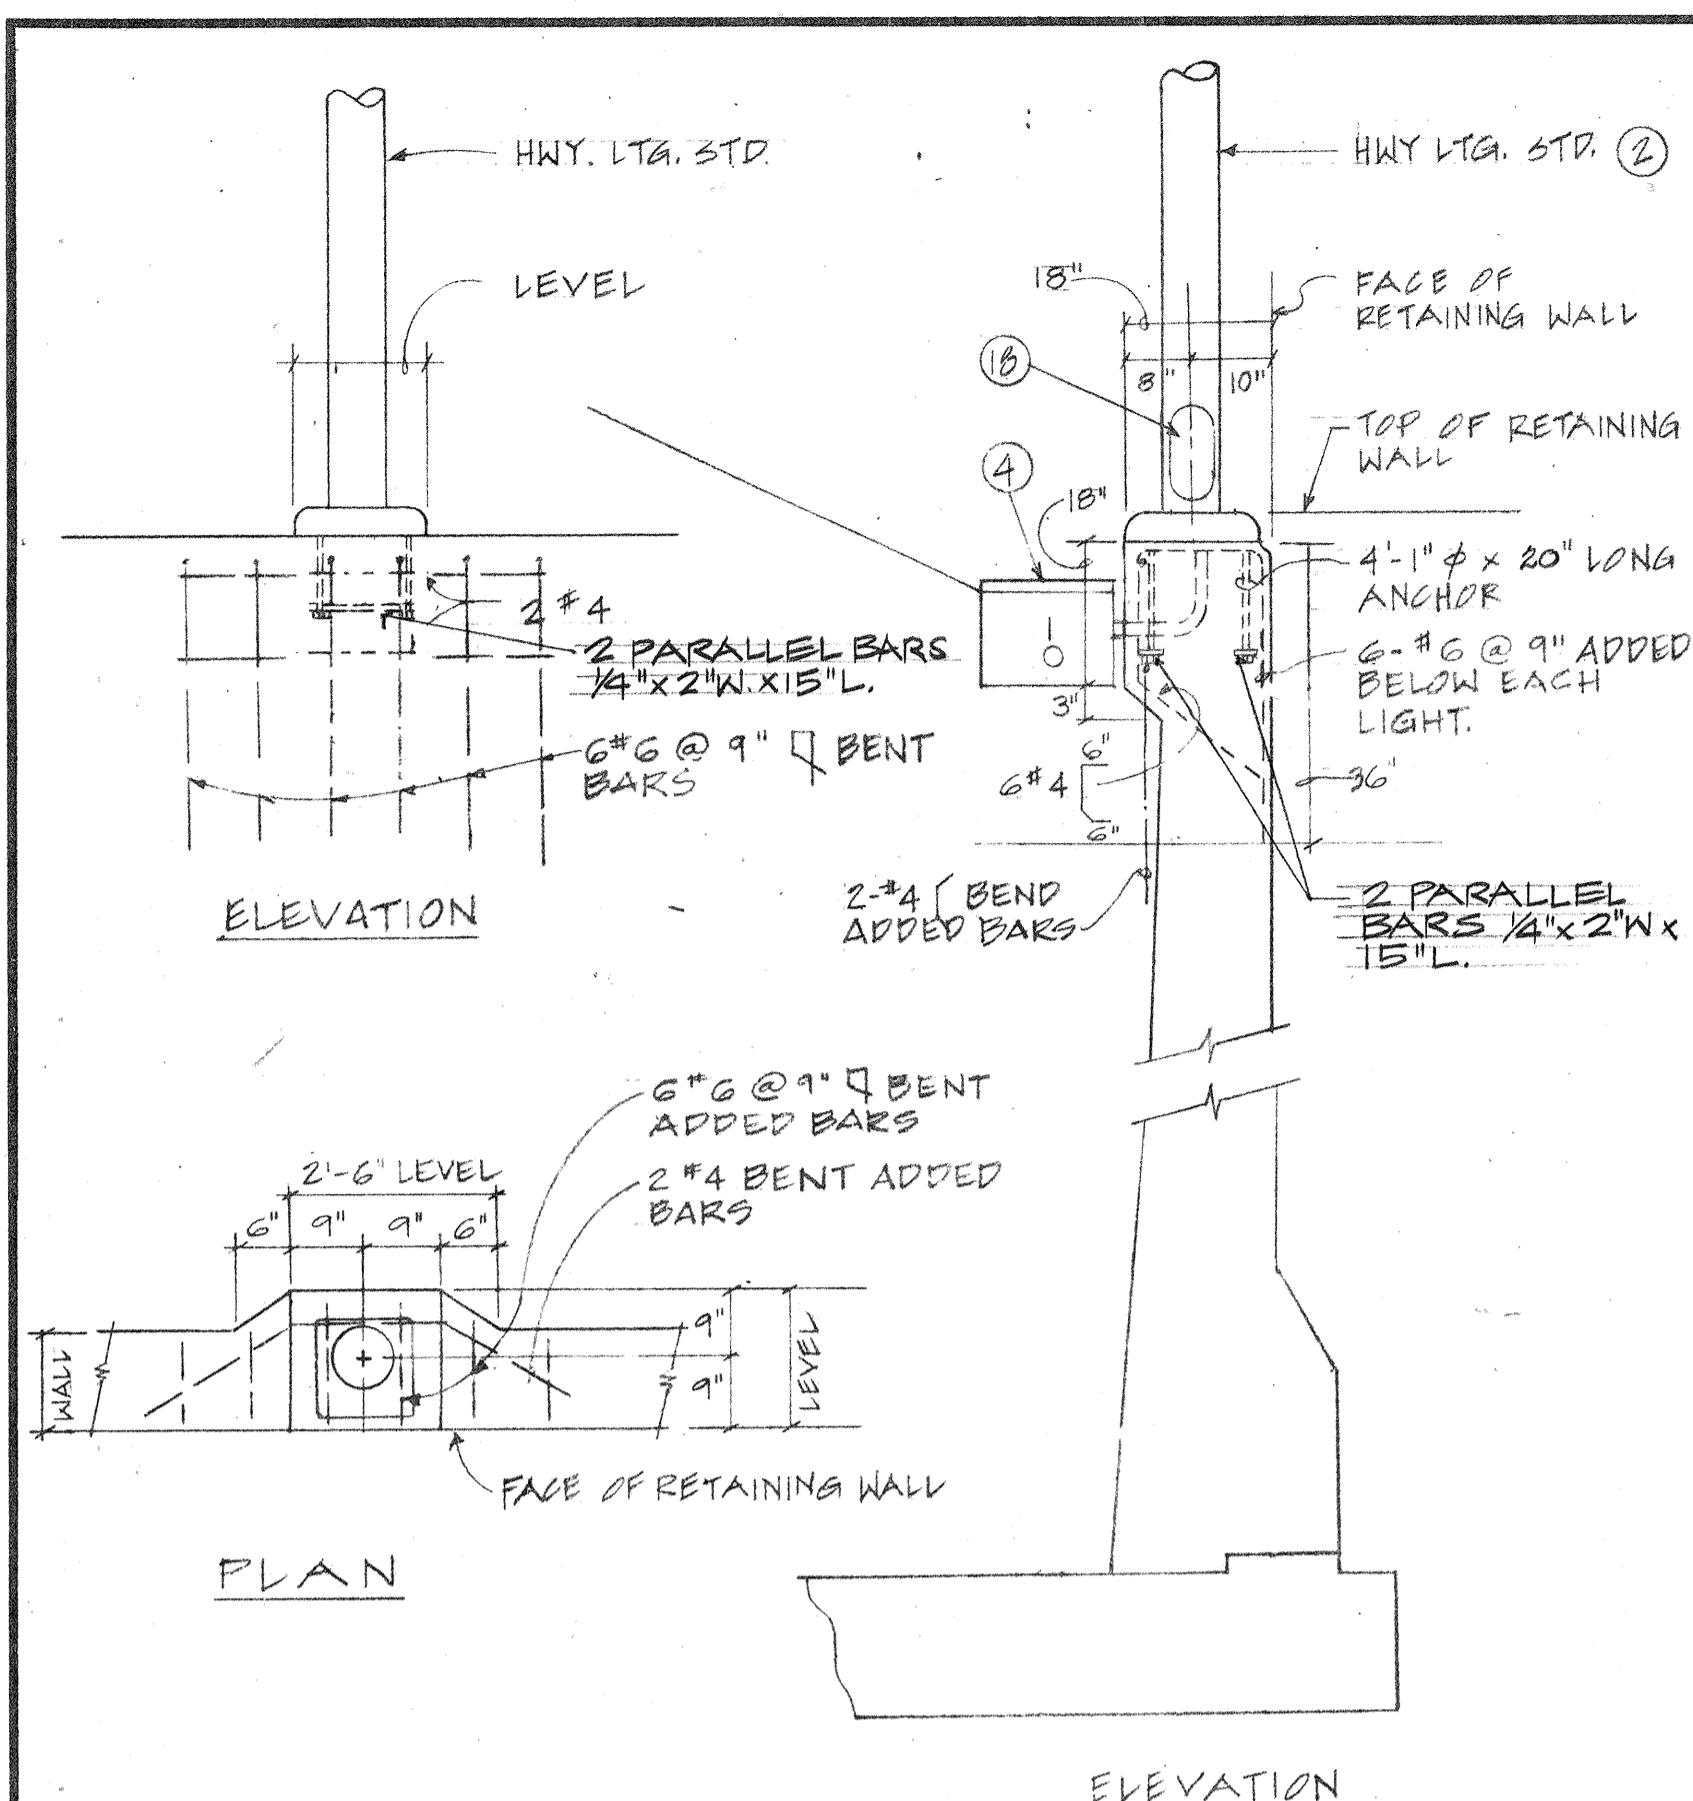


NOTE

Concrete and Reinf. Steel for rebuilt wall section will be paid under "Concrete other than in Bridges" and "Reinf. Steel other than in Bridges" respectively.


A LIGHT STANDARD AT RETAINING WALL
SECTION "A-A" SEE NOTE #3

SCALE: 1/2" = 1'-0" SEE NOTE #

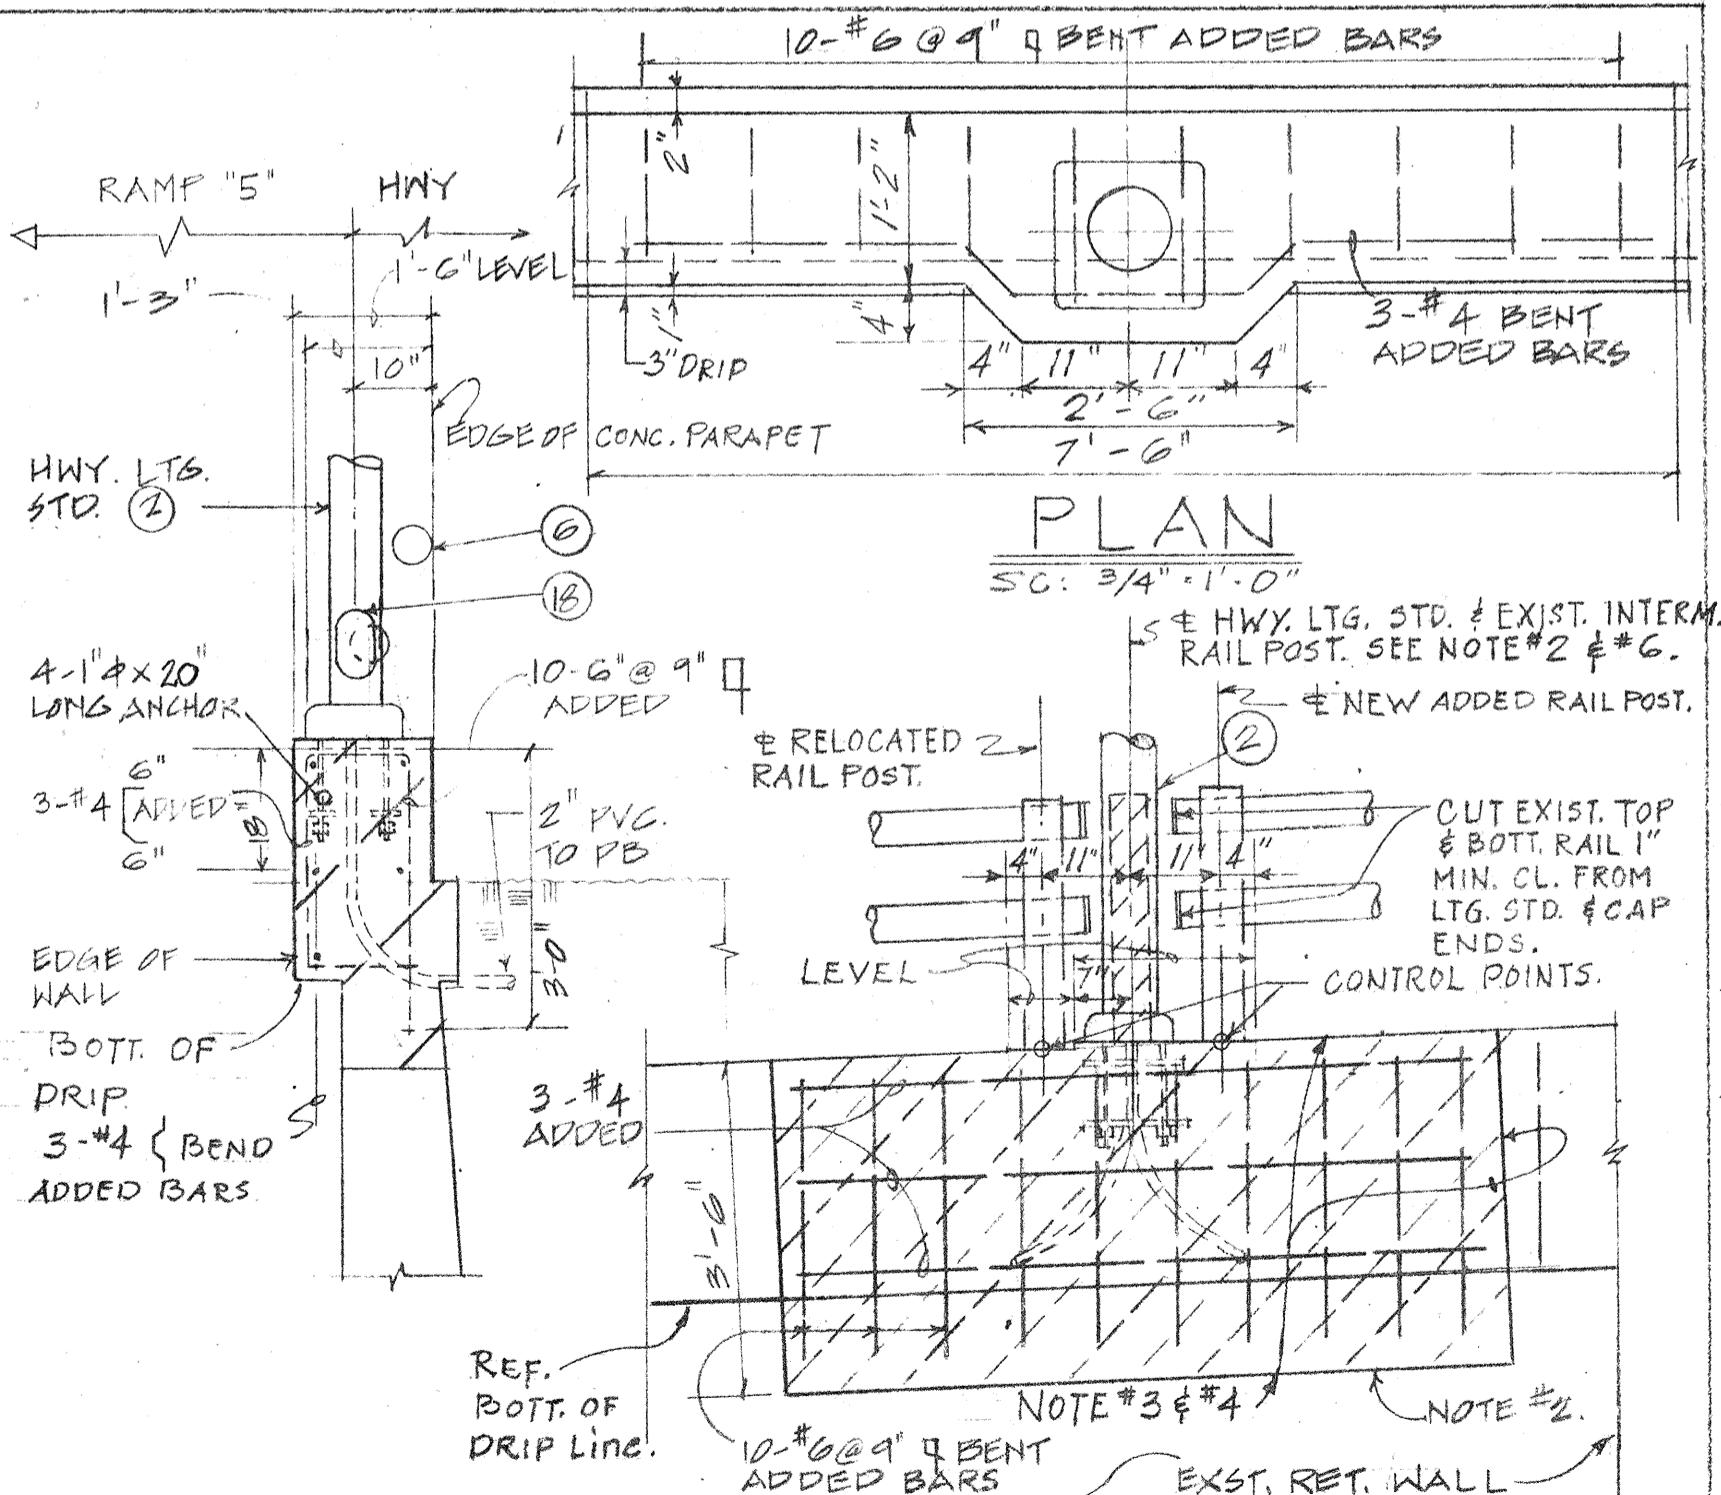


SECTION


SC. 1/2' = 1'-0" SC. 1/2' = 1'-0"
LIGHT STANDARD AT EXISTING STRUCTURE
SEE NCEC #5 SEE NOTE DETAIL A

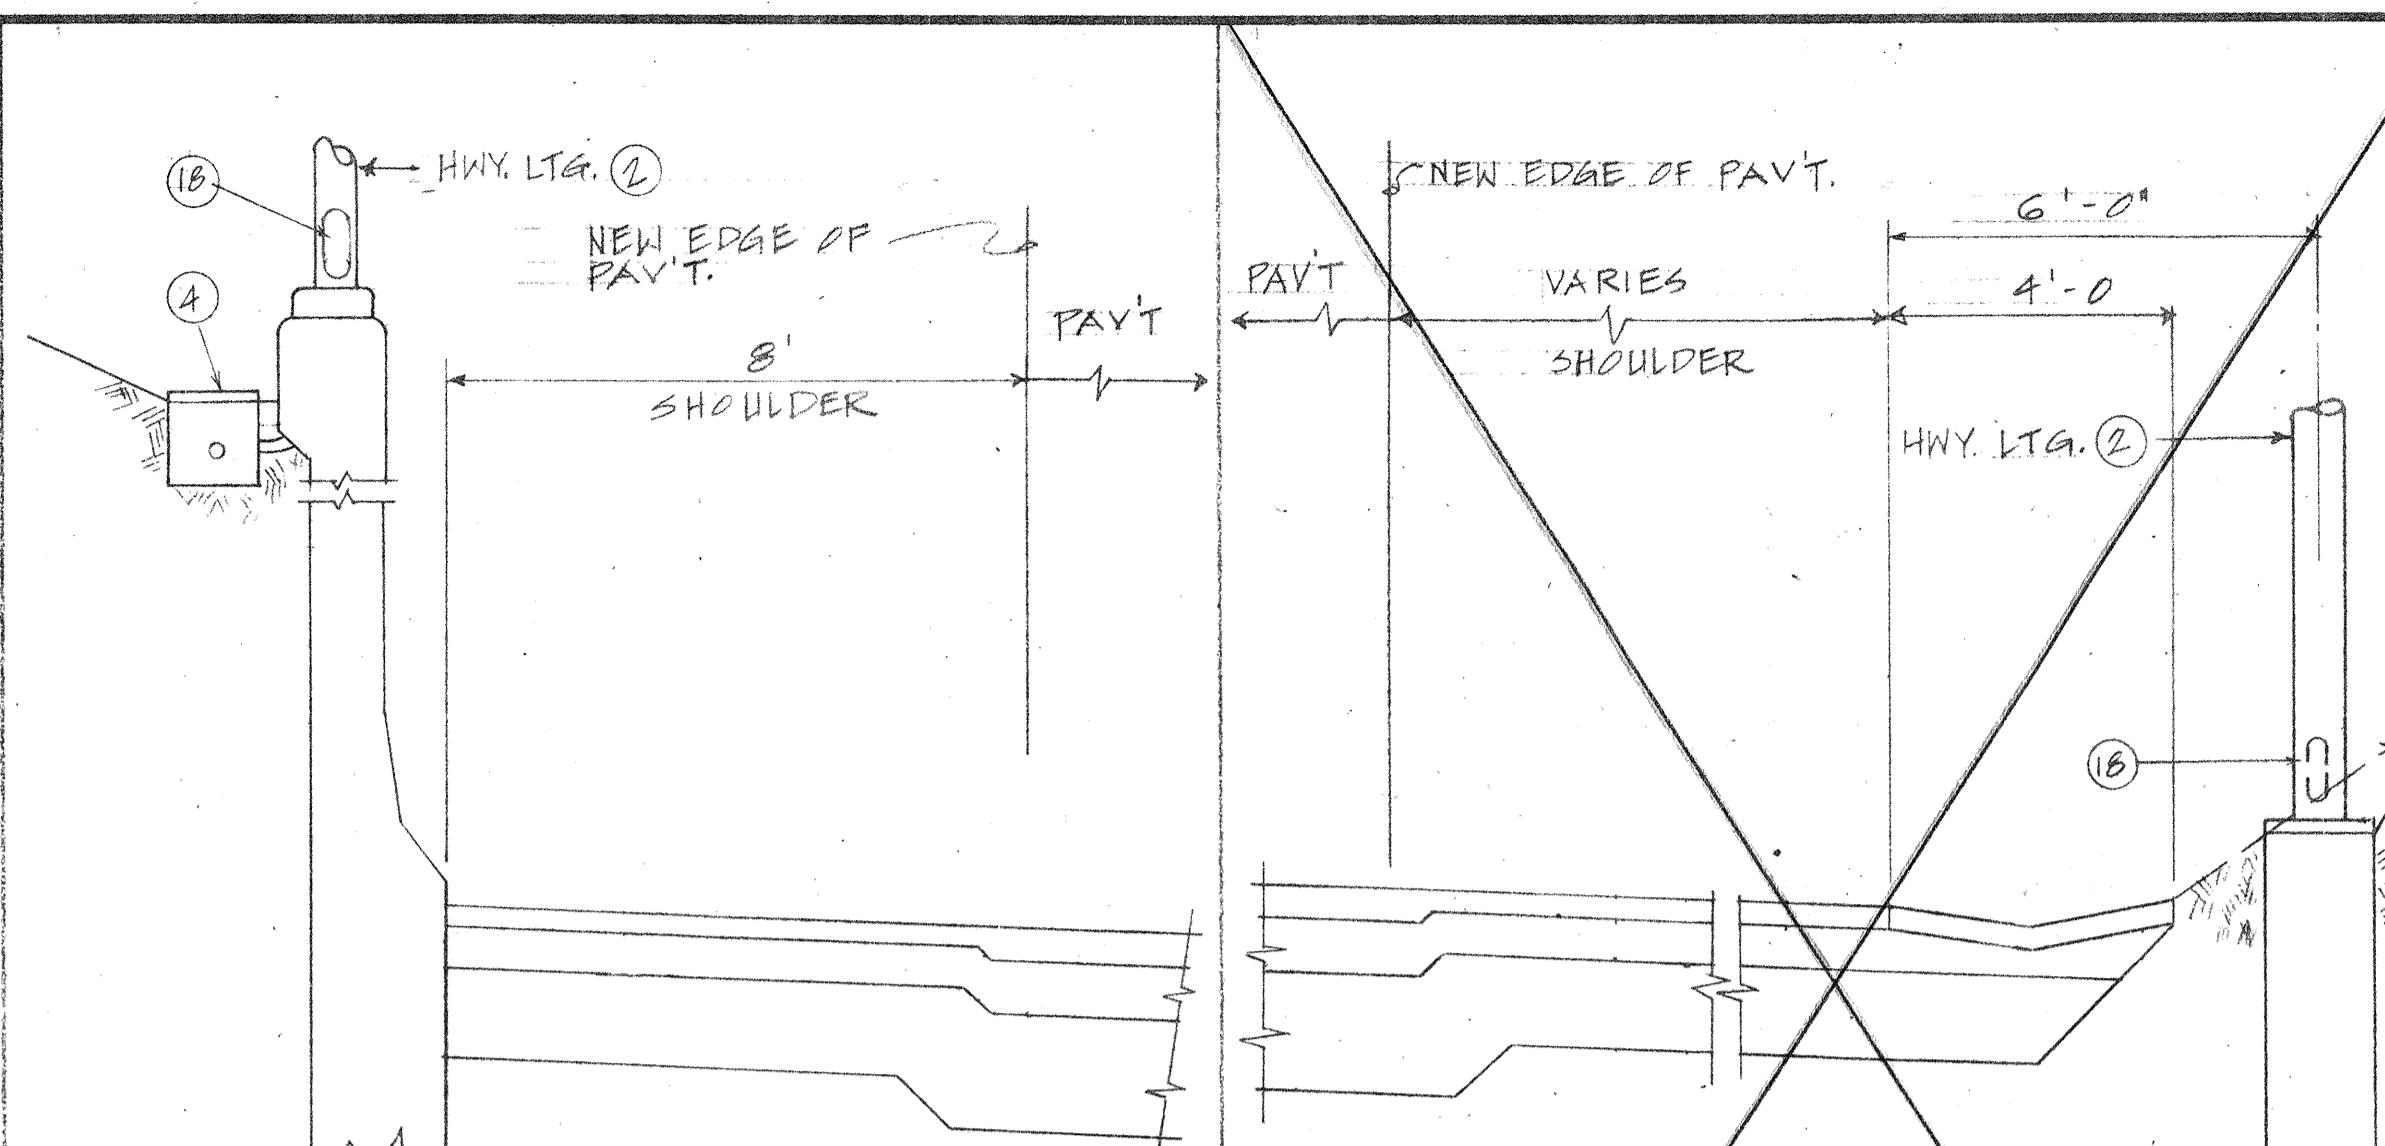


(C) RAMP K-1

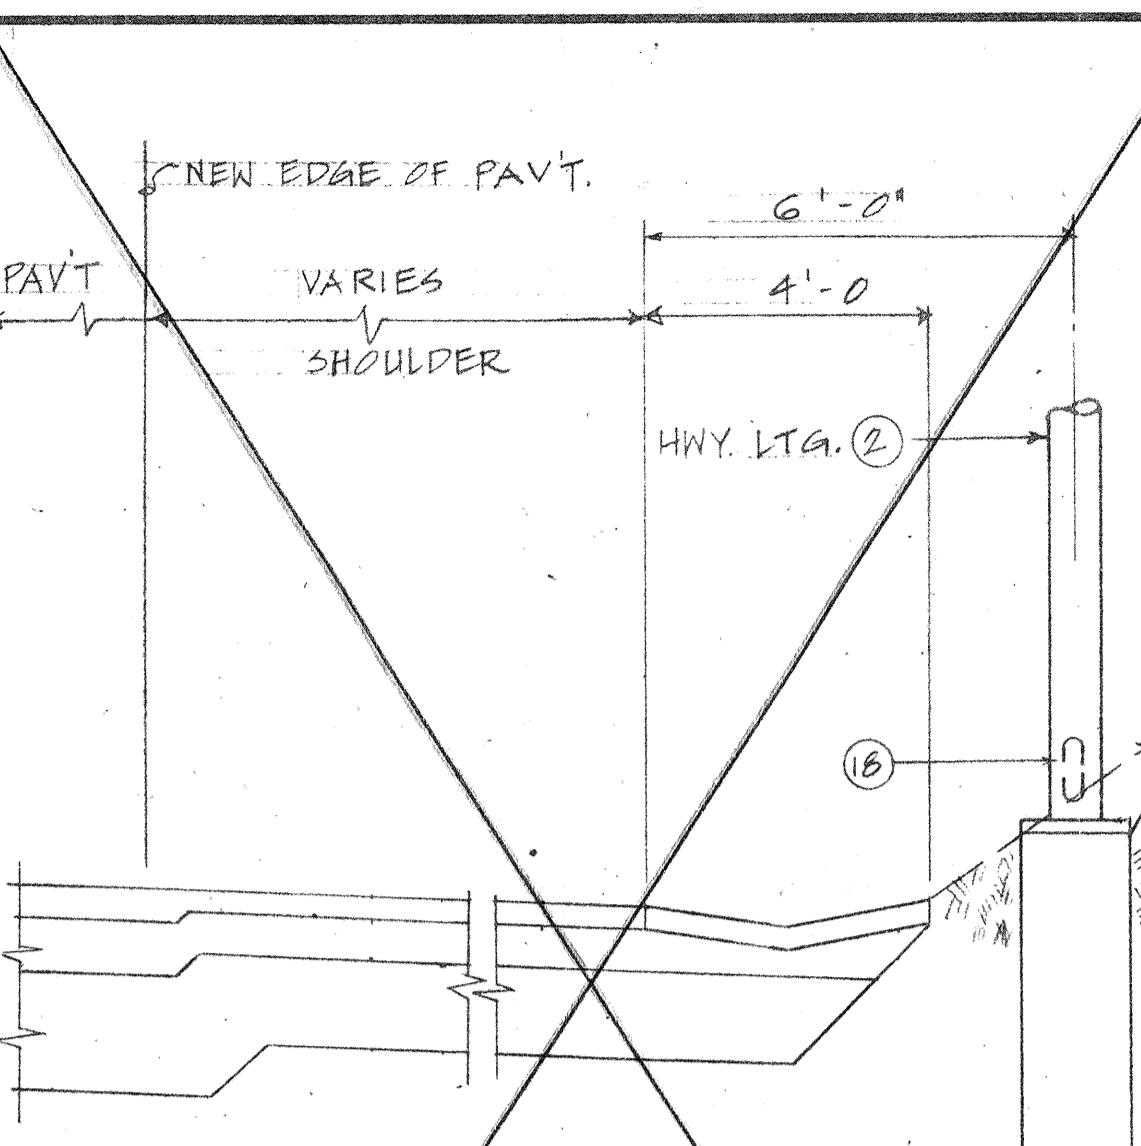


E RAMP M-3
STA. 20 + 50 TO 22 + 60

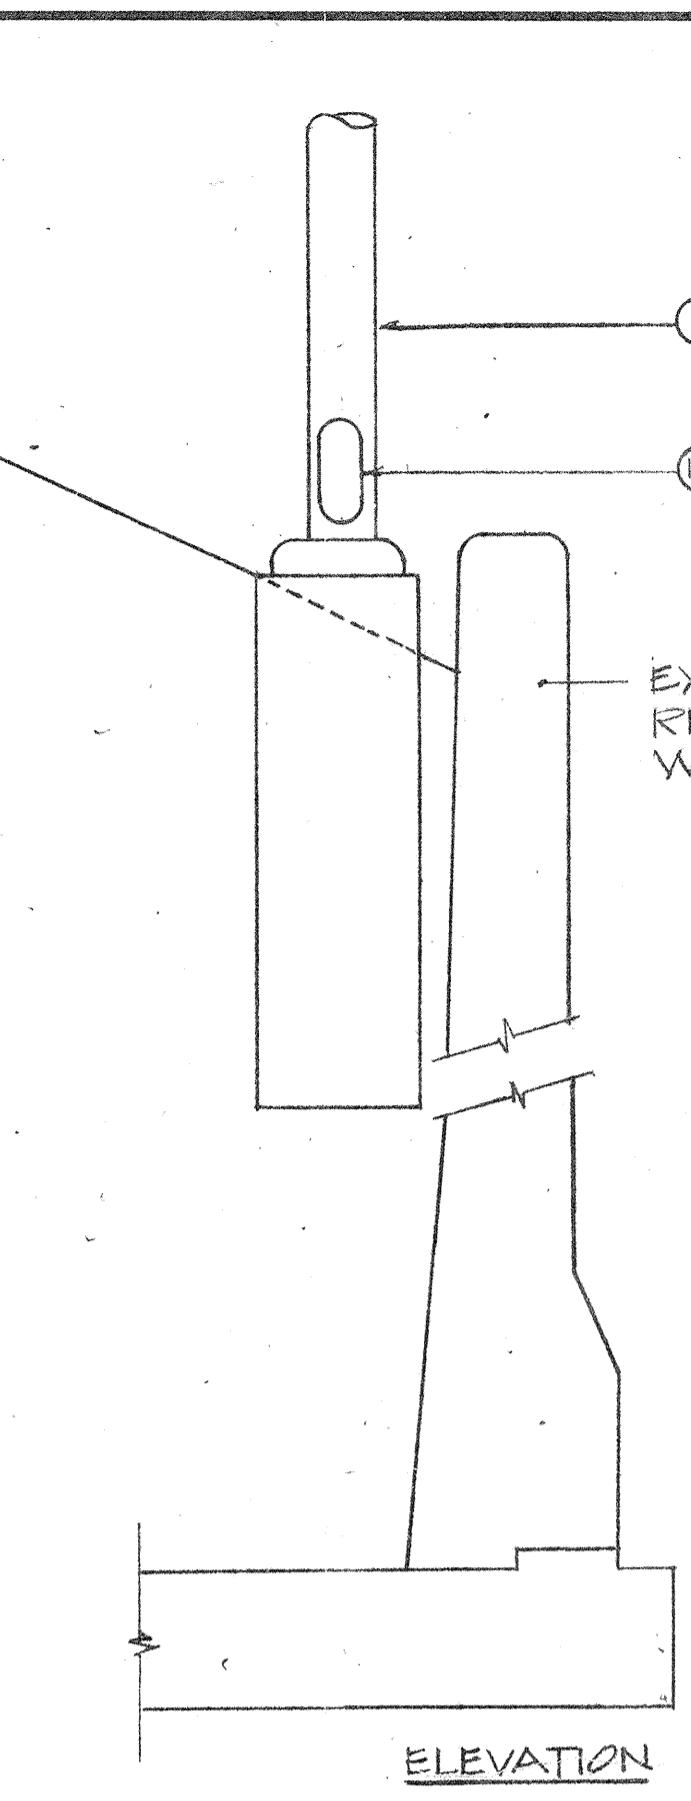

G LIGHT STANDARD BACK OF WALL

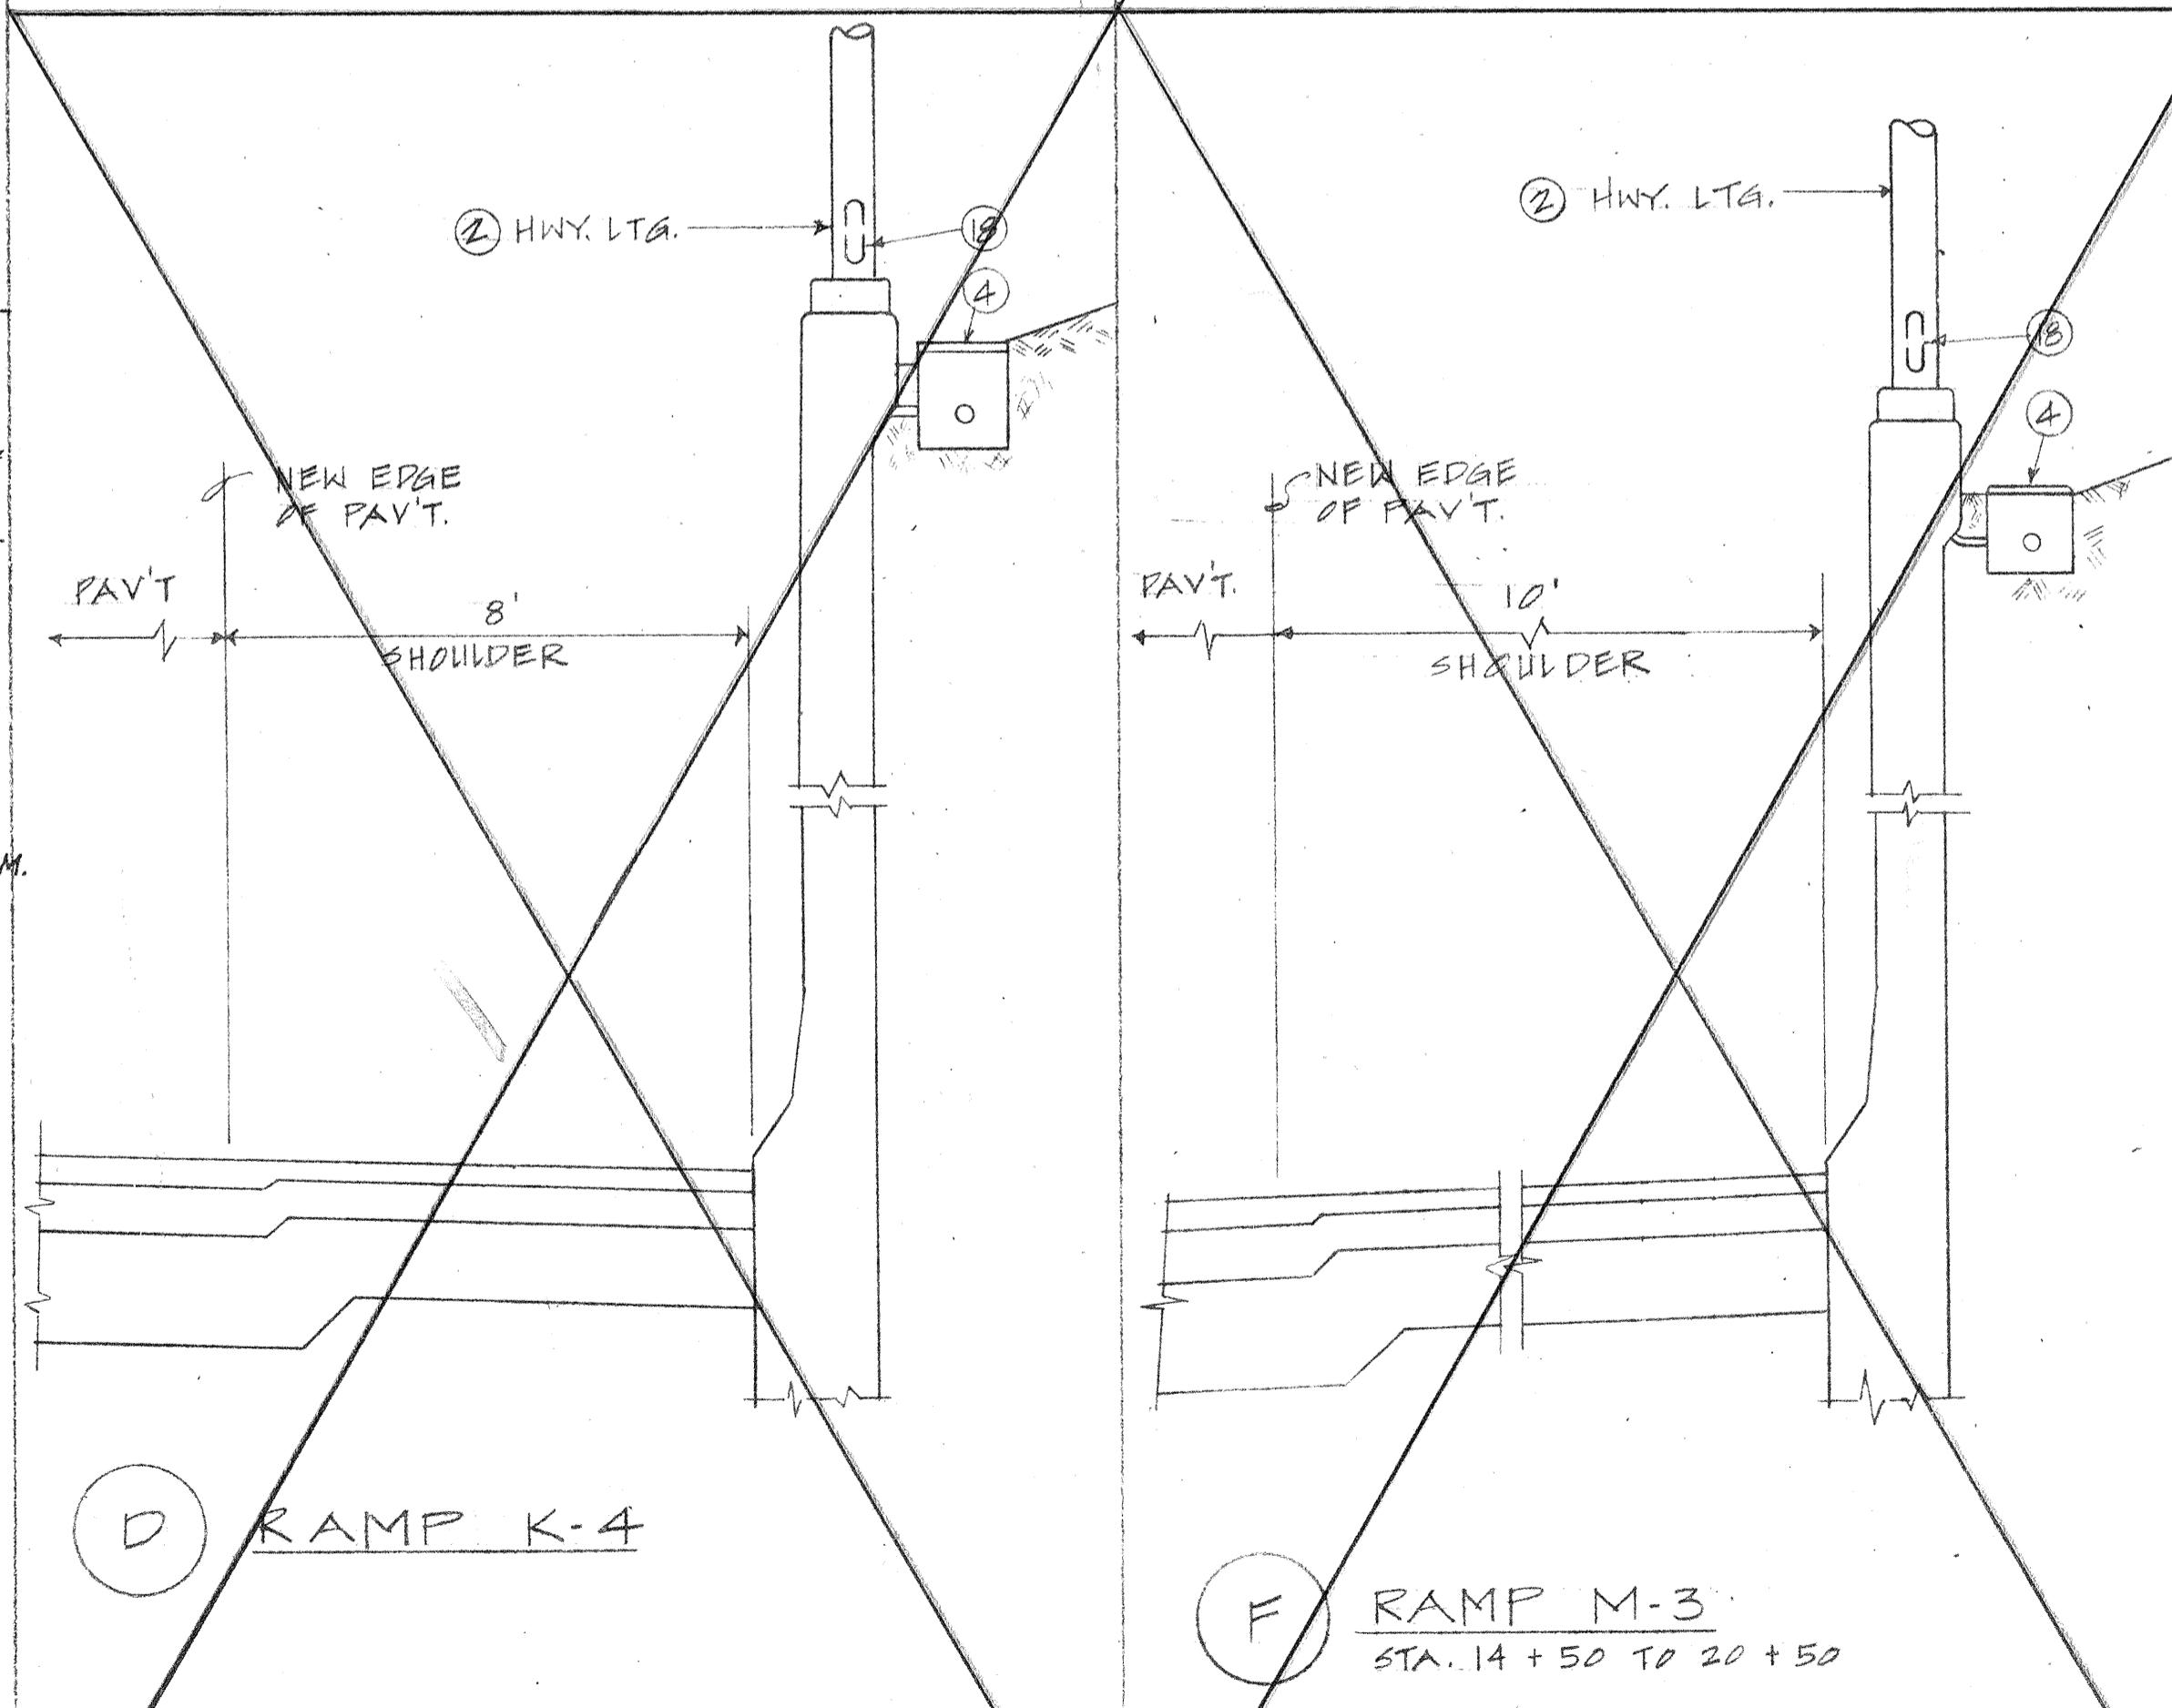

N.C.

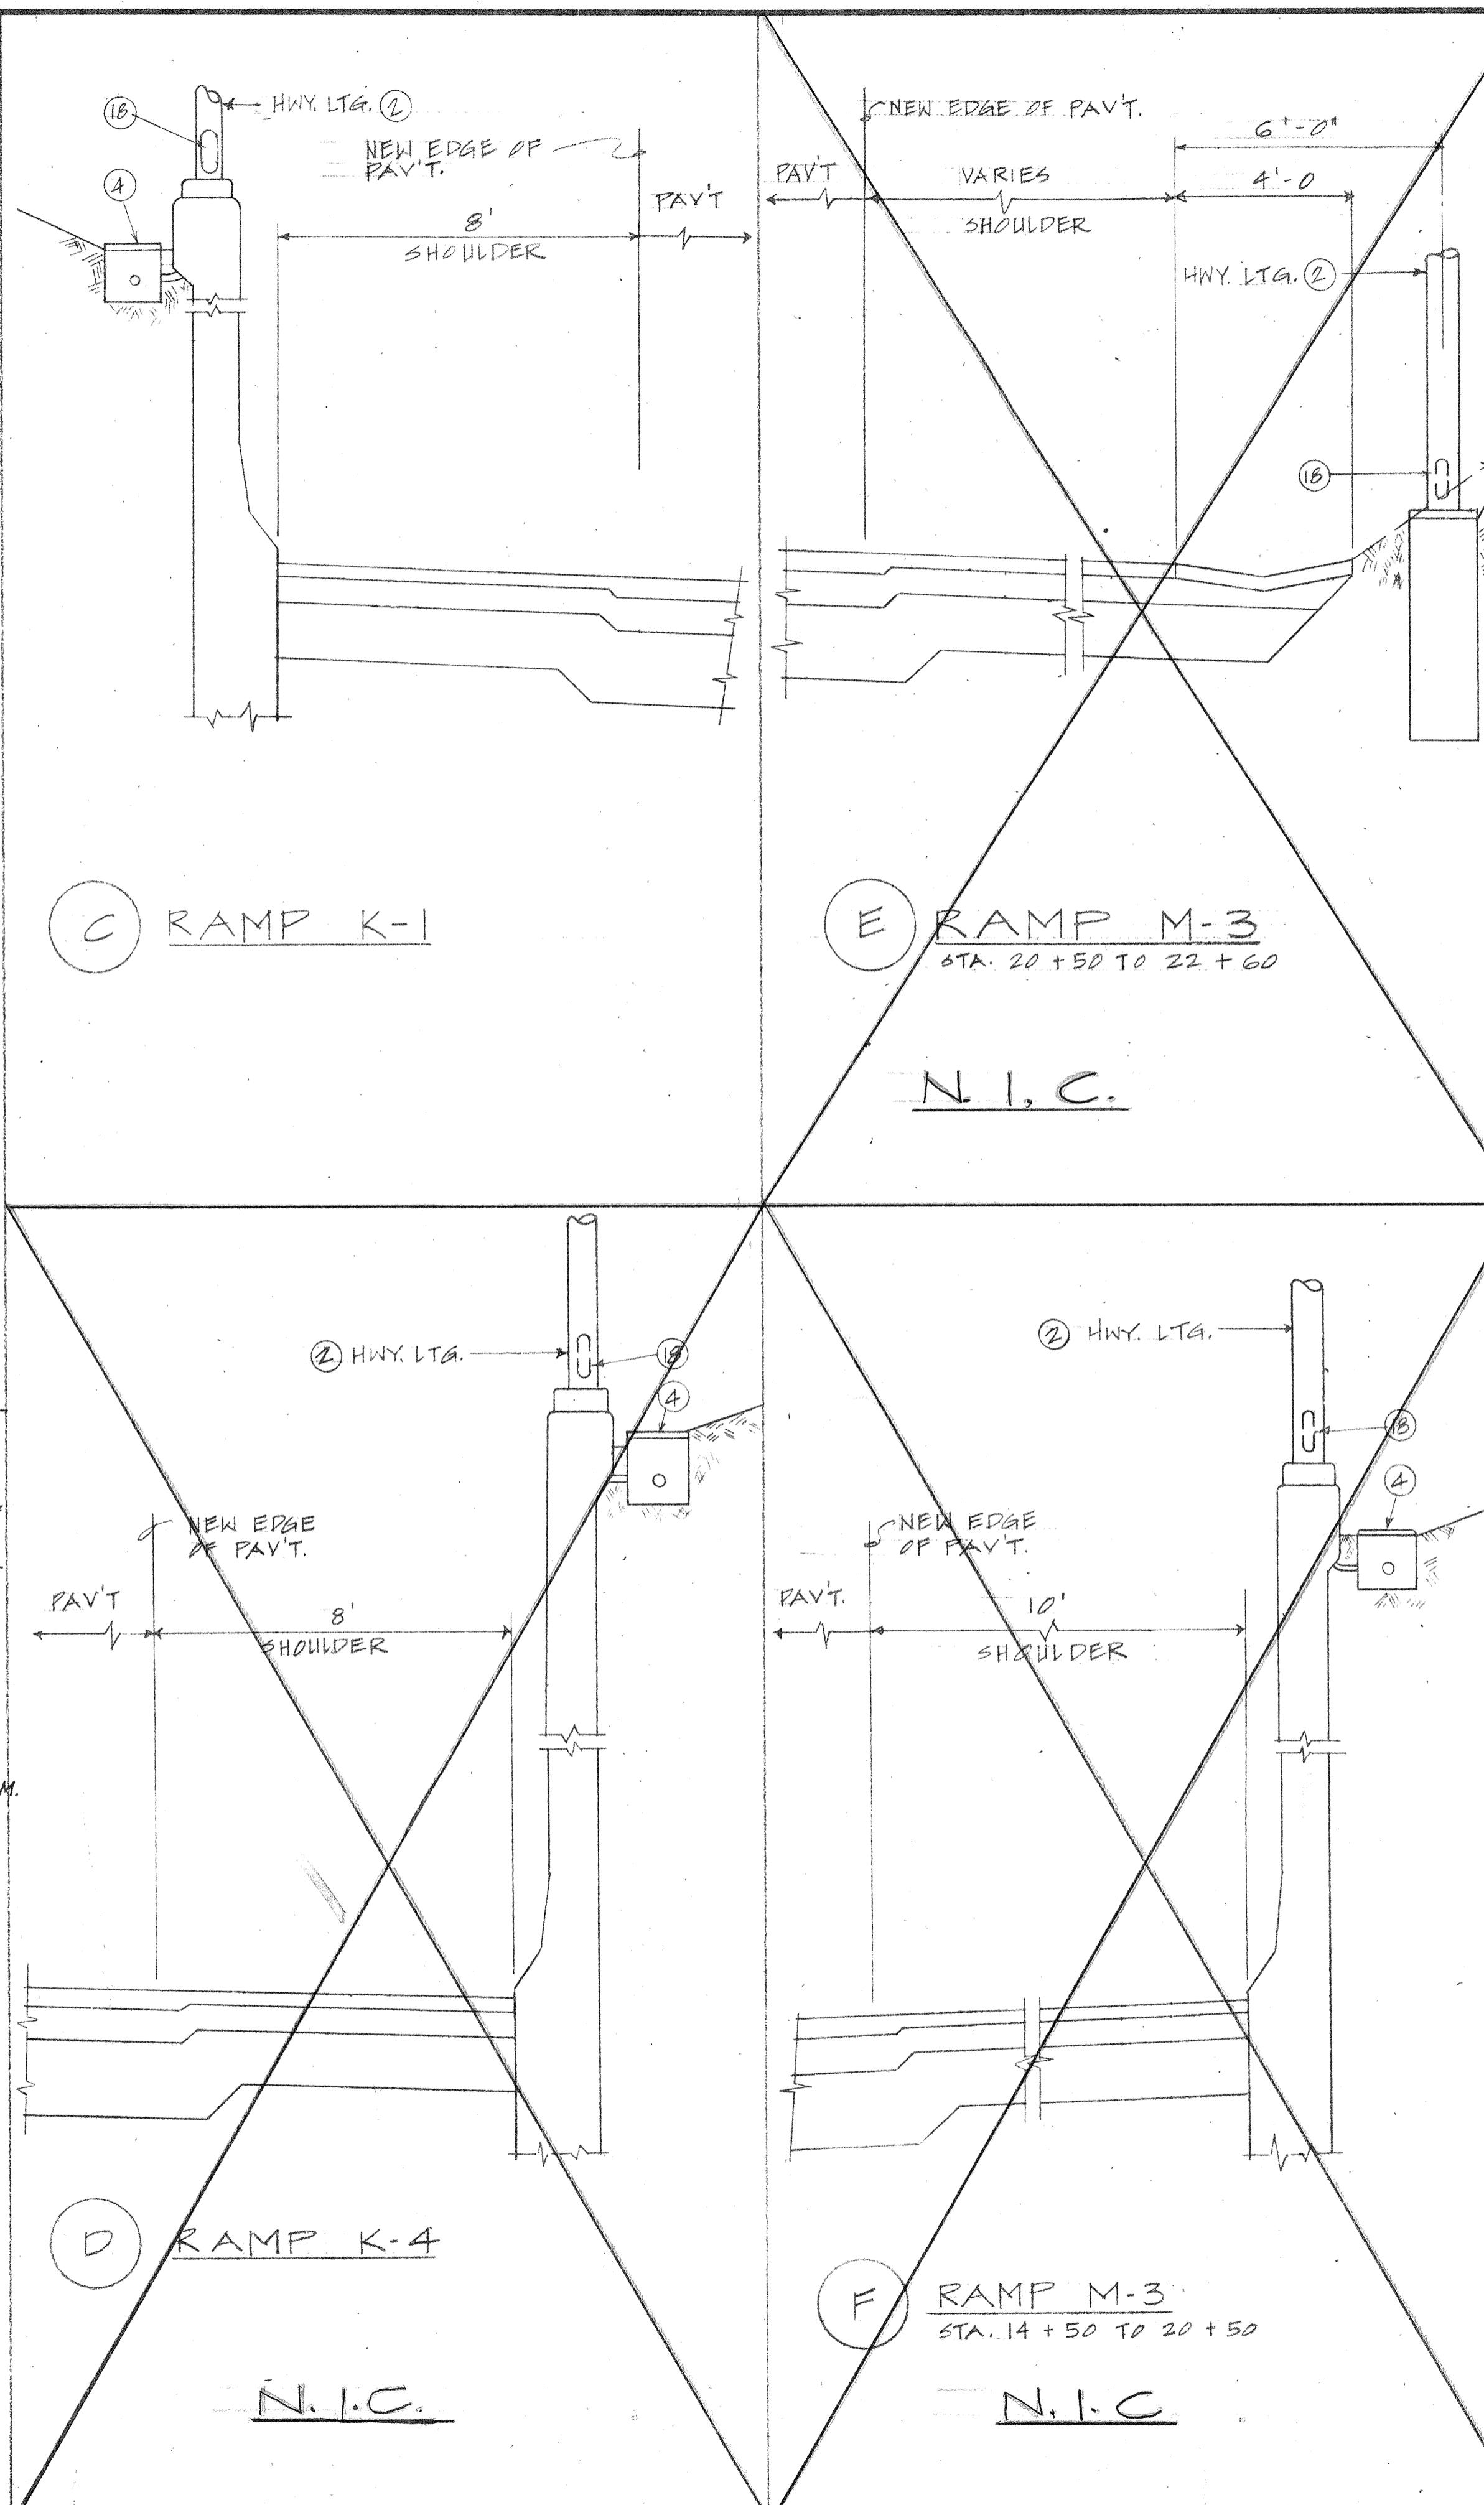


RAMP M-3



THIS WORK WAS PREPARED BY
ME OR UNDER MY SUPERVISION.


STATE OF HAWAII
DEPARTMENT OF TRANSPORTATION
HIGHWAYS DIVISION
HIGHWAY LIGHTING
POLE ASSEMBLY ON STRUCTURES
SAFETY IMPROVEMENT
KALIHI STREET TO PALI HIGHWAY
F.A.I. PROJECT NO. I-HI-1(12)19

FED. ROAD DIST. NO.	STATE	FED. AID PROJ. NO.	FISCAL YEAR	SHEET NO.	TOTAL SHEETS
HAWAII	HAW.	I-HI-1(102)19	1973	120	176

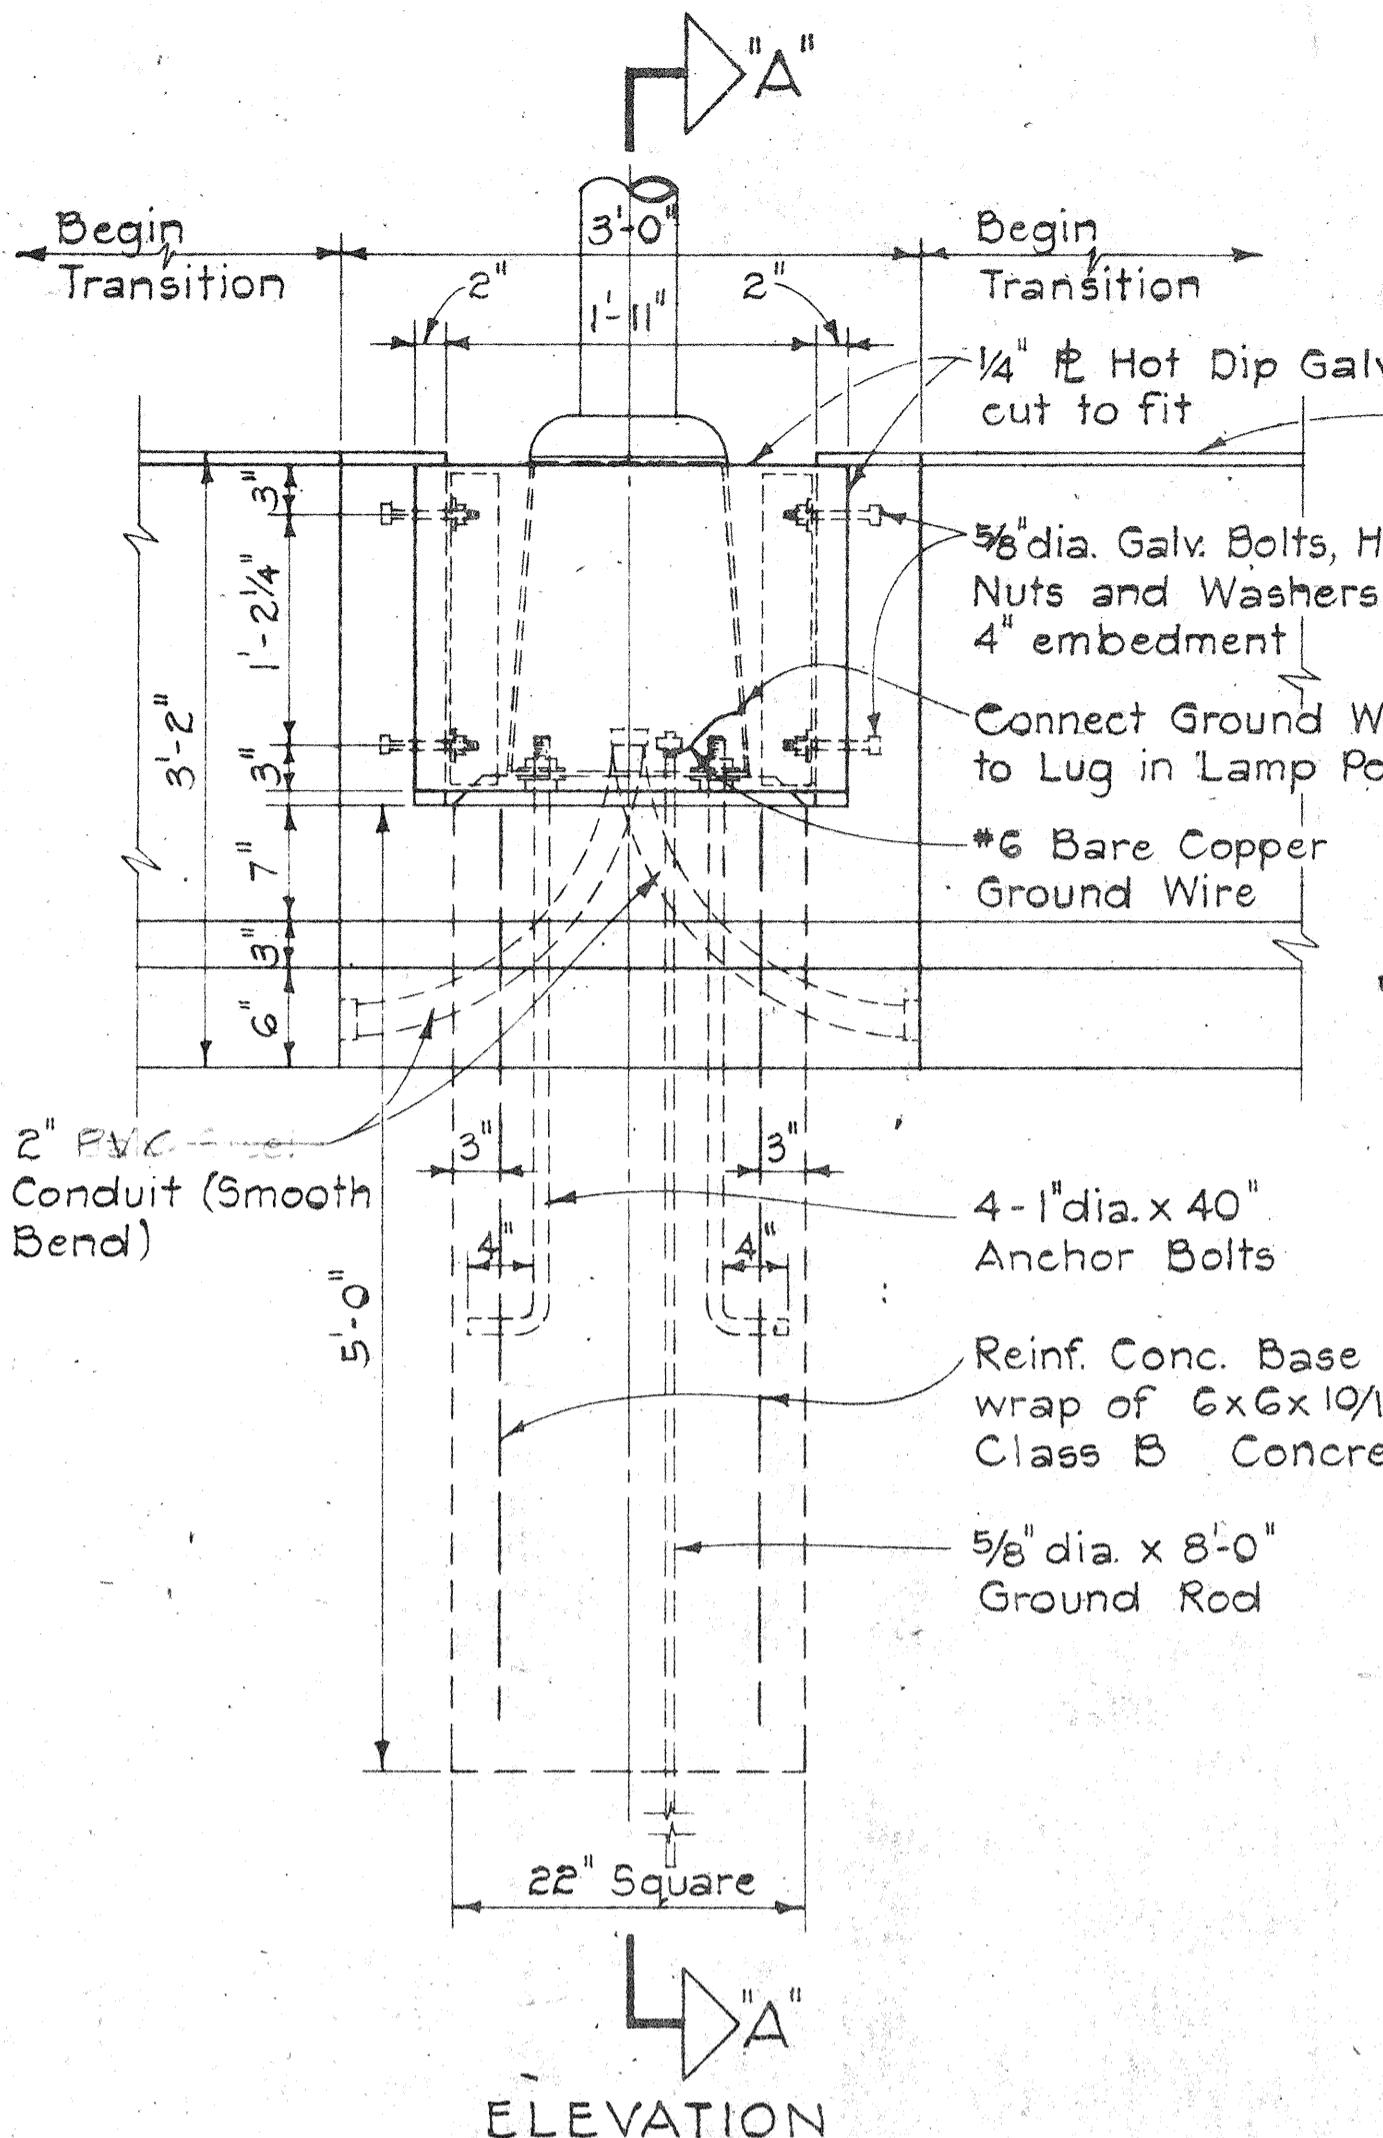

HIGHWAY LIGHTING STANDARD MOUNTING
DETAIL ON TYPE "A" CONCRETE BARRIER

Scale: 1" = 1'-0"

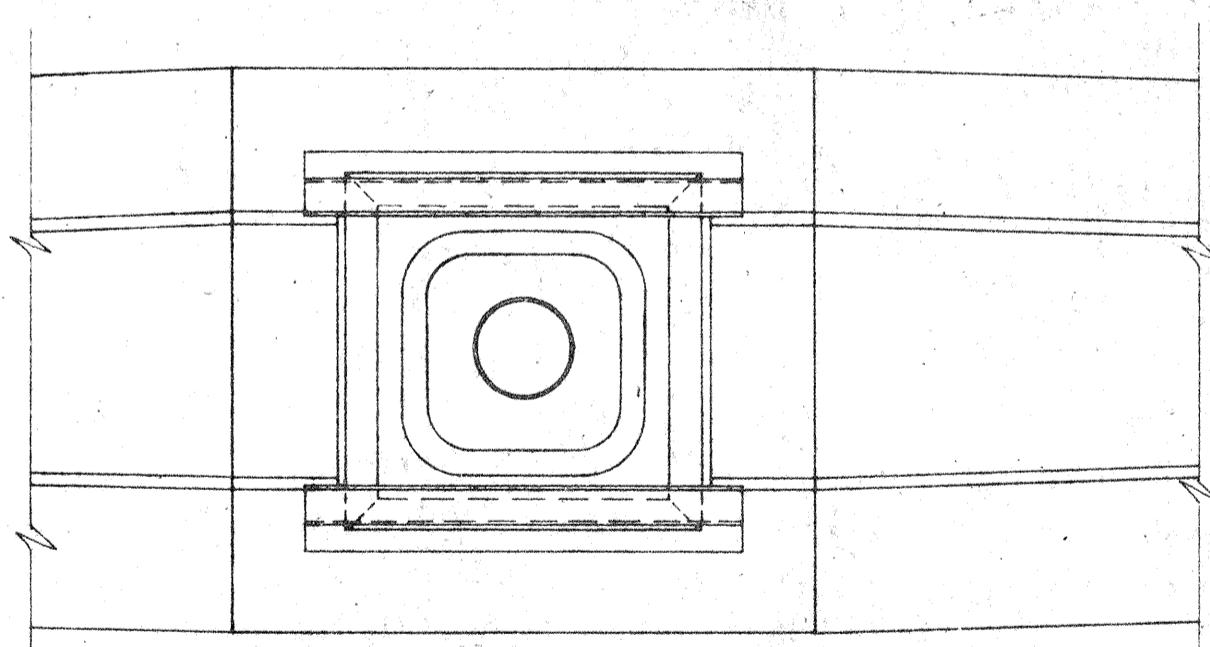


TYPICAL PLAN



Scale: 1" = 1'-0"

ANGLE IRON - COVER PLATE DETAIL

Scale: 3" = 1'-0"

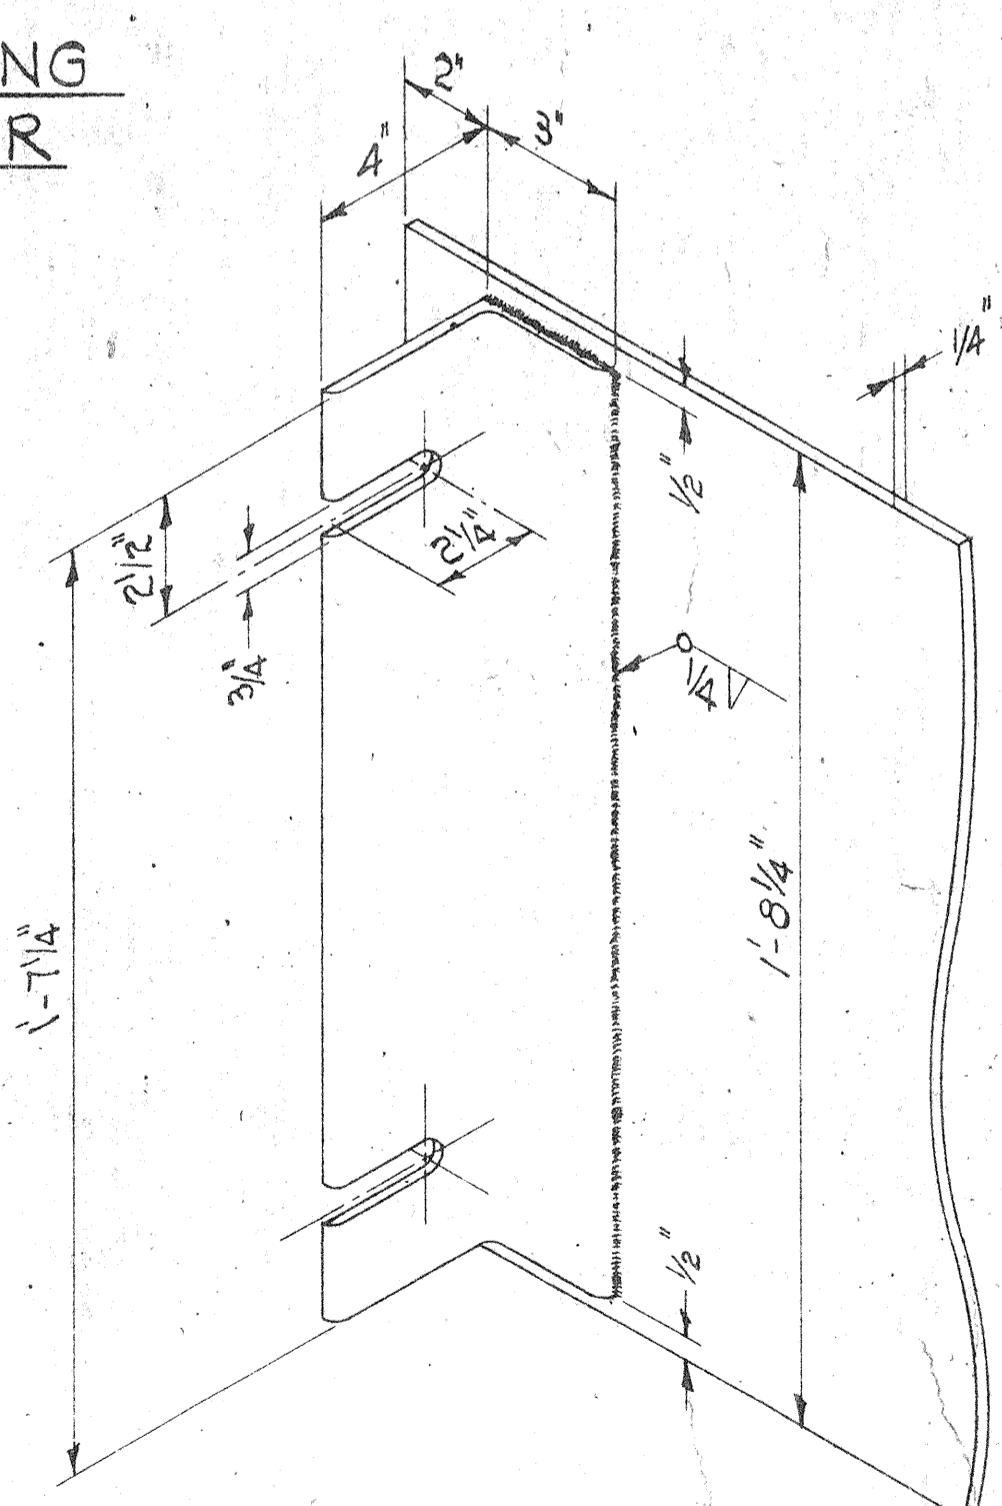


SECTION "A-A"

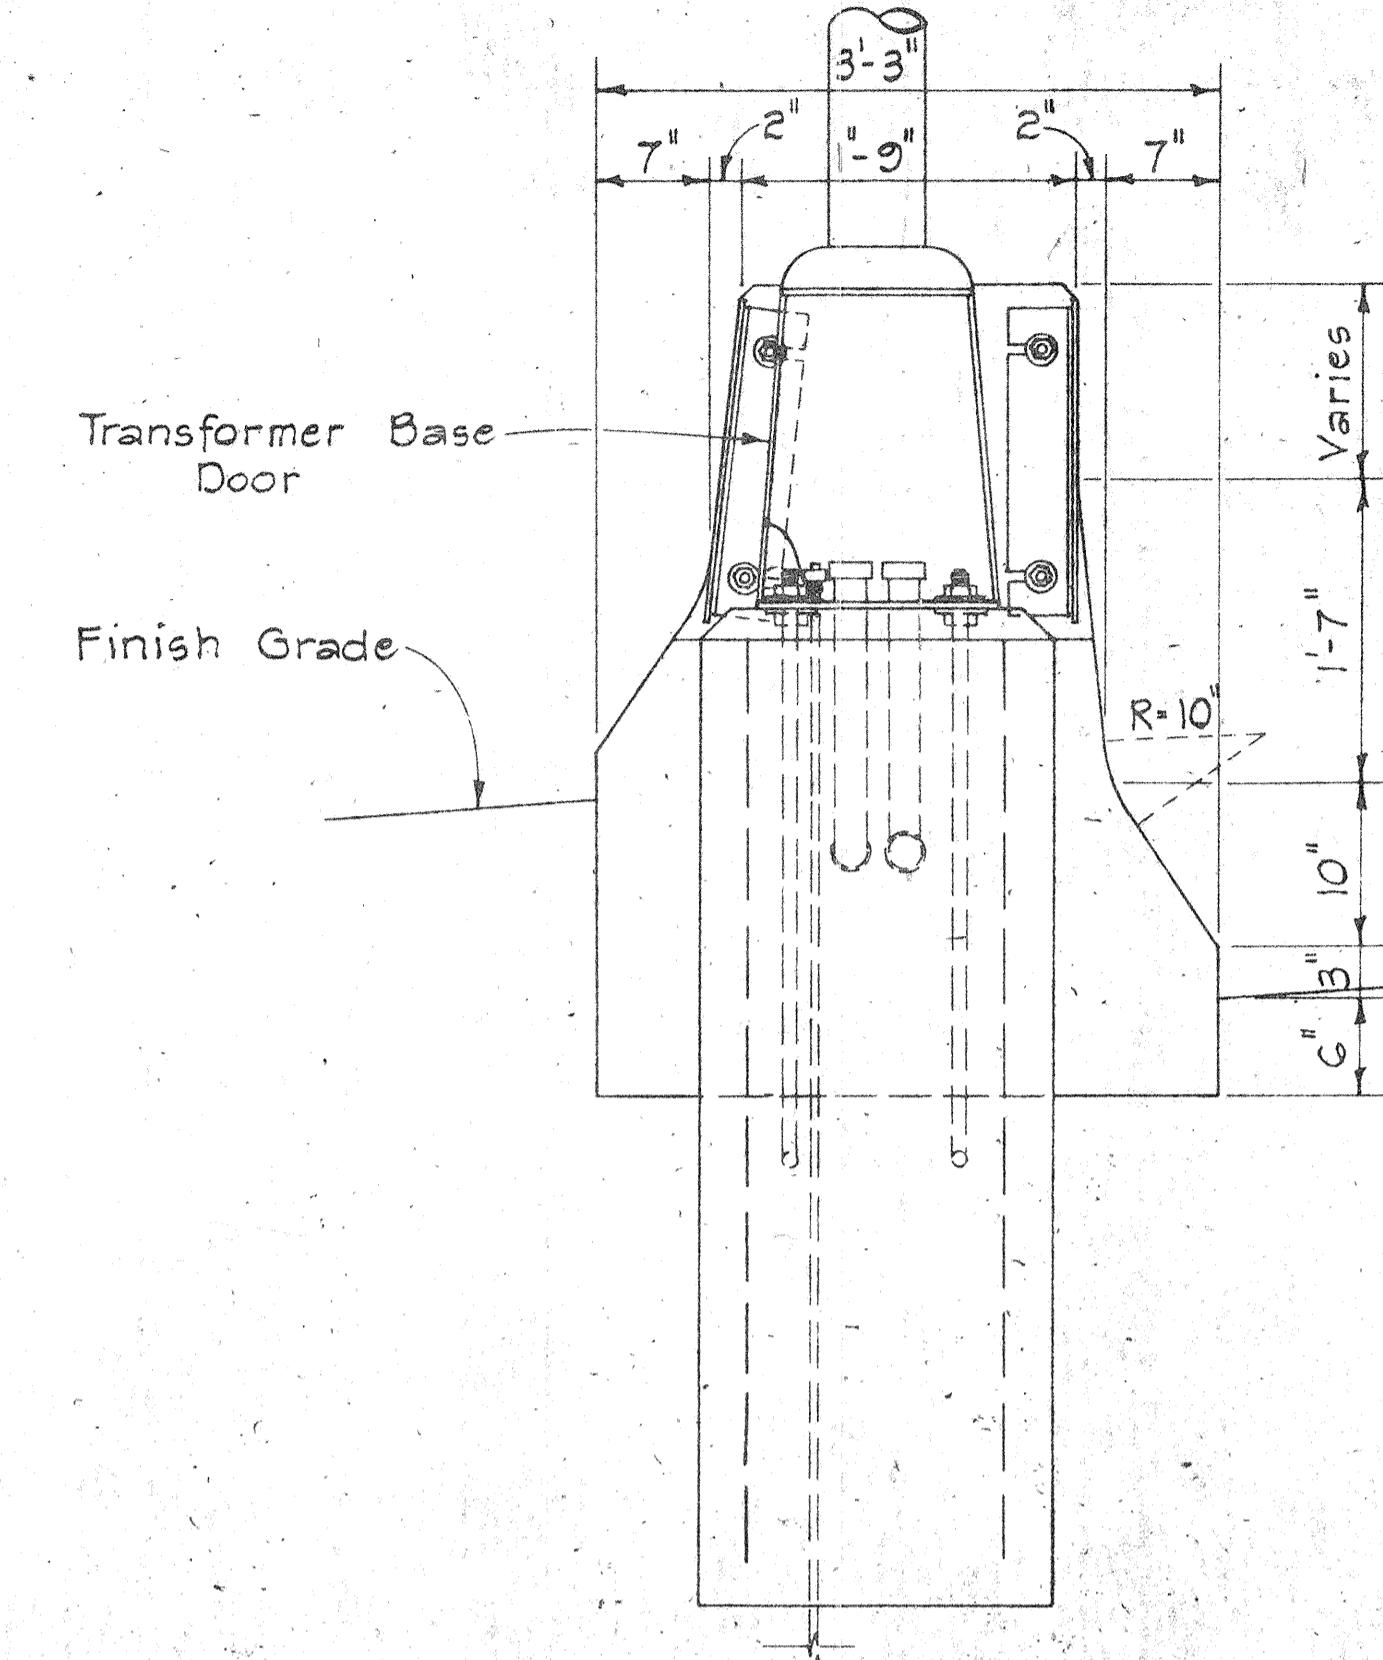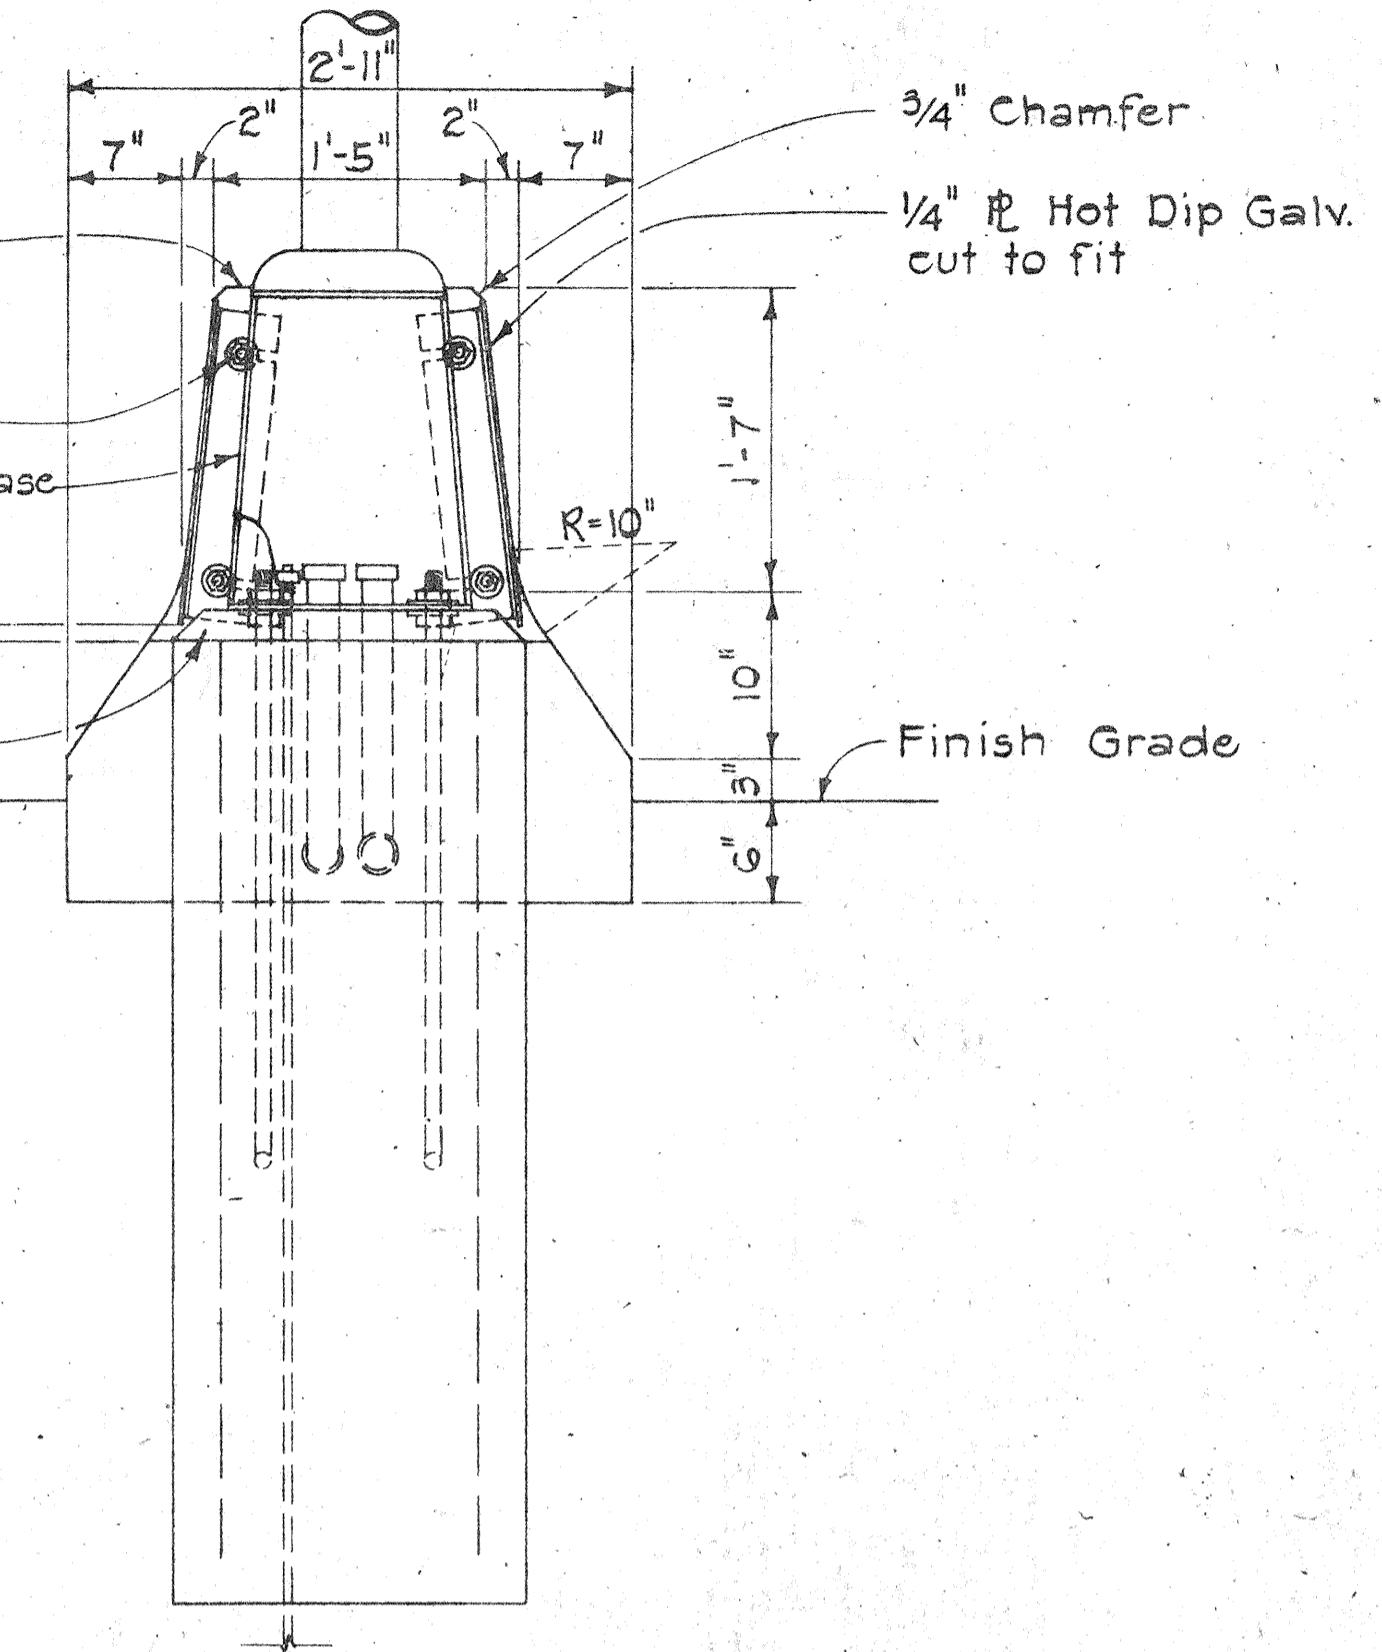

HIGHWAY LIGHTING STANDARD MOUNTING
DETAIL ON TYPE "B" CONCRETE BARRIER

Scale: 1" = 1'-0"

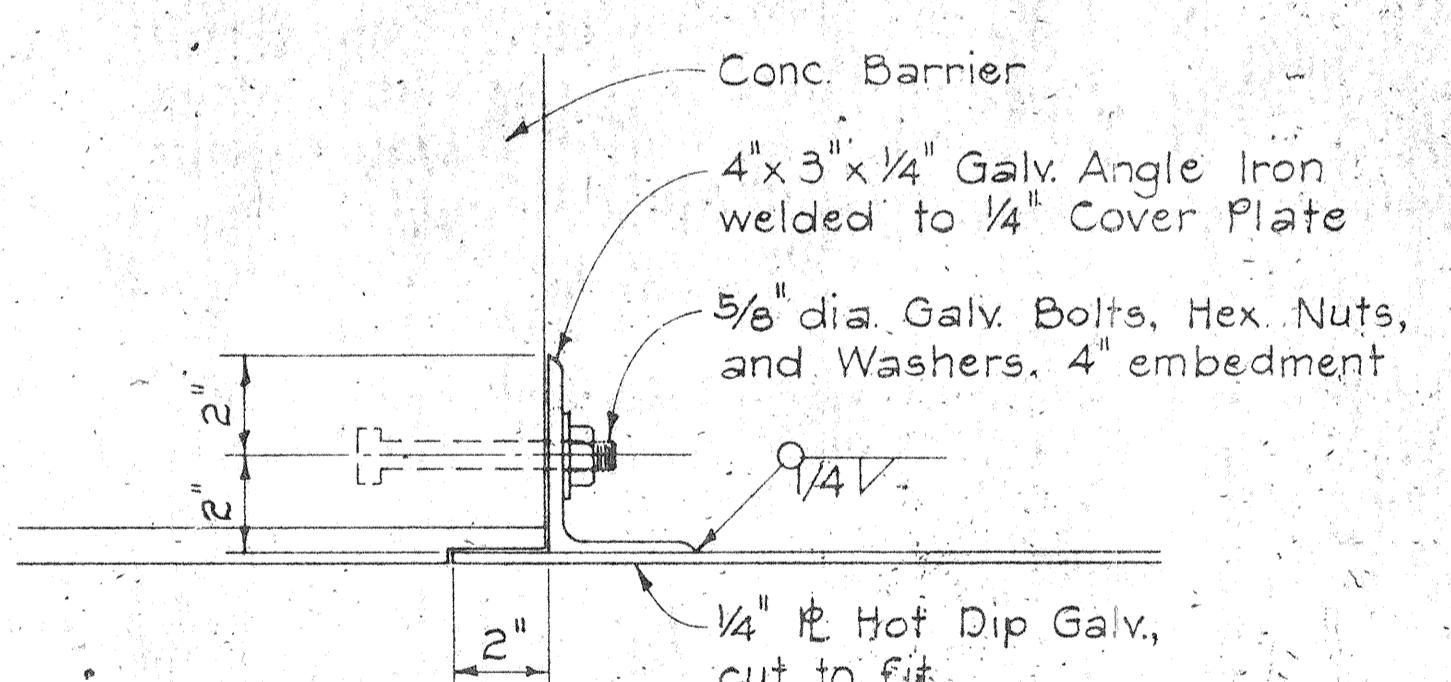

COVER PLATE ANCHOR DETAIL

Scale: 3" = 1'-0"

NOTES:

1. Constructing conc. barrier foundation for Hwy. Lighting Standards shall consist of all work and materials necessary for constructing the 3'-0" concrete barrier section as shown on the plans. The work shall include furnishing and installing cover plate, angle iron, nuts and bolts and all other appurtenances, and labor including galvanizing, as shown and necessary to complete the work.

APPROVAL RECOMMENDED:

Etsuro Tanaka
TRAFFIC ENGINEER


12/23/69
DATE

APPROVED:

John S. Smith
ASSISTANT CHIEF, ENGINEERING


12-30-69
DATE

NO	REVISION	APPROVED BY	DATE

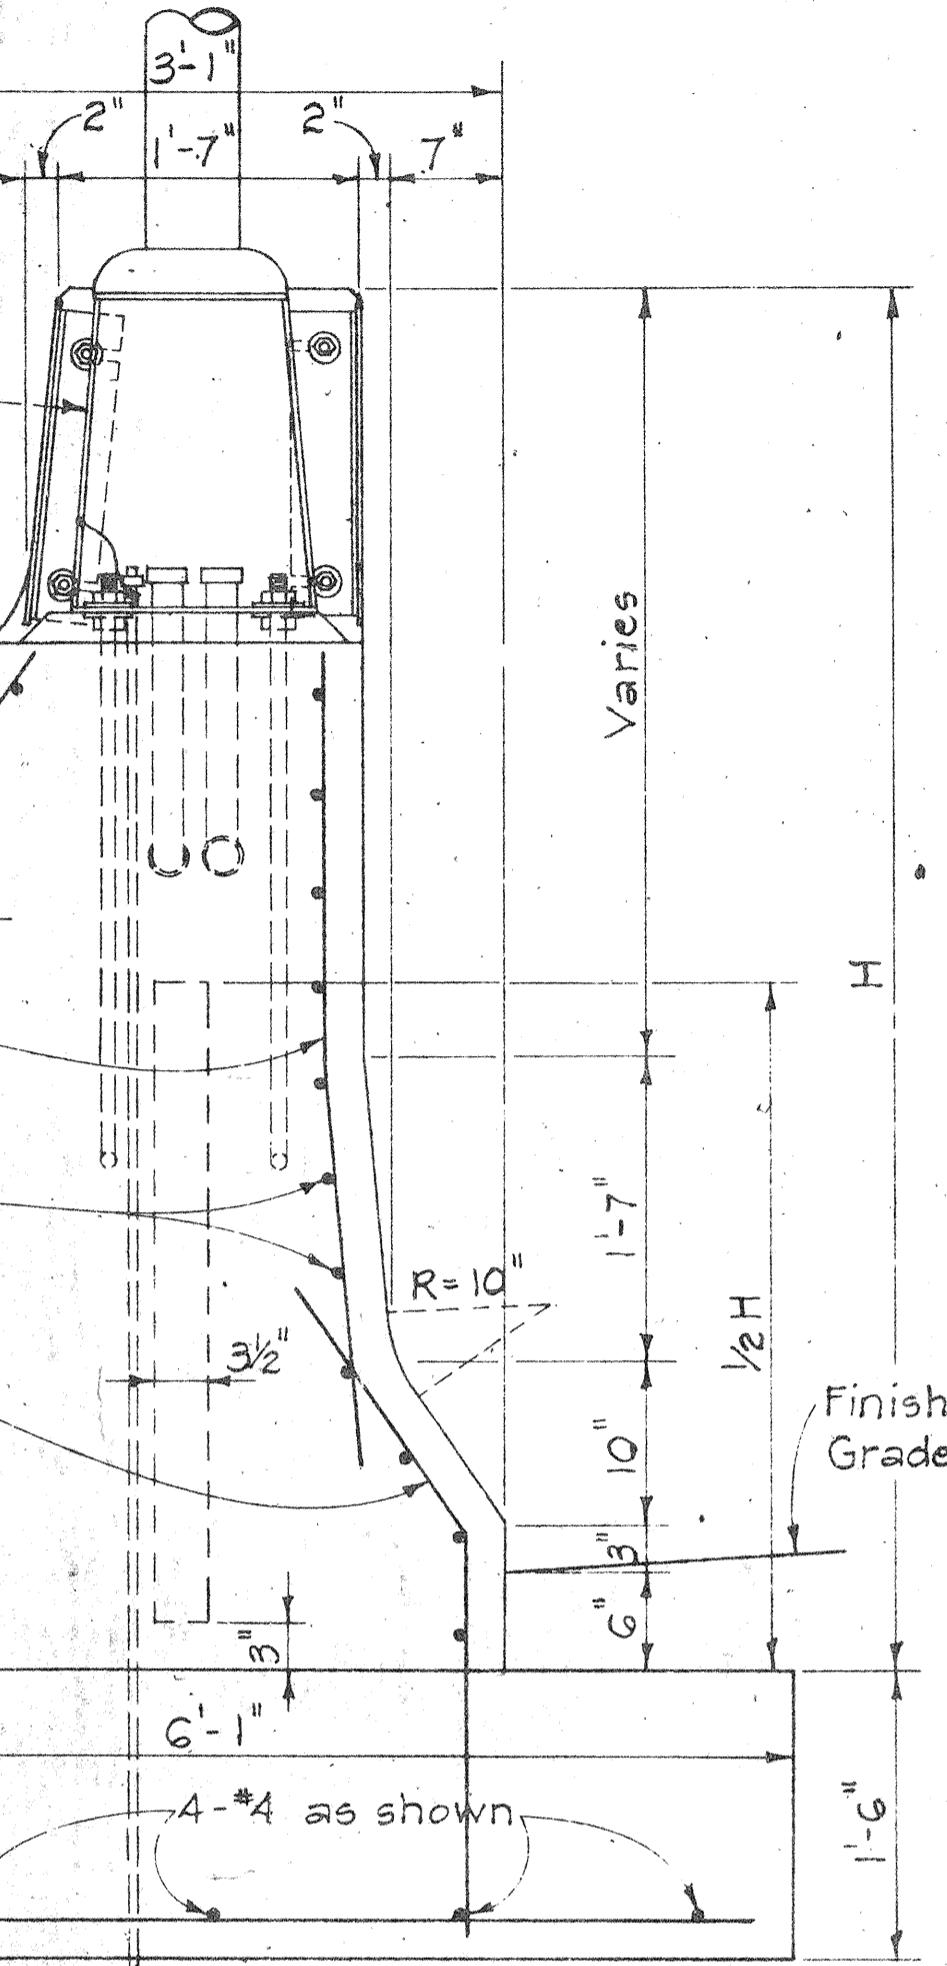

SECTION "C-C"

Scale: 1" = 1'-0"

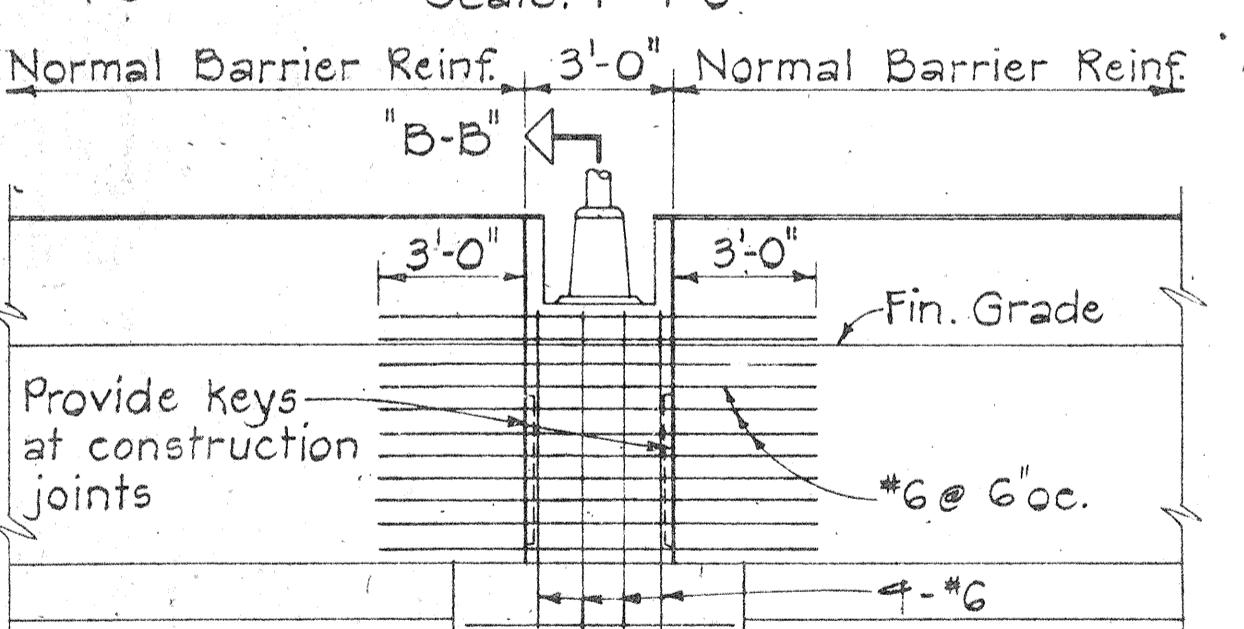

ELEVATION

Scale: 1/4" = 1'-0"


HIGHWAY LIGHTING STANDARD MOUNTING
DETAIL ON TYPE "C" & "D" CONC. BARRIER

STATE OF HAWAII
DEPARTMENT OF TRANSPORTATION
HIGHWAYS DIVISION
HIGHWAY LIGHTING
STANDARD DETAIL
HIGHWAY LIGHTING
STANDARD MOUNTING
DET. OH CONC. BARRIER

Scale: As Shown Date: APR. 1973


SHEET No. 10 OF 10 SHEETS DT 515

FED. ROAD DIVISION NO.	STATE	FED. AID PROJ. NO.	PUBLIC YEAR	SHEET NO.	TOTAL SHEETS
HAWAII	HAWAII	IHH-12(1)	1973	121	170

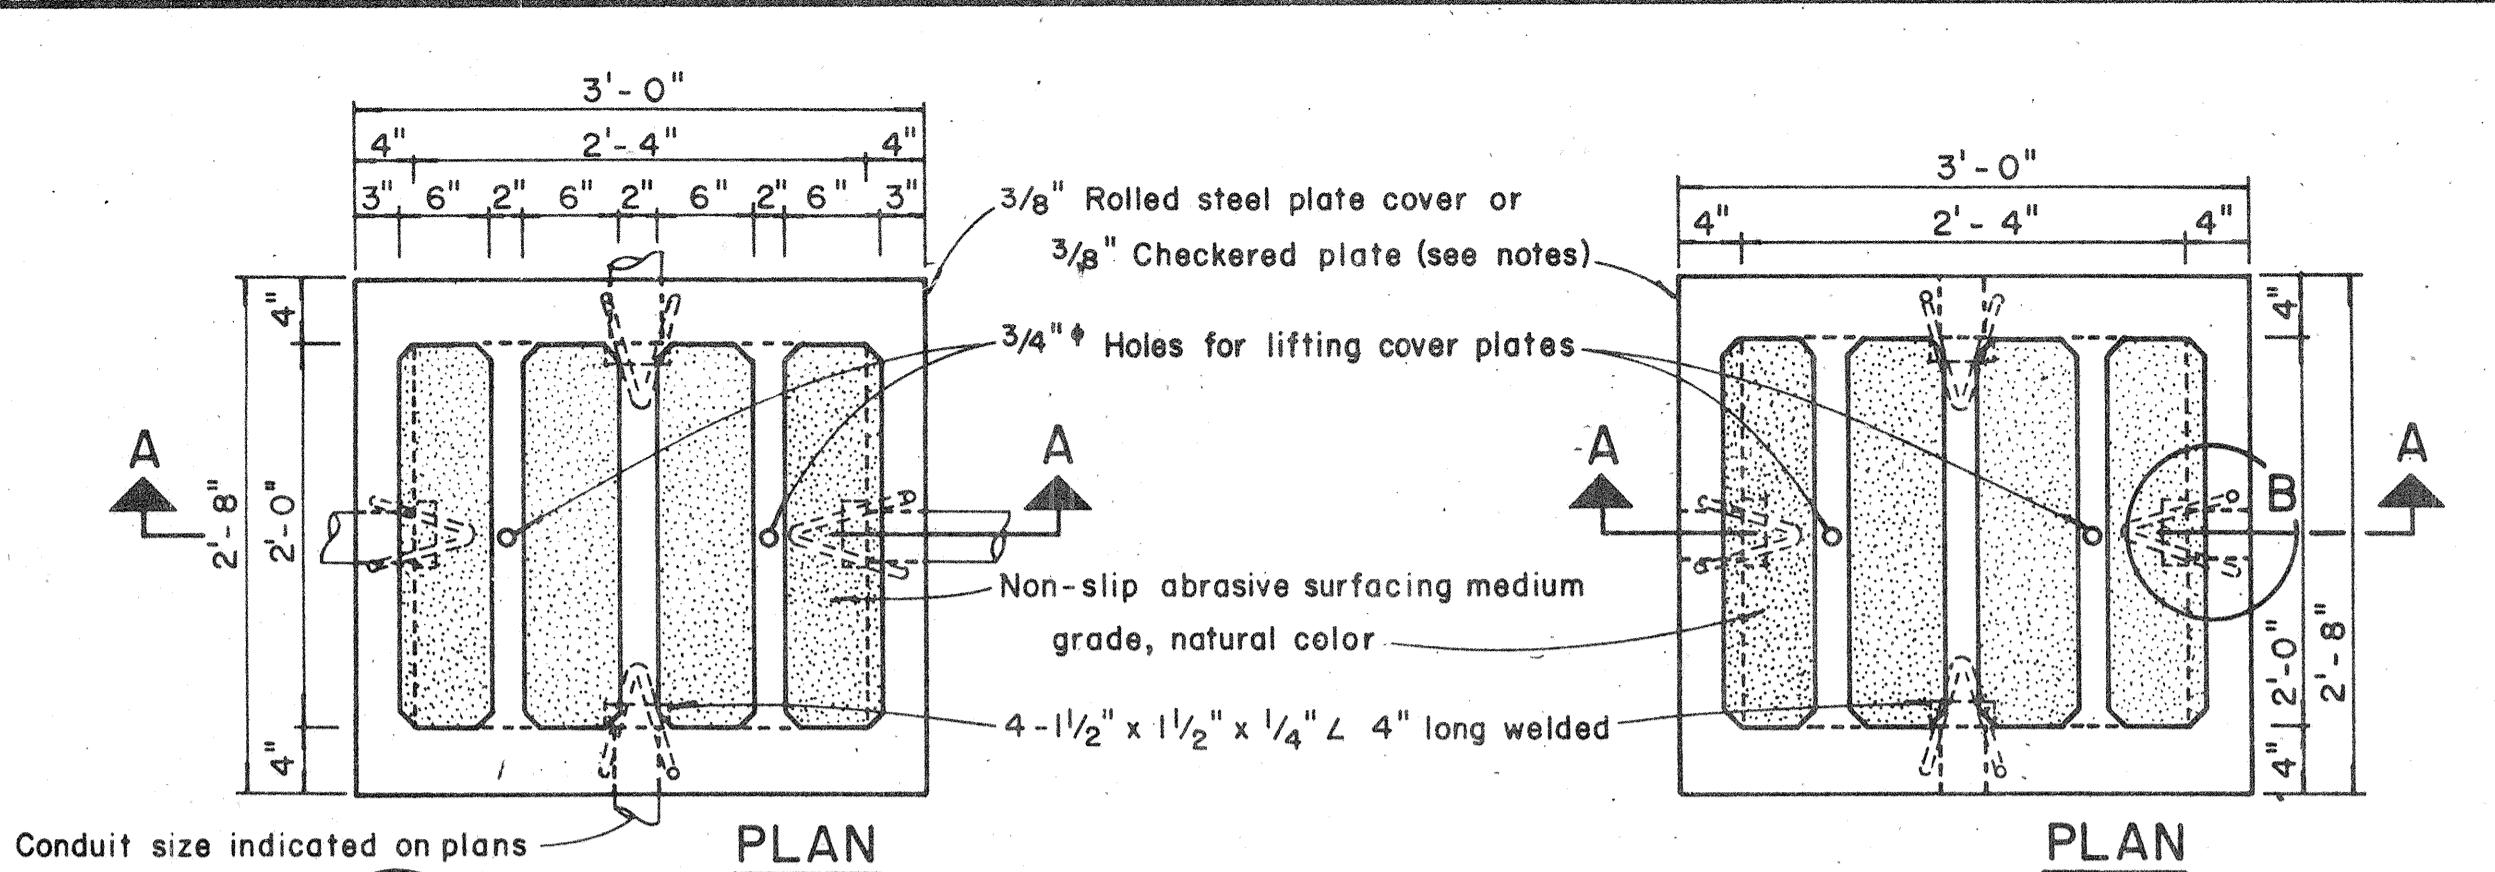

Conduit size indicated on plans

PLAN

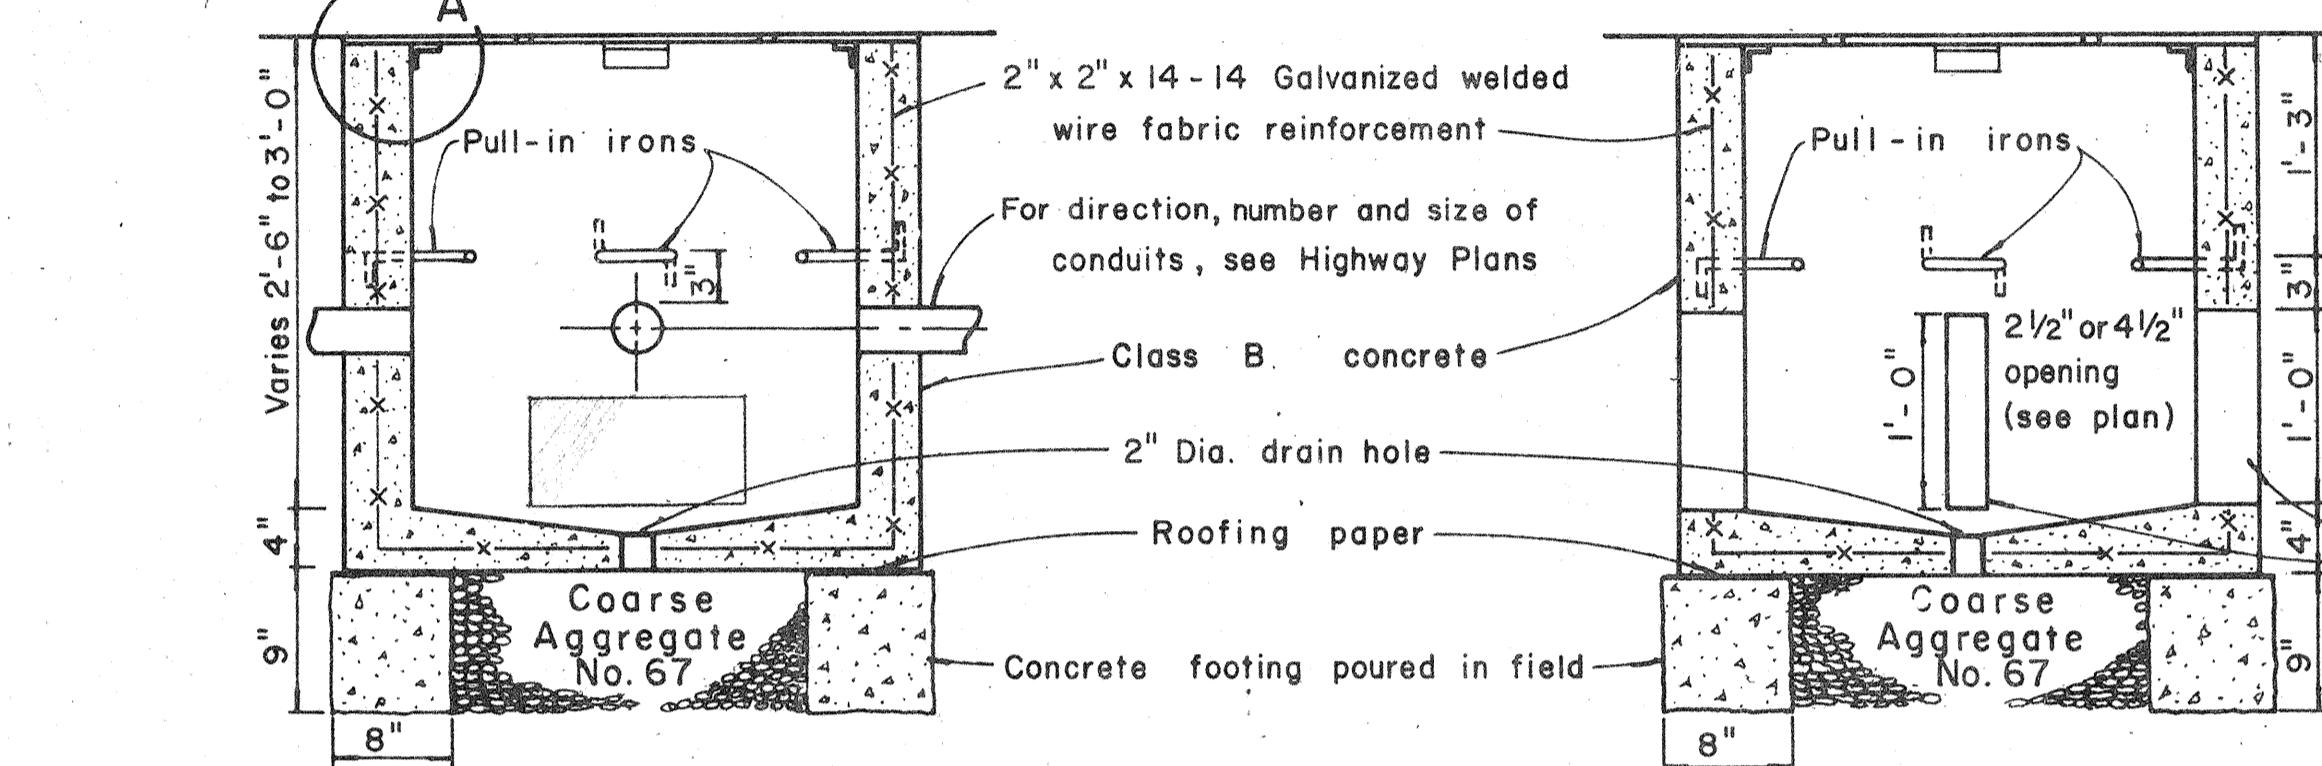

TYPE "A" PULLBOX CAST-IN-PLACE

Scale: 1" = 1'-0"
NOTE NO. 2

TYPE "A" PULLBOX PRECAST

Scale: 1" = 1'-0"
NOTE NO. 2

For direction, number and size of slots for conduits, see Highway Plans

Grout conduit slot with 1:3 cement mortar after conduit is placed

Varies (to be determined in the field)


Bricks with mortar. Mortar between all contact surfaces

COARSE AGGREGATE
is H.O. 67

FED. ROAD DIST. NO.	STATE	FED. AID PROJ. NO.	FISCAL YEAR	SHEET NO.	TOTAL SHEETS
HAWAII	HAW.	I-HI-(12)19	1973	122	176


NOTES:

1. ALL PULLBOXES W/ BALLAST OR ISOLATING TRANSFORMER SHALL HAVE 4"X4"X16" CONC. BLOCK (C.M.U.).
2. SEE NOTE #1, SH. 11L.
3. SEE NOTE #19 & #20, SH. 13L.

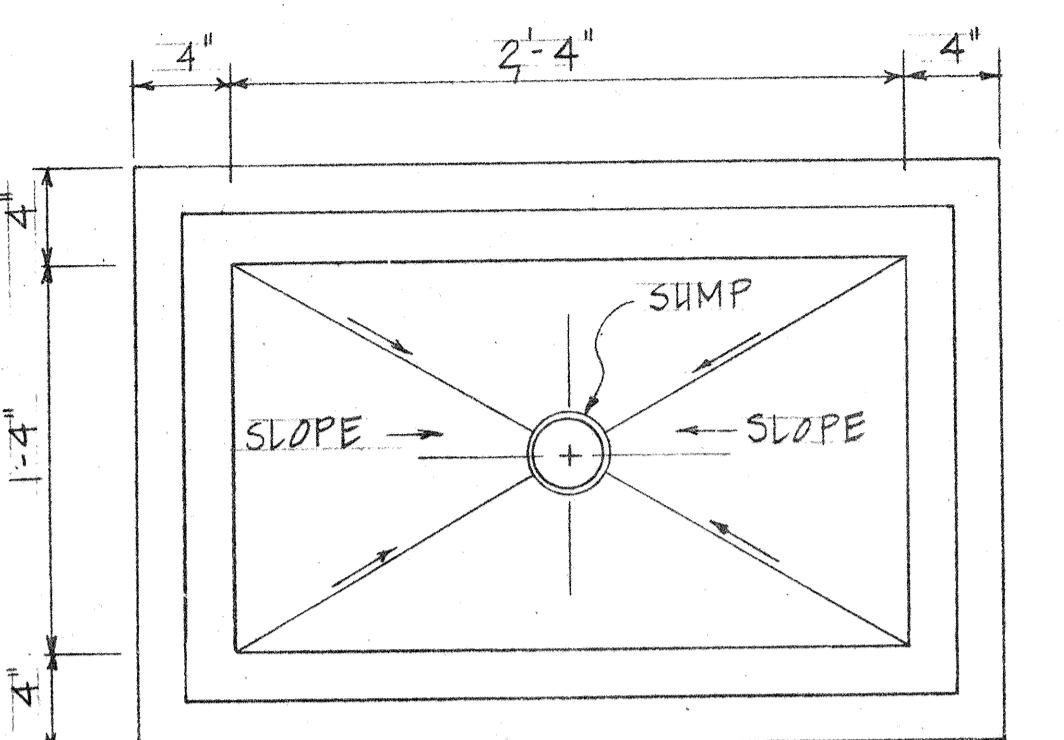

PLAN


SCALE: 1/2" = 1'-0"

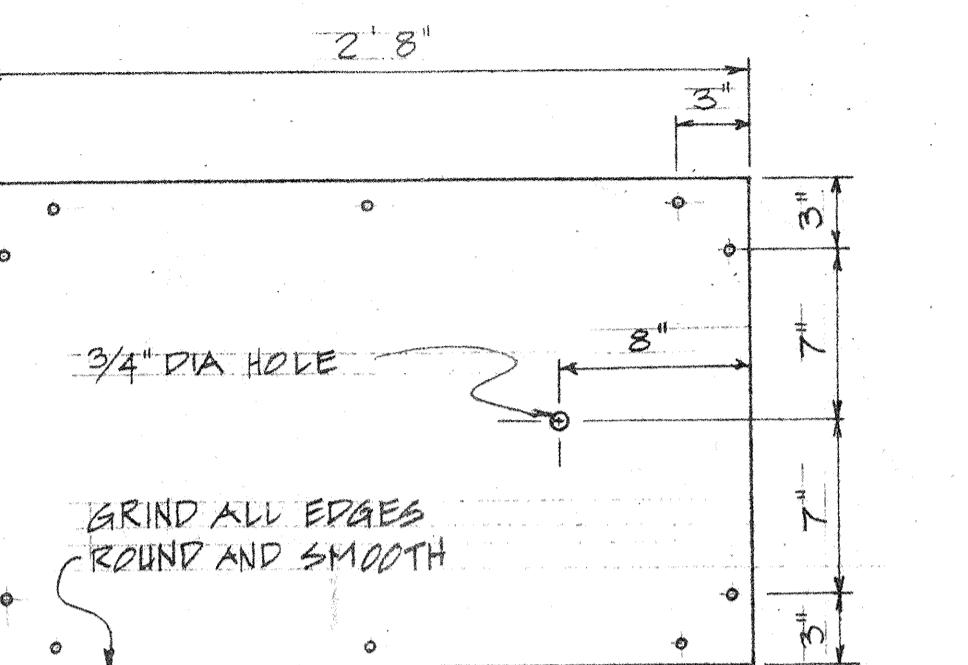

3/8" CHECKED PLATE COVER


(HOT DIP GALV. CHECKERED TO AFTER DRILLING COUNTERSINKING & GRINDING EDGE)

SCALE: 1/2" = 1'-0"

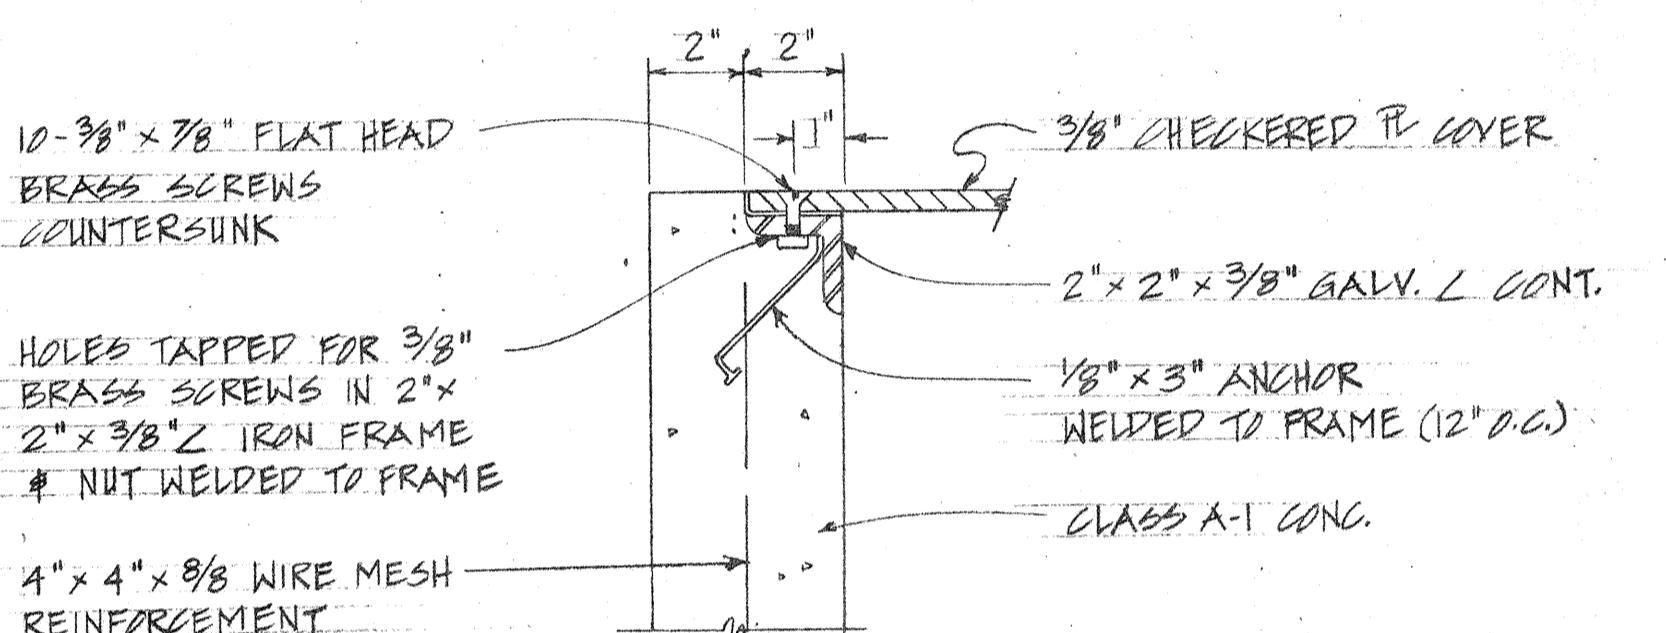

DETAIL "A"

SCALE: 3" = 1'-0"

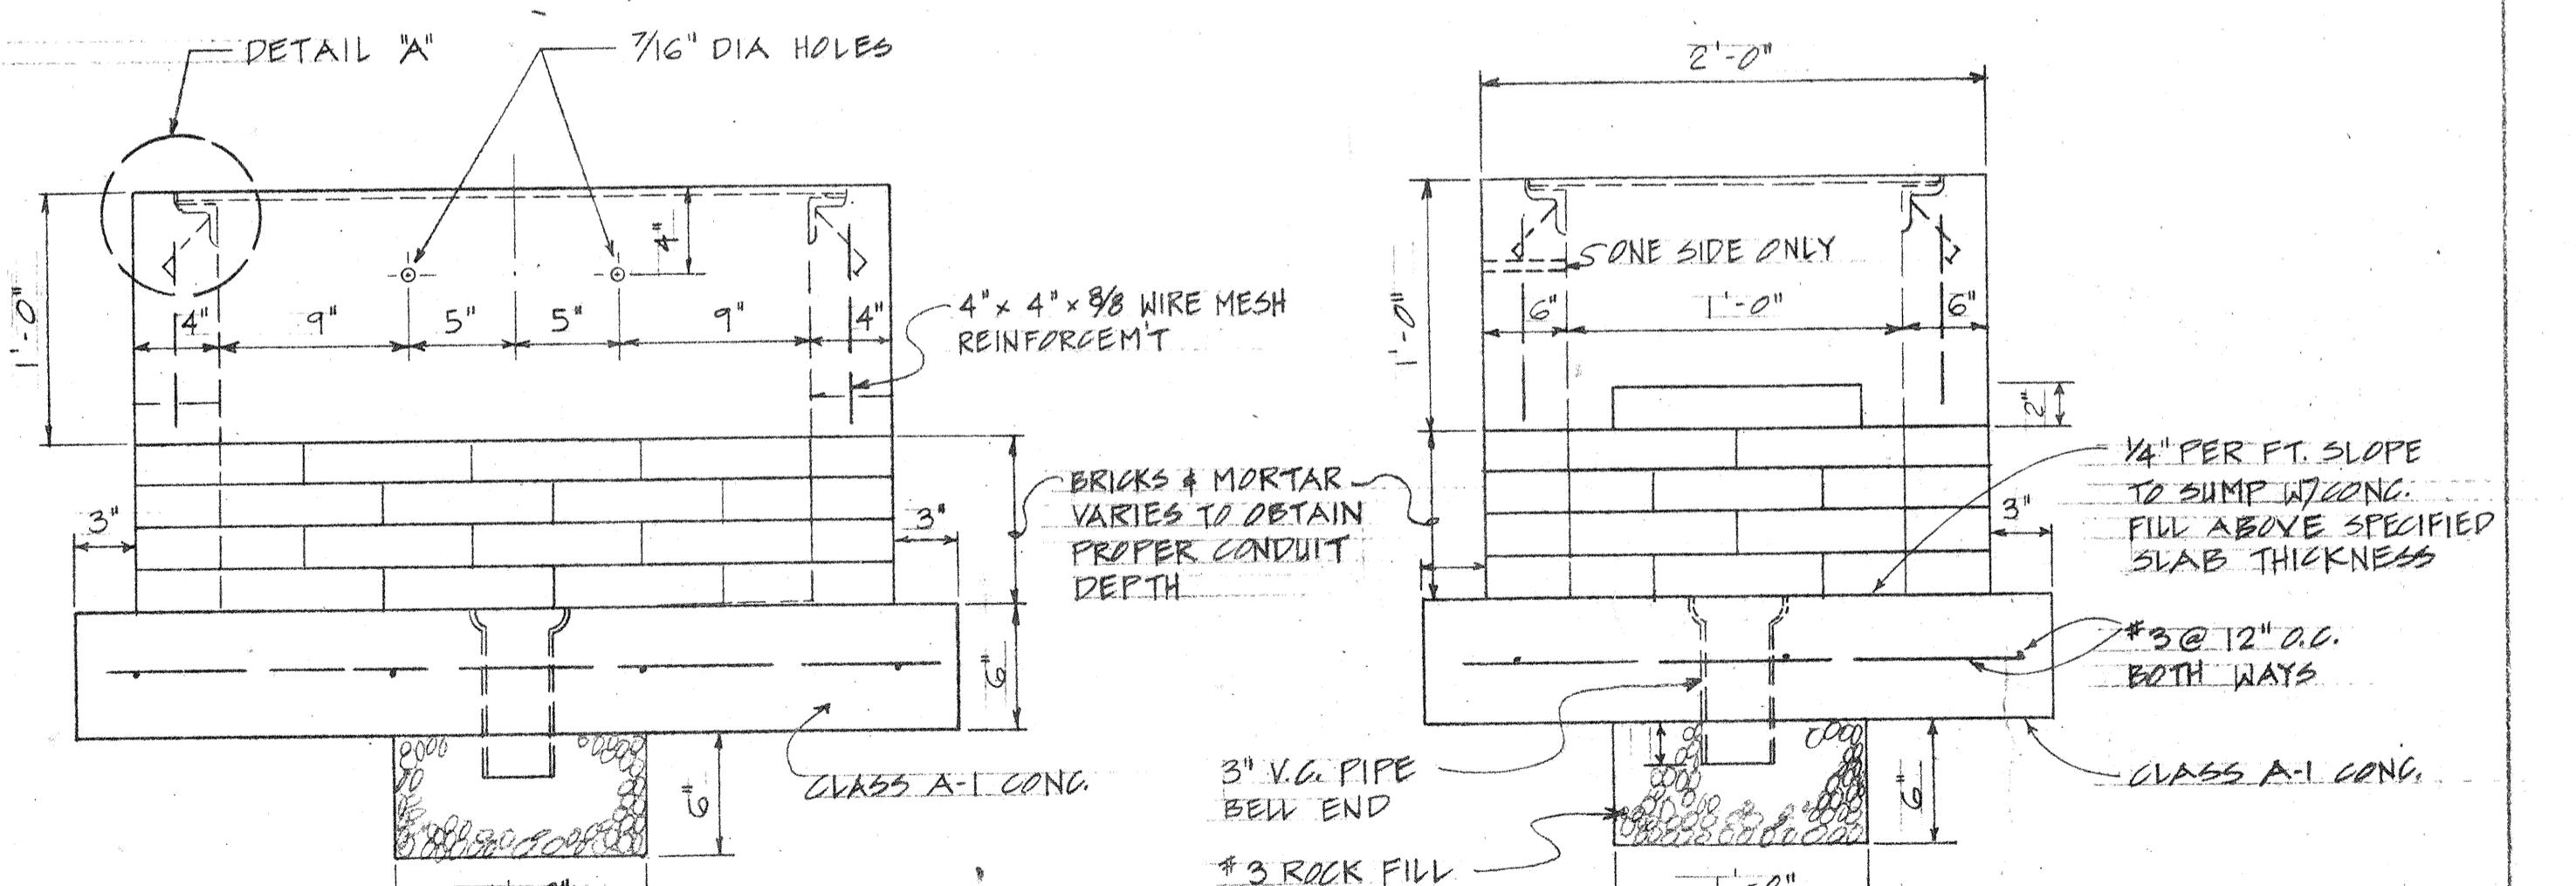

SIDE VIEW

SCALE: 1/2" = 1'-0"

2'-0" x 3'-0" CONCRETE PULLBOX

SEE NOTE NO. 1

END VIEW

SCALE: 1/2" = 1'-0"

3" V.G. PIPE
BELL END

#3 ROCK FILL

CLASS A-I CONG.

STATE OF HAWAII
DEPARTMENT OF TRANSPORTATION
HIGHWAYS DIVISION
HIGHWAY LIGHTING
STANDARD DETAILS-PULL BOX
TYPE "X"
SAFETY IMPROVEMENT
KALIHI STREET TO PALI HIGHWAY
F.A.I. PROJECT NO. I-HI-(12)19
SCALE AS NOTED DATE: APR. 1973
SHEET NO. 12 OF 18L SHEETS

1 60 60

①

ORIGINAL	STYLED/PLOTTED BY
DRAWN BY	TRACED BY
NOTE BOOK	DESIGNED BY
No. _____	CHECKED BY

FED. ROAD DIST. NO.	STATE	FED. AID PROJ. NO.	FISCAL YEAR	SHEET NO.	TOTAL SHEETS
HAWAII	HAW.	I-HI-1(12)19	1973	123	176

- MATERIAL LIST
- ① MERCURY-VAPOR LUMINAIRE
 - ② PHOTO ELEC. SW. (MULTIPLE CKT. ONLY)
 - ③ TRUSS BRACKET
 - ④ POLE
 - ⑤ POLE BASE 4-BOLTS, WASHERS & NUTS
 - ⑥ POLE BASE BOLT COVER
 - ⑦ GROUNDING LUGS
 - ⑧ TRANSFORMER BASE W/ ACCESS COVER
 - ⑨ 4-1" X 40" GALV. ANCHOR BOLTS
 - ⑩ GRD ROD 5/8" Ø X 10'-0" COPPERGLAD
 - ⑪ PVC SCH'D. 40, 36" DEEP MIN.
 - ⑫ CONC. W/ 6#3 BARS UNLESS OTHERWISE NOTED.
 - ⑬ WIRING ACCESS HANDHOLE, SEE DET. SH. 13L
 - ⑭ SLIP BASE INSERT STD, SEE DET. SH. 14L
 - ⑮ REINFORCED CONC. FOUNDATION INCLUDING 10#3 BONDED GRD. LUGS TO GRD. ROD, SIMILAR TO DET. "A" W/ EXCEPTIONS AS NOTED.
 - ⑯ FOR POLES 60, 71, 73, 79, 80, 74, 76, 78, 80, 100, 102, 104, 106, 103, 105, 107 ROUND SECTION DEPTH SHALL BE 7'-0" MIN. LOCATE LT. STD. 5' EITHER WAY.
 - ⑰ DOUBLE BRACKET CONDITION, COMPLETE W/ LUMINAIRES (PHOTO ELEC. SW. FOR MULTI-CKT.) & WIRING.
 - ⑱ FOR MULTI-CKT., PROVIDE IN-LINE NEOPRENE MOLDED FUSE & MOLDED CONNECTOR FOR NEUTRAL.
 - ⑲ PROVIDE 1#10 TW BOND BETWEEN POLE LUG & GRD. ROD & #6 TW STRANDED COPPER, CONTINUOUS BOND AMONG ALL NEW PULL BOXES & POLES GROUNDING VIA NEW RACEWAYS SYSTEM FOR MULTI-CKT, SEE NOTE #1, SH. 11L
 - ⑳ PROVIDE 1#10 TW BOND BETWEEN POLE LUG & PULLBOX GRD. ROD FOR SERIES CKT. SEE NOTE #1, SH. 11L
 - ㉑ REMOTE BALLAST FOR SERIES-CKT, LOCATE IN PB OR TRANS. BASE.
 - ㉒ AT EXST. CUT, INCREASE ROUND SECT. DEPTH BY 12 INCH PER 2 INCH VERT. DIFFERENCE FROM FOUNDATION TOP TO FIN. GR.
 - ㉓ FOR 35' & 40' POLES, INCREASE ROUND SECT. DEPTH TO 60 INCHES.

STATE OF HAWAII
DEPARTMENT OF TRANSPORTATION
HIGHWAYS DIVISION
HIGHWAY LIGHTING
HIGHWAY STANDARD DETAILS

SAFETY IMPROVEMENT


KALIHI STREET TO PALI HIGHWAY

F.A.I. PROJECT NO. I-HI-1(12)19


AS NOTED DATE: APR. , 1973

SHEET NO. 13 OF 18 L SHEETS

123

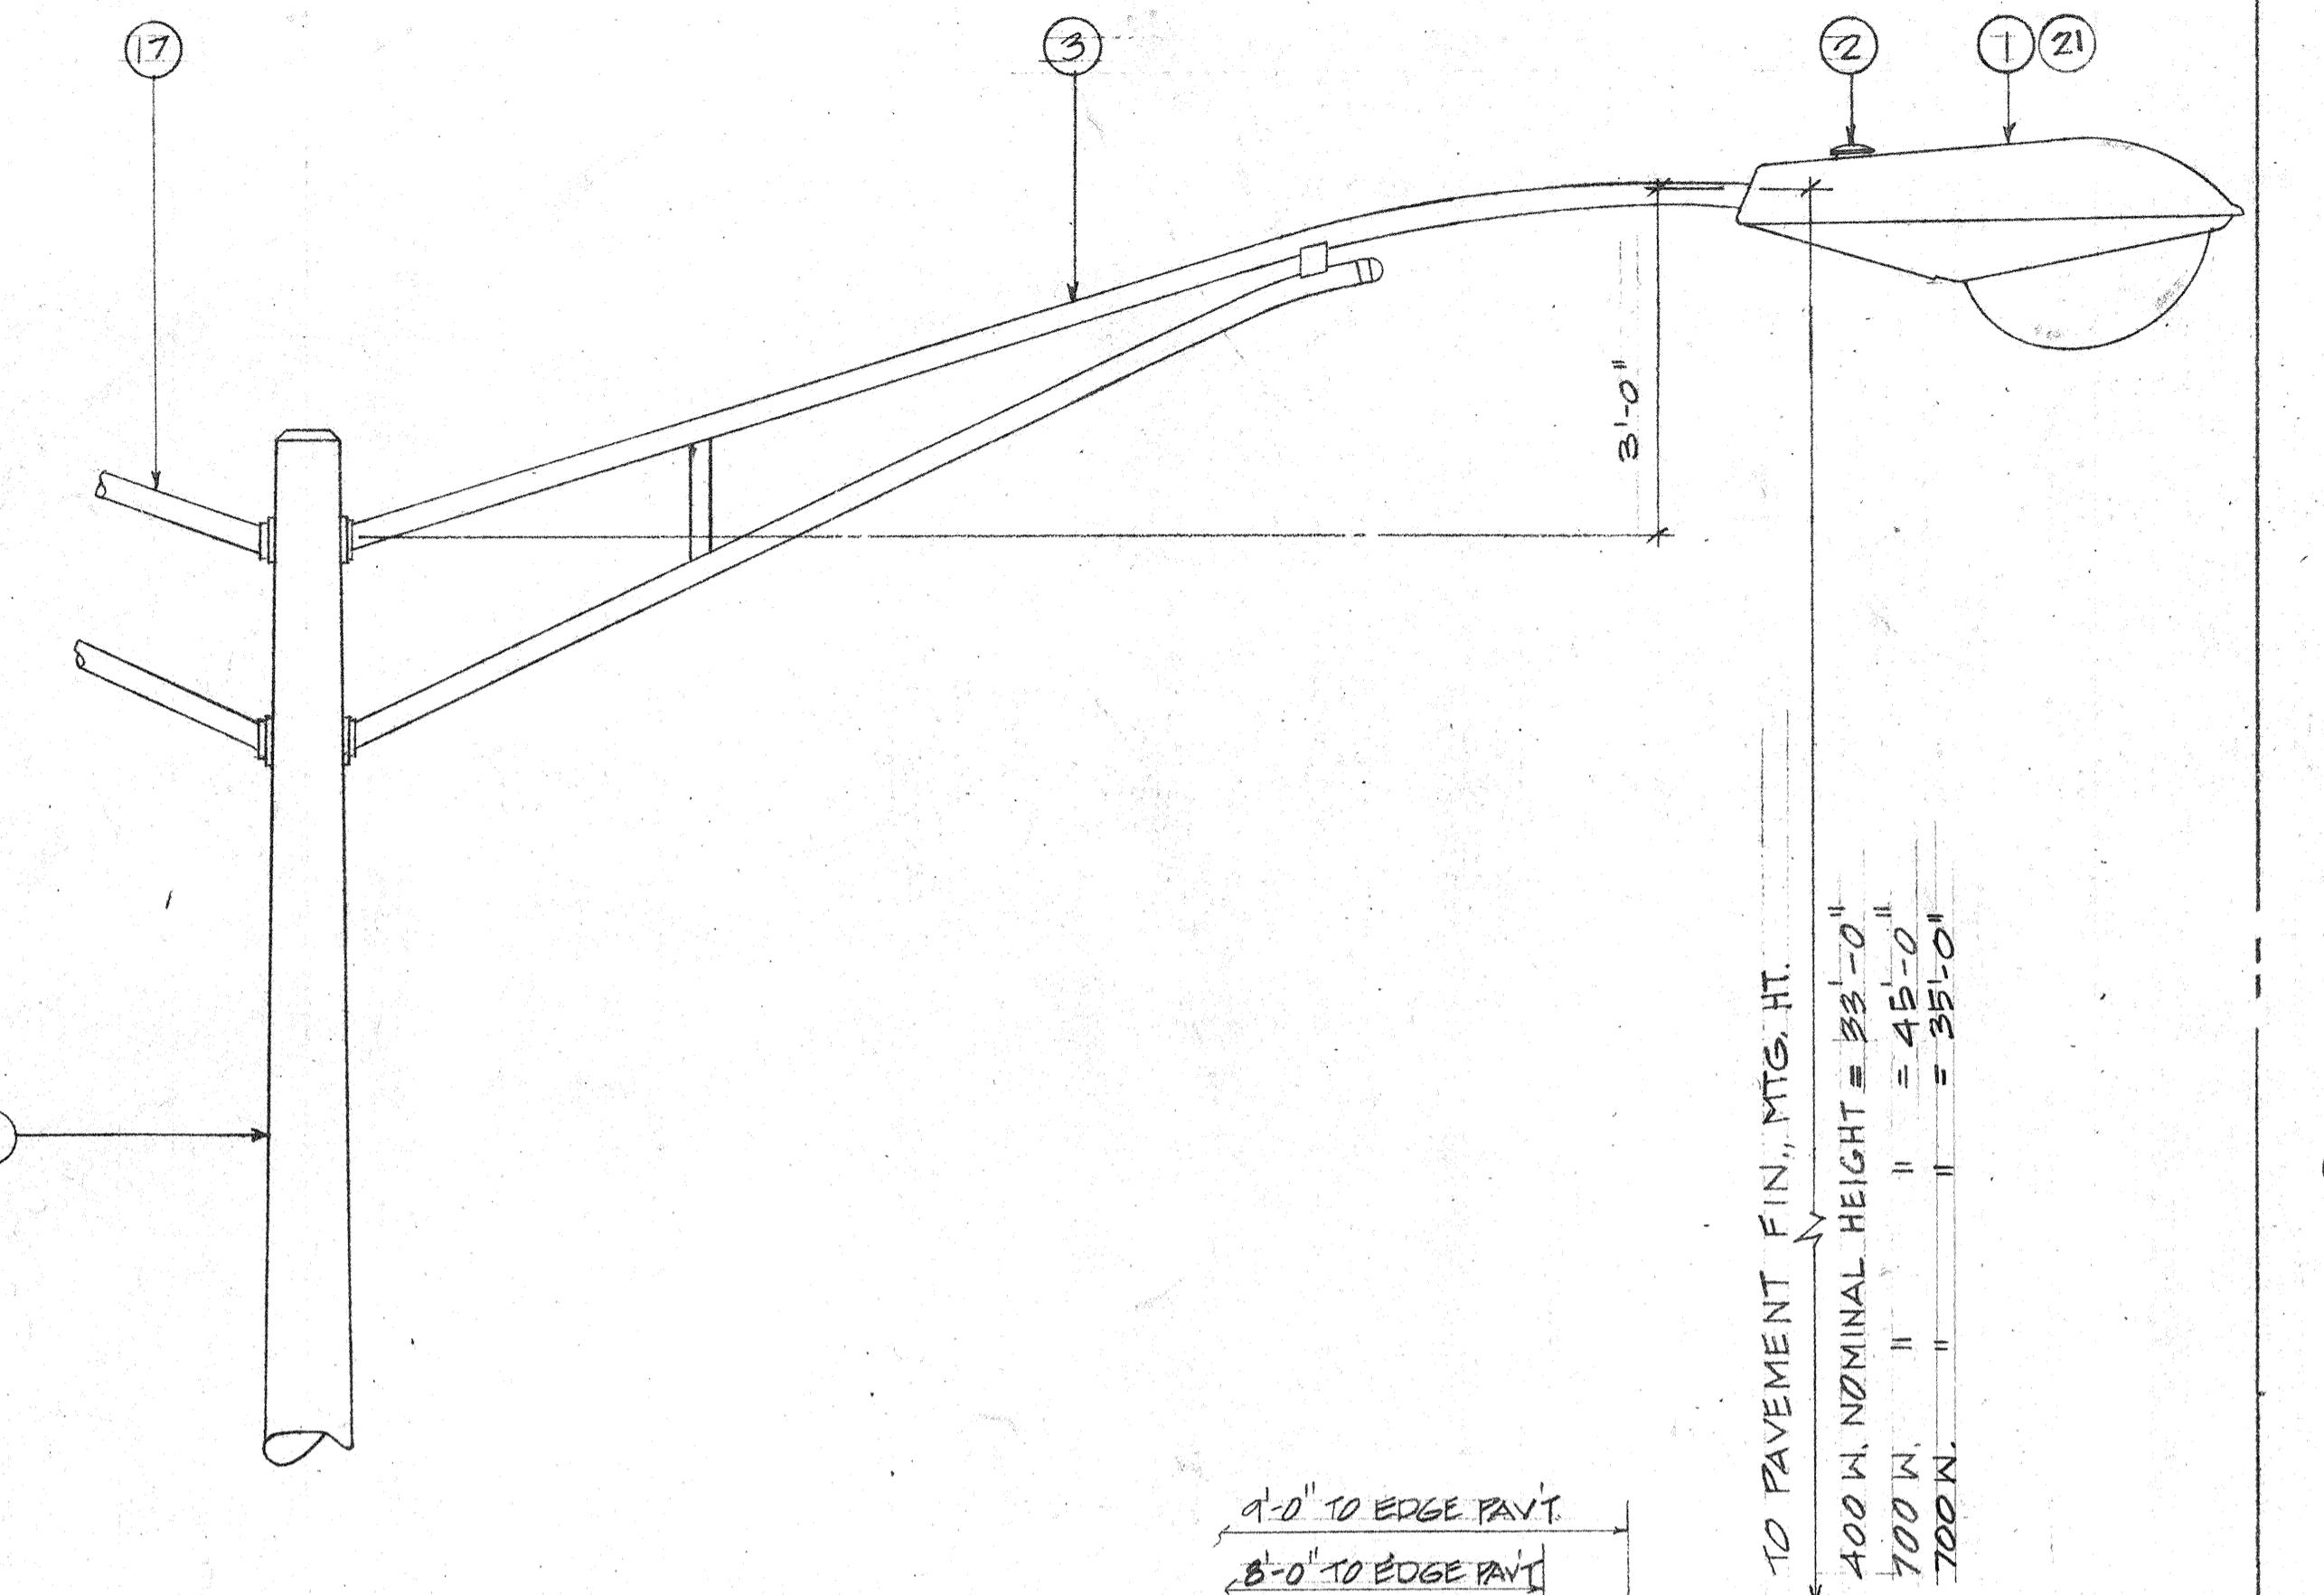

ELEVATION

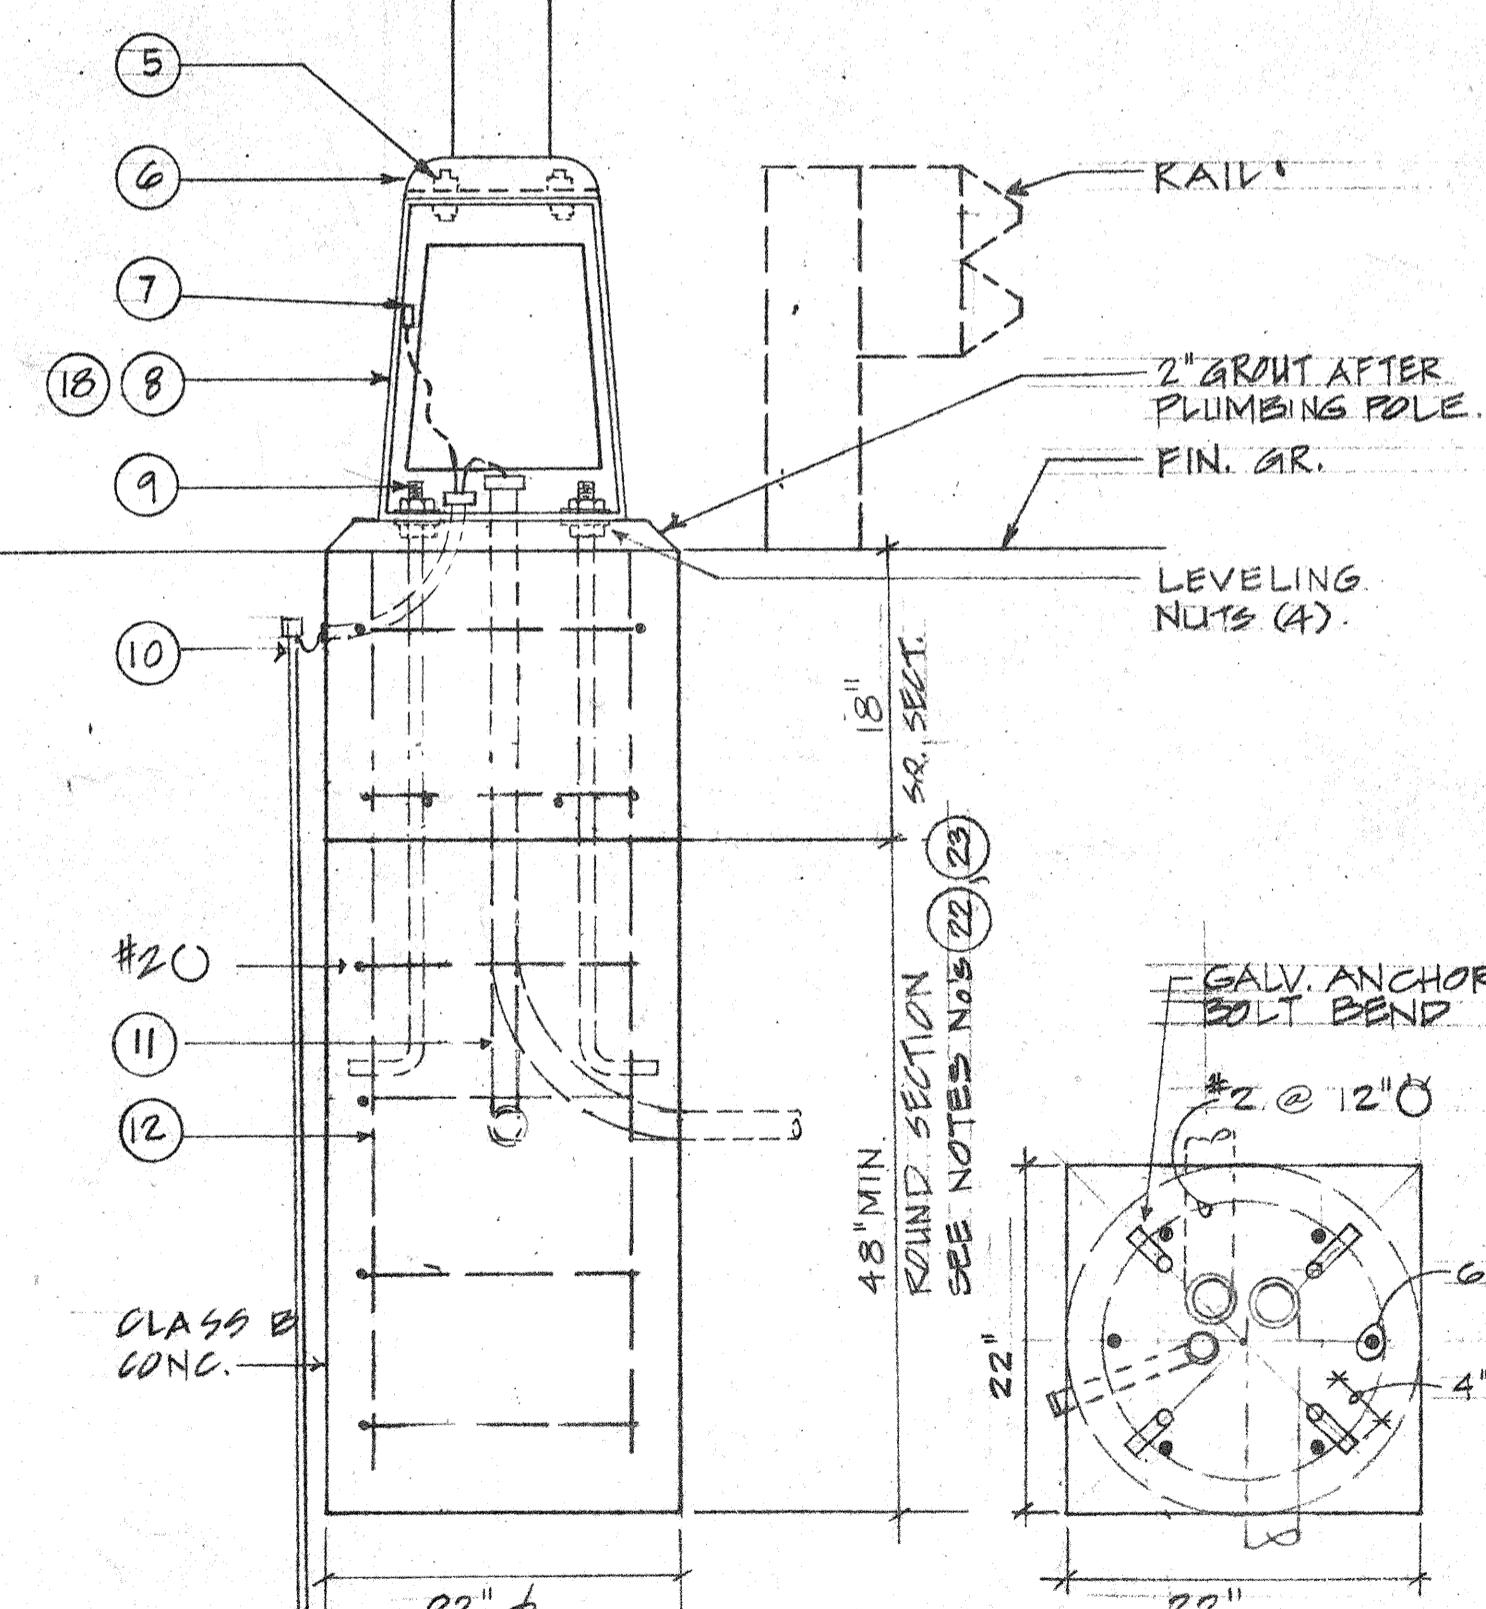

SECTION

PLAN

HIGHWAY LIGHTING STANDARD DETAIL

TYPE "A" FOR USE IN LEVEL AREA.


SCALE: 1" = 1'-0"

ORIGINAL PLAN SURVEY PLOTTED BY DRAWN BY TRACED BY DESIGNED BY CHECKED BY


FOUNDATION AT FILL

SEE NOTE (16)

SCALE: 1/8" = 1'-0"

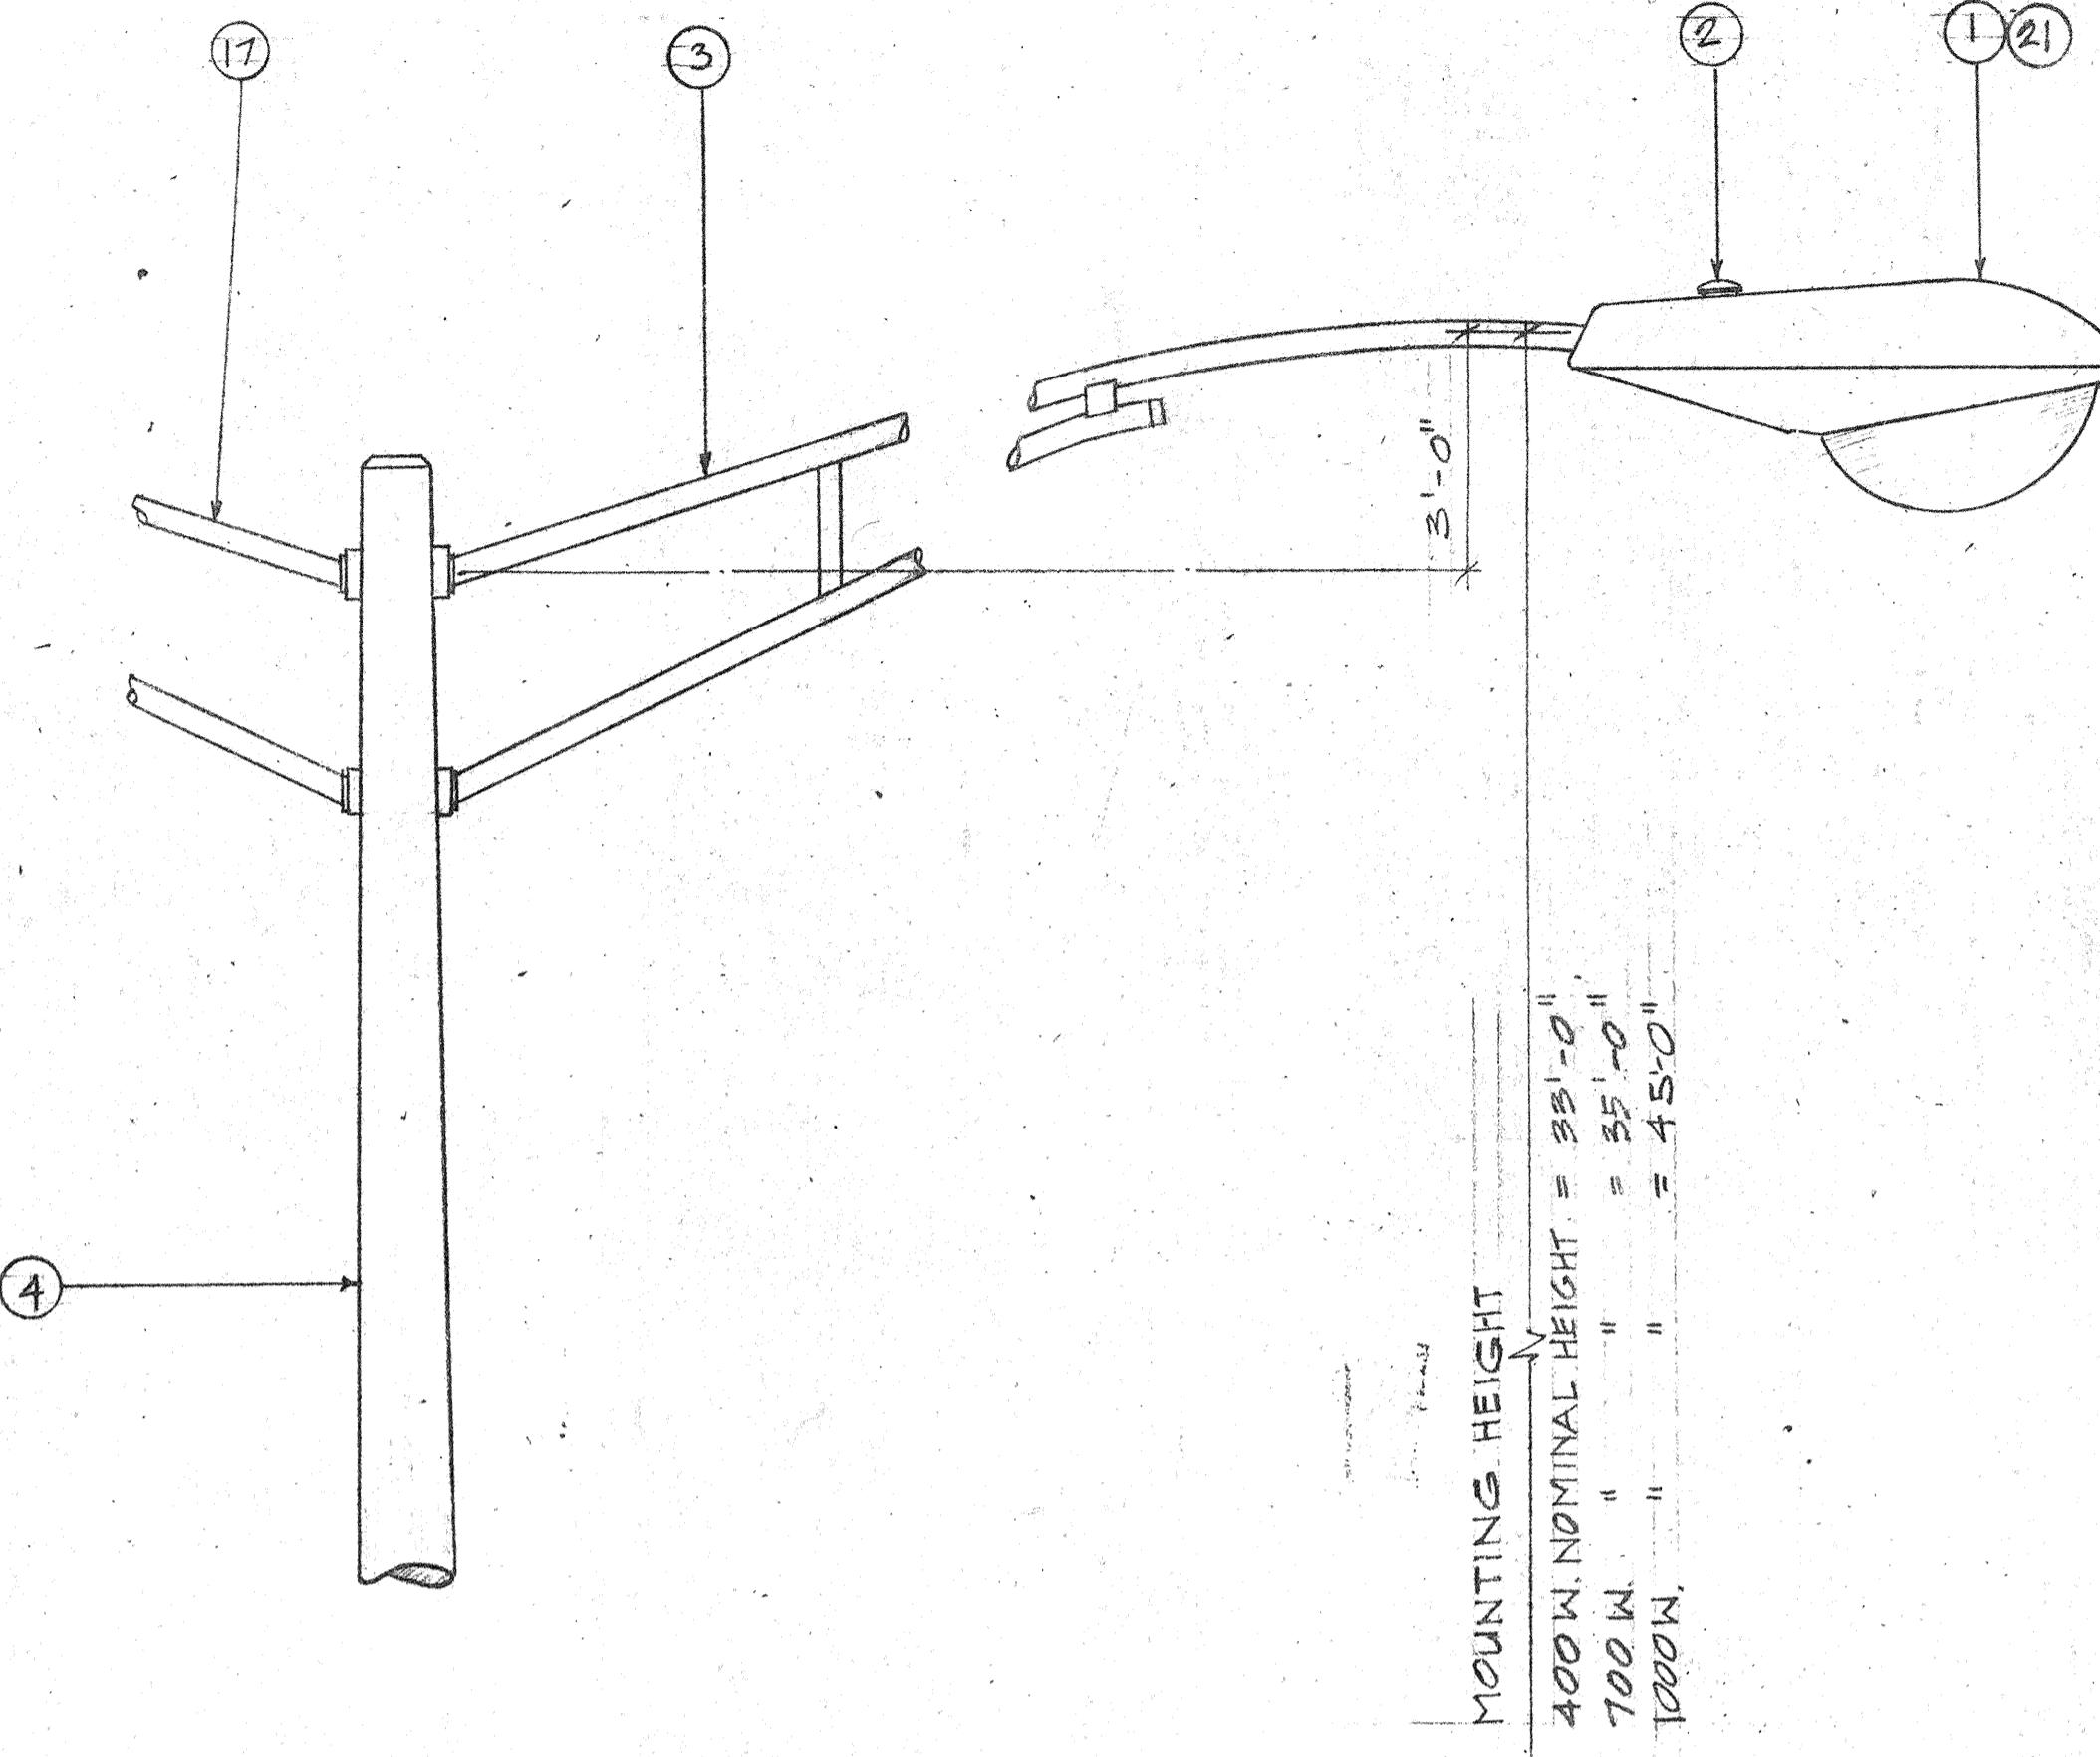

ELEVATION

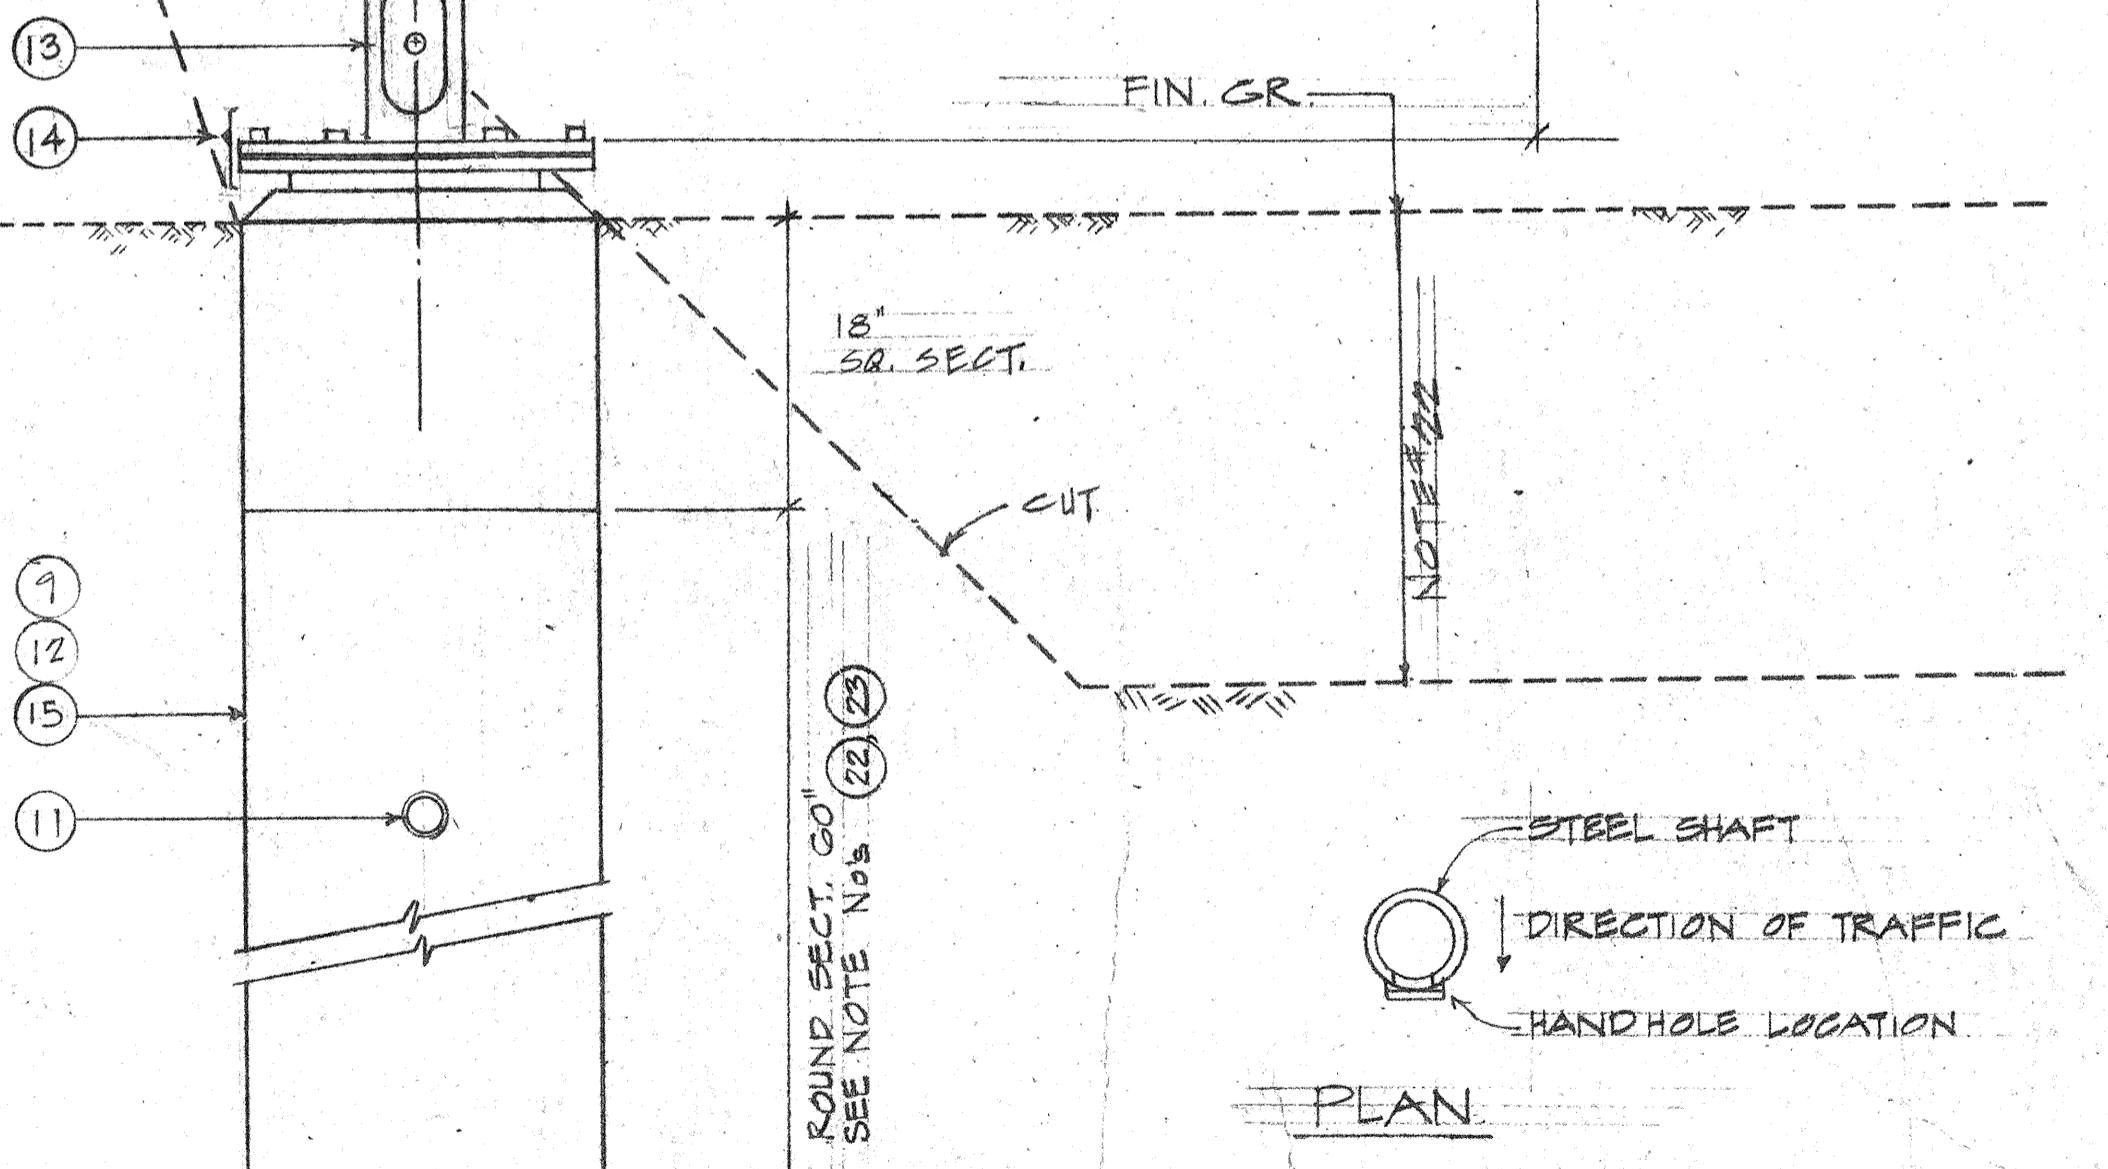

SECTION

HIGHWAY LIGHTING STANDARD DETAIL

TYPE "B" FOR USE IN CUT SLOPE



SCALE: 1" = 1'-0"

PRINTED ON NO. 1000 CLEARPRINT



This work was prepared by
me or under my supervision
Takao Kawanabe

FED. ROAD DIST. NO.	STATE	FED. AID PROJ. NO.	FISCAL YEAR	SHEET NO.	TOTAL SHEETS
HAWAII	HAW.	I-HI(112)19	1973	125	176

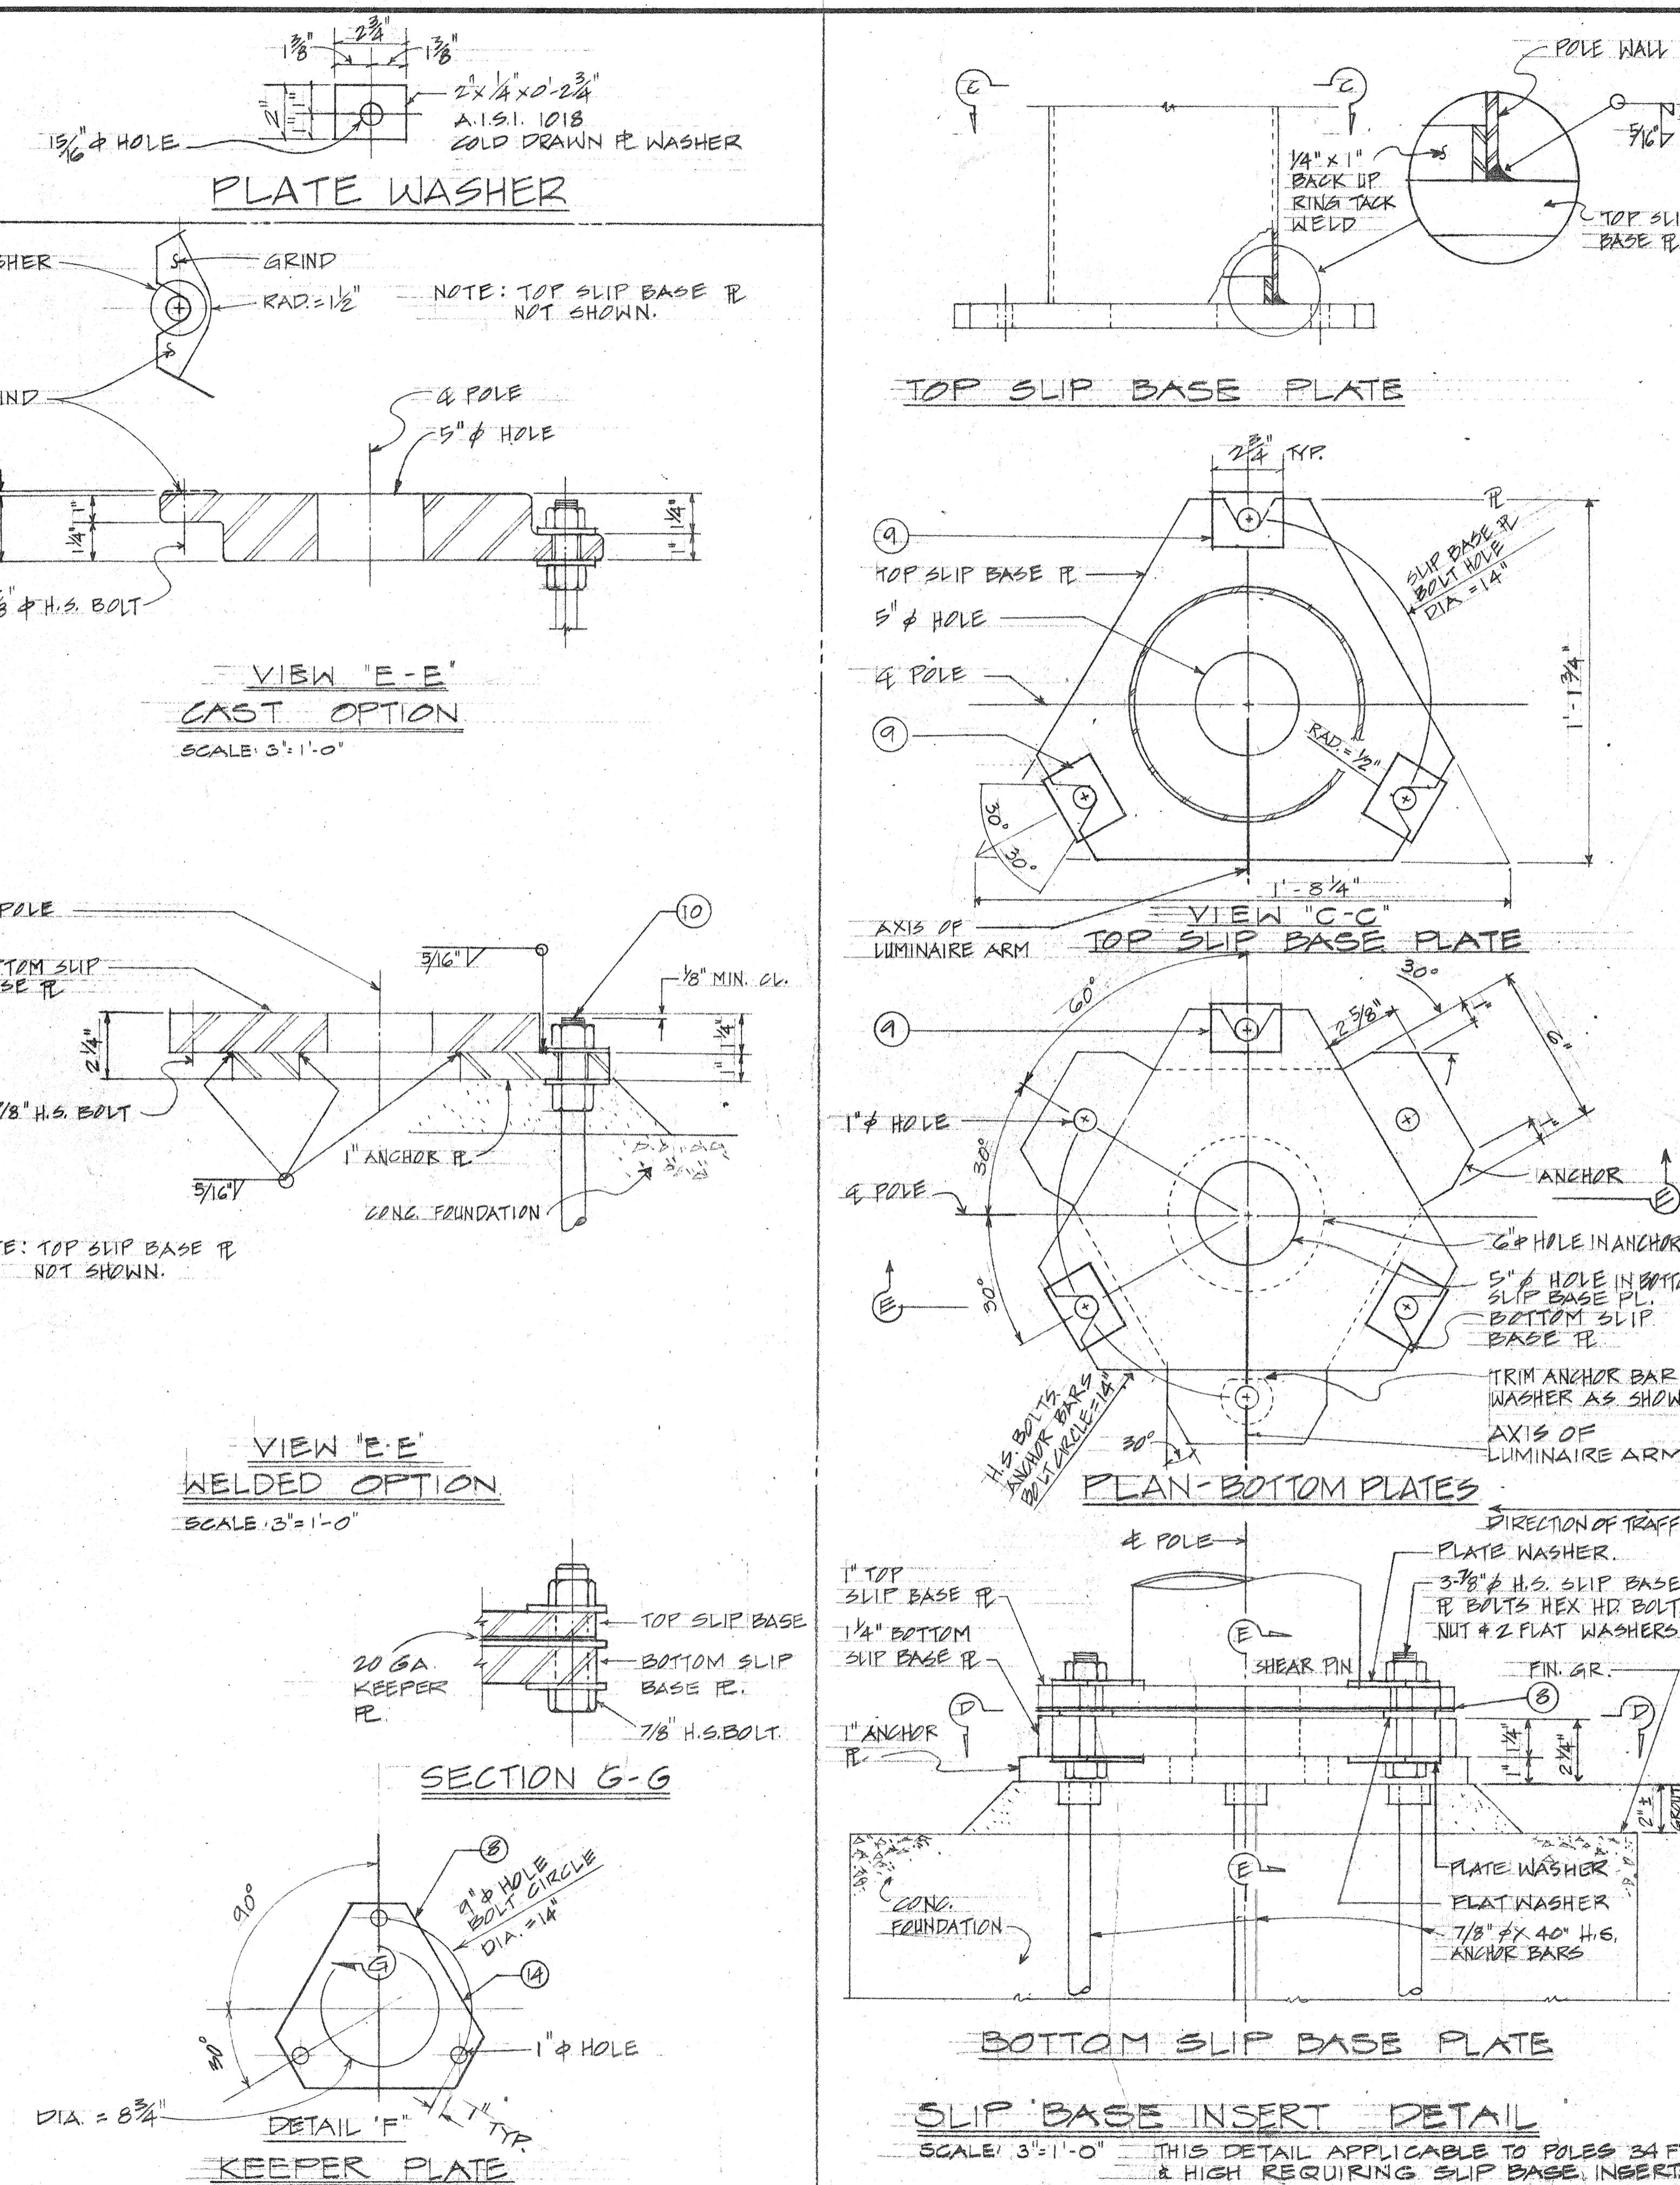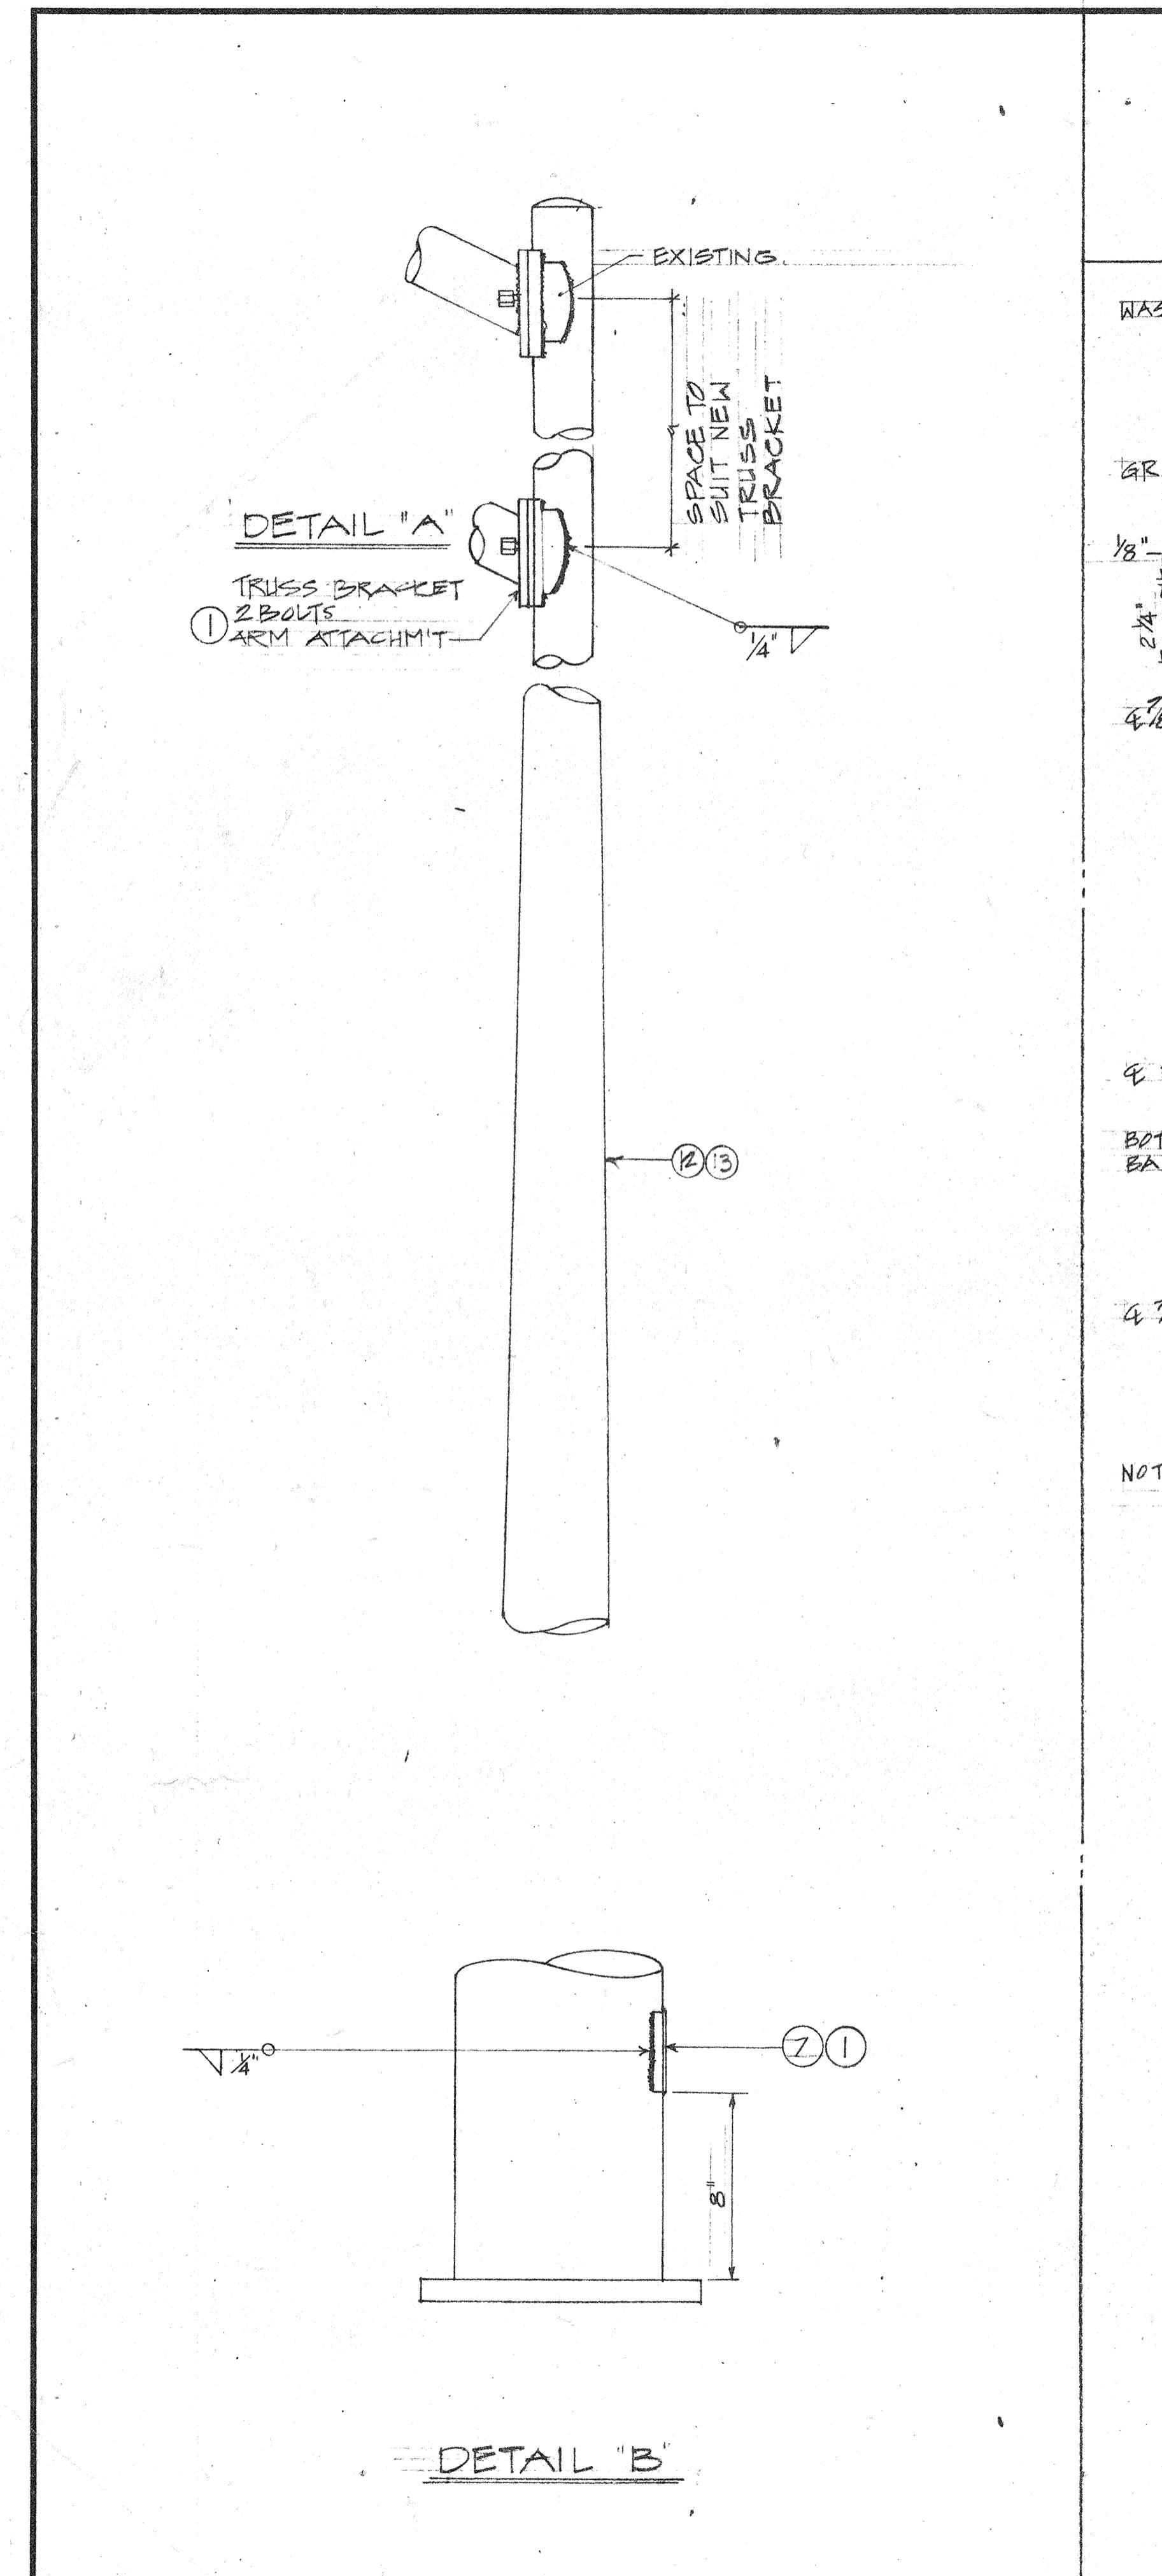

NOTES:


- ① ALL STEEL SHAFTS, P'S, MAST ARMS, BOLTS, SCREWS, NUTS & WASHERS TO BE GALV. AFTER FAB OR MODIFICATION.
- ② P'S TO CONFORM TO ASTM A-36.
- ③ CAST OPTION TO CONFORM TO ASTM A-486 CL. 90.
- ④ TORQUE $\frac{7}{8}$ " H.S. SLIP BASE P' BOLTS TO 1000 INCH LBS.
- ⑤ $\frac{7}{8}$ " H.S. ANCHOR BARS, WRENCH TIGHTEN - TORQUE REQUIREM'T. WAIVED.
- ⑥ FABRICATORS ELECTING LARGER THAN MIN. ARM DIAMETERS MUST ADJUST DETAILS AS REQ'D. TO PERMIT SOLID SEATING OF CAP SCREWS. IN LIEU OF TORQUE REQUIREM'TS FOR H.S. BOLTS, CAP SCREWS SHALL BE TIGHTENED BY THE TURN-OF-NUT METHOD & TURN FROM SNUG TIGHT CONDITION. NO WASHER WILL BE REQ'D.
- ⑦ 4" X 6 1/2" HANDHOLE REINFORCED W/ #3 GA. RING 1 1/2" WIDE WELDED TO OUTSIDE OF POLE COVER OF 10 GA. PL. LOCATE 90 DEGREES OF MAST. ARM UNLESS SHOWN OTHERWISE. SEE TLK. 9L.
- ⑧ 20 GA. KEEPER P', PLACE ON TOP OF MIDDLE FLAT WASHER ASTM A446 GR. "A".
- ⑨ PLATE WASHER.
- ⑩ 3-7/8" H.S. BARS, THREAD 6" & GALV. 10", W/ HEX. HD. NUT, LEVELING NUT & WASHER.
- ⑪ HEX. HD. NUT SHOWN OR AS AN ALT. DET. ANCHOR P'S MAY BE RETAINED W/ 5/16" FILLET WELDS. ALL ROUND OR FORMED HEADS.
- ⑫ ROUND TAPERED STEEL TUBE W/ MAX. TAPER OF 0.15"/FOOT.
- ⑬ NO. 11 GAGE SHEET STEEL OF WELDABLE GRADE ACCEPTABLE IF STEEL AFTER FABRICATION HAS A MIN. YIELD STRENGTH OF 40,000 PSI.
- ⑭ 20 GA. KEEPER P', PLACE ON TOP OF FLAT WASHER, A.S.T.M. A526, 125 COMMERCIAL.
- ⑮ SLIP BASE INSERT DET. ON THIS SHEET APPLICABLE FOR POLE STD'S. TALLER THAN 34'-0".

STATE OF HAWAII
DEPARTMENT OF TRANSPORTATION
HIGHWAYS DIVISION
HIGHWAY LIGHTING
SLIP BASE INSERT AND
POLE MODIFICATION
SAFETY IMPROVEMENT
KALIHI STREET TO PALI HIGHWAY
FAI PROJECT NO. I-HI-1(112)19
SCALE AS NOTED
DATE: APR. 1973
SHEET NO. 15 OF 181 SHEETS


FED. ROAD DIST. NO.	STATE	FED. AID PROJ. NO.	FISCAL YEAR	SHEET NO.	TOTAL SHEETS
HAWAII	HAW.	I-HI-1(112)19	1973	126	176

NOTES:

1. BACKFILL, TYPE A, BEACH SAND, EARTH OR EARTH & GRAVEL, IF EARTH & GRAVEL THE MAX. ROCK SIZE SHALL BE 1" & THE MIX. SHALL NOT CONTAIN MORE THAN 50% BY VOL. OF ROCK PARTICLES.
2. BACKFILL, TYPE B, BEACH SAND, EARTH OR EARTH & GRAVEL, IF EARTH & GRAVEL THE MIX. MUST PASS A $\frac{1}{8}$ " MESH SCREEN & CONTAIN NOT MORE THAN 20% BY VOL. OF ROCK PARTICLES.
3. CONDUIT, 2" PVC. SCH'D. AD.
4. PRIM. CONN. USED ONLY BETWEEN BALLASTS & LUMINAIRE IN POLE SHAFT ACCESSIBLE VIA HANDHOLE FOR SERIES-CKT.
5. FOR CONDUIT POSITION, SEE SH. 7L.
6. 2" HIGH X $\frac{1}{2}$ " DEEP LETTER ENGRAVED IN MARKER.
7. REPLACE MULTIPLE CKT. ID TAG AFFECT BY CHANGES IN REQUIREMENTS (CONTRACT NO., LT. NO., LAMP DATA, REFRACTOR DATA OR POST NO.)

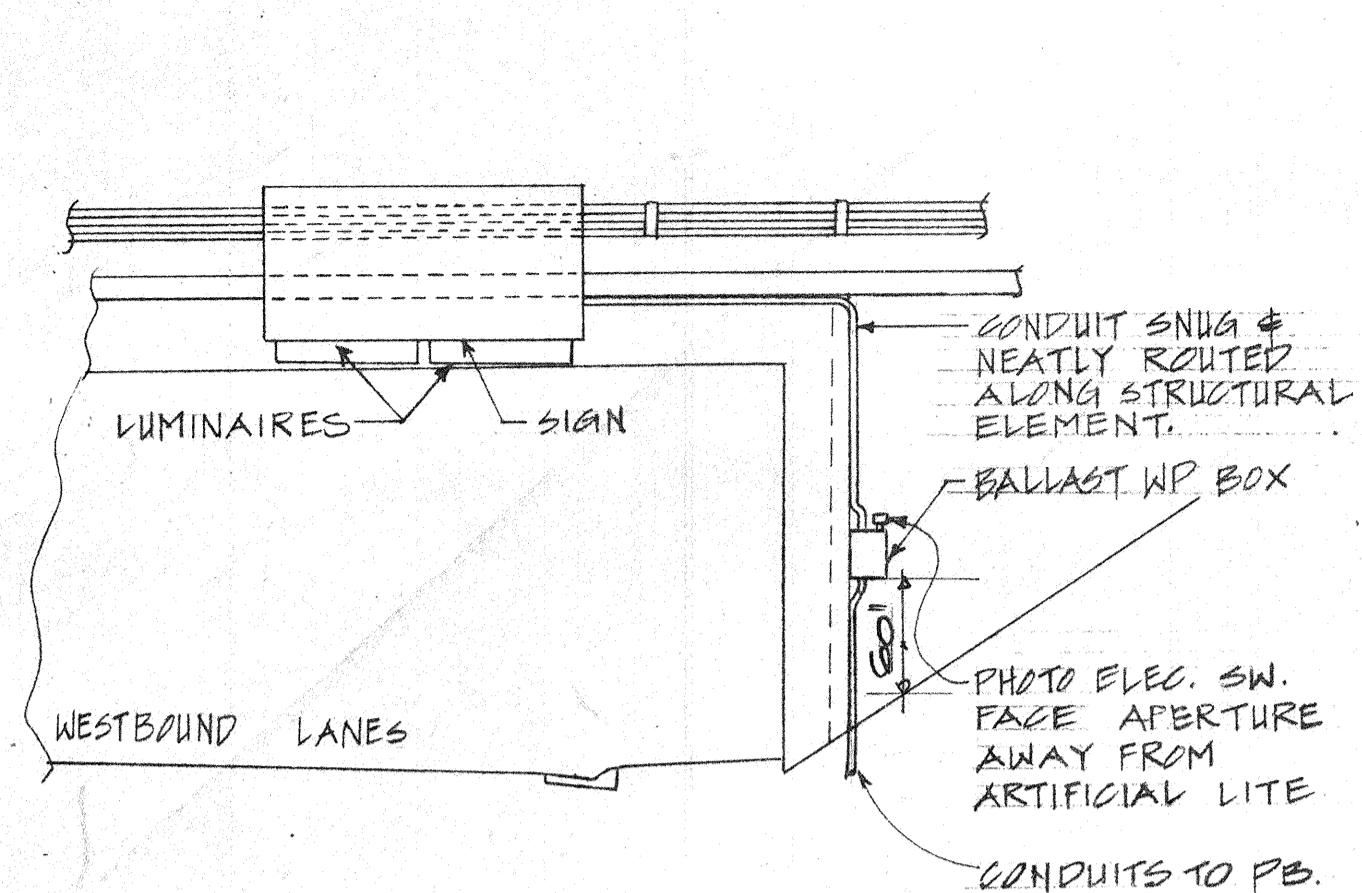

SIGN ON STRUCTURE NO. 6
INTERSTATE HI-1 AT LIUHA ST.
STA. 112 + 62

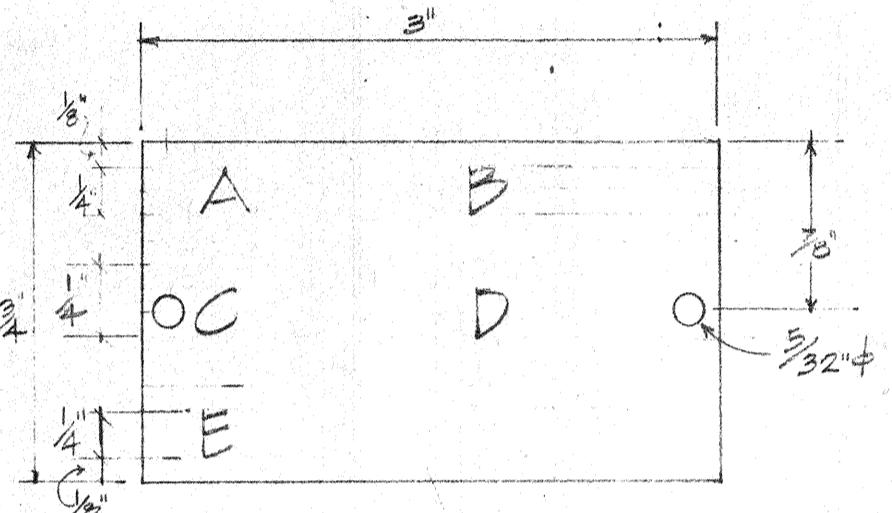

- NOTES:
 1. USE 3PLY PLASTIC BLK-WHITE-BLK.
 2. ENGRAVE NOMENCLATURE NUMBER 4" HIGH X $\frac{1}{2}$ " WIDE, COMMERCIAL GOTHIC FORM.
 (NATTAGE, IES DISTRIB, VOLTAGE OR SYSTEM TYPE)
 3. IF MULTIPLE-CKT. FROM HECO, ENGRAVE CONTRACT NO.



4. ATTACH TO POLE w/ No. 7 CAPMIUM PLATED DRIVE SCREWS.
 5. USE "H" FOR MERCURY VAPOR

6. LEGEND:
 A. CONTRACT NO.
 B. LIGHT NO.
 C. LAMP DATA
 D. REFRACTOR DATA
 E. POST NO.
 F. ATTACH ON POLE +5'-0"
 G. SUBMIT A LIST OF TAG. SCH'D. FOR APPROVAL BEFORE ENGRAVING.

IDENTIFICATION TAG
N.T.S. NOTE #7


PRIMARY CONNECTOR

N.T.S.
NOTE #4.

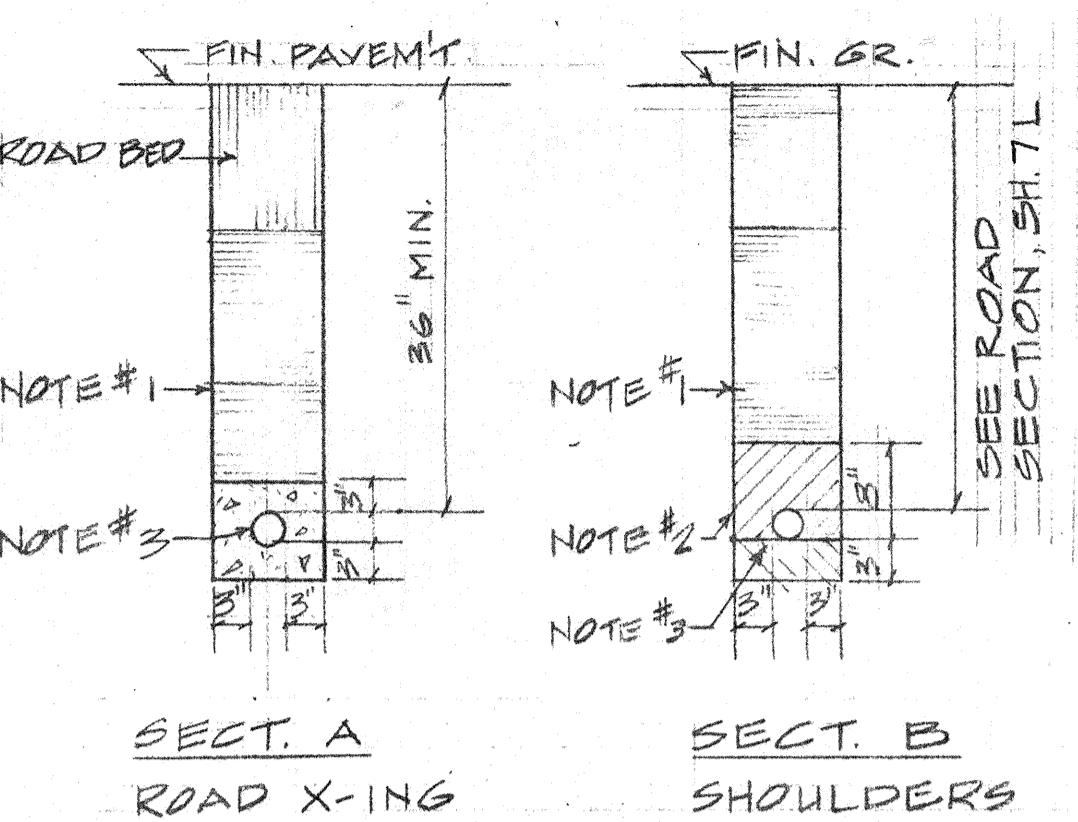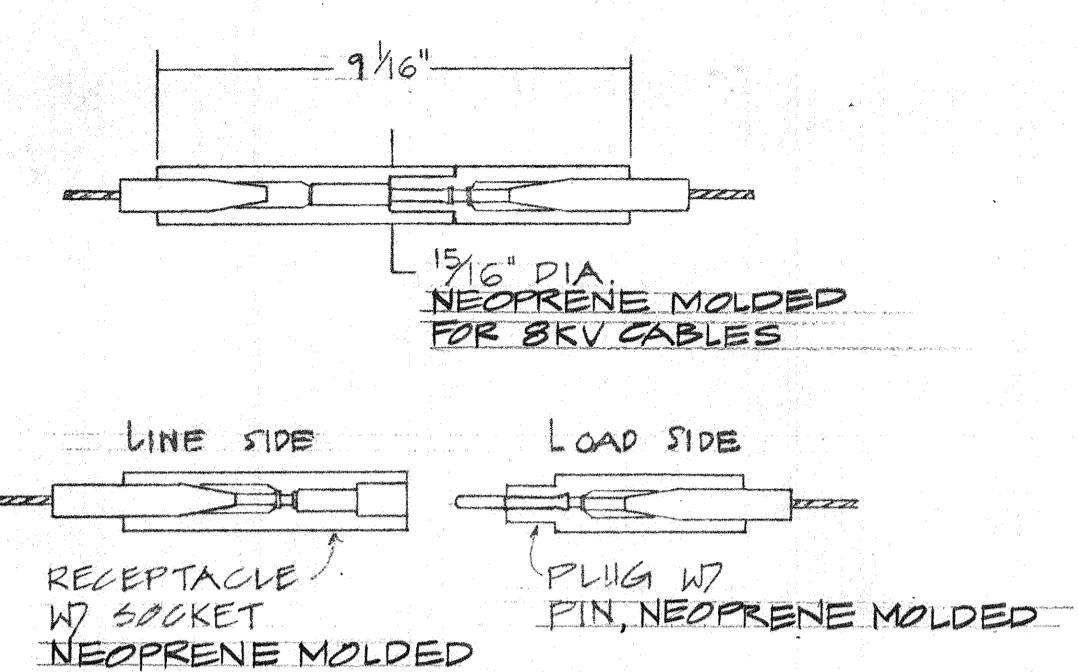


TYPICAL DUCT SECTIONS

NOTE #5

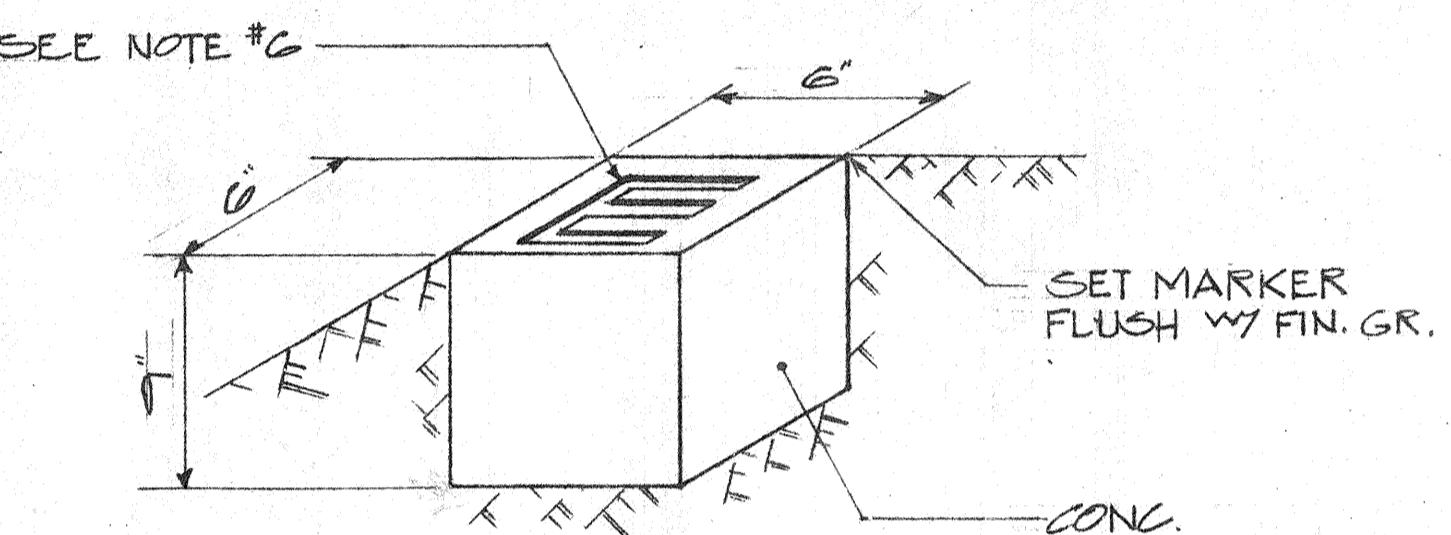


MARKER FOR STUB-OUT

N.T.S.

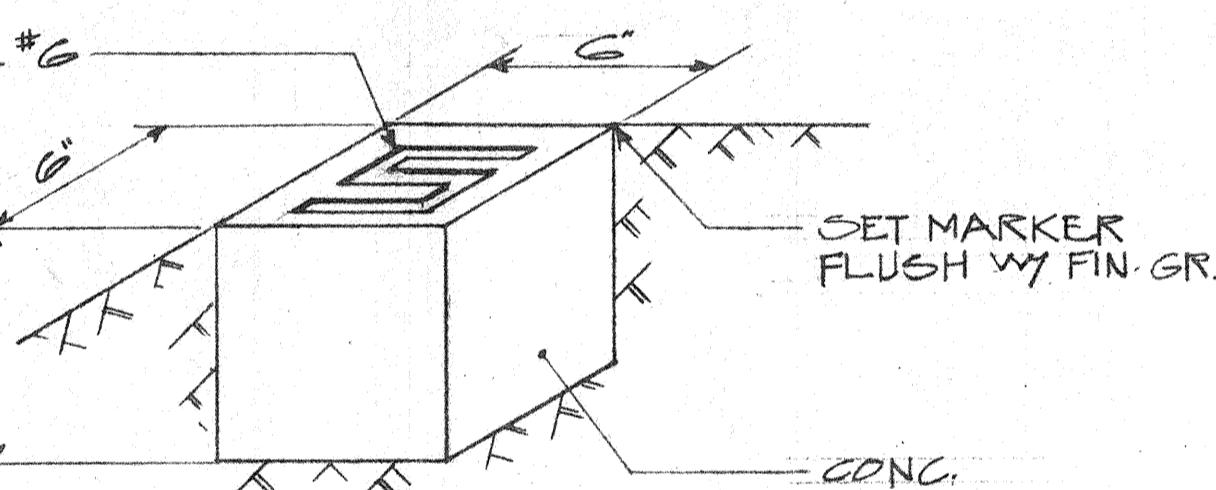


MARKER FOR CABLE SPLICE

N.T.S.

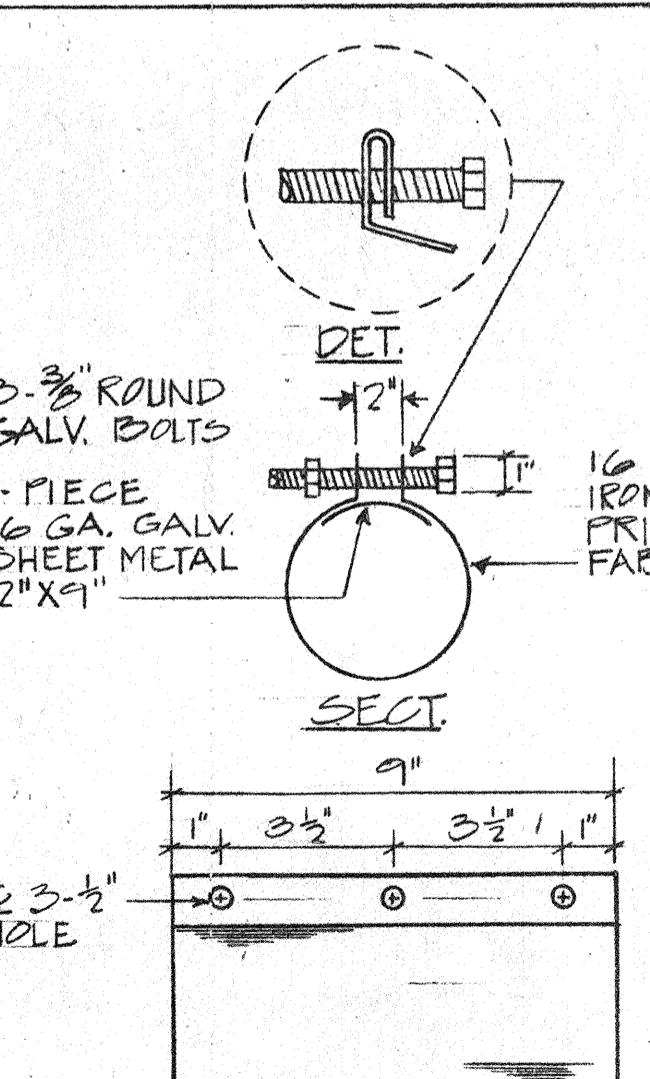

ELEV.
3 BOLT CLAMP DET.
SCALE: 3" = 1'-0"

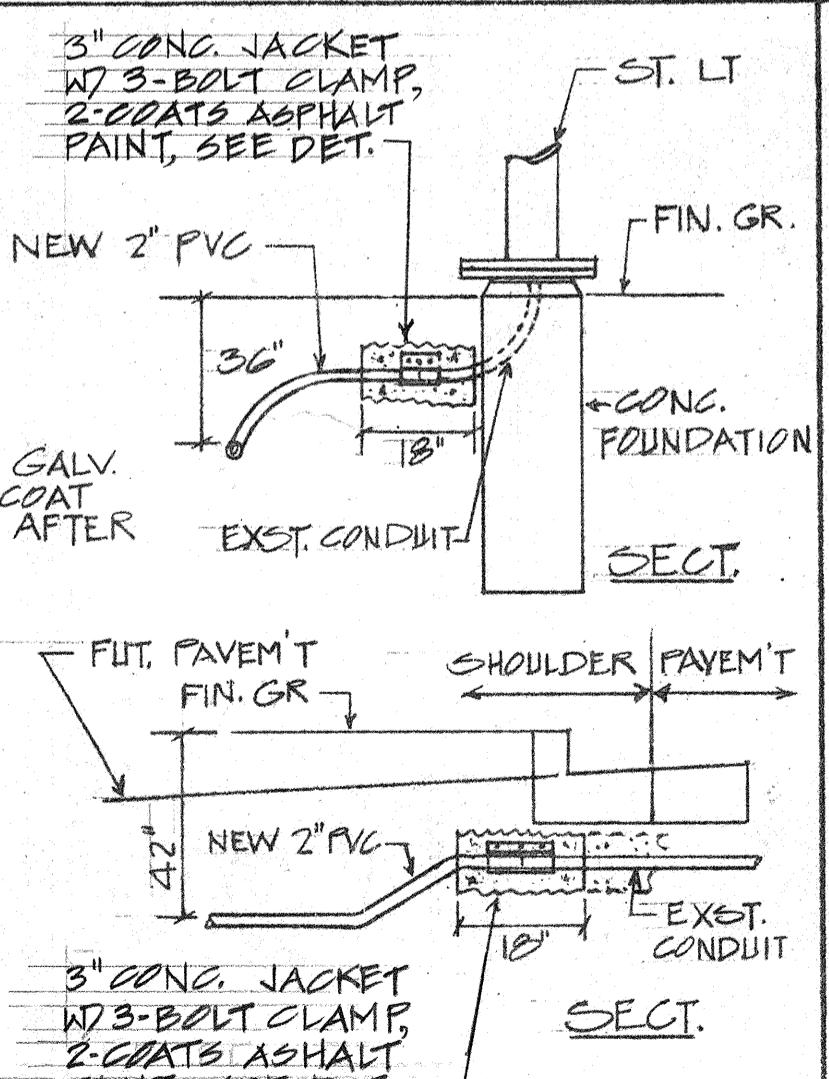

TYP. CONDUIT CONNECTIONS
N.T.S.

ORIGINAL PLAN	SURVEY PLOTTED BY
DRAWN BY	TRACED BY
DESIGNED BY	QUANTITIES BY
NOTE BOOK	CHECKED BY
No. _____	_____

PRINTED ON NO. 1000 CLEARPRINT



THIS WORK WAS PREPARED BY
ME OR UNDER MY SUPERVISION





Takut Kawahata

STATE OF HAWAII
DEPARTMENT OF TRANSPORTATION
HIGHWAYS DIVISION
HIGHWAY LIGHTING
MISC. ELECTRICAL DETAILS
SAFETY IMPROVEMENT
KALIHI STREET TO PALI HIGHWAY
F.A.T. PROJECT NO. I-HI-1(112)19
SCALE: AS NOTED DATE: APR. 1973
SHEET NO. 1GLOF 18L SHEETS

1 (6) (5)

(1)


FED. ROAD DIST. NO.	STATE	FED. AID PROJ. NO.	FISCAL YEAR	SHEET NO.	TOTAL SHEETS
HAWAII	HAW.	I-HI-1(112)19	1973	127	176

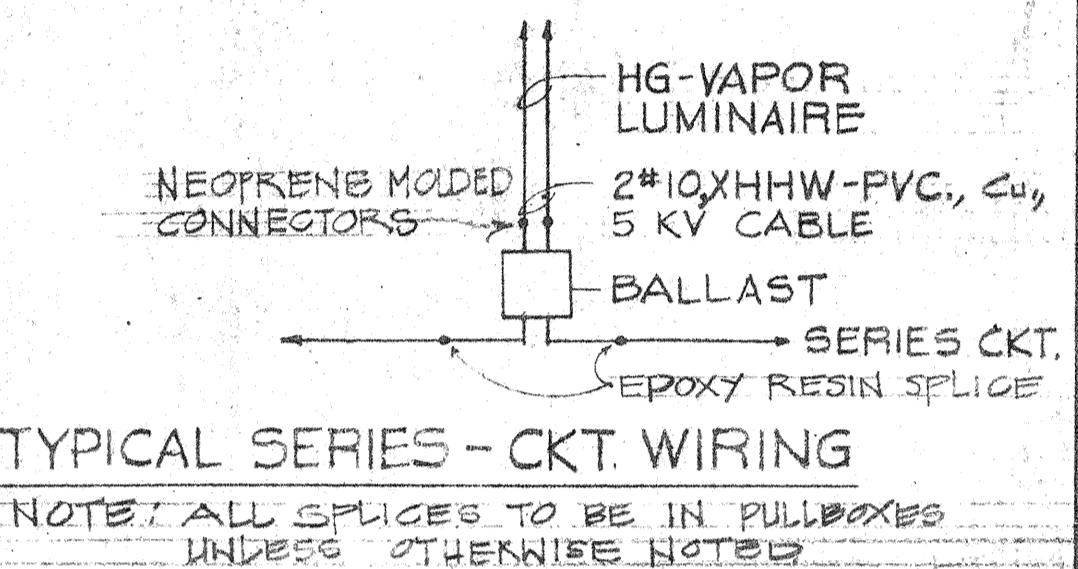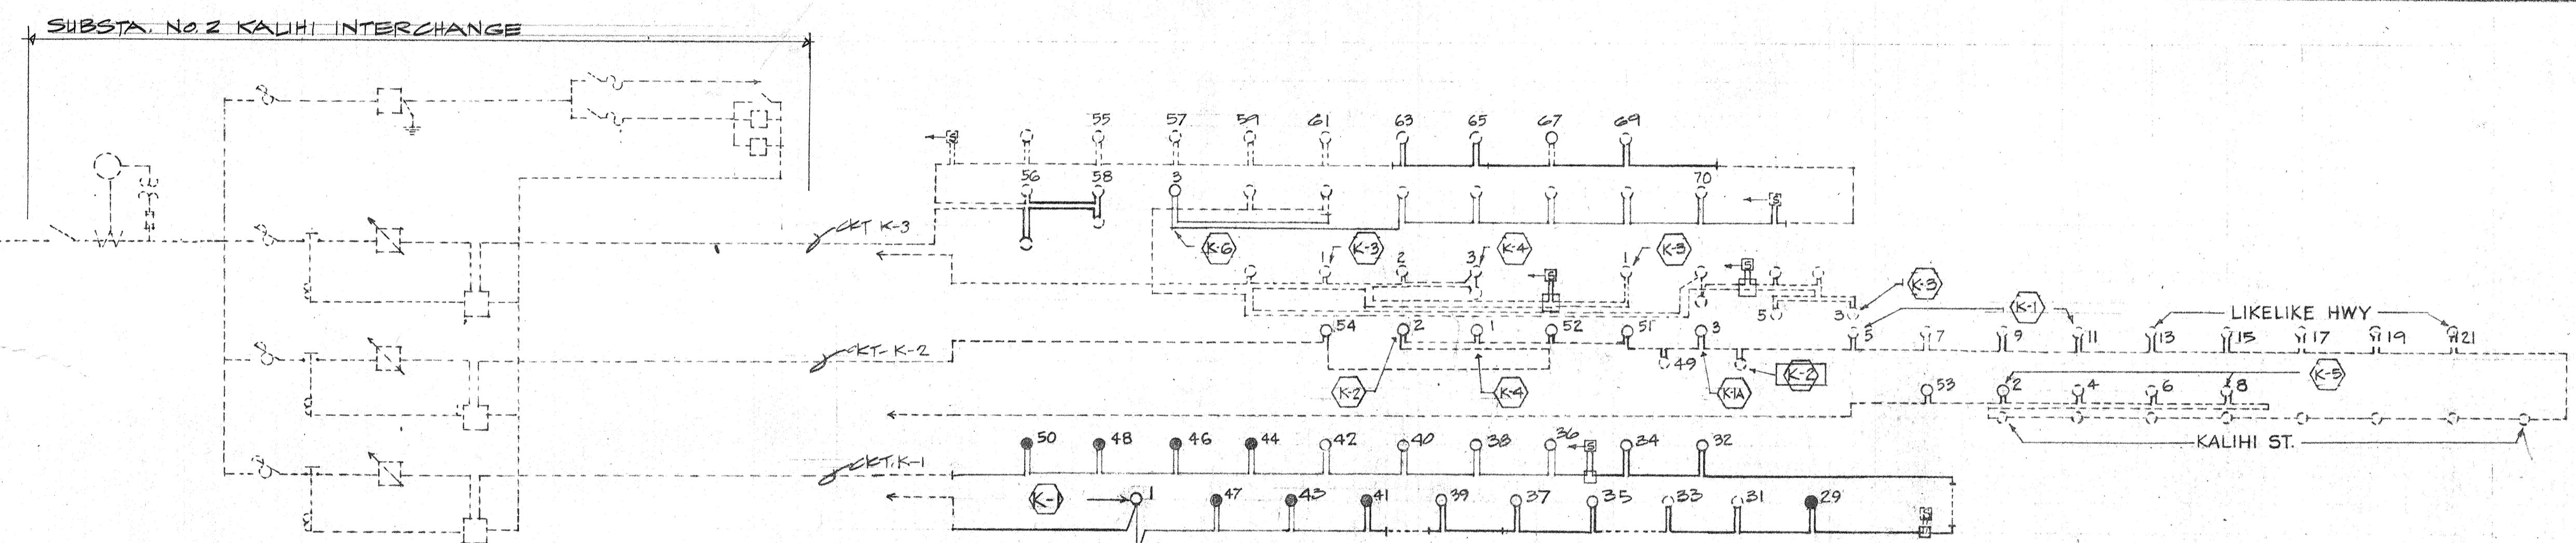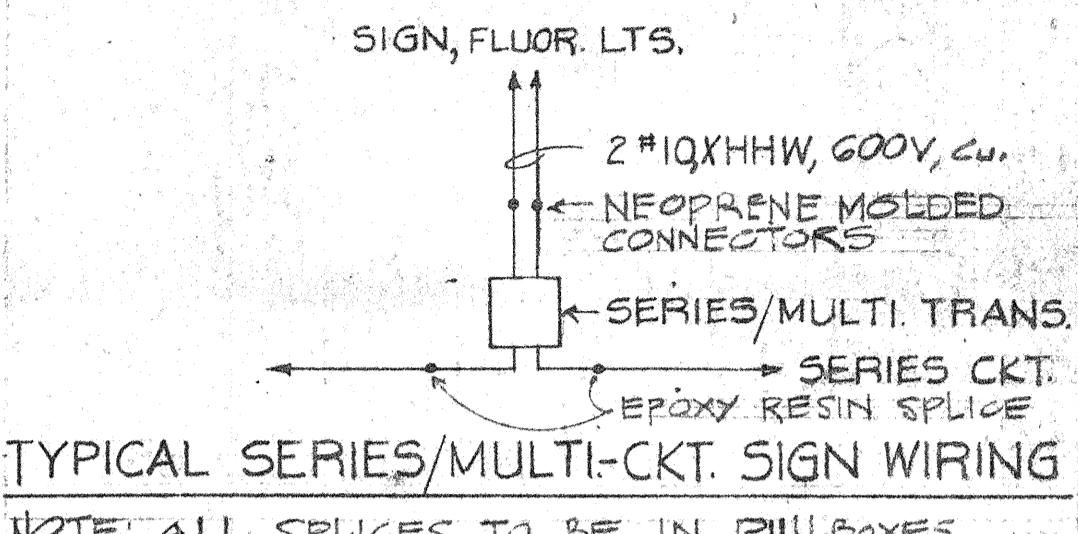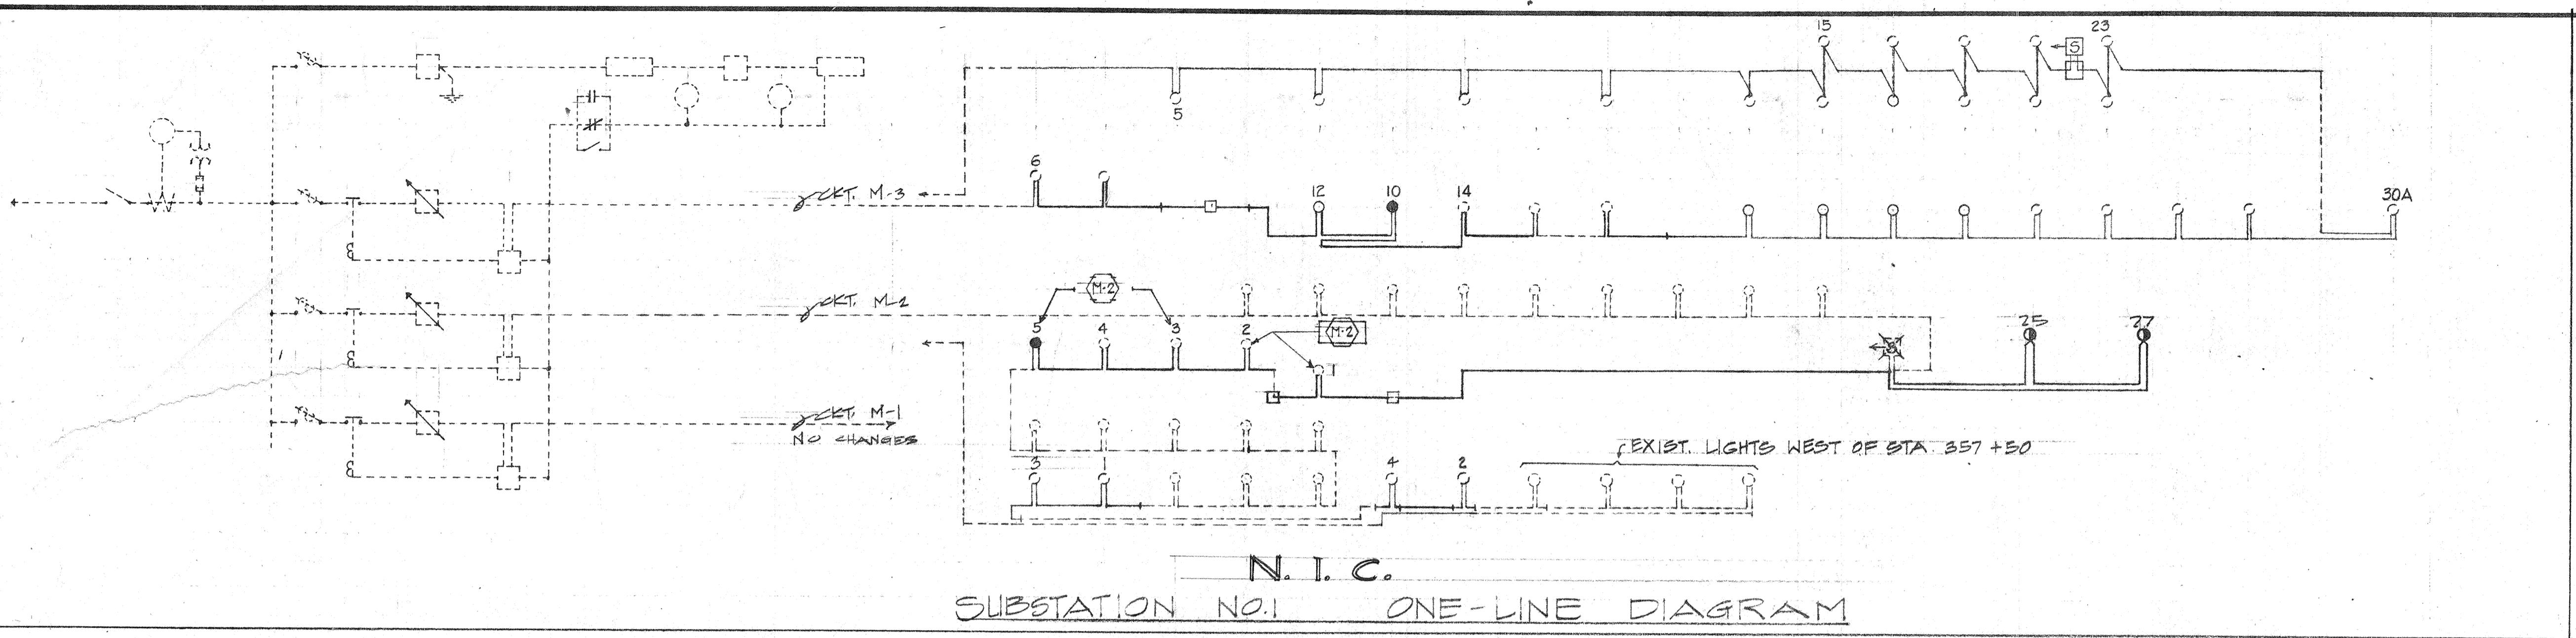

SYMBOLS

(K)	INDICATOR FOR RAMP ASSIGNMENT
●	700W HG-VAPOR
○	400W HG-VAPOR
-■-	ILLUM. SIGN
—	EXIST. CABLE
—	NEW CABLE W/2" PVC, 36" DEEP
◎	1000W HG-VAPOR

NOTES:
 1. BROKEN LINES DENOTE EXIST. SOLID LINES DENOTE NEW WORK.

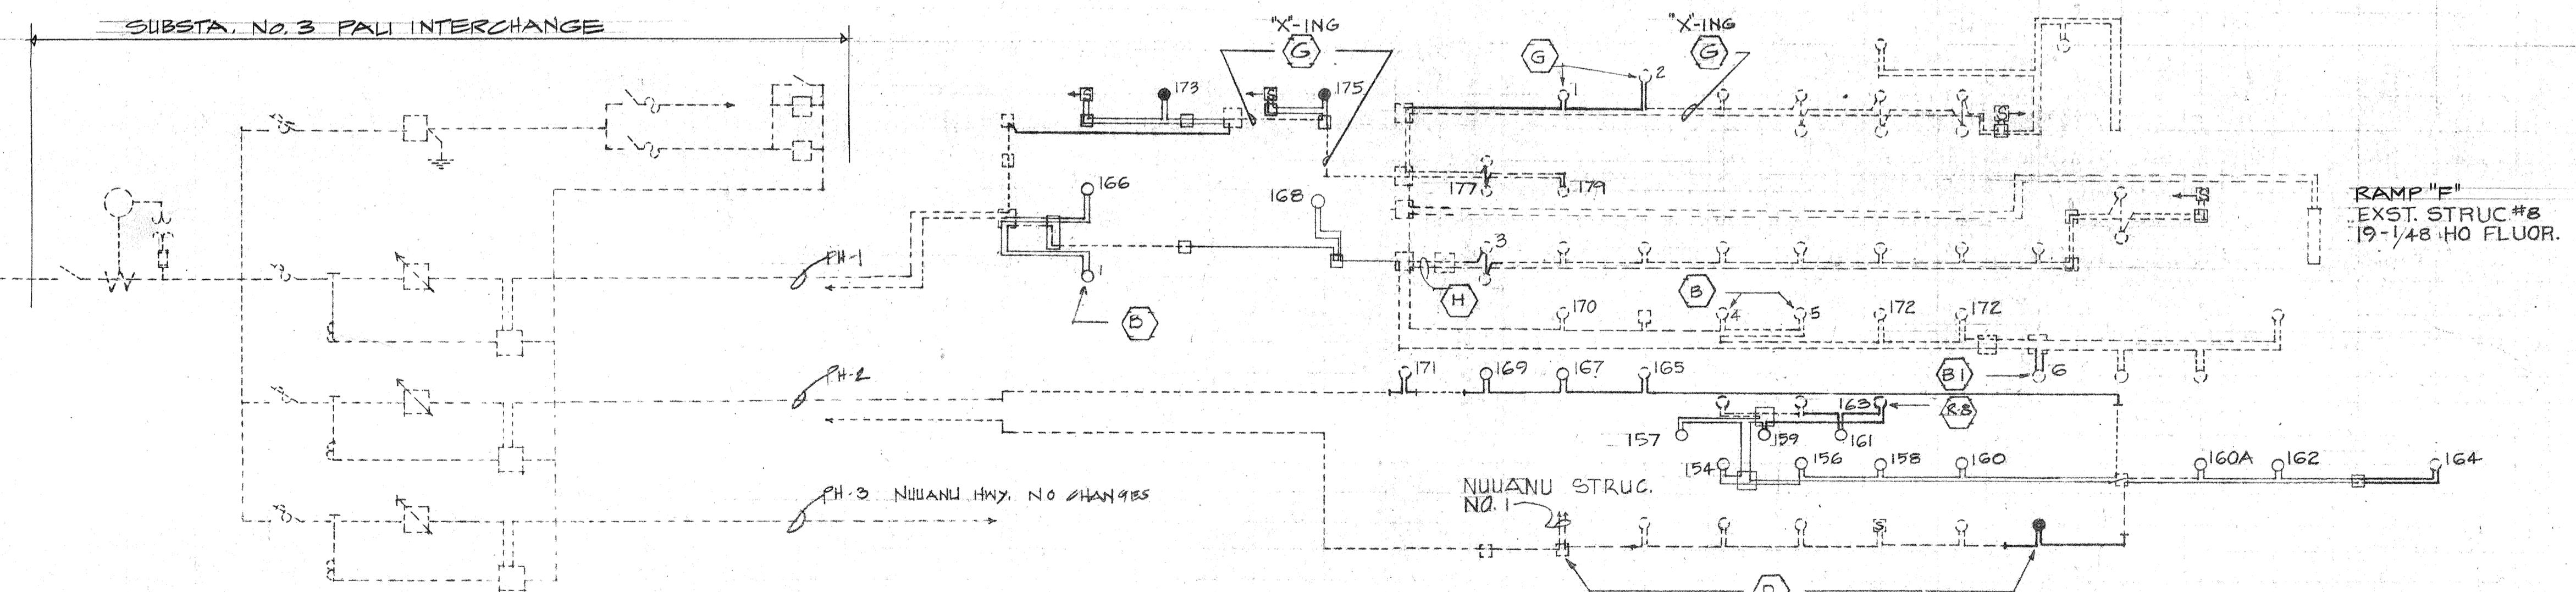

KALIHI STREET TO PALI HIGHWAY
 FAI PROJECT NO. I-HI-1(112)19

DATE APR, 1973
 SHEET NO. 17 LOF 18 SHEETS


Tabut K. Kawamoto

ORIGINAL PLAN
DRAWN BY
DESIGNED BY
QUANTITY BY
CHECKED BY
NO. _____

FED. ROAD DIST. NO.	STATE	FED. AID. PROJ. NO.	FISCAL YEAR	SHEET NO.	TOTAL SHEETS
HAWAII	HAW.	I-HI-I(112)19	1973	120	176

SYMBOLS


- 400W Hg. VAPOR
- 700W Hg. VAPOR
- ILLUM. SIGN
- - - EXIST. CABLE
- NEW CABLES W/ 2" PVC, 36" DEEP

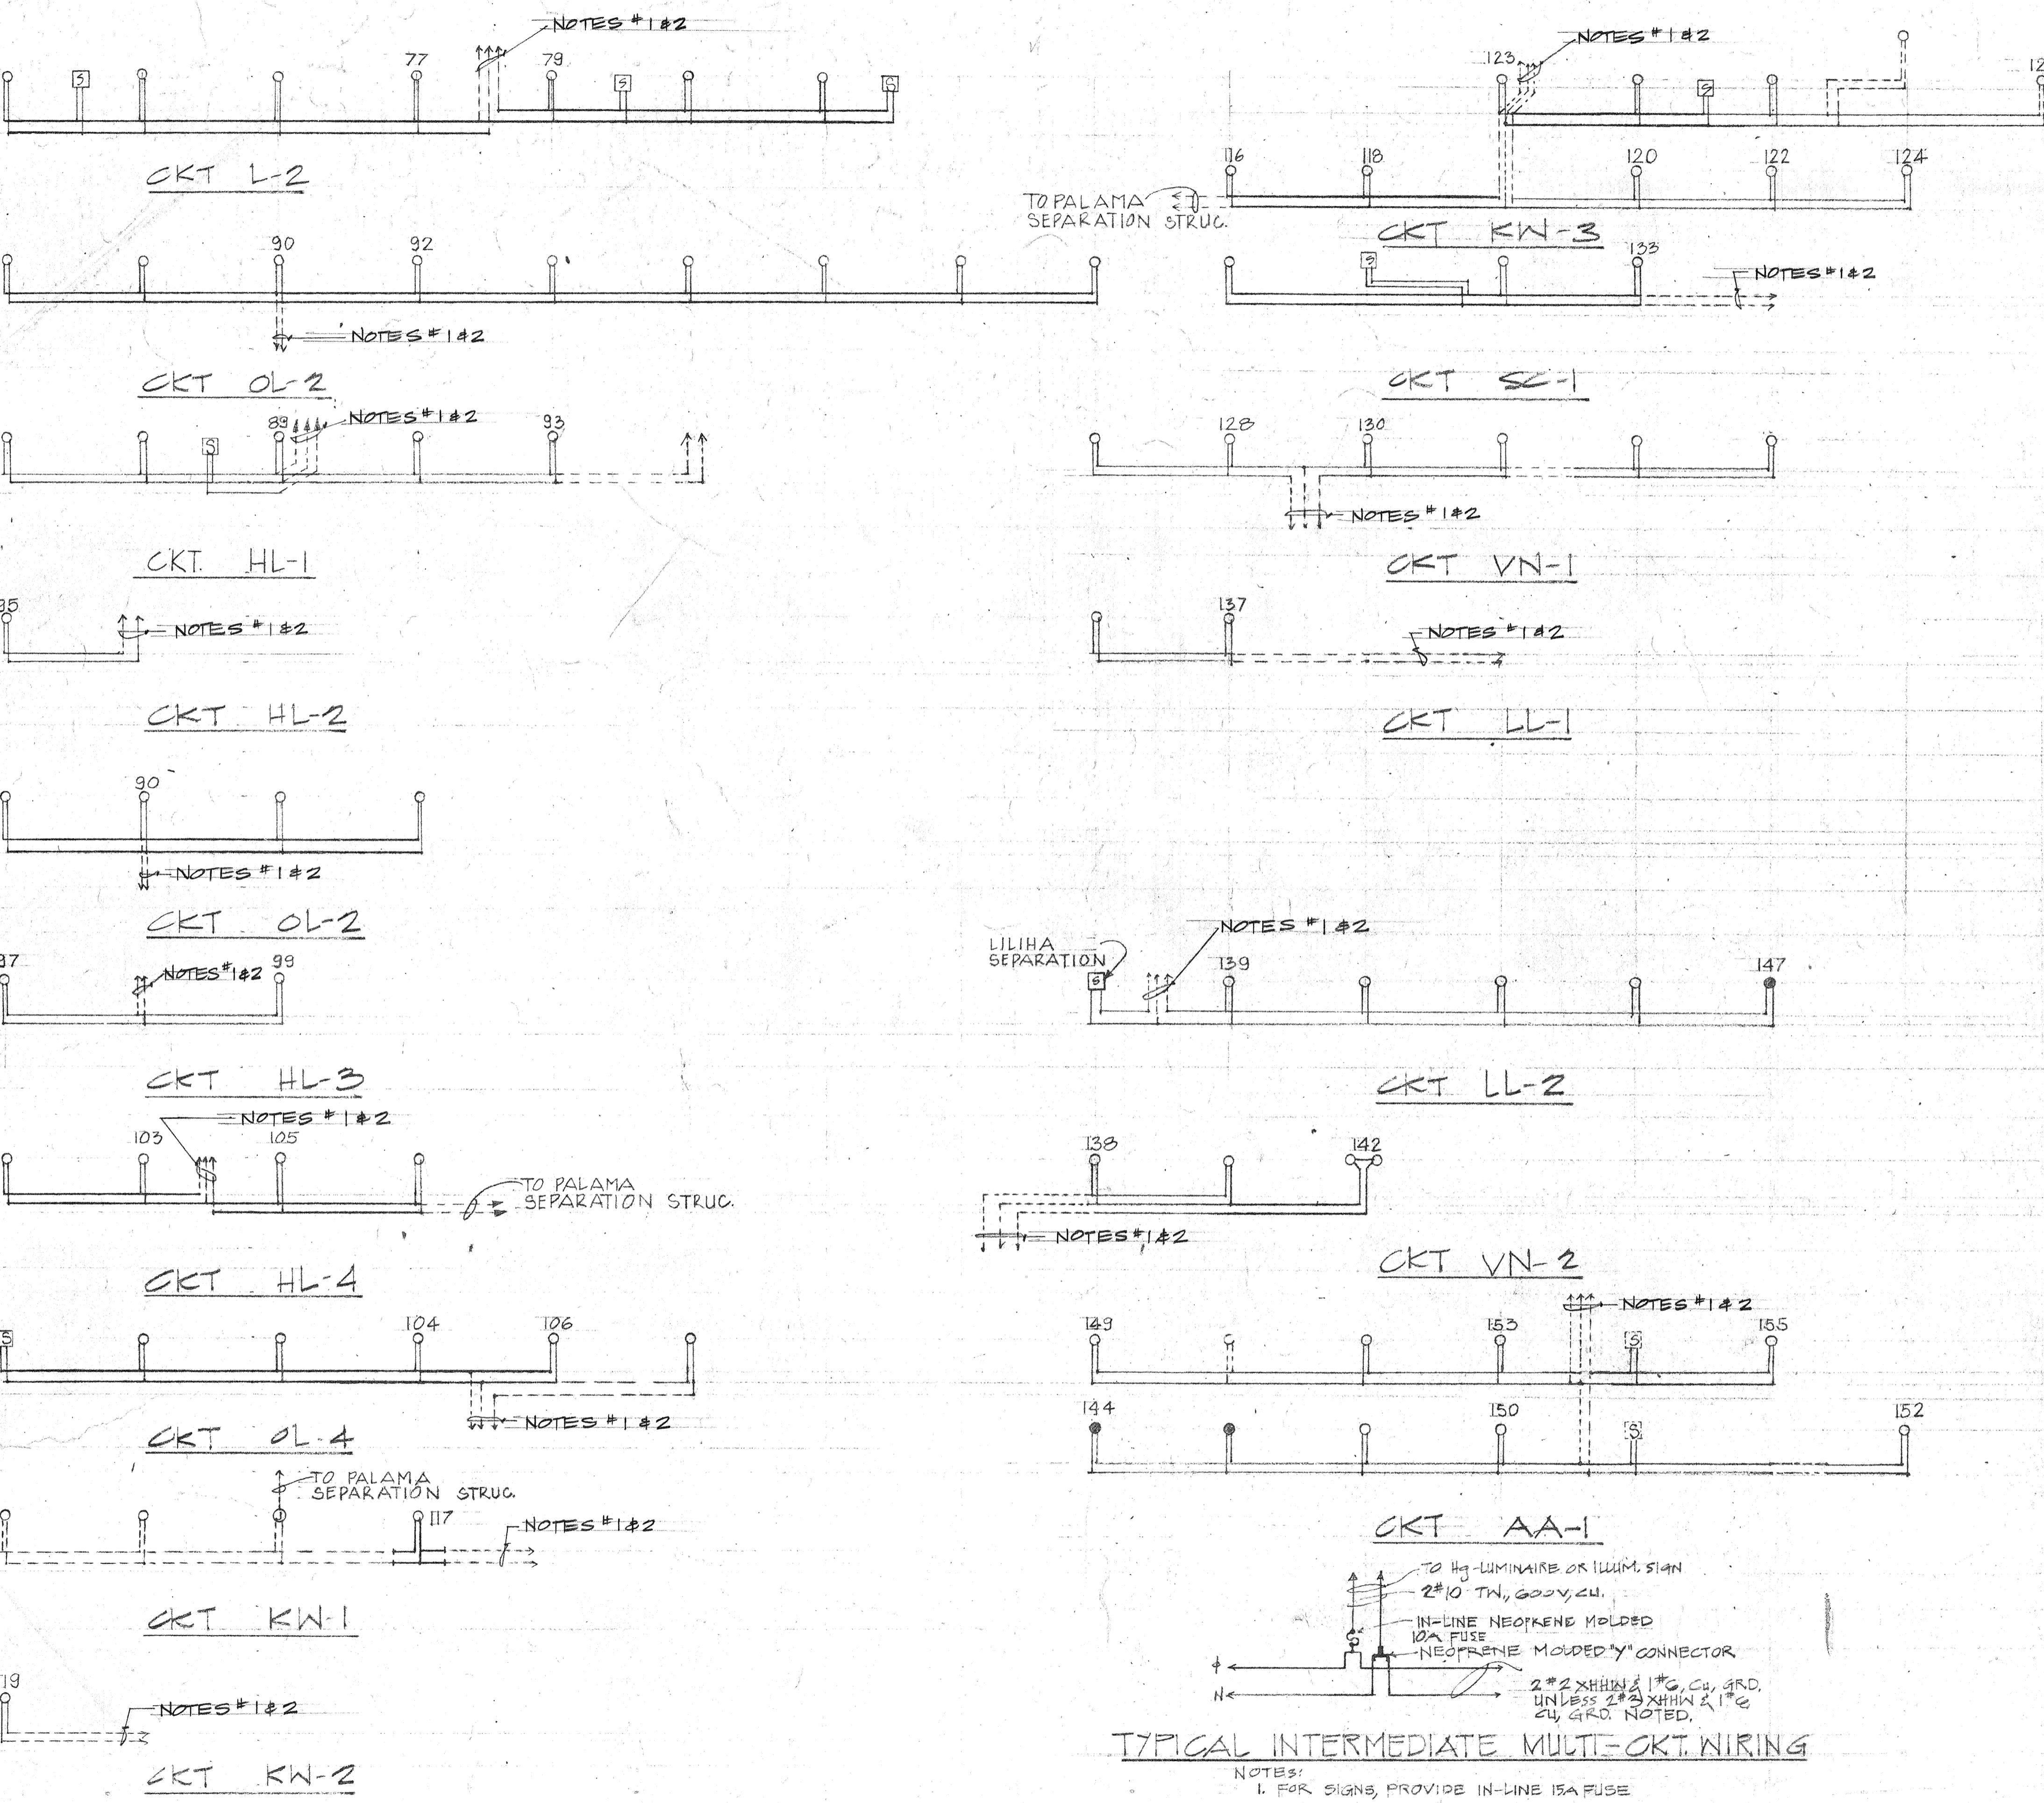

TYPICAL TERMINAL MULTICKT. WIRING

NOTES:

1. —> INDICATES VG CABLES TO HECo. SVC.
2. BROKEN LINE DENOTES EXST. SOLID LINE DENOTES NEW WORK.
3. TO RECONN. HECo. SVC., COMPLY WITH UTILITY REQUIREMENTS & PAY FOR ANY FEES REQUEST BY UTILITY COMPANIES.

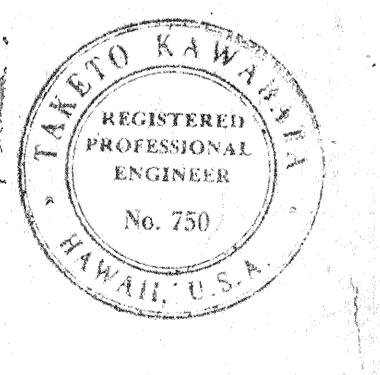

STATE OF HAWAII
DEPARTMENT OF TRANSPORTATION
HIGHWAYS DIVISION
HIGHWAY LIGHTING
MULTIPLE SYSTEMS
SAFETY IMPROVEMENT
KALIHI STREET TO Pali HIGHWAY
F.A.I. PROJECT NO. I-HI-I(112)19.
DATE: APR. 1973
SHEET NO. 18LOF 18L SHEETS

TYPICAL INTERMEDIATE MULTICKT. WIRING

- NOTES:
1. FOR SIGNS, PROVIDE IN-LINE 15A FUSE

ORIGINAL PLAN
DRAWN BY _____
TRACED BY _____
DESIGNED BY _____
QUANTITY BY _____
CHECKED BY _____

DATE: _____

PRINTED ON NO. 1000 CLEARPRINT

128

17