


FED. ROAD DIST. NO.	STATE	FED. AID PROJ. NO.	FISCAL YEAR	SHEET NO.	TOTAL SHEETS
HAWAII	HAW.	HI-E-01-74	1974	1	1

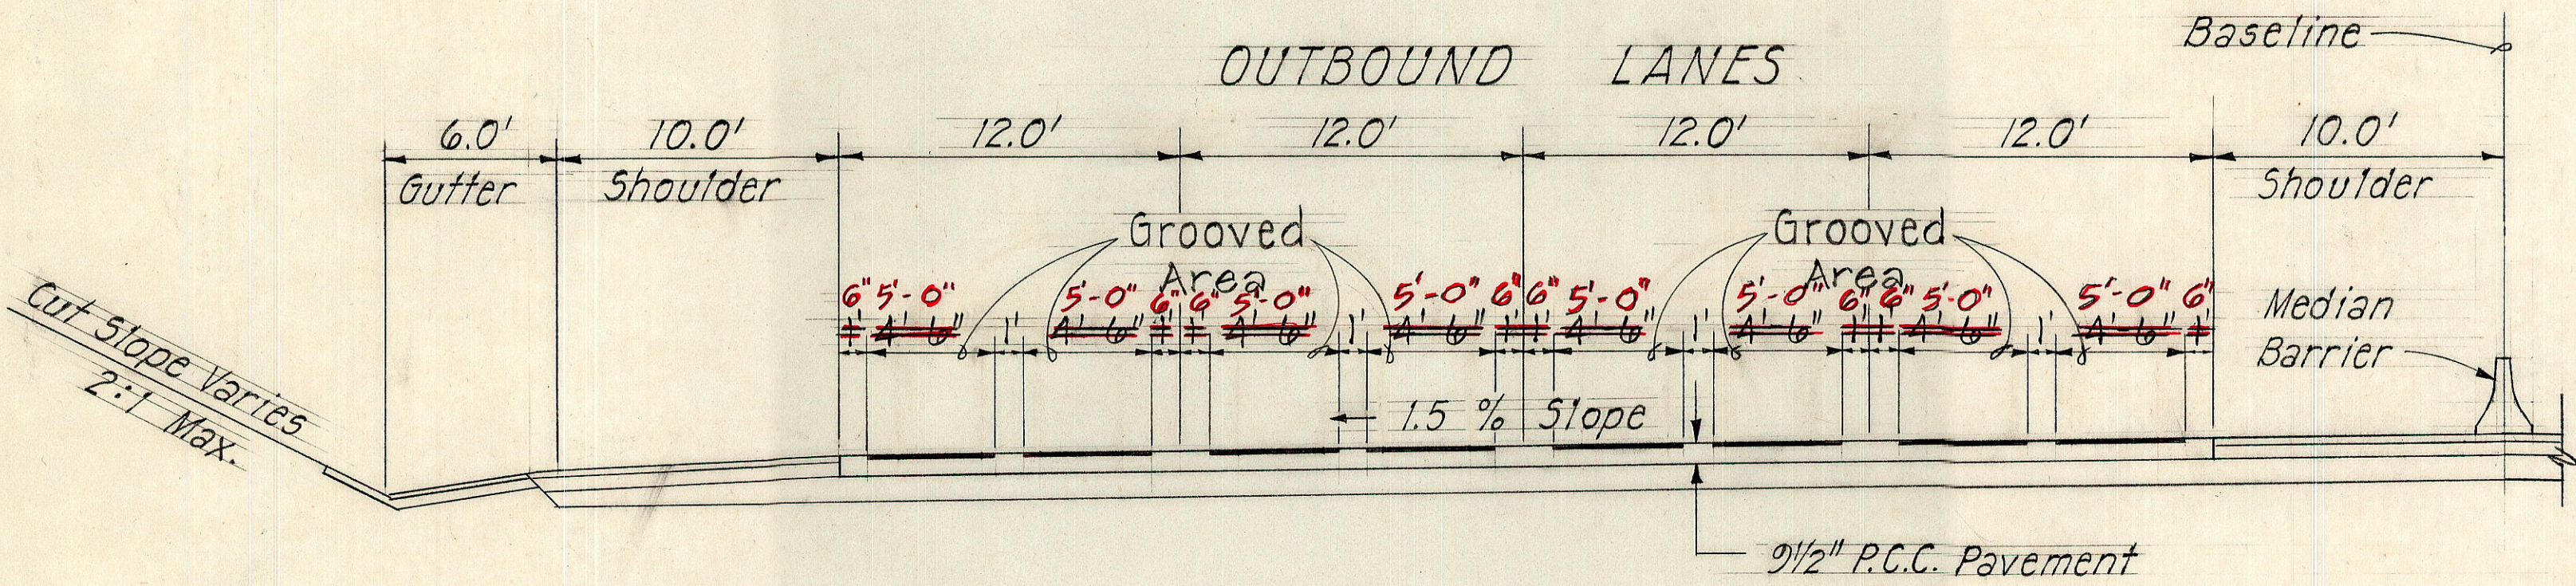

### TYPICAL SECTION


Scale: 3/16" = 1'-0"

NOTE: Pavement grooving pattern as shown above shall be the same for the Waimalu Viaduct.

### "AS BUILT PLAN"

ALL CHANGES MADE DURING CONSTRUCTION HAVE BEEN INCORPORATED ON THESE PLANS (IN RED), EXCEPT CHANGES IN THE ORIGINAL THEORETICAL QUANTITIES. FOR ACTUAL QUANTITIES REFER TO PROJECT LEDGER AND/OR COMPUTATION BOOK.

*High M. Sam* 12/1/81  
PROJECT ENGINEER DATE

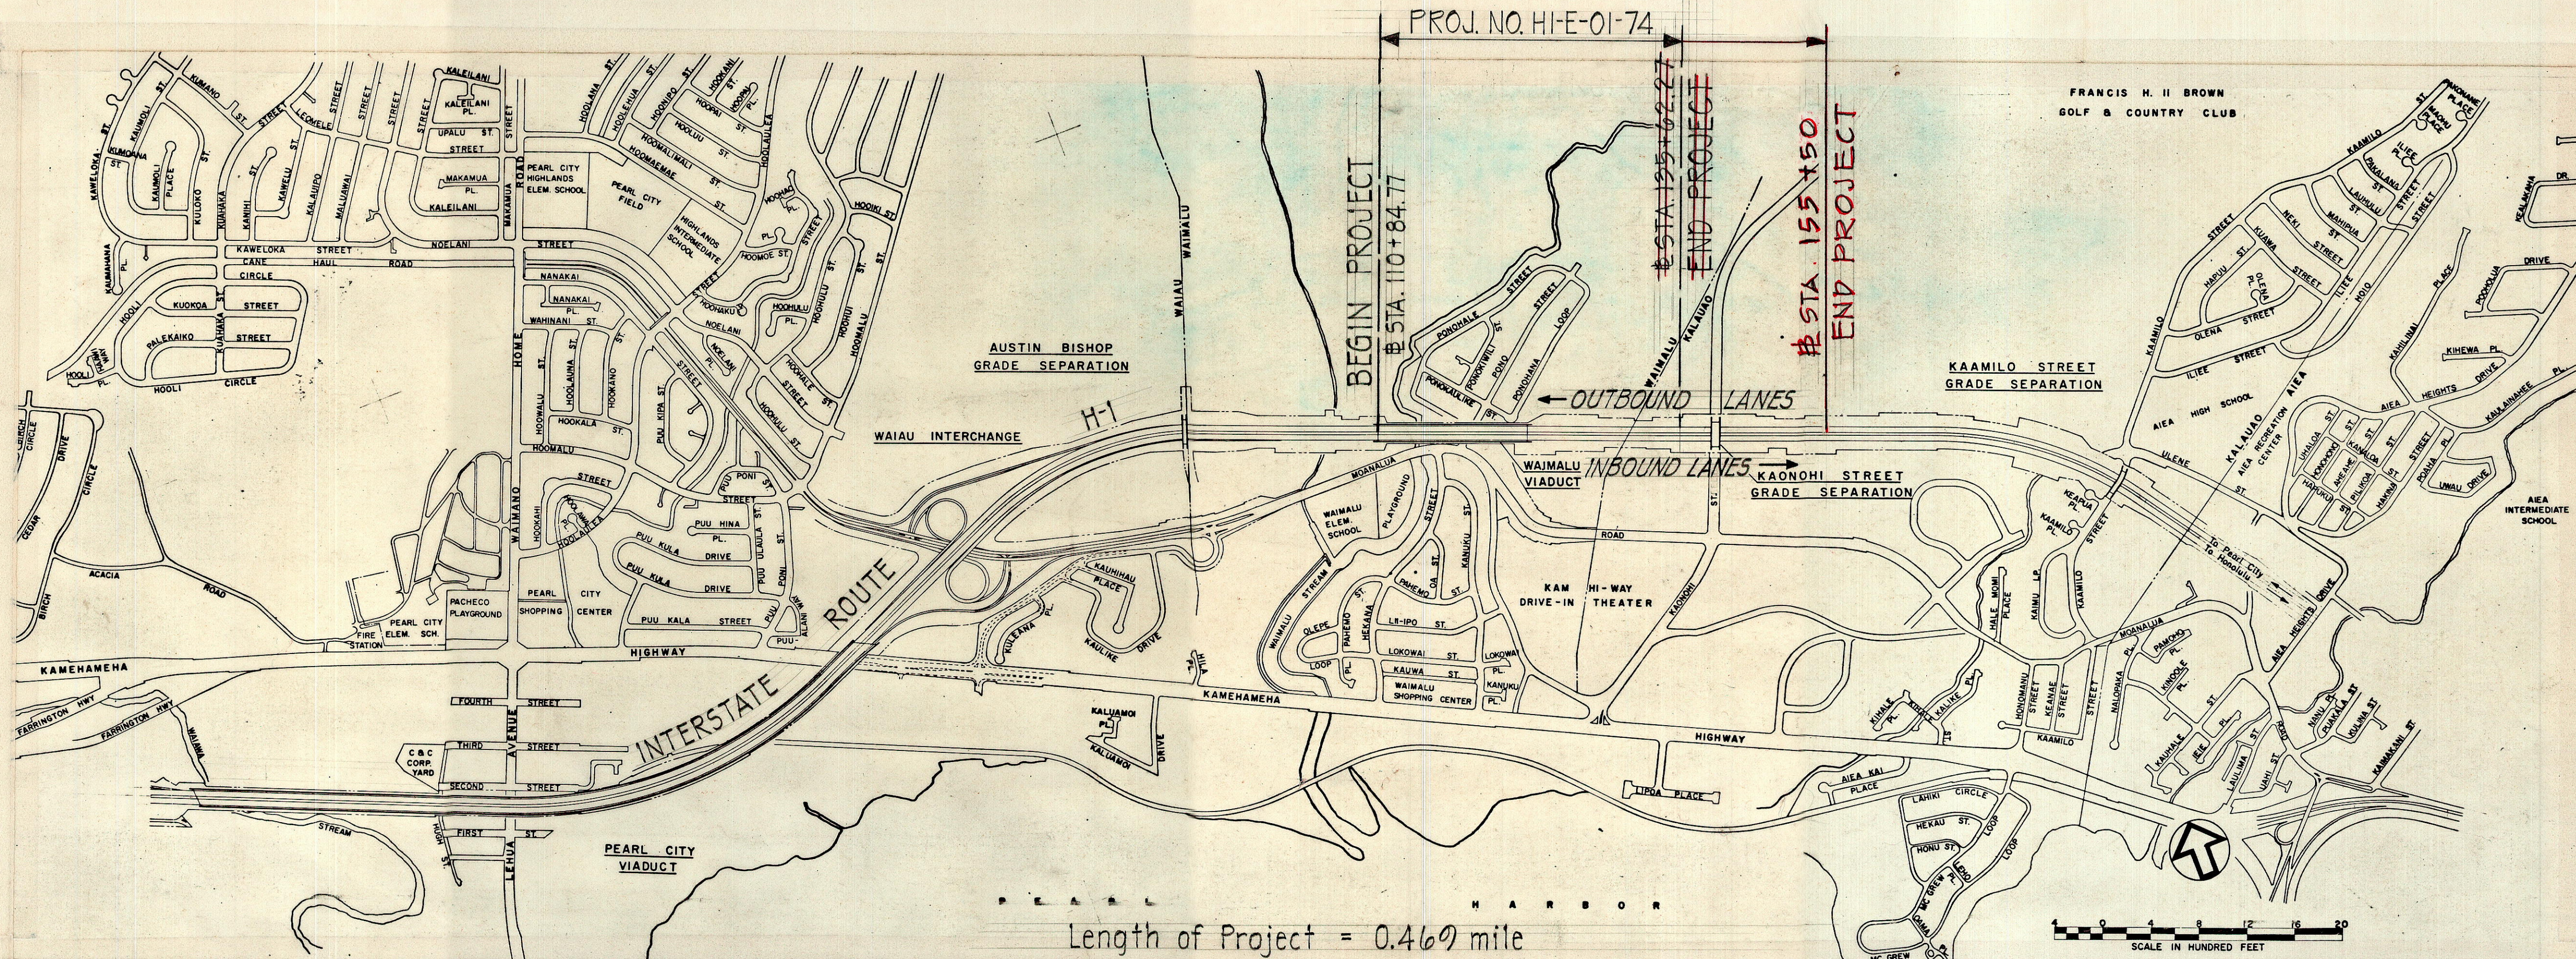

DEPARTMENT OF TRANSPORTATION  
STATE OF HAWAII  
APPROVED: *Murray Lee* 3/1/74  
FOR DIR. OF TRANSPORTATION DATE

STATE OF HAWAII  
DEPARTMENT OF TRANSPORTATION  
HIGHWAYS DIVISION  
ROUTE H-1 OUTBOUND LANES  
BETWEEN WAIMALU VIADUCT AND  
KAAMULO STREET OVERPASS,  
GROOVE P.C.C. PAVEMENT  
PROJECT NO. HI-E-01-74

SHEET No. 1 OF 1 SHEETS

DATE  
DRAWN BY  
CHECKED BY  
DESIGNED BY  
NOTED BY  
No.