

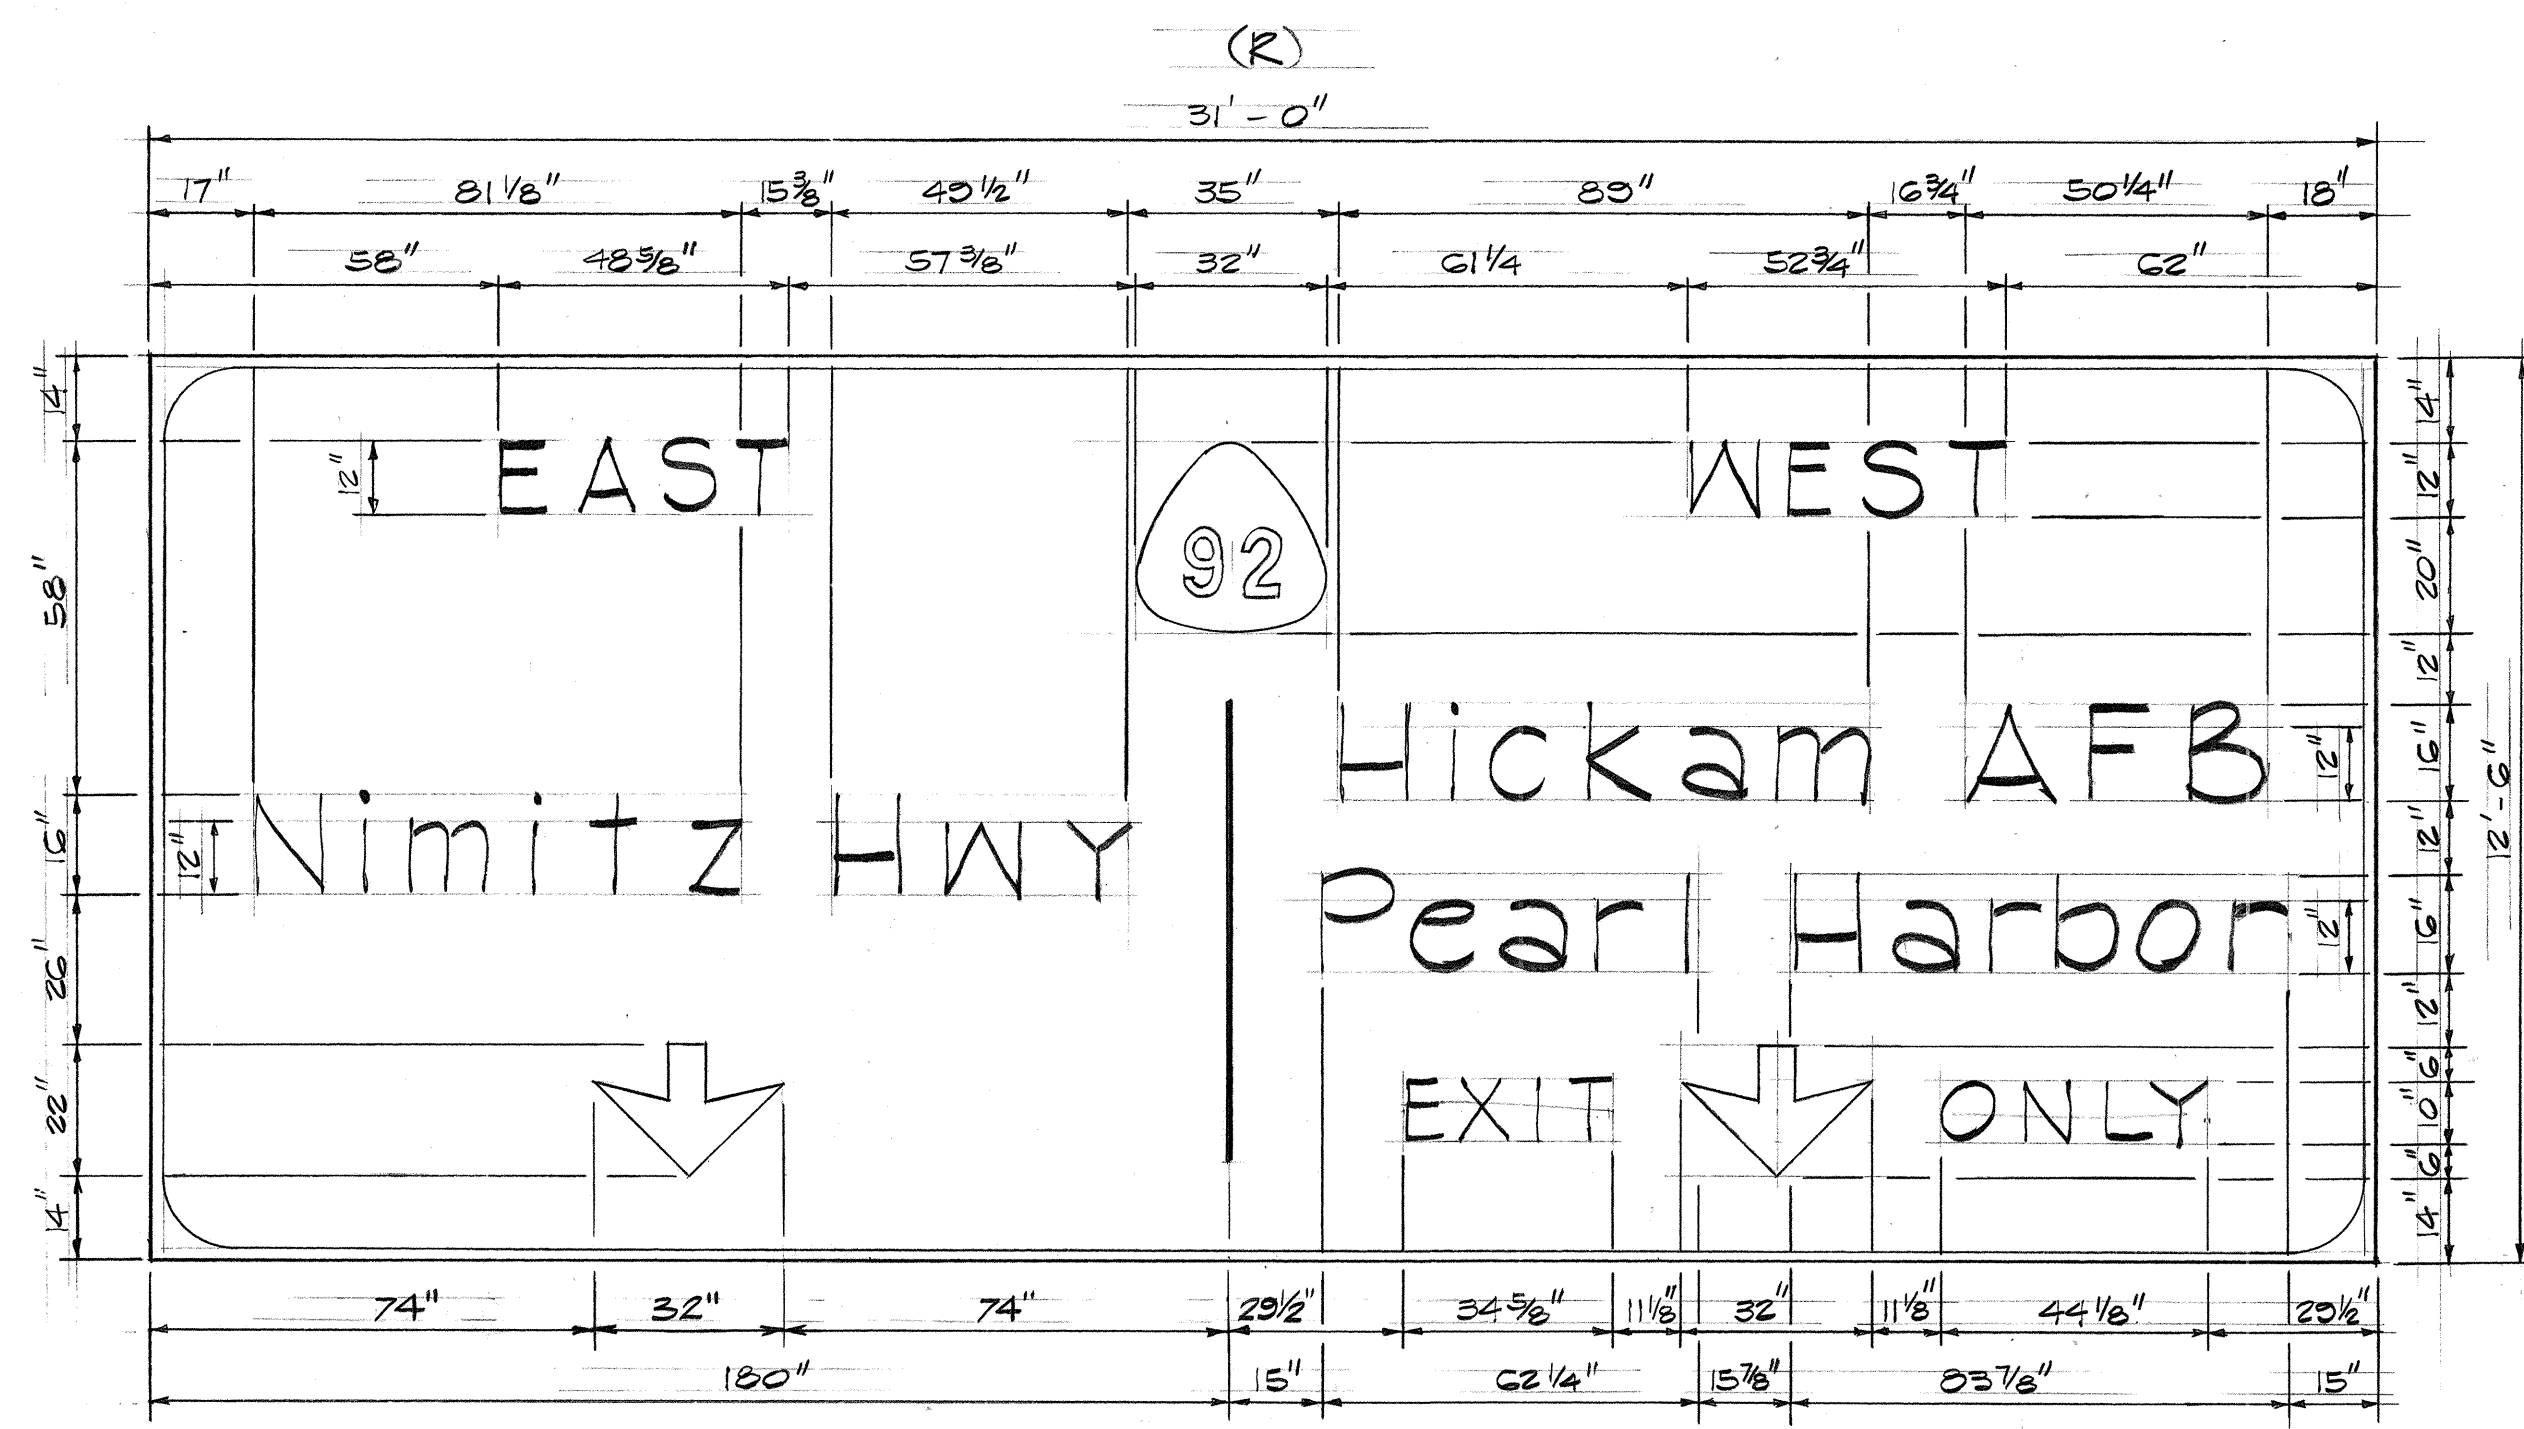



FED. ROAD DIST. NO.	STATE	FED. AID PROJ. NO.	FISCAL YEAR	SHEET NO.	TOTAL SHEETS
HAWAII	HAW.	I-HI-(111):14	1974	81	234

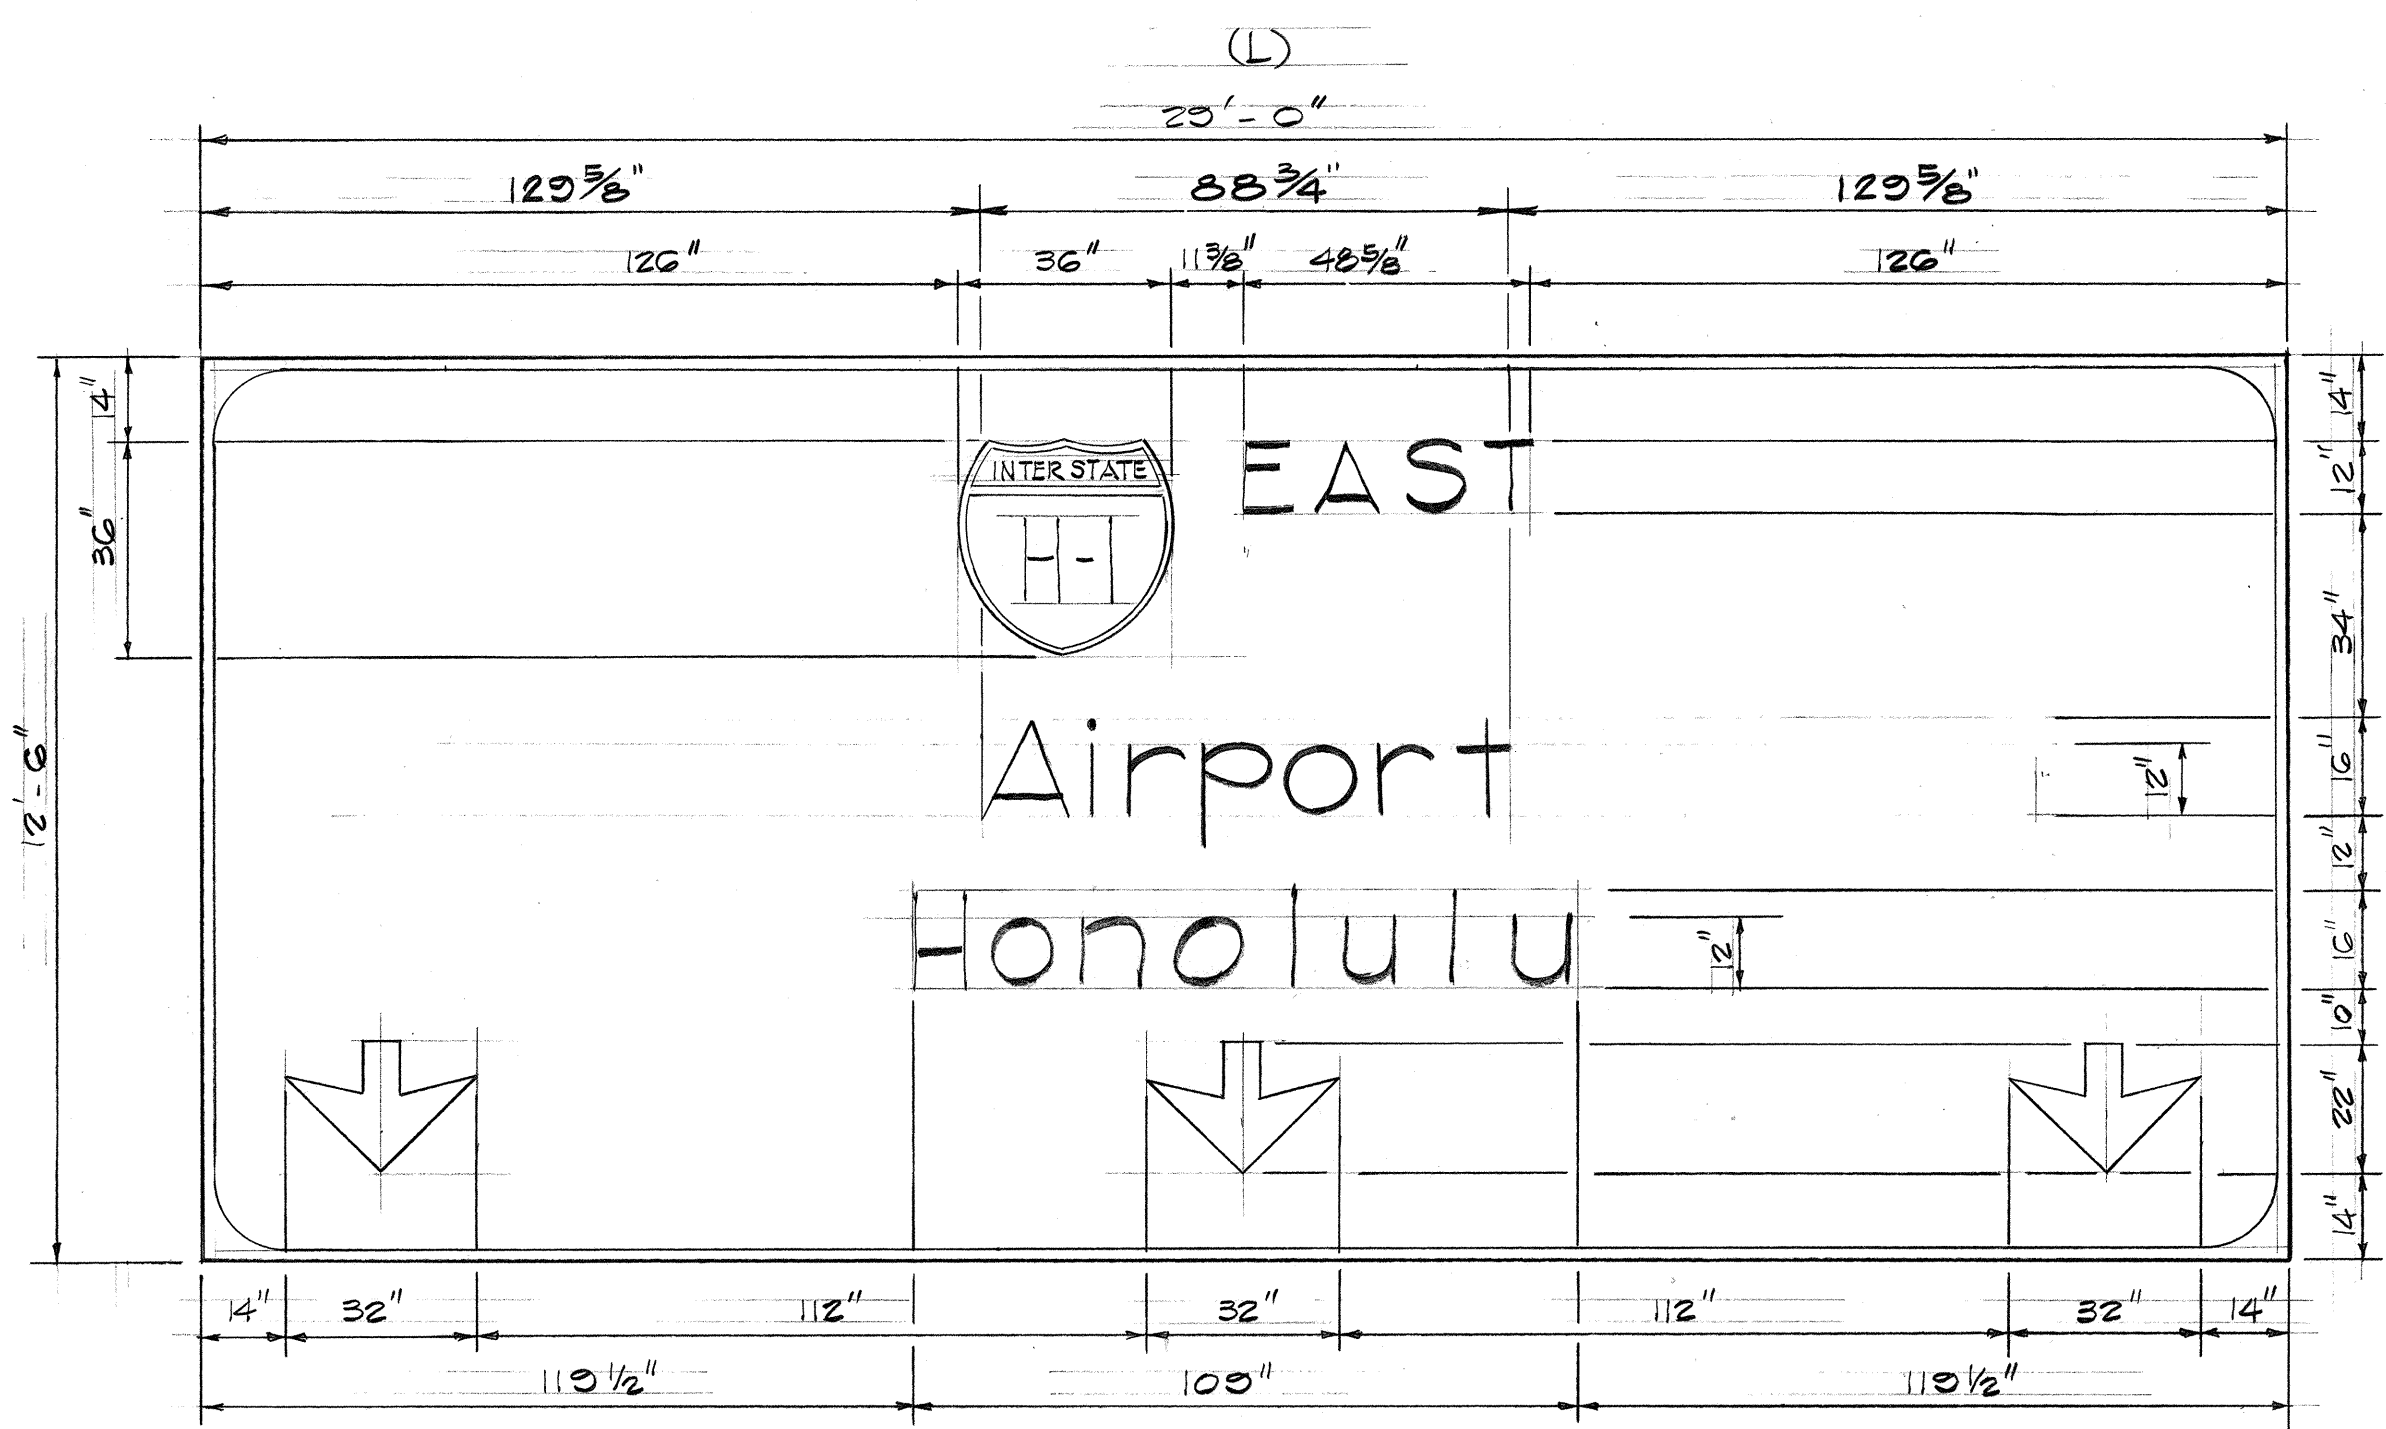

SIGN E-5

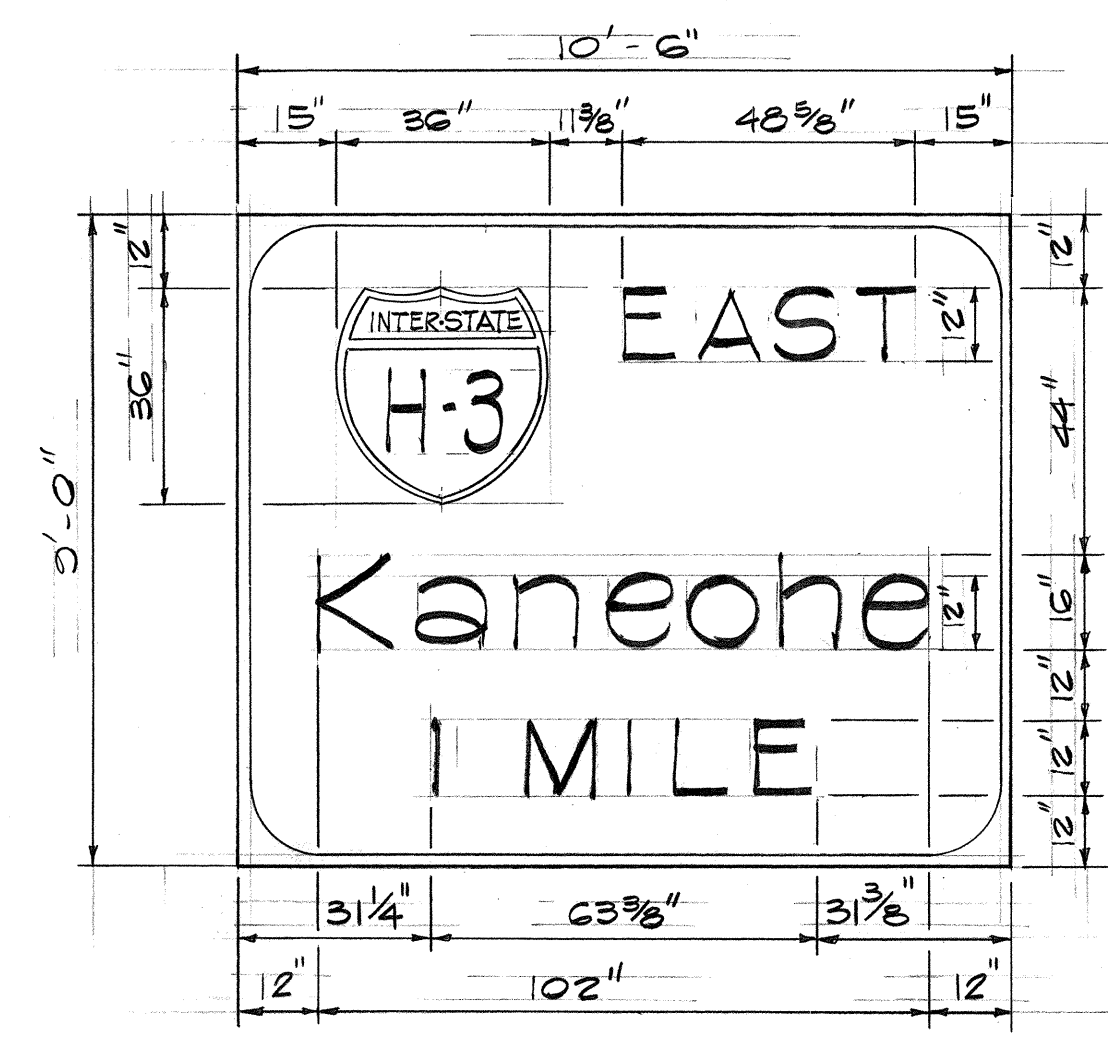


SIGN E-13

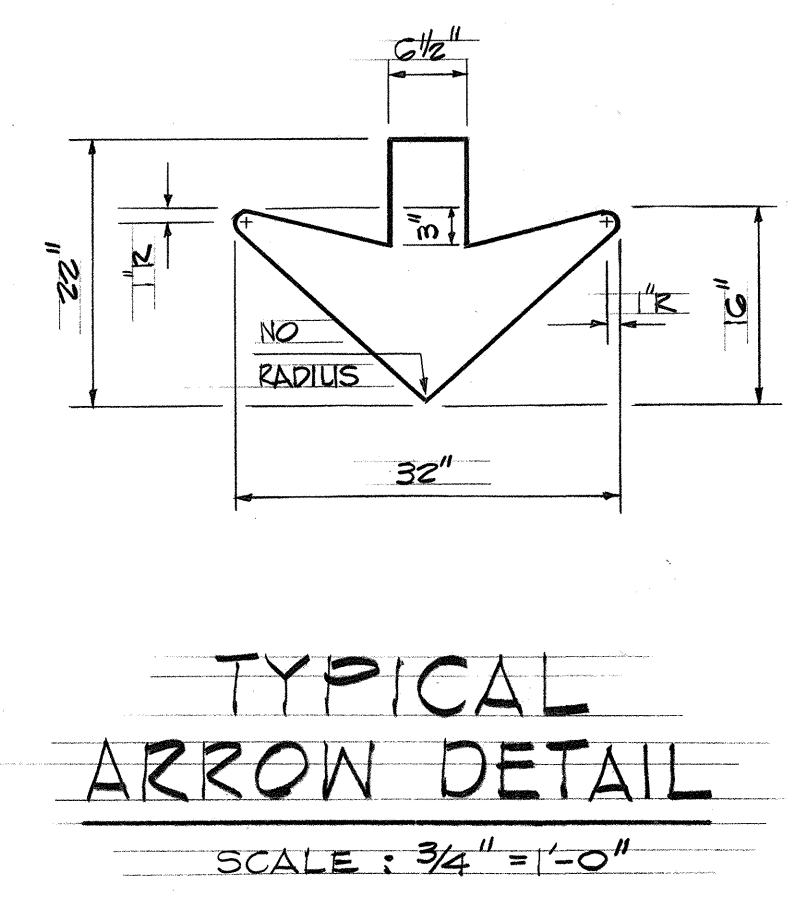

GENERAL NOTES:

- LETTERS SHALL CONFORM TO THE MODIFIED SERIES "E" LETTERS SHOWN IN THE "STANDARD ALPHABETS FOR HIGHWAY SIGNS," BUREAU OF PUBLIC ROADS, 1966.
- ARROWS, BORDERS AND ROUTE MARKERS SHALL CONFORM WITH DETAILS AS SHOWN ON PLANS.
- LETTERS, NUMERALS, SYMBOLS AND BORDERS SHALL BE DEMOUNTABLE ALUMINUM CUT-OUTS WITH WHITE REFLECTIVE SHEETING OR CLEAR REFLEX REFLECTORS, AND SHALL BE FASTENED ON THE SIGN PANEL WITH BLIND RIVETS. SEE SPECIAL PROVISIONS.
- EXPRESSWAY SIGNS (E) SHALL HAVE EITHER WHITE REFLECTIVE SHEETING ON ALUMINUM CUT-OUTS OR CLEAR REFLEX REFLECTORS SET IN WHITE PORCELAIN ENAMELED ALUMINUM CUT-OUTS. BACKGROUND FOR THE EXPRESSWAY SIGNS SHALL BE GREEN PORCELAIN ENAMEL.
- DESTINATION SIGNS (D) SHALL HAVE WHITE REFLECTIVE SHEETING ON ALUMINUM CUT-OUTS ON GREEN REFLECTIVE SHEETING BACKGROUND.
- "EXIT ONLY" PANELS SHALL BE DEMOUNTABLE ALUMINUM CUT-OUTS WITH BLACK LEGEND ON REFLECTORIZED YELLOW BACKGROUND.
- SEE SHEETS 183 TO 188 FOR OVERHEAD SIGN SUPPORTS AND DETAILS.

ORIGINAL PLAN	SURVEY PLOTTED BY	DATE
DESIGNED BY		
NOTED BY		
CHECKED BY		
NO.		

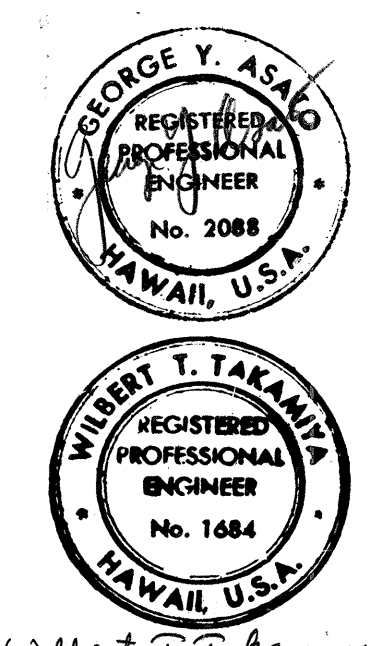

THIS WORK WAS PREPARED BY ME OR UNDER MY SUPERVISION

STATE OF HAWAII
DEPARTMENT OF TRANSPORTATION
HIGHWAYS DIVISION


PANEL LAYOUT

PEARL HARBOR INTERCHANGE
F.A.I. Proj. No. I-HI-(111):14



Scale: As Shown Date: DEC. 14, 1973

SHEET No. 1 OF 3 SHEETS


FED. ROAD DIST. NO.	STATE	FED. AID PROJ. NO.	FISCAL YEAR	SHEET NO.	TOTAL SHEETS
HAWAII	HAW.	I-HI-(111)14	1974	82	234

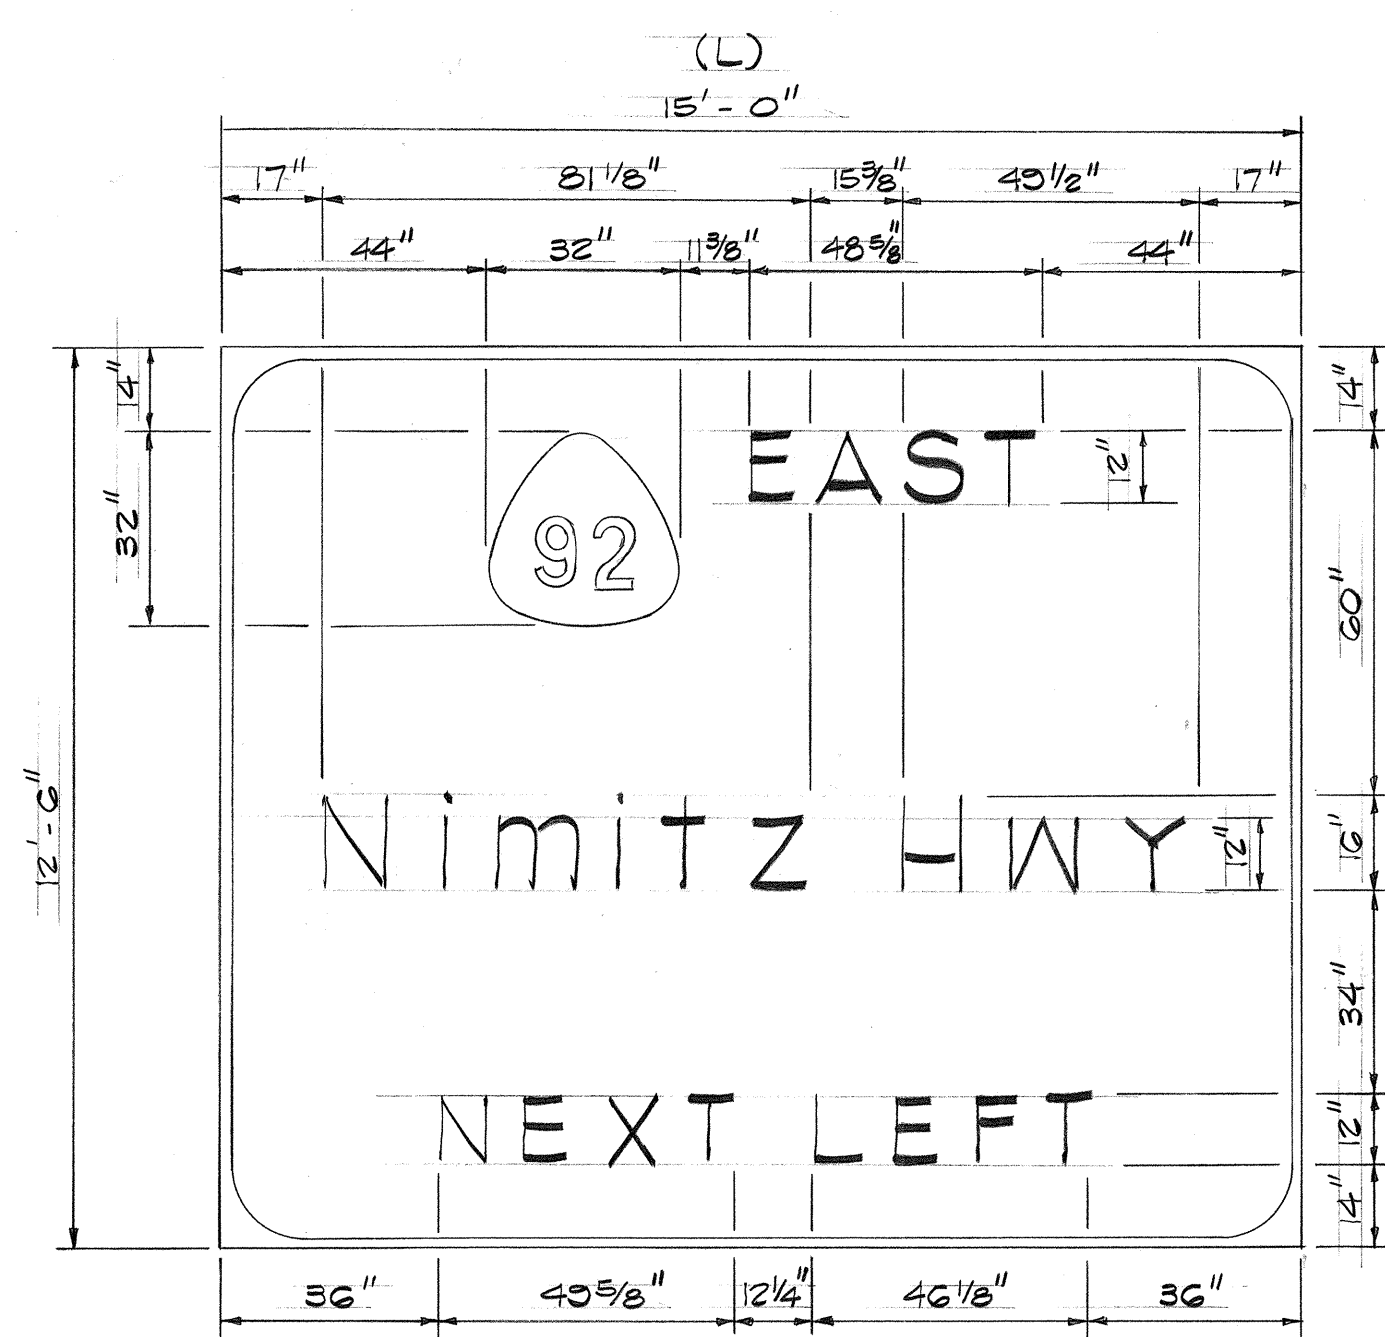


SIGN E-1

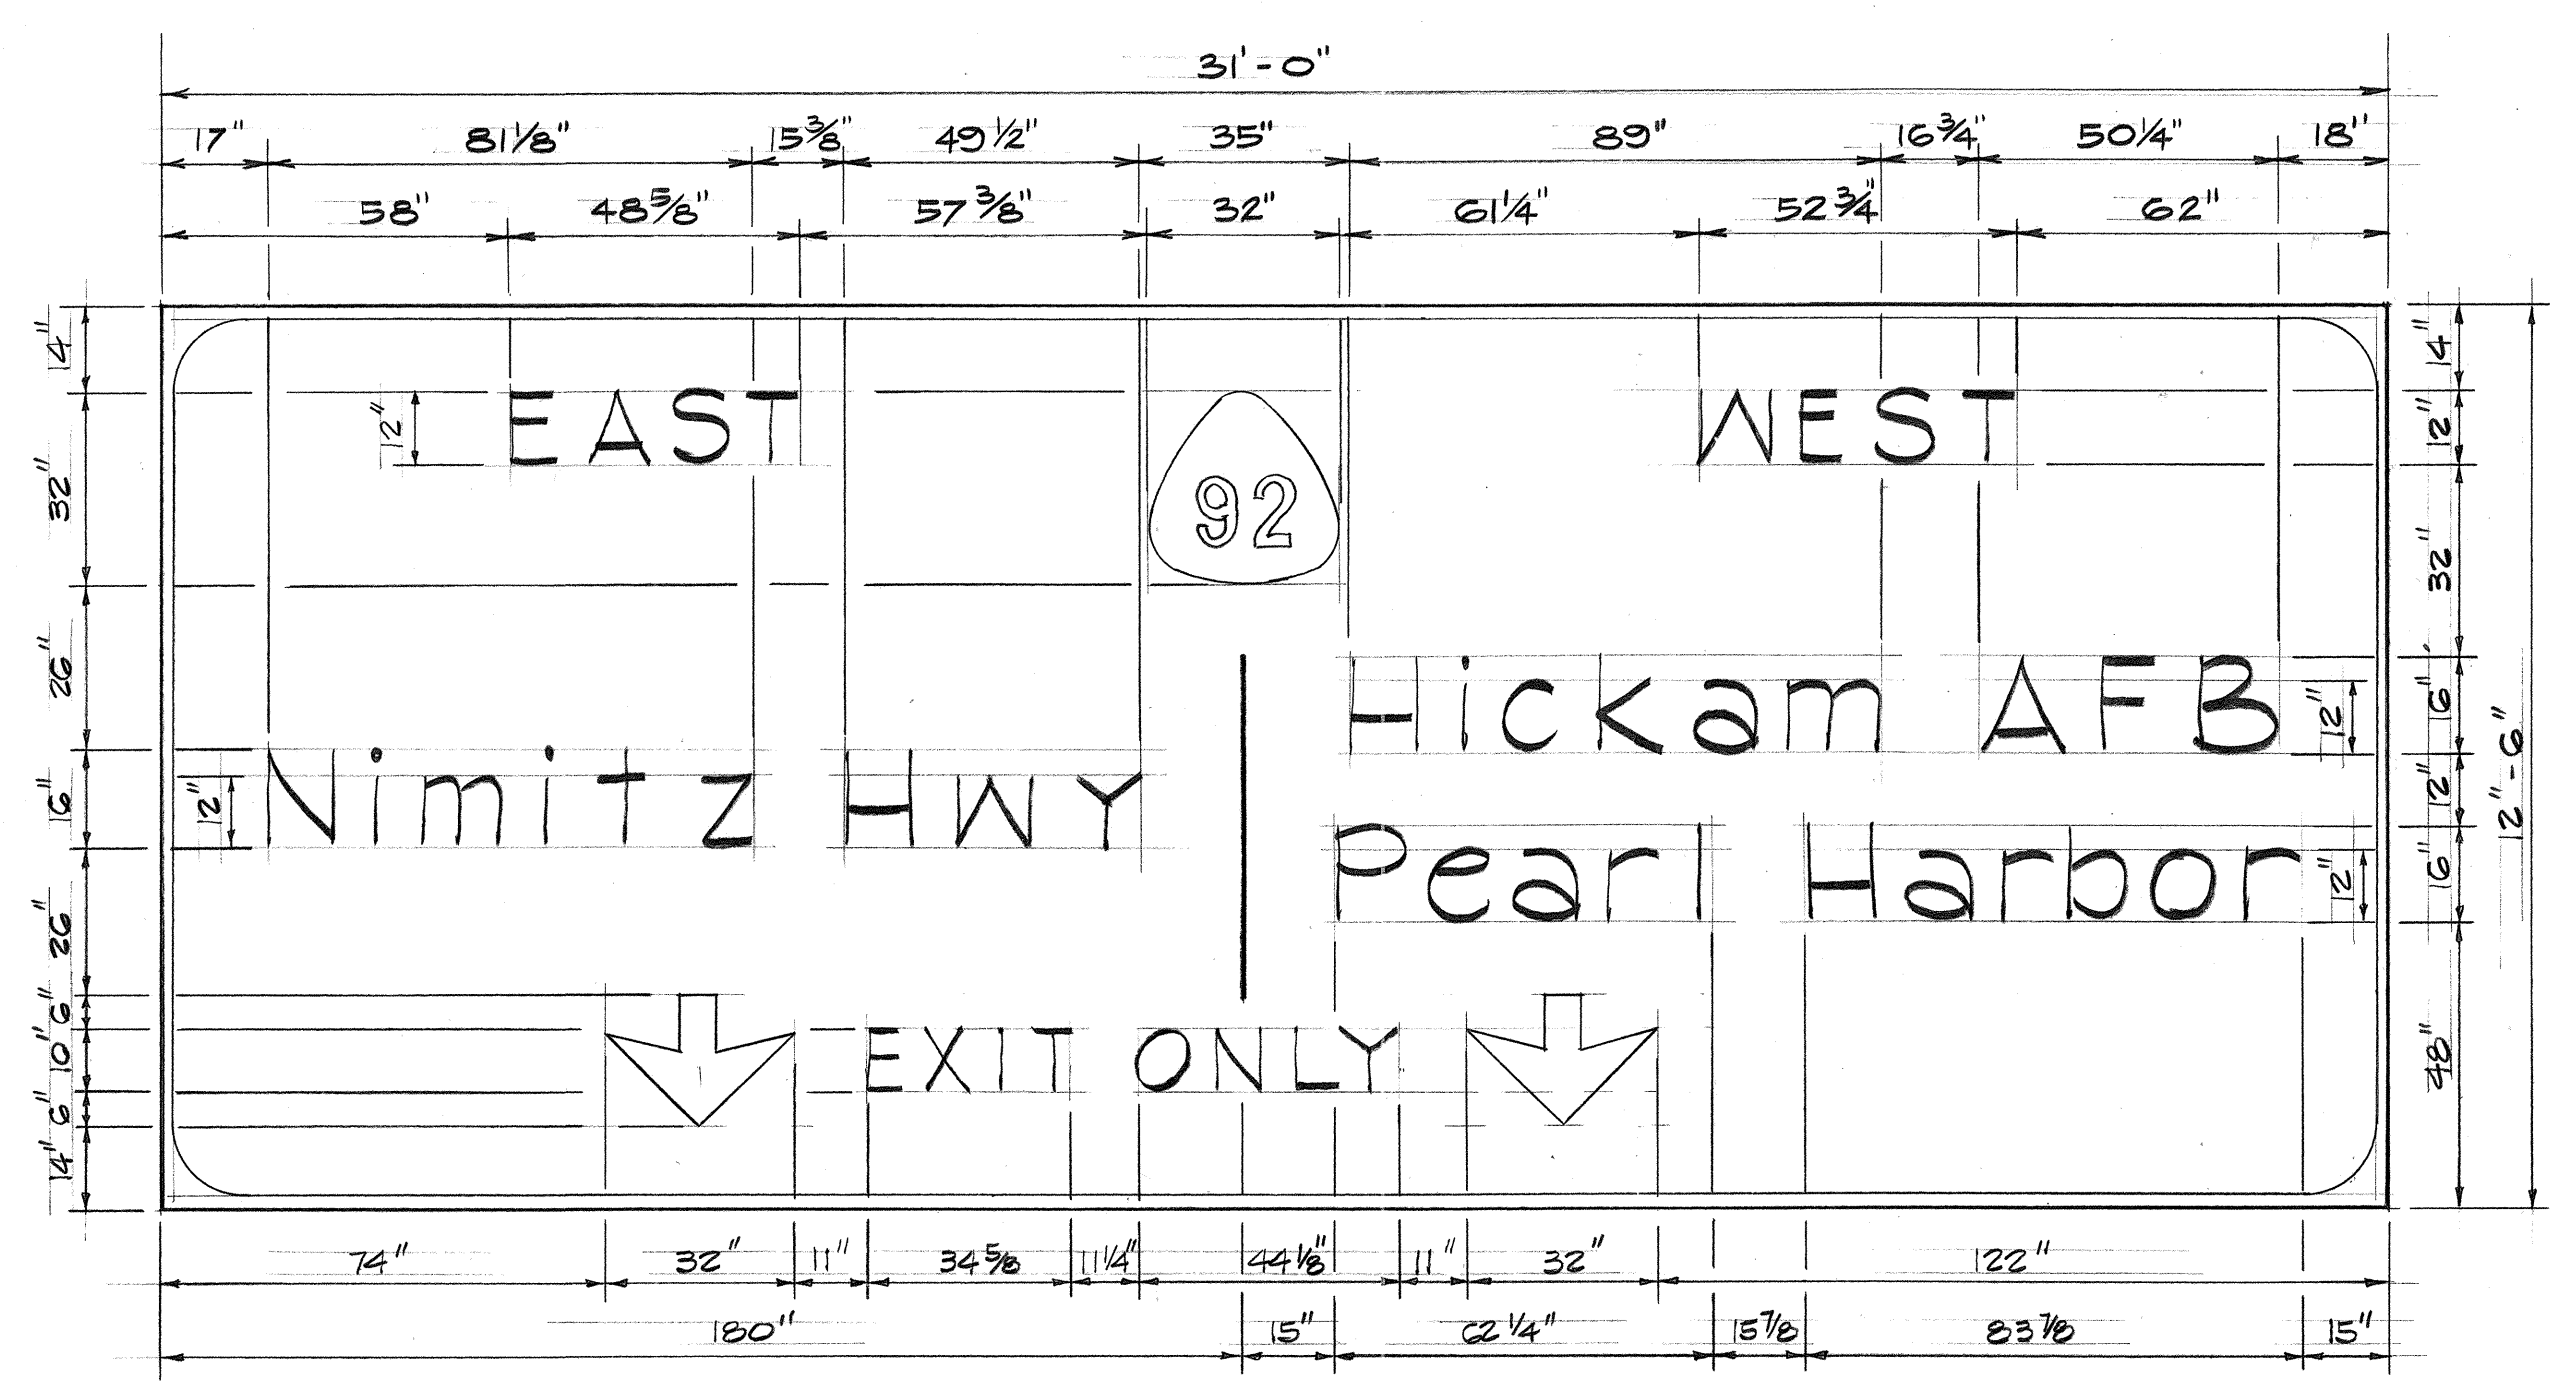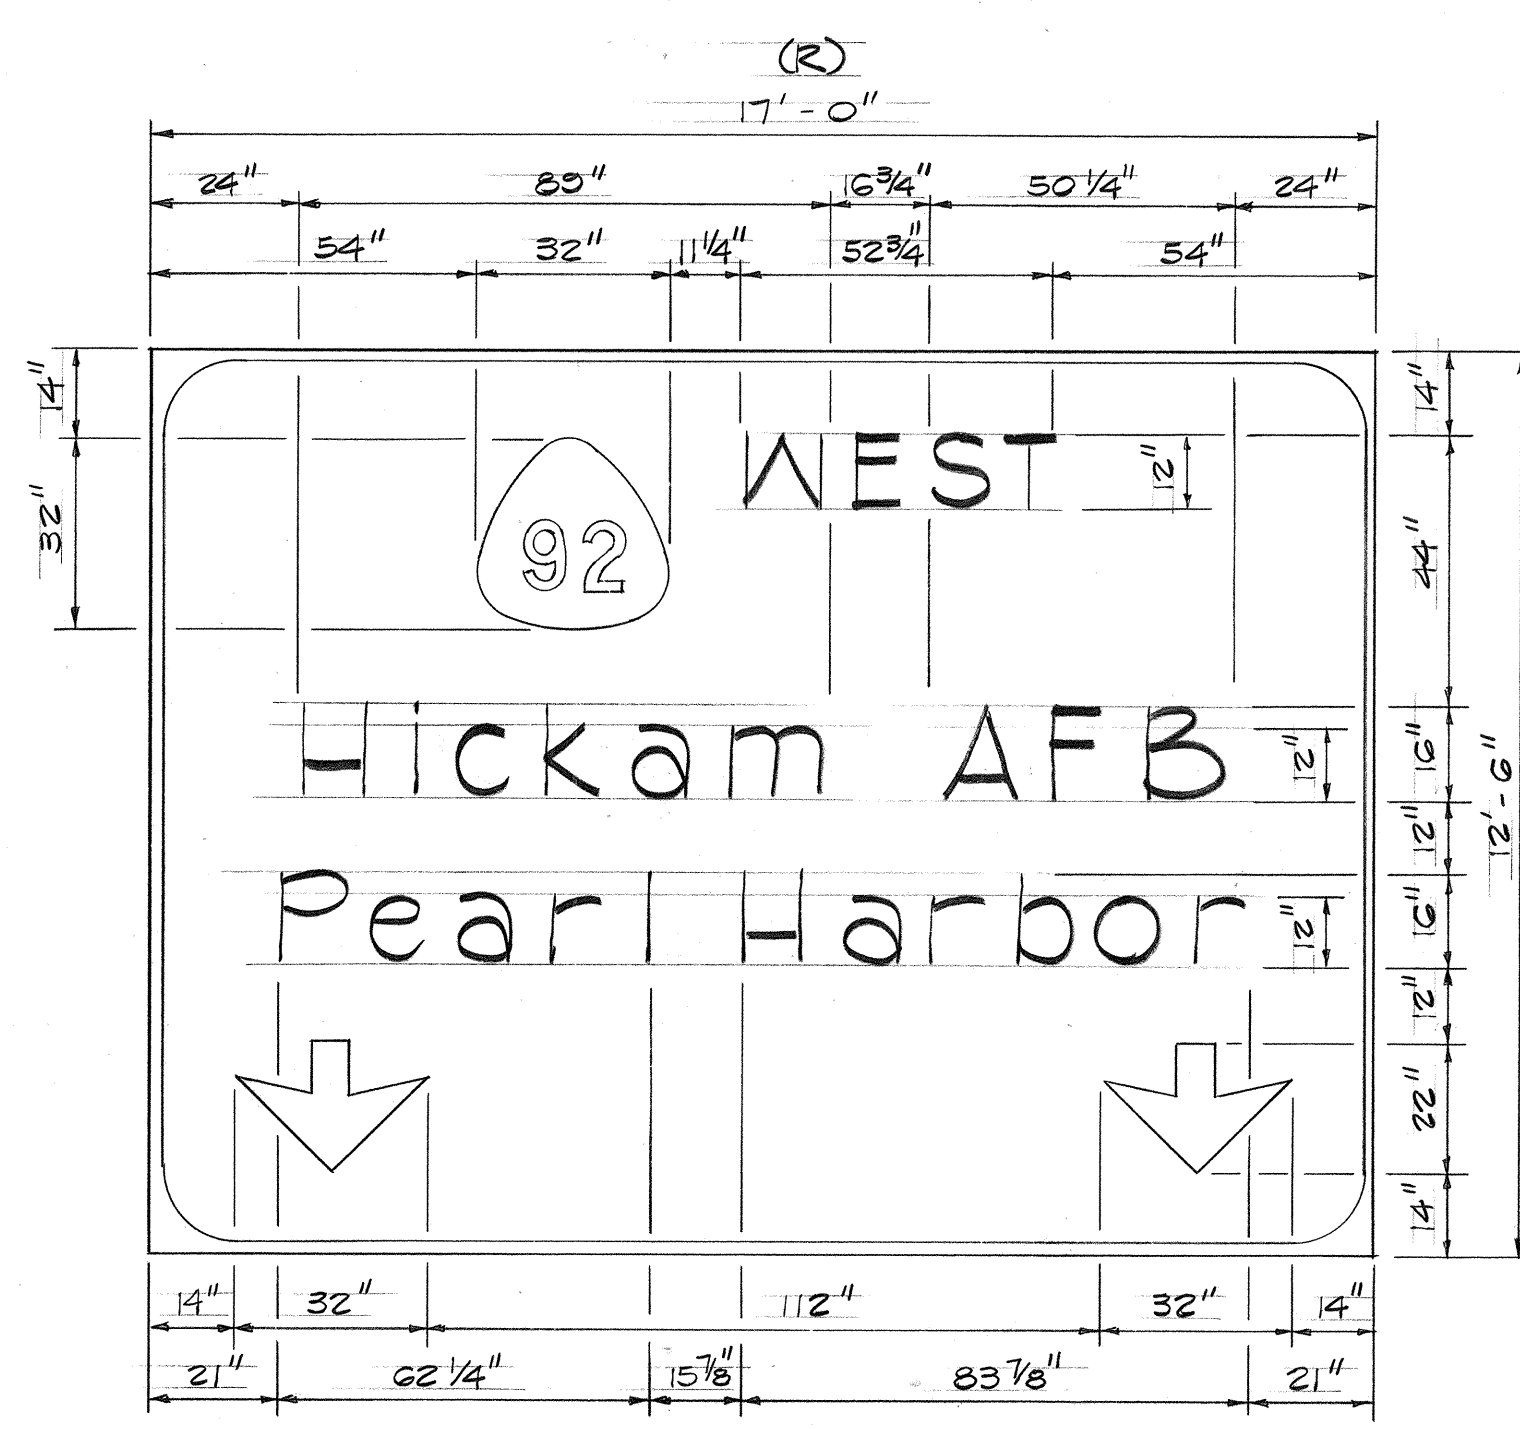



SIGN E-6

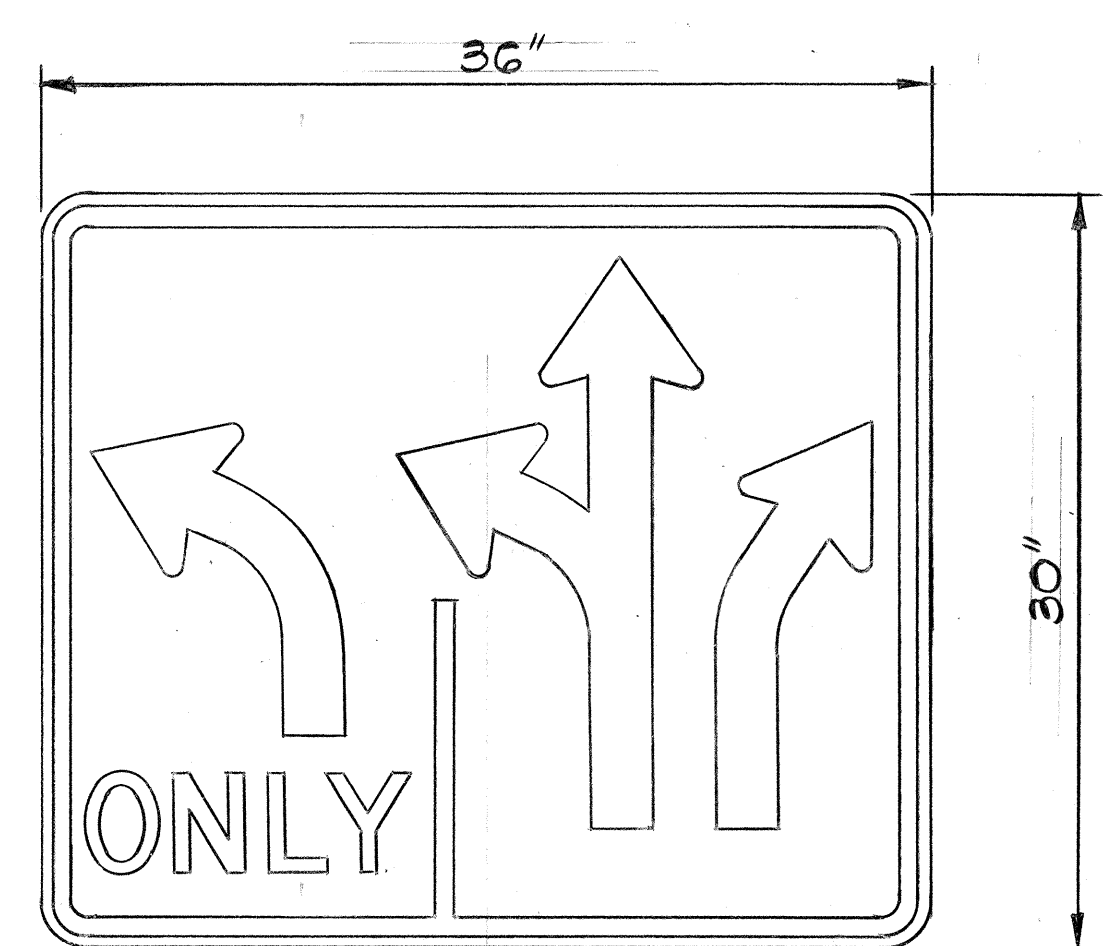

SIGN D-7
R3-14 36" x 30"

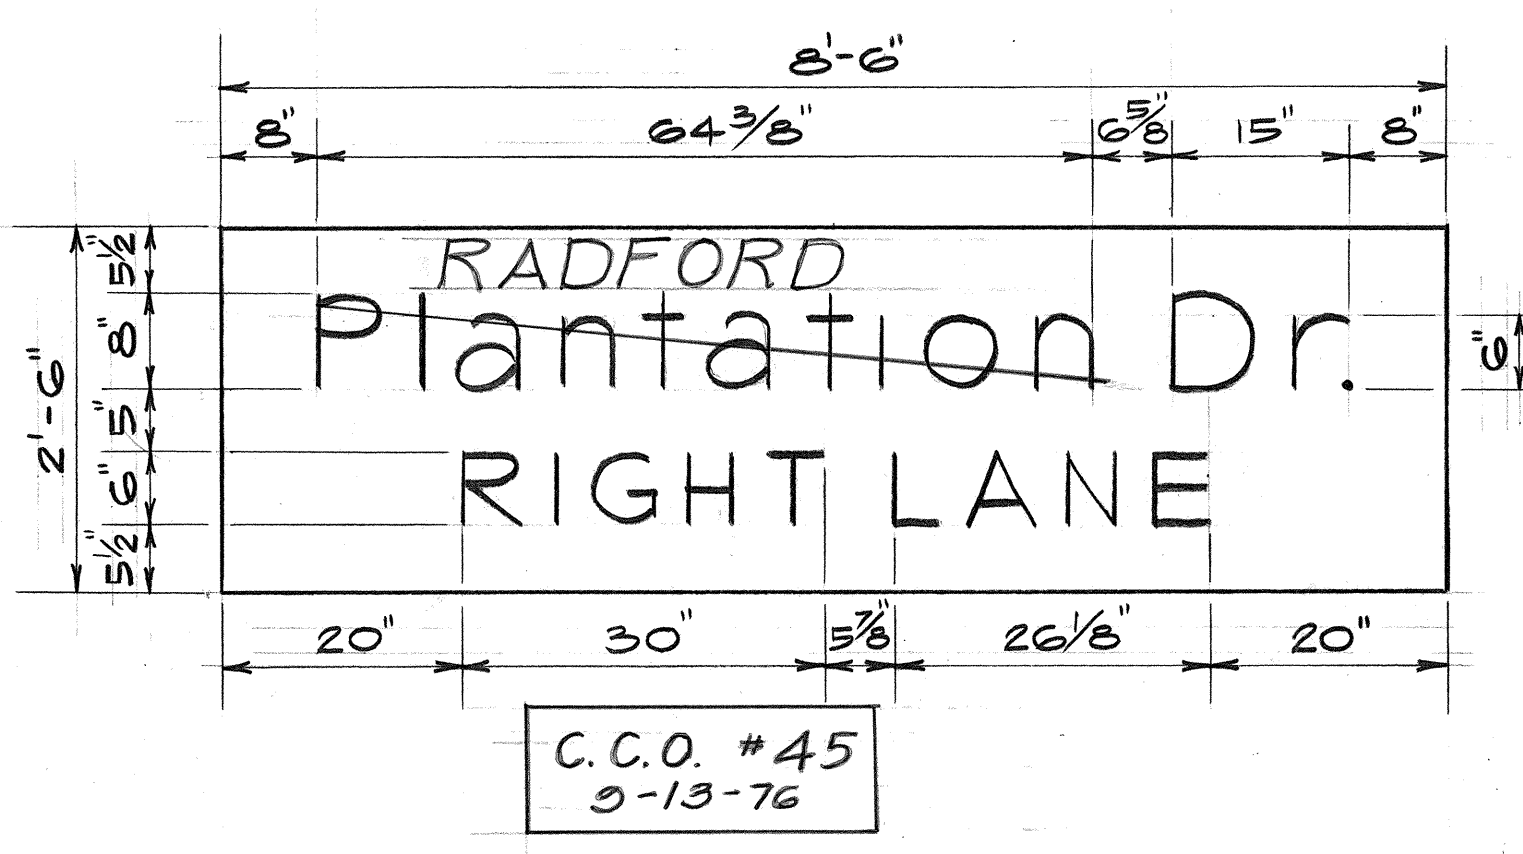

SIGN E-17

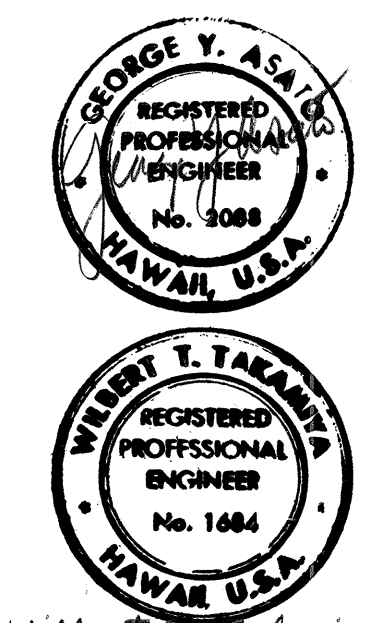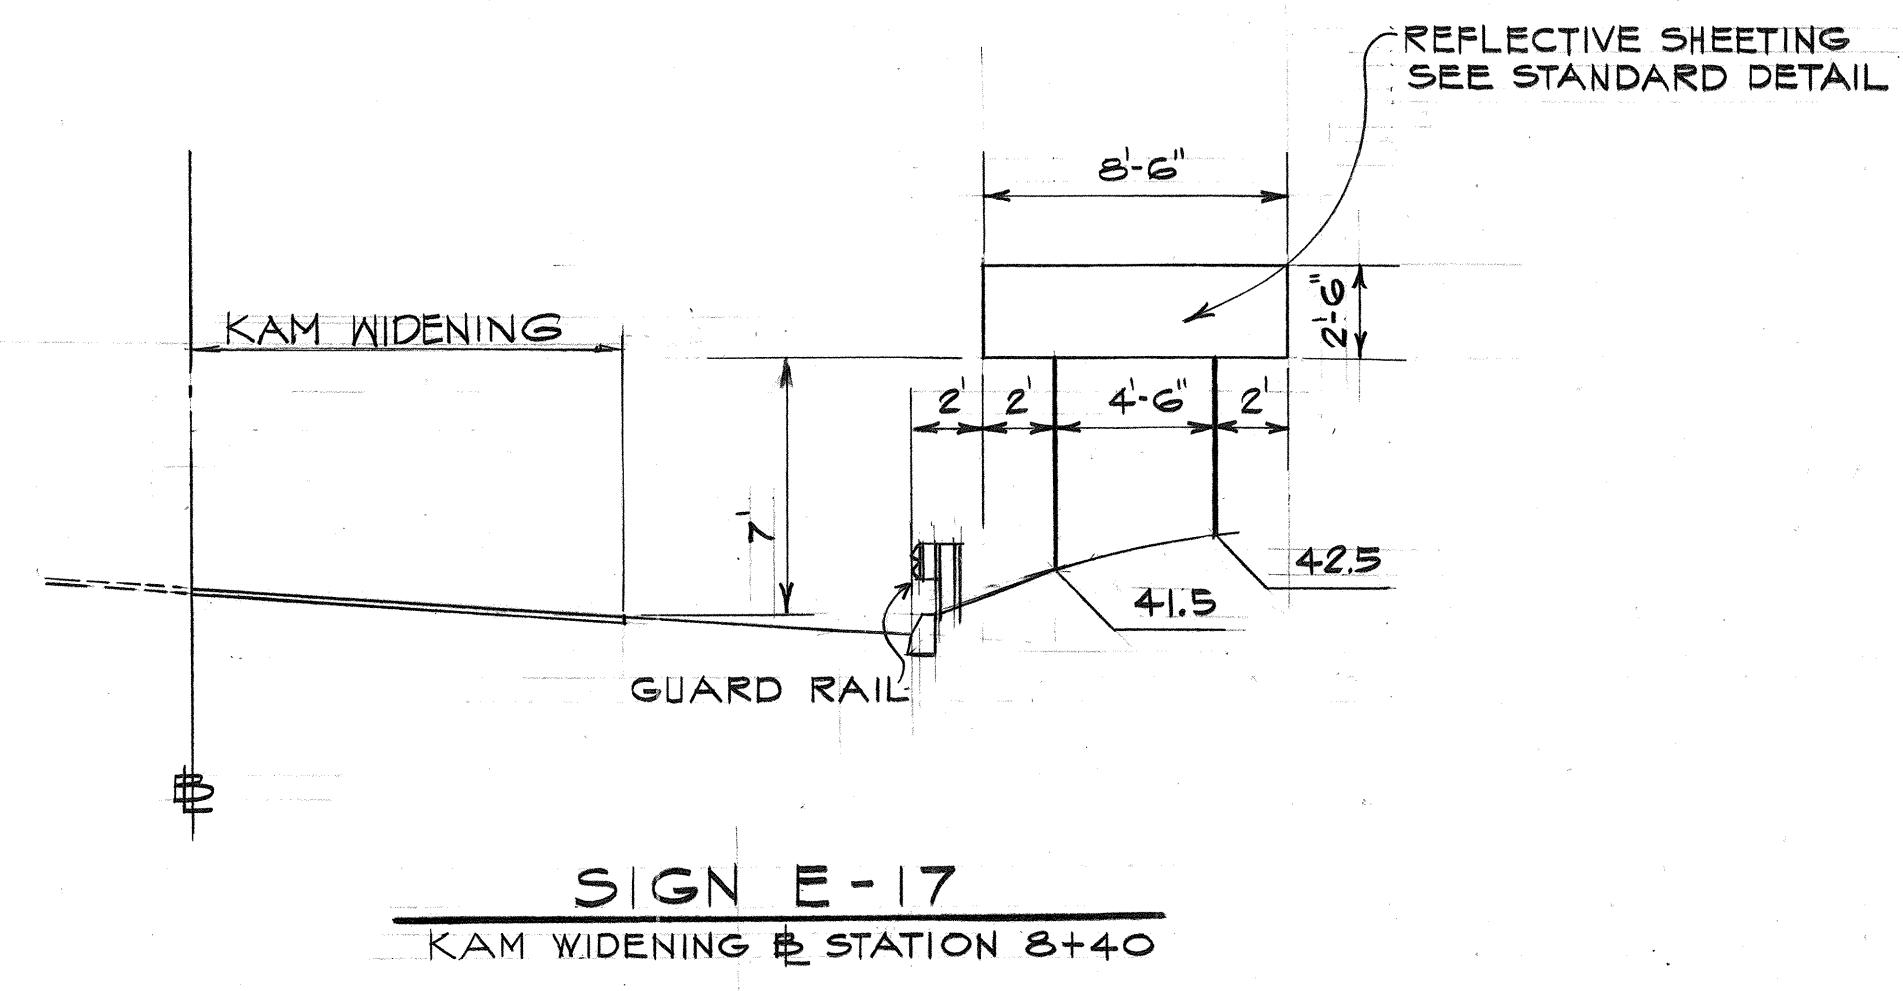

STATE OF HAWAII
DEPARTMENT OF TRANSPORTATION
HIGHWAYS DIVISION


PANEL AND FRAME LAYOUT
PEARL HARBOR INTERCHANGE
F.A.I. Proj. No. I-HI-1(111)14
Scale: As Shown Date: DEC. 14, 1973
SHEET NO. 2 OF 3 SHEETS

12/17/75	REVISED SIGN PANEL D-7
DATE	REVISION


THIS WORK WAS PREPARED BY ME OR UNDER MY SUPERVISION

ORIGINAL PLAN	SURVEY PLOTTED BY	DATE
NOTE BOOK	DRAWN BY	
No.	DESIGNED BY	
	QUANTITIES BY	
	CHECKED BY	


FED. ROAD DIST. NO.	STATE	FED. AID PROJ. NO.	FISCAL YEAR	SHEET NO.	TOTAL SHEETS
HAWAII	HAW.	I-H-1(11):14	1974	83	234

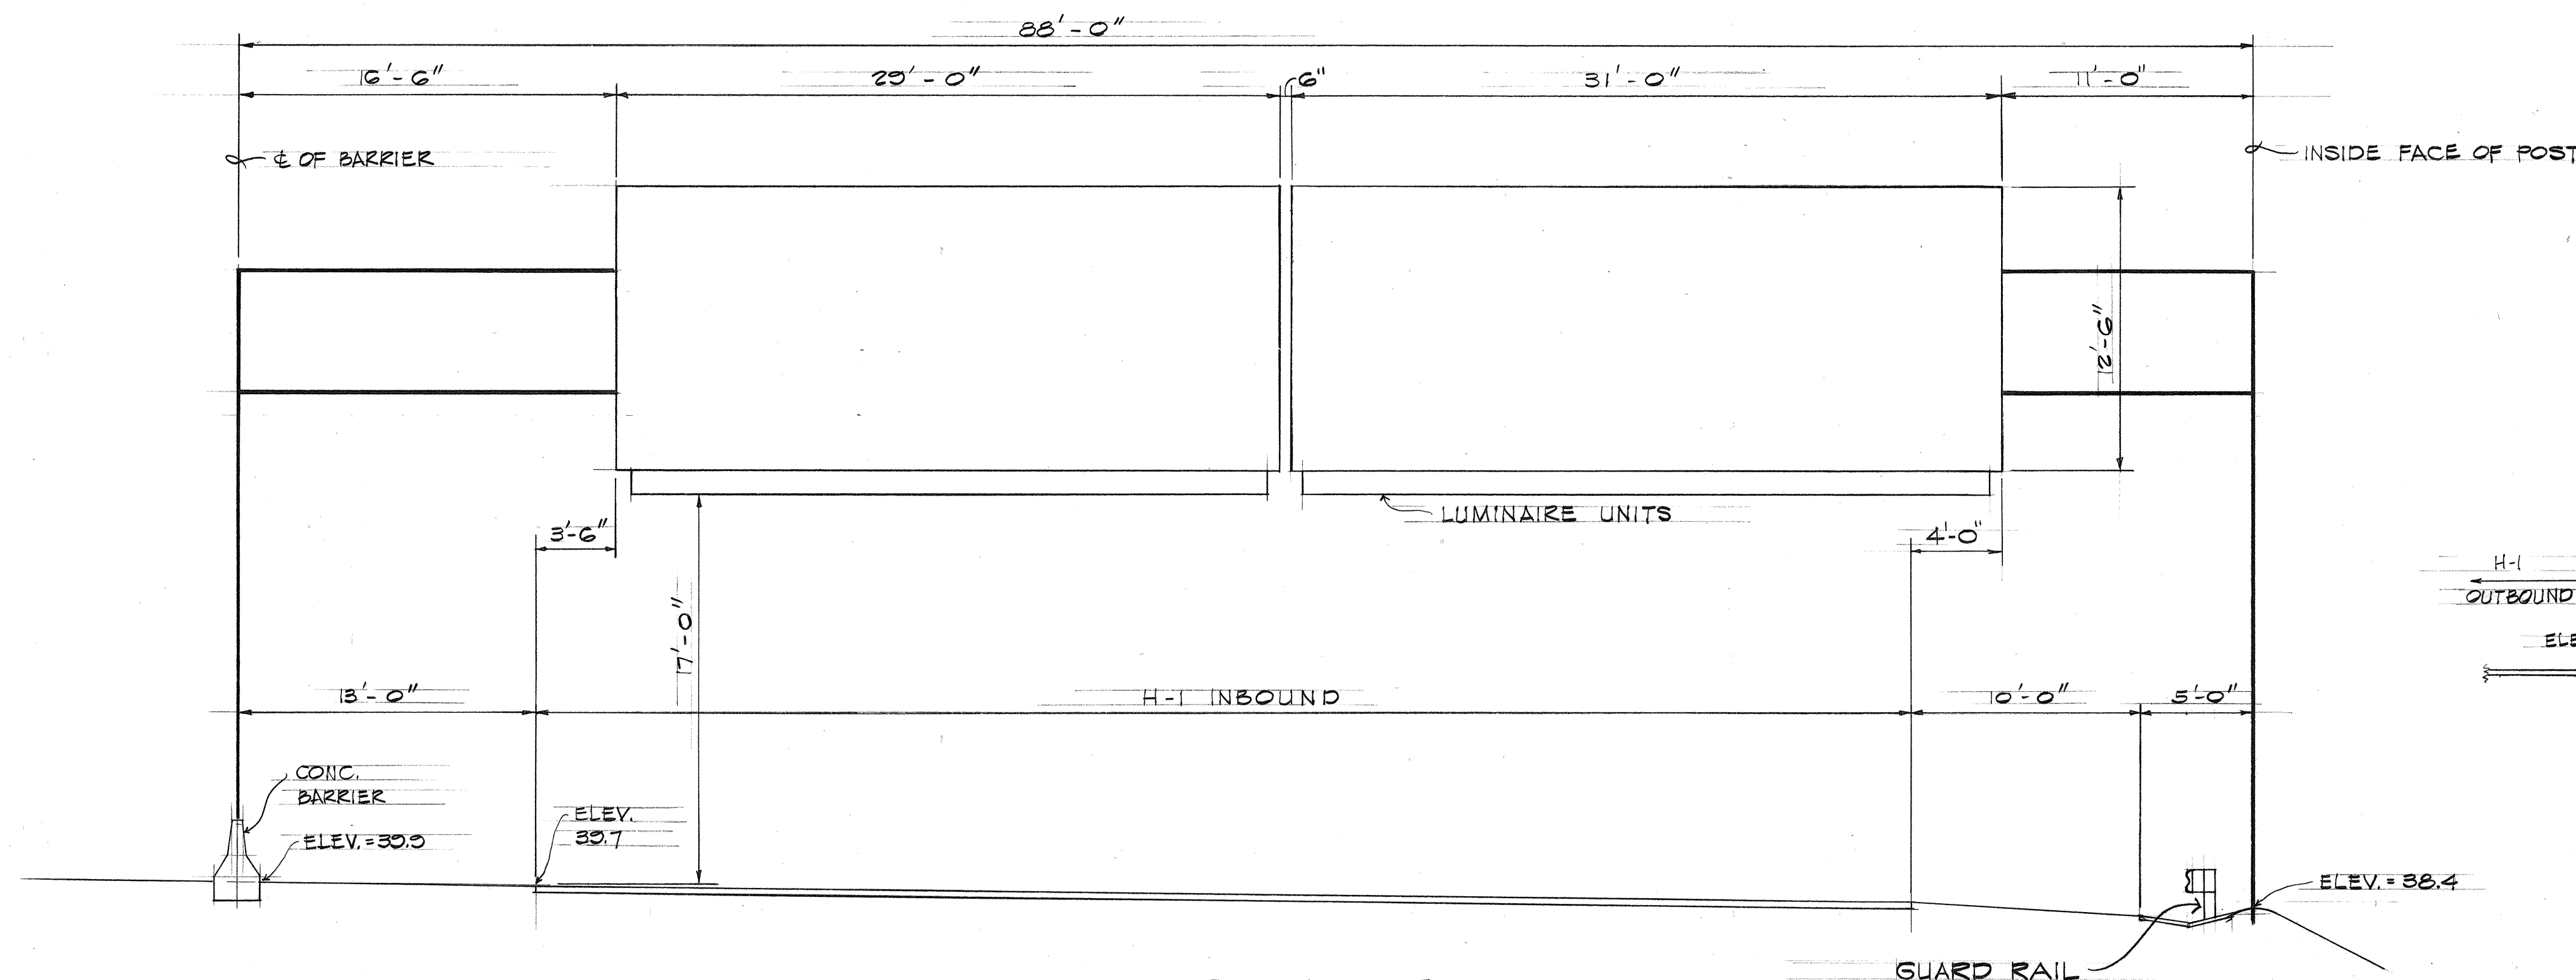


SIGN E-5
H-1 INBOUND STA. 56+00

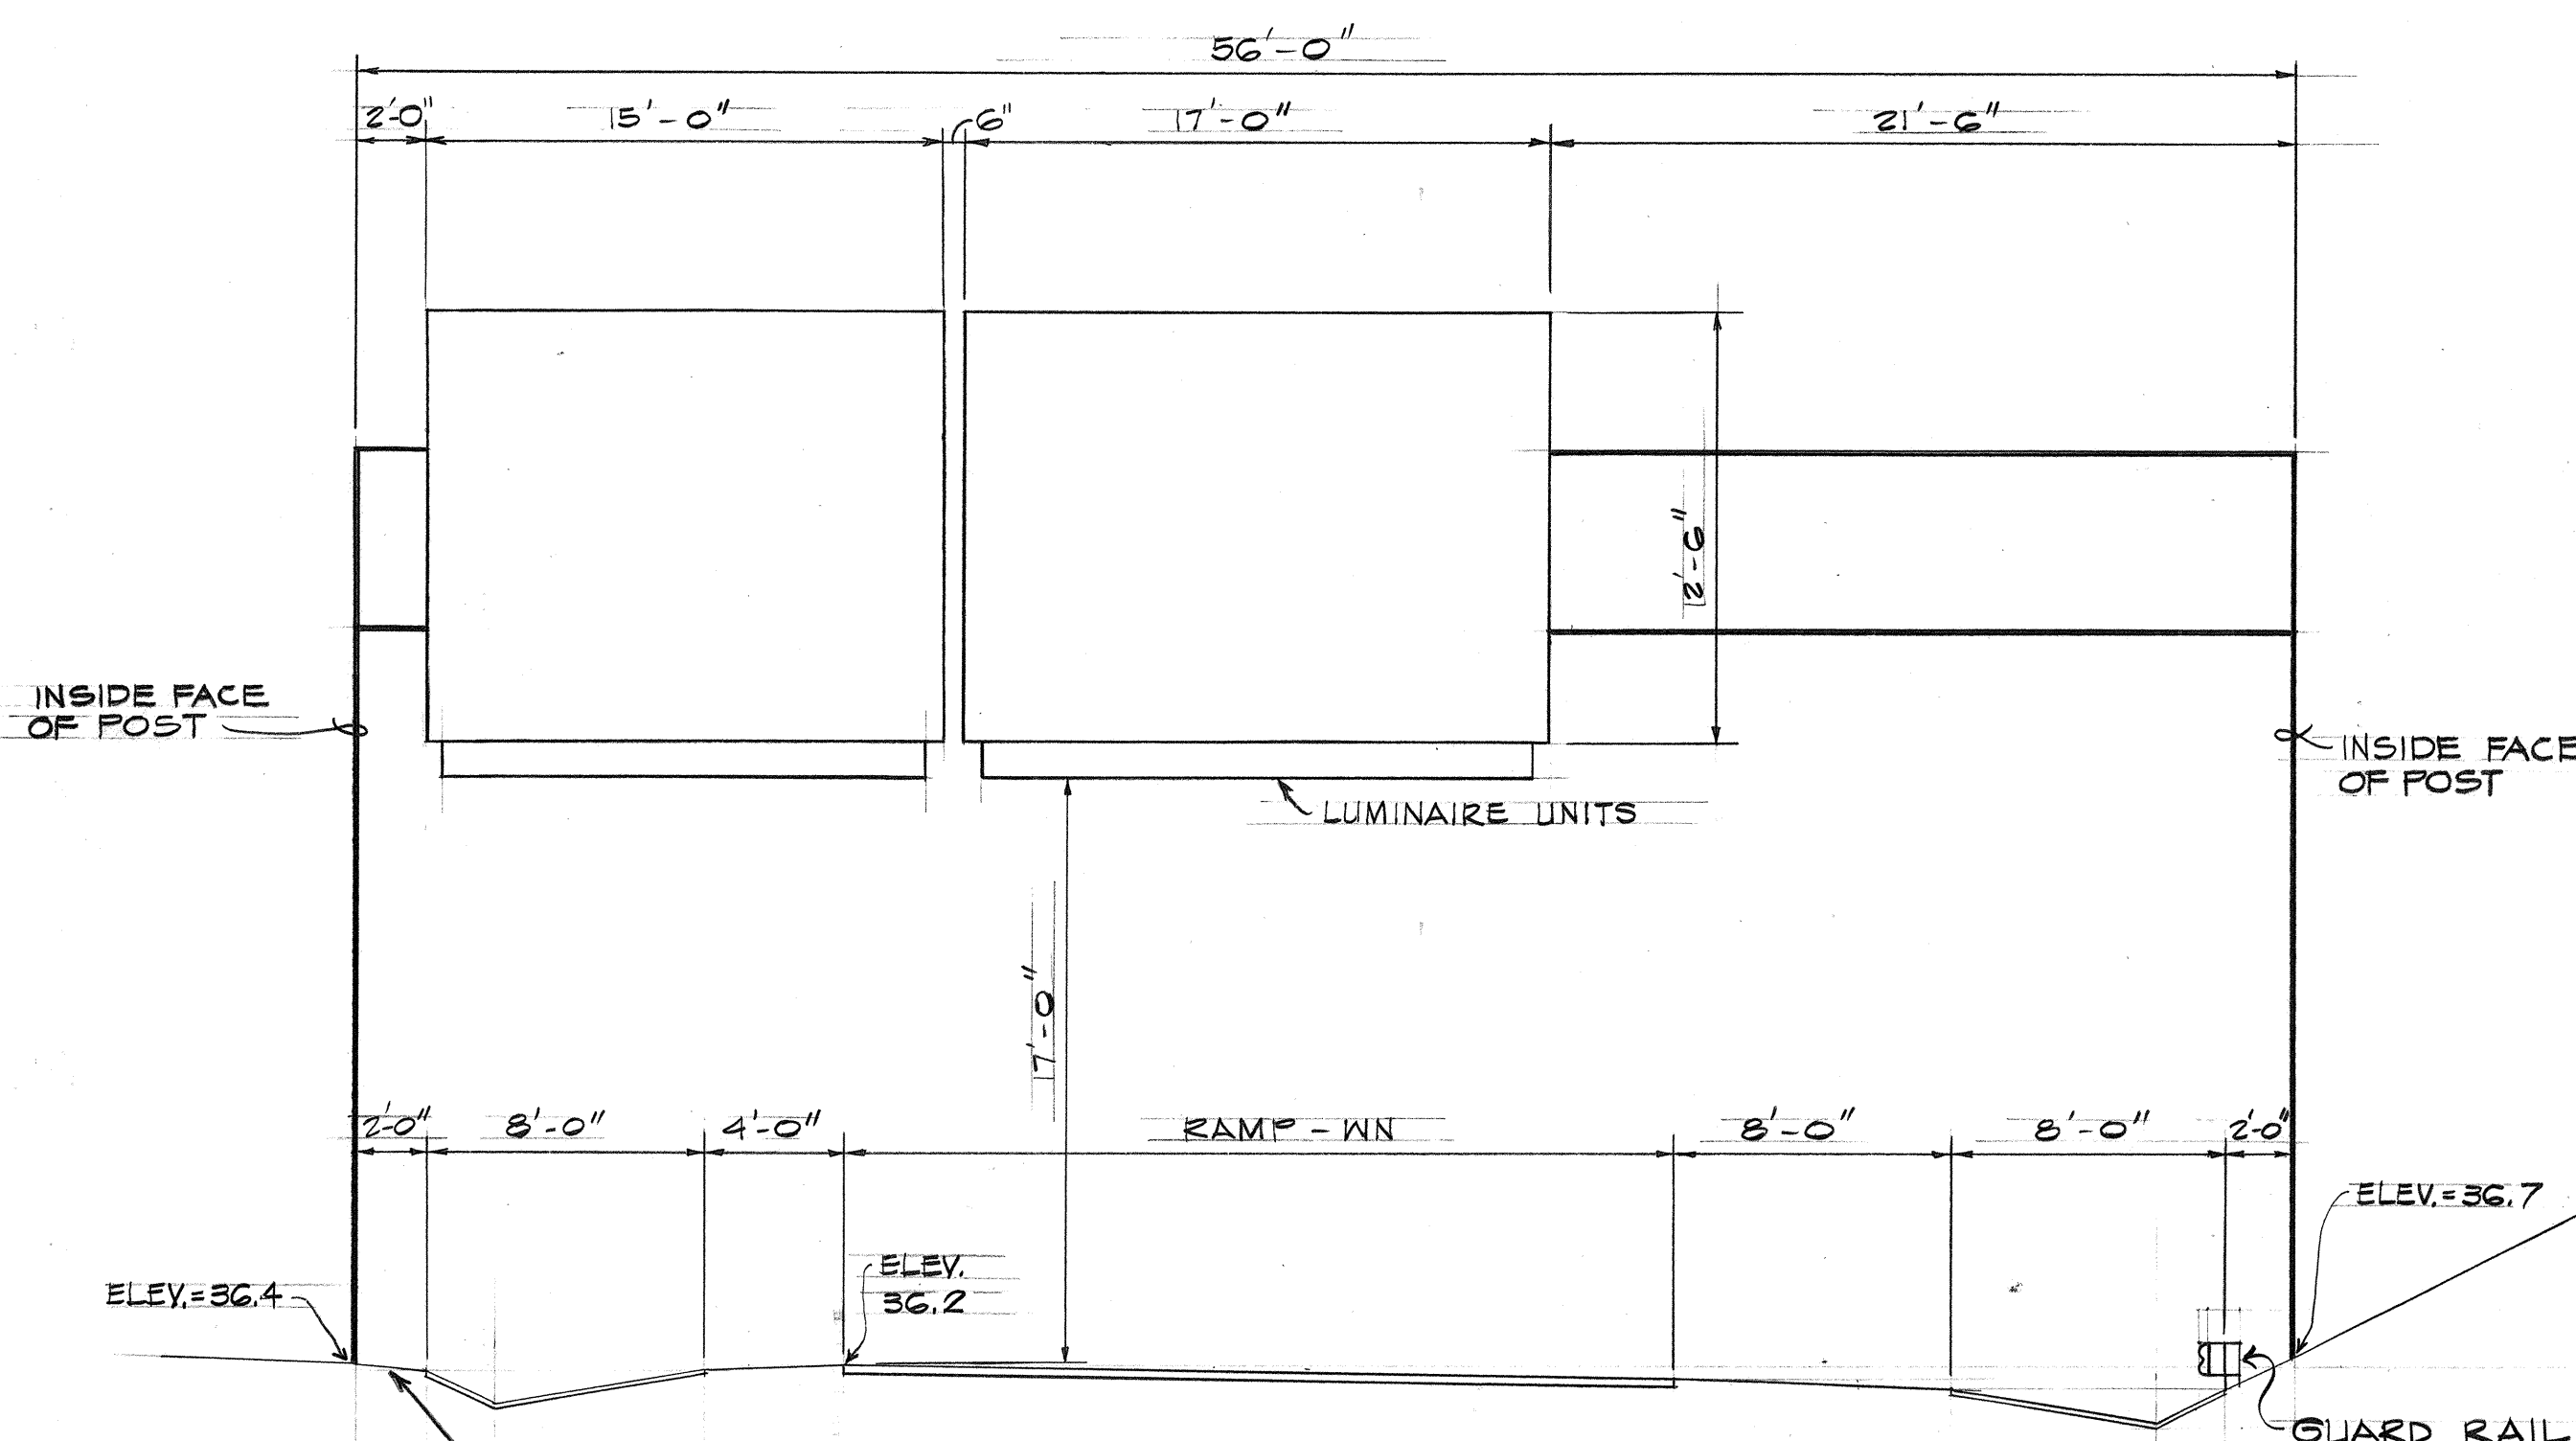


SIGN E-1
RAMP WN STA. 11+00
C.C.O. #51
11-17-76
SEE SHT. C.O. 77

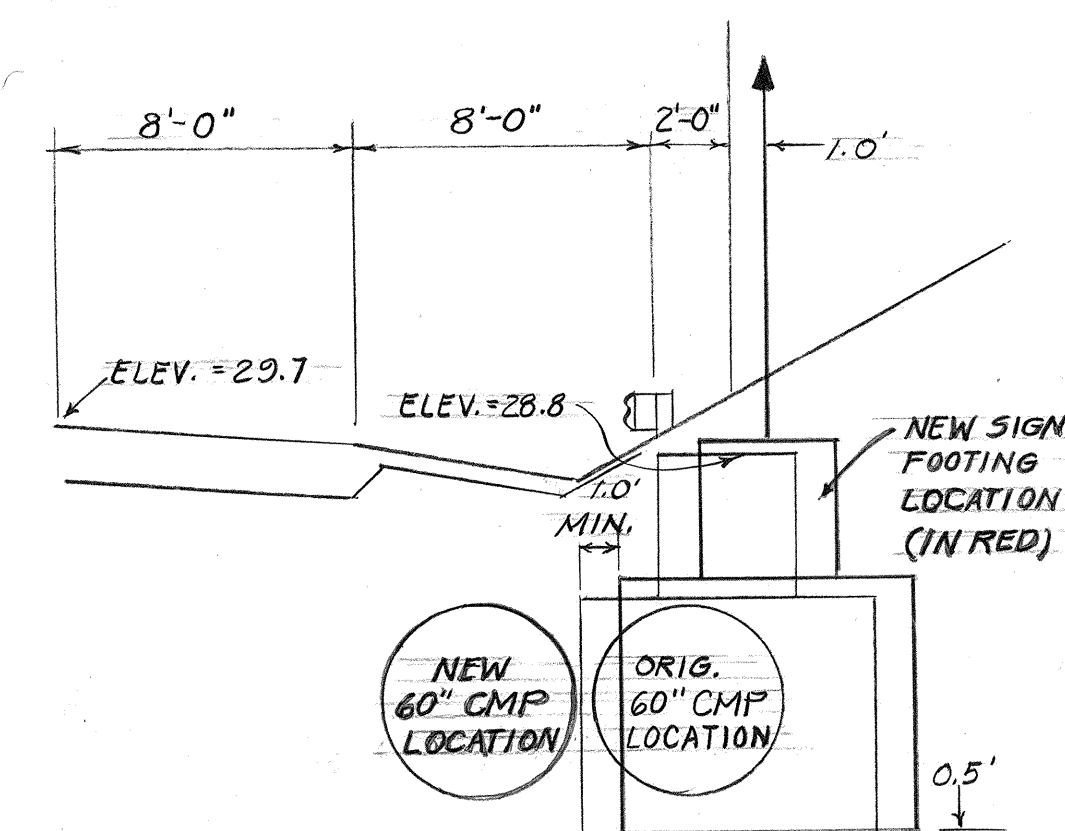


SIGN E-6
RAMP WN STA. 2+50
FIELD DIRECTIVE June 14, 1976
REFER TO SHTS. C.O. 39R, 42, C.O. 77 & 83

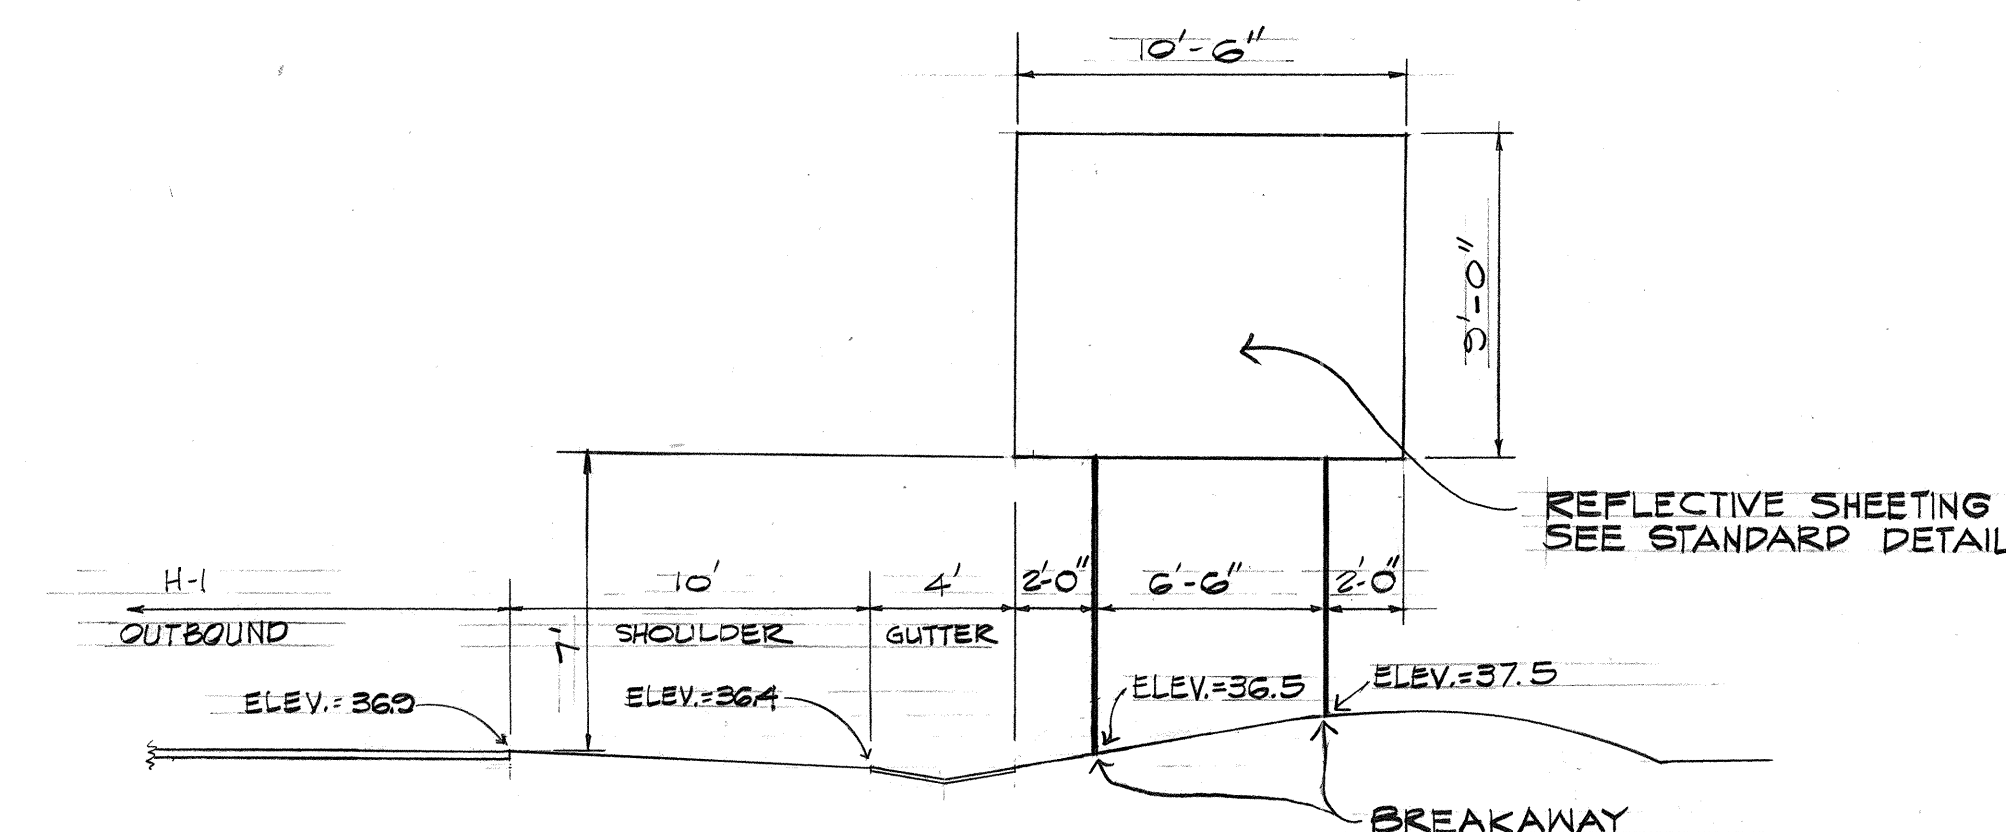

SIGN E-13
H-1 OUTBOUND STA. 53+00

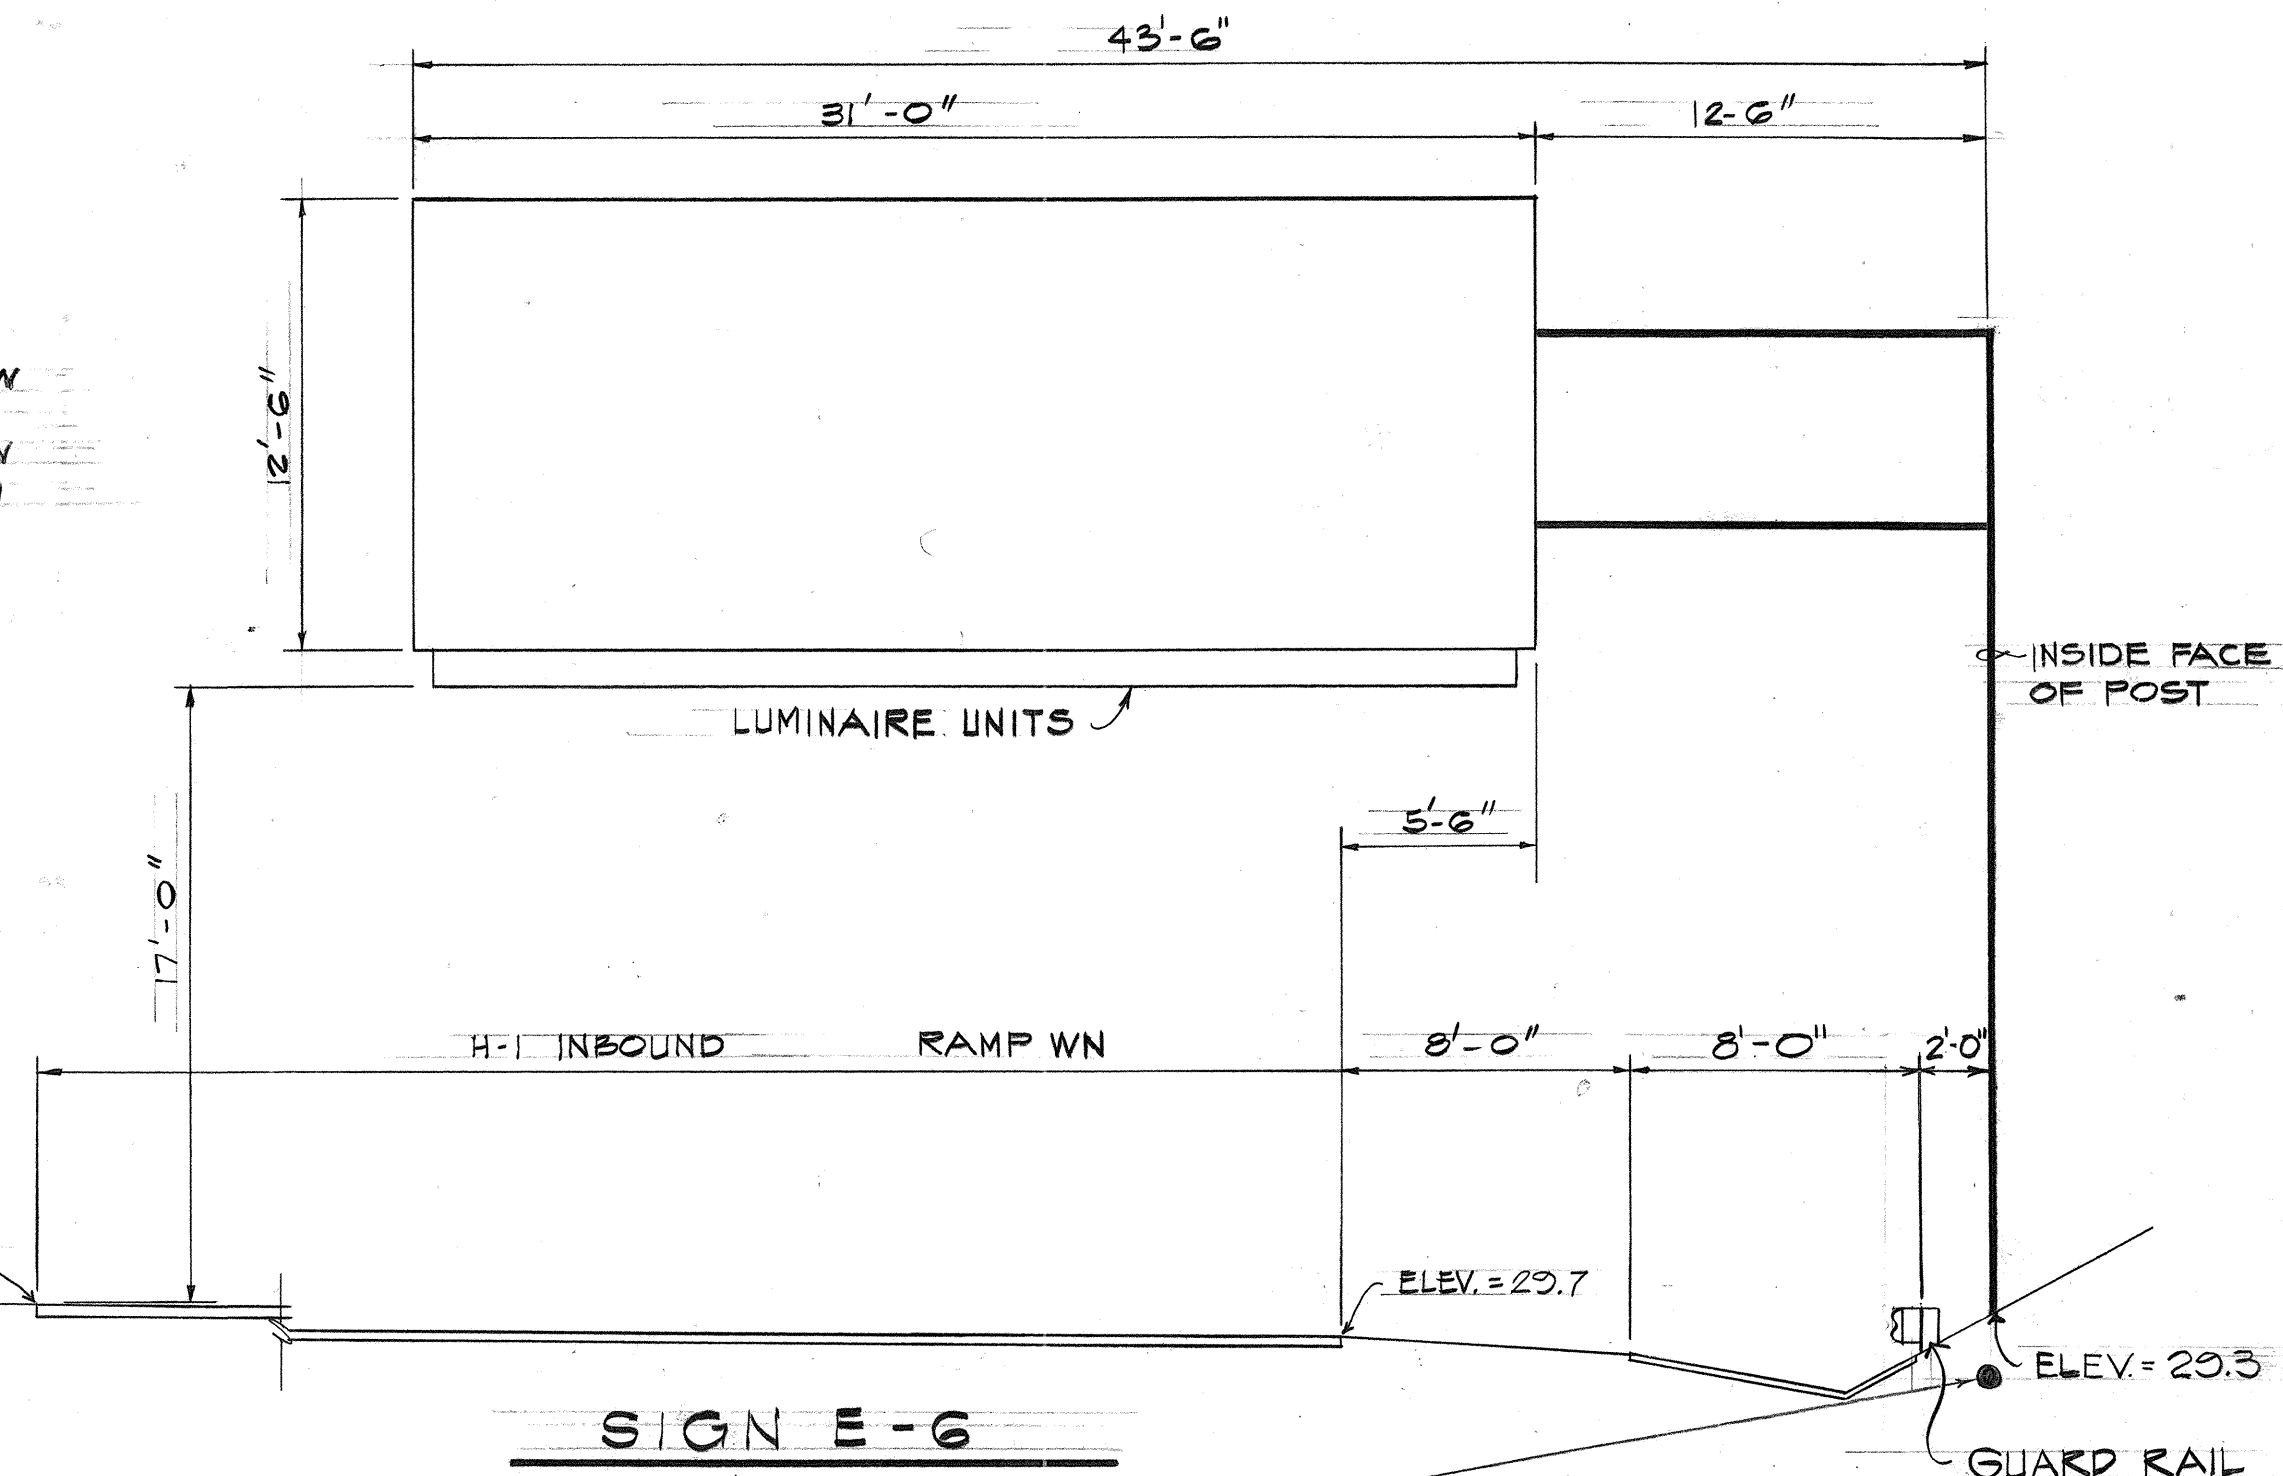

SIGN E-6
RAMP WN STA. 2+50
FIELD DIRECTIVE June 14, 1976
SEE DRAWING ON LEFT (IN RED). FIELD REVISION FOR THE CONFLICT BETWEEN THE 60-INCH CMP DRAINLINE AND SIGN E-6 FOOTING AT RAMP WN STA. 2+50 1/2 RT.

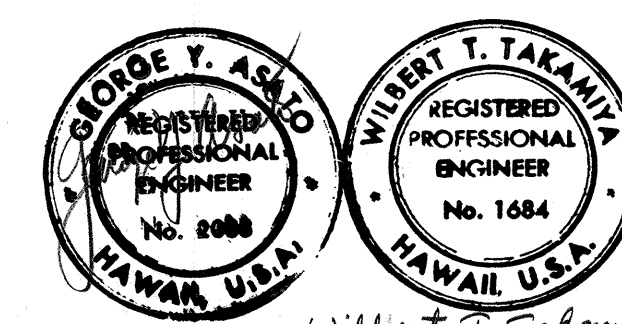

THIS WORK WAS PREPARED BY ME OR UNDER MY SUPERVISION

STATE OF HAWAII
DEPARTMENT OF TRANSPORTATION
HIGHWAYS DIVISION

FRAME LAYOUT

PEARL HARBOR INTERCHANGE
F.A.I. Proj. No. I-H-1(11):14

Scale: As Shown Date: DEC 14, 1973

SHEET NO. 3 OF 3 SHEETS