


FED. ROAD DIST. NO.	STATE	FED. AID PROJ. NO.	FISCAL YEAR	SHEET NO.	TOTAL SHEETS
HAWAII	HAW.	I-HI-1(73):15	1974	51	369

TRUE NORTH
SCALE: 1" = 50'

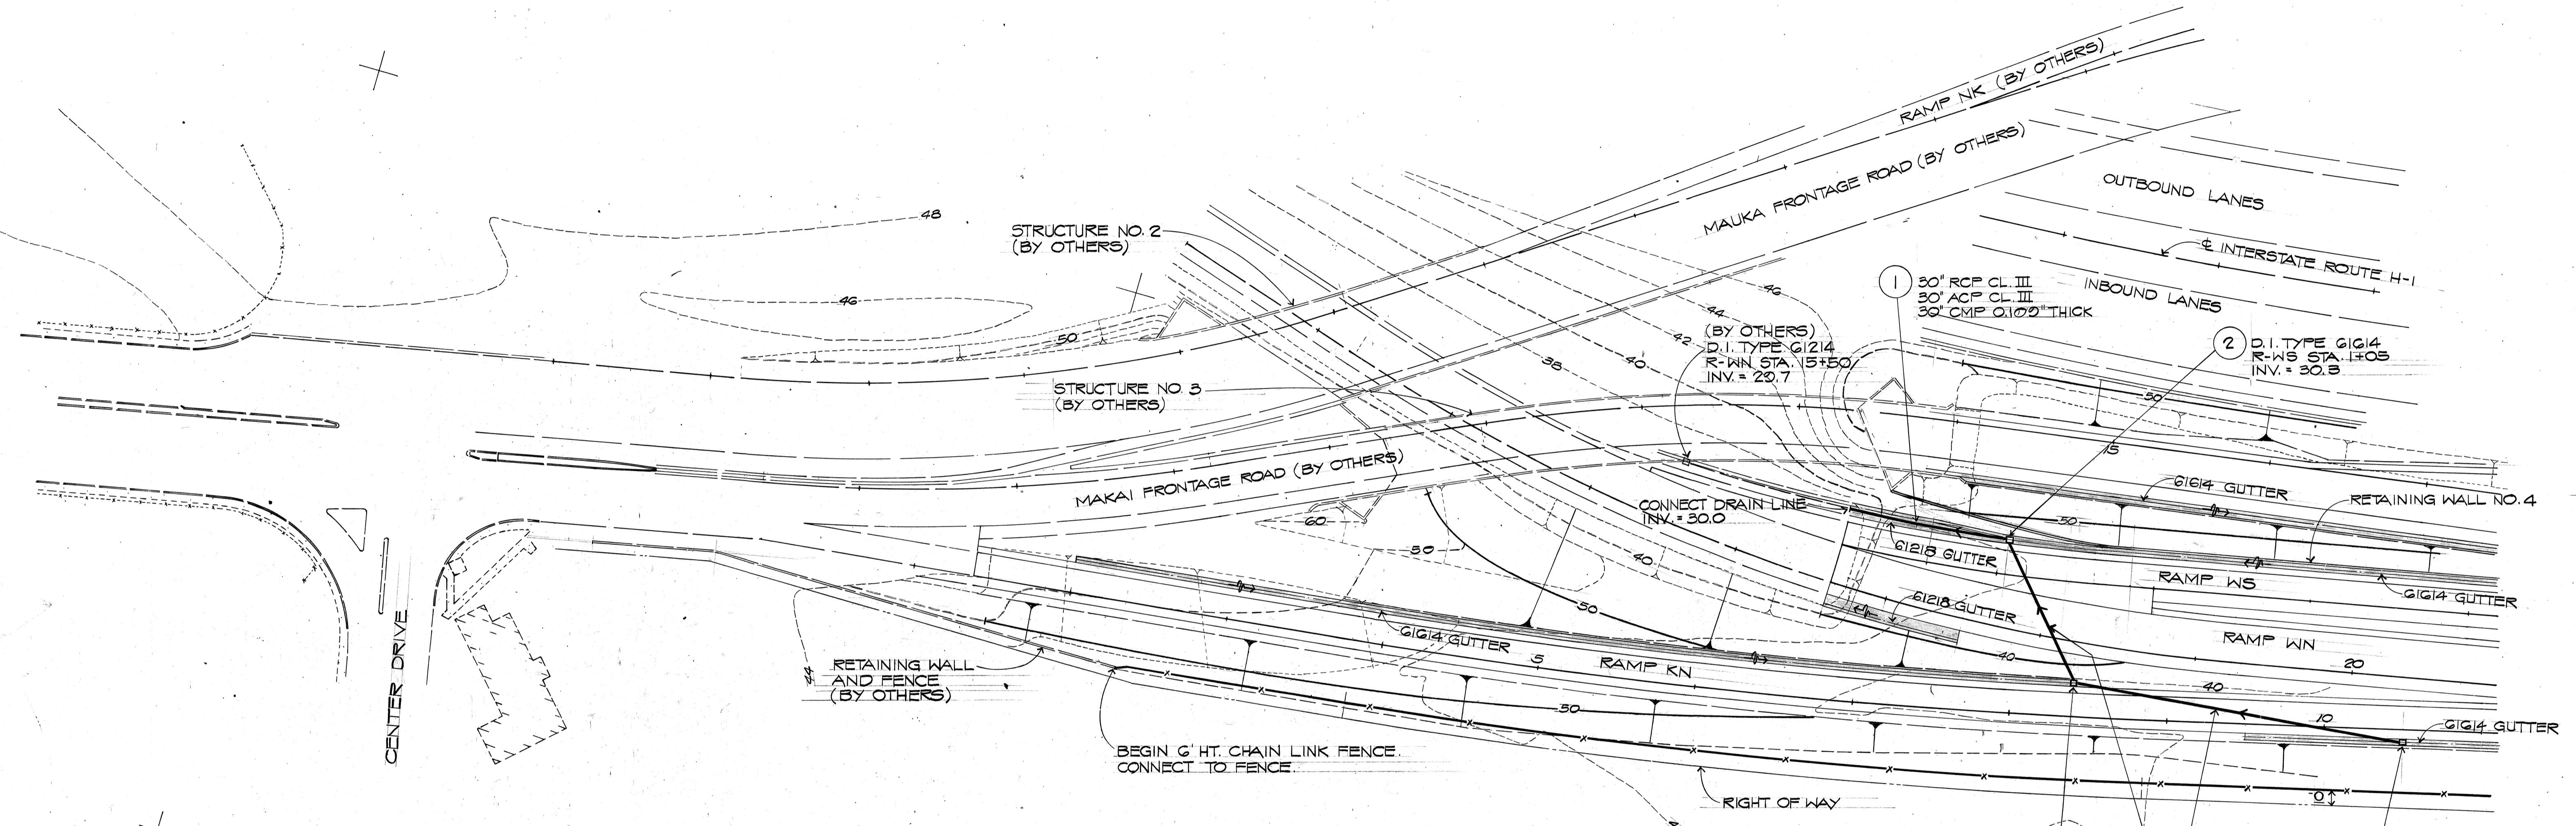

ABBREVIATION

ACP	ASBESTOS CEMENT PIPE
CMP	CORRUGATED METAL PIPE
RCP	REINFORCED CONCRETE PIPE
CL	CLASS
%S	OFFSET
INV	INVERT ELEVATION
THICK	THICKNESS
CIPP	CAST-IN-PLACE CONCRETE PIPE

LEGEND

- 50-- EXISTING CONTOUR
 - 50— FINISH CONTOUR
 - FLOW DIRECTION (SURFACE)
 - FLOW DIRECTION (PIPE)
 - (No) DRAINAGE STRUCTURE NUMBER

PLAN

SCALE: 1" = 50'



**STATE OF HAWAII
DEPARTMENT OF TRANSPORTATION**

GRADING & DRAINAGE PLAN

PEARL HARBOR INTERCHANGE
A.I. PROJ. NO. I - HI - 1 (73) : 15

Wilbert S. Tokamiya
THIS WORK WAS PREPARED BY ME
OR UNDER MY SUPERVISION

DATE	REVISION
7/20/75	REVISED EXISTING GRADING BETWEEN R-KN AND MAKAI F.R.


FED. ROAD DIST. NO.	STATE	FED. AID PROJ. NO.	FISCAL YEAR	SHEET NO.	TOTAL SHEETS
HAWAII	HAW.	I-HI-(73)	1974	52	369

PROJECT LIMIT


**BOX CULVERT
CURVE DATA**

$\Delta = 90^{\circ} 00' 00''$
 $\delta/2 = 45^{\circ} 00' 00''$
 $R = 125.00'$
 $T = 125.00'$
 $Ch = 176.78'$
 $Lc = 06.35'$

TRUE NORTH
SCALE: 1" = 50'

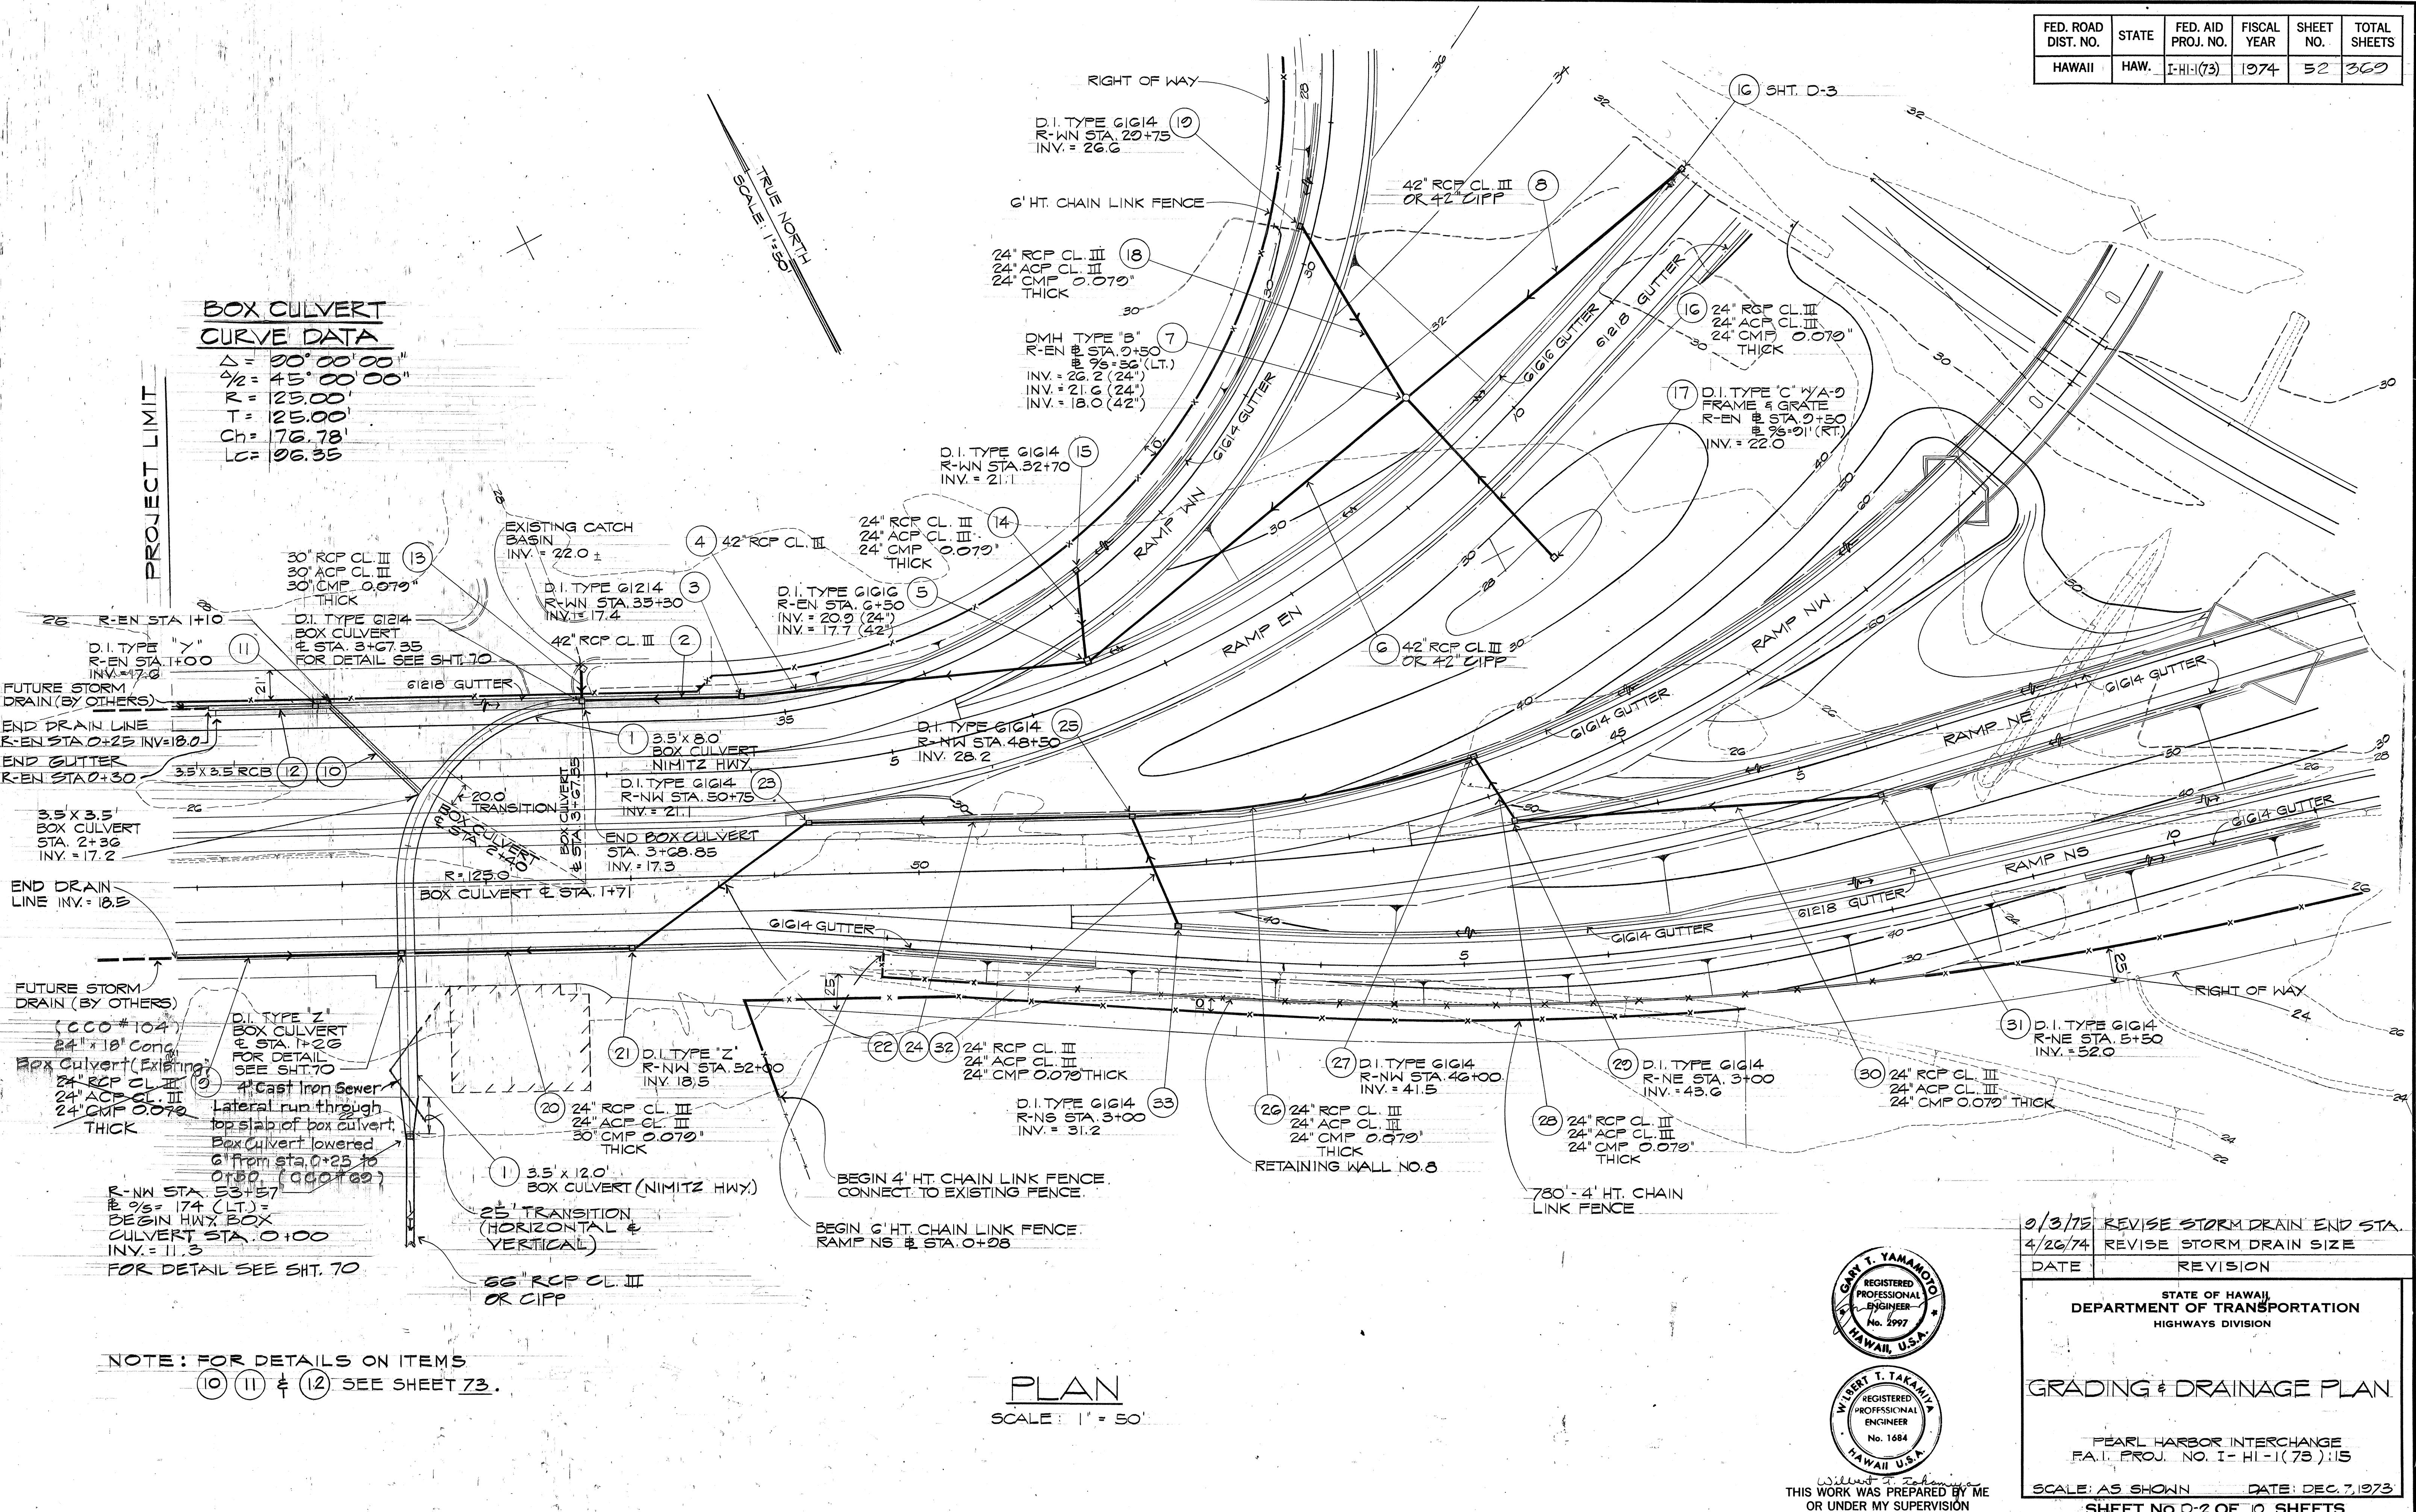

FED. ROAD DIST. NO.	STATE	FED. AID PROJ. NO.	FISCAL YEAR	SHEET NO.	TOTAL SHEETS
HAWAII	HAW.	I-HI-1(73):15	1974	53	369

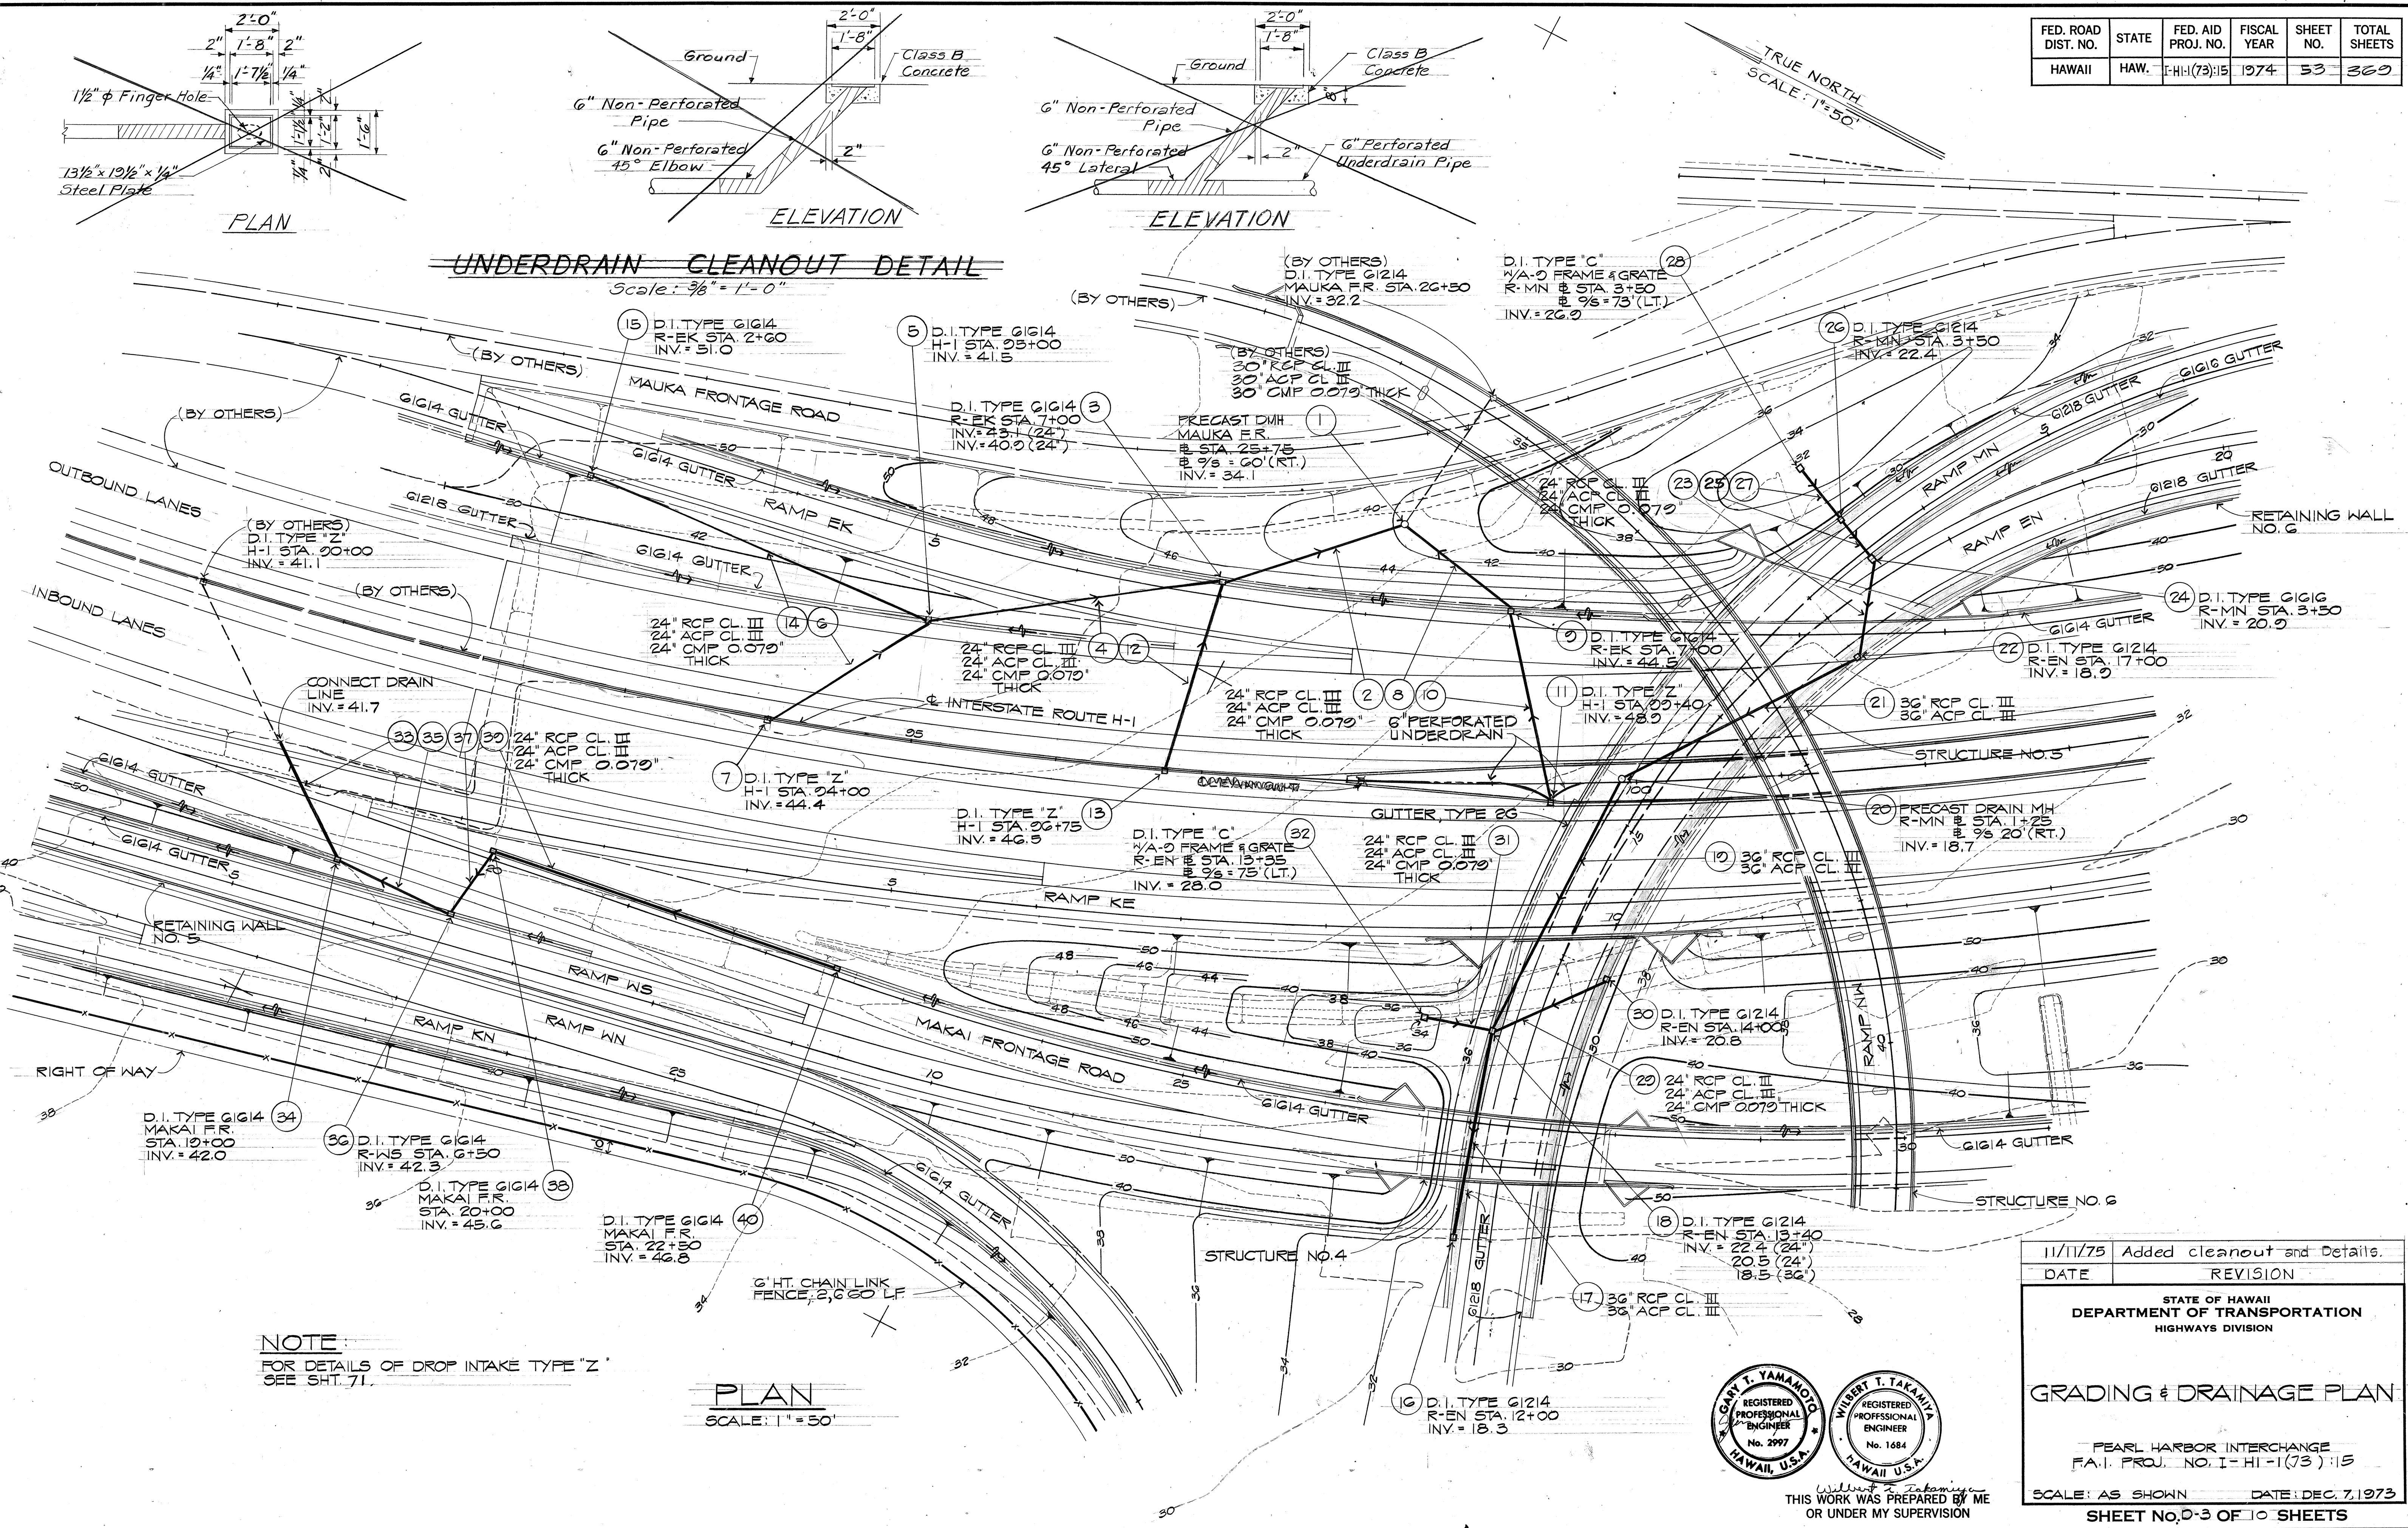

ORIGINAL PLAN	SURVEY PLOTTED BY _____ DRAWN BY _____	DATE _____ " _____
NOTE BOOK No. _____	TRACED BY _____ DESIGNED BY _____	" _____
	QUANTITIES BY _____	" _____
	CHECKED BY _____	" _____

NOTE:
FOR DETAILS OF DROP INTAKE TYPE
SEE SHT. 71

PLAN

Wilbert I. Takamiya
THIS WORK WAS PREPARED BY ME
OR UNDER MY SUPERVISION

11/11/75 | Added cleanout and Details.

**STATE OF HAWAII
DEPARTMENT OF TRANSPORTATION
HIGHWAYS DIVISION**

GRADING & DRAINAGE PLAN

FEB 20 1973


~~PEARL HARBOR INTERCHANGE~~

F.A.I. PROJ. NO. I-HI-1(73) : 5

SHEET No D-3 OF 10 SHEETS

C053

FED. ROAD DIST. NO.	STATE	FED. AID PROJ. NO.	FISCAL YEAR	SHEET NO.	TOTAL SHEETS
HAWAII	HAW.	I-HI-1(73)E	1974	55	369

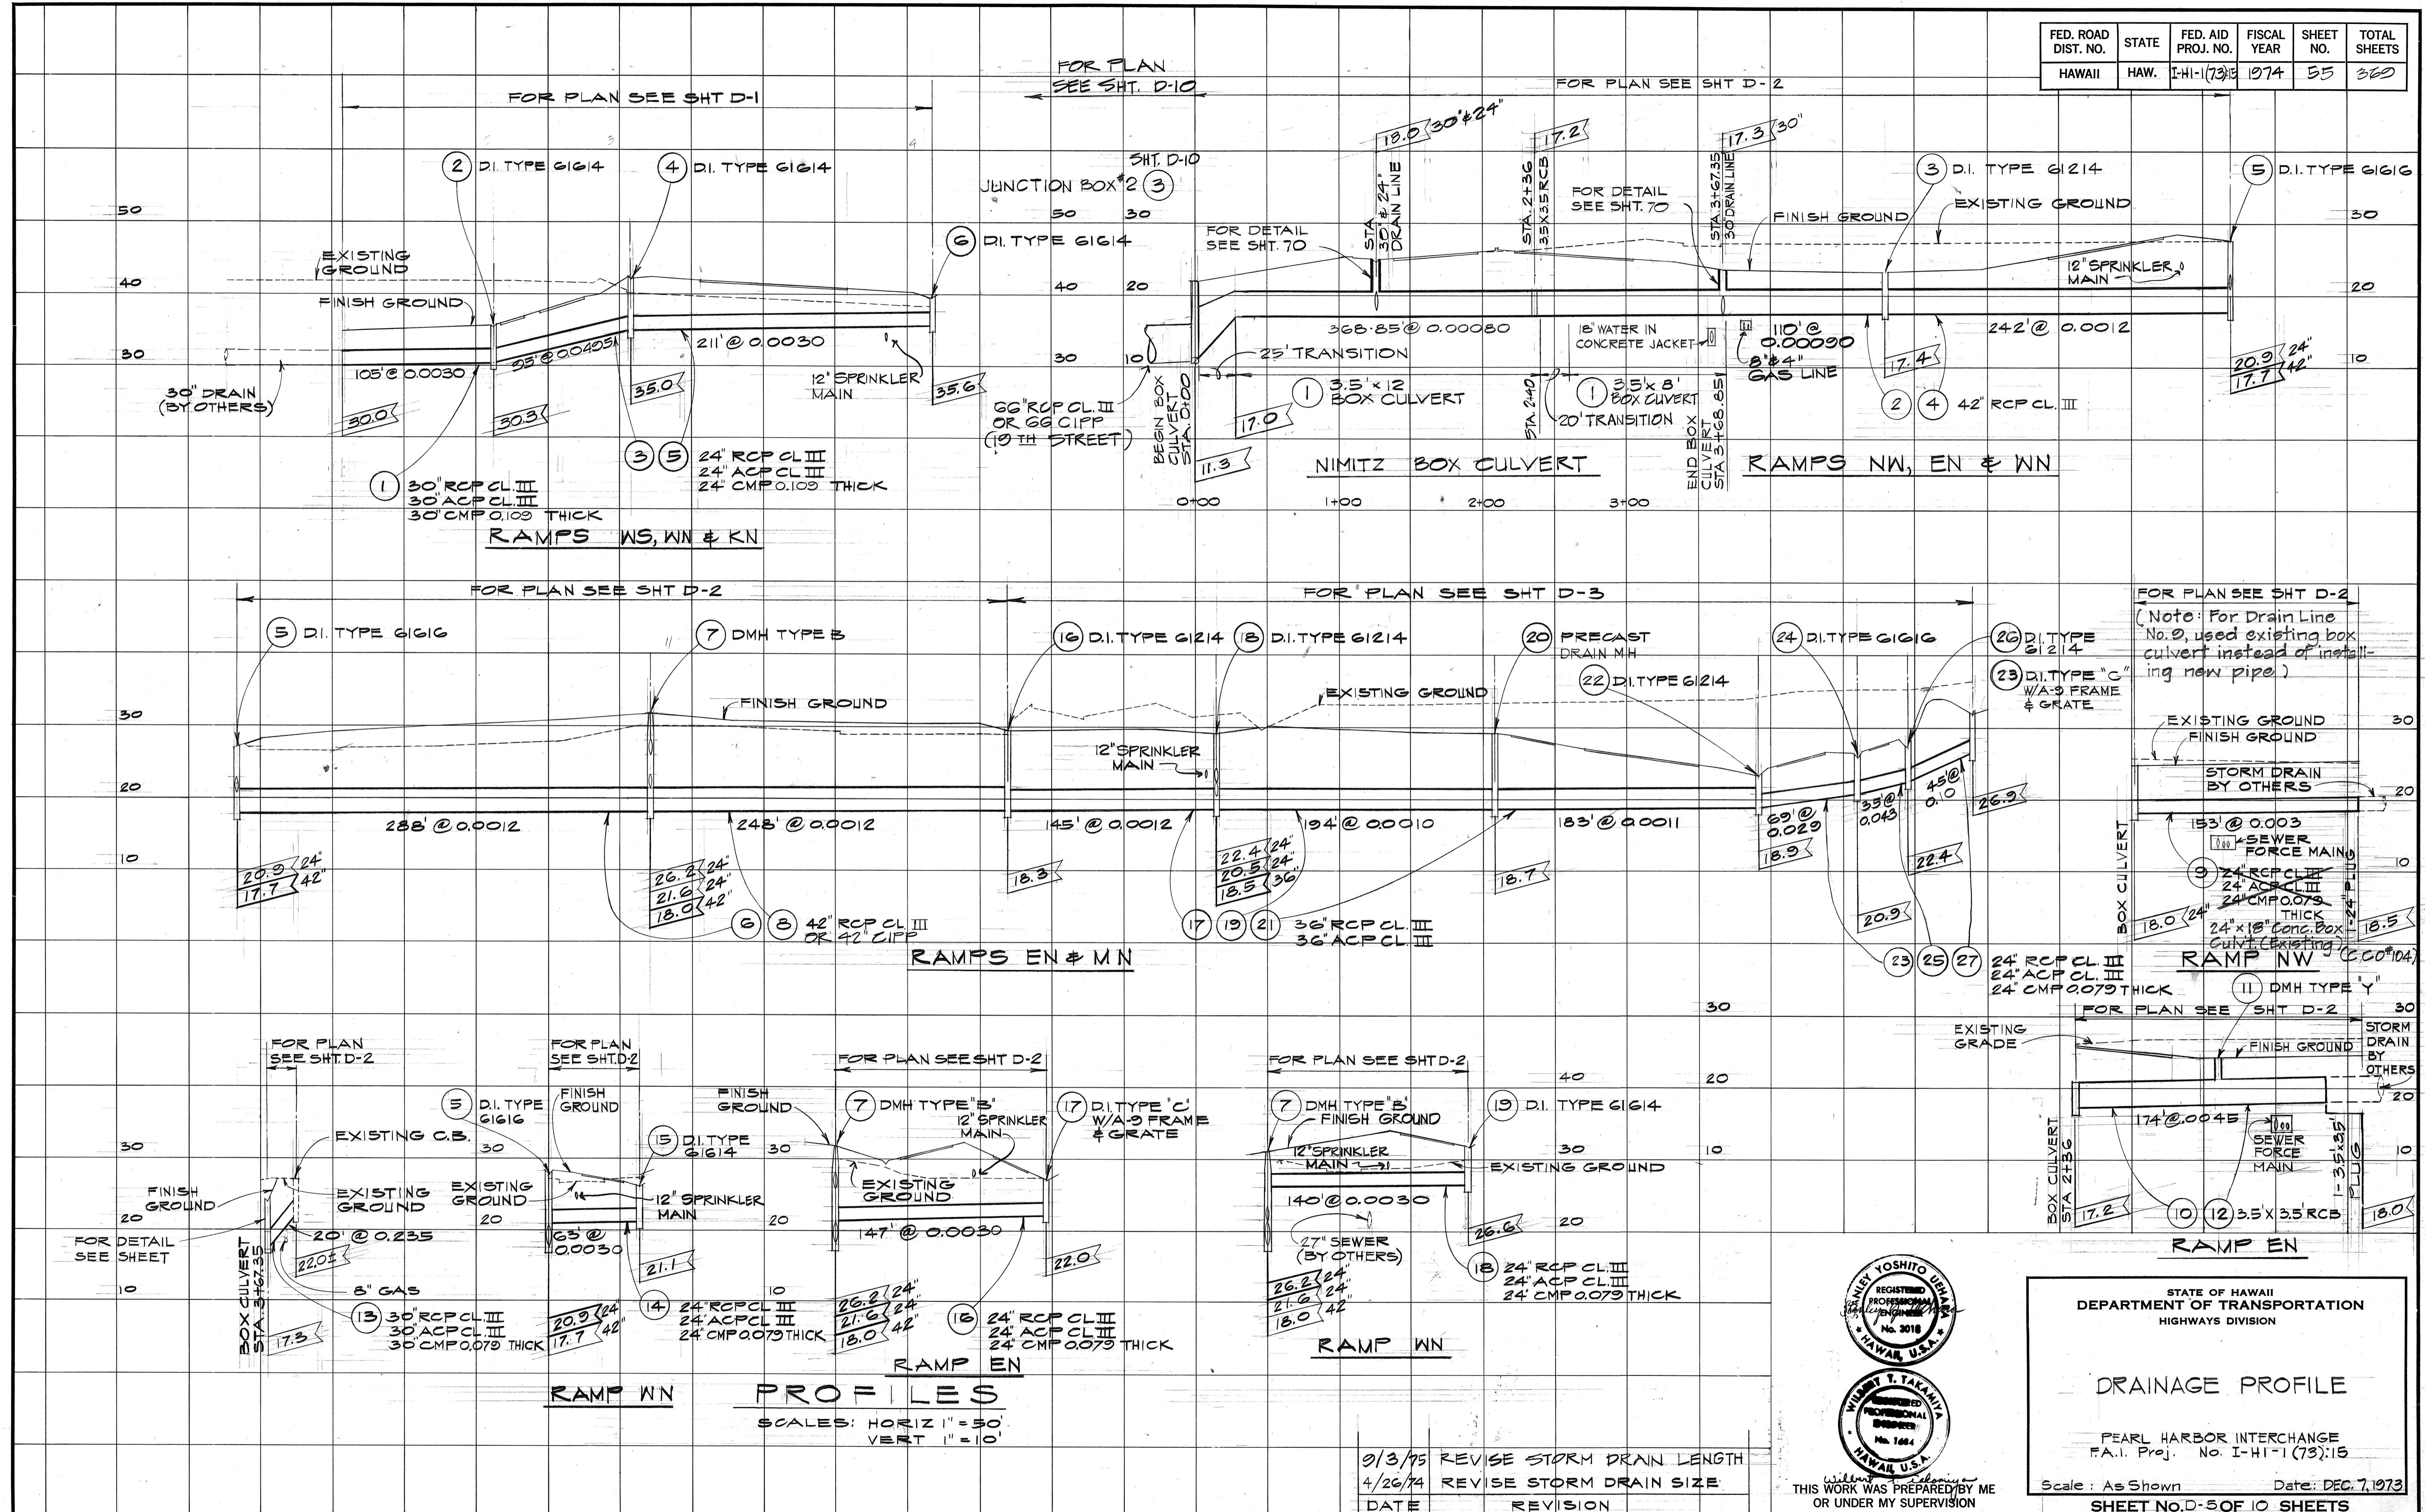

**STATE OF HAWAII
DEPARTMENT OF TRANSPORTATION
HIGHWAYS DIVISION**

PEARL HARBOR INTERCHANGE
F.A.I. Proj. No. I-HI-1(73):15


PEARL HARBOR INTERCHANGE
F.A.I. Proj. No. I-HI-1(73):15

A circular black and white stamp. The outer ring contains the text "WILEY YOSHITO UEHARA" at the top and "HAWAII U.S.A." at the bottom. Inside the circle, the words "REGISTERED", "PROFESSIONAL", and "ENGINEER" are stacked vertically in the center. At the bottom of the circle, "No. 3018" is printed. There is some faint, illegible cursive handwriting across the center of the stamp.

A circular black and white stamp. The outer ring contains the text "WILBERT T. TAKAMIYA" at the top and "HAWAII, U.S.A." at the bottom. The inner circle contains "PROFESSIONAL" at the top, "PHOTOGRAPHER" in the center, and "No. 1684" at the bottom.

9/3/75	REVISE STORM DRAIN LENGTH
4/26/74	REVISE STORM DRAIN SIZE
DATE	REVISION

FED. ROAD DIST. NO.	STATE	FED. AID PROJ. NO.	FISCAL YEAR	SHEET NO.	TOTAL SHEETS
HAWAII	HAW.	I-HI-I(73)15	1974	56	369

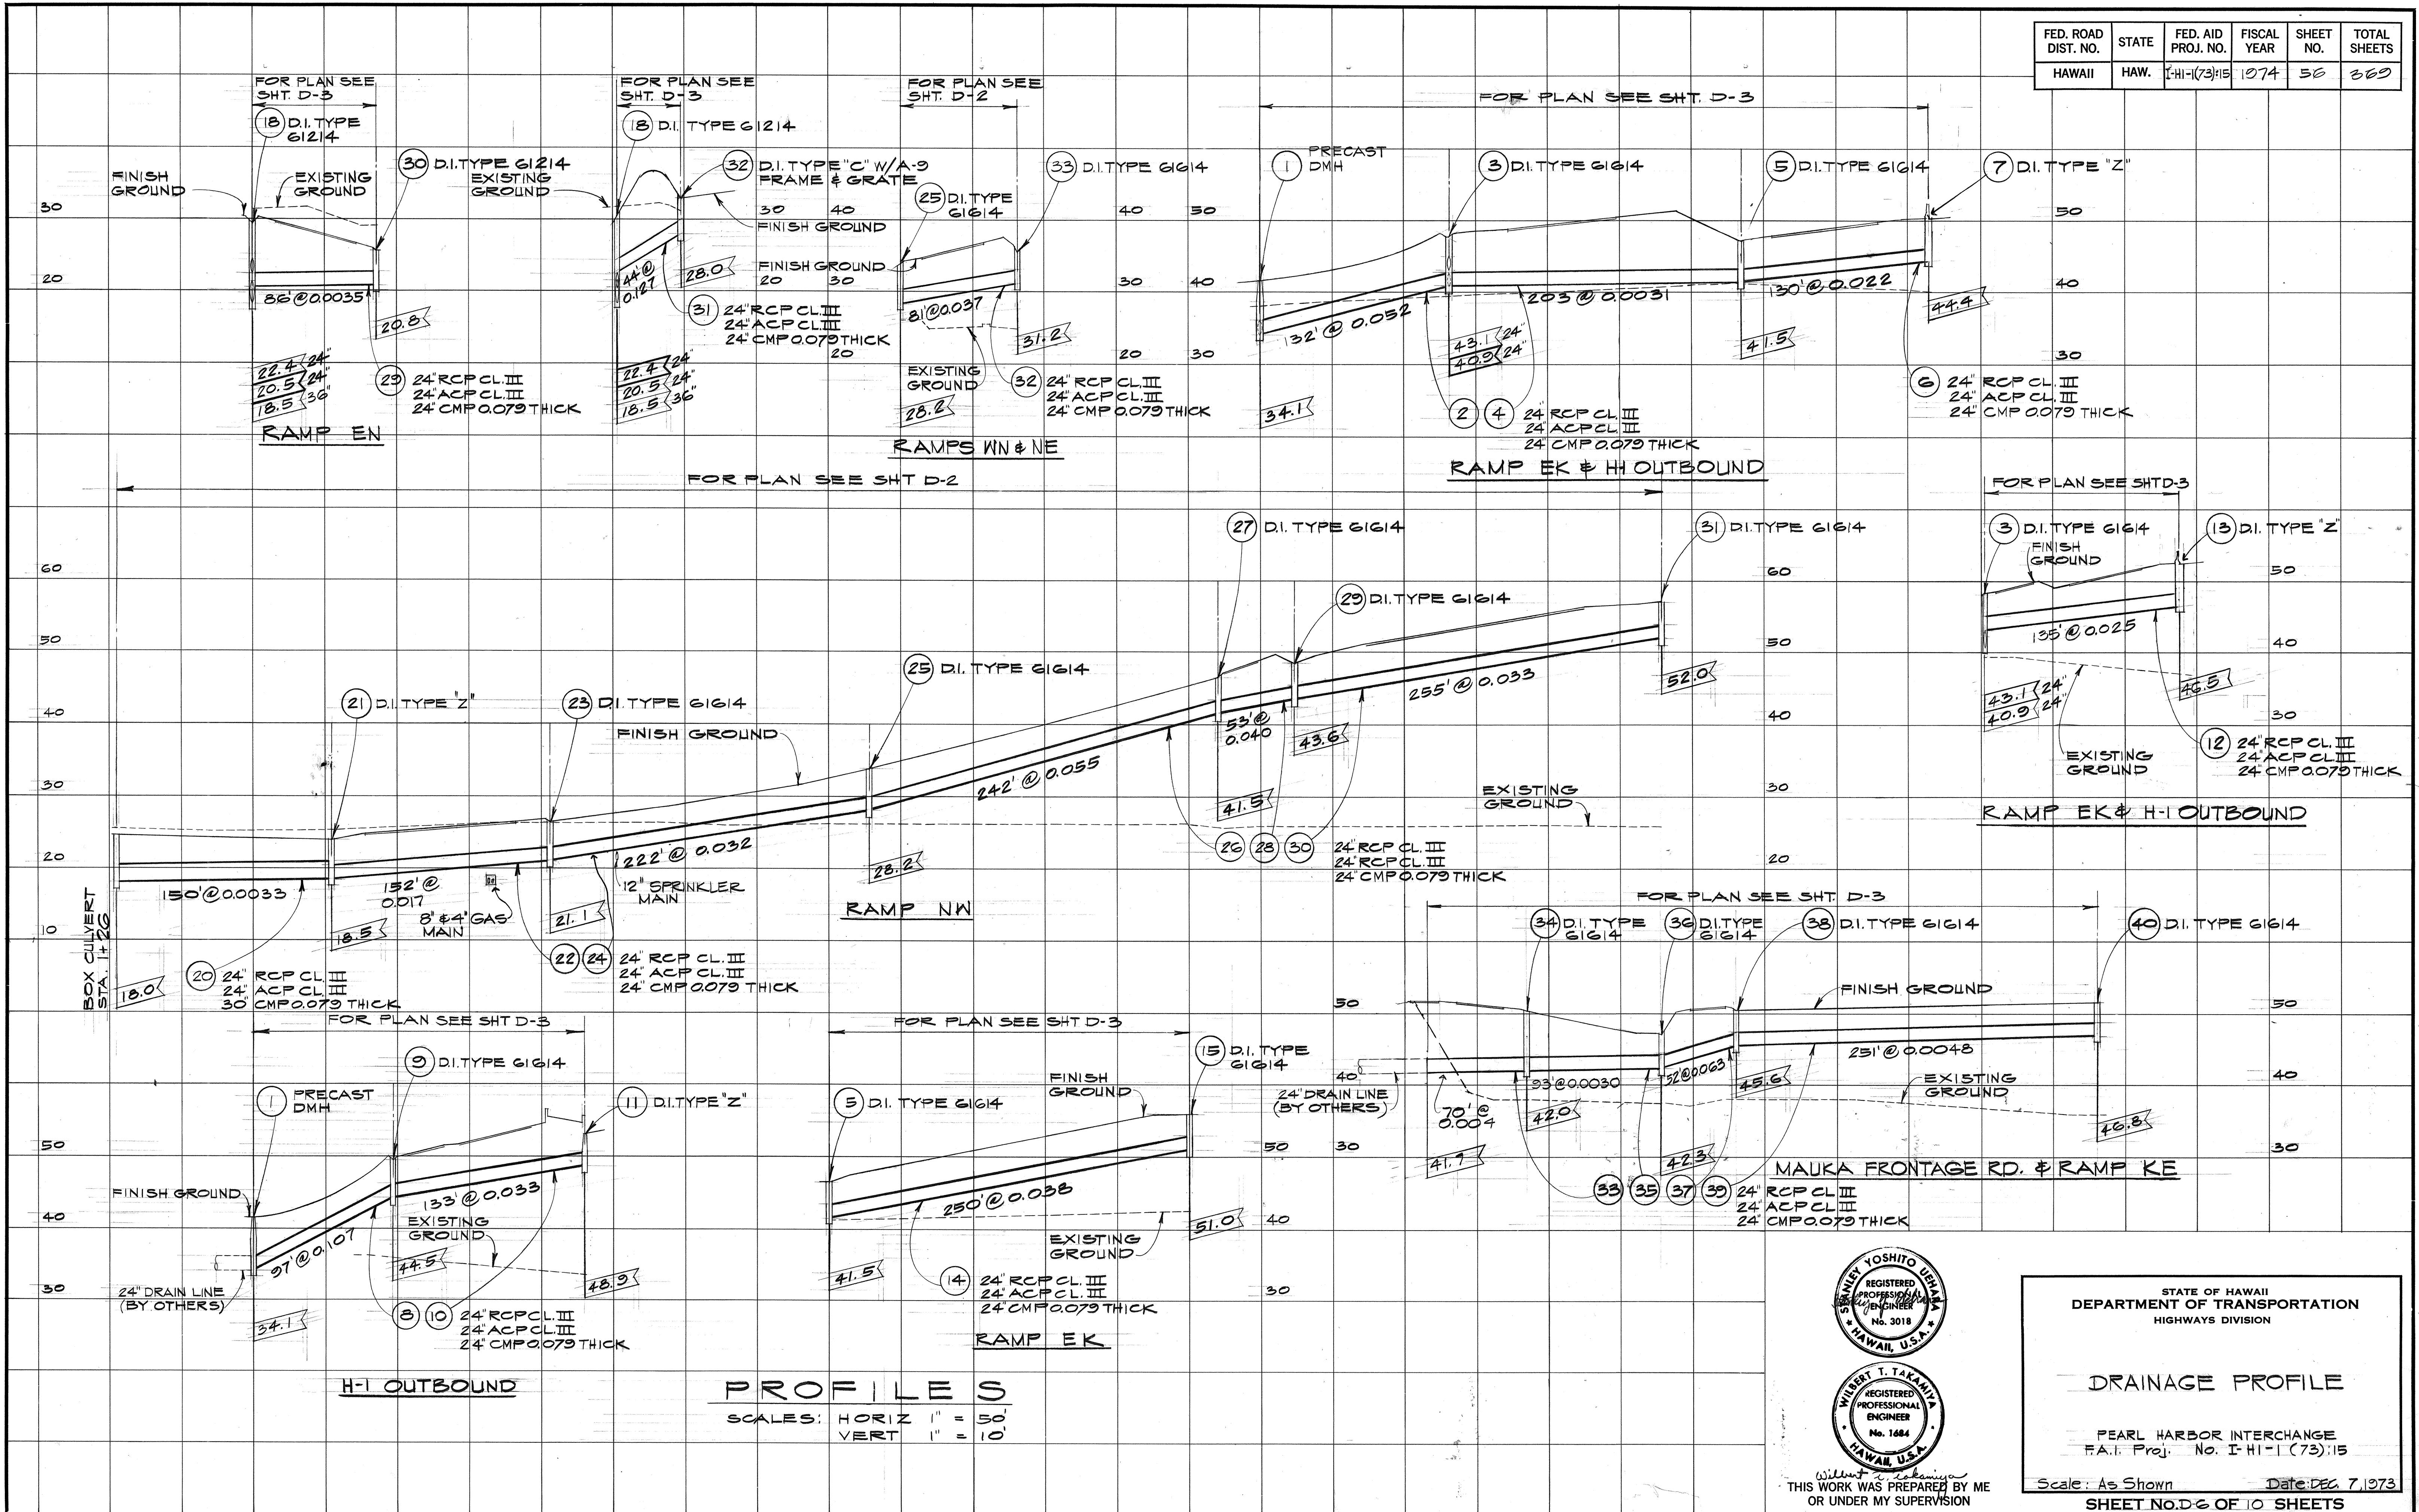

**STATE OF HAWAII
DEPARTMENT OF TRANSPORTATION
HIGHWAYS DIVISION**

DRAINAGE PROFILE

PEARL HARBOR INTERCHANGE
Proj. No. I-HI-1 (73)15


cale: As Shown Date: DEC. 7, 19

A circular black and white stamp. The outer ring contains the text "HAWAII U.S.A." at the bottom and "STANLEY YOSHITO UEHARA" at the top. The inner circle contains "REGISTERED PROFESSIONAL ENGINEER" in the center, flanked by two stars. Below this, the number "No. 3018" is stamped.


A circular black and white stamp. The outer ring contains the text "WILBERT T. TAKAMUY" at the top and "HAWAII U.S.A." at the bottom. The inner circle contains the text "REGISTERED" on the top line, "PROFESSIONAL" on the second line, and "ENGINEER" on the third line. Below "ENGINEER" is the number "No. 1684".

Wilbert I. Lakamya
THIS WORK WAS PREPARED BY ME
OR UNDER MY SUPERVISION

FED. ROAD DIST. NO.	STATE	FED. AID PROJ. NO.	FISCAL YEAR	SHEET NO.	TOTAL SHEETS
HAWAII	HAW.	I-HI-1(73)S	1974	57	369

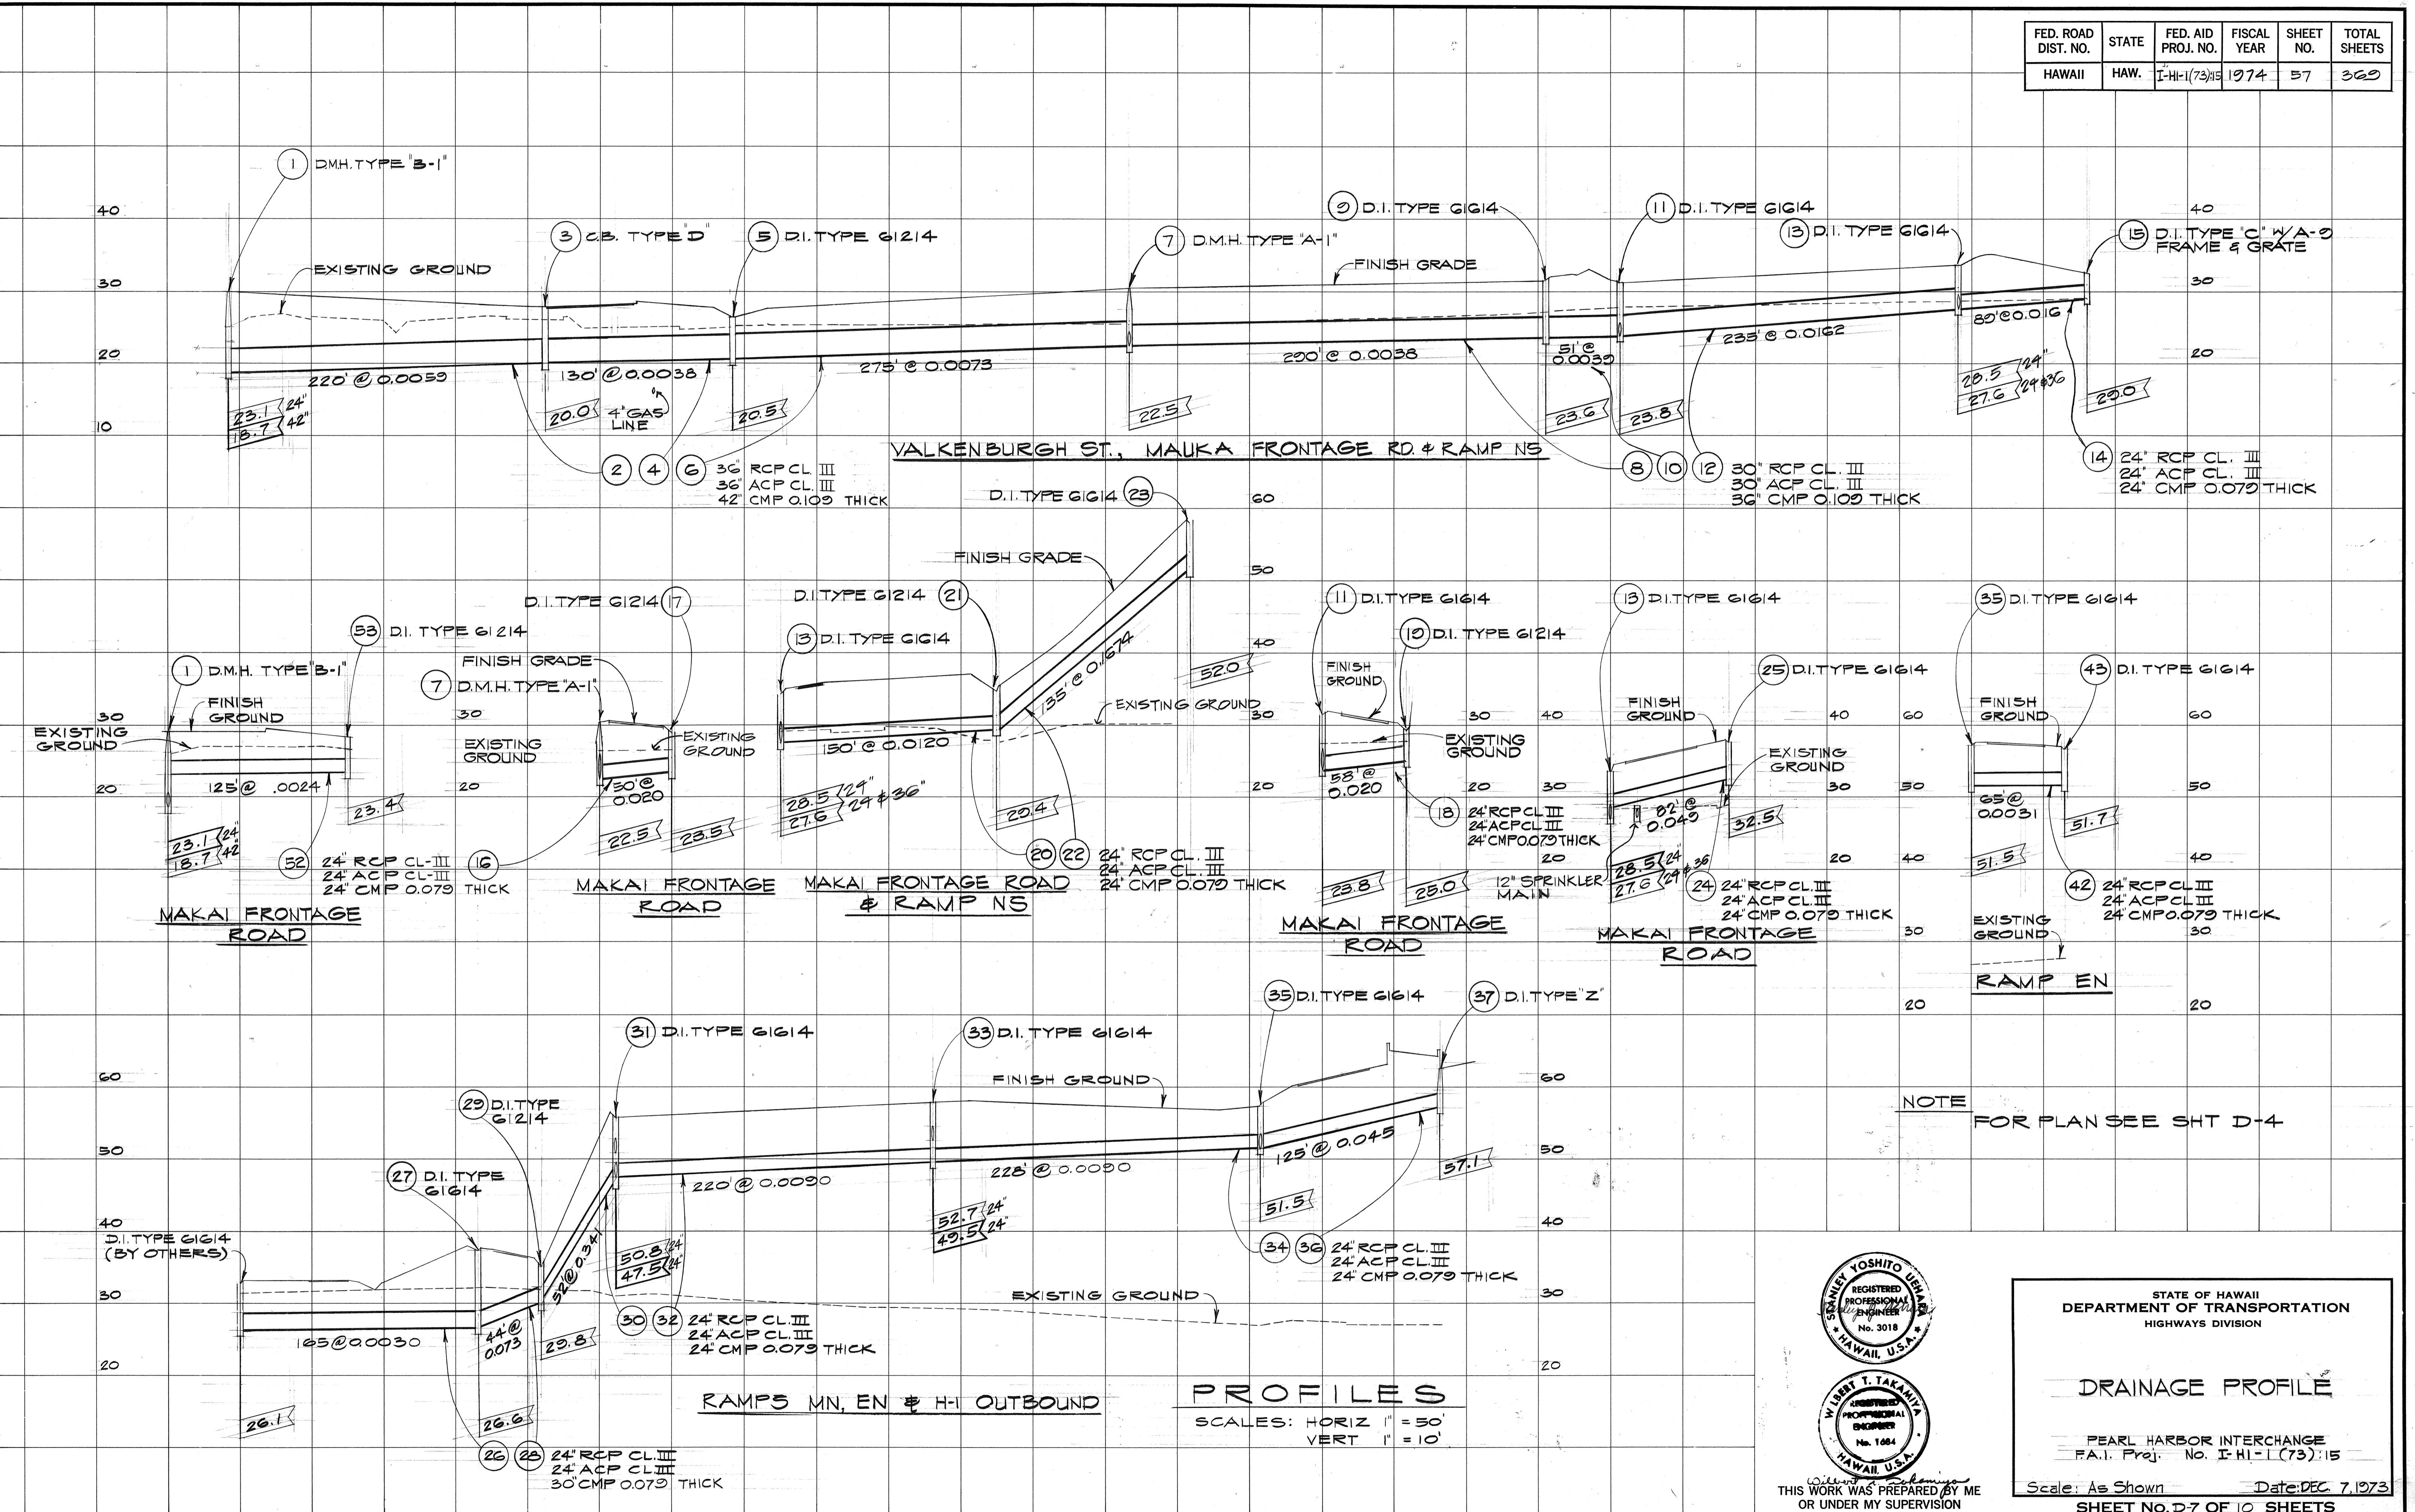


FED. ROAD DIST. NO.	STATE	FED. AID PROJ. NO.	FISCAL YEAR	SHEET NO.	TOTAL SHEETS
HAWAII	HAW.	I-HI-1(73):5	1974	58	369

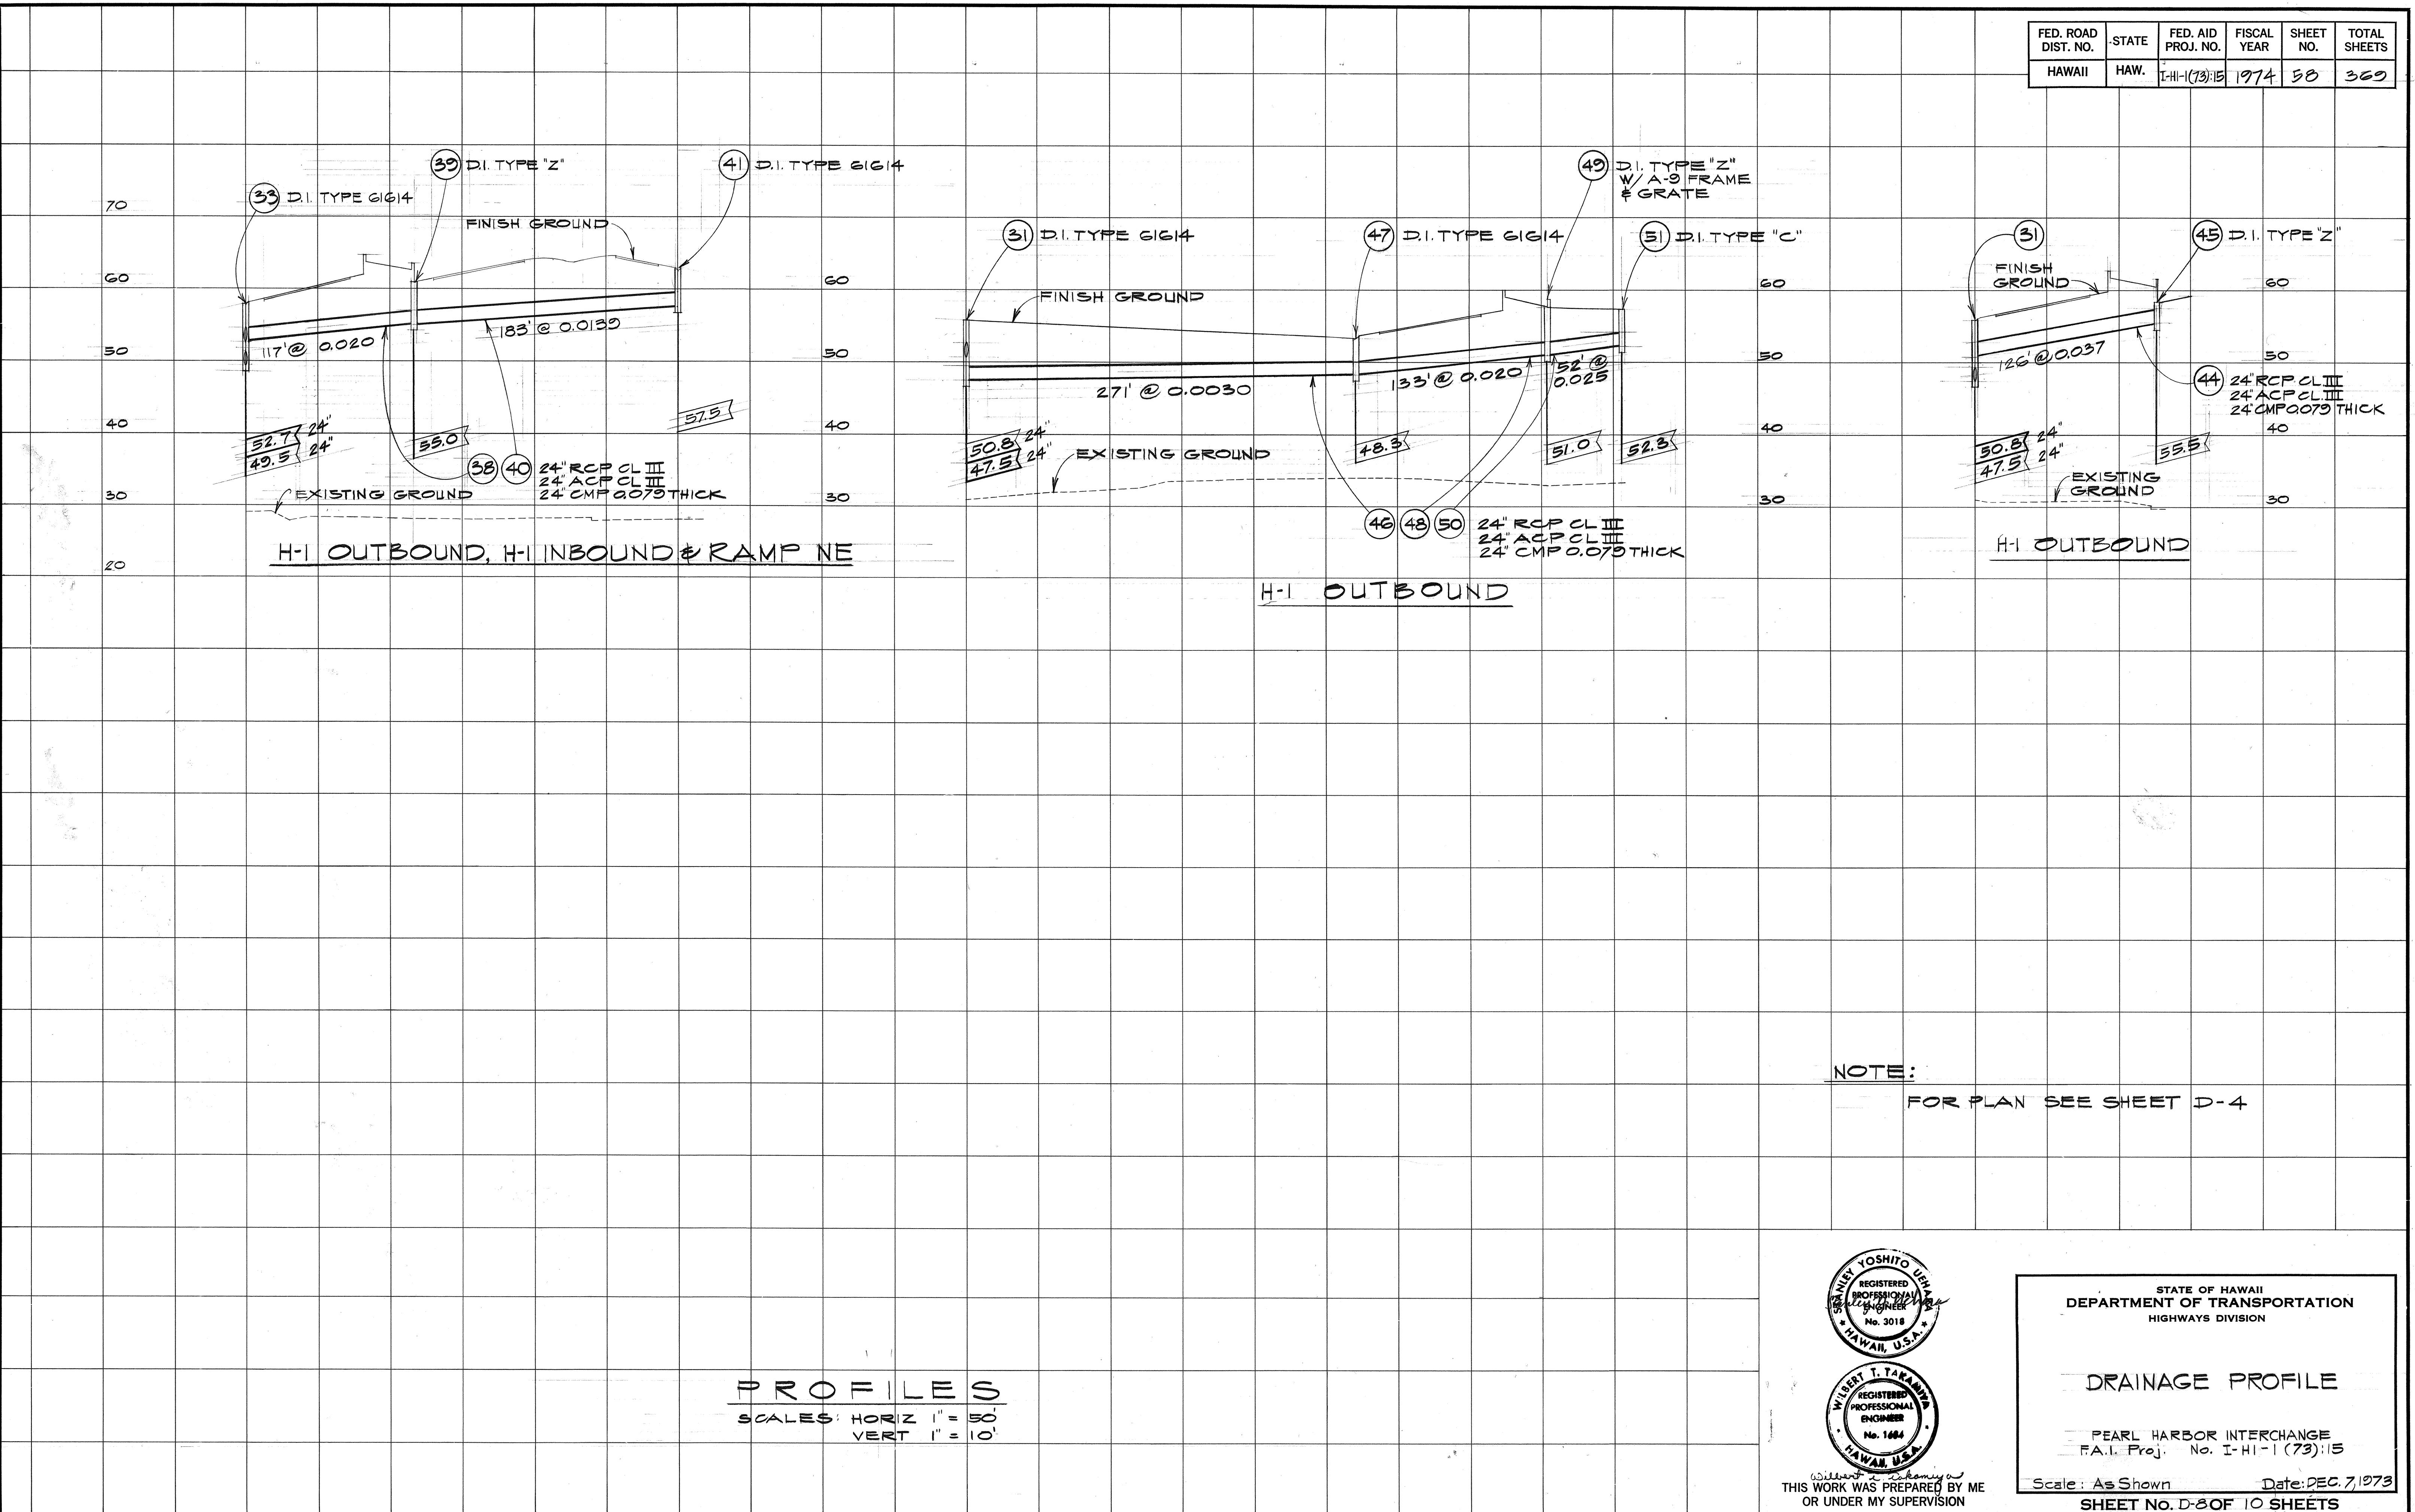


FED. ROAD DIST. NO.	STATE	FED. AID PROJ. NO.	FISCAL YEAR	SHEET NO.	TOTAL SHEETS
HAWAII	HAW.	I-HI-1(73):15	1974	59	360

PLAN	SUBVEYED	DATE
NOTE BOOK	PLOTTED	BY
NO.	ALIGNED CHECKED	
	RTL OF WAT CHECKED	

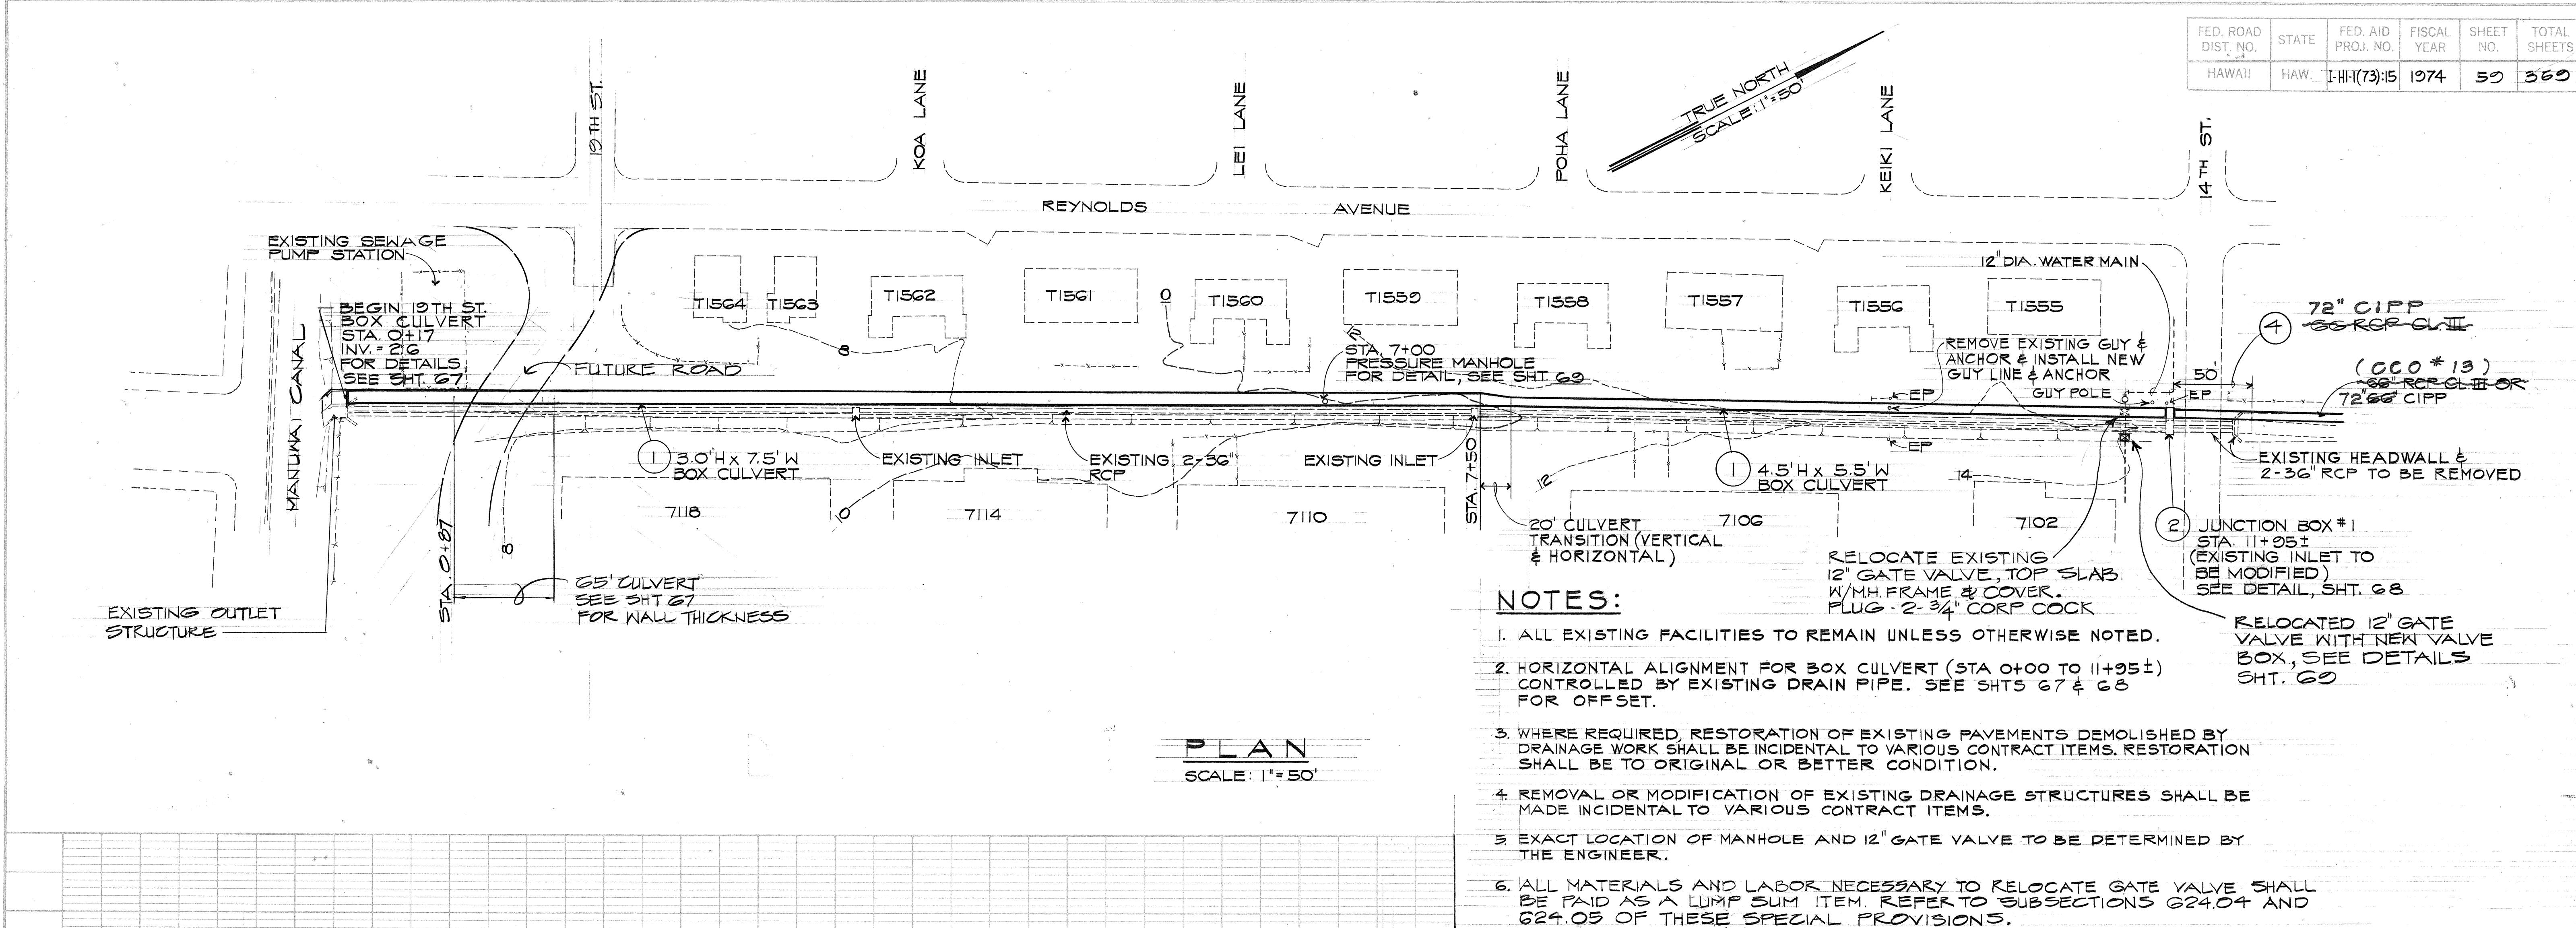



PROFILE SURVEYED	DATE
NOTE BOOK	BY
NO.	GRADES CHECKED
	STRUCTURE NOTES CHECKED

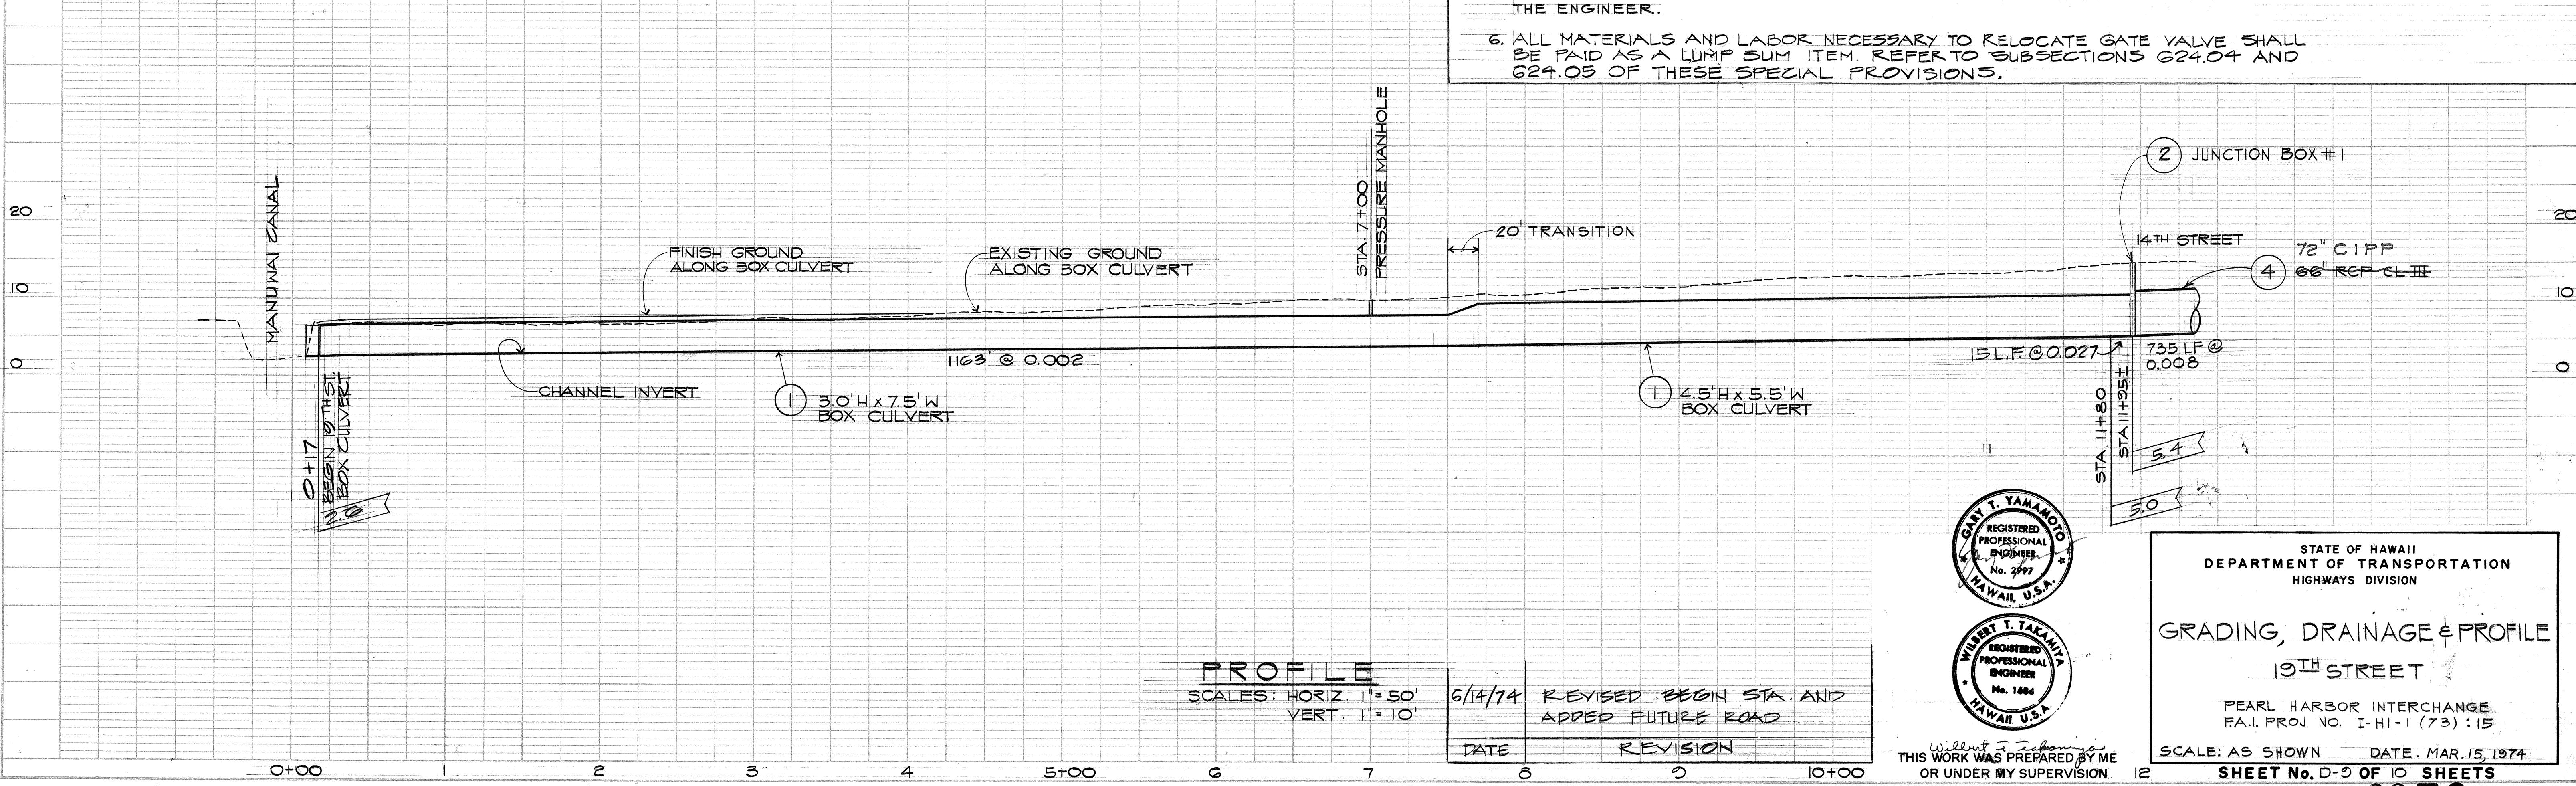

FED. ROAD DIST. NO.	STATE	FED. AID PROJ. NO.	FISCAL YEAR	SHEET NO.	TOTAL SHEETS
HAWAII	HAW.	I-HI-(73):15	1974	60	369

PLAN	SURVEYED
BY	DATE
NOTE BOOK	ALIGNMENT CHECKED
NO.	R/T OF WAY CHECKED

PROFILE	SURVEYED
BY	DATE
NOTE BOOK	GRADES CHECKED B.M. NOTED
NO.	STRUCTURE ROTATED CHK'D

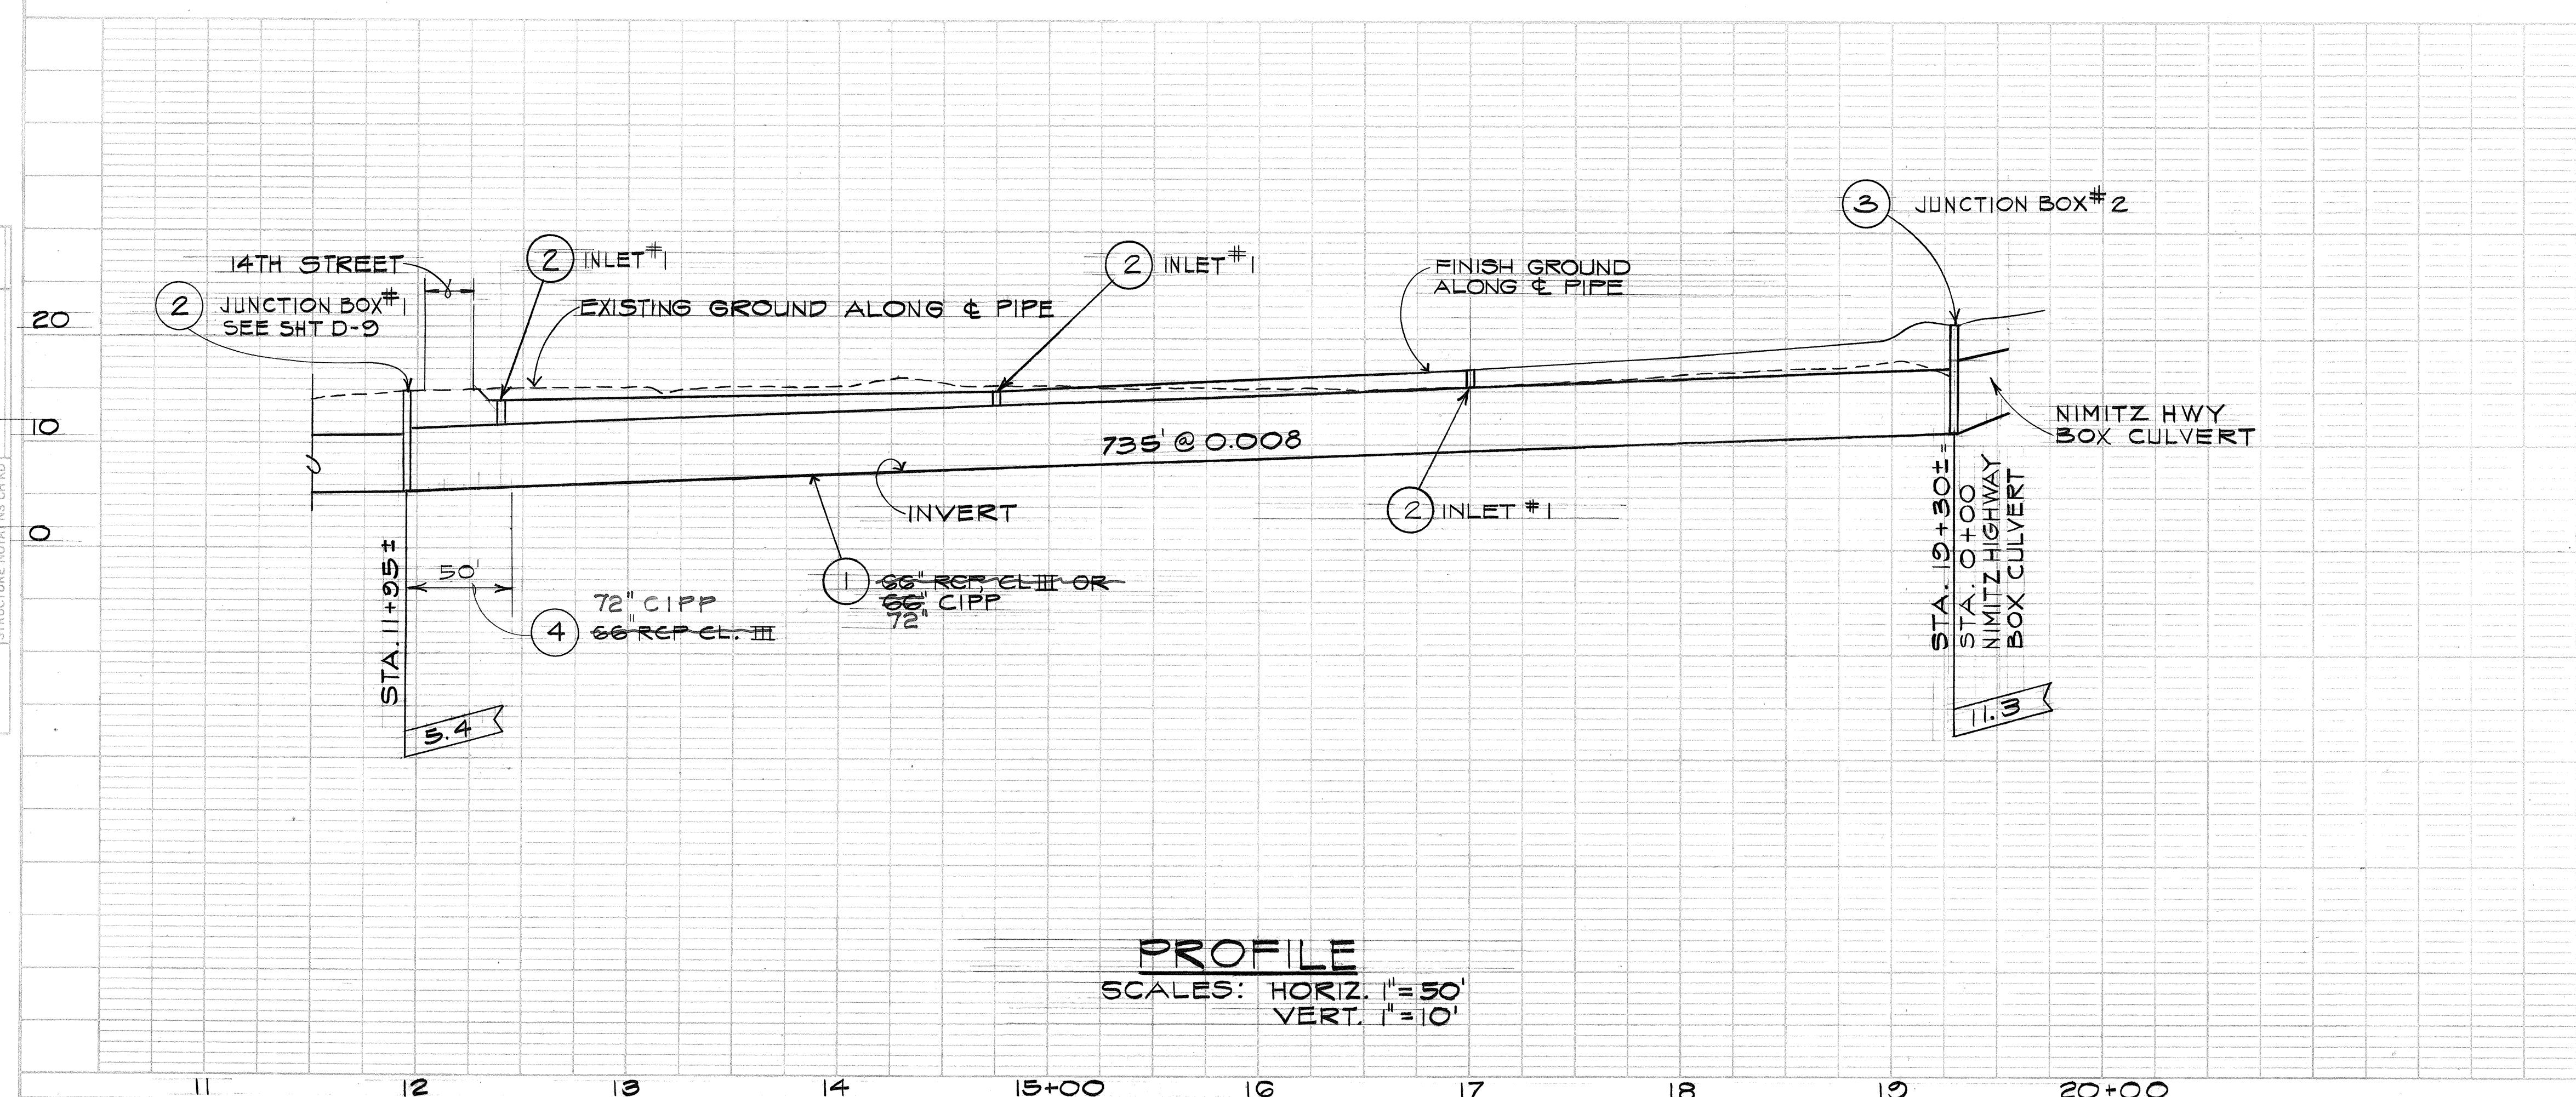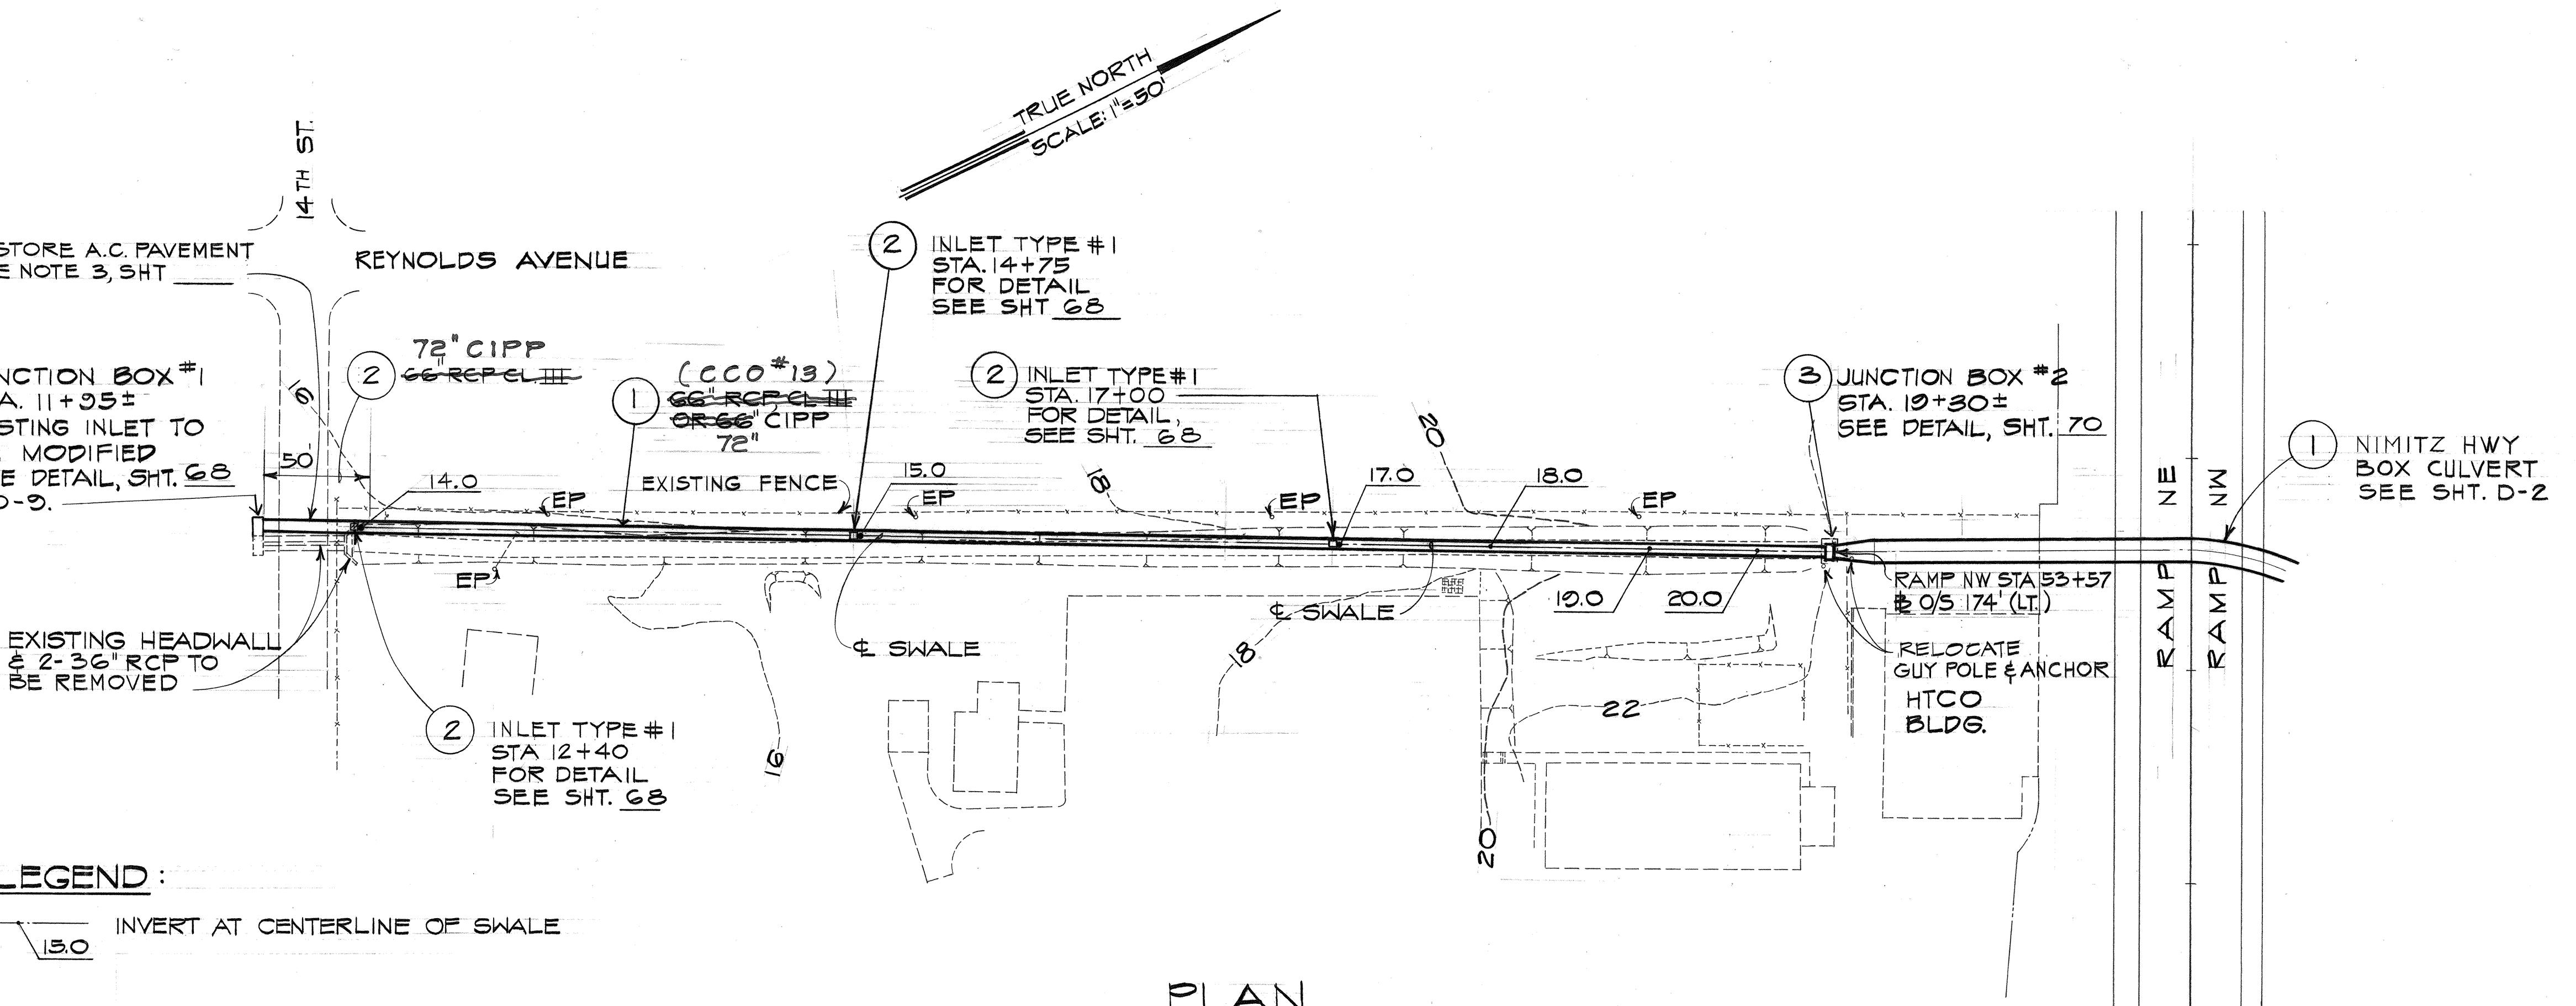

DRAINAGE

SUMMARY

ED. ROAD DIST. NO.	STATE	FED. AID PROJ. NO.	FISCAL YEAR	SHEET NO.	TOTAL SHEETS
HAWAII	HAW.	I-HI-1(73):5	1974	62	369

8/4/74 REVISE QUANTITIES, EMS
503.002 & 602.103. ADDED
897.70

DATE REVISION



Wilbert T. Tokunaga
THIS WORK WAS PREPARED BY ME
OR UNDER MY SUPERVISION

DRAINAGE

S U M M A R Y

FED. ROAD DIST. NO.	STATE	FED. AID PROJ. NO.	FISCAL YEAR	SHEET NO.	TOTAL SHEETS
HAWAII	HAW.	I-HI-1(73):15	1974	63	369



THIS WORK WAS PREPARED BY ME
OR UNDER MY SUPERVISION

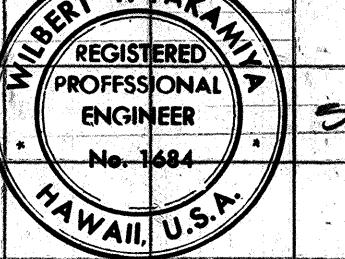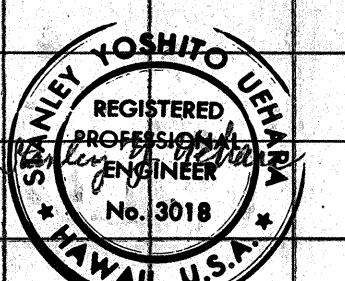

DRAINAGE

S U M M A R Y

ED. ROAD DIST. NO.	STATE	FED. AID PROJ. NO.	FISCAL YEAR	SHEET NO.	TOTAL SHEETS
HAWAII	HAW.	I-H-I(73):15	1974	64	369

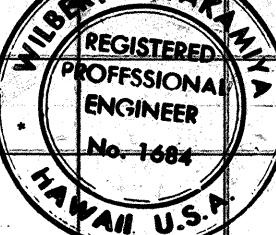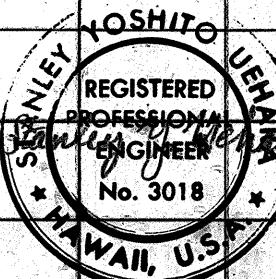

Wilbert T. Takamiya
THIS WORK WAS PREPARED BY ME
OR UNDER MY SUPERVISION

DRAINAGE

S U M M A R Y


ED. ROAD DIST. NO.	STATE	FED. AID PROJ. NO.	FISCAL YEAR	SHEET NO.	TOTAL SHEETS
HAWAII	HAW.	I-H-1(73):15	1974	65	369

DRAINAGE

S U M M A R Y






FED. ROAD DIST. NO.	STATE	FED. AID PROJ. NO.	FISCAL YEAR	SHEET NO.	TOTAL SHEETS
HAWAII	HAW.	I-H-1(73):15	1974	66	369

10/12/76	REVISED ITEMS 206.80, 605.006 AND TOTAL	
9/3/75	REVISED TOTAL	QUANTITIES ITEMS 206.20, 503.002, 602.103 & 603.90
6/14/74	REVISE TOTAL	QUANTITIES, ITEMS 503.002 & 602.103. ADDED 607.70
4/26/74	REVISE TOTAL	QUANTITIES, ITEMS 206.02, 206.20, 503.002, 602.103, 603.1016 & 603.90
	DATE	REVISION

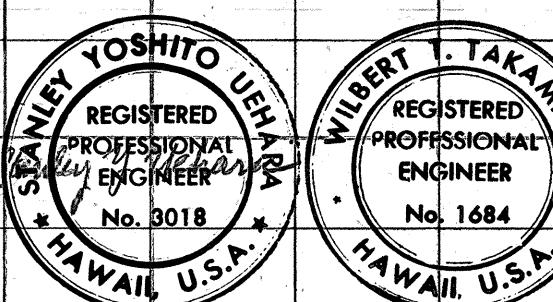

Wilbert T. Takemoto
THIS WORK WAS PREPARED BY ME
OR UNDER MY SUPERVISION

ED. ROAD DIST. NO.	STATE	FED. AID PROJ. NO.	FISCAL YEAR	SHEET NO.	TOTAL SHEETS
HAWAII	HAW.	I-HI-1(73)15	1974	68	369

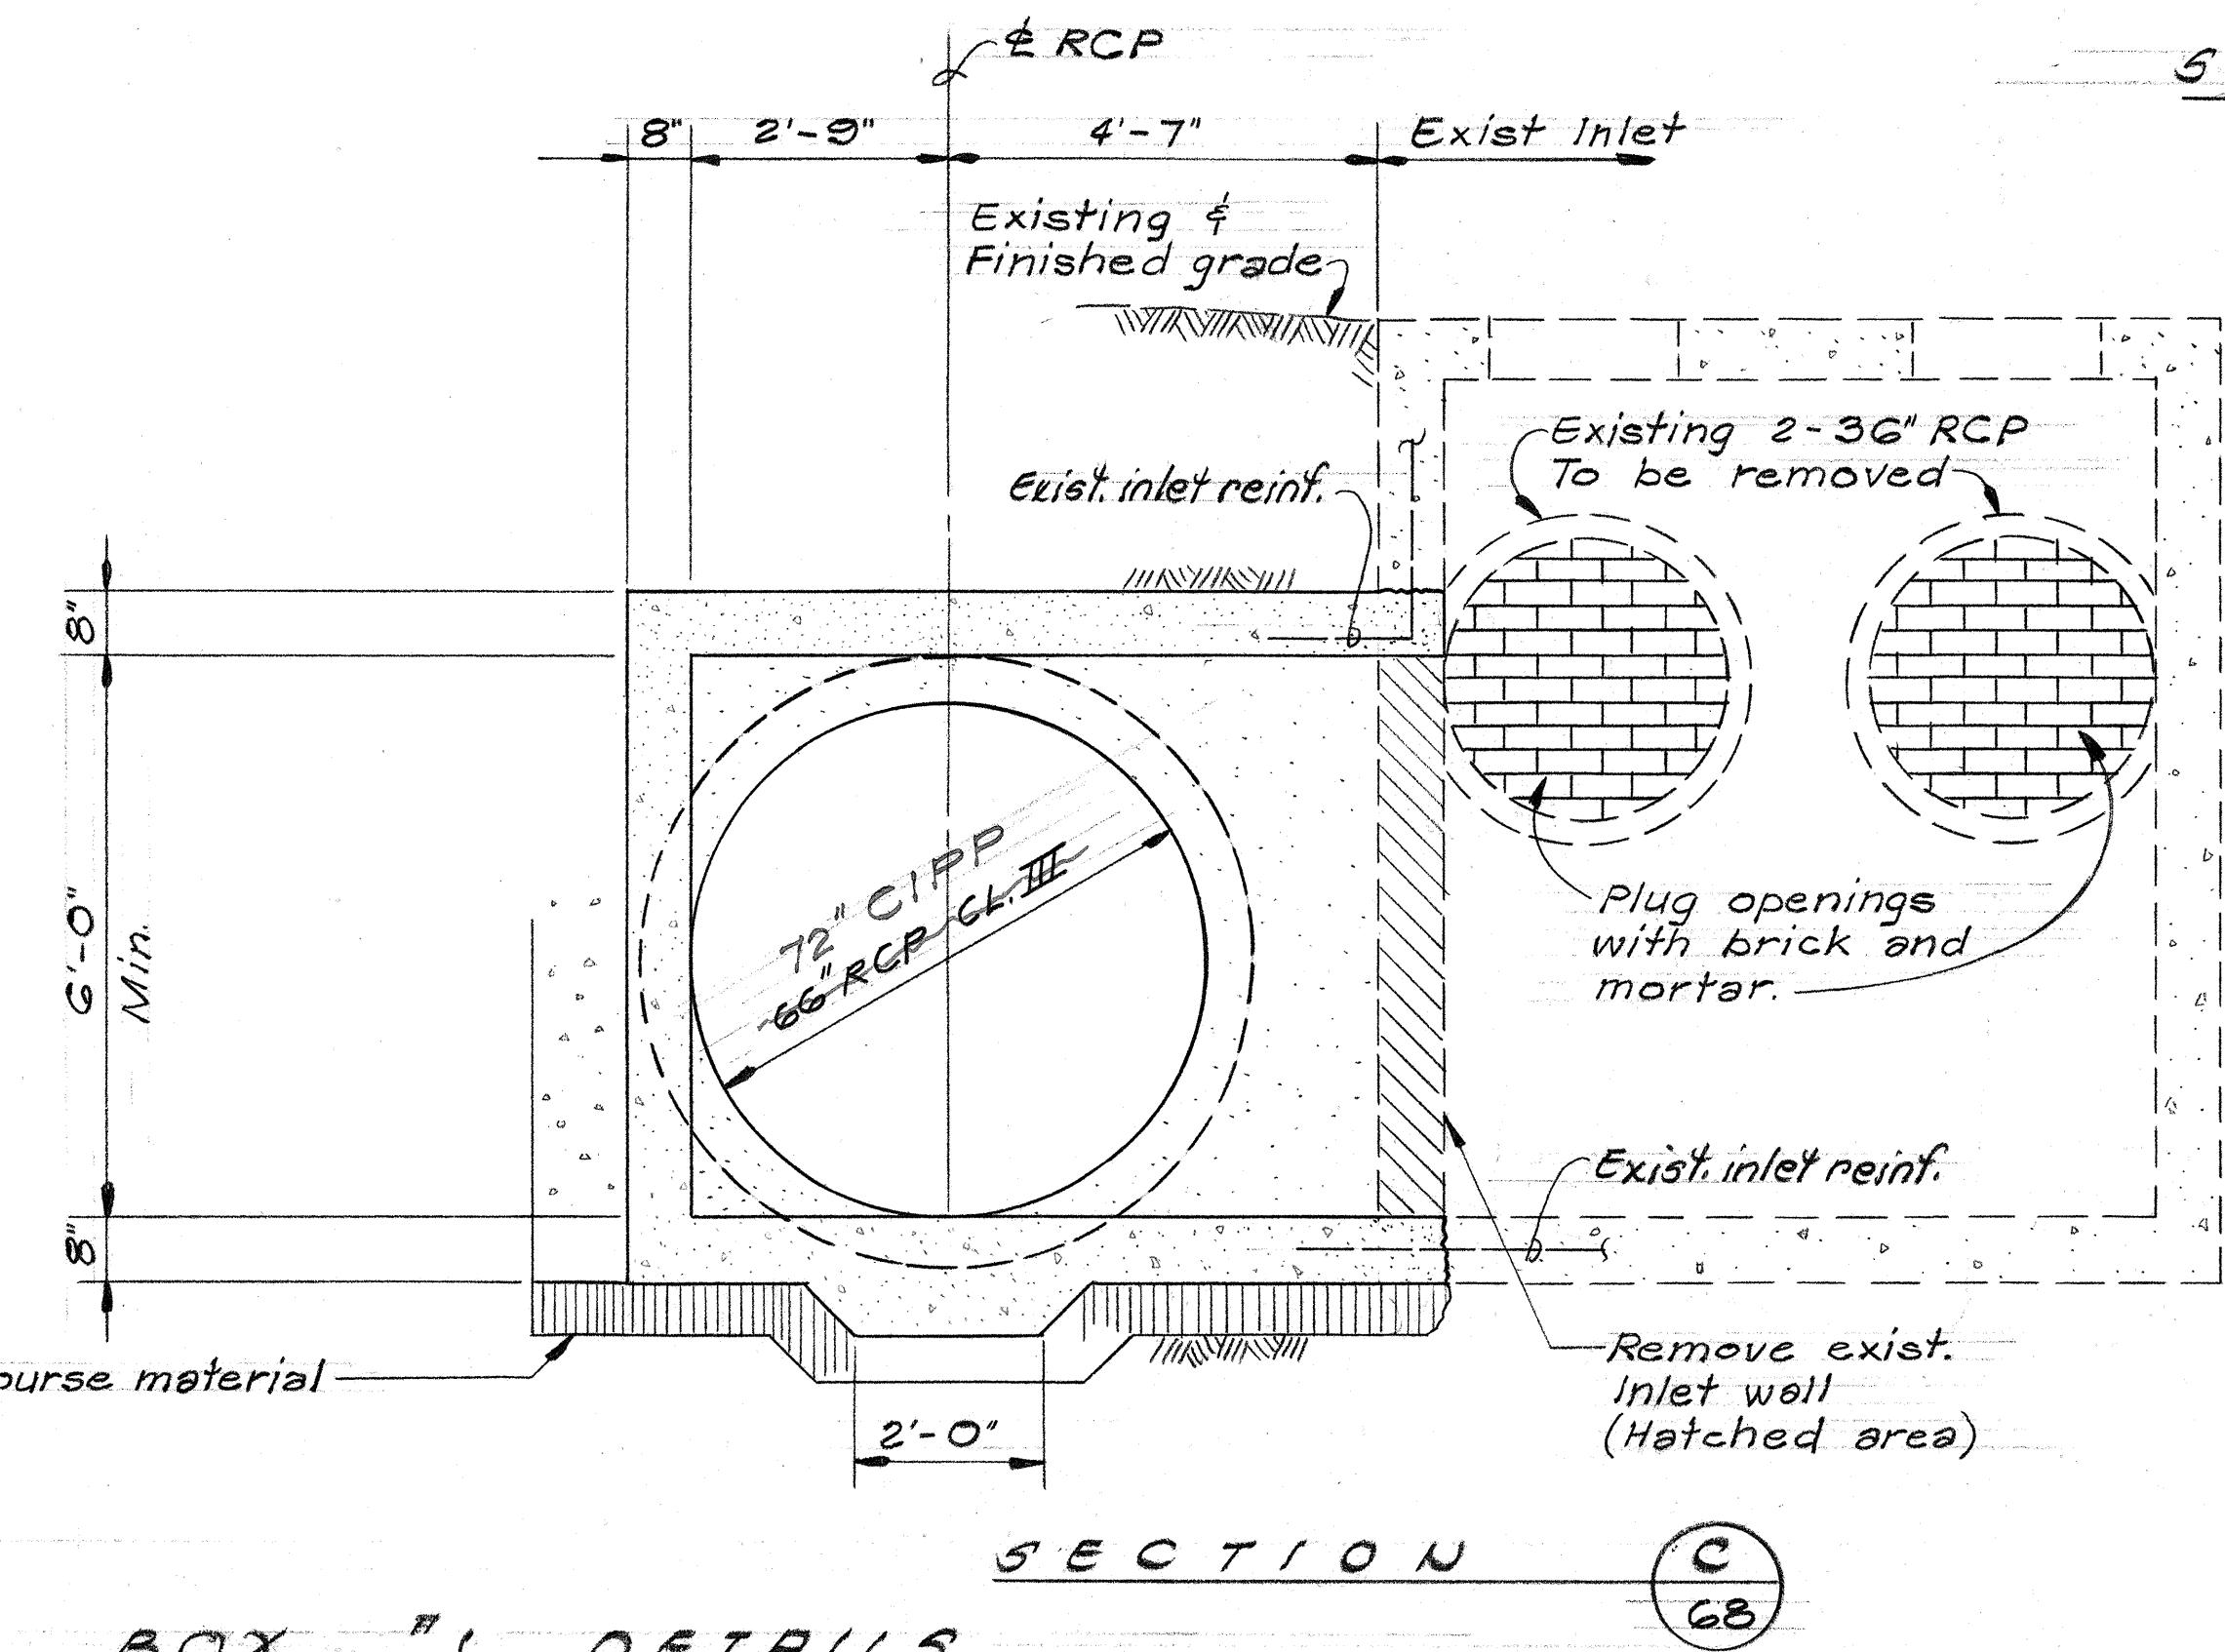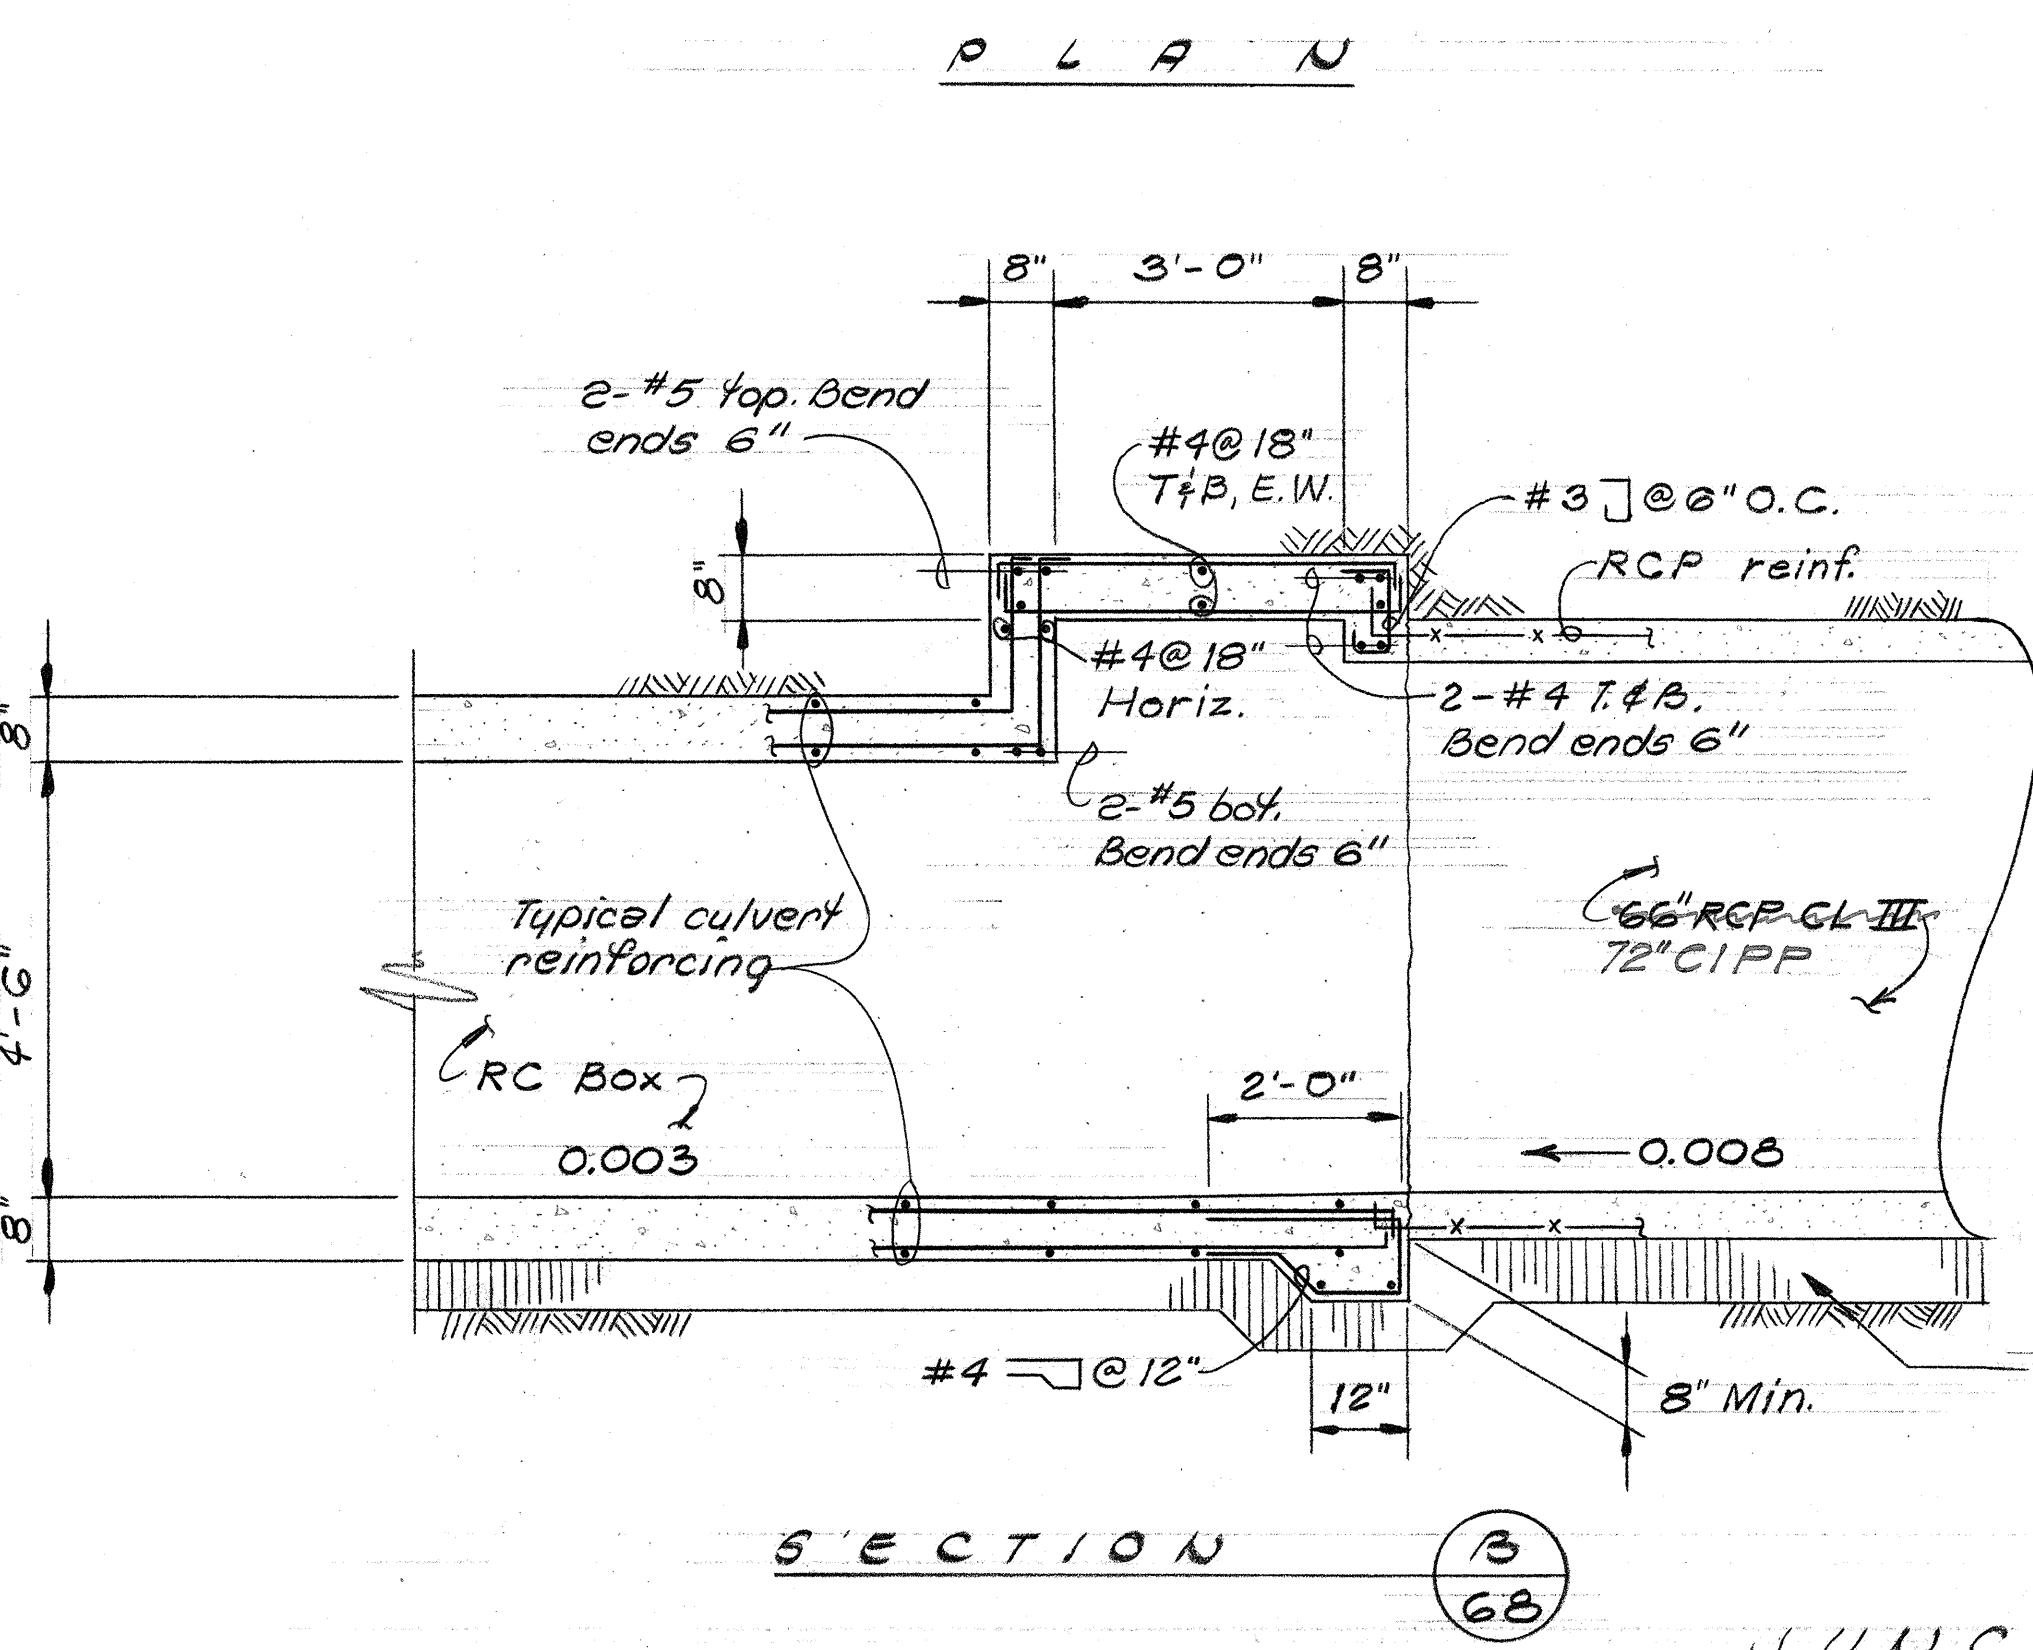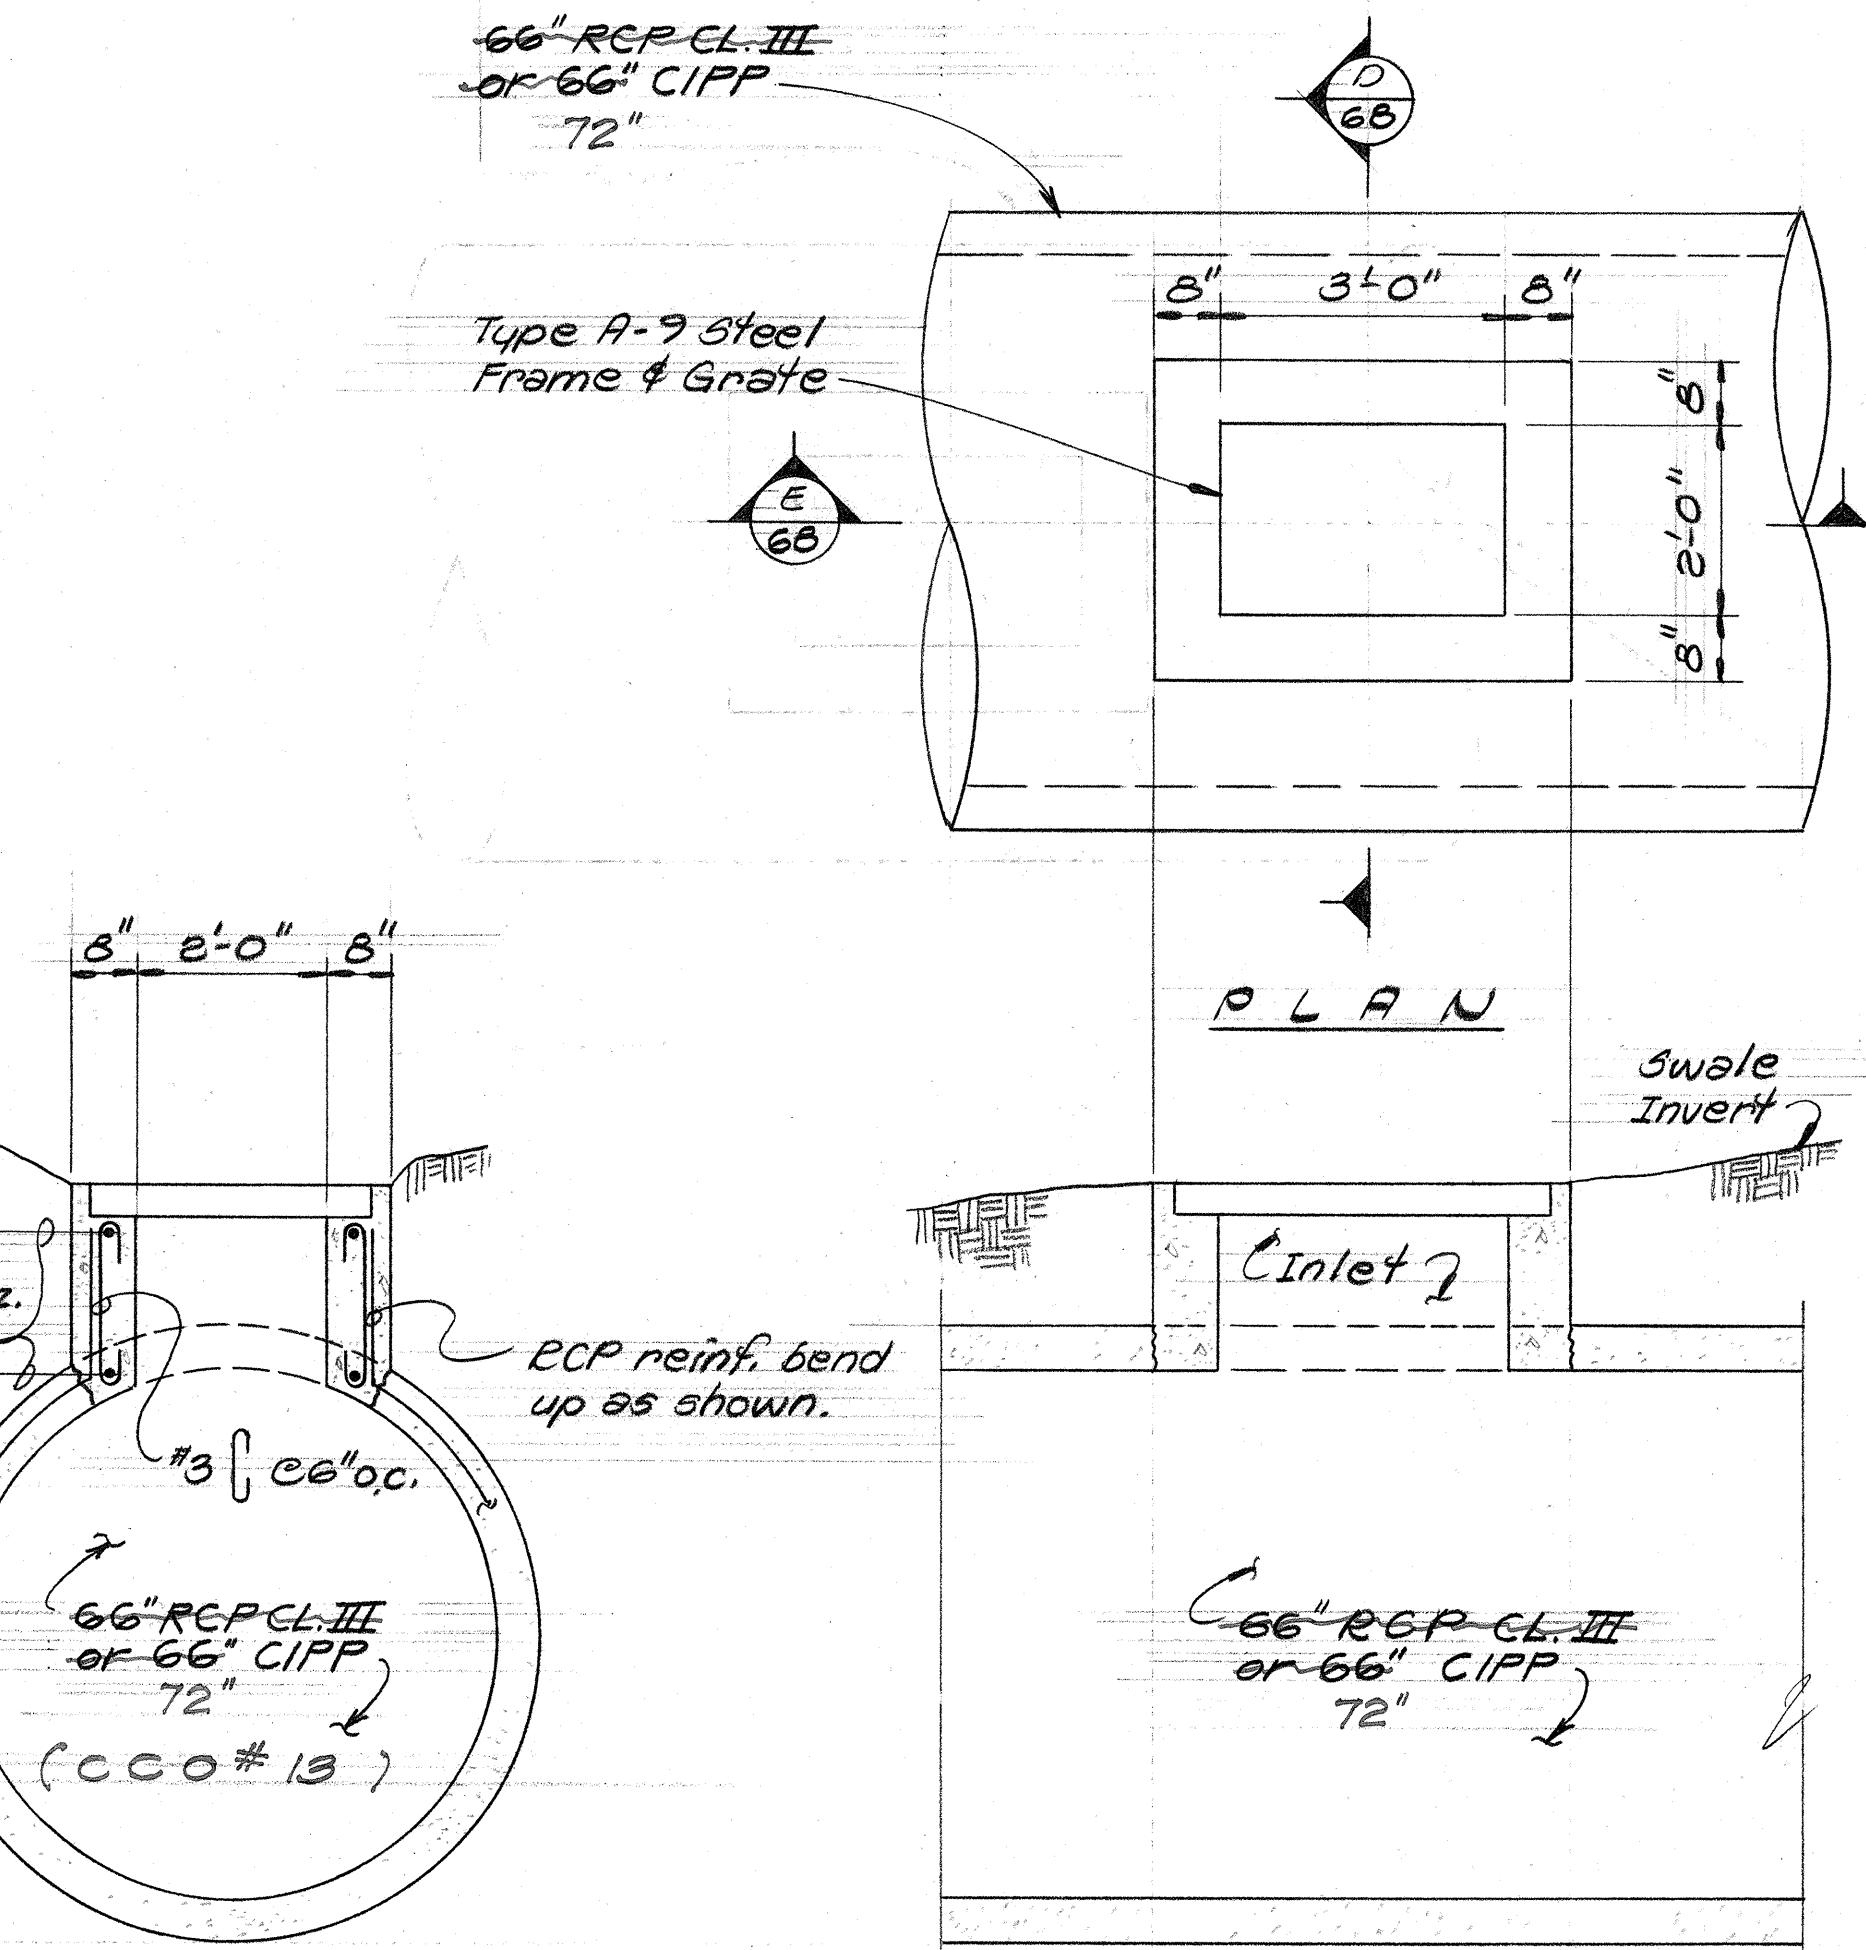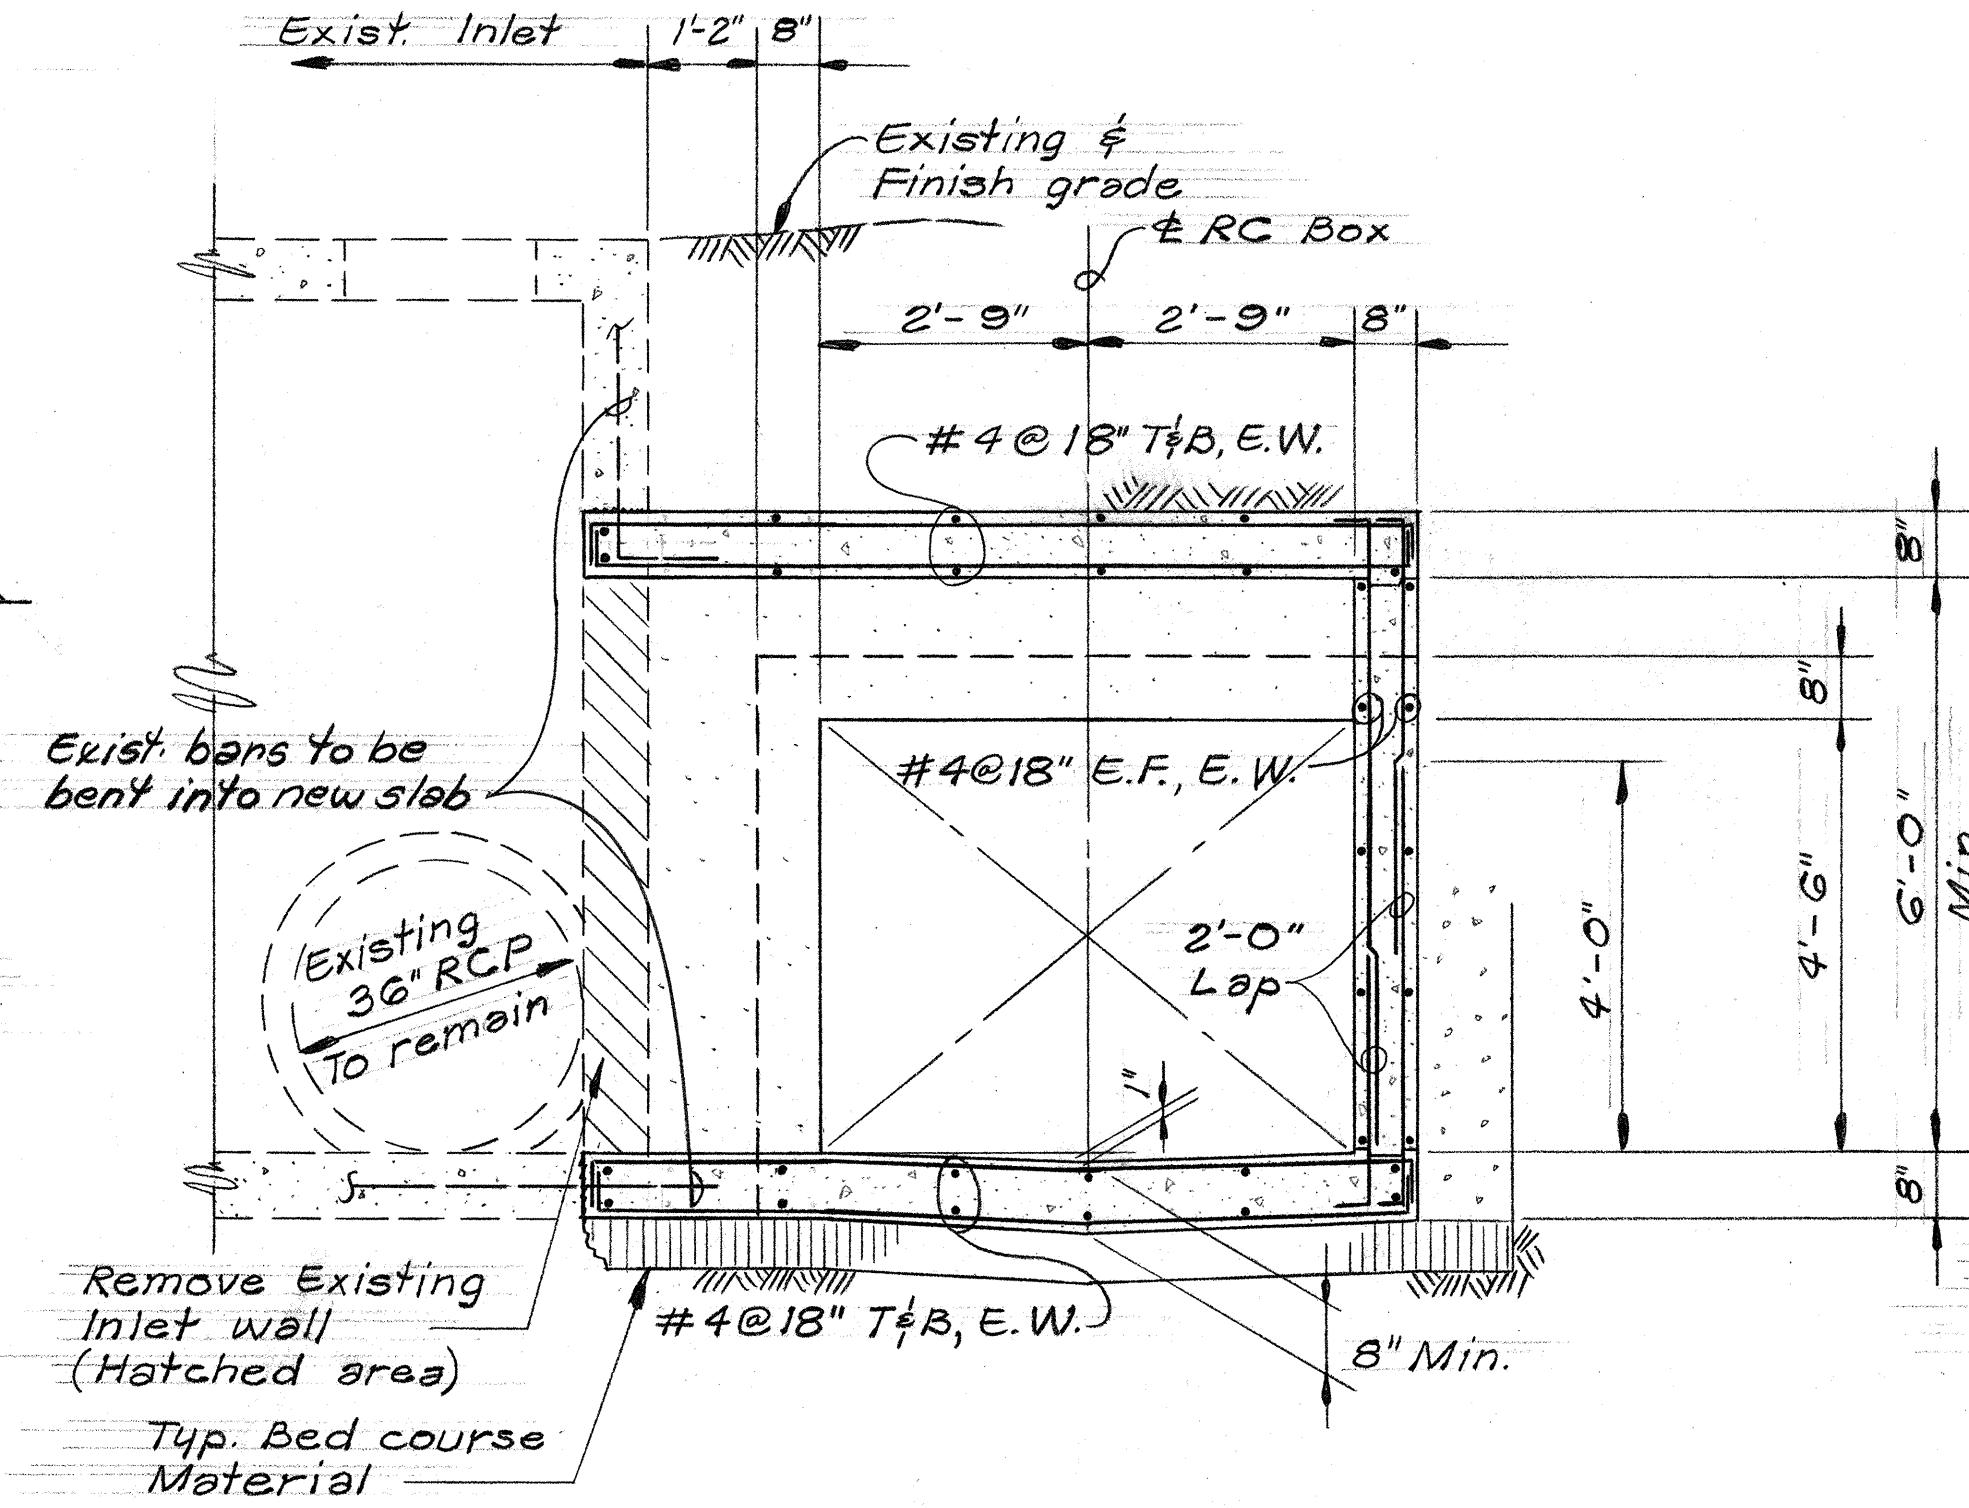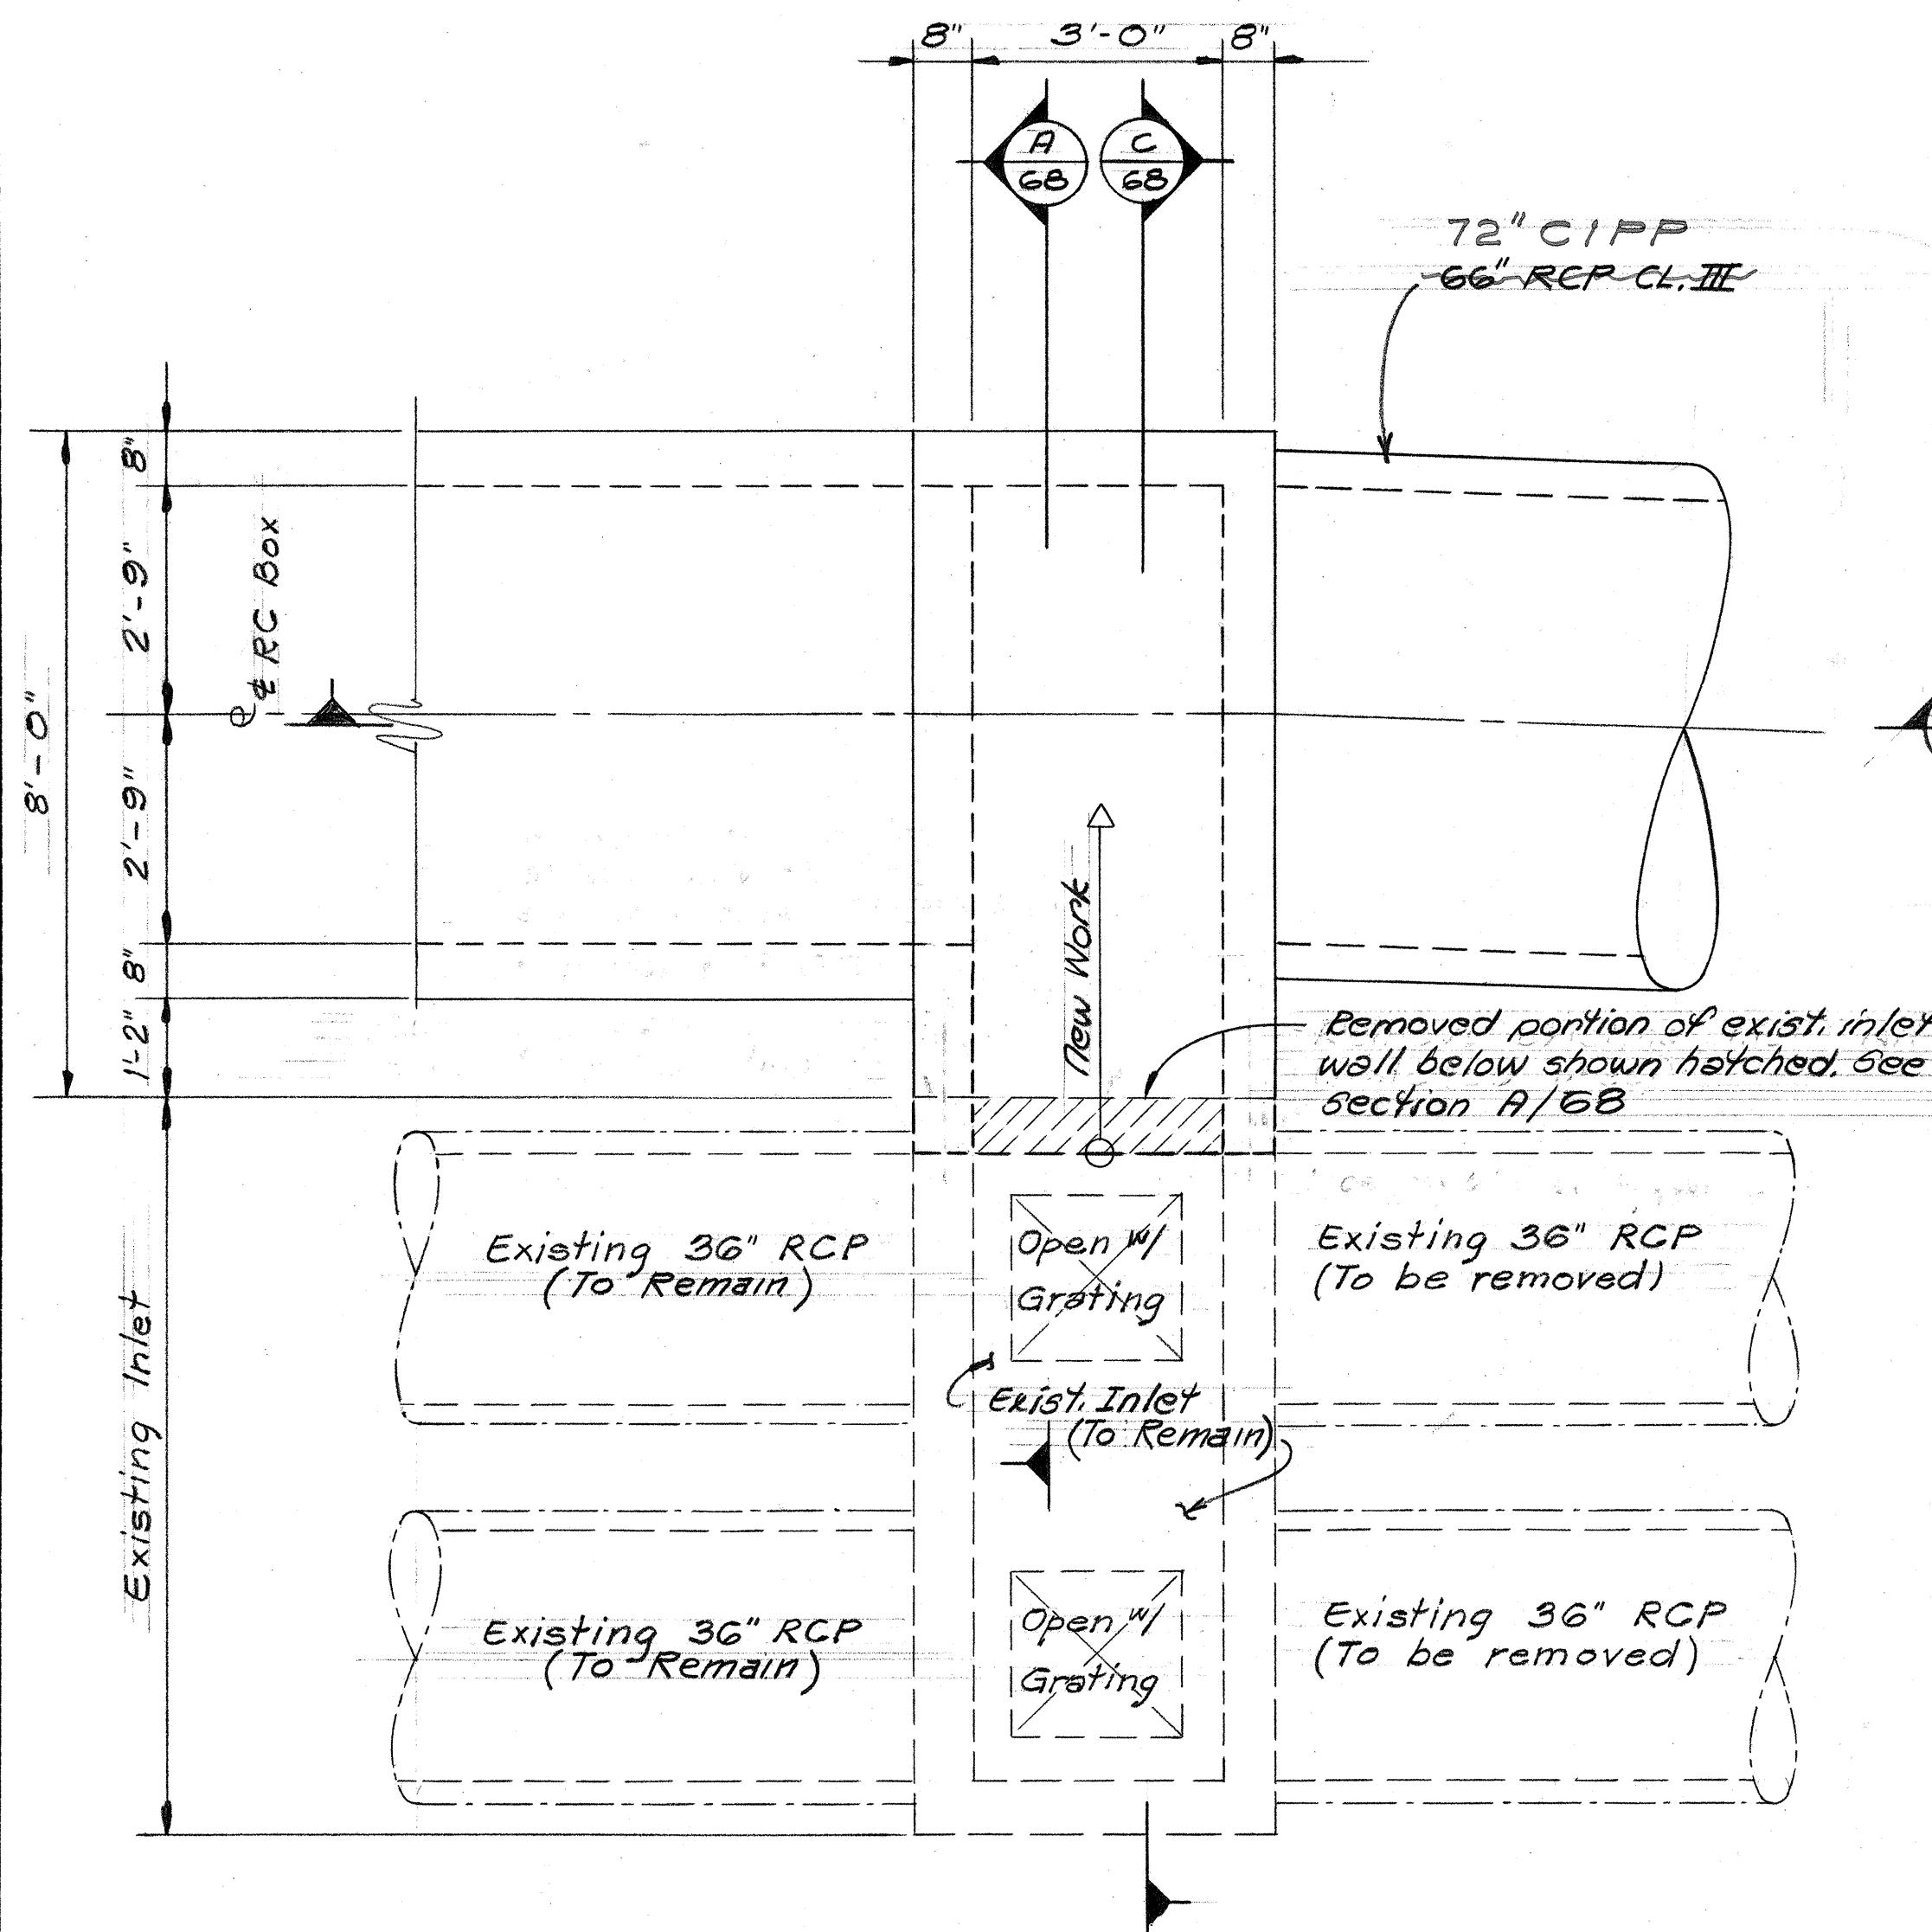

JUNCTION BOX "S" DETAILS

Scale: $1/2'' = 1'-0''$

SHIMAZU SHIMABUKURO & FUKUDA, INC.
Consulting Structural Engineers
1210 Ward Ave., Honolulu, HI 96814

ROY S. SHIMABUKURO
REGISTERED PROFESSIONAL ENGINEER
No. 1150
HAWAII, U.S.A.

MICHAEL PAUL MATSUMOTO
REGISTERED PROFESSIONAL ENGINEER
No. 2974
HAWAII, U.S.A.

**STATE OF HAWAII
DEPARTMENT OF TRANSPORTATION
HIGHWAYS DIVISION**


DRAINAGE DETAILS

9TH STREET

KR HARBOR INTERCHANGE
PROJ. NO. I-HI-1(73):15


scale: As Shown Date: Mar. 15, 1974

FED. ROAD DIST. NO.	STATE	FED. AID PROJ. NO.	FISCAL YEAR	HEET	TOTAL SHEETS
HAWAII	HAW.	I-HI-1(73)15	1974	69	300

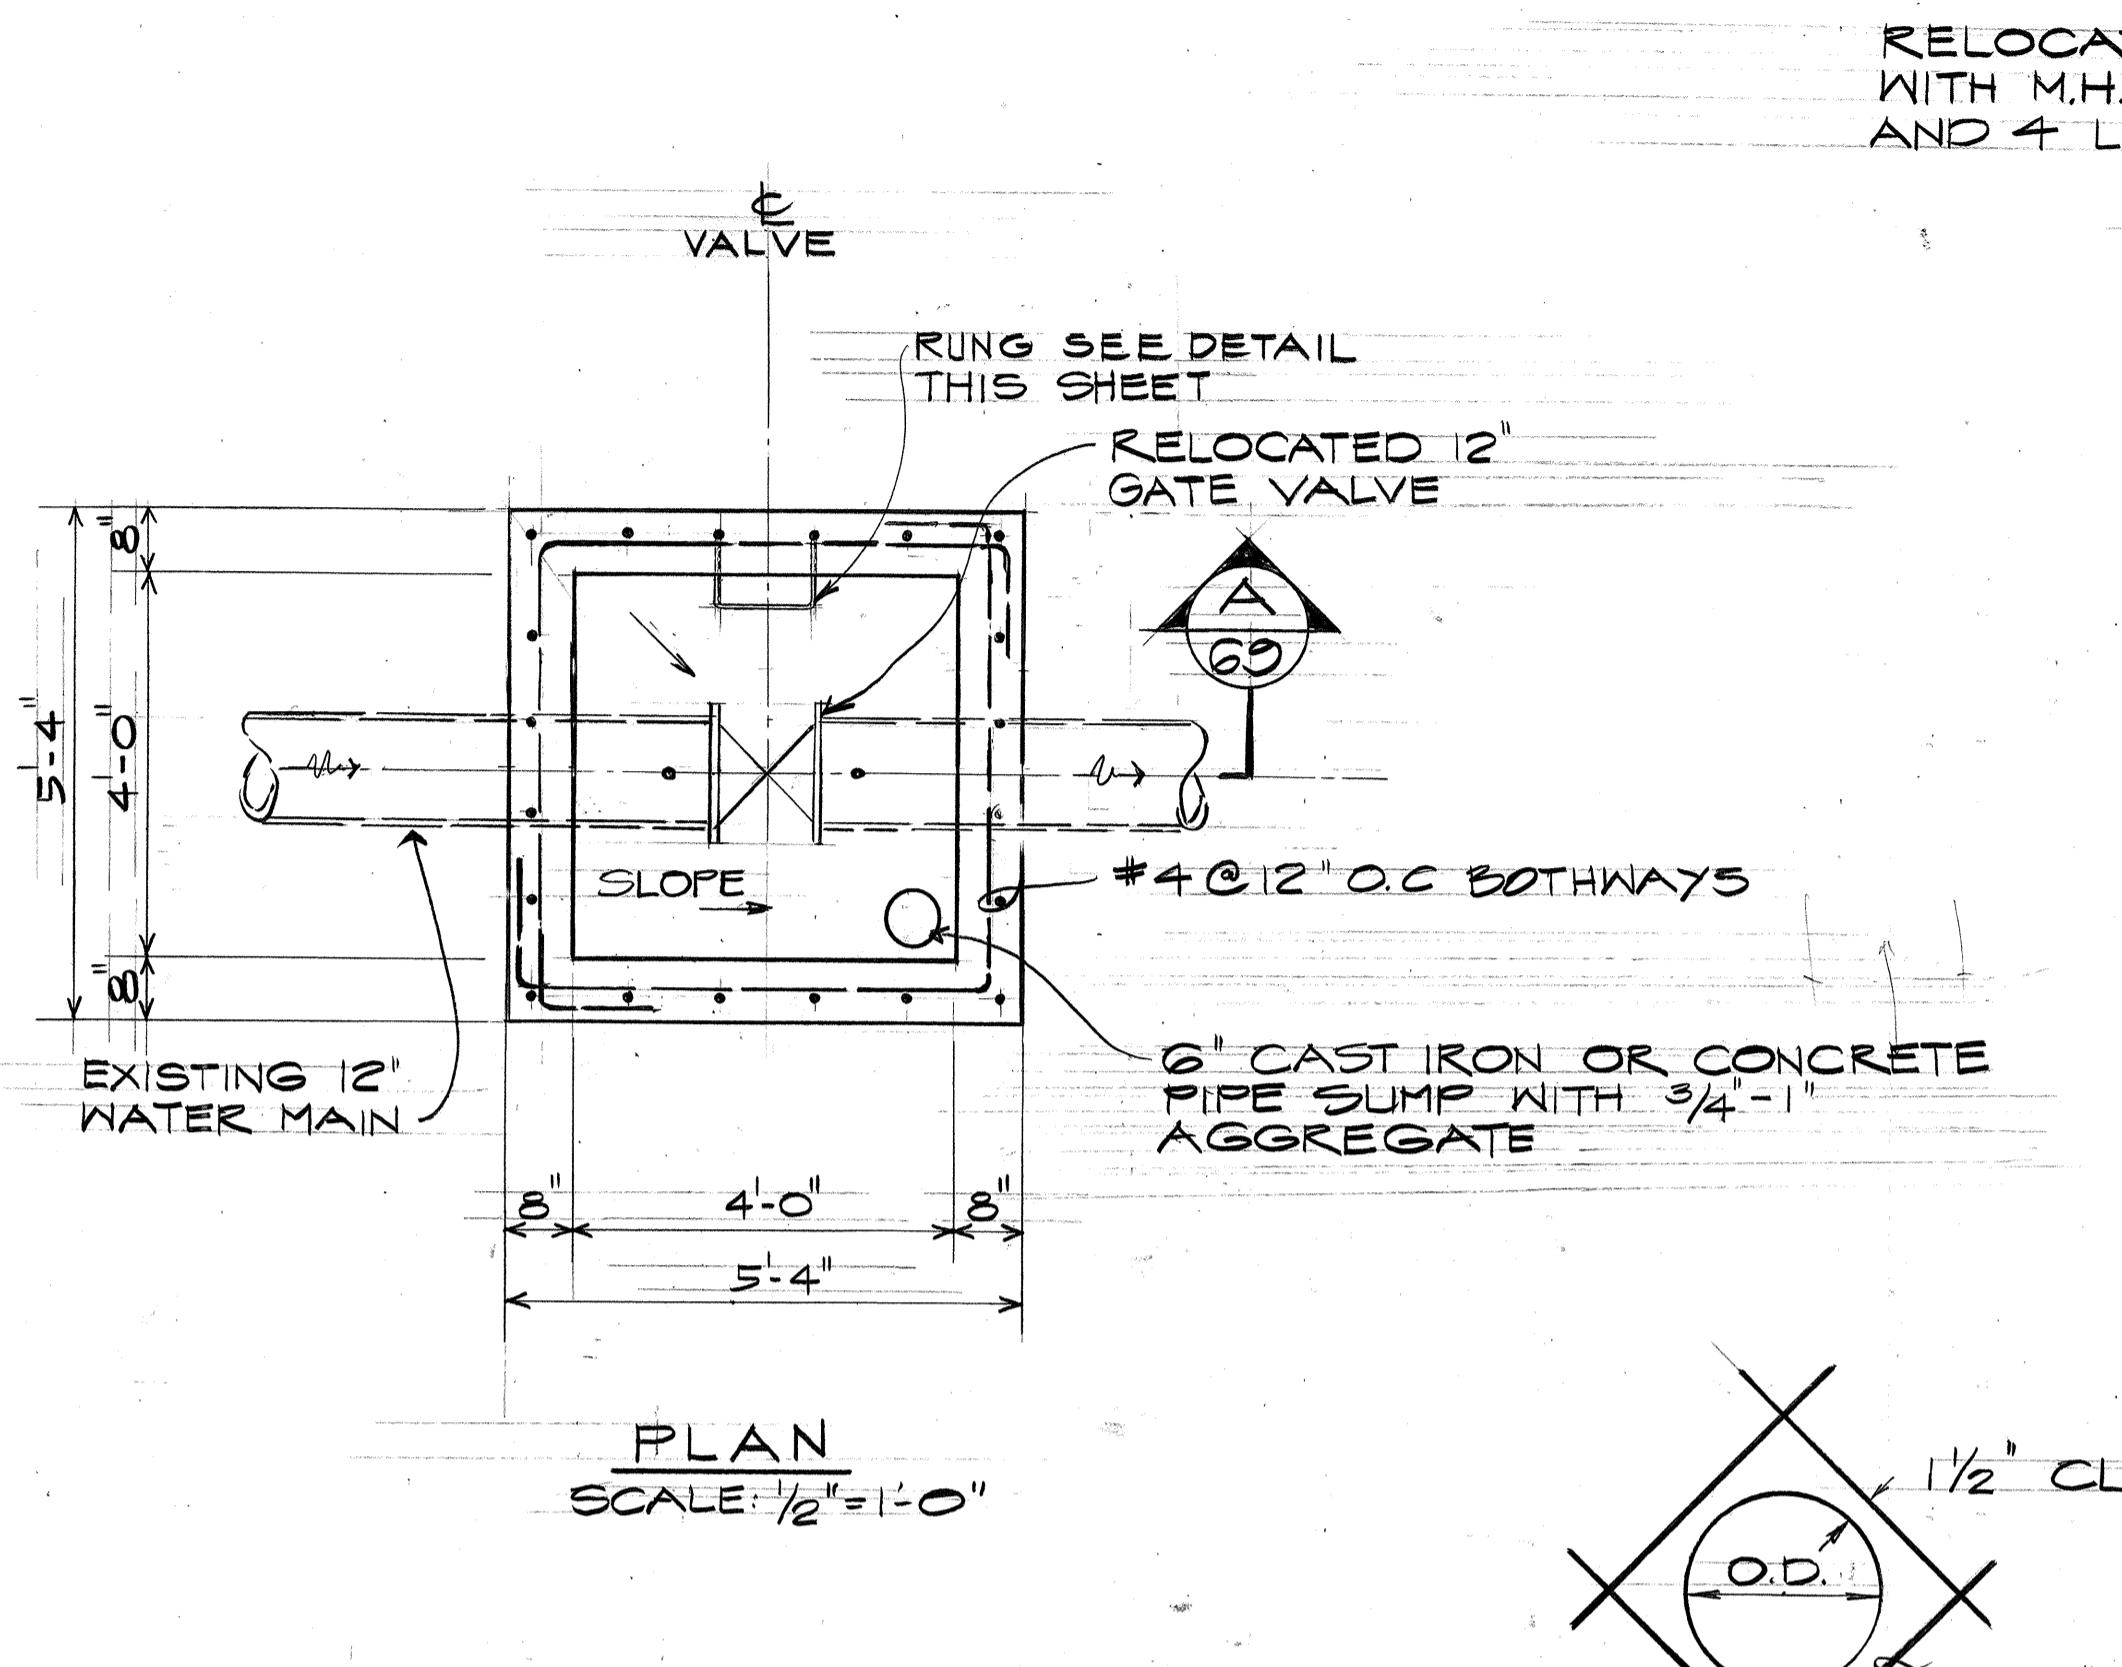

KEYWAY DETAIL


SCALE: 1/2" = 1'-0"

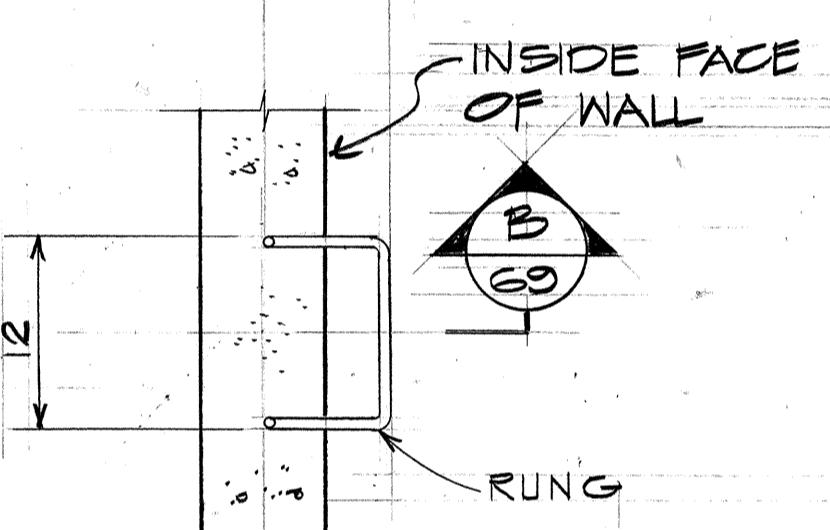

NOTES:

1. RUNGS SHALL BE $\frac{3}{4}$ " GENUINE WROUGHT IRON AND SHALL BE HOT-DIPPED GALVANIZED AFTER BENDING.
2. RUNGS SHALL BE SPACED 16" O.C. AND THE LOWEST RUNG SHALL BE NOT MORE THAN 2'-0" ABOVE THE MANHOLE FLOOR.


PLAN

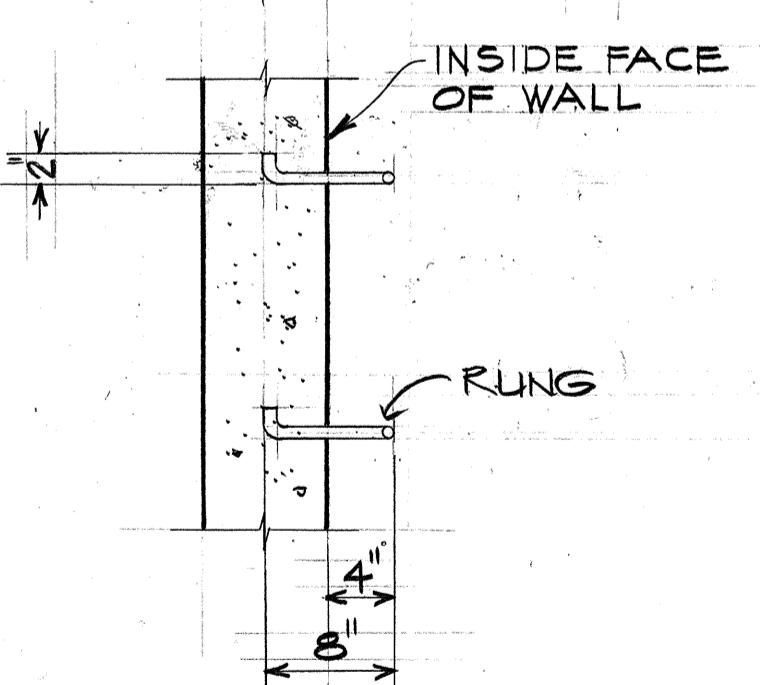



SECTION B

RUNG DETAIL

SCALE: 1" = 1'-0"

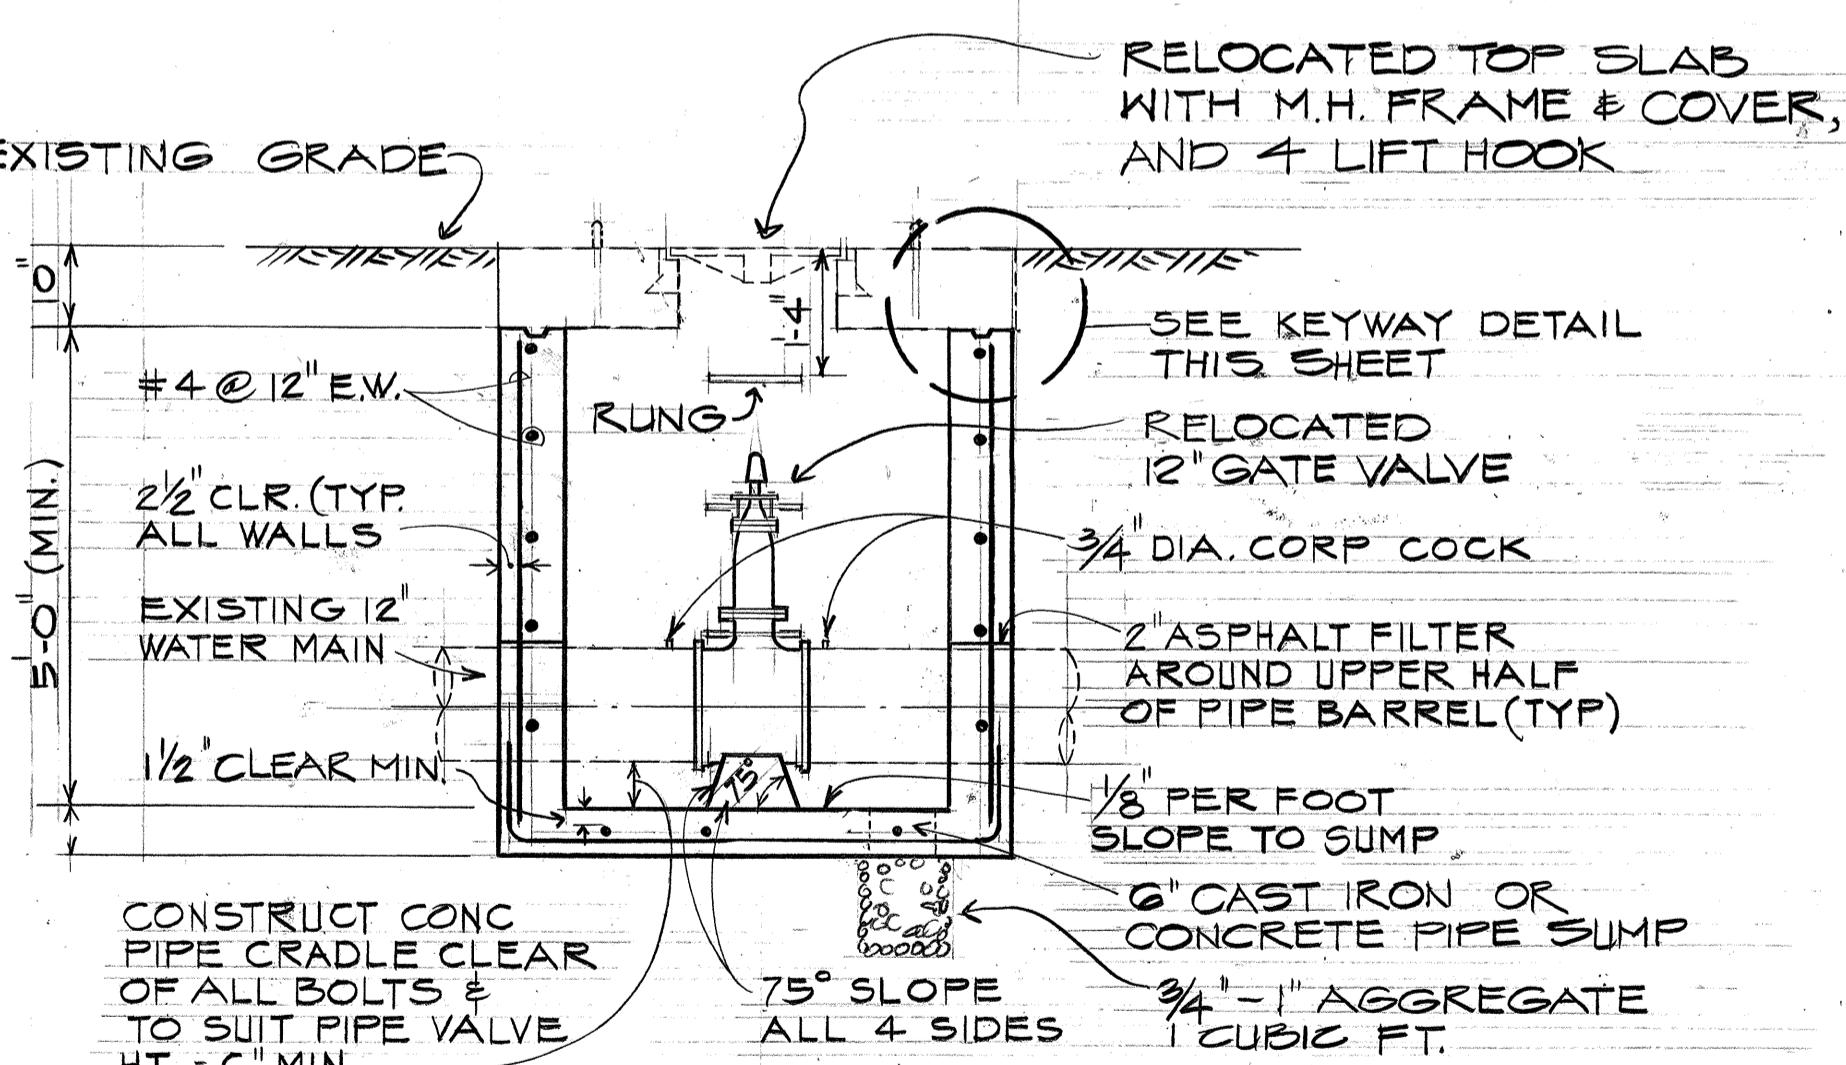

GATE VALVE BOX DETAILS

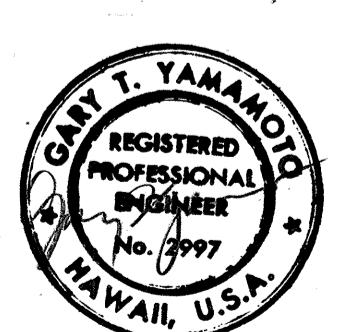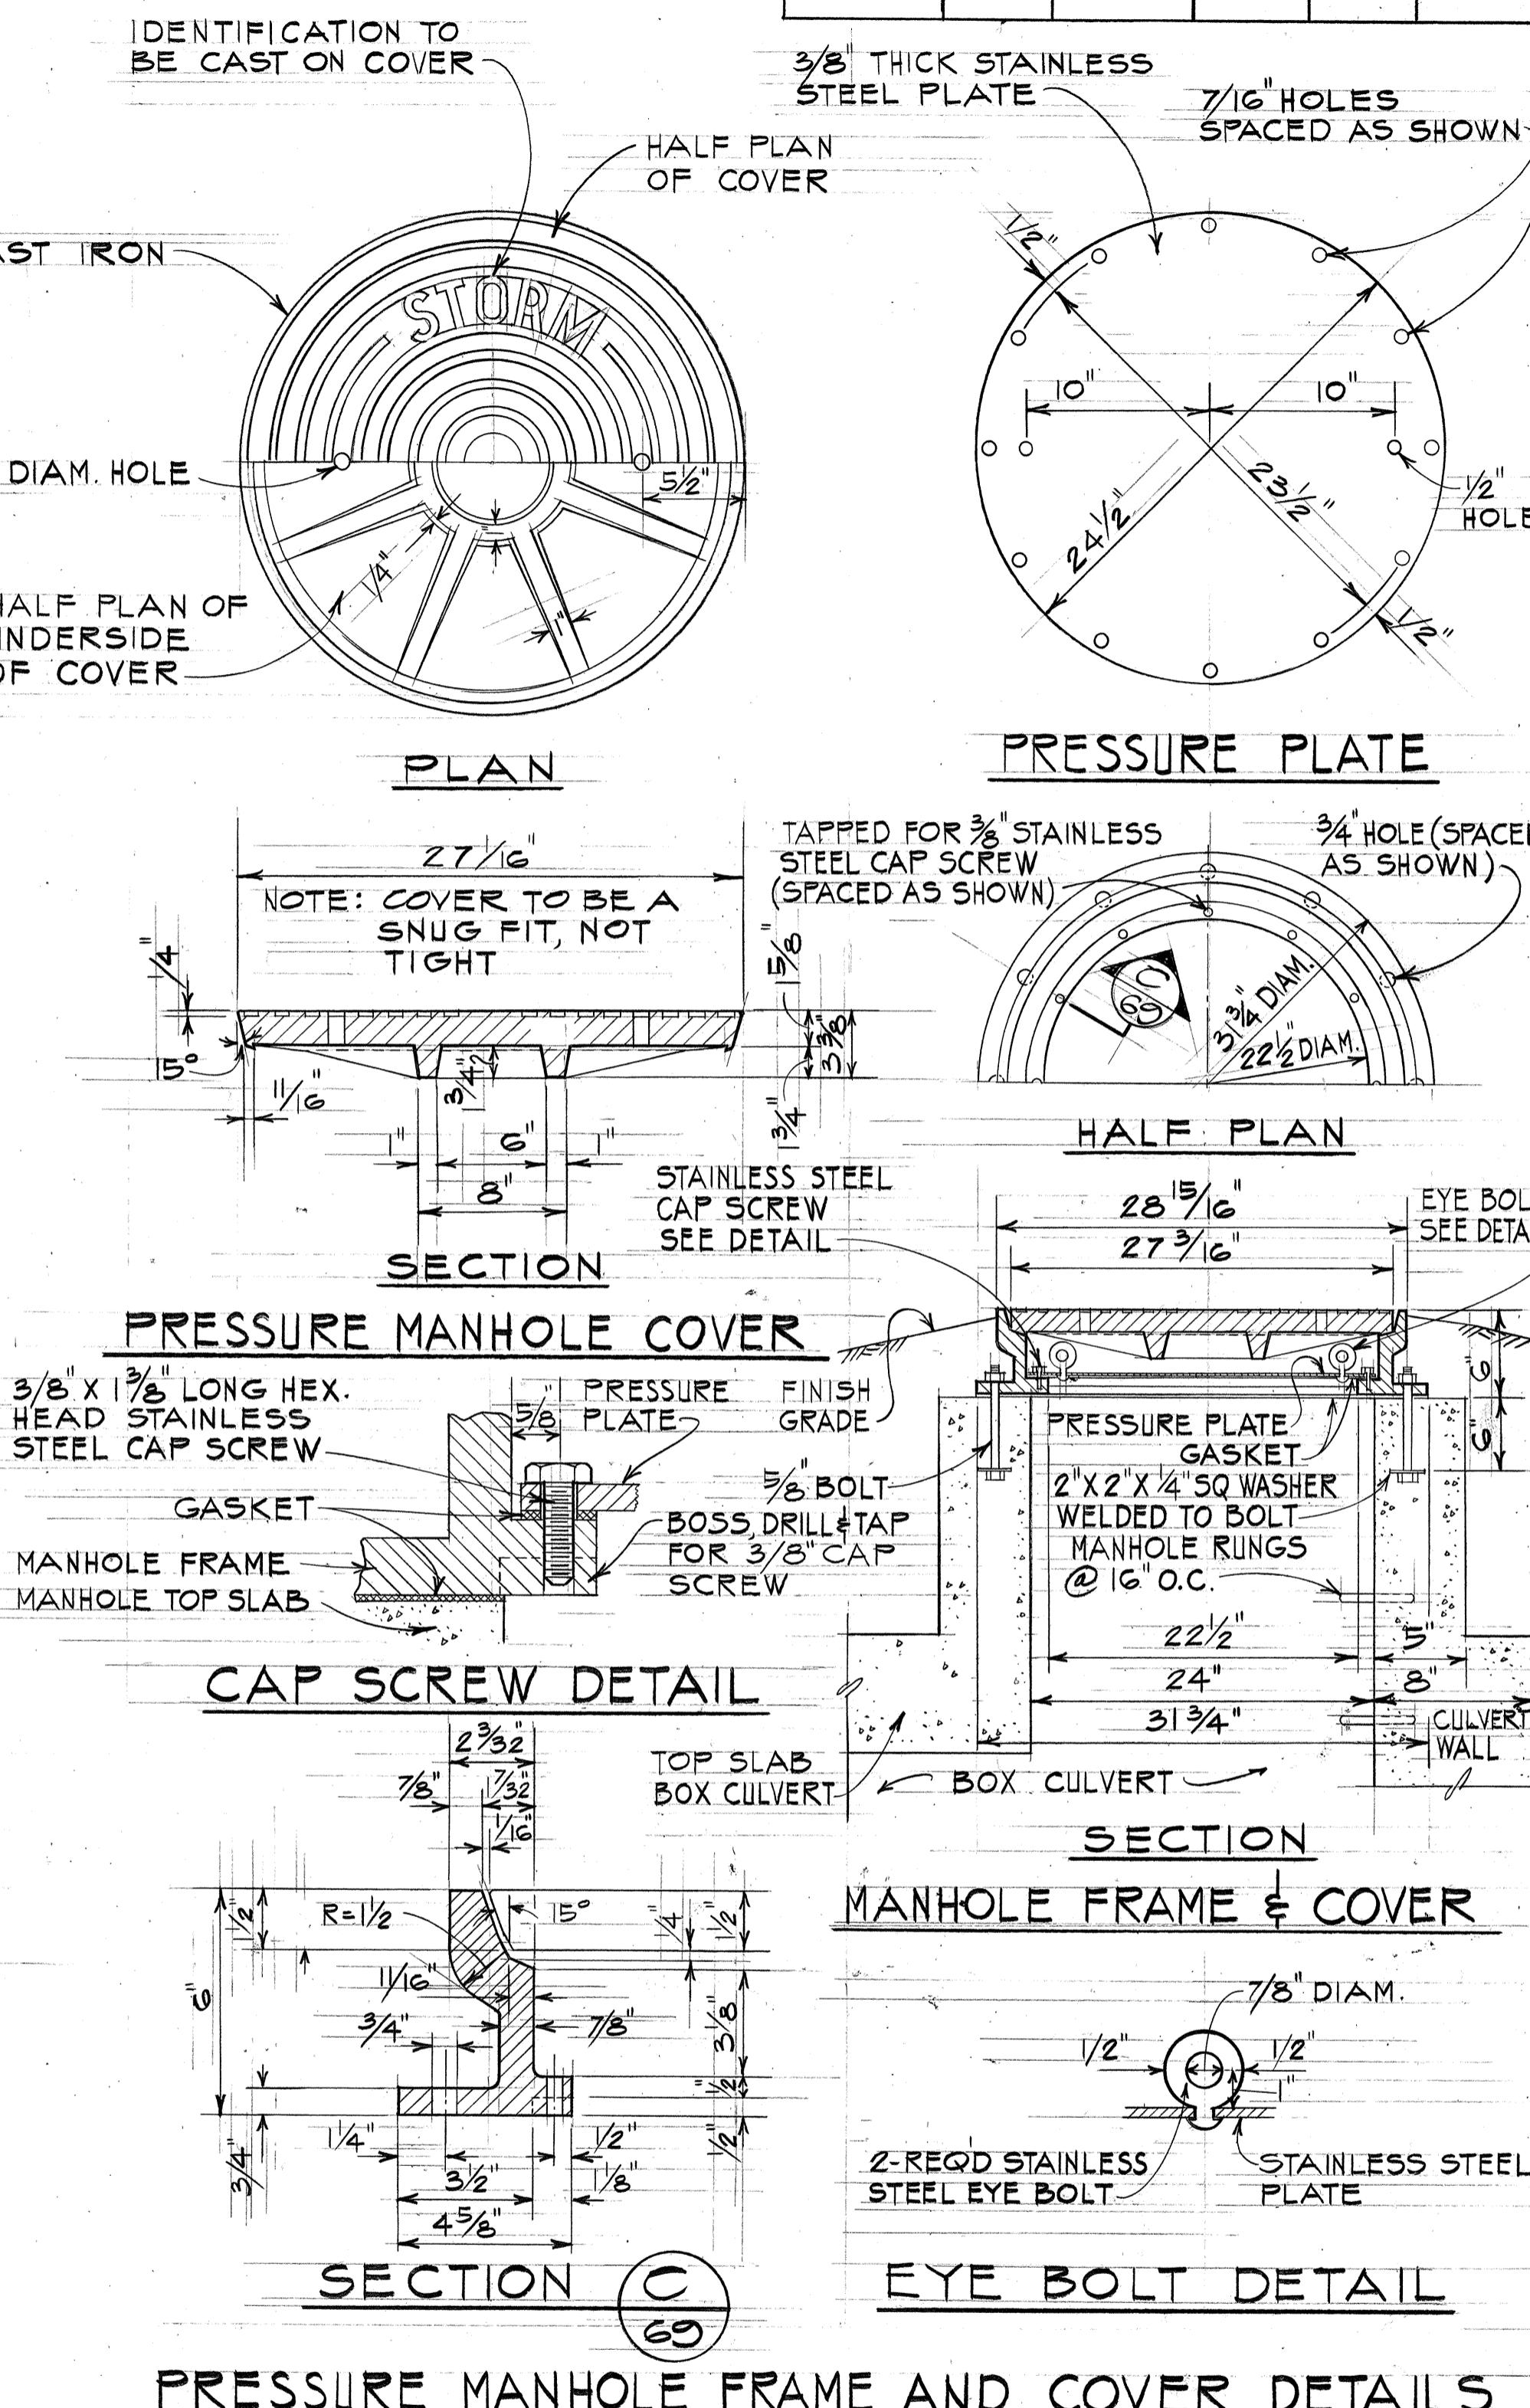

Wilbert T. Takemoto
THIS WORK WAS PREPARED BY ME
OR UNDER MY SUPERVISION

STATE OF HAWAII
DEPARTMENT OF TRANSPORTATION
HIGHWAYS DIVISION


DRAINAGE DETAILS

19TH STREET BOX CULVERT

VALVE BOX DETAILS
PEARL HARBOR INTERCHANGE
F.A.I. PROJ. NO. I-HI-1(73):15

Scale: As Shown Date: DEC. 7, 1973
SHEET No. 3 OF 17 SHEETS

FED. ROAD DIST. NO.	STATE	FED. AID PROJ. NO.	FISCAL YEAR	SHEET NO.	TOTAL SHEETS
HAWAII	HAW.	IHI-1(73)15	1974	70	300

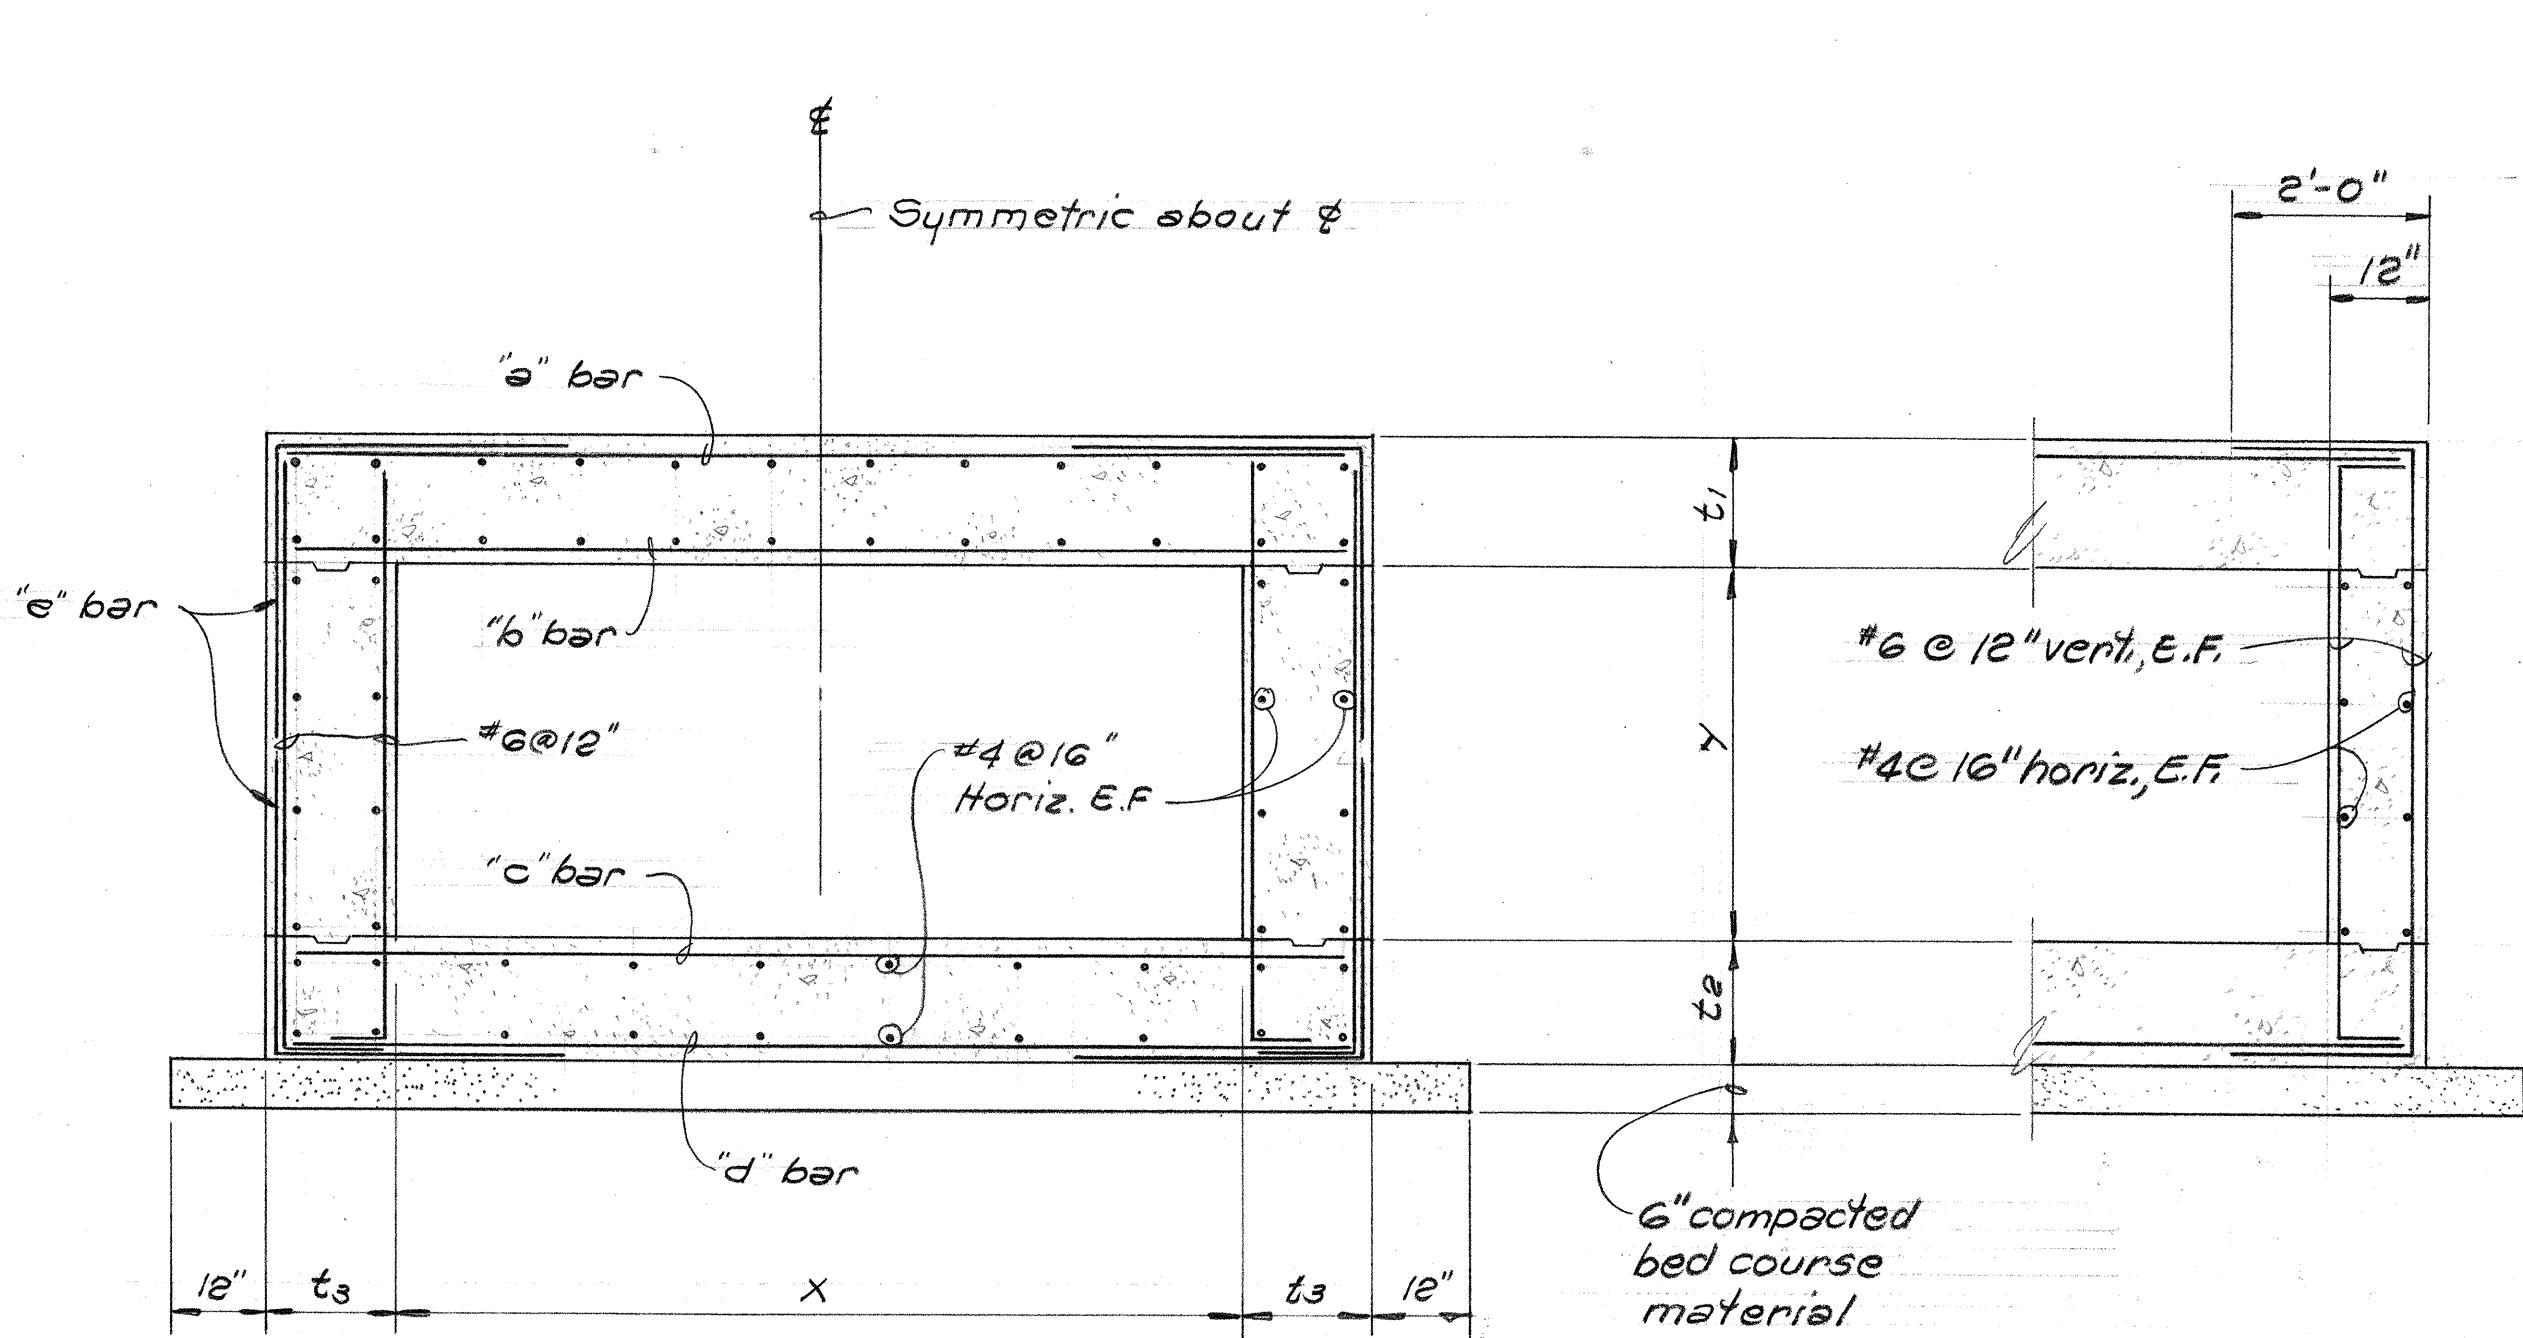


TYPICAL SECTION

SECTION AT END WALL (STA. 3+68.85)

Scale: 1/2" = 1'-0"

CULVERT SCHEDULE									
Station From	To	x	y	t ₁	t ₂	t ₃	"a" bar	"b" bar	"c" bar
0+00	0+27.67	Varies	Varies	12"	12"	12"	#6@11"	#8@11"	#8@11"
0+27.67	1+20	12'-0"	3'-6"	12"	12"	12"	#6@11"	#8@11"	#8@11"
1+20	2+40	12'-0"	3'-6"	1'-5"	2'-0"	1'-2"	#6@12"	#8@12"	#8@12"
2+40	2+60	Varies	3'-6"	1'-5"	2'-0"	1'-2"	#6@12"	#8@12"	#8@12"
2+60	3+68.85	8'-0"	3'-6"	1'-2"	1'-2"	1'-2"	#8@13"	#8@9"	#8@9"

SPECIAL NOTE: At Sta. 1+26 provide 3'0" x 6'0" opening in top slab for drop intake. Add 3-#8X14'-0" ea. side of opening.

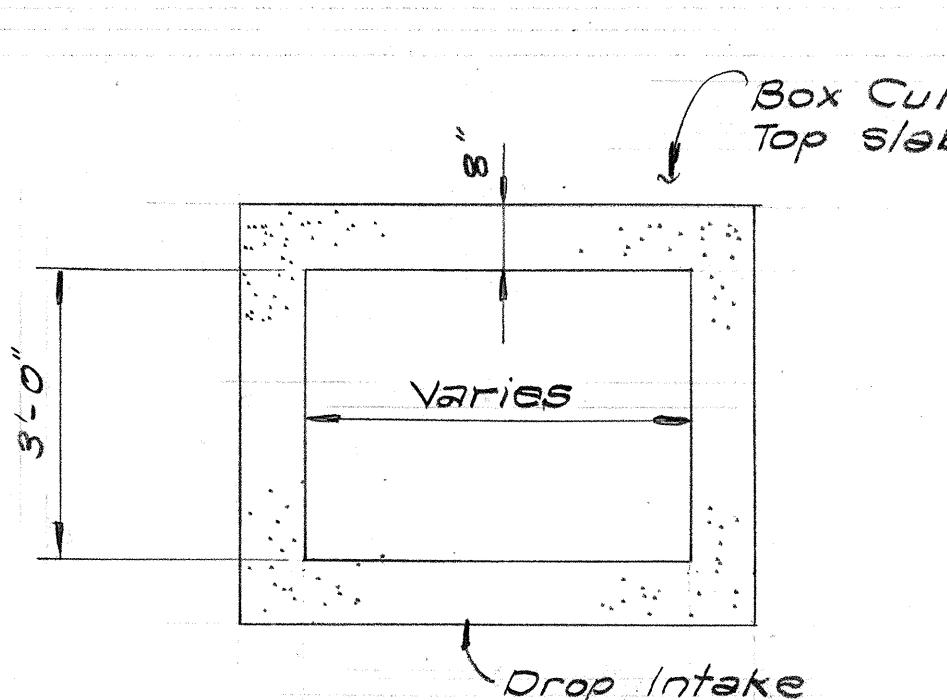


DROP INTAKE MOUNTED ON
BOX CULVERT, FOR TYPE "Z"
INTAKE SEE SH. 71, FOR
TYPE G/218 SEE SH. 82

PLAN


NOTE:
For Plan Location of Drop
Intake See Sh. D-2

TYPICAL SECTION

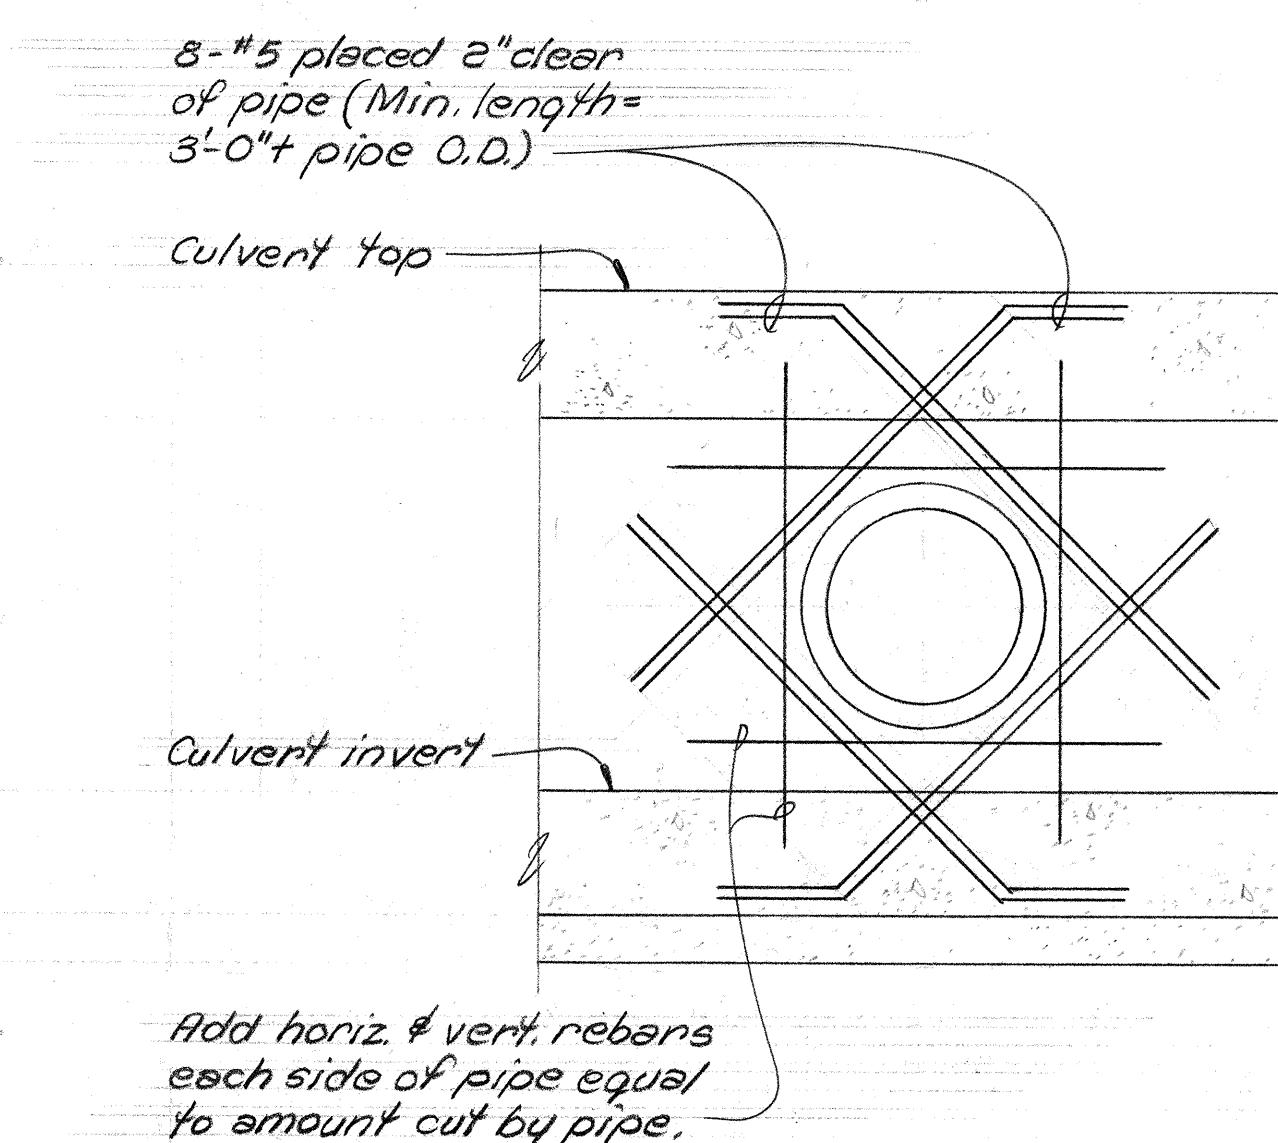


TYPICAL DETAIL AT JUNCTION

Scale: 1/2" = 1'-0"

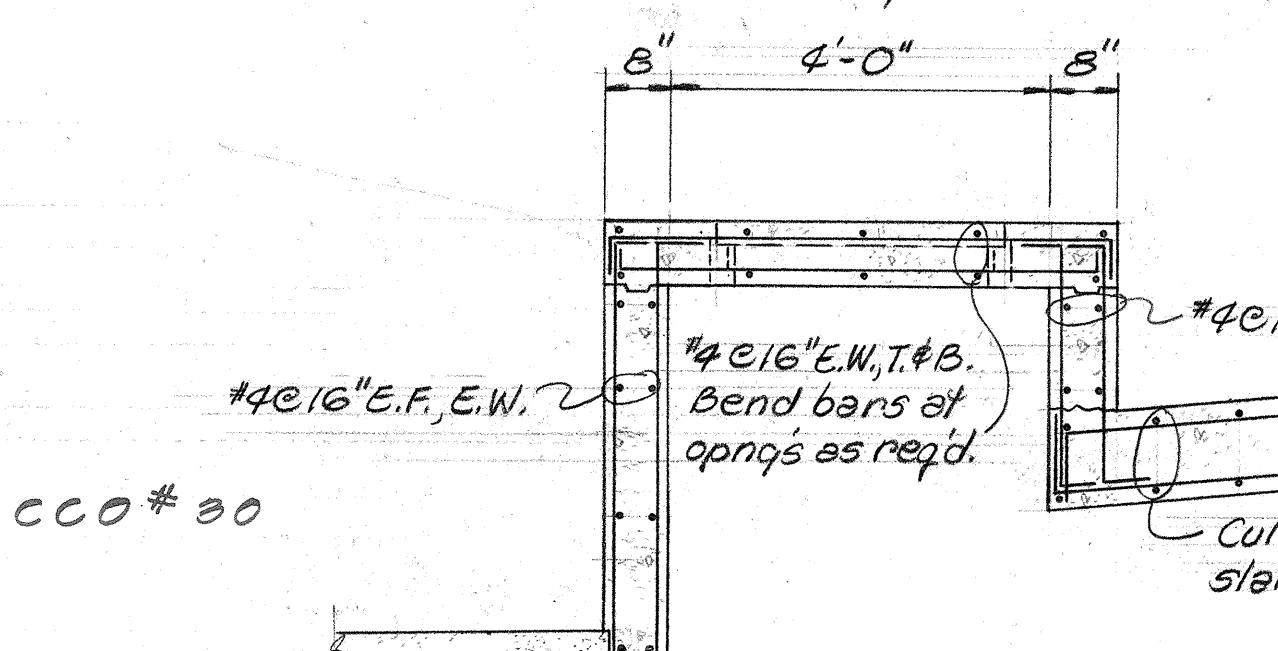

PLAN AT JUNCTION BOX #2 (STA. 0+00)


Scale: 1/4" = 1'-0"

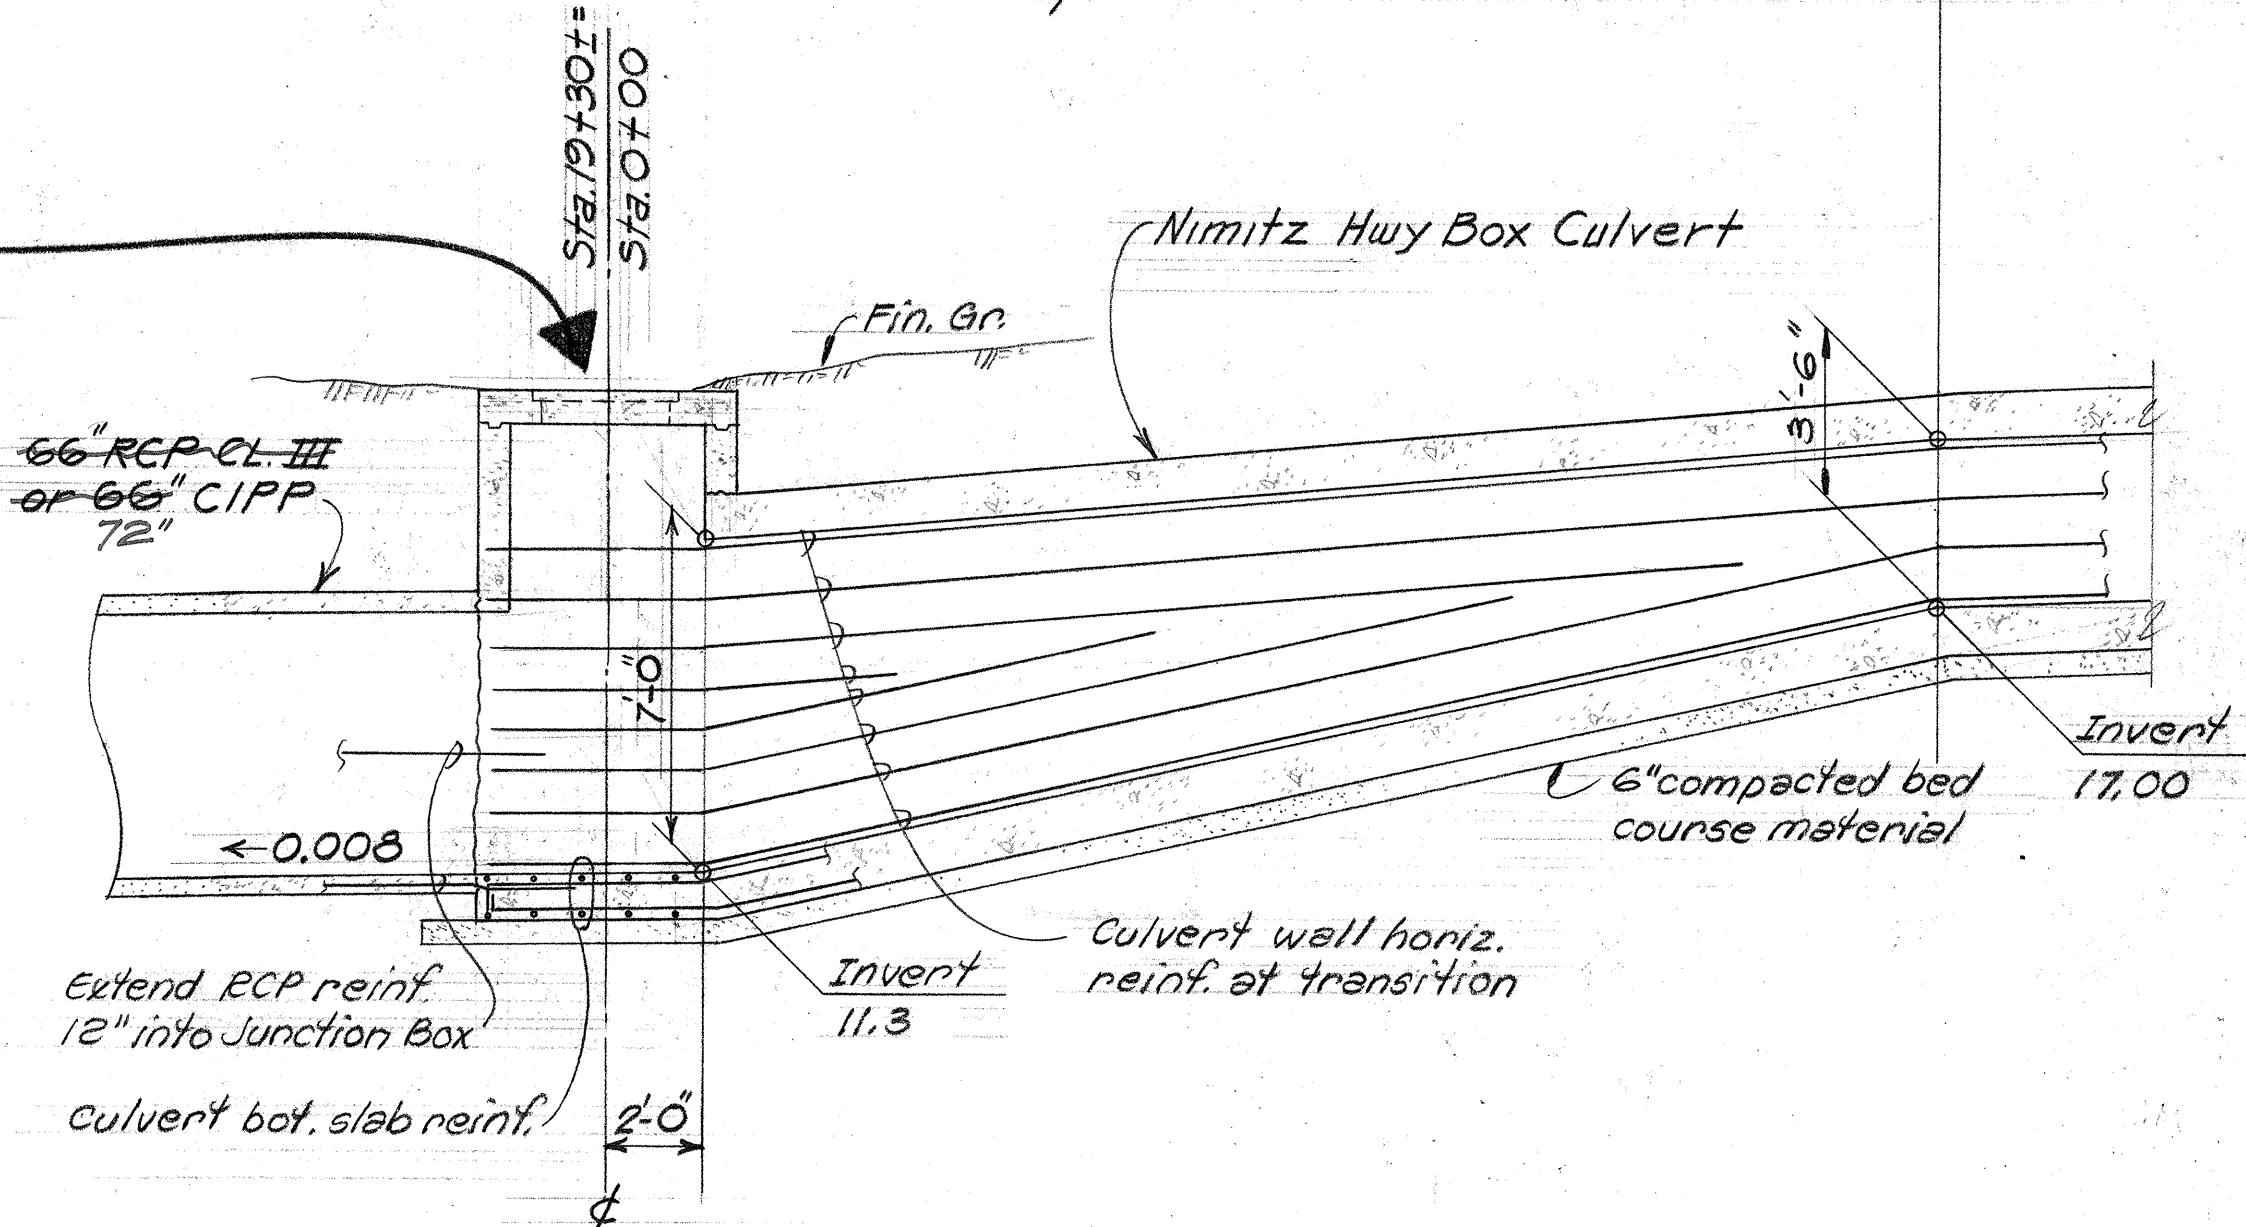

SECTION
Scale: 1/4" = 1'-0"

NOTE:
For Nimitz Hwy Box Culvert Plan See Sheet D-2

JUNCTION BOX #2 DETAILS

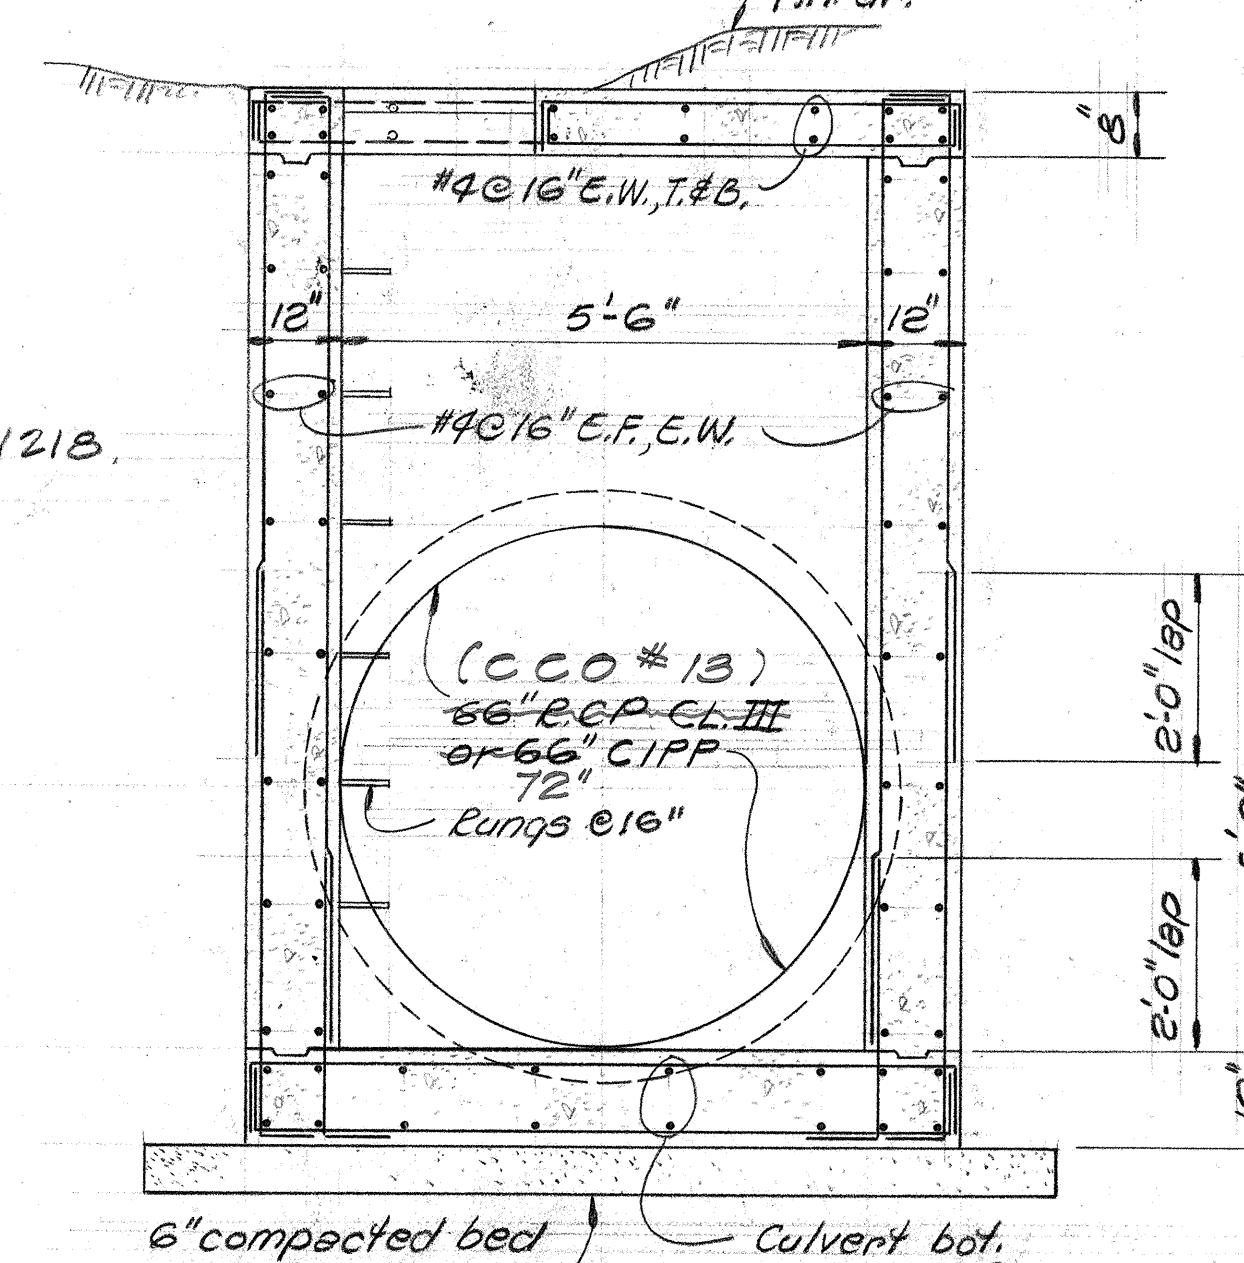

SECTION
Scale: 1/2" = 1'-0"

NIMITZ HIGHWAY BOX CULVERT DETAILS



THIS WORK WAS PREPARED BY ME
OR UNDER MY SUPERVISION

STATE OF HAWAII
DEPARTMENT OF TRANSPORTATION
HIGHWAYS DIVISION


DRAINAGE DETAILS
(NIMITZ HIGHWAY BOX CULVERT)
&
(JUNCTION BOX #2)
PEARL HARBOR INTERCHANGE
F.A.I. PROJ. NO. I-HI-1 (73) : 15

SCALE: AS SHOWN DATE: DEC. 7, 1973
SHEET NO. 4 OF 17 SHEETS


FED. ROAD DIST. NO.	STATE	FED. AID PROJ. NO.	FISCAL YEAR	SHEET NO.	TOTAL SHEETS
HAWAII	HAW.	I-HI-1(73):15	1974	71	369

GENERAL NOTES:

1. GENERAL NOTES AND APPLICABLE DETAILS FOR STANDARD DETAILS OF TYPES G1214 AND G1614 DROP INTAKES WILL APPLY.
 2. REINFORCED CONCRETE DESIGN DATA $f'_c = 3000 \text{ PSI}$ (28 DAYS)
 $f_s = 20,000 \text{ PSI}$
DEFORMED BARS
 3. FOR SPLICES NOT DETAILED, OVERLAP BARS 24" BAR DIAMETERS OR 12" MINIMUM; STAGGER ALL SPLICES AS APPROVED BY THE ENGINEER.
 4. REINFORCING STEEL FOR BEAMS ARE TO BE $1\frac{1}{2}$ " CLEAR FROM FORMS.
 5. WALL REINFORCING BARS WILL BE #5 @ 12" O.C. BOTH DIRECTIONS CENTERED IN SLAB AND BEND INTO TOP SLAB WHERE APPLICABLE A MINIMUM OF 12".
 6. BEND WALL REINFORCEMENT AROUND PIPE CULVERT WHERE NECESSARY.
 7. UNLESS OTHERWISE SPECIFIED MINIMUM INSIDE WIDTH OF BOX 3'-0".
 8. INSIDE WALL WIDTH WHEN GREATER THAN MINIMUM TO BE THE PROJECTION OF EQUIVALENT CMP INSIDE DIAMETER OR RCP OUTSIDE DIAMETER.
 9. ALL CONCRETE SHALL BE CLASS "A" UNLESS OTHERWISE NOTED.
 10. TOP OF INTAKE TO CONFORM TO FINISH GRADE.
 11. CONNECTION TO EXISTING DRAINAGE SYSTEM SHALL BE INCIDENTAL TO VARIOUS CONTRACT ITEMS.

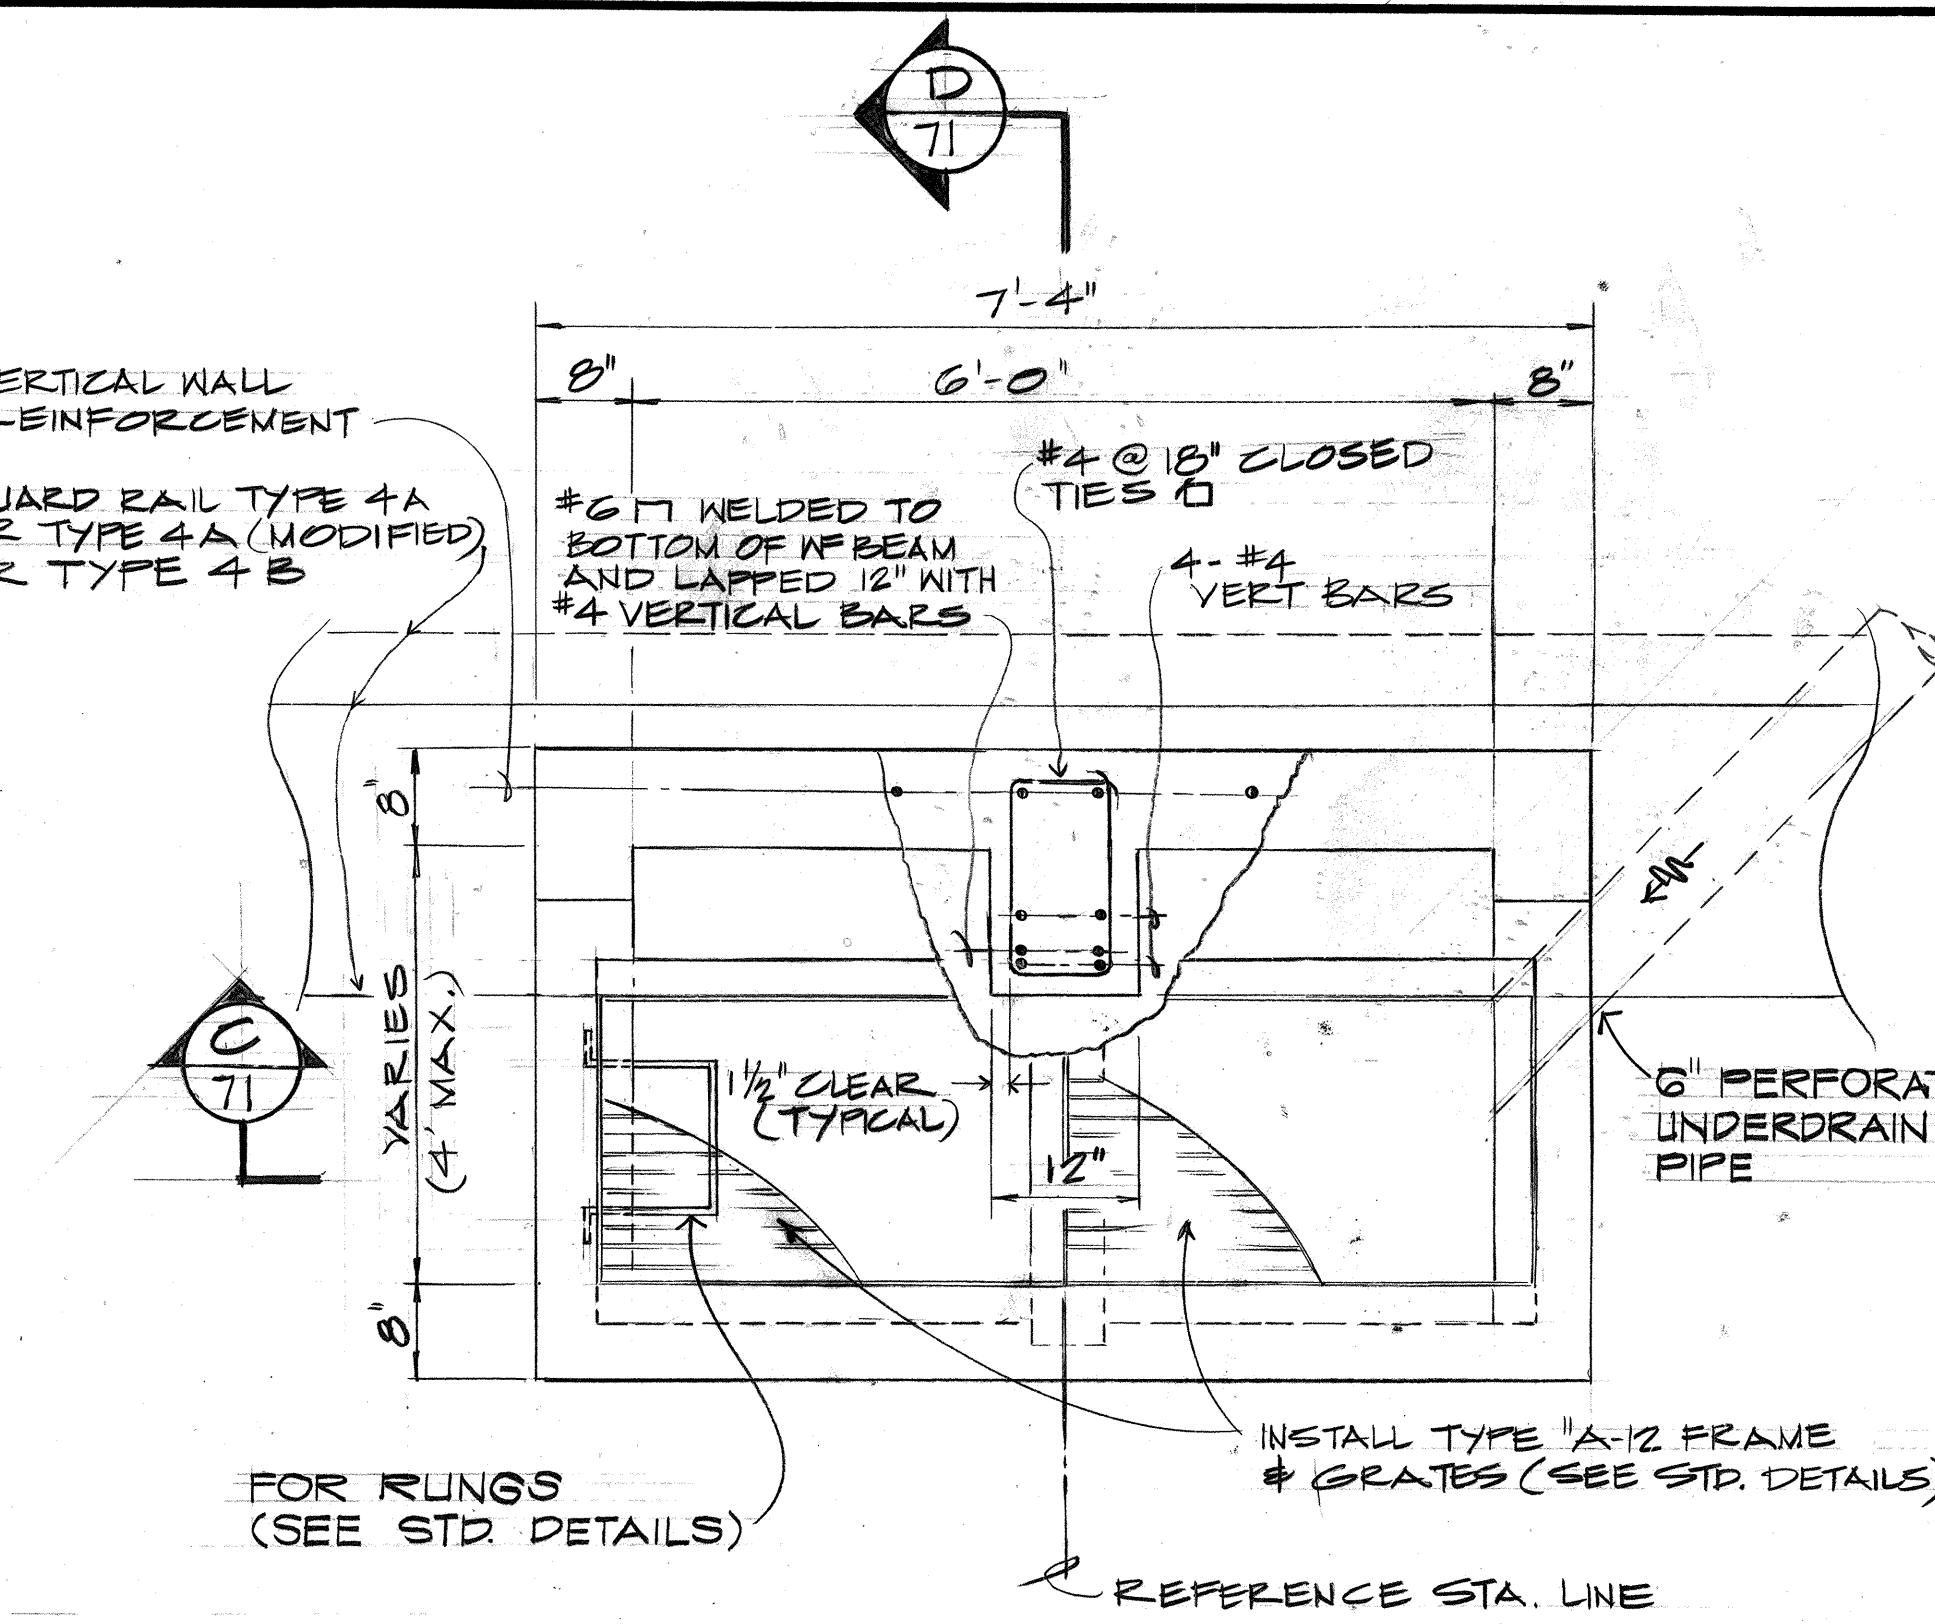



PLA

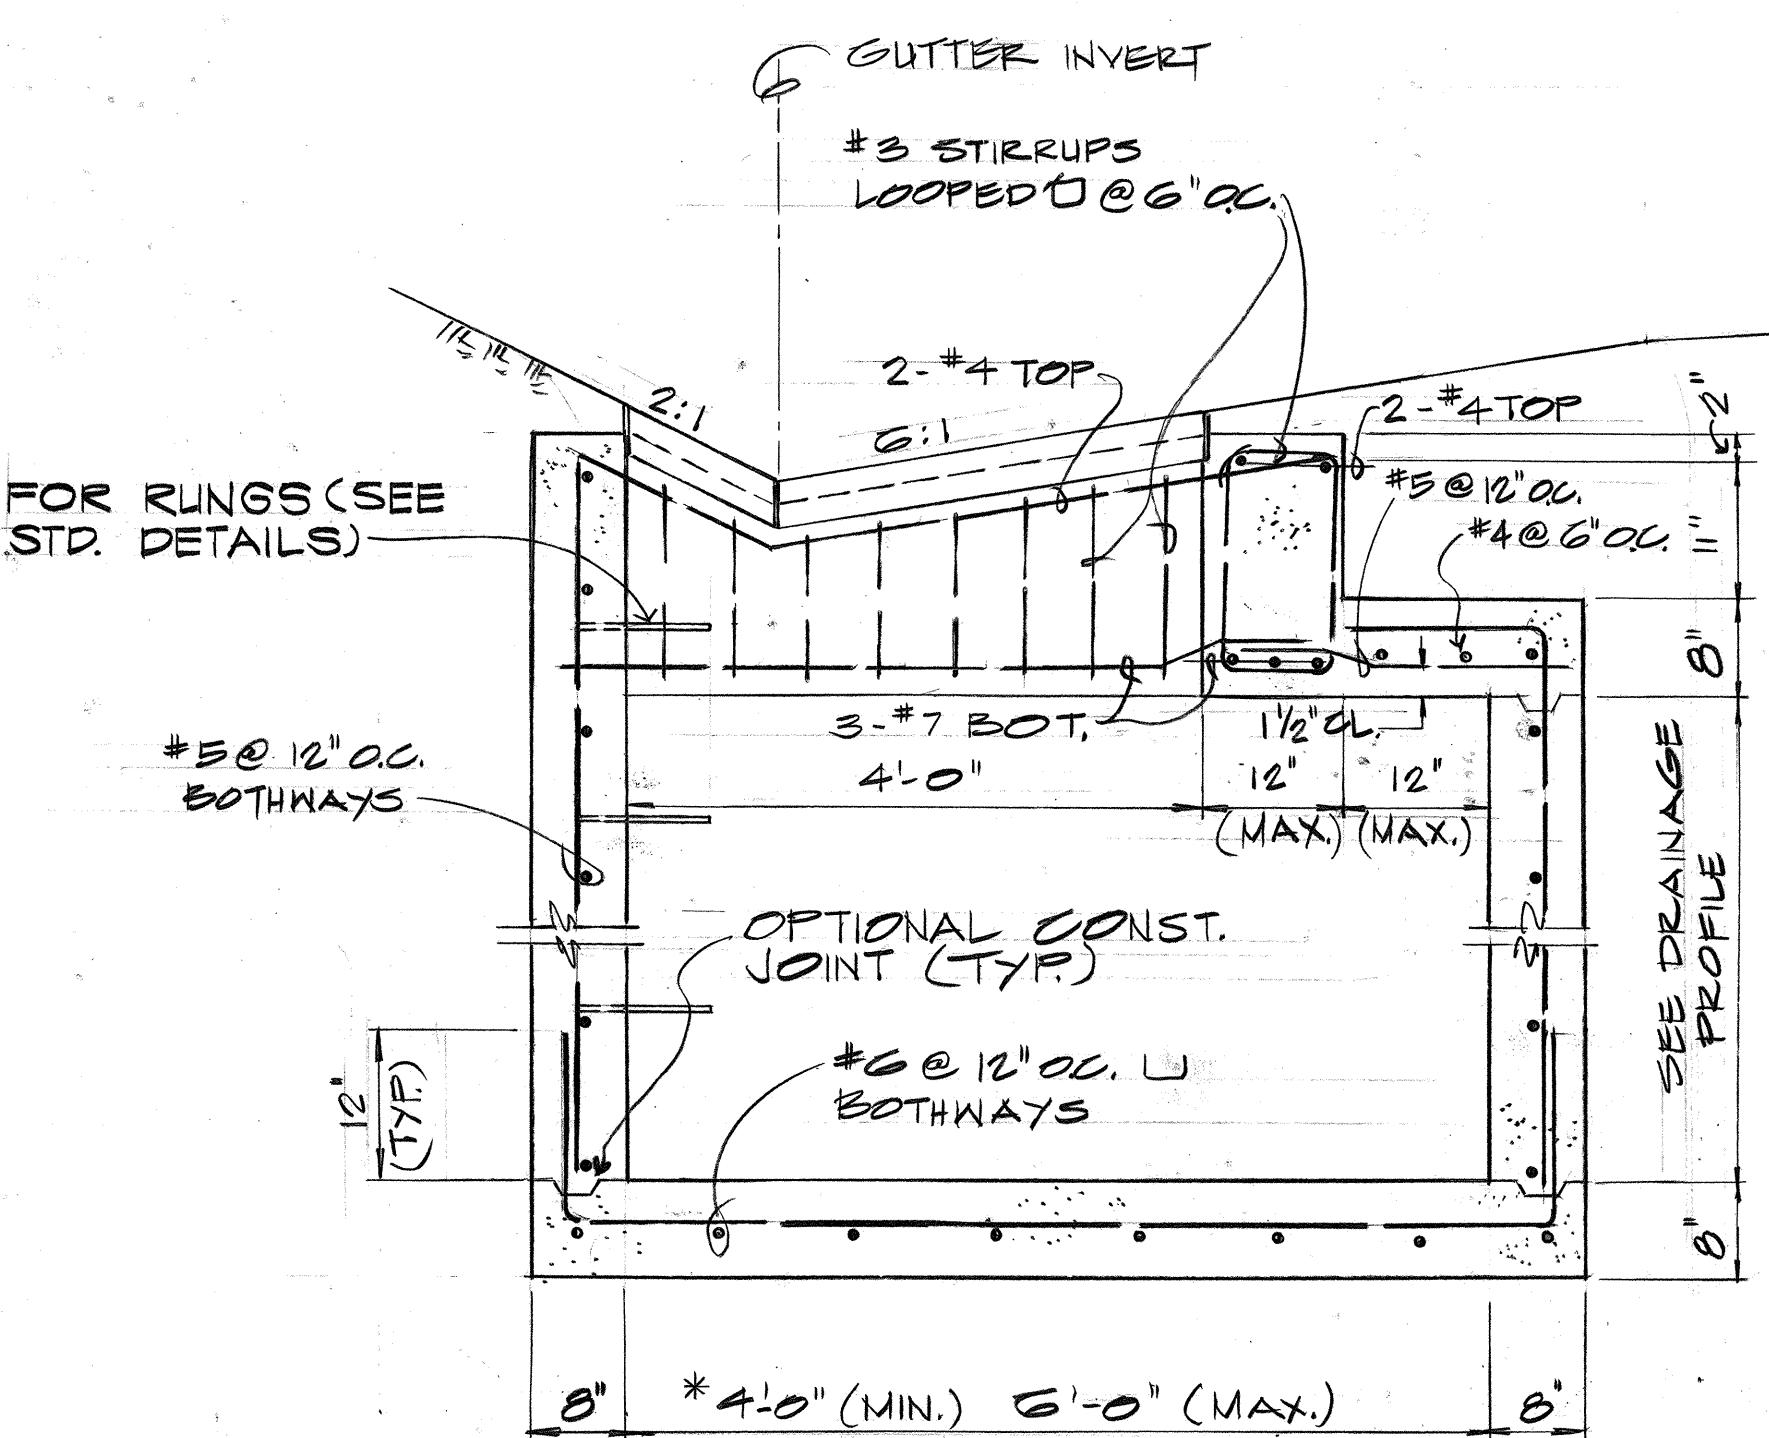

SECTION A



DROP INTAKE TYPE "S"

SCALE: 3/4" = 1'-0"

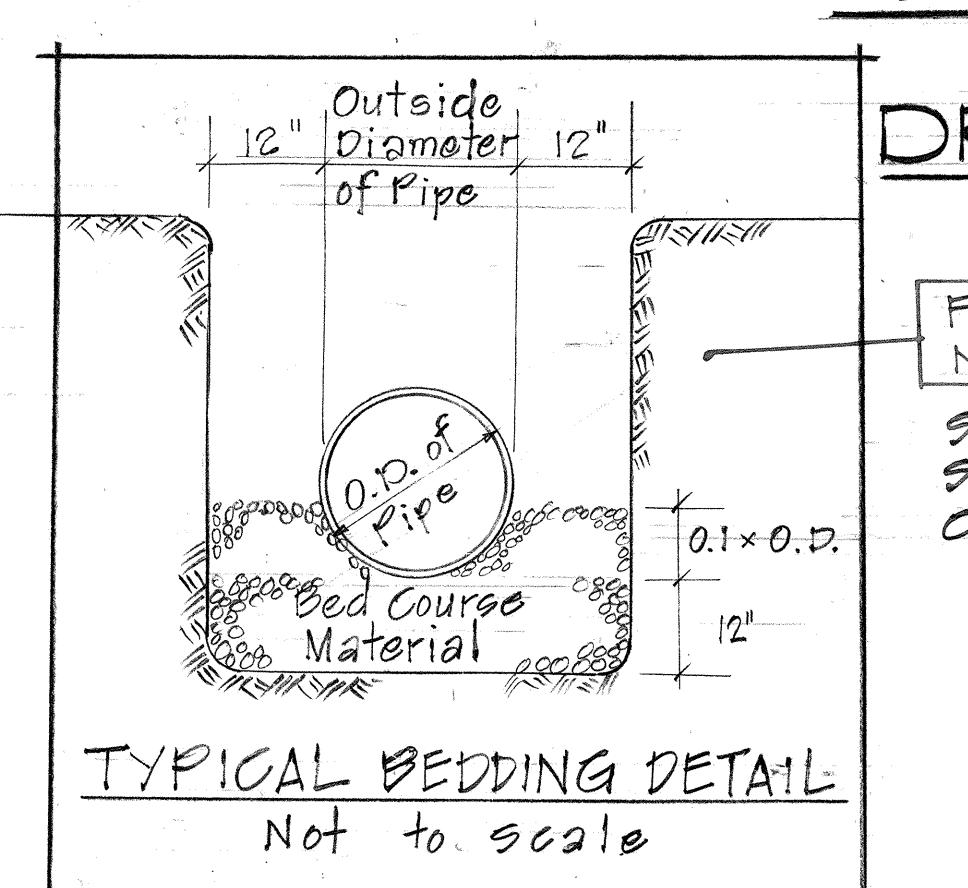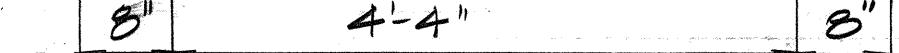

SECTION

SECTION

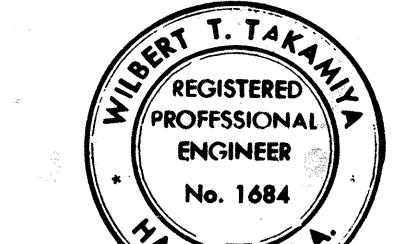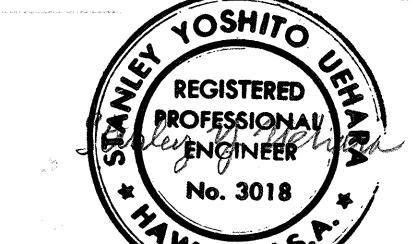

THIS WORK WAS PREPARED BY ME
OR UNDER MY SUPERVISION

**STATE OF HAWAII
DEPARTMENT OF TRANSPORTATION
HIGHWAYS DIVISION**

DRAINAGE DETAILS


PEARL HARBOR INTERCHANGE

SCALE: AS SHOWN DATE: DEC. 7, 1973
SHEET NO. 5 OF 17 SHEETS

FED. ROAD DIST. NO.	STATE	FED. AID PROJ. NO.	FISCAL YEAR	SHEET NO.	TOTAL SHEETS
HAWAII	HAW.	I-HI-1(73)15	1974	72	369


NOTES:

- COLLAR INSTALLATION, 2-12" RCP AND REMOVAL OF HEADWALL TO BE INCIDENTAL TO CONCRETE BOX CULVERT
- WHEN REMOVING HEADWALL PORTION OF PIPE TO REMAIN SHALL BE FREE OF SHATTERING OR SPALLING.


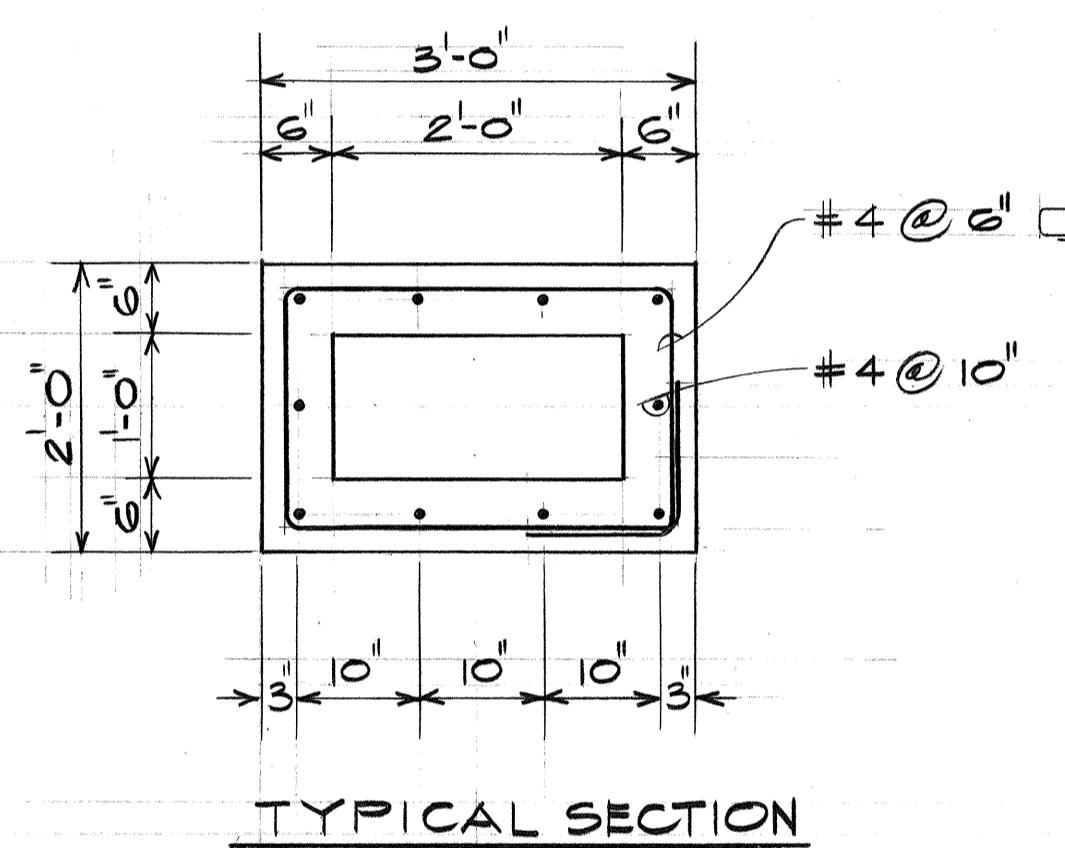


STEWART AVE BOX CULVERT

SCALE: $\frac{3}{4}'' = 1'-0''$

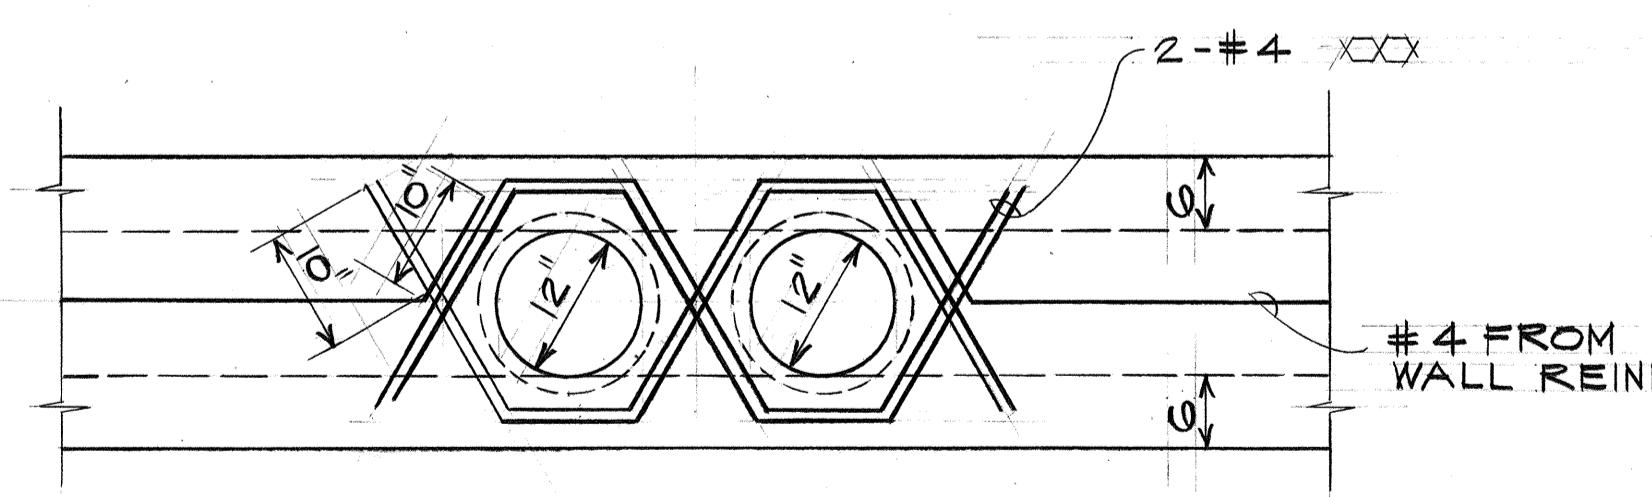

SCALE: $\frac{3}{4}'' = 1'-0''$

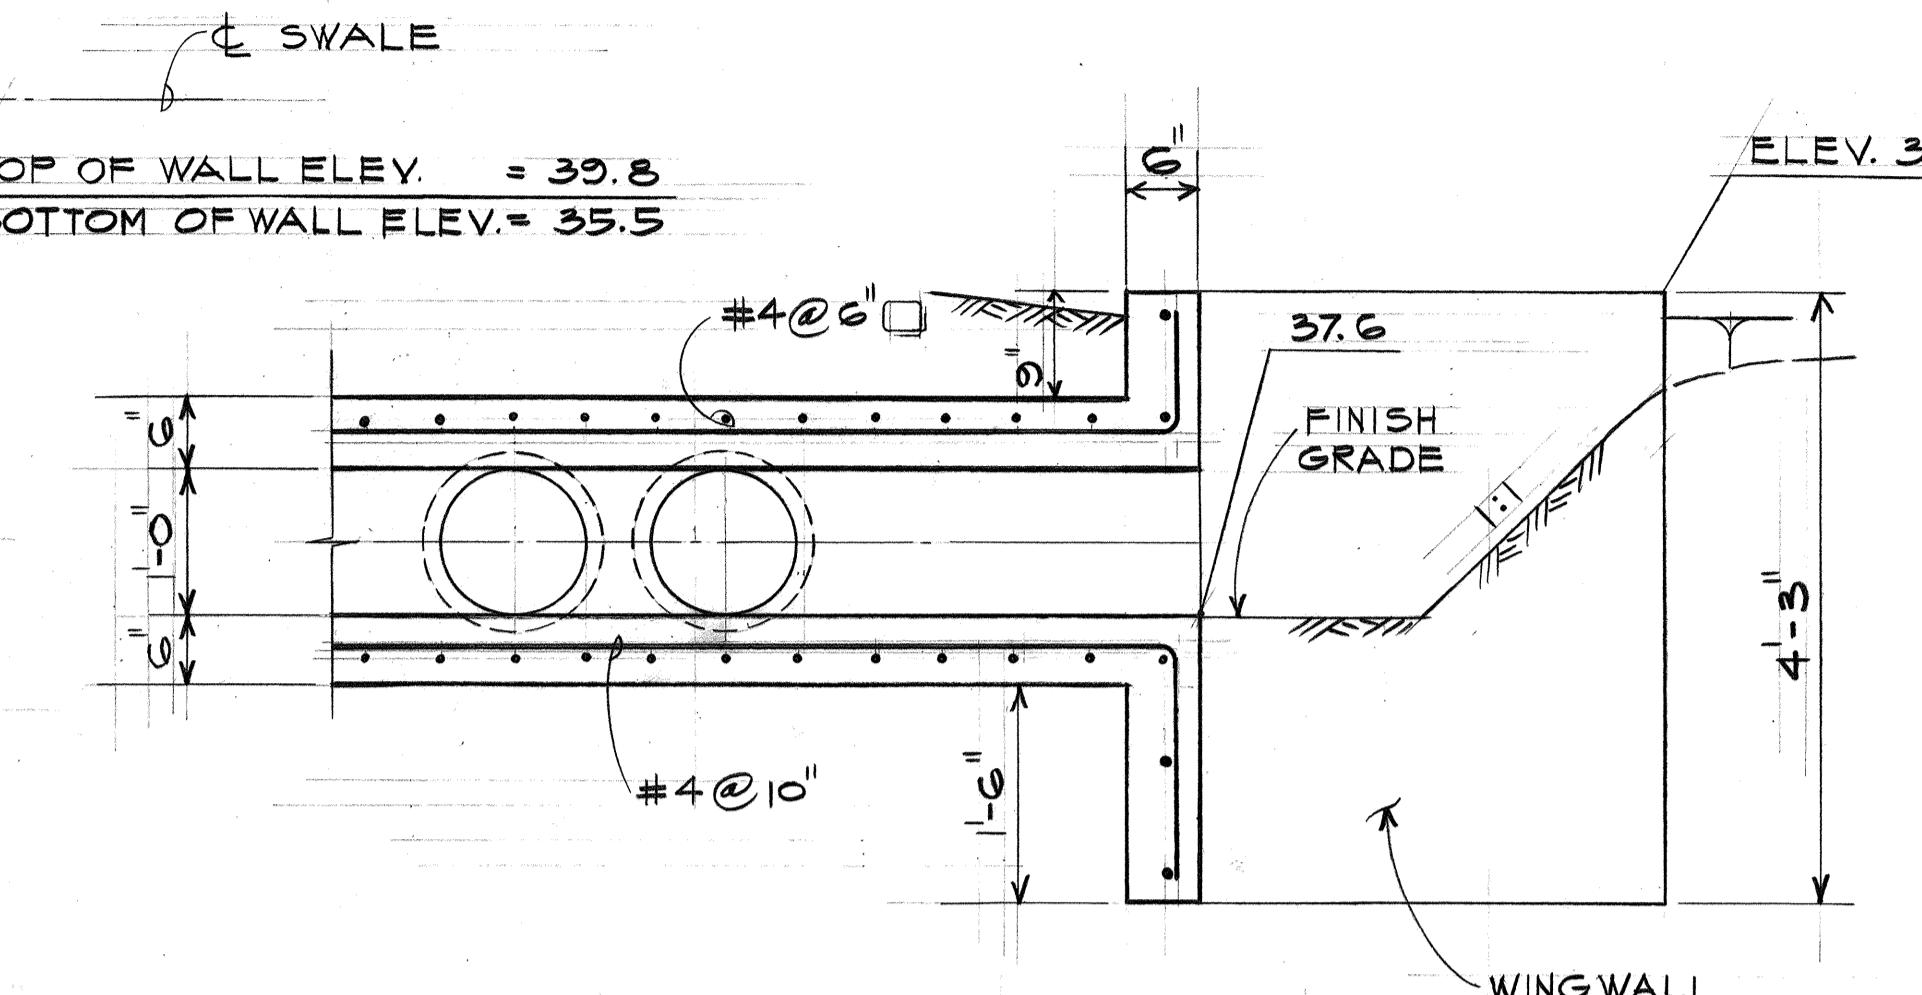
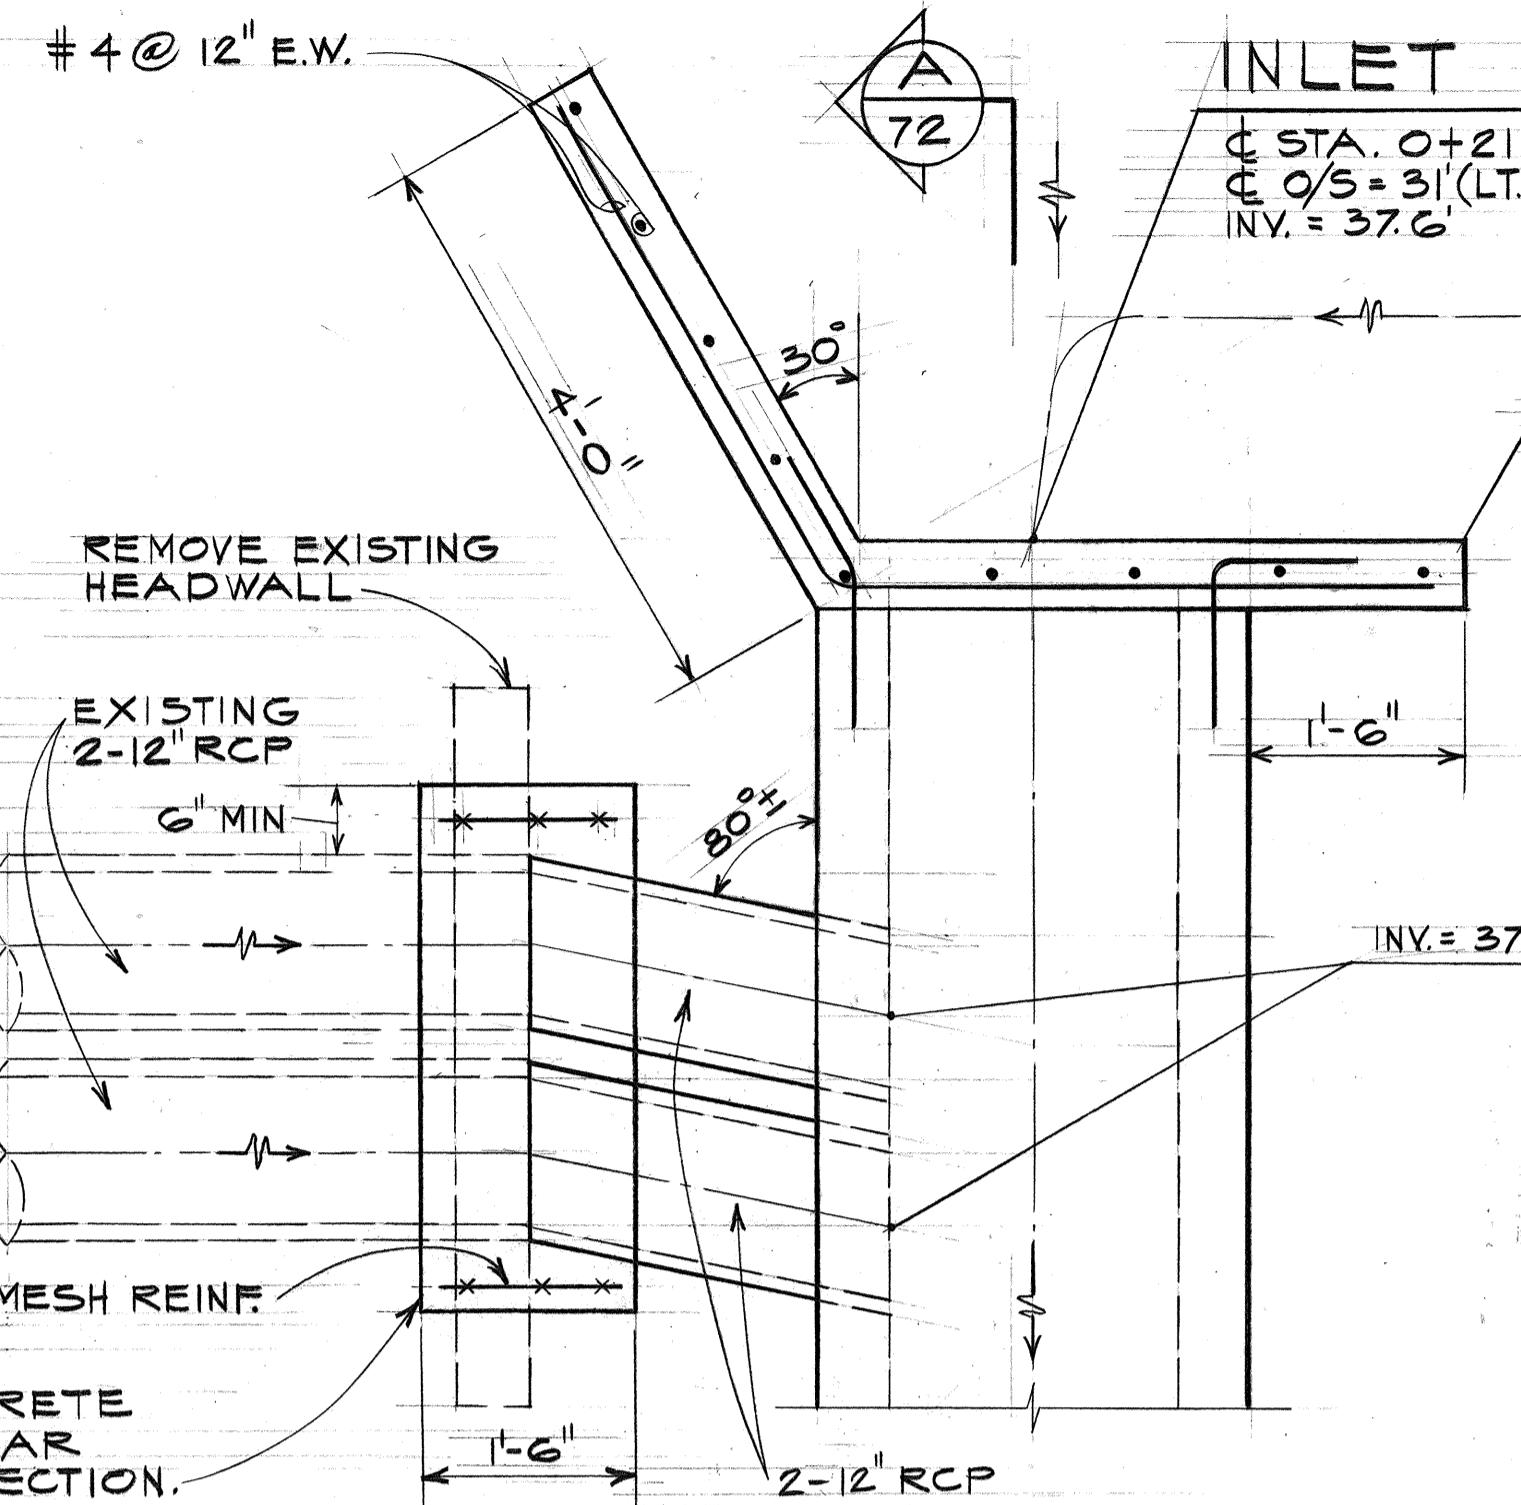


SECTION A
72

INLET
SCALE: $\frac{3}{4}'' = 1'-0''$

OUTLET

STEWART AVE EXTENSION
STA. 0+18
O/S 39' (RT.)
INV. = 36.9'

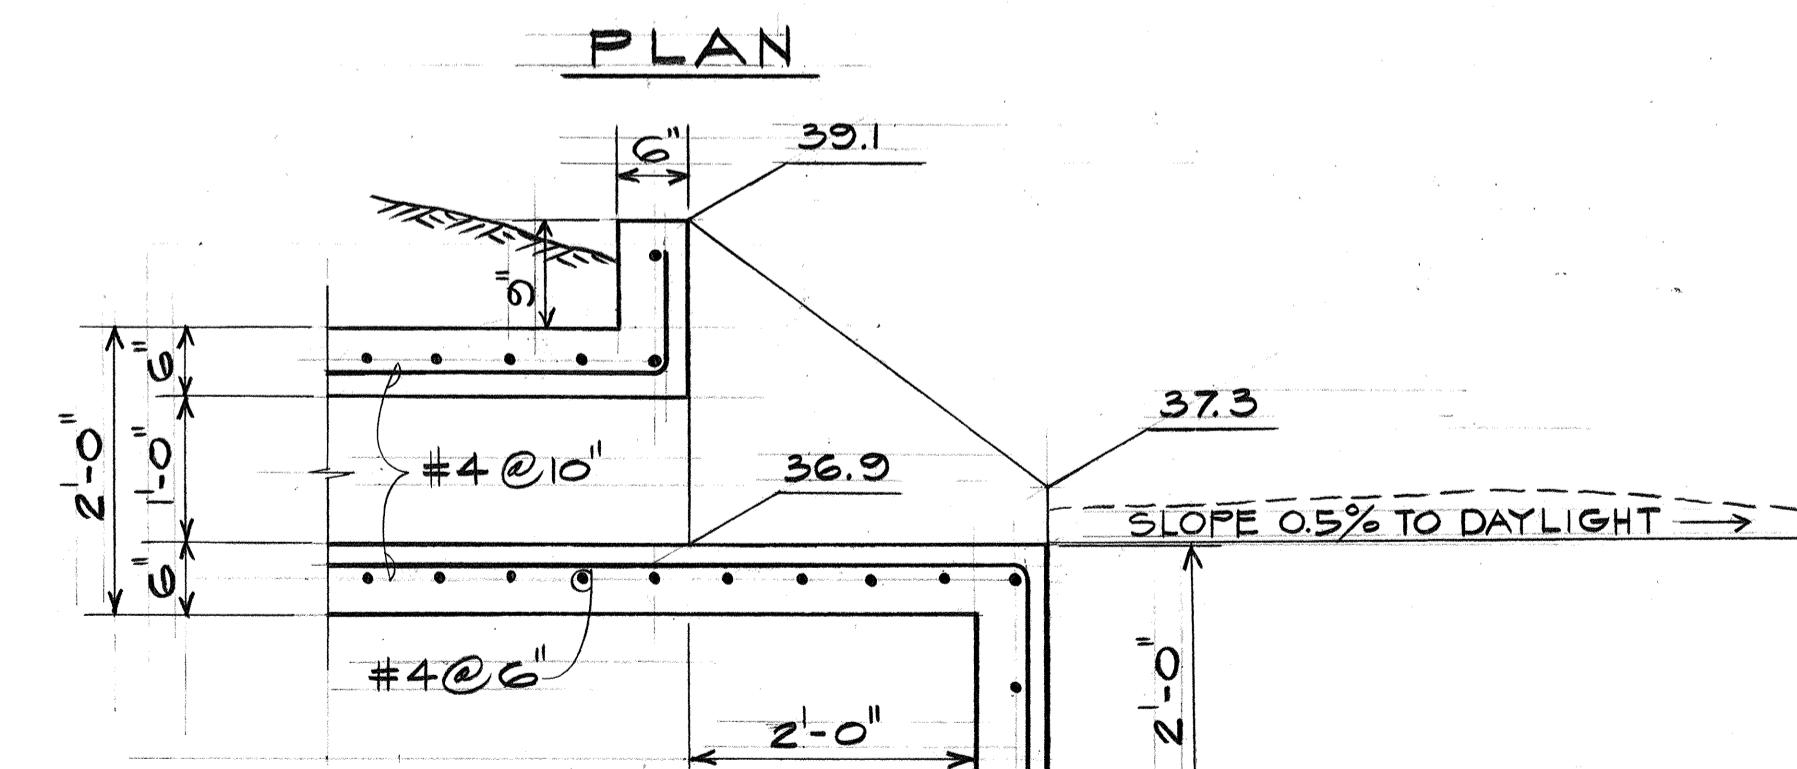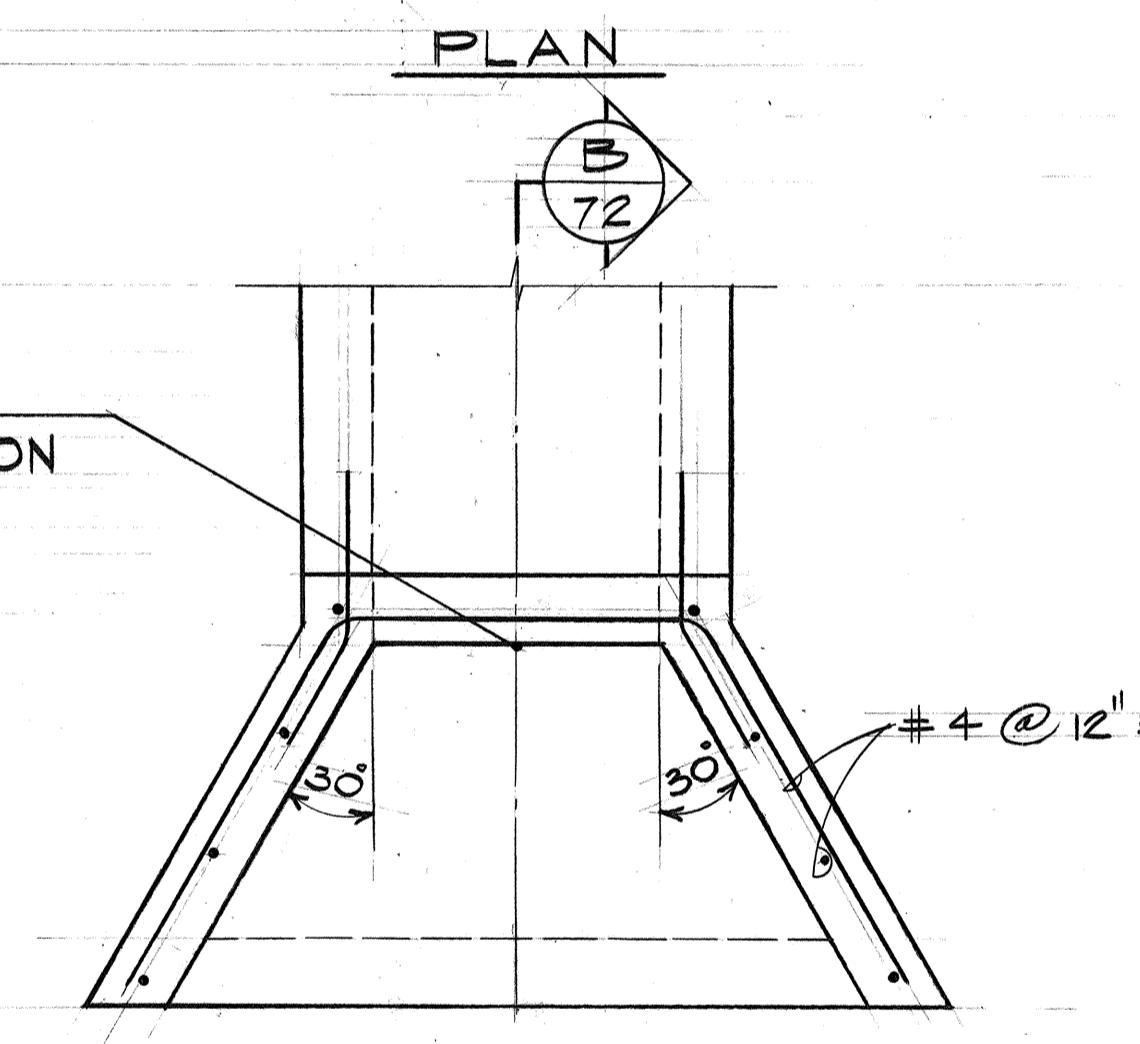

SECTION B
72

OUTLET
SCALE: $\frac{3}{4}'' = 1'-0''$



STATE OF HAWAII
DEPARTMENT OF TRANSPORTATION
HIGHWAYS DIVISION


DRAINAGE DETAILS
(STEWART AVE. BOX CULVERT)

PEARL HARBOR INTERCHANGE
F.A.I. Proj. No. I-HI-1(73):15

Wilbert T. Ichimura
THIS WORK WAS PREPARED BY ME
OR UNDER MY SUPERVISION

Scale: As Shown Date: DEC. 7, 1973
SHEET NO. 6 OF 17 SHEETS

FED. ROAD DIST. NO.	STATE	FED. AID PROJ. NO.	FISCAL YEAR	SHEET NO.	TOTAL SHEETS
HAWAII	HAW.	I-HI-1(73)15	1074	72 S-1	300

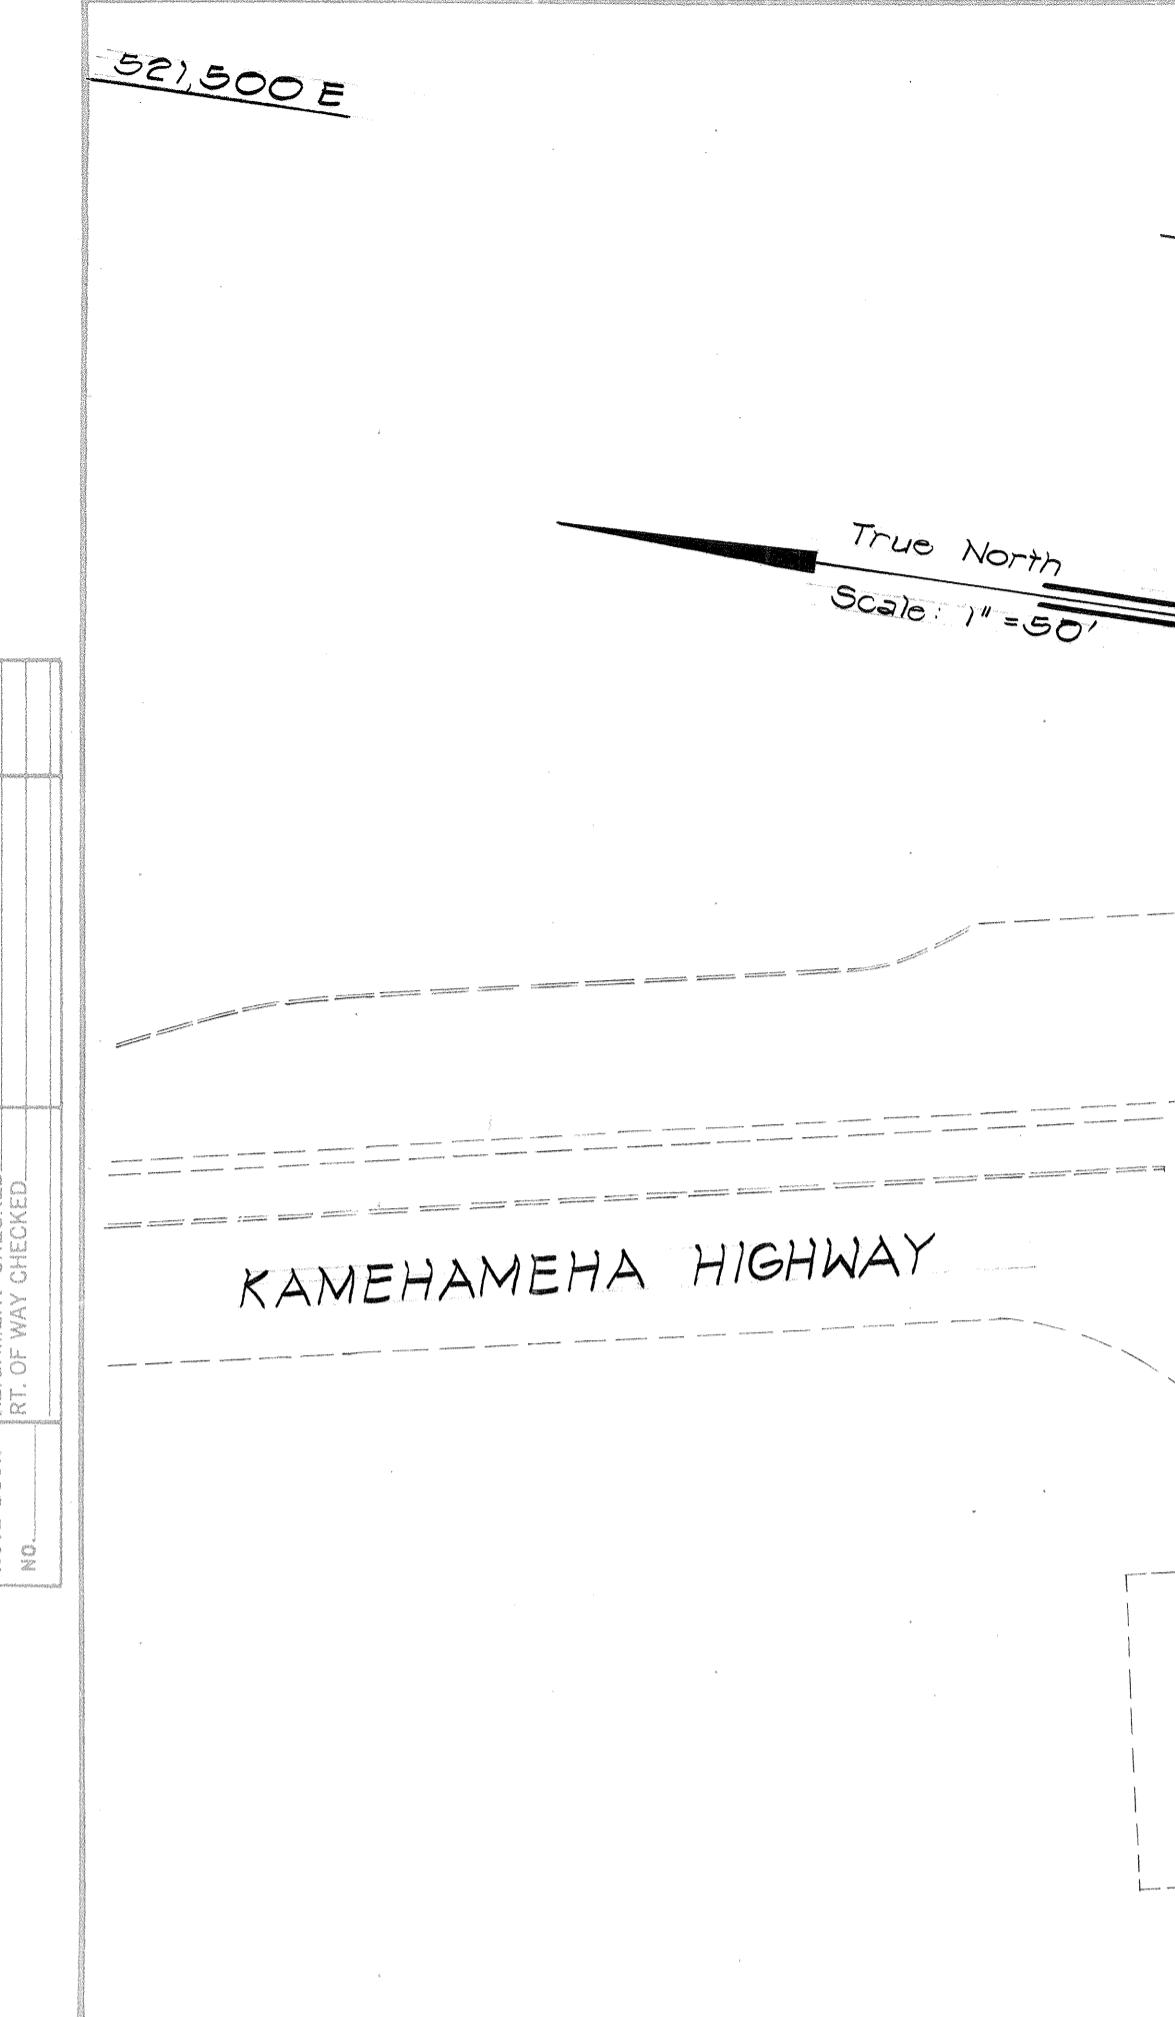


KAMEHAMEHA HIGHWAY

2½" Asphalt Concrete Mix V
6" Aggregate Base
6" Aggregate Subbase

TYPICAL DETOUR ROAD
Scale: 1/8" = 1'-0"


PROFILE SURVEYED
PLOTTED
GRADES CHECKED
B.M.s NOTED
STRUCTURE NOTATED CHKO

PLAN SURVEYED
NOTE BOOK
ALIGNMENT CHECKED
RL OF WAY CHECKED

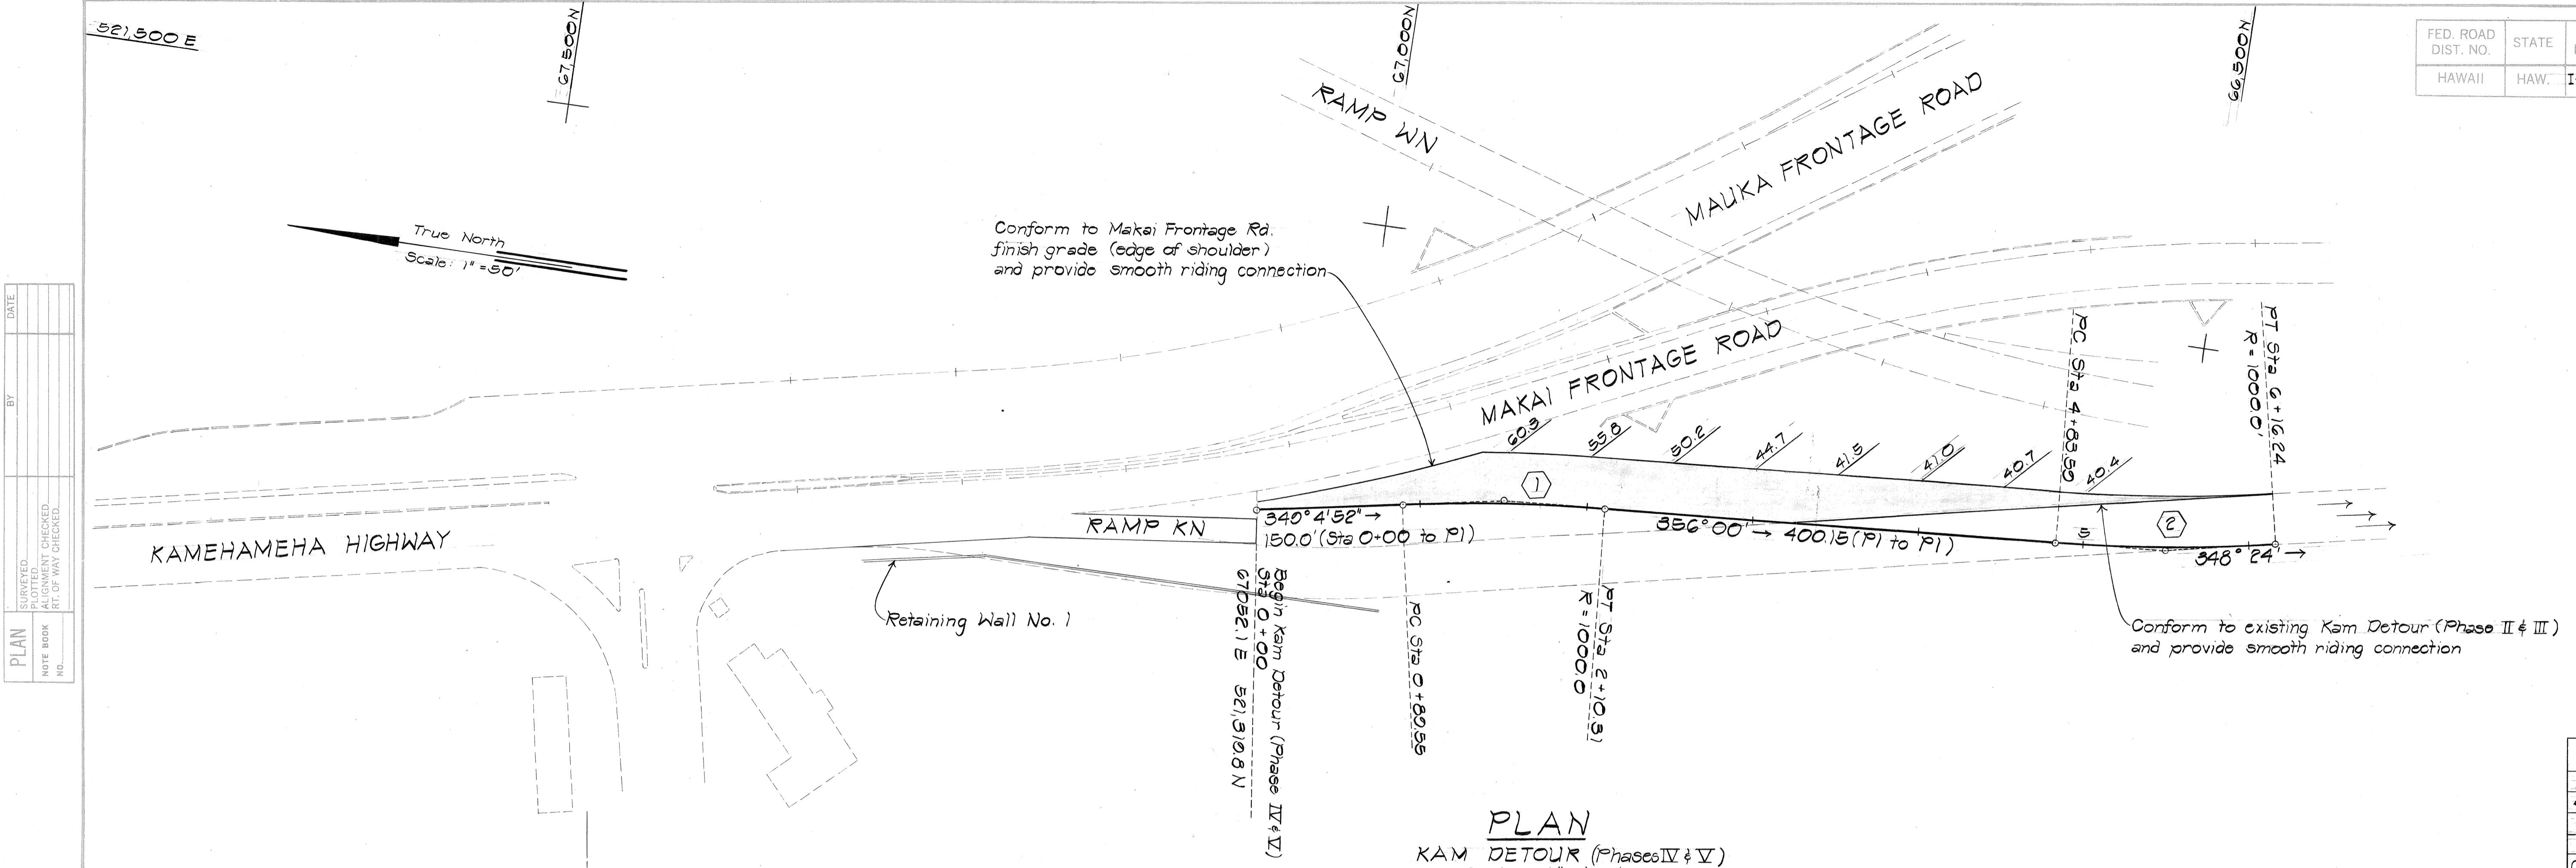



PLAN
KAM DETOUR (Phases IV & V)
Scale: 1" = 50'

CURVE DATA	
(1)	(2)
Δ 6° 55' 0"	7° 24' 00"
4/2 3° 27' 34"	3° 36' 00"
R 1000.00	1000.00
T 60.45	66.42
Ch 120.68	132.85
Lc 120.76	132.65

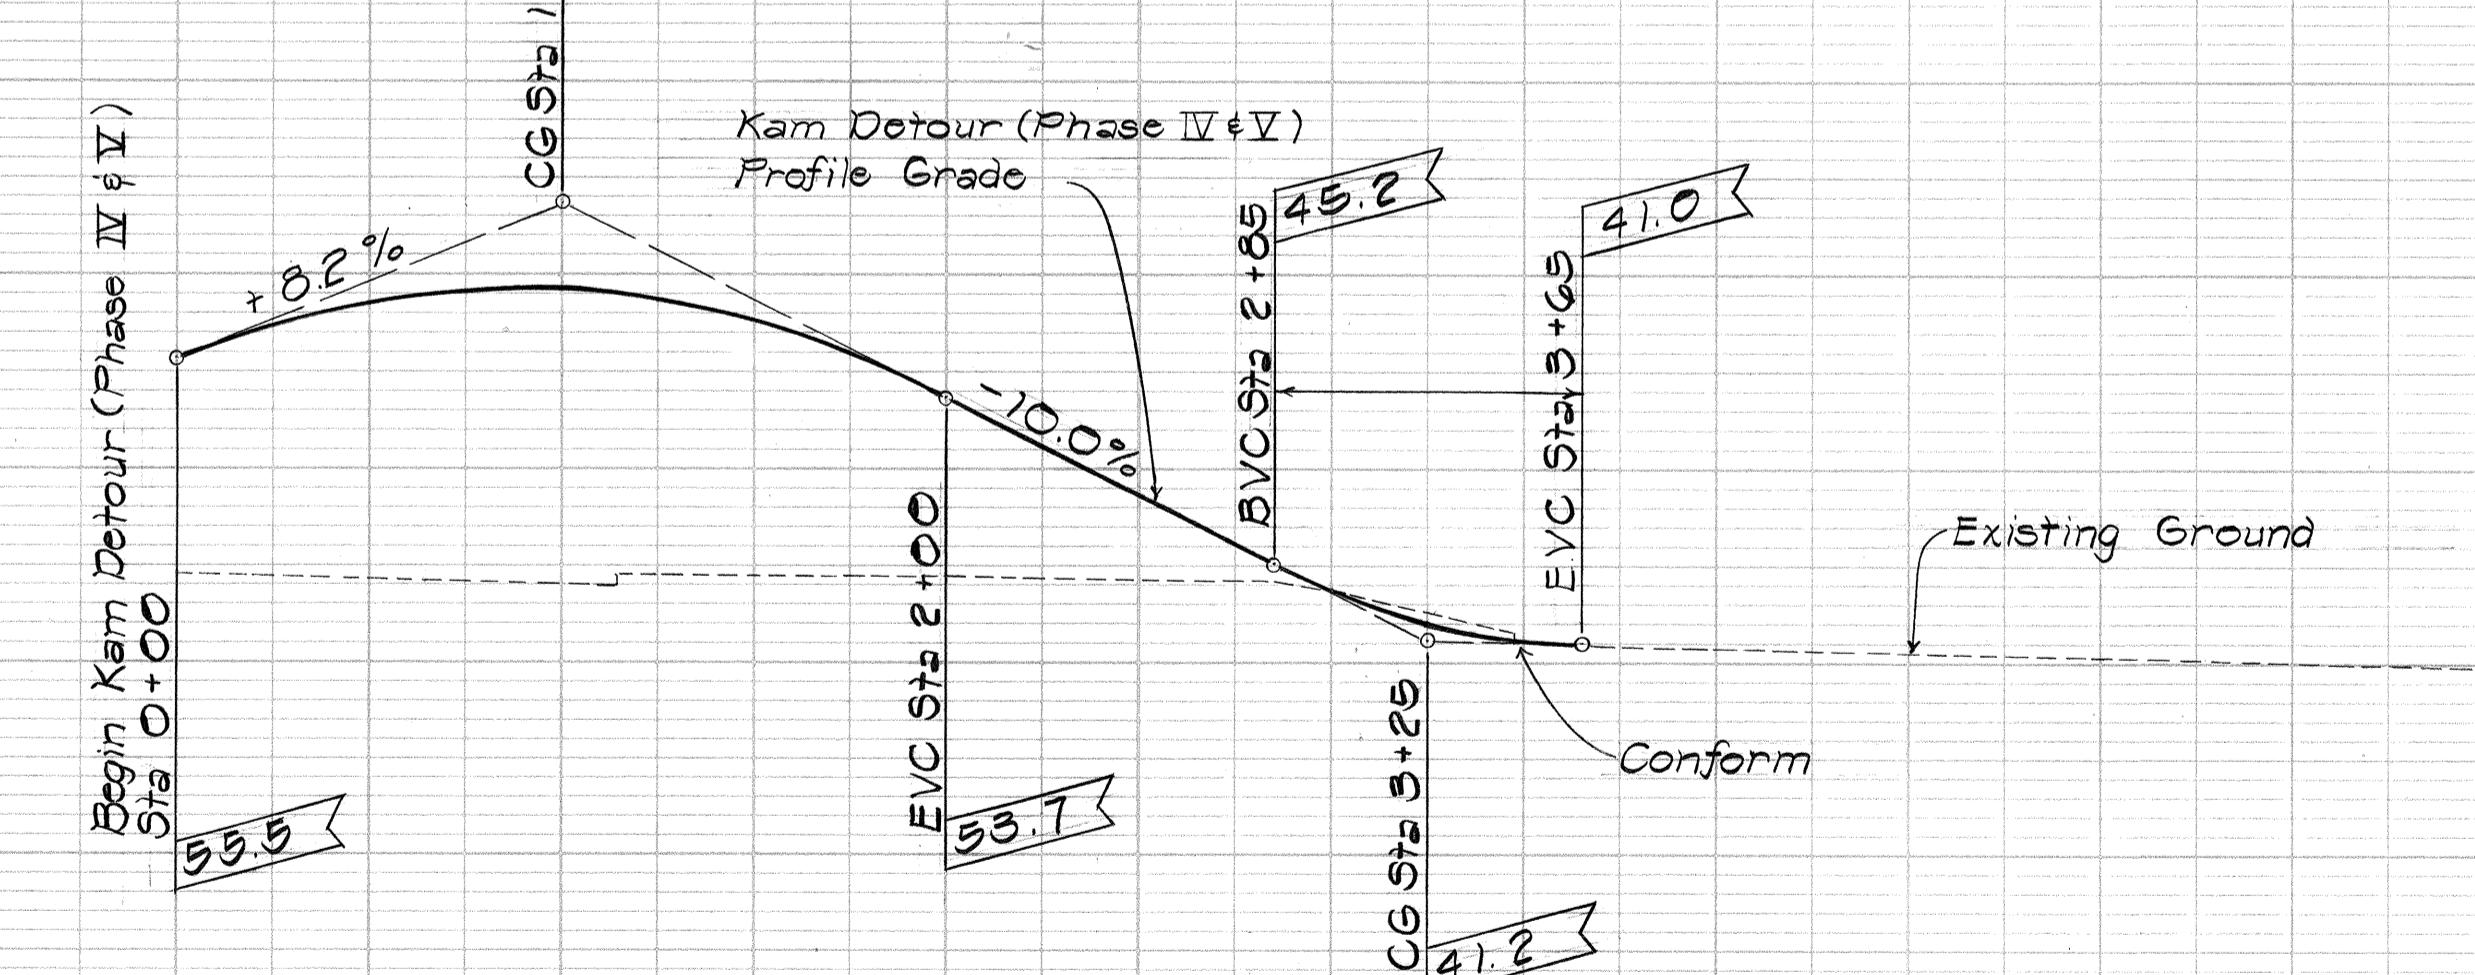

PROFILE
Scale: Horiz. 1" = 50'
Vert. 1" = 10'

0+00 1 2 3 4 5+00 6

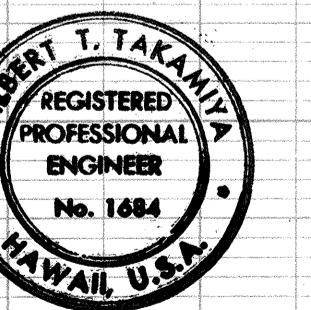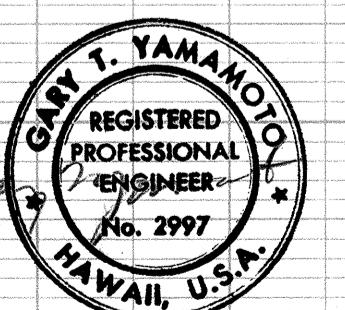

Wilbert T. Takahama
THIS WORK WAS PREPARED BY ME
OR UNDER MY SUPERVISION


C.O. 72 S-1

FED. ROAD DIST. NO.	STATE	FED. AID PROJ. NO.	FISCAL YEAR	SHEET NO.	TOTAL SHEETS
HAWAII	HAW.	I-HI-1(73):15	1974	73	369


SCHEDULE OF ROADWAY GUTTERS & CURBS

LOCATION	ITEM NO.	609 190	609 193	609 195	609 200	609 230	609 241	609 24
		4 GUTTER 6 GUTTER	6 GUTTER 6 GUTTER	628 GUTTER 6 GUTTER	CURB TYPE 2A CURB TYPE 1	GUTTER TYPE 2G GUTTER TYPE 1	CURB & GUTTER TYPE 2AGM CURB & GUTTER TYPE 1	CURB & GUTTER CURB & GUTTER
		LF	LF	LF	LF	LF	LF	LF
H-1 OUTBOUND (92+00 TO 92+50 LT.)				50				
H-1 OUTBOUND (92+50 TO 93+50 LT.)		100	TRANSITION					
H-1 OUTBOUND (93+50 TO 96+75 LT.)		325						
H-1 OUTBOUND (102+20 TO 109+50 LT.)		730						
MAKAI F.R. (14+05 TO 19+00 RT.)		495						
MAKAI F.R. (20+00 TO 26+25 LT.)		625						
MAKAI F.R. (28+45 TO 34+00 LT.)		555						
MAKAI F.R. (34+00 TO 34+50 LT.)			50 TRANSITION					
MAKAI F.R. (34+50 TO 41+30 LT.)				680				
MAKAI F.R. (41+30 TO 41+50 LT.)				20 TRANSITION				
MAKAI F.R. (30+45 TO 35+50 RT.)		505						
RAMP EK (1+70 TO 2+60 RT.)		90						
RAMP EK (3+00 TO 9+75 LT.)		695						
RAMP WS (0+00 TO 0+55 LT.)				55				
RAMP WS (0+55 TO 1+05 LT.)				50 TRANSITION				
RAMP WS (1+05 TO 7+50 LT.)		645						
RAMP KN (2+00 TO 8+40 LT.)		640						
RAMP KN (9+50 RT.) TO RAMP WN (34+00 RT.)		1467						
RAMP WN (34+00 TO 34+50 RT.)			50 TRANSITION					
RAMP WN (34+50 RT.) TO RAMP EN (0+30 LT.)				443				
RAMP WN (16+63.87 TO 17+50 RT.)				86				
RAMP EN (6+50 TO 11+50 LT.)			500					
RAMP EN (11+50 TO 12+00 LT.)			50 TRANSITION					
RAMP EN (12+00 TO 13+50 LT.)				150				
RAMP EN (13+50 LT.) TO RAMP MN (0+00 LT.)		53	TRANSITION					
RAMP EN (11+50 TO 23+85 RT.)				1235				
RAMP EN (23+85 TO 24+35 RT.)			50 TRANSITION					
RAMP EN (24+35 TO 26+50 RT.)		215						
RAMP EN (21+10 TO 26+25 LT.)		515						
RAMP MN (0+00 TO 3+00 LT.)					300			
RAMP MN (3+00 TO 3+50 LT.)			50 TRANSITION					
RAMP MN (3+50 TO 5+50 LT.)				200				
RAMP MN (5+50 TO 6+00 LT.)			50 TRANSITION					
RAMP MN (6+00 TO 8+00 LT.)		200						
RAMP MN (3+50 TO 7+00 RT.)				350				
RAMP MN (7+00 TO 7+50 RT.)			50 TRANSITION					
RAMP MN (7+50 RT.) TO MAKAI F.R. (38+50 RT.)				564				
RAMP NW (42+35 TO 50+75 RT.)		830						
RAMP NS (0+98 RT.) TO RAMP NS (2+45 RT.)		147						
RAMP NS (9+35 TO 14+70 RT.)		535						
RAMP NS (3+00 TO 6+50 LT.)		350						
RAMP NS (6+50 TO 7+00 LT.)			50 TRANSITION					
RAMP NS (7+00 TO 11+75 LT.)				475				
RAMP NE (3+00 TO 7+50 LT.)		450						
RAMP NE (5+50 TO 8+05 RT.)		255						
VALKENBURGH (11+72.64 RT.) TO MAKAI F.R. (41+50 LT.)					379			
MAUKA F.R. (39+88.88 RT.) TO MAKAI F.R. (44+40.24 LT.)					423			
VALKENBURGH (14+92 TO 23+44.41 LT.)						968		
VALKENBURGH (14+98 TO 23+44.41 LT.)						950		
VALKENBURGH/MAKAI TRAFFIC ISLAND □					31			
SUB-TOTAL		10,269	850	3938	31	300	802	1918

ITEM NO.	609 190	609 193	609 195	609 200	609 230	609 241	609 246	609 20
LOCATION	61614 GUTTER	61616 GUTTER	61218 GUTTER	CURB TYPE 2A	GUTTER TYPE 2G	CURB # GUTTER TYPE 2AGM	CURB \$ GUTTER TYPE 2DG	CURB
	LF	LF	LF	LF	LF	LF	LF	LF
TRANSITIONS (61616 TO 61218) = 100'		50	50					
(61614 TO 61218) = 400'	200		200					
(TYPE 2G TO 61218) = 103'			52		51			
(TYPE 2AGM TO 61218) = 20'			10		10			
STEWART AVE. EXTENSION					110			78
TOTAL	10,469	900	4280	31	461	812	1918	78

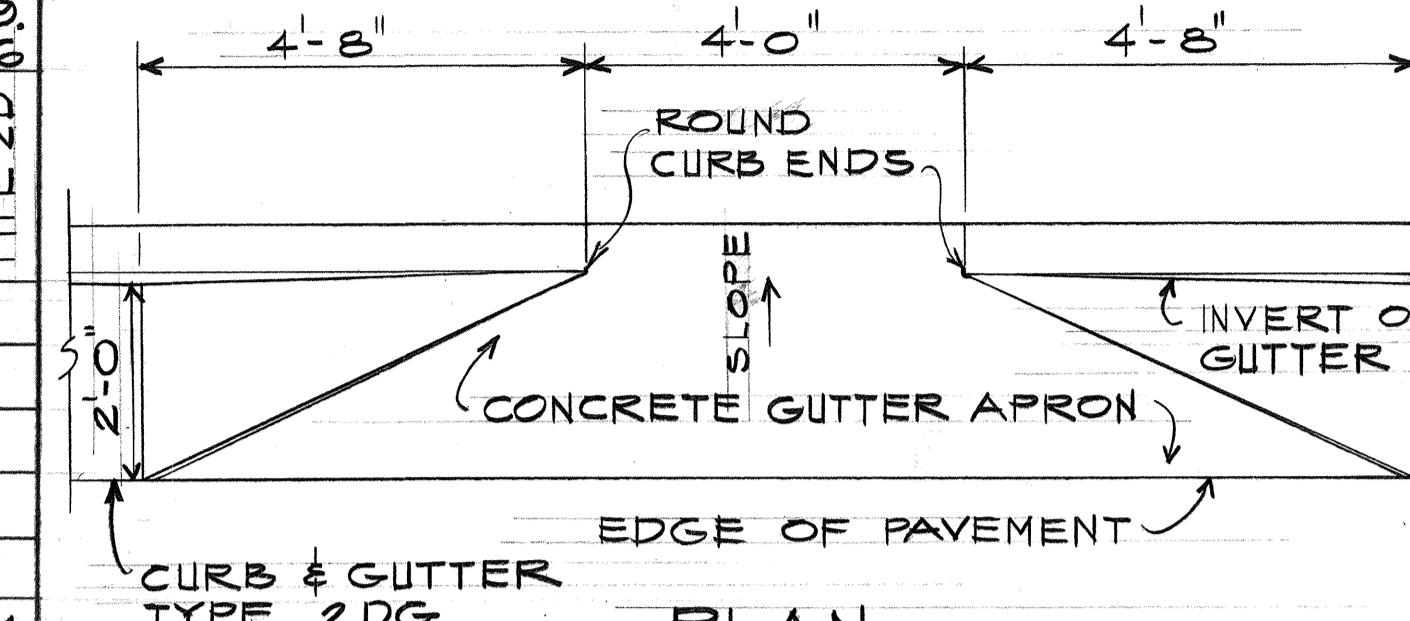


PLAN

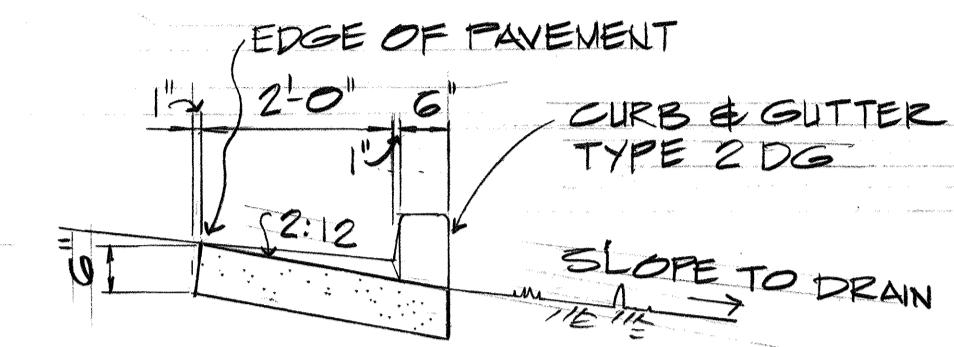


SECTION

TYPICAL CURB OPENING


SCALE: $1/2'' = 1'-0$

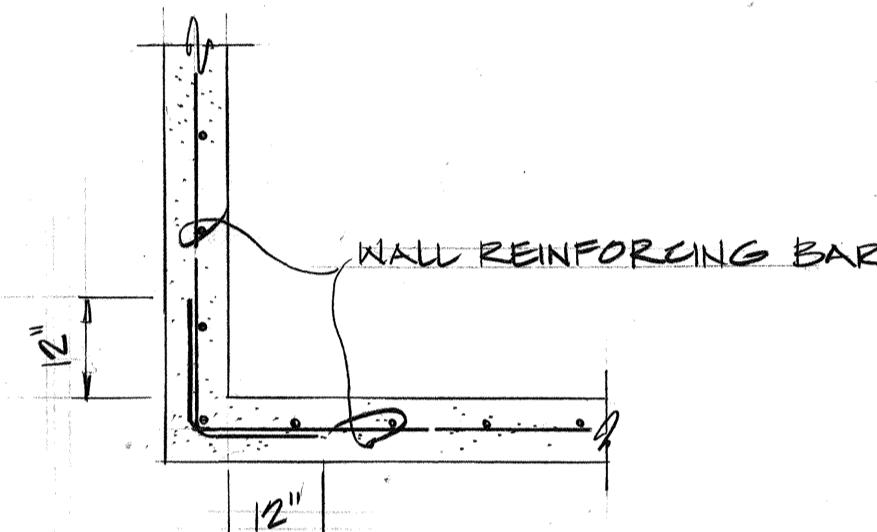

PLA

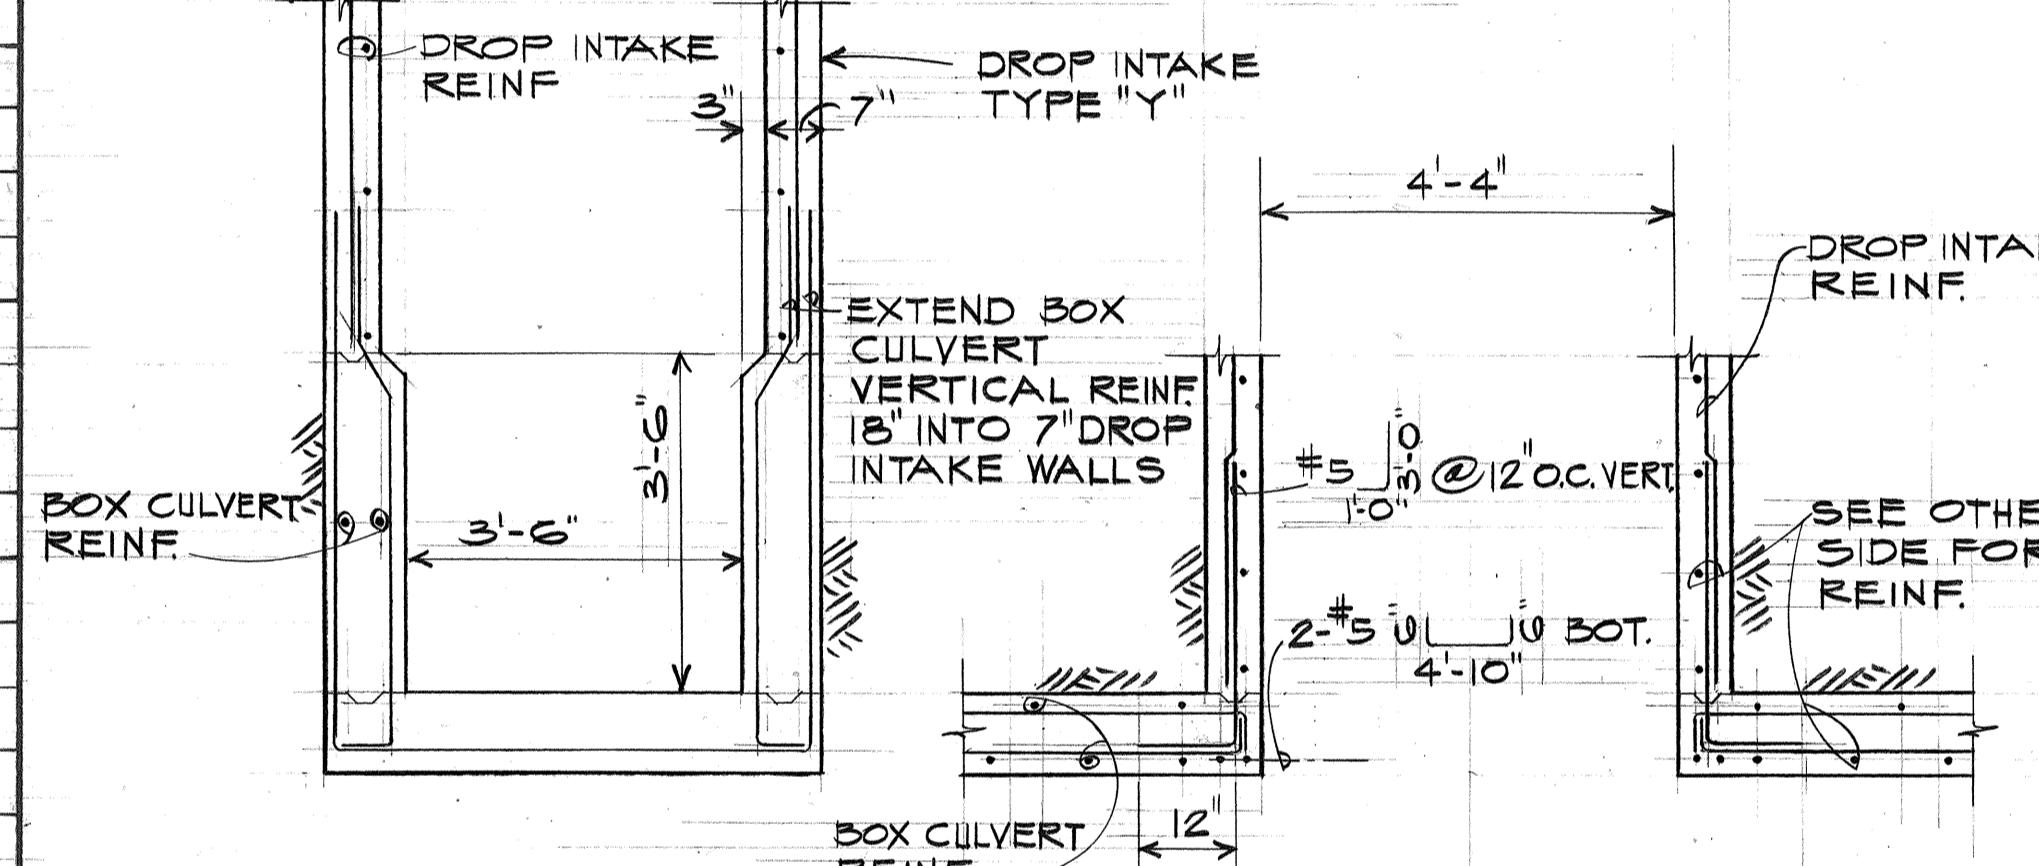

SECTION

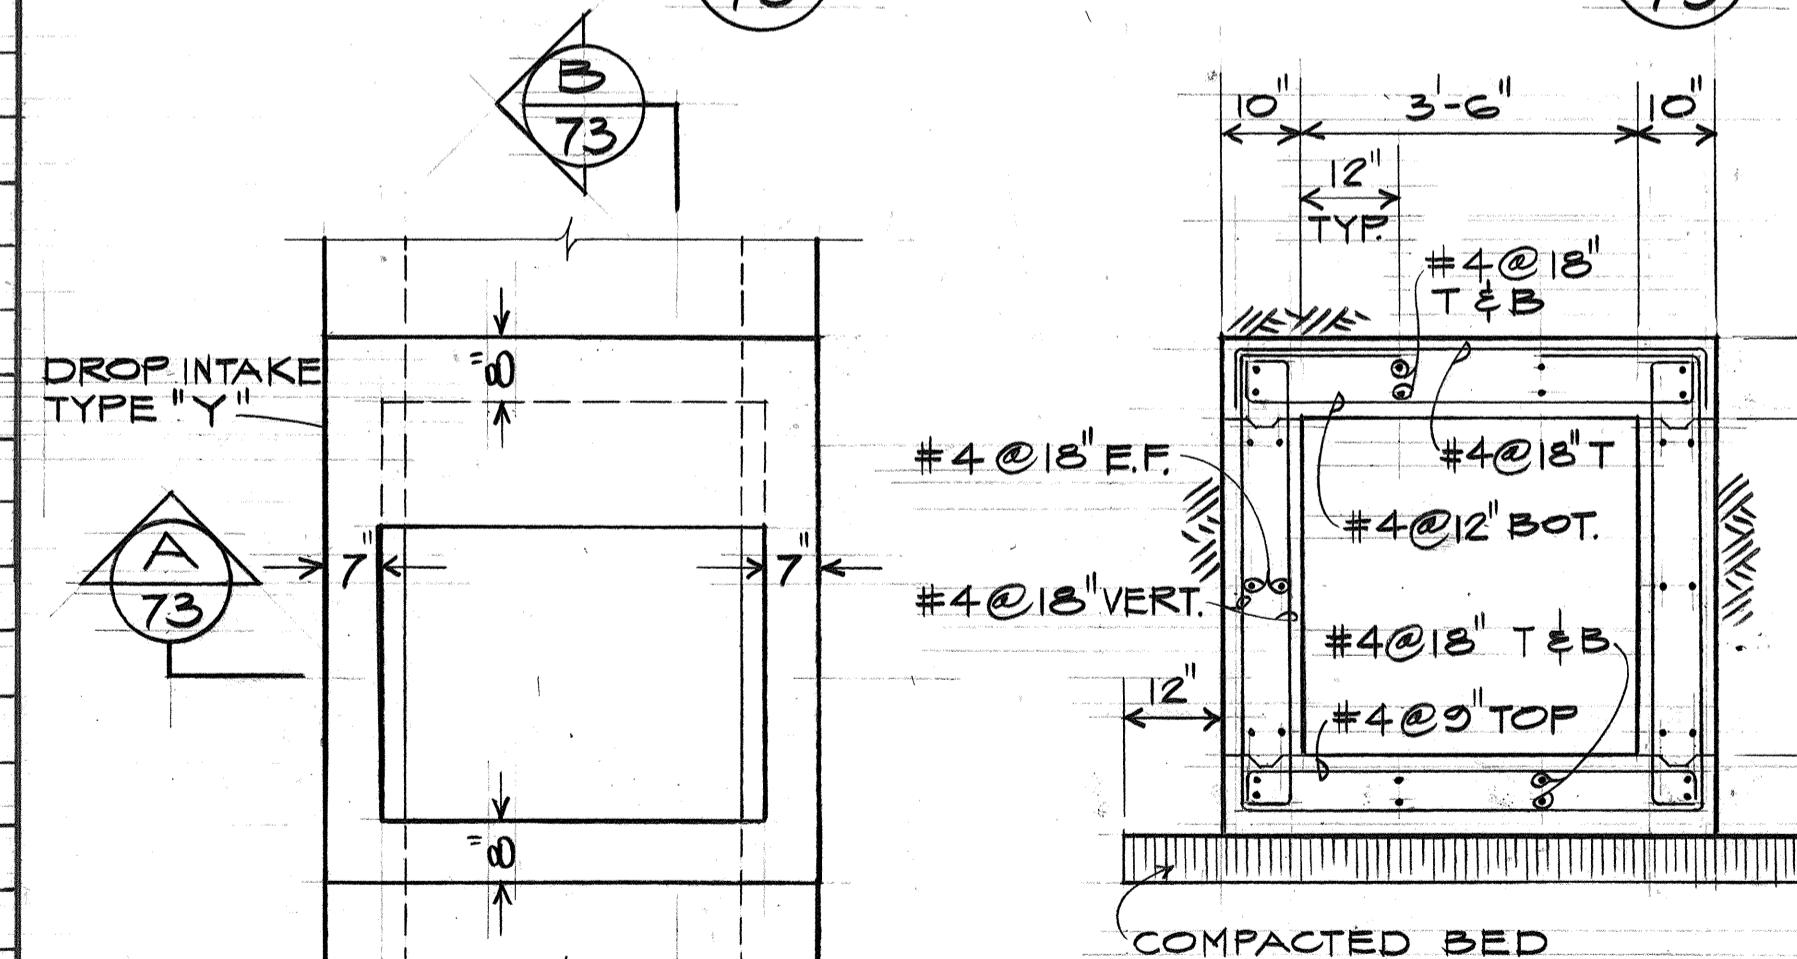

PIANE



SCADA E-1/2"

9/3/75, REVISE 61218 GUTTER LENGTH

4 2674 ADDED RCB DETAIL

DATE **REVISION**

卷之三

10. The following table shows the number of hours worked by 1000 employees in a company.

A circular registration stamp with the following text:

STANLEY YOSHITO UEHARA
REGISTERED PROFESSIONAL ENGINEER
No. 3018
HAWAII, U.S.A.

A circular metal stamp with a double-lined border. The outer ring contains the name "WILBERT T. TAKAMIYA" in capital letters. The inner circle contains the text "REGISTERED PROFESSIONAL ENGINEER" on the top two lines and "No. 1684" on the bottom line. At the bottom of the inner circle, the words "HAWAII, U.S.A." are stamped.

Wilbert T. Tsukamiya
THIS WORK WAS PREPARED BY ME
OR UNDER MY SUPERVISION


**STATE OF HAWAII
DEPARTMENT OF TRANSPORTATION
HIGHWAYS DIVISION**

DRAINAGE DETAILS


PEARL HARBOR INTERCHANGE
F.A.I. PROJ. NO. I - HI - 1 (73):15

SCALE: AS SHOWN DATE: DEC. 7, 1973
SHEET NO. 7 OF 17 SHEETS

FED. ROAD DIST. NO.	STATE	FED. AID PROJ. NO.	FISCAL YEAR	SHEET NO.	TOTAL SHEETS
HAWAII	HAW.	I-HI-1(73)-15	1974	73 S-1	369

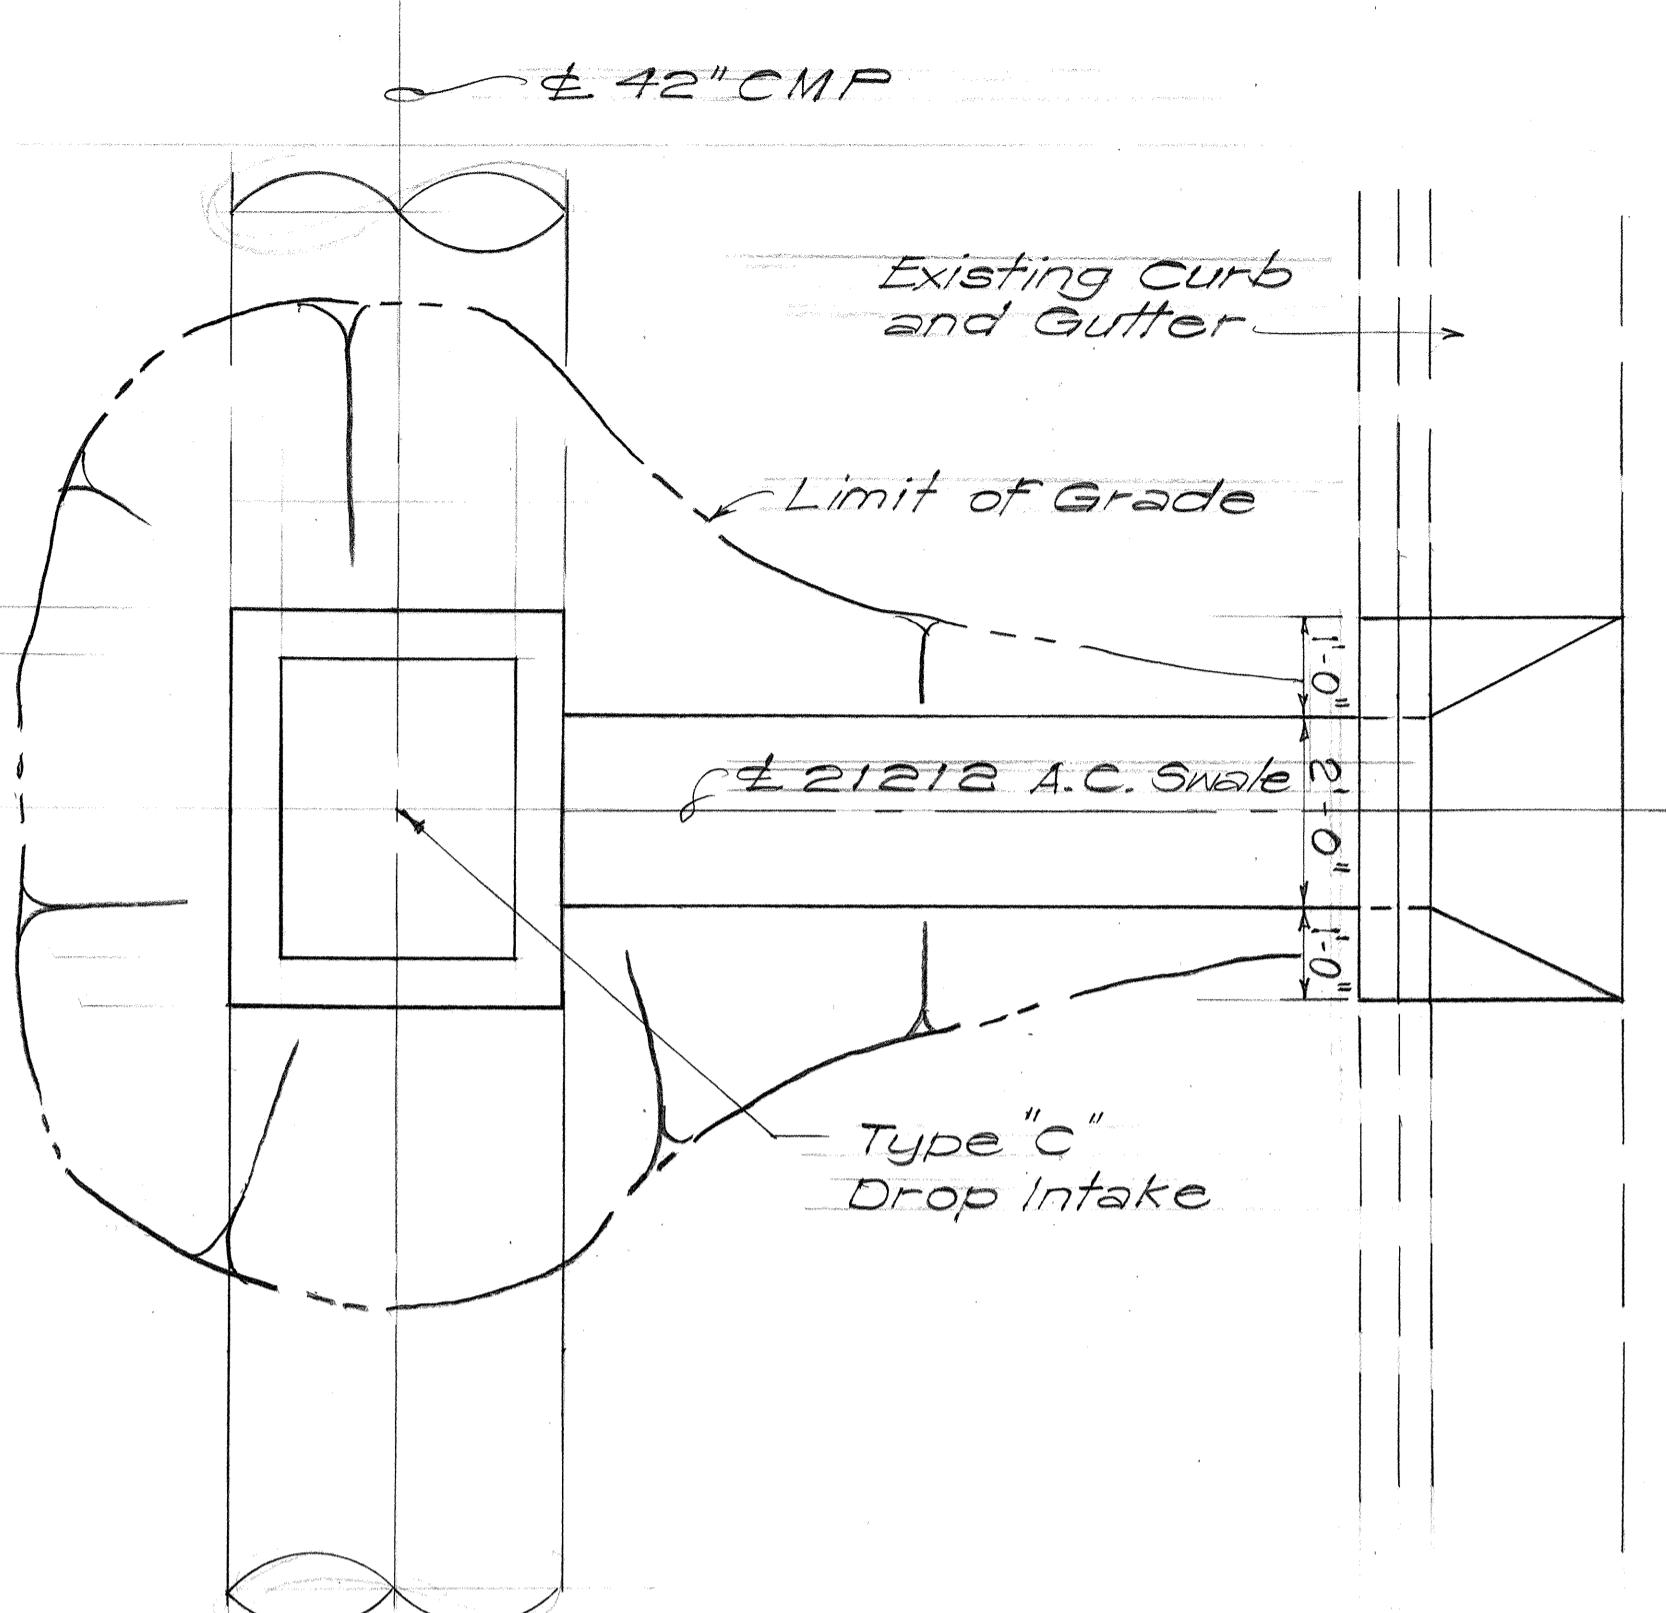


PLAN
Scale: $\frac{1}{12}$ " = 1'-0"

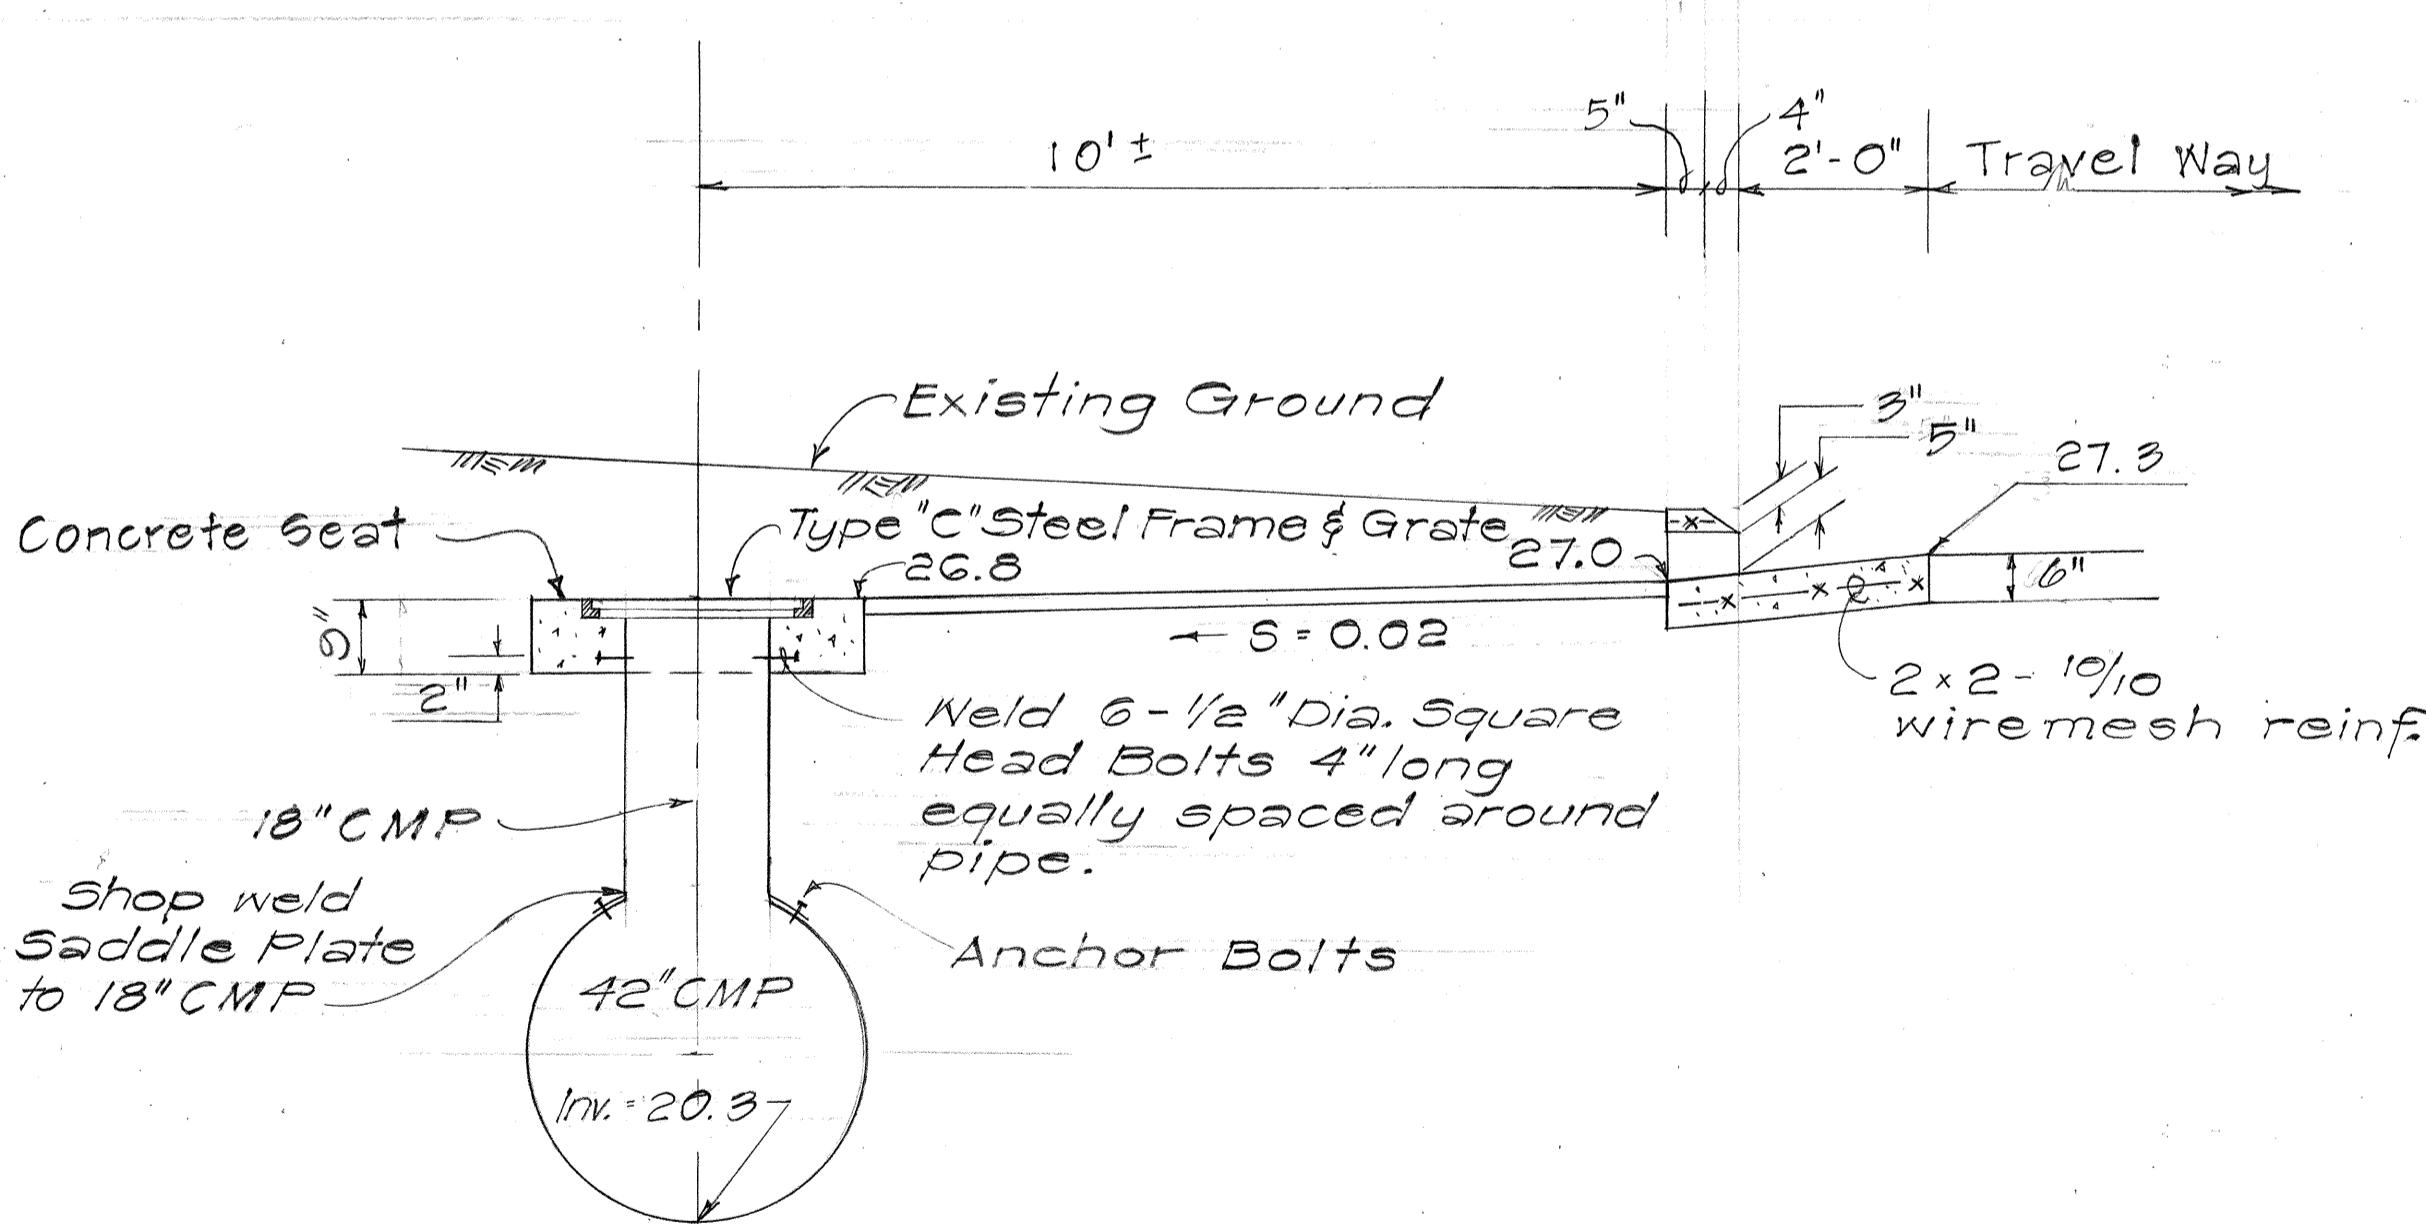


SECTION VIEW
Scale: $\frac{1}{12}$ " = 1'-0"


ORIGINAL PLAN	SURVEY PLOTTED BY
NOTE BOOK	DRAWN BY
No. _____	TRACED BY
QUANTITIES BY	
CHECKED BY	

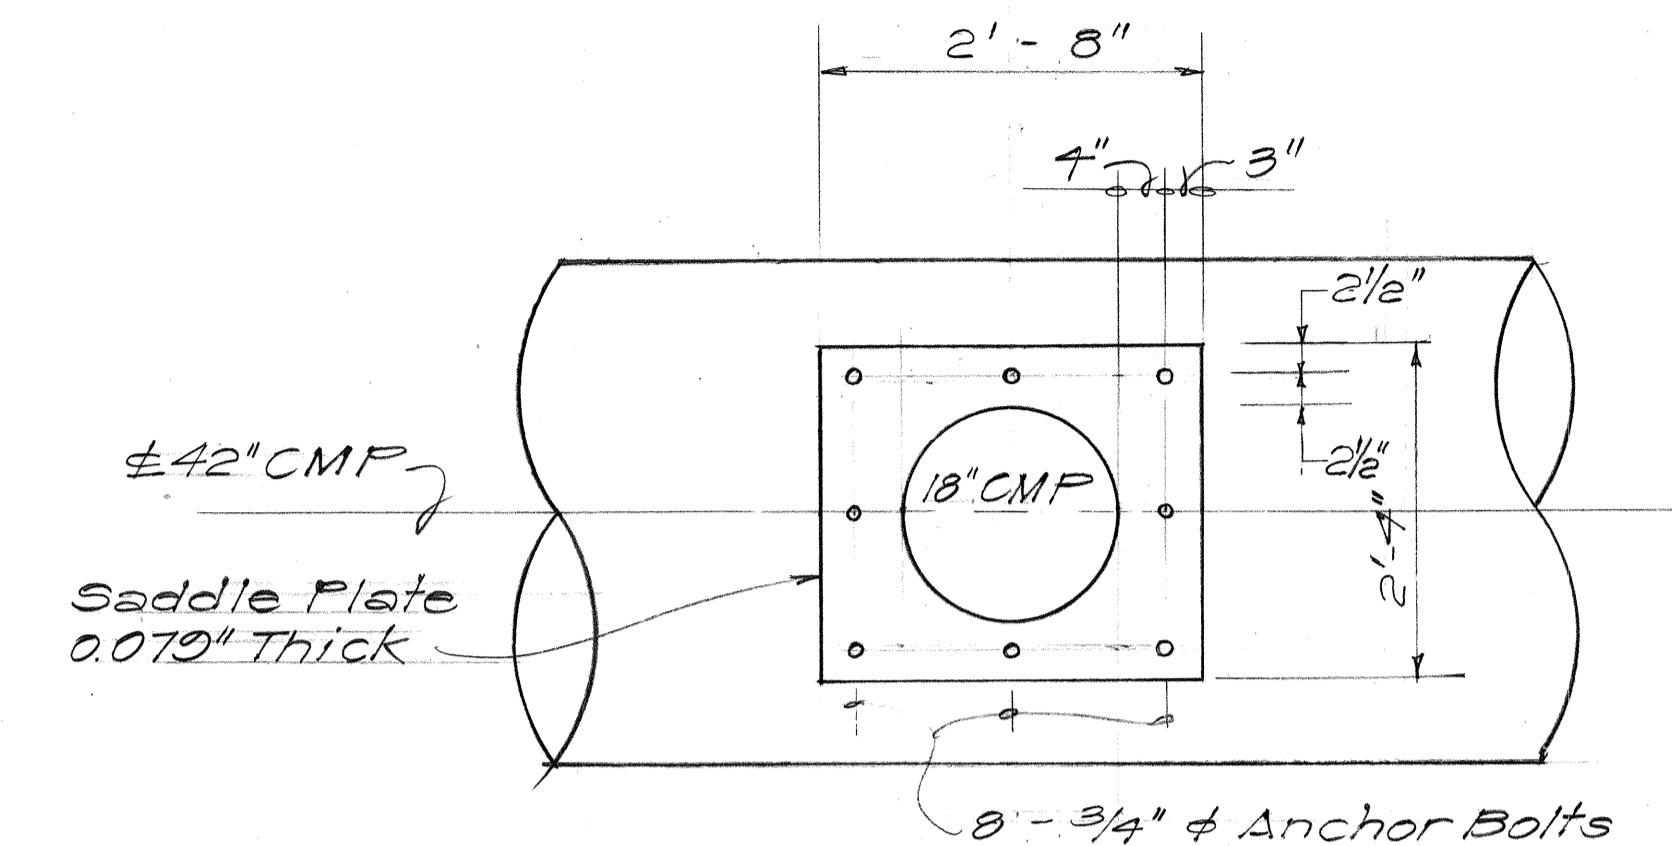

PLAN
SADDLE PLATE
Scale: $\frac{3}{4}$ " = 1'-0"

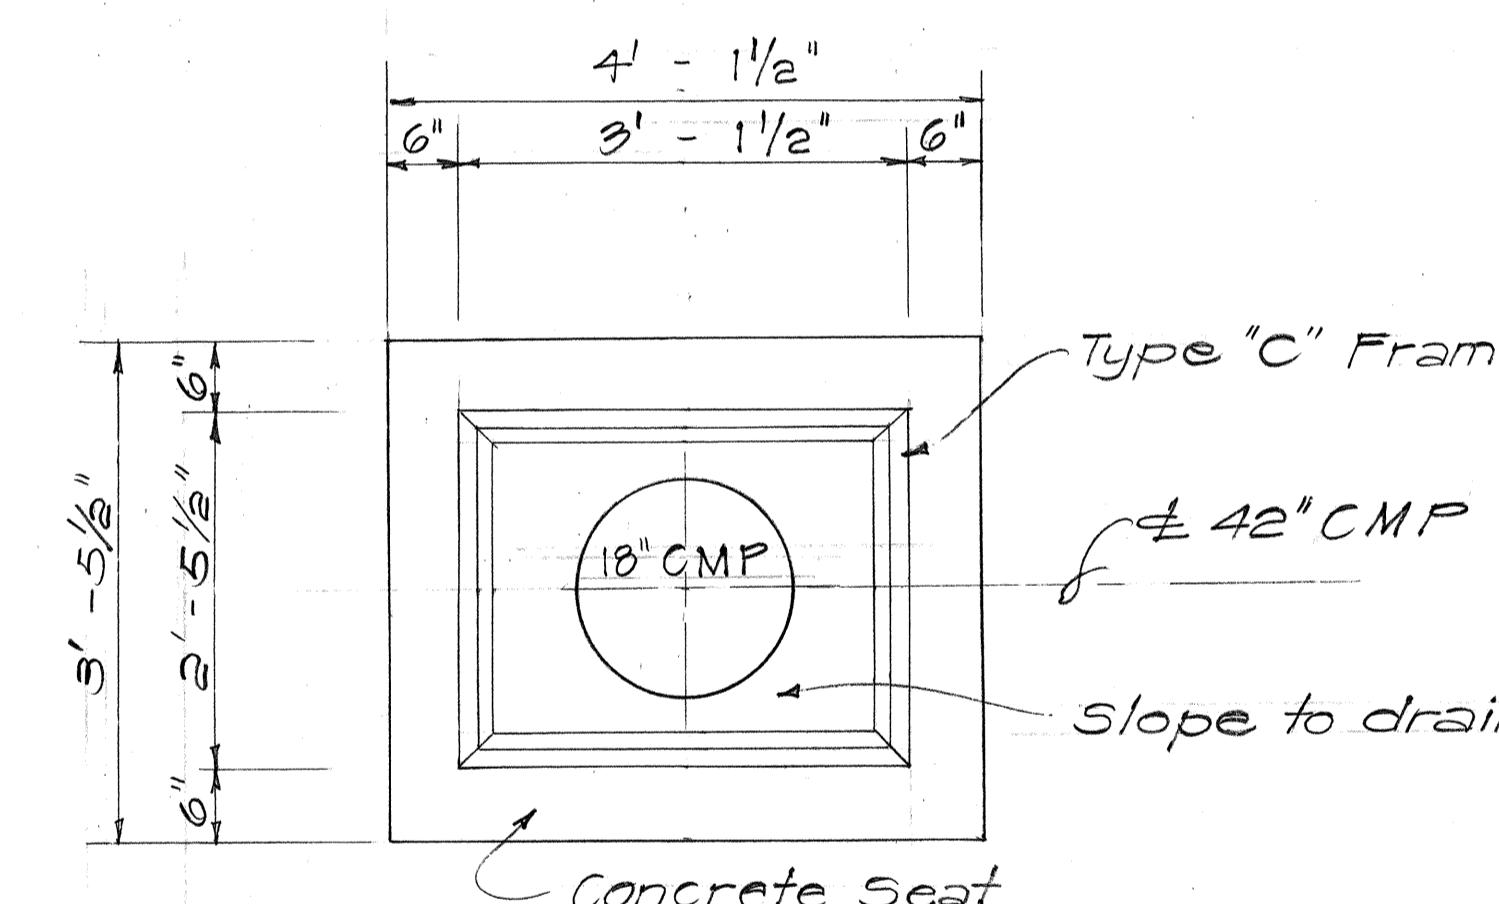

PLAN
CONCRETE SEAT
Scale: $\frac{3}{4}$ " = 1'-0"

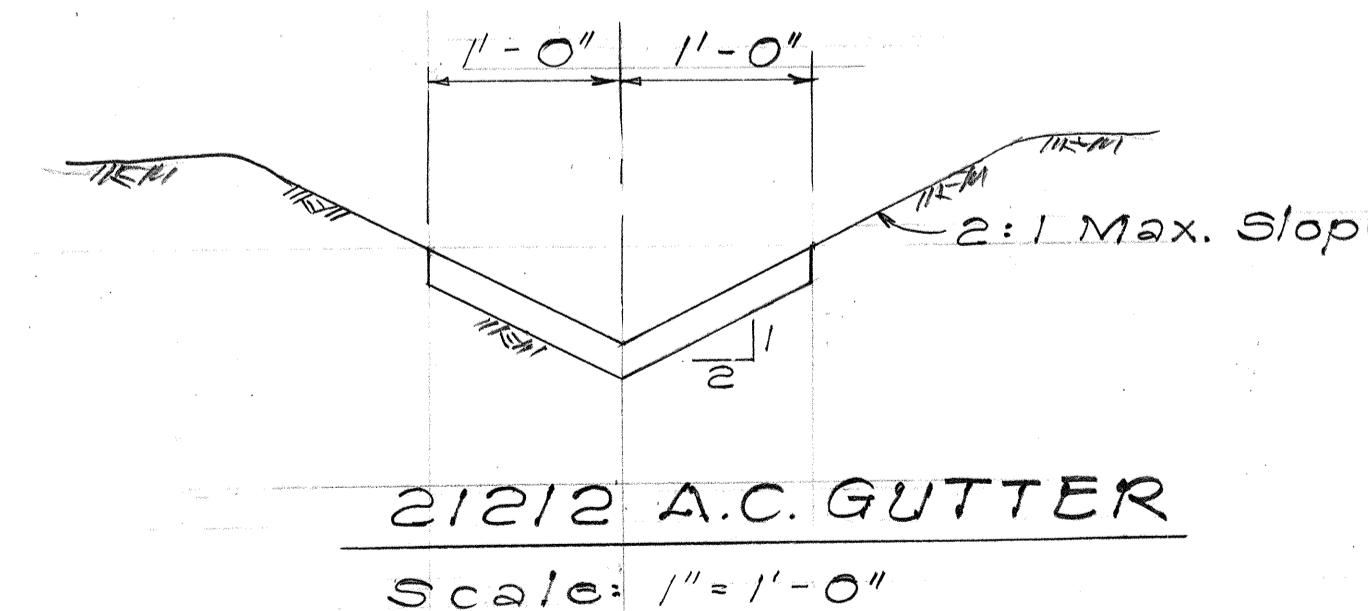

Scale: 1" = 1'-0"


THIS SHEET PREPARED
DURING "AS-BUILT" POSTING

STATE OF HAWAII
DEPARTMENT OF TRANSPORTATION
LAND TRANSPORTATION FACILITIES DIVISION

DRAINAGE DETAILS
DRAIN FROM CURB AND
GUTTER TO CULVERT
PEARL HARBOR INTERCHANGE
F.A.I. PROJ. NO. I-HI-1(73)-15


Scale: As shown
SHEET NO. OF SHEETS

FED. ROAD DIST. NO.	STATE	FED. AID PROJ. NO.	FISCAL YEAR	SHEET NO.	TOTAL SHEETS
HAWAII	HAW.	IHI-1(73)15	1974	74	369

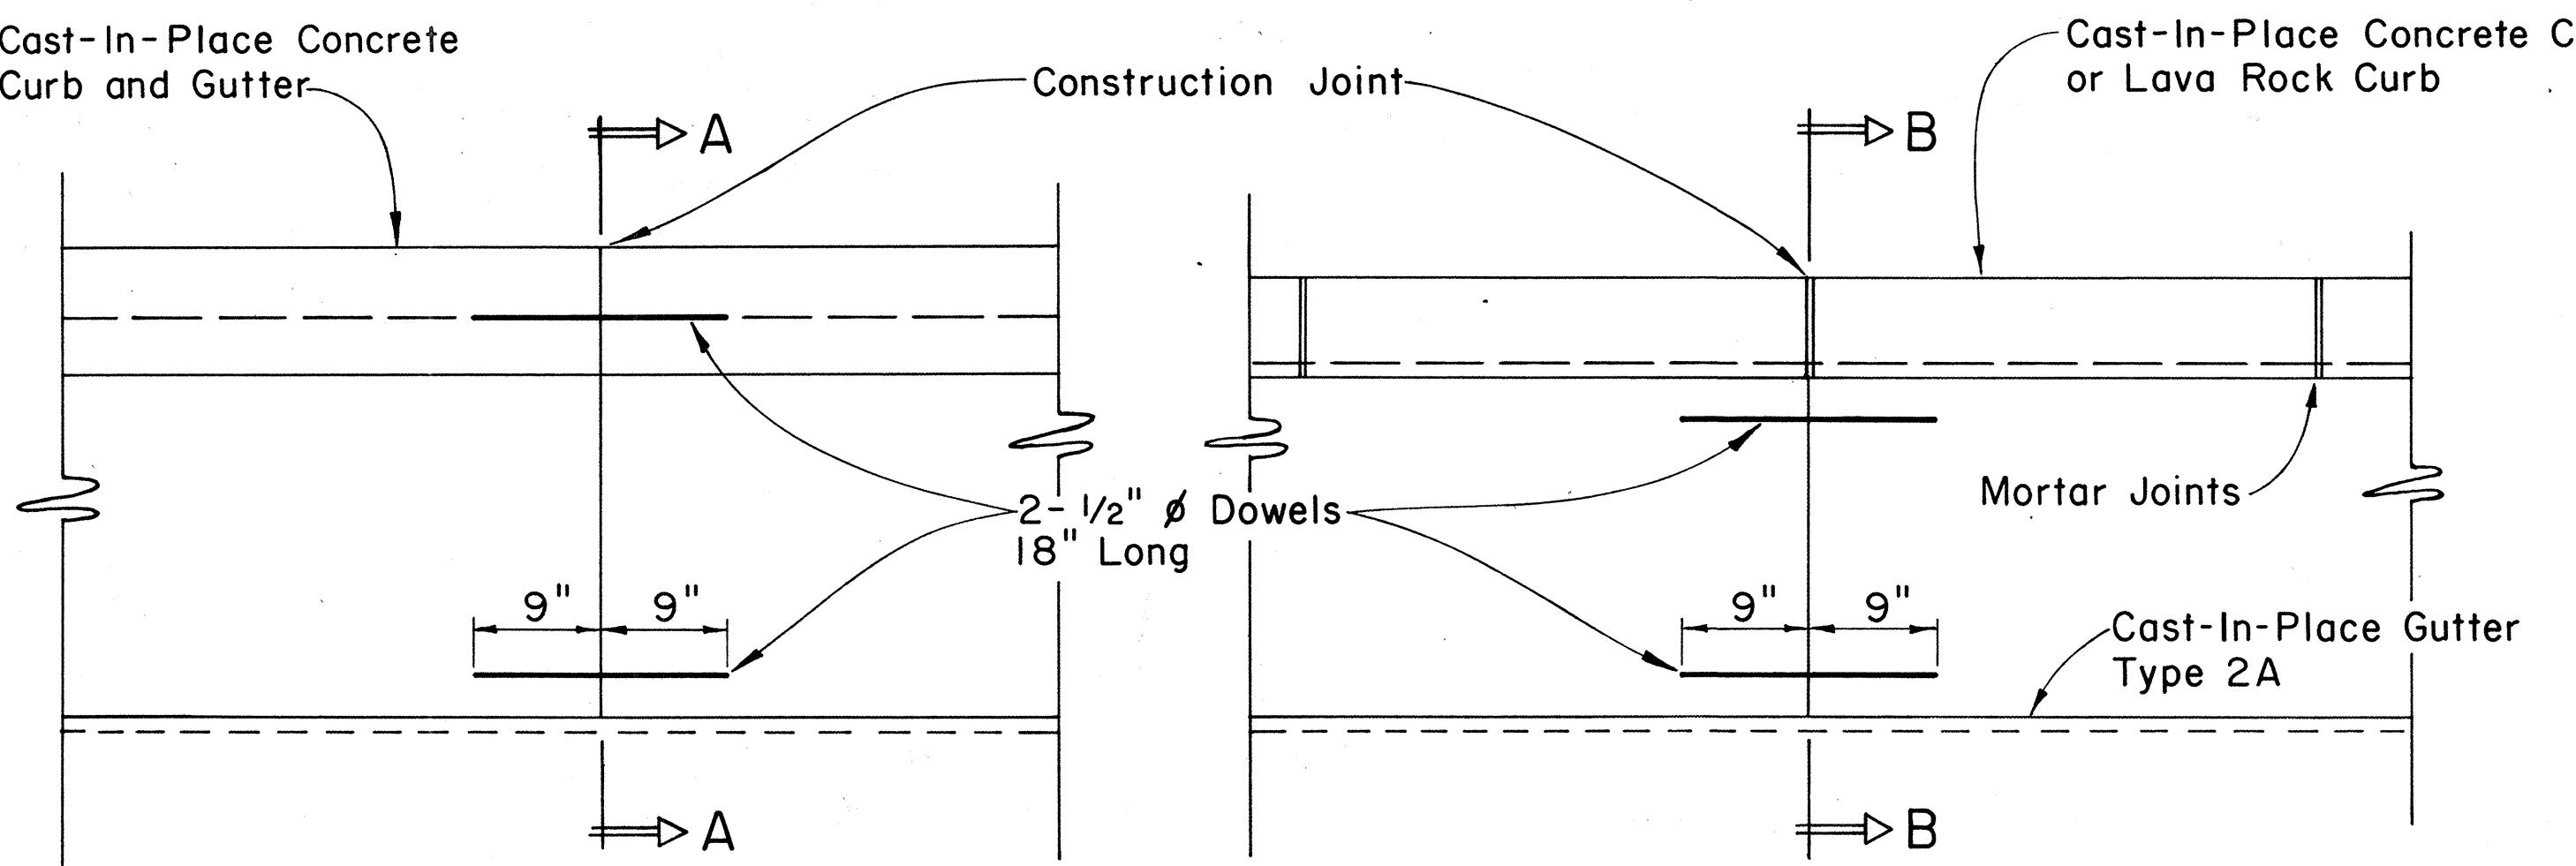


PLAN

PLAN

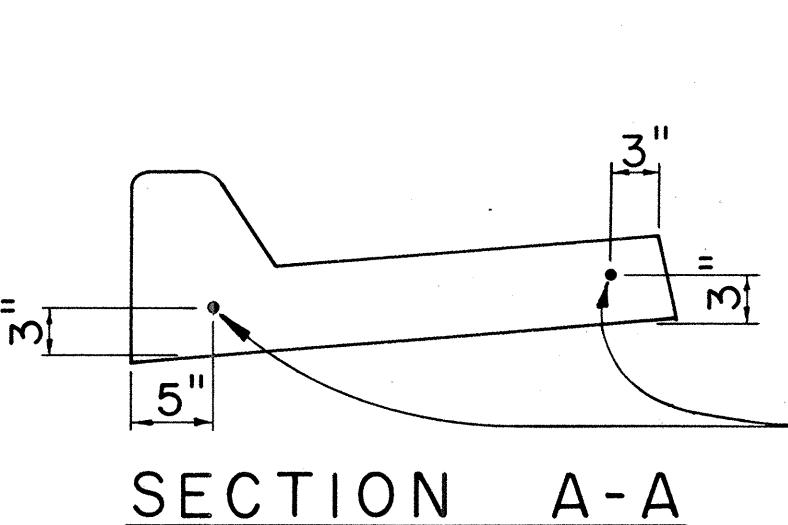


SECTION A-A

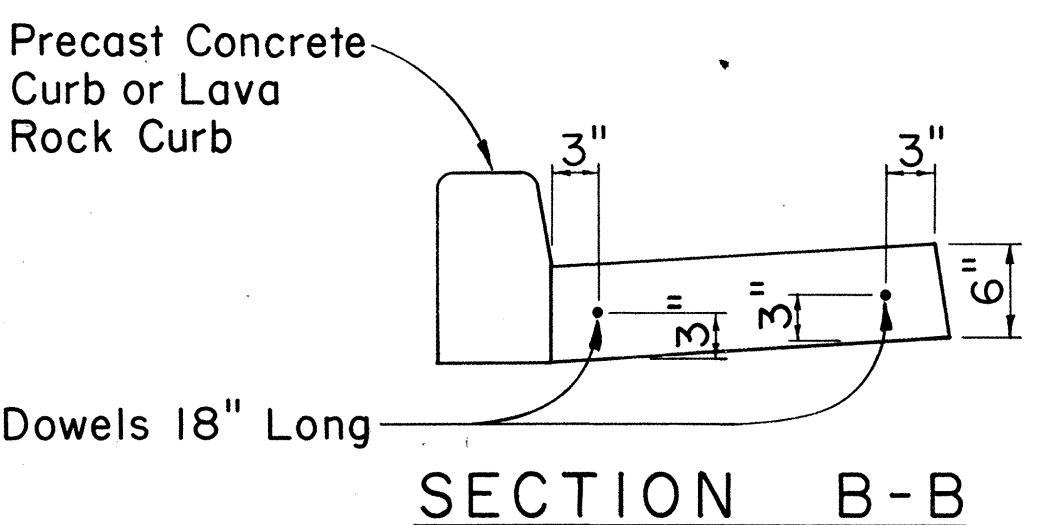


SECTION B-B

CAST-IN-PLACE CURB & GUTTERCAST-IN-PLACE GUTTERCONSTRUCTION JOINT DETAIL


Scale: 1" = 1'-0"

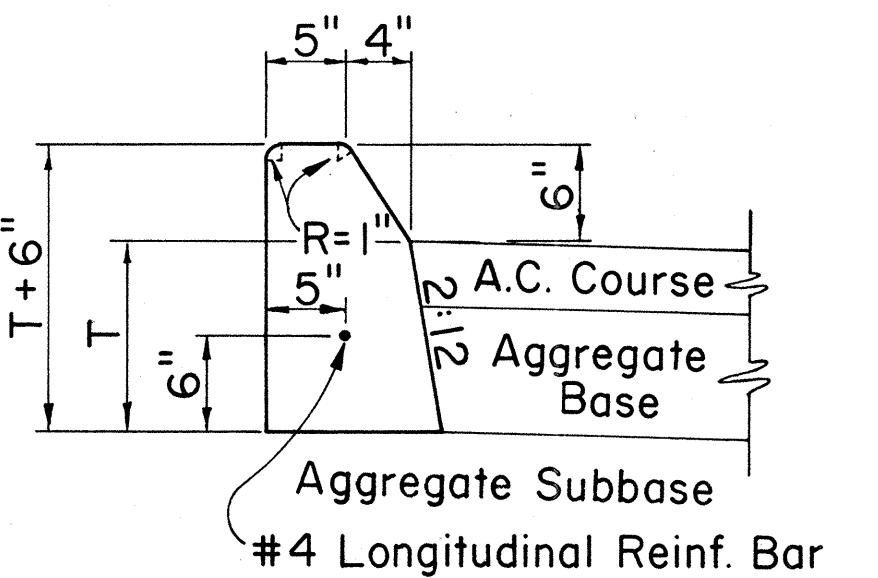


CURB, TYPE 2A

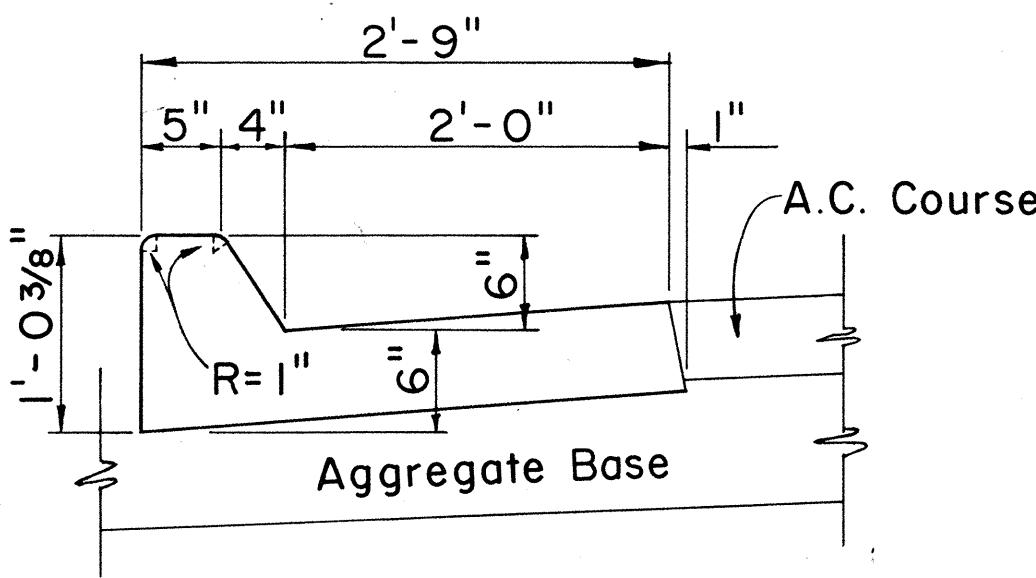


CURB & GUTTER, TYPE 2AG

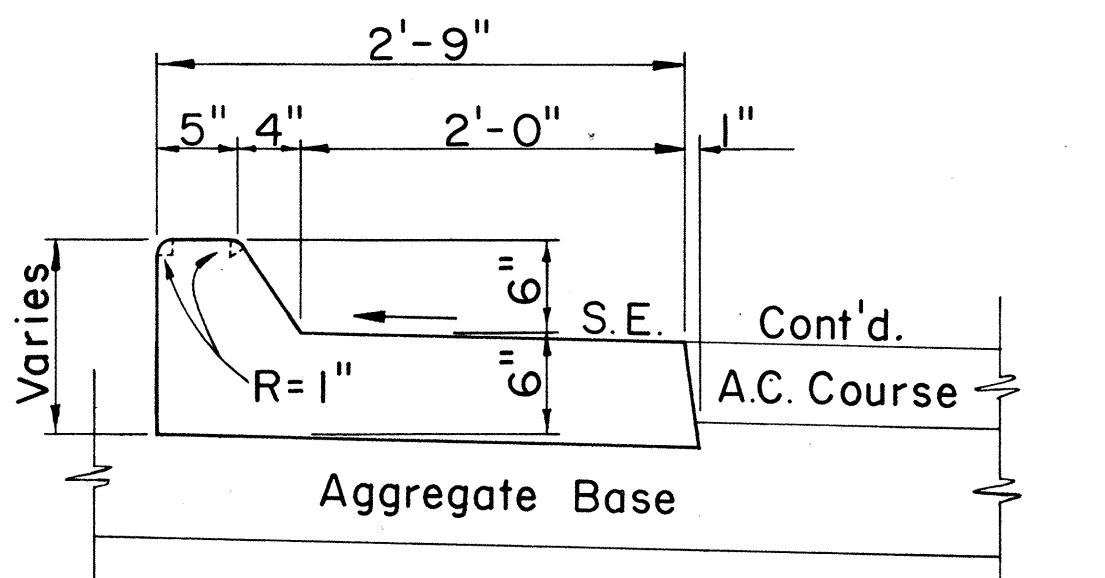


CURB & GUTTER, TYPE 2AGM

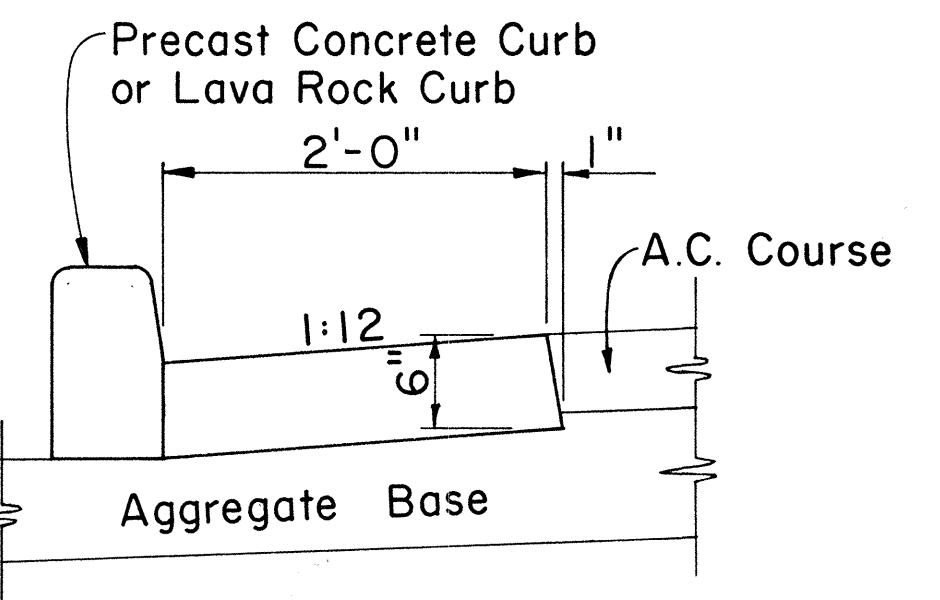


GUTTER, TYPE 2A

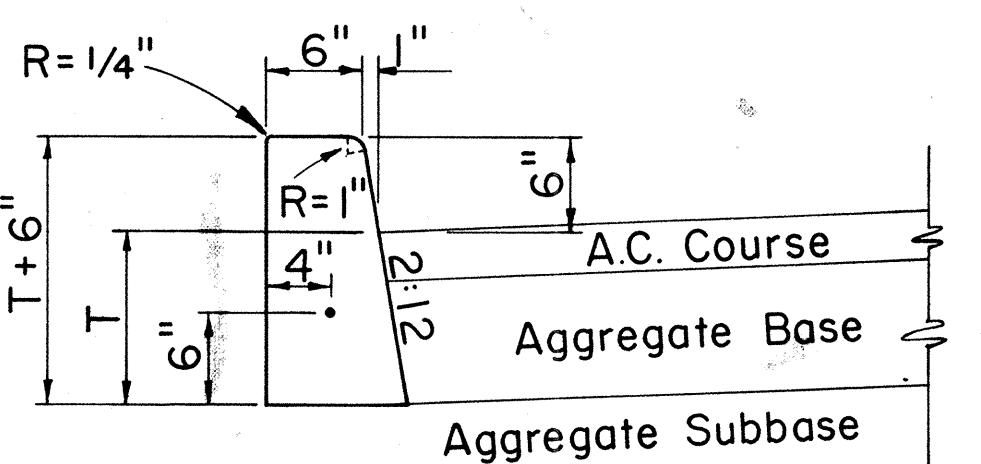

CURB, TYPE 2D

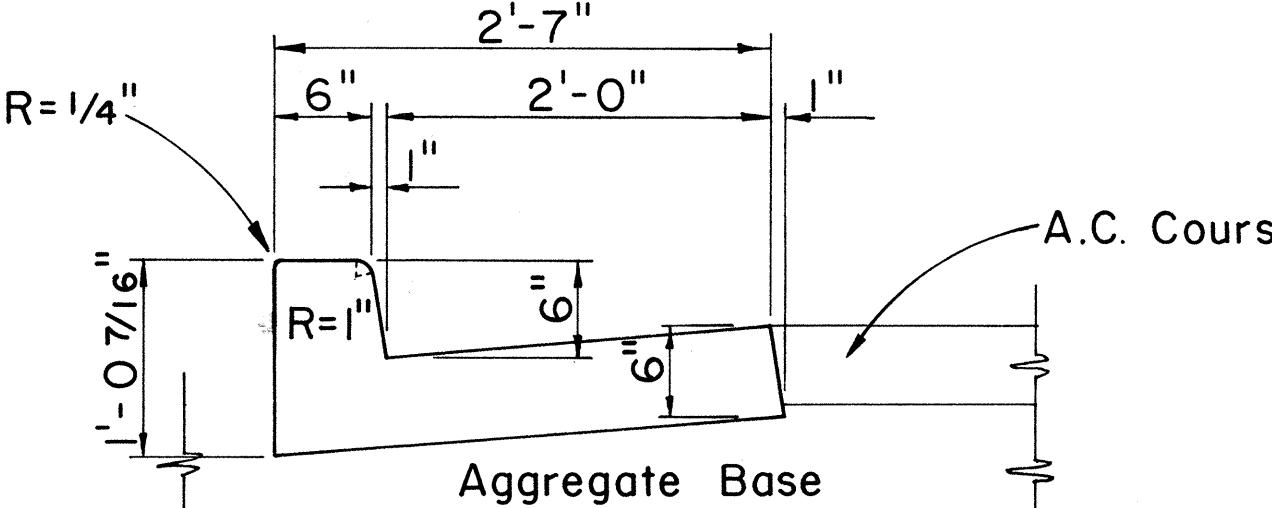


CURB & GUTTER, TYPE 2DG

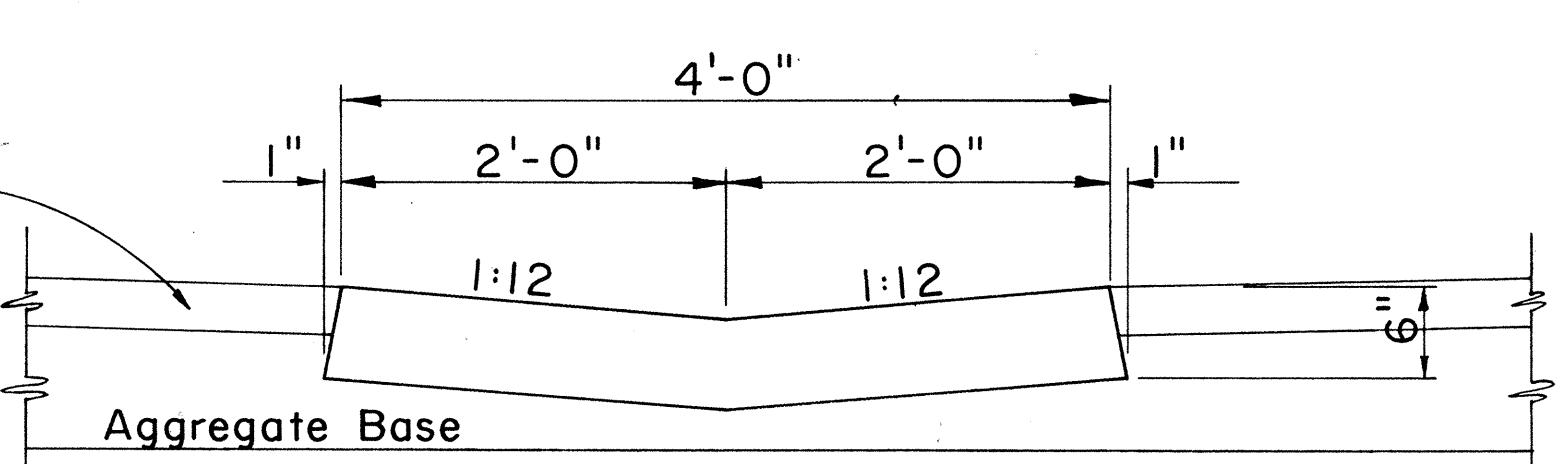


GUTTER, TYPE 2G

CAST-IN-PLACE CONCRETE CURBS AND/OR GUTTERS


Scale: 1" = 1'-0"

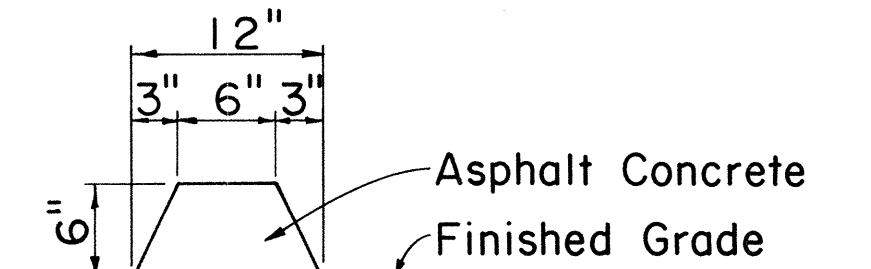CURB, TYPE 6BITUMINOUS CURB


Scale: 1 1/2" = 1'-0"

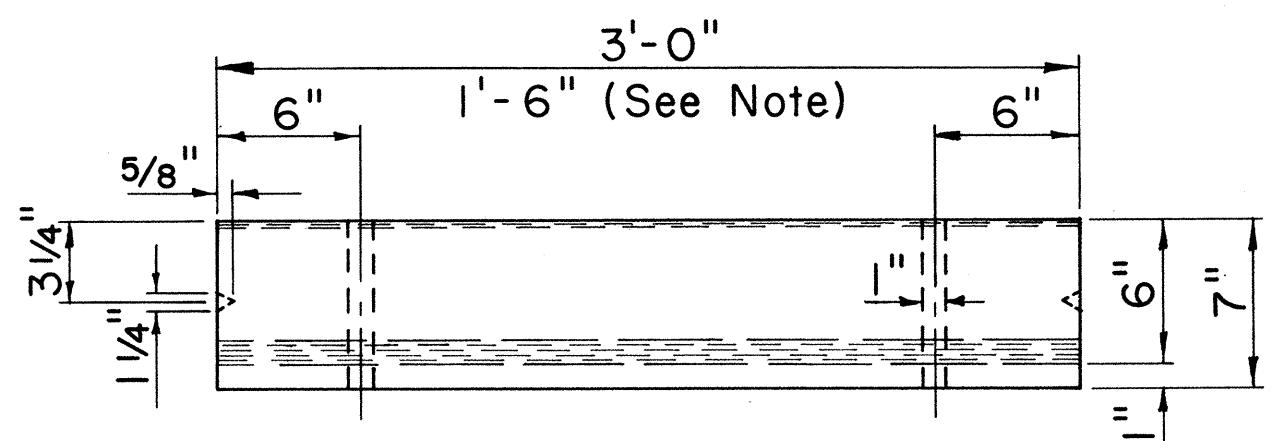

PLAN

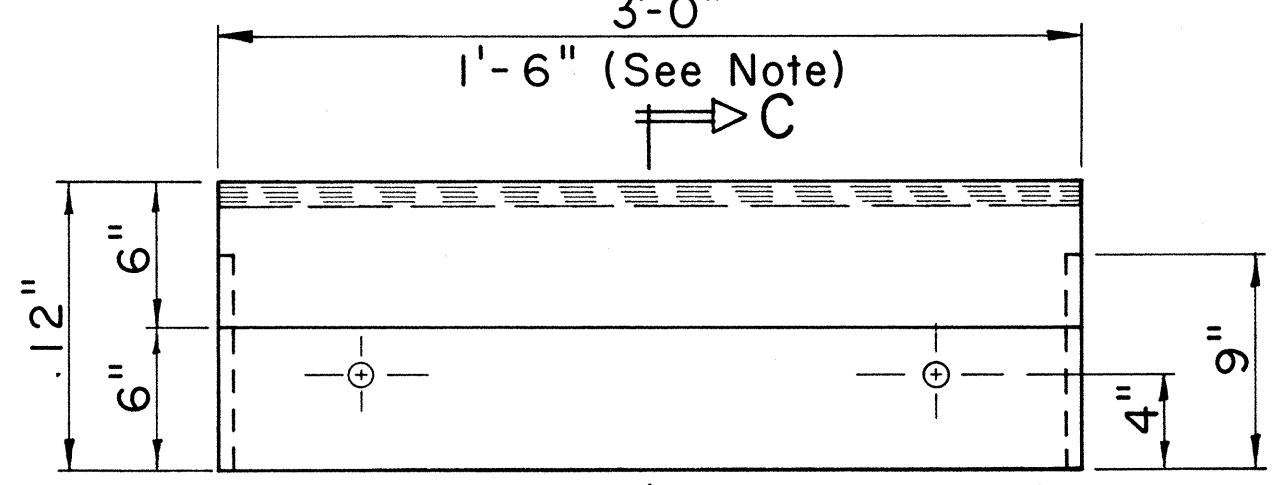

ELEVATION

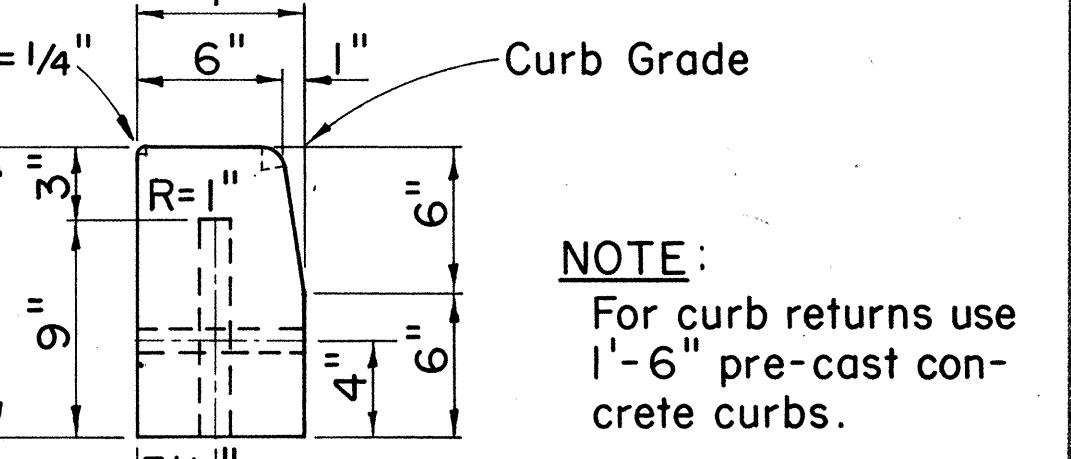

SECTION C-C

CURB, TYPE 3DPRE-CAST CONC. CURB

Scale: 1 1/2" = 1'-0"

APPROVAL RECOMMENDED:
M. Jirazana
 HIGHWAY DESIGN ENGINEER
 DATE: 12-4-69

APPROVED:
A. S. S. S. S.
 ASSISTANT CHIEF, ENGINEERING
 DATE: 12-10-69




NO.	REVISION	APPROVED BY	DATE

STATE OF HAWAII
DEPARTMENT OF TRANSPORTATION
HIGHWAYS DIVISIONSTANDARD DETAILSTYPICAL DETAILS OF CURBAND/OR GUTTERS

Scale: As Shown

SHEET No. 8 OF 17 SHEETS DD 609.1

FED. ROAD DIST. NO.	STATE	FED. AID PROJ. NO.	FISCAL YEAR	SHEET NO.	TOTAL SHEETS
HAWAII	HAW.	I-HI-I(73)-15	1974	75	369

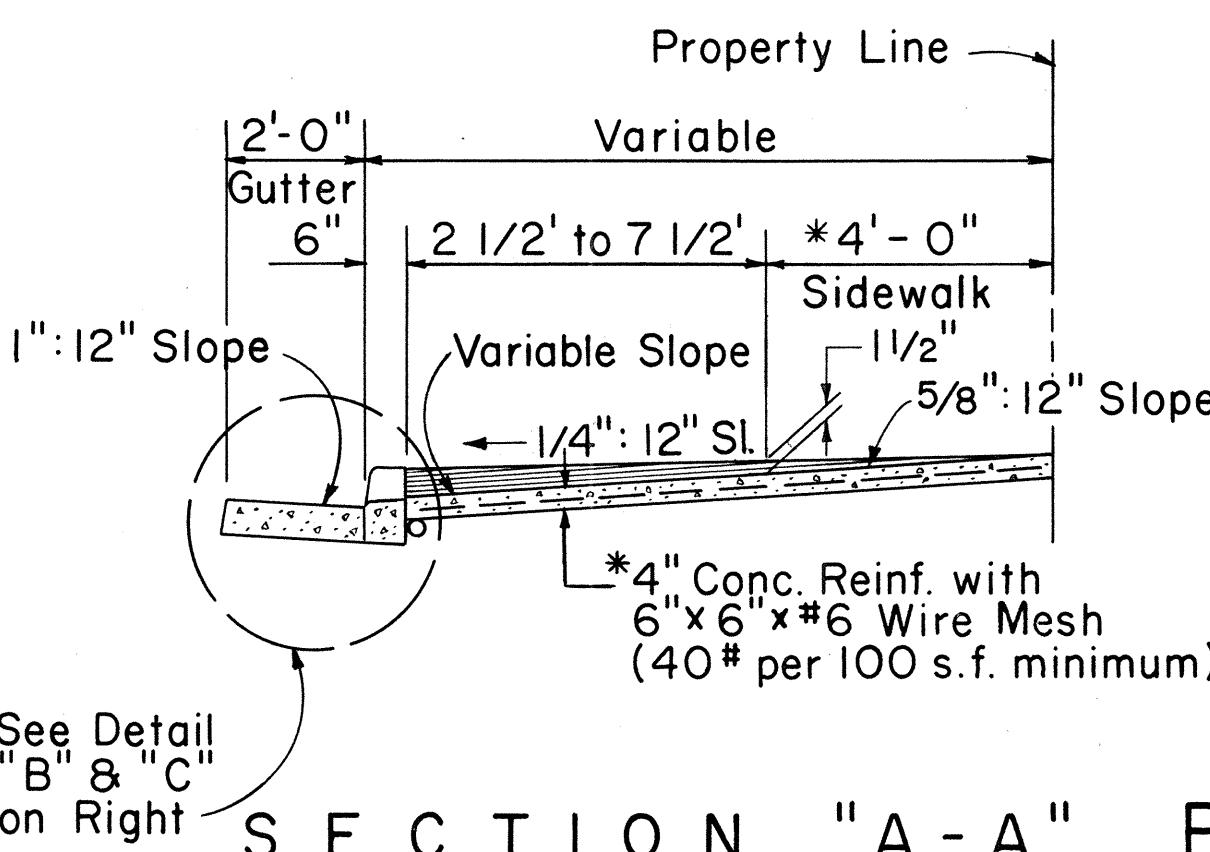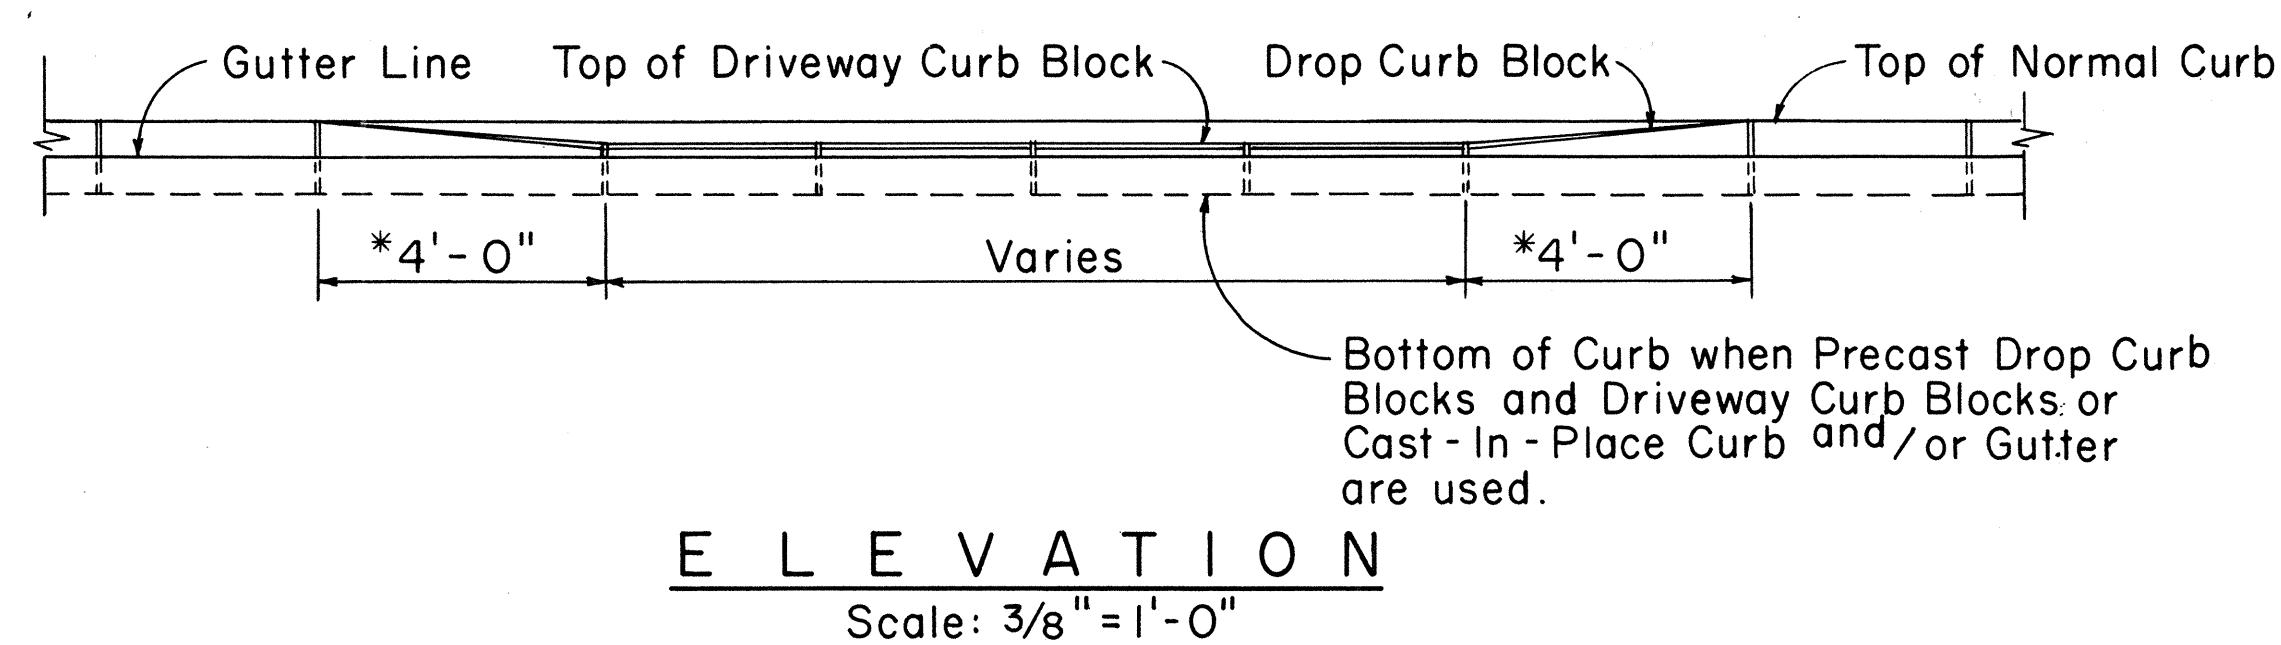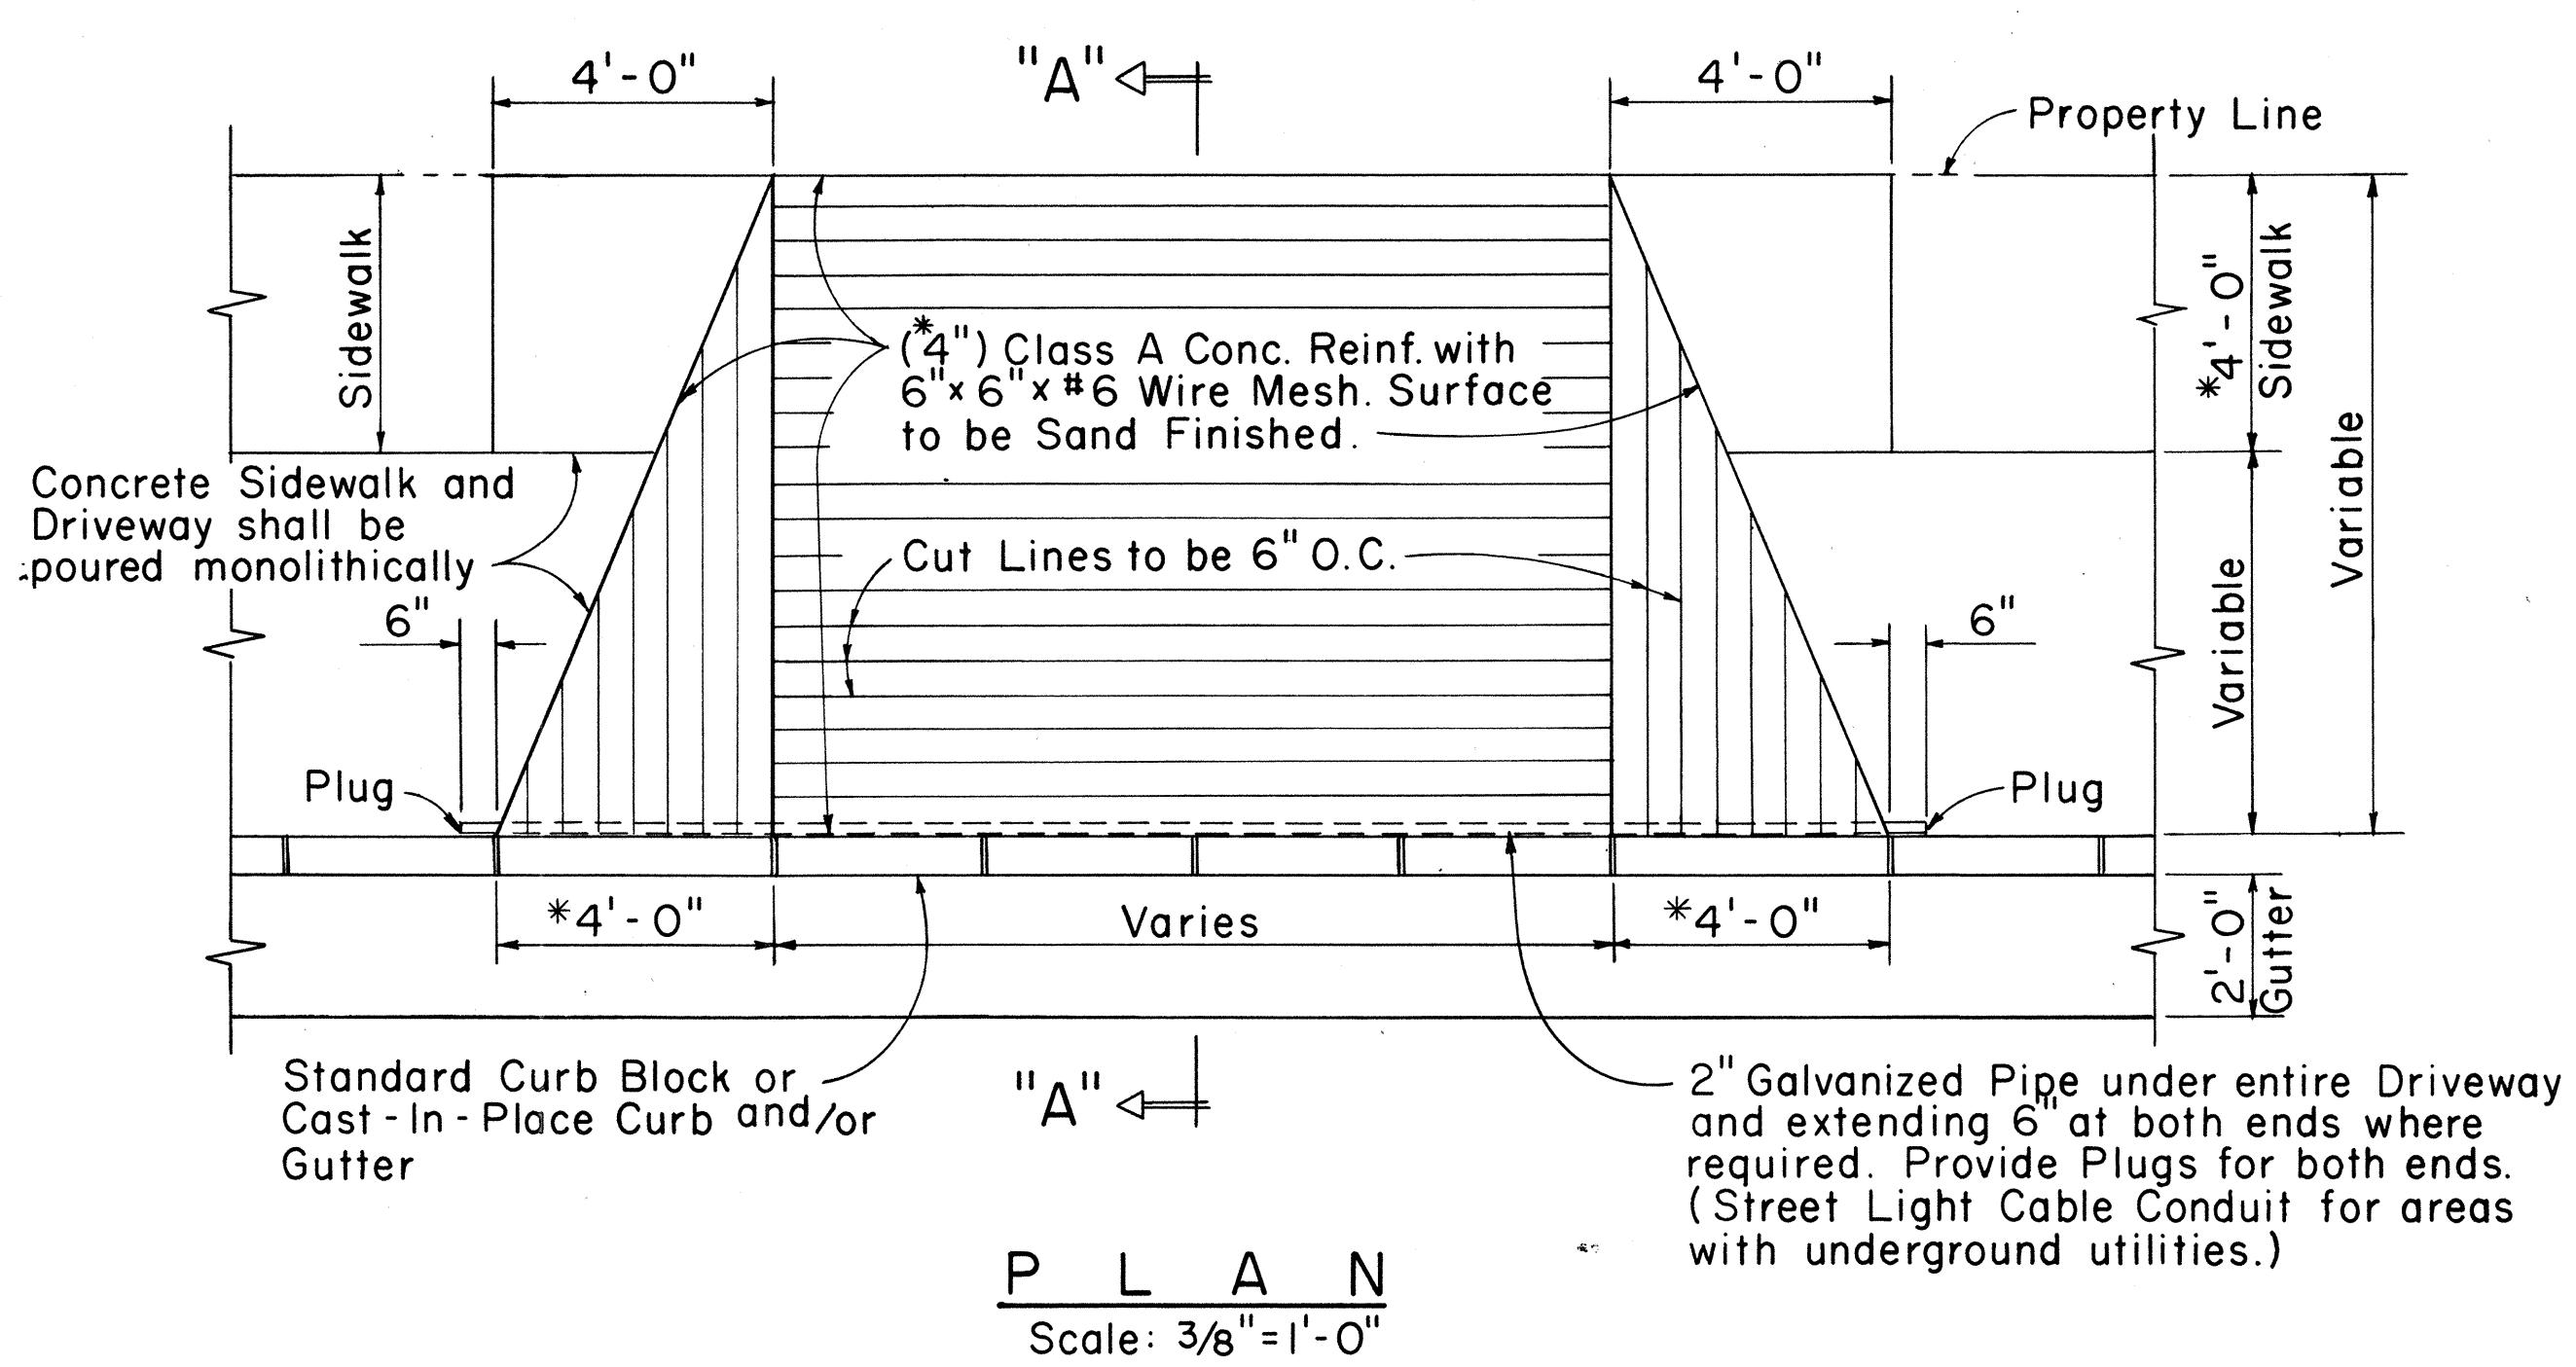

PRE-CAST DRIVEWAY CURB AND CAST-IN-PLACE GUTTER


D E T A I L "B"
Scale: 3/4" = 1'-0"

CAST-IN-PLACE INTEGRAL DRIVEWAY CURB AND GUTTER


D E T A I L "C"
Scale: 3/4" = 1'-0"

TYPICAL DETAILS OF REINF. CONC. DROP DRIVEWAY


Scale: As Noted

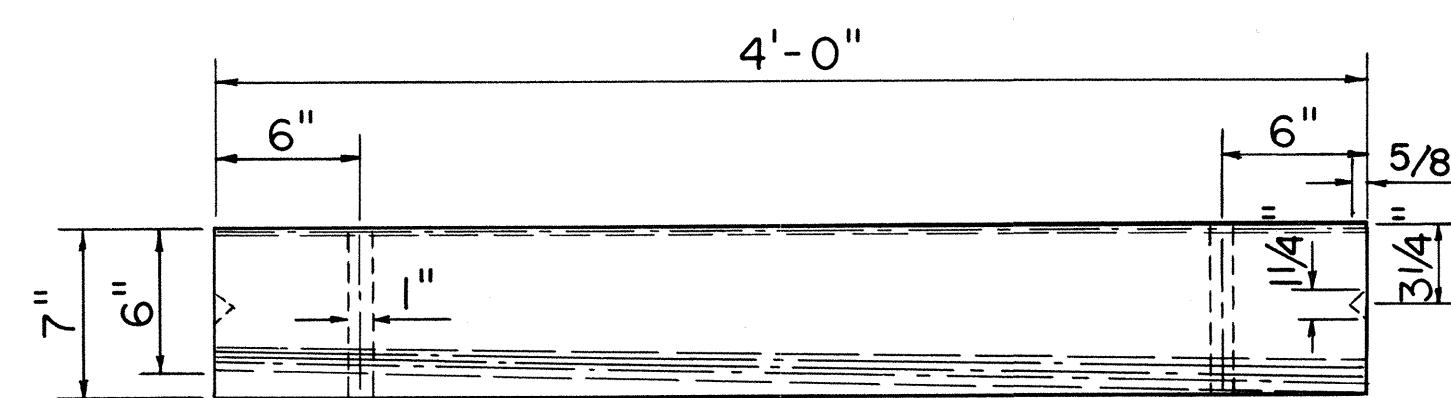


P L A N
Scale: 1 1/2" = 1'-0"

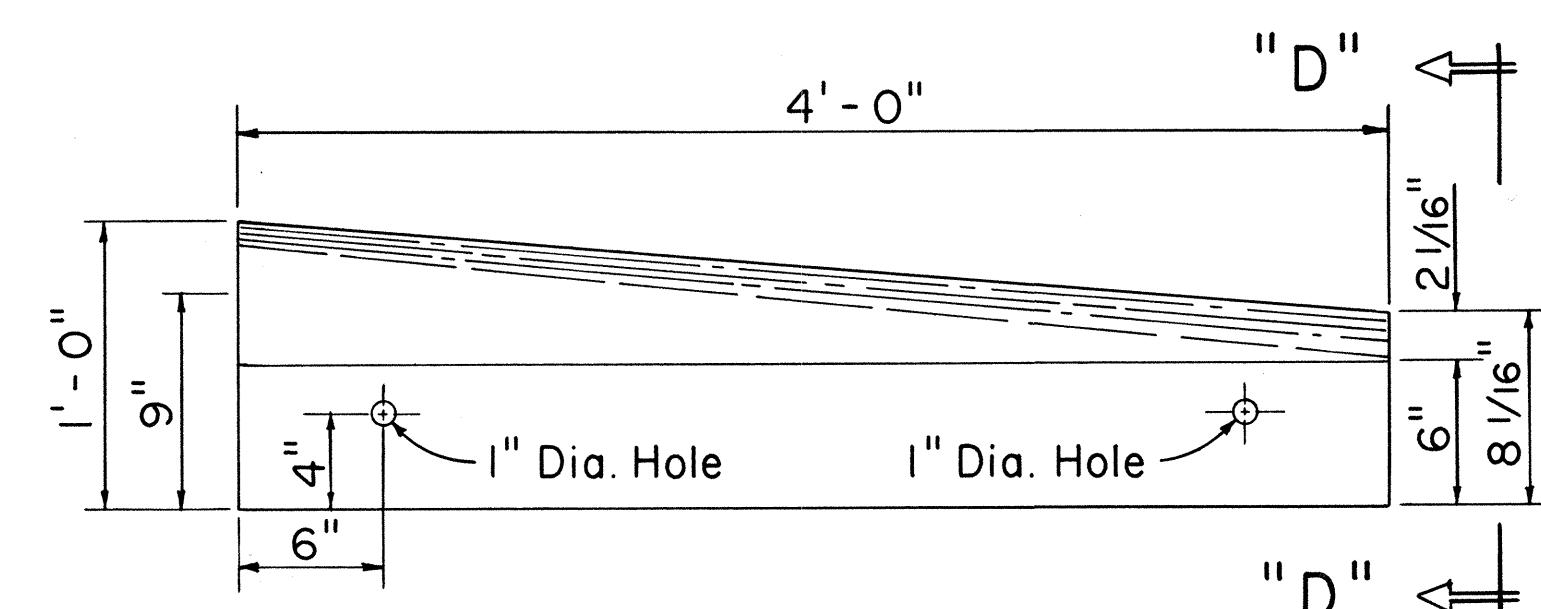


E L E V A T I O N
Scale: 1 1/2" = 1'-0"

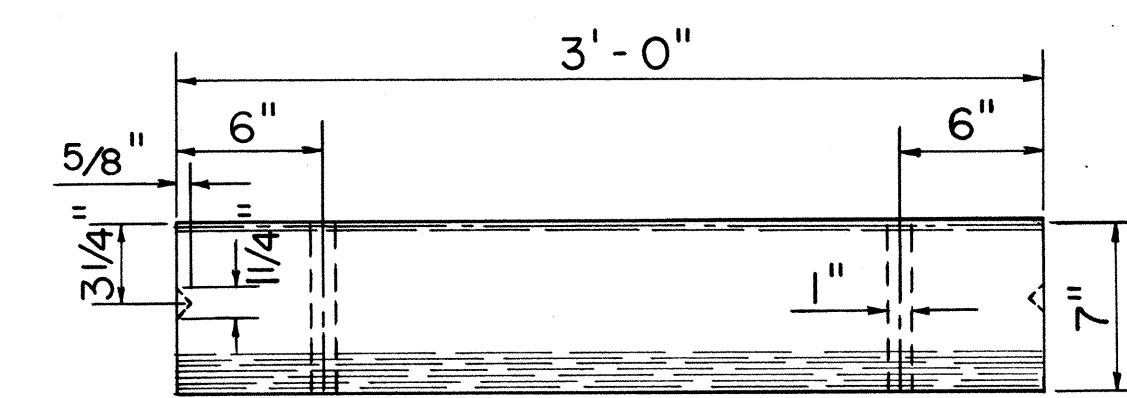


P L A N
Scale: 1 1/2" = 1'-0"

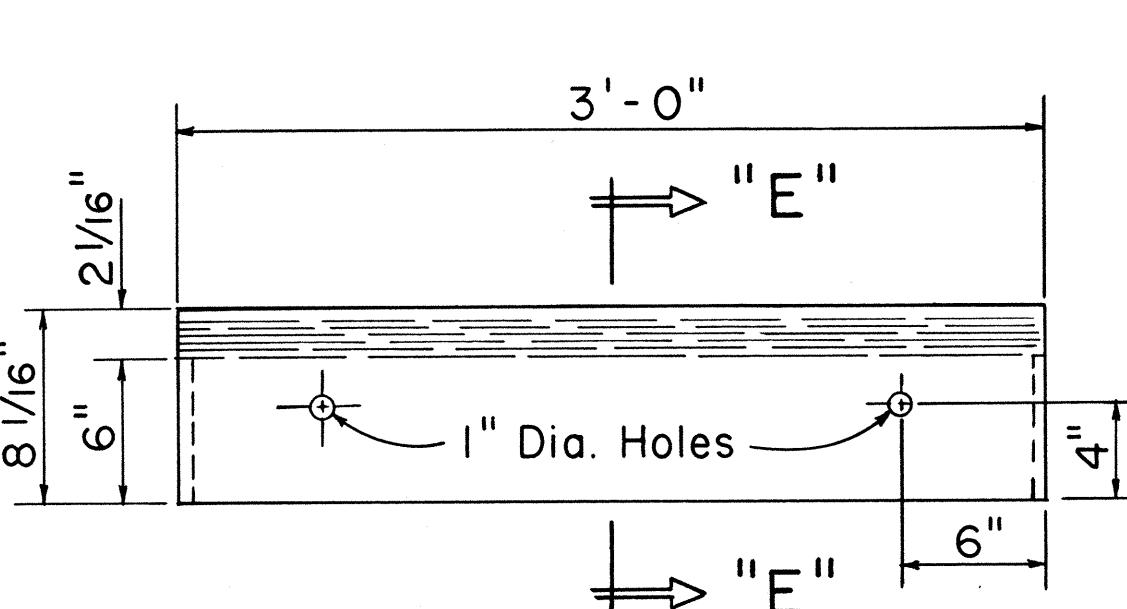


E L E V A T I O N
Scale: 1 1/2" = 1'-0"

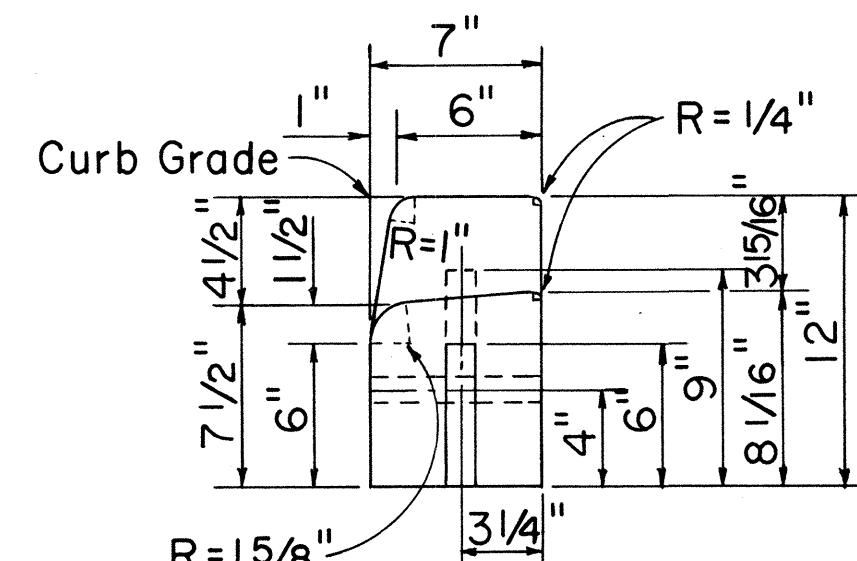

S E C T I O N "D - D"
Scale: 1 1/2" = 1'-0"

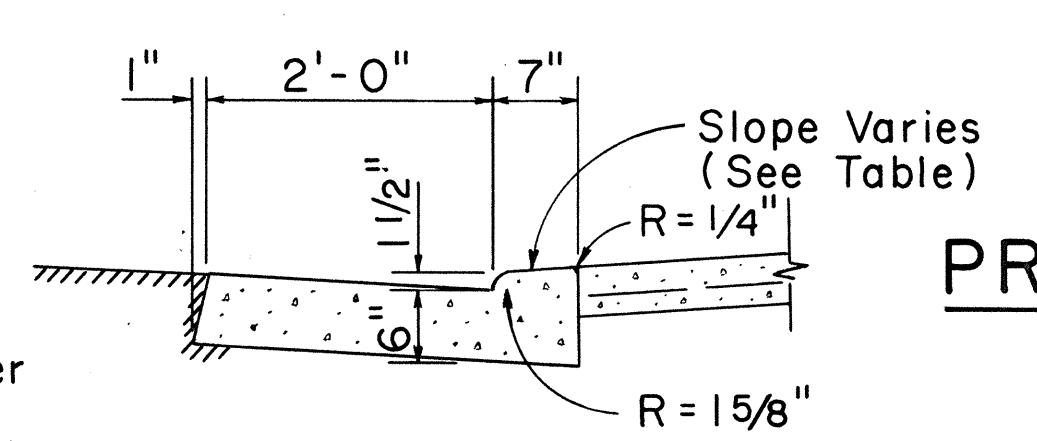

PRE-CAST CONC. DROP CURB BLOCK

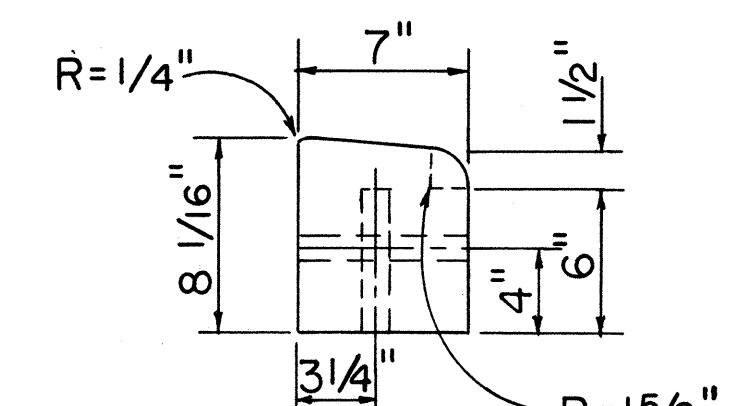

S E C T I O N "E - E"
Scale: 1 1/2" = 1'-0"

PRE-CAST CONC. DRIVEWAY CURB

NOTE:

I. *Use dimension shown unless otherwise noted on the plans.

APPROVAL RECOMMENDED:
Mr. [Signature]
HIGHWAY DESIGN ENGINEER
DATE: 12-4-69

APPROVED:
John P. [Signature]
ASSISTANT CHIEF, ENGINEERING
DATE: 12-10-69


NO.	REVISION	APPROVED BY	DATE

STATE OF HAWAII
DEPARTMENT OF TRANSPORTATION
HIGHWAYS DIVISION
STANDARD DETAILS
TYPICAL DETAILS OF
REINF. CONC. DROP DRIVEWAY


Scale: As Shown

2/17/59

D. ROAD ST. NO.	STATE	FED. AID PRJ. NO.	FISCAL YEAR	SHEET NO.	TOTAL SHEETS
AWAII	HAW.	I-HI-1(73):15	1974	76	369

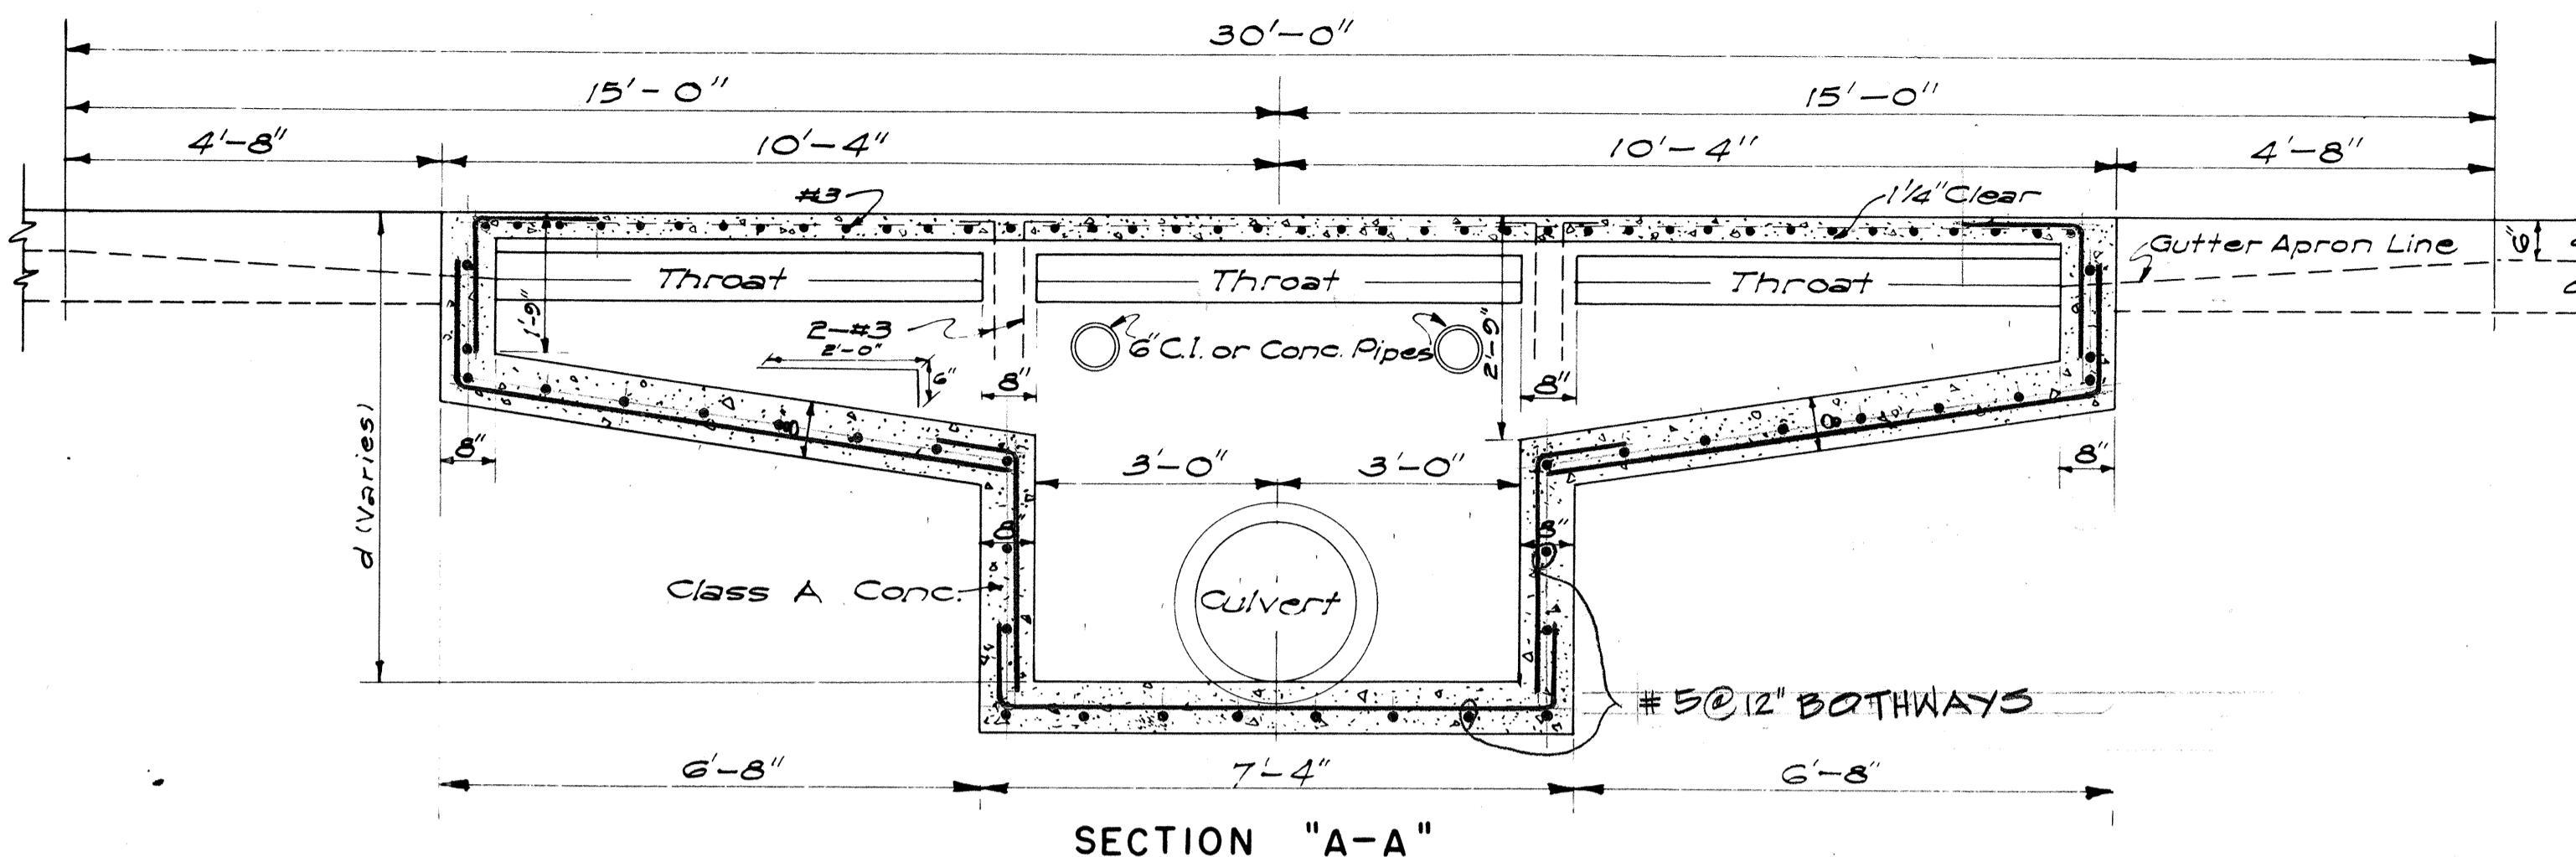


SECTION "A-A

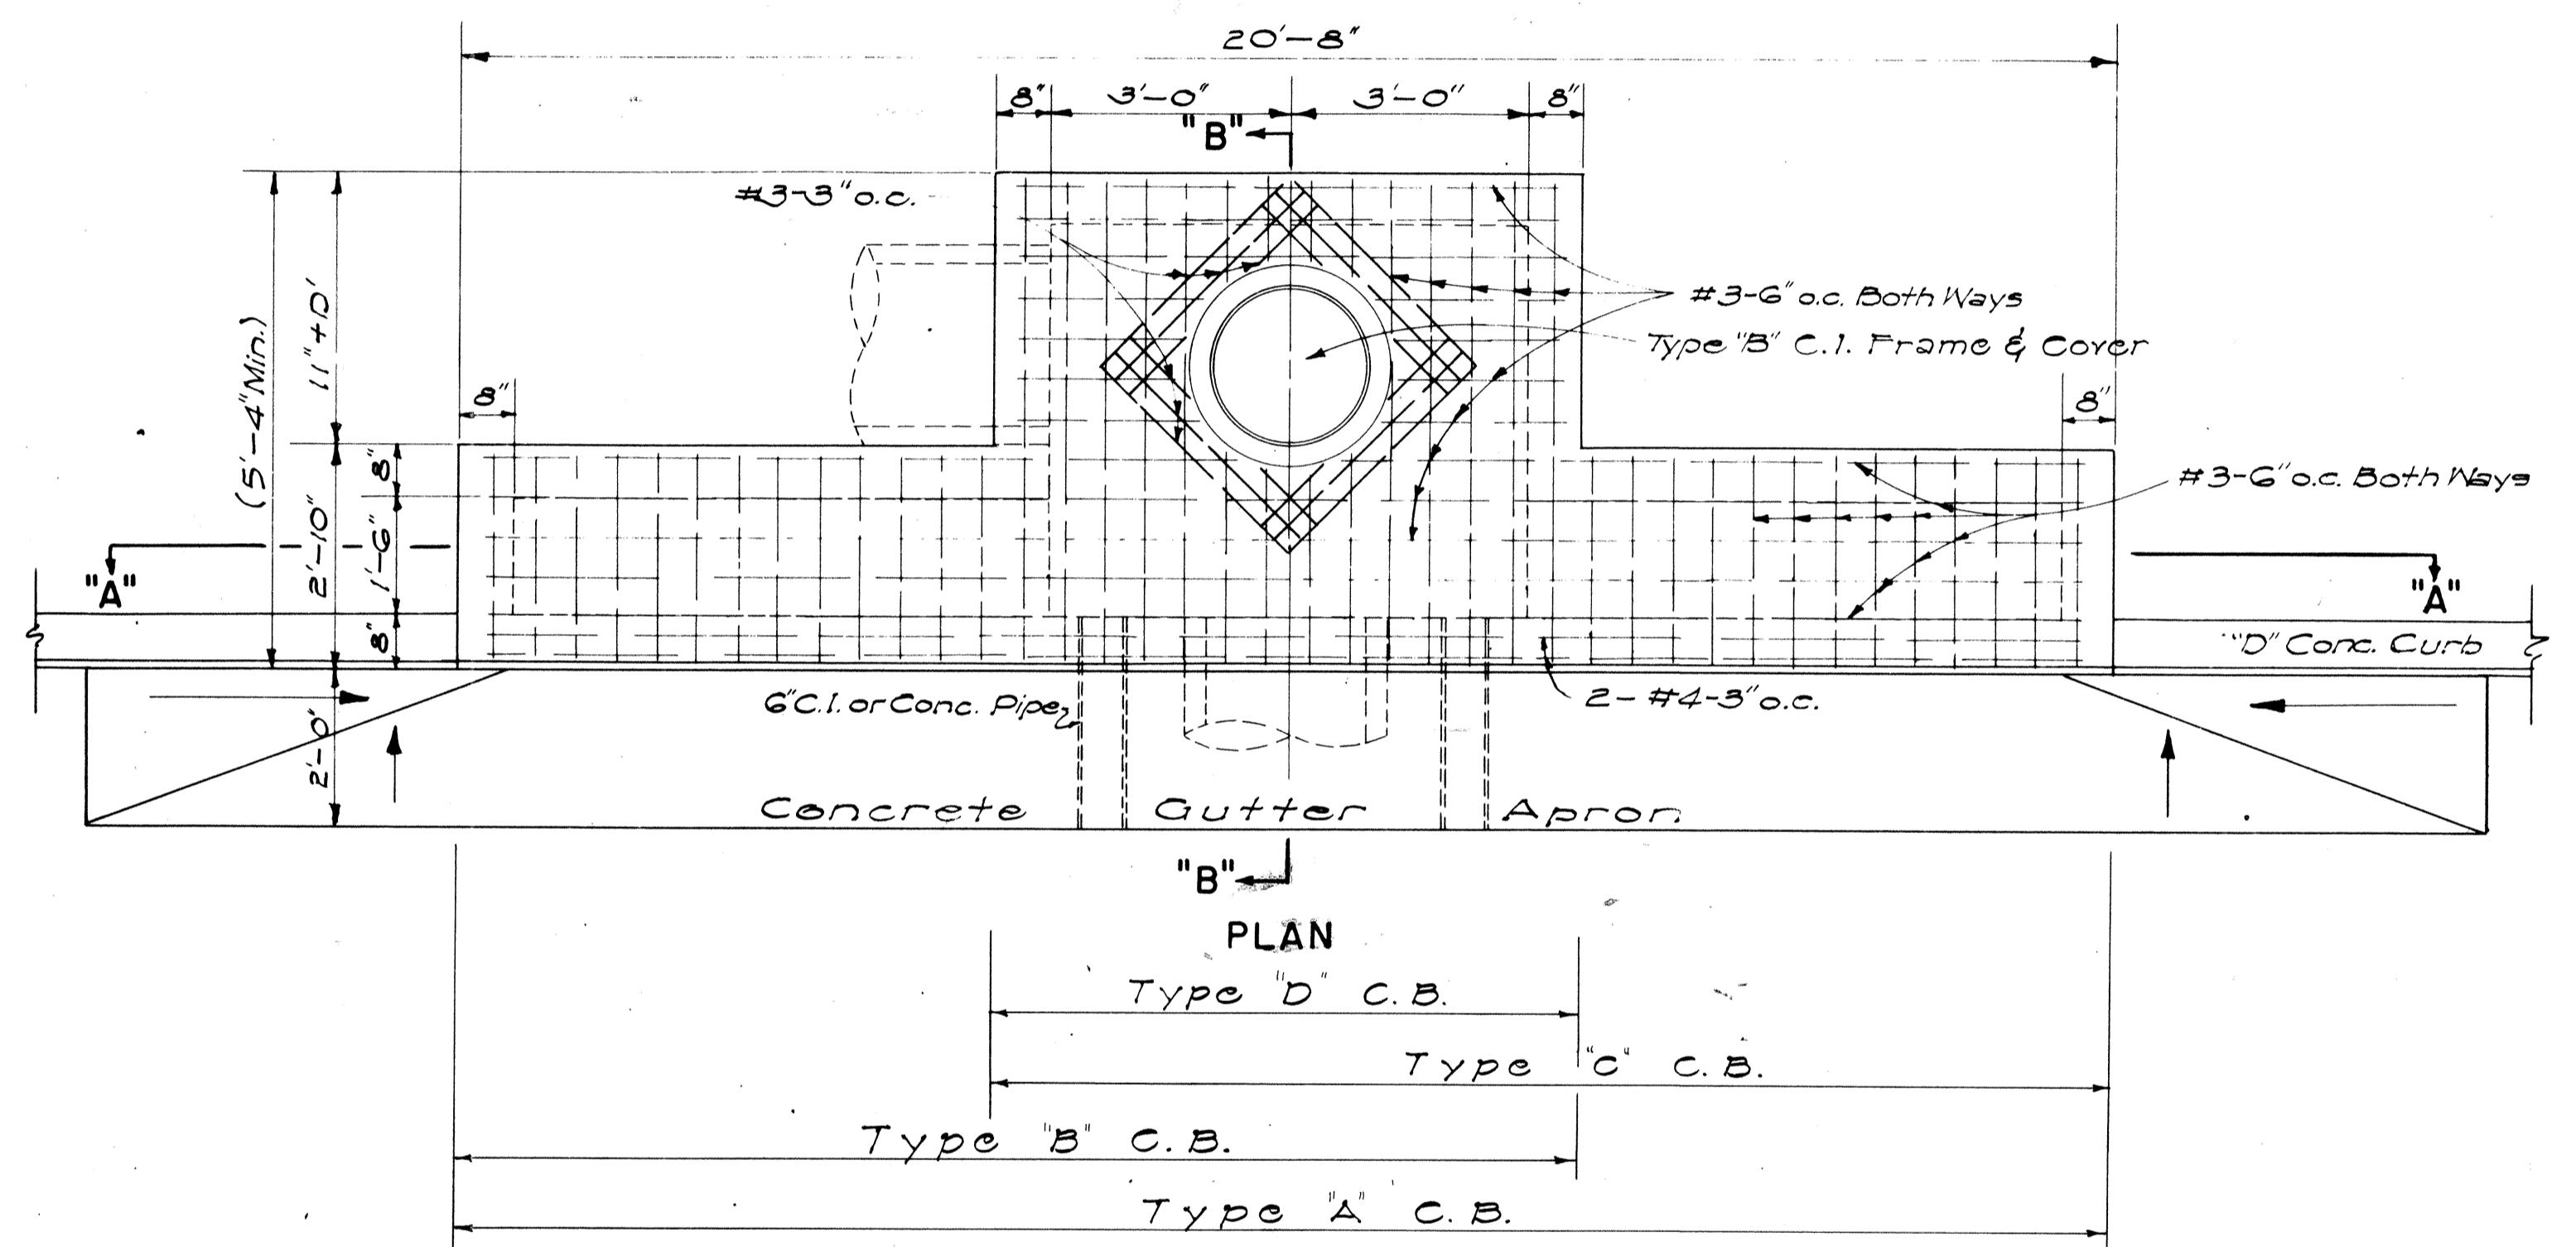


DETAILS OF TYPES "A", "B", "C" AND "D" CATCH BASINS


SCALE: 1/2" = 1' - 0"

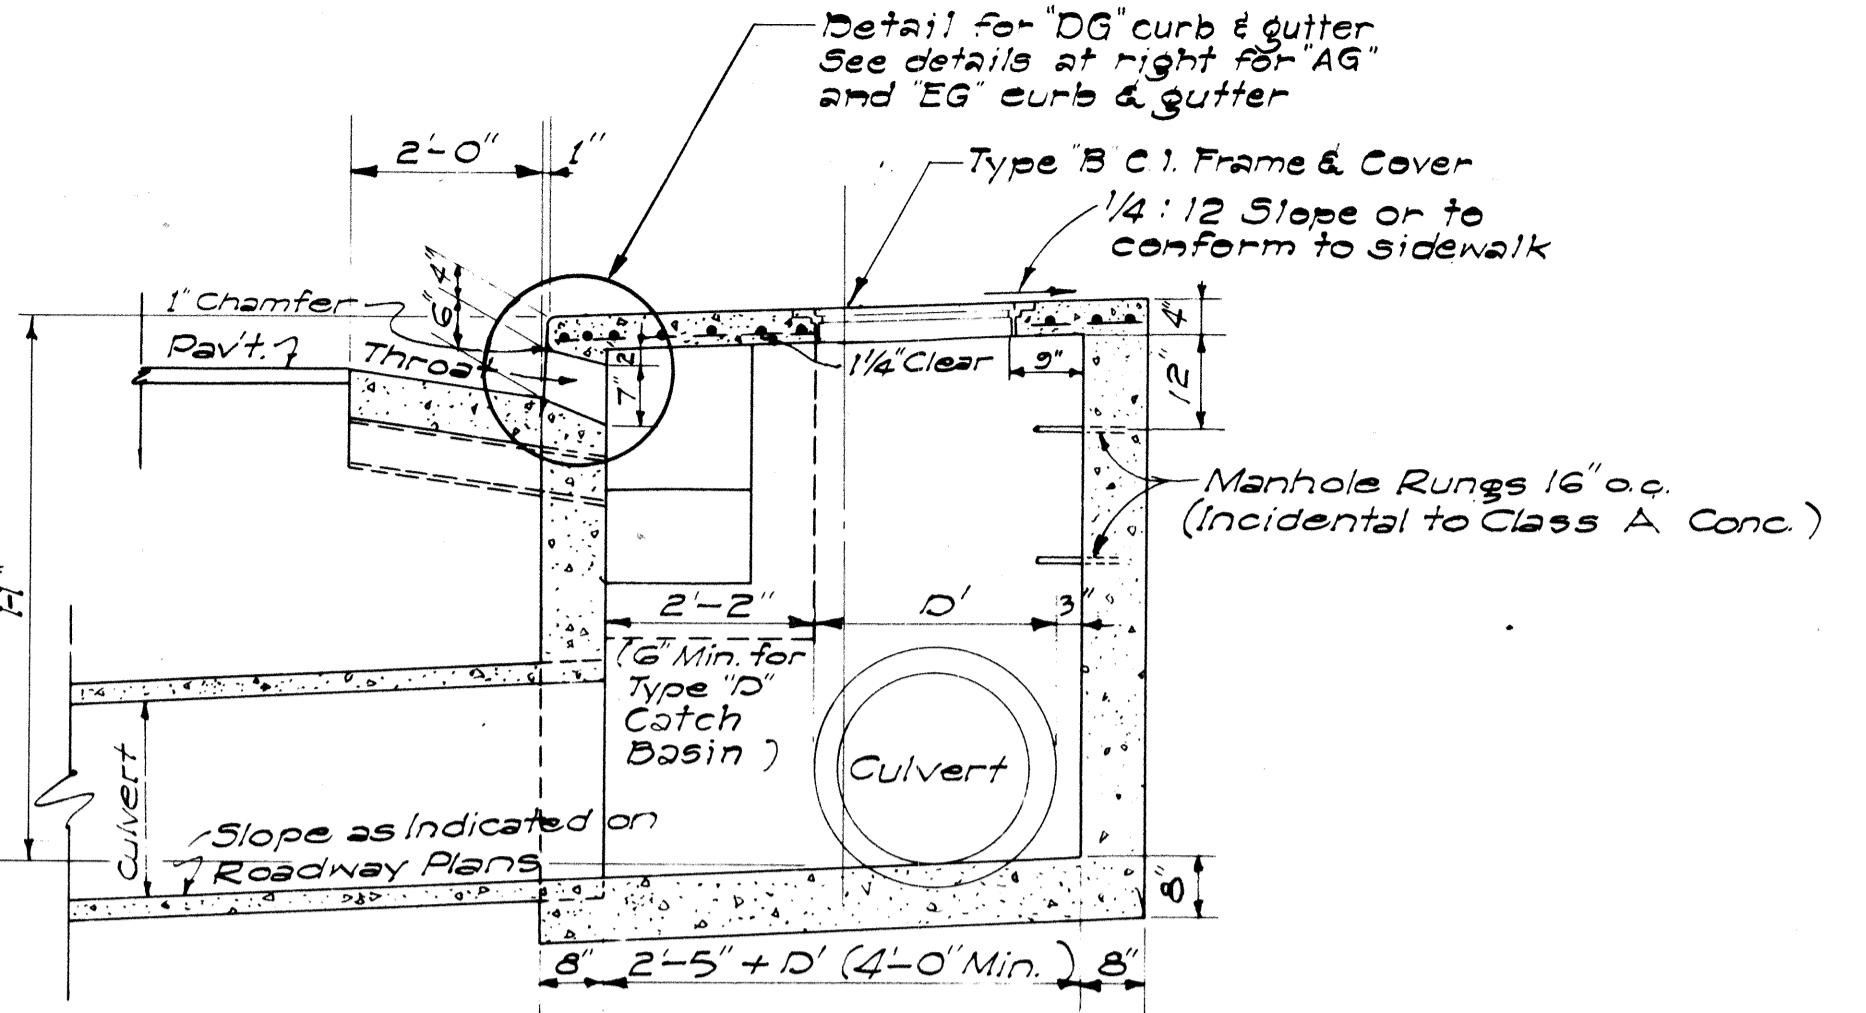

SECTION "B-B"

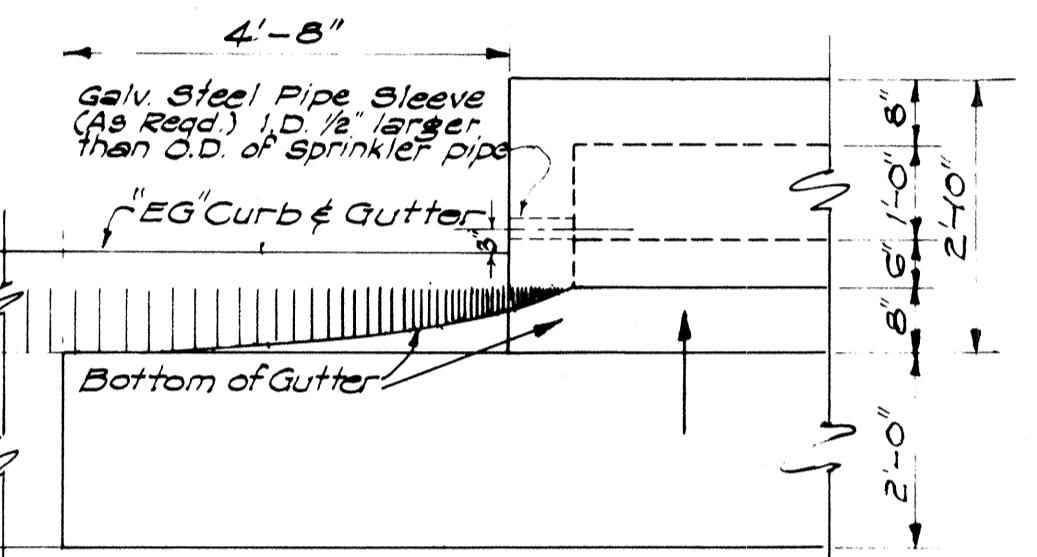

DETAIL OF CATCH BASIN WITH "EG" CURB & GUTTER



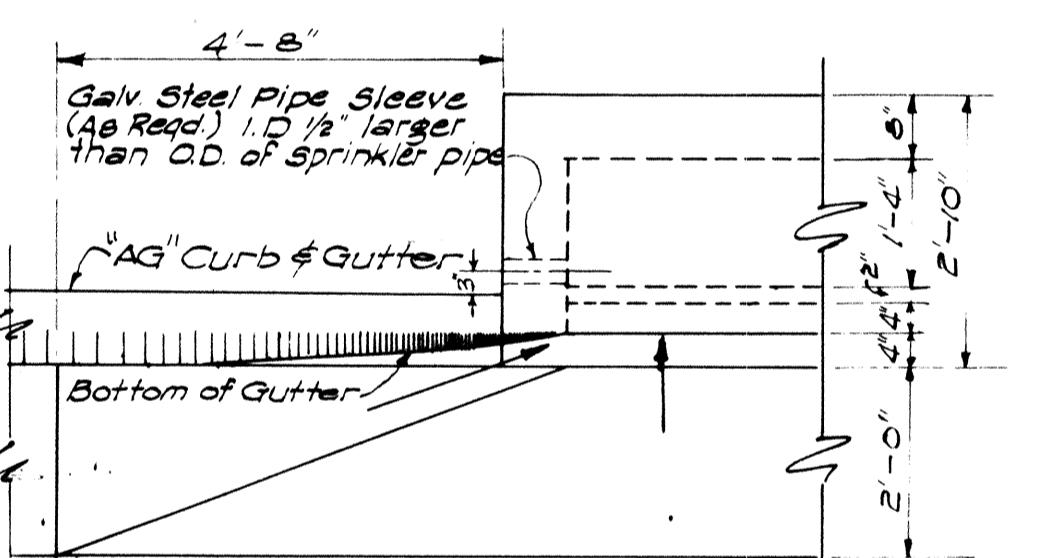


DETAIL OF CATCH BASIN WITH "AG" CURB & GUTTER


SCALE: 1/3" = 1' = 0"

GENERAL NOTES

1. Quantities based on $d = 5.75'$ and $D' = 30"$.
 2. Quantities do not include concrete for Gutter Apron.
 3. The Contractor shall install two 6" Cast Iron or Concrete Pipes as incidental to Class A Concrete for Construction Drainage. The Engineer shall determine the exact location in the field.
 4. Culvert shall leave C.B. from any position and any direction indicated by plans or ordered by the Engineer. Culvert may both enter and leave C.B. so that C.B. will also act as Manhole.
 5. The Contractor shall install Galvanized Steel Pipe Sleeves and Straps as incidental to Sprinkler System.
 6. The type of curb and/or gutter (Type 1, 2, 3, etc.) shall conform to the type specified on the roadway plans.
 7. Manhole Rungs (16" o.c.) are required when "H" is greater than 4 feet 6 inches. Only one rung (12 inches from the bottom) is required if "H" is 4 feet 6 inches or less. Type "B" Cast Iron Frame and Cover and Manhole Rungs may be placed at any location as ordered by the Engineer.
 8. SEE SHEET 71 GENERAL CONCRETE NOTES AND DETAILS.

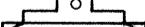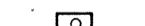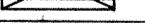Type	Class A Conc.	Struct. Exc.	Reinf. Steel	Gutter Length
"A" 	7.5 c.y.	24.7 c.y.	145 lb.	30'-0"
"B" 	6.0 c.y.	21.5 c.y.	108 lb.	23'-4"
"C" 	6.0 c.y.	21.5 c.y.	108 lb.	23'-4"
"D" 	4.9 c.y.	16.5 c.y.	77 lb.	16'-8"

* REINFORCING STEEL QUANTITIES ARE FOR TOP SLAB ONLY

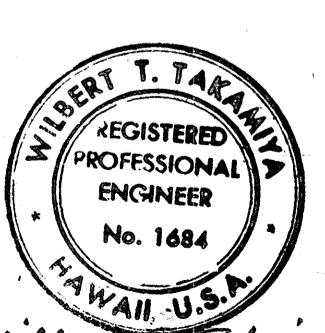


Welbert T. Takemoto
**THIS WORK WAS PREPARED BY ME
OR UNDER MY SUPERVISION.**

NO.	REVISION	APPROVED	BY	DATE


STATE OF HAWAII
DEPARTMENT OF TRANSPORTATION
HIGHWAYS DIVISION

CATCH BASINS

Scale: As Noted Date: July, 1969
SHEET NO 10 OF 17 SHEETS DH

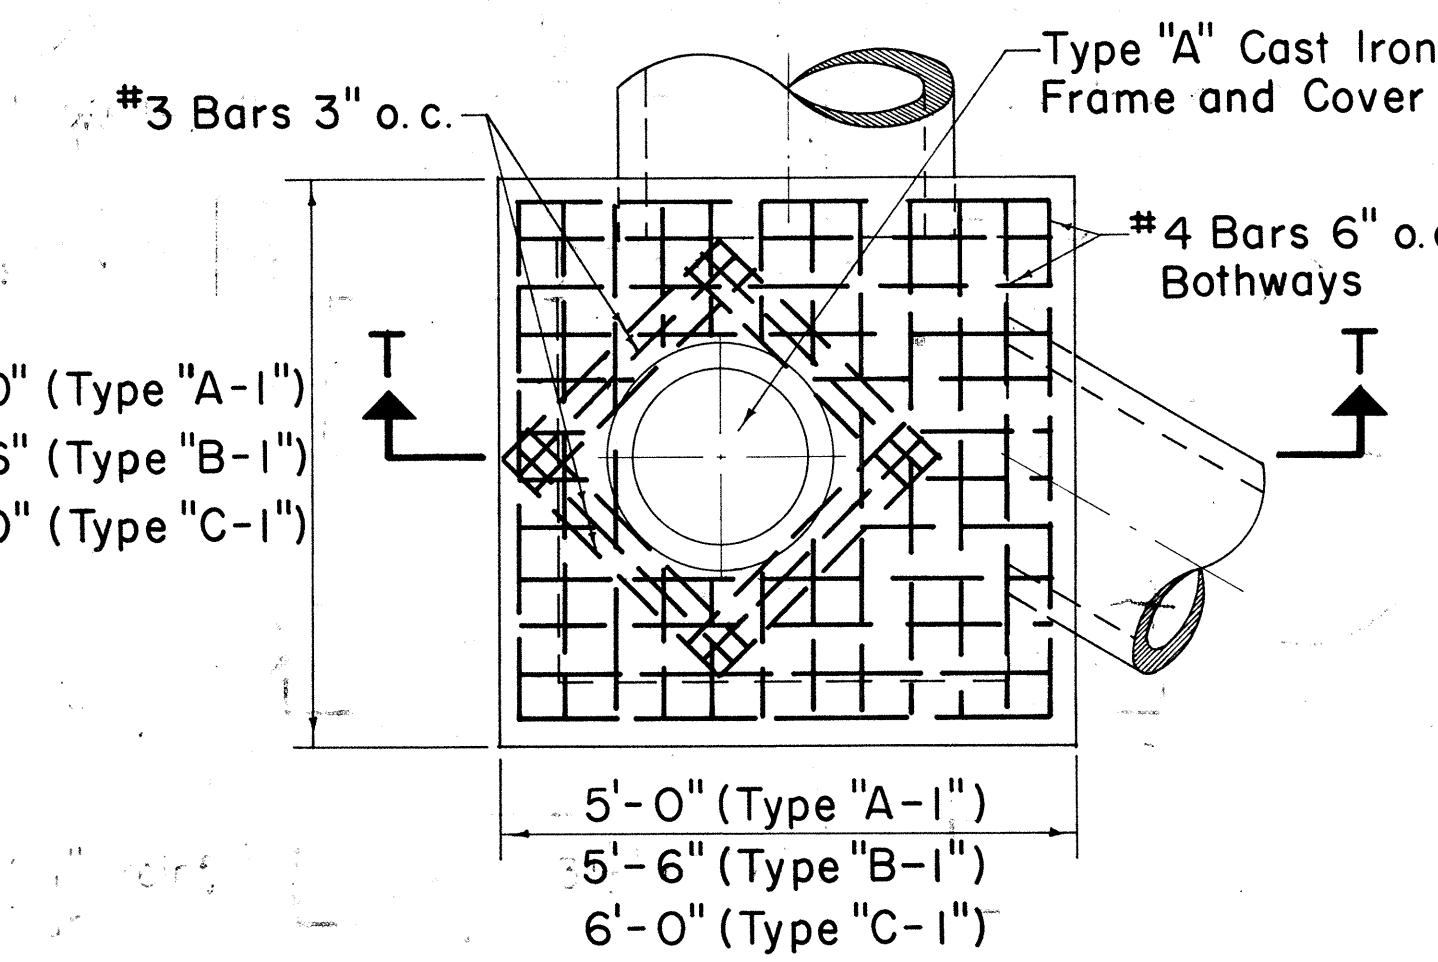

PLAN

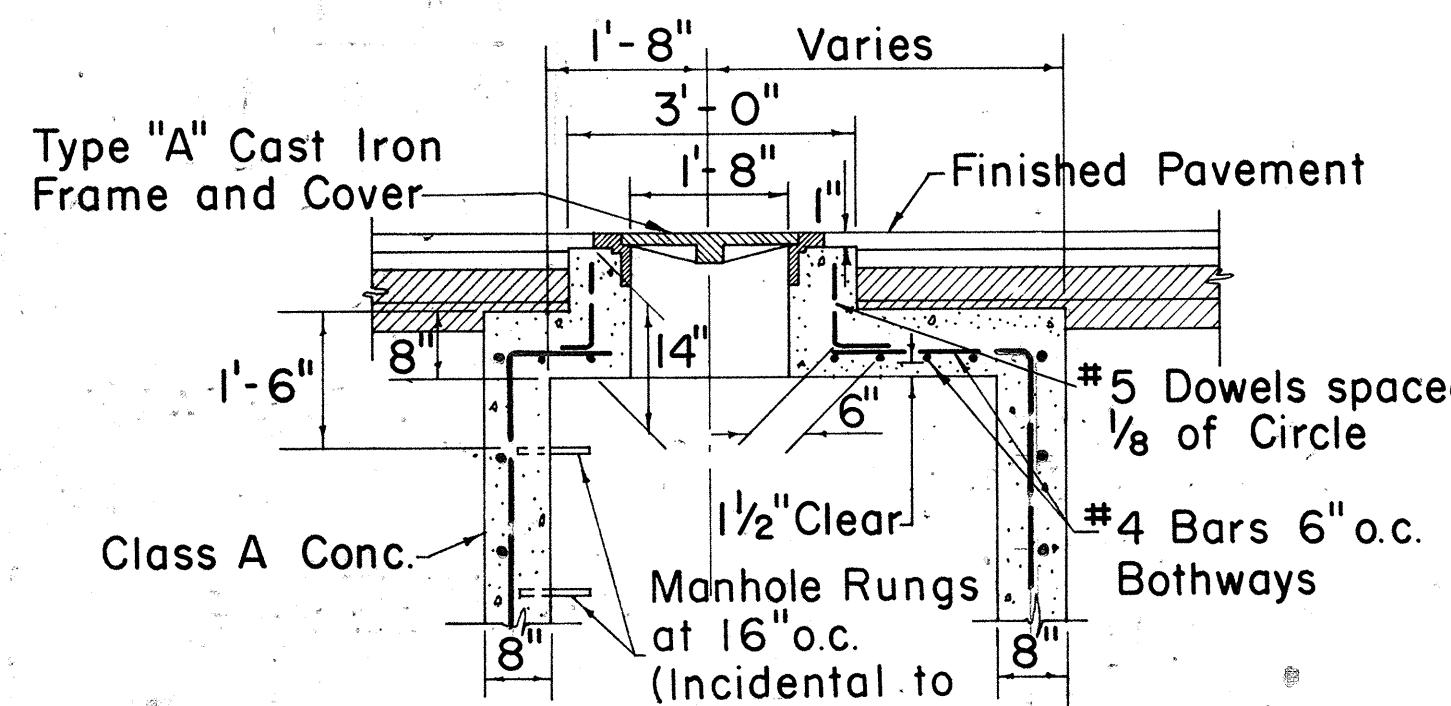

Note: Bottom detail similar to Type "A", "B", & "C".

SECTION T-T


TYPE "A-I", "B-I", & "C-I"
STORM DRAIN MANHOLE
TOP DETAIL UNDER PAVEMENT

Scale: $\frac{1}{2}$ " = 1'-0"


GENERAL NOTES

- I. Culvert shall enter and leave S.D.M.H. from any position and in the direction indicated by the plans or ordered by the Engineer.
 2. Manhole Rungs (16" o.c.) are required when "H" is greater than 4'-6". Only one rung (12" from the bottom) is required if "H" is 4'-6" or less. Type "A" C.I. Frame and Cover and Manhole Rungs may be placed at any location as ordered by the Engineer.


3. SEE SHEET 71 FOR GENERAL CONCRETE NOTES AND DETAILS.

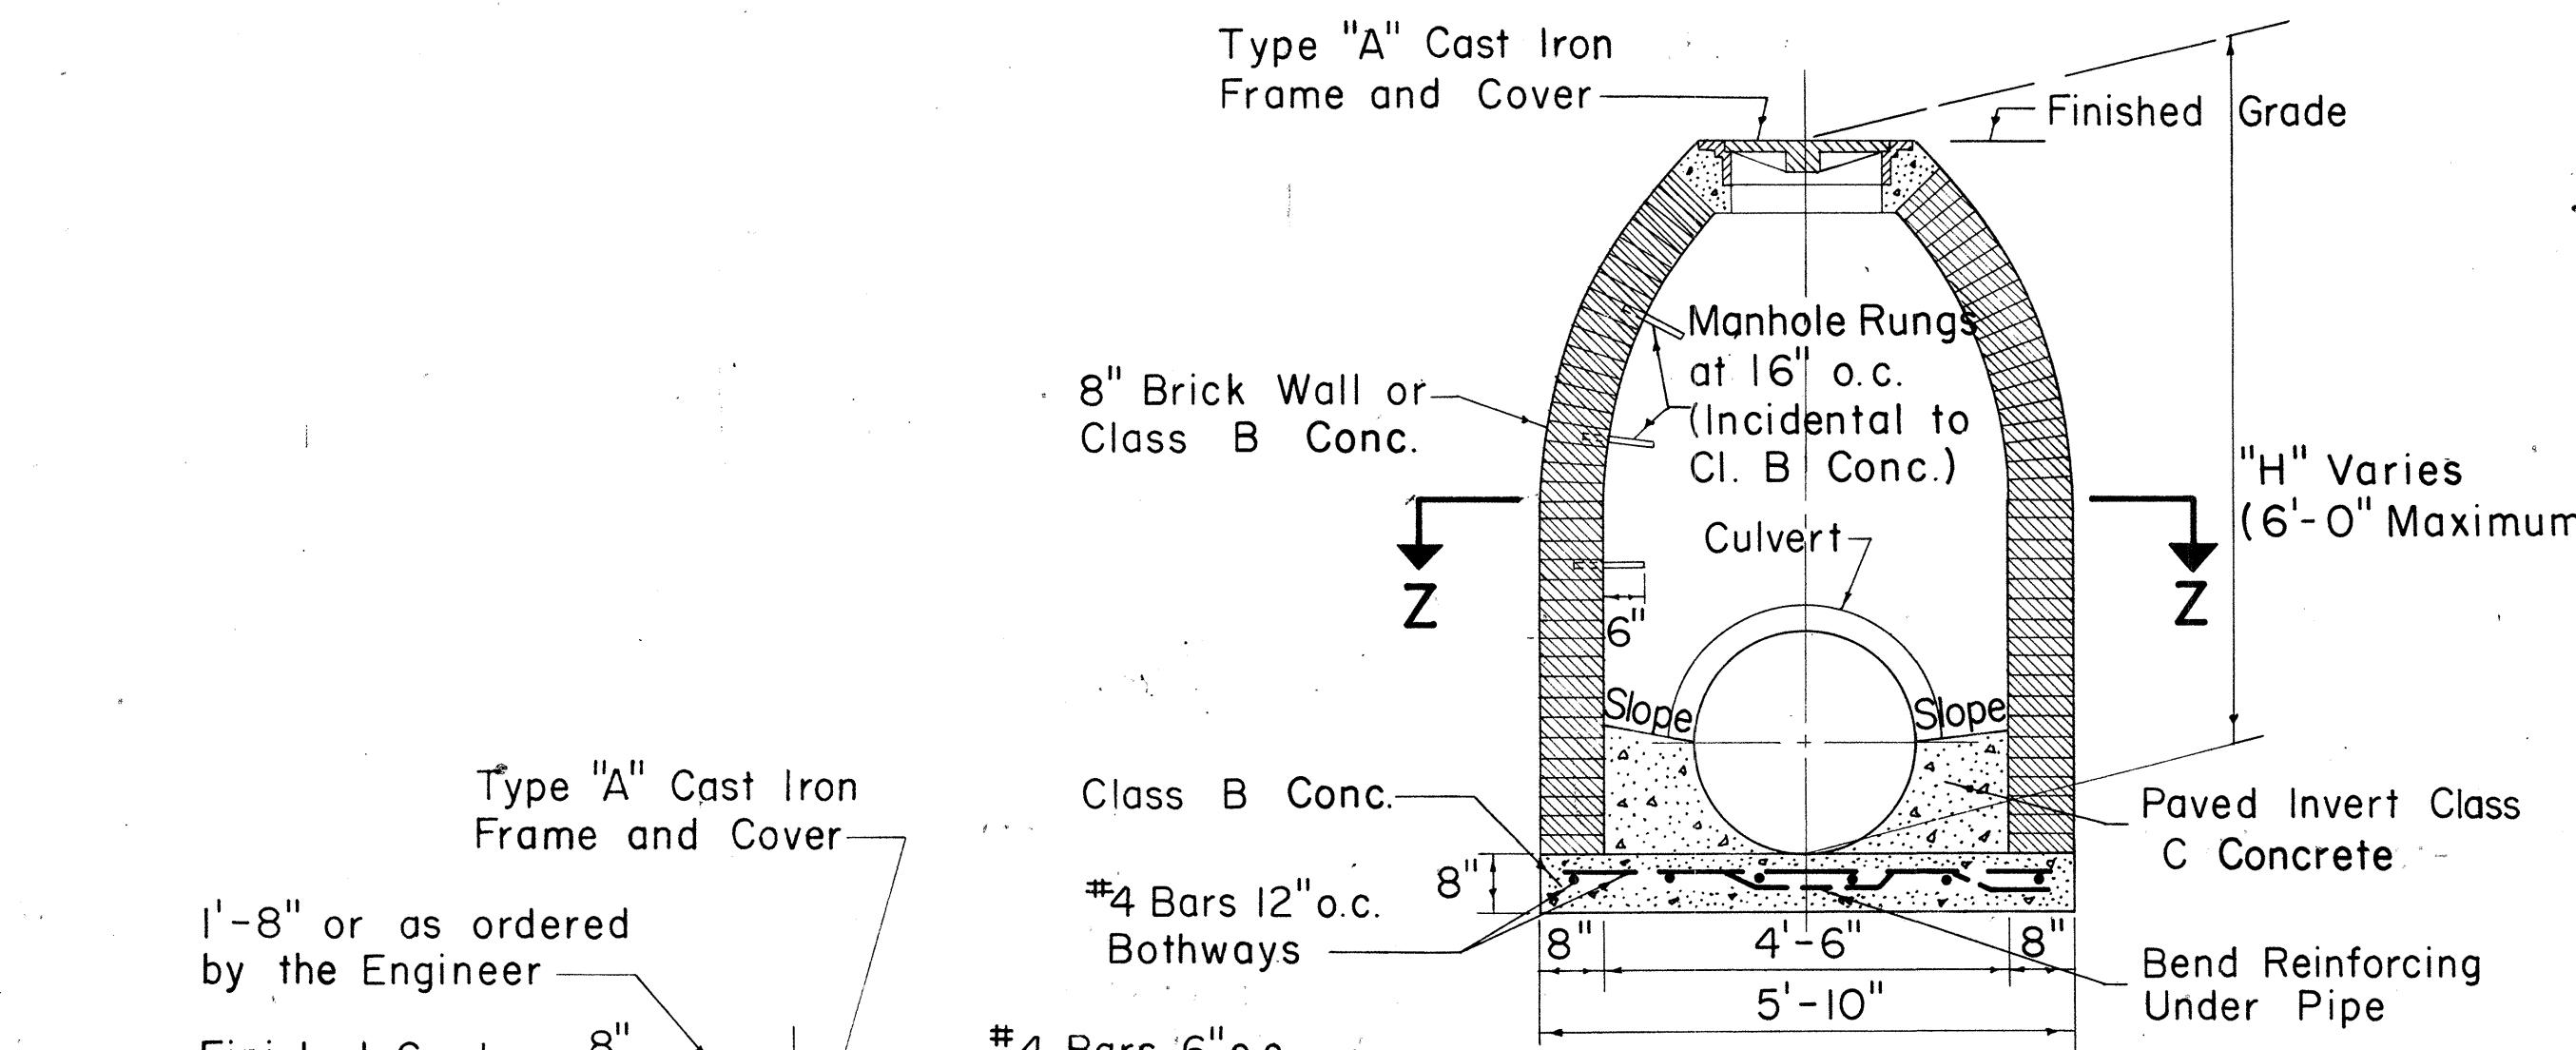

tion Y-Y

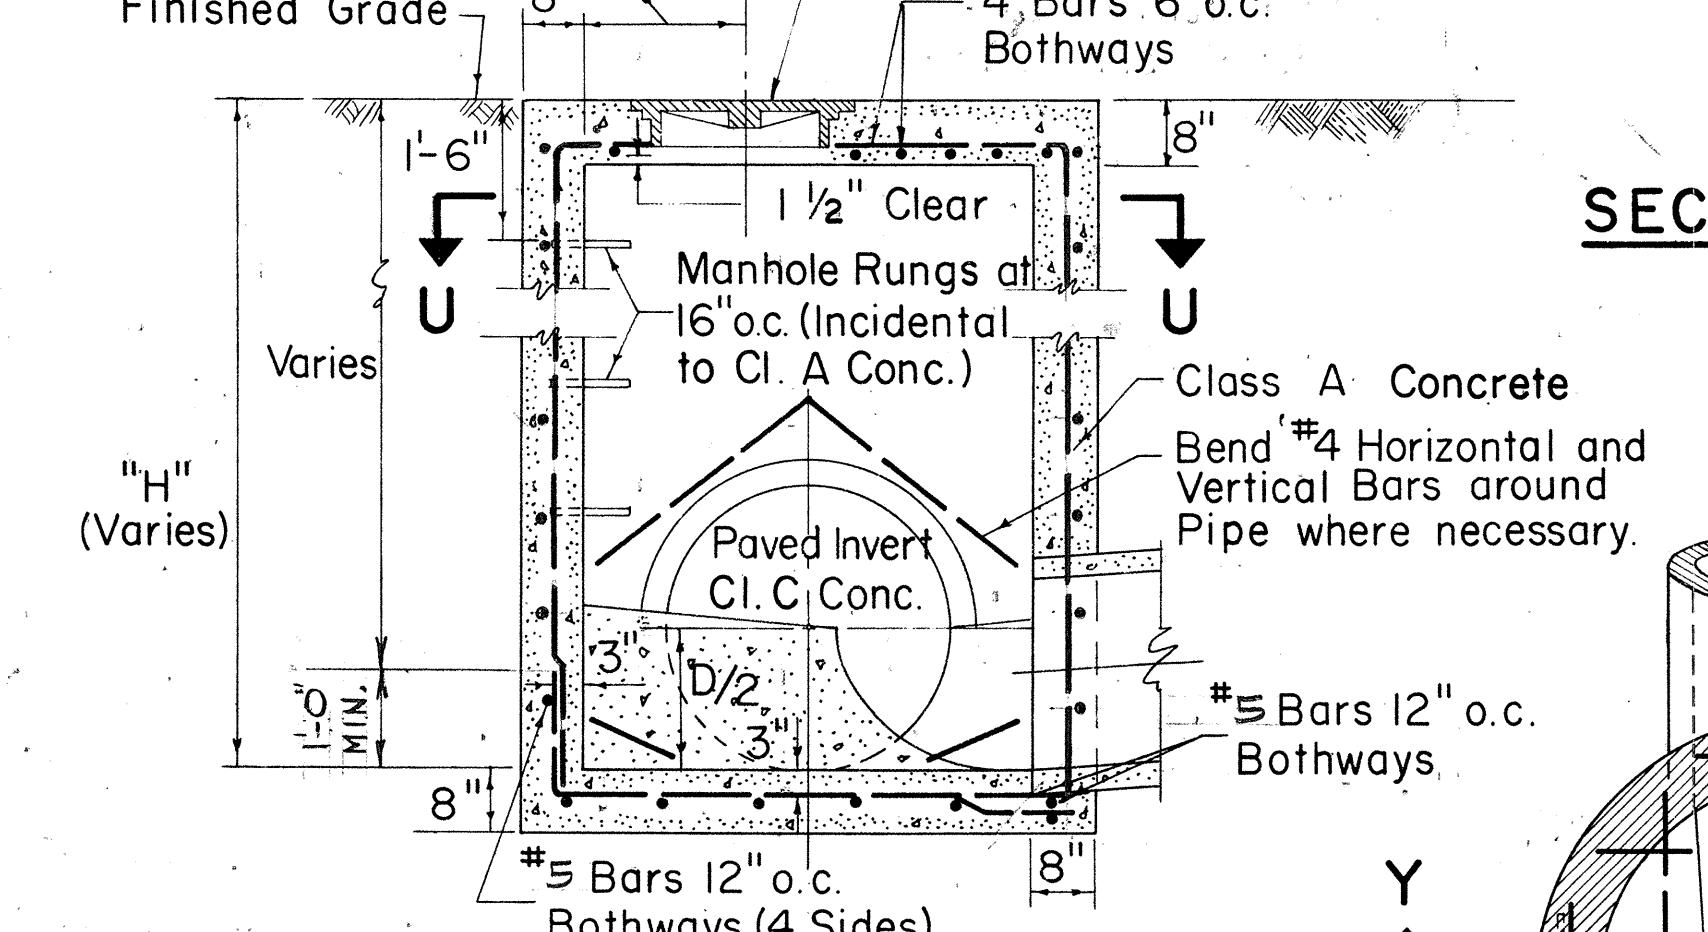


SECTION V-V

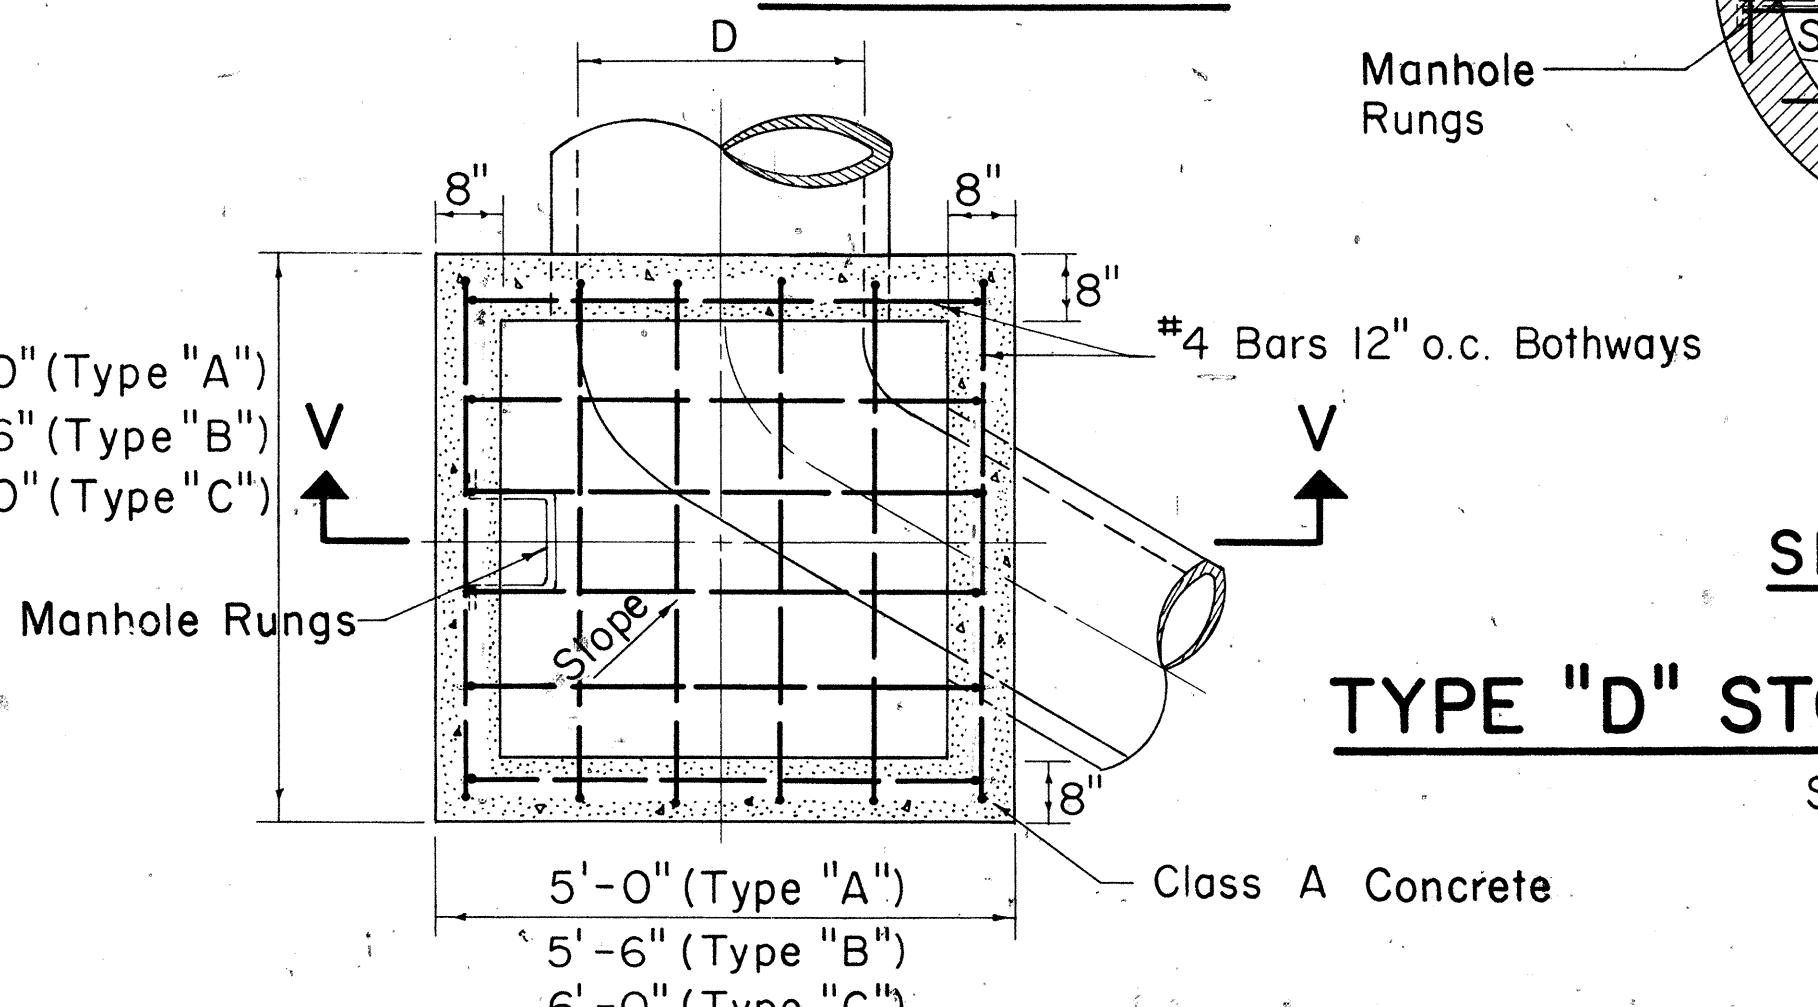


SECTION Z-Z

TYPE "D" STORM DRAIN MANHOLE


Scale: $\frac{1}{2}'' = 1'-0''$

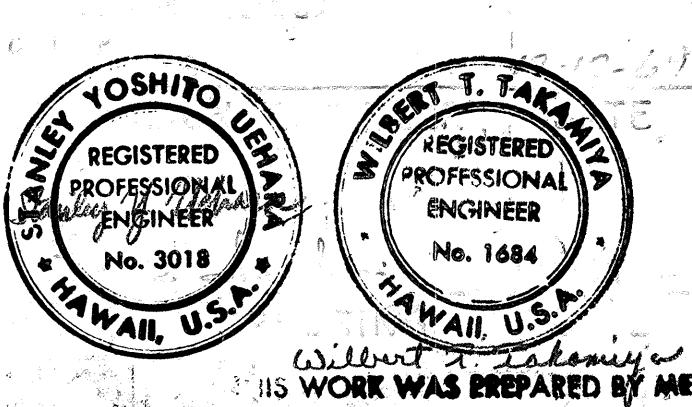

Wilbert A. Lachmeyer
HIS WORK WAS PREPARED BY ME
OR UNDER MY SUPERVISION

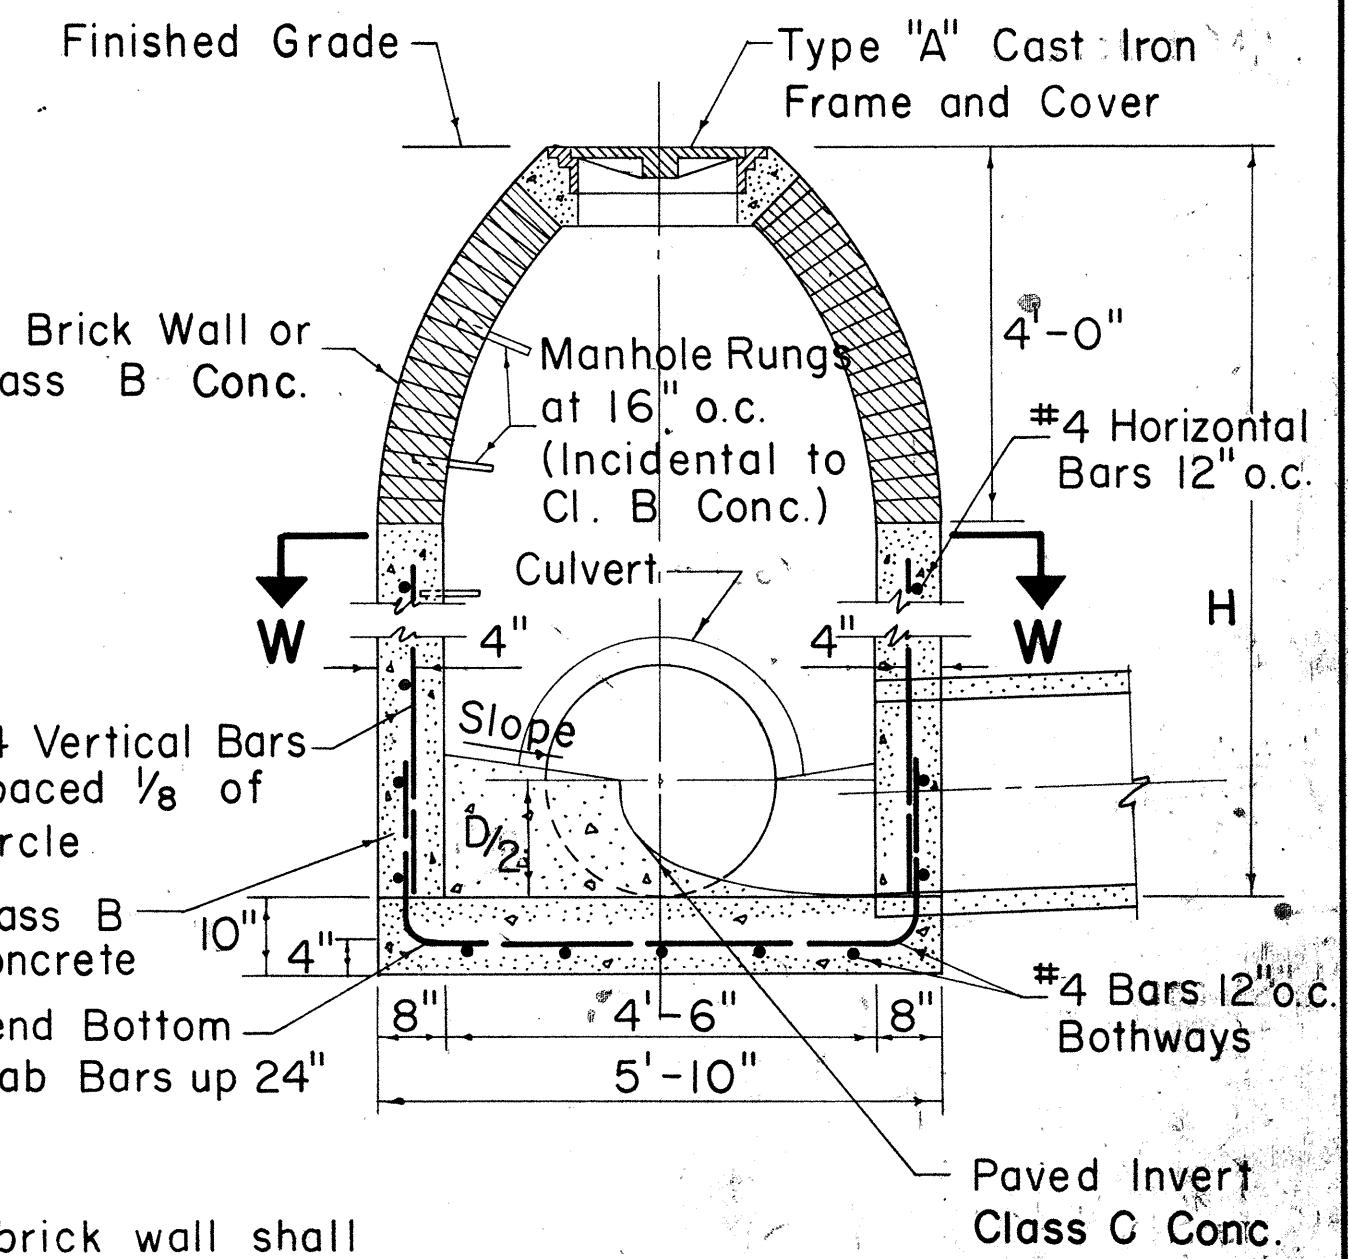

SECTION X-X

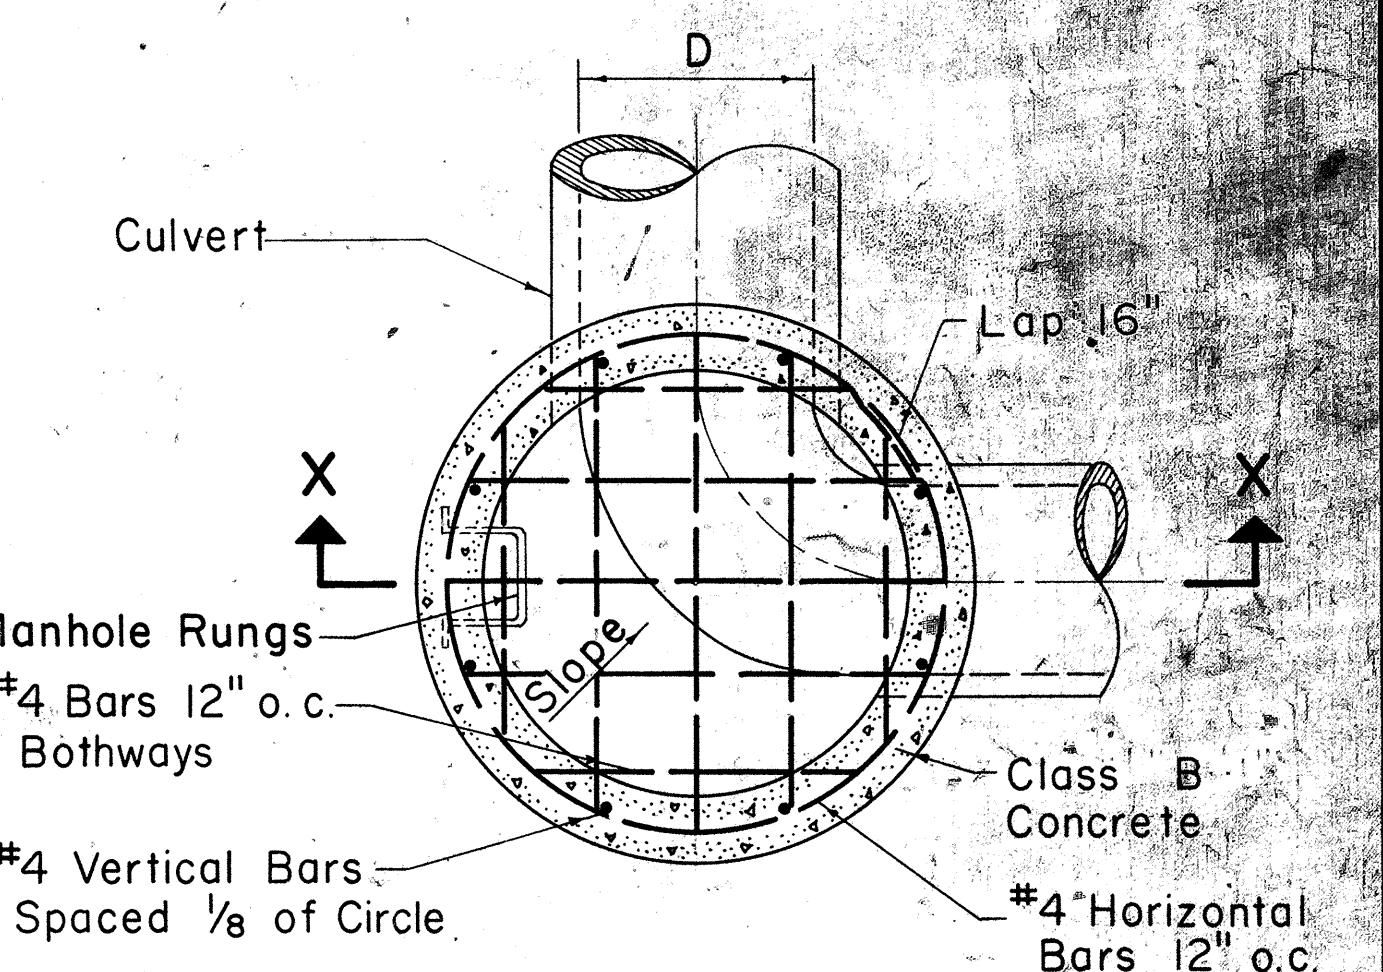

SECTION W-W

TYPE "F" STORM DRAIN MANHOLE


Scale: $\frac{1}{6}'' = 1' = 0''$

STATE OF HAWAII
DEPARTMENT OF TRANSPORTATION
HIGHWAYS DIVISION

STORM DRAIN MANHOLES


Scales: As Noted Date: July 1, 1969

FED. ROAD DIST. NO.	STATE	FED. AID PROJ. NO.	FISCAL YEAR	HEET NO.	TOTAL SHEETS
HAWAII	HAW.	I-HI-1(3):15	1974	78	369

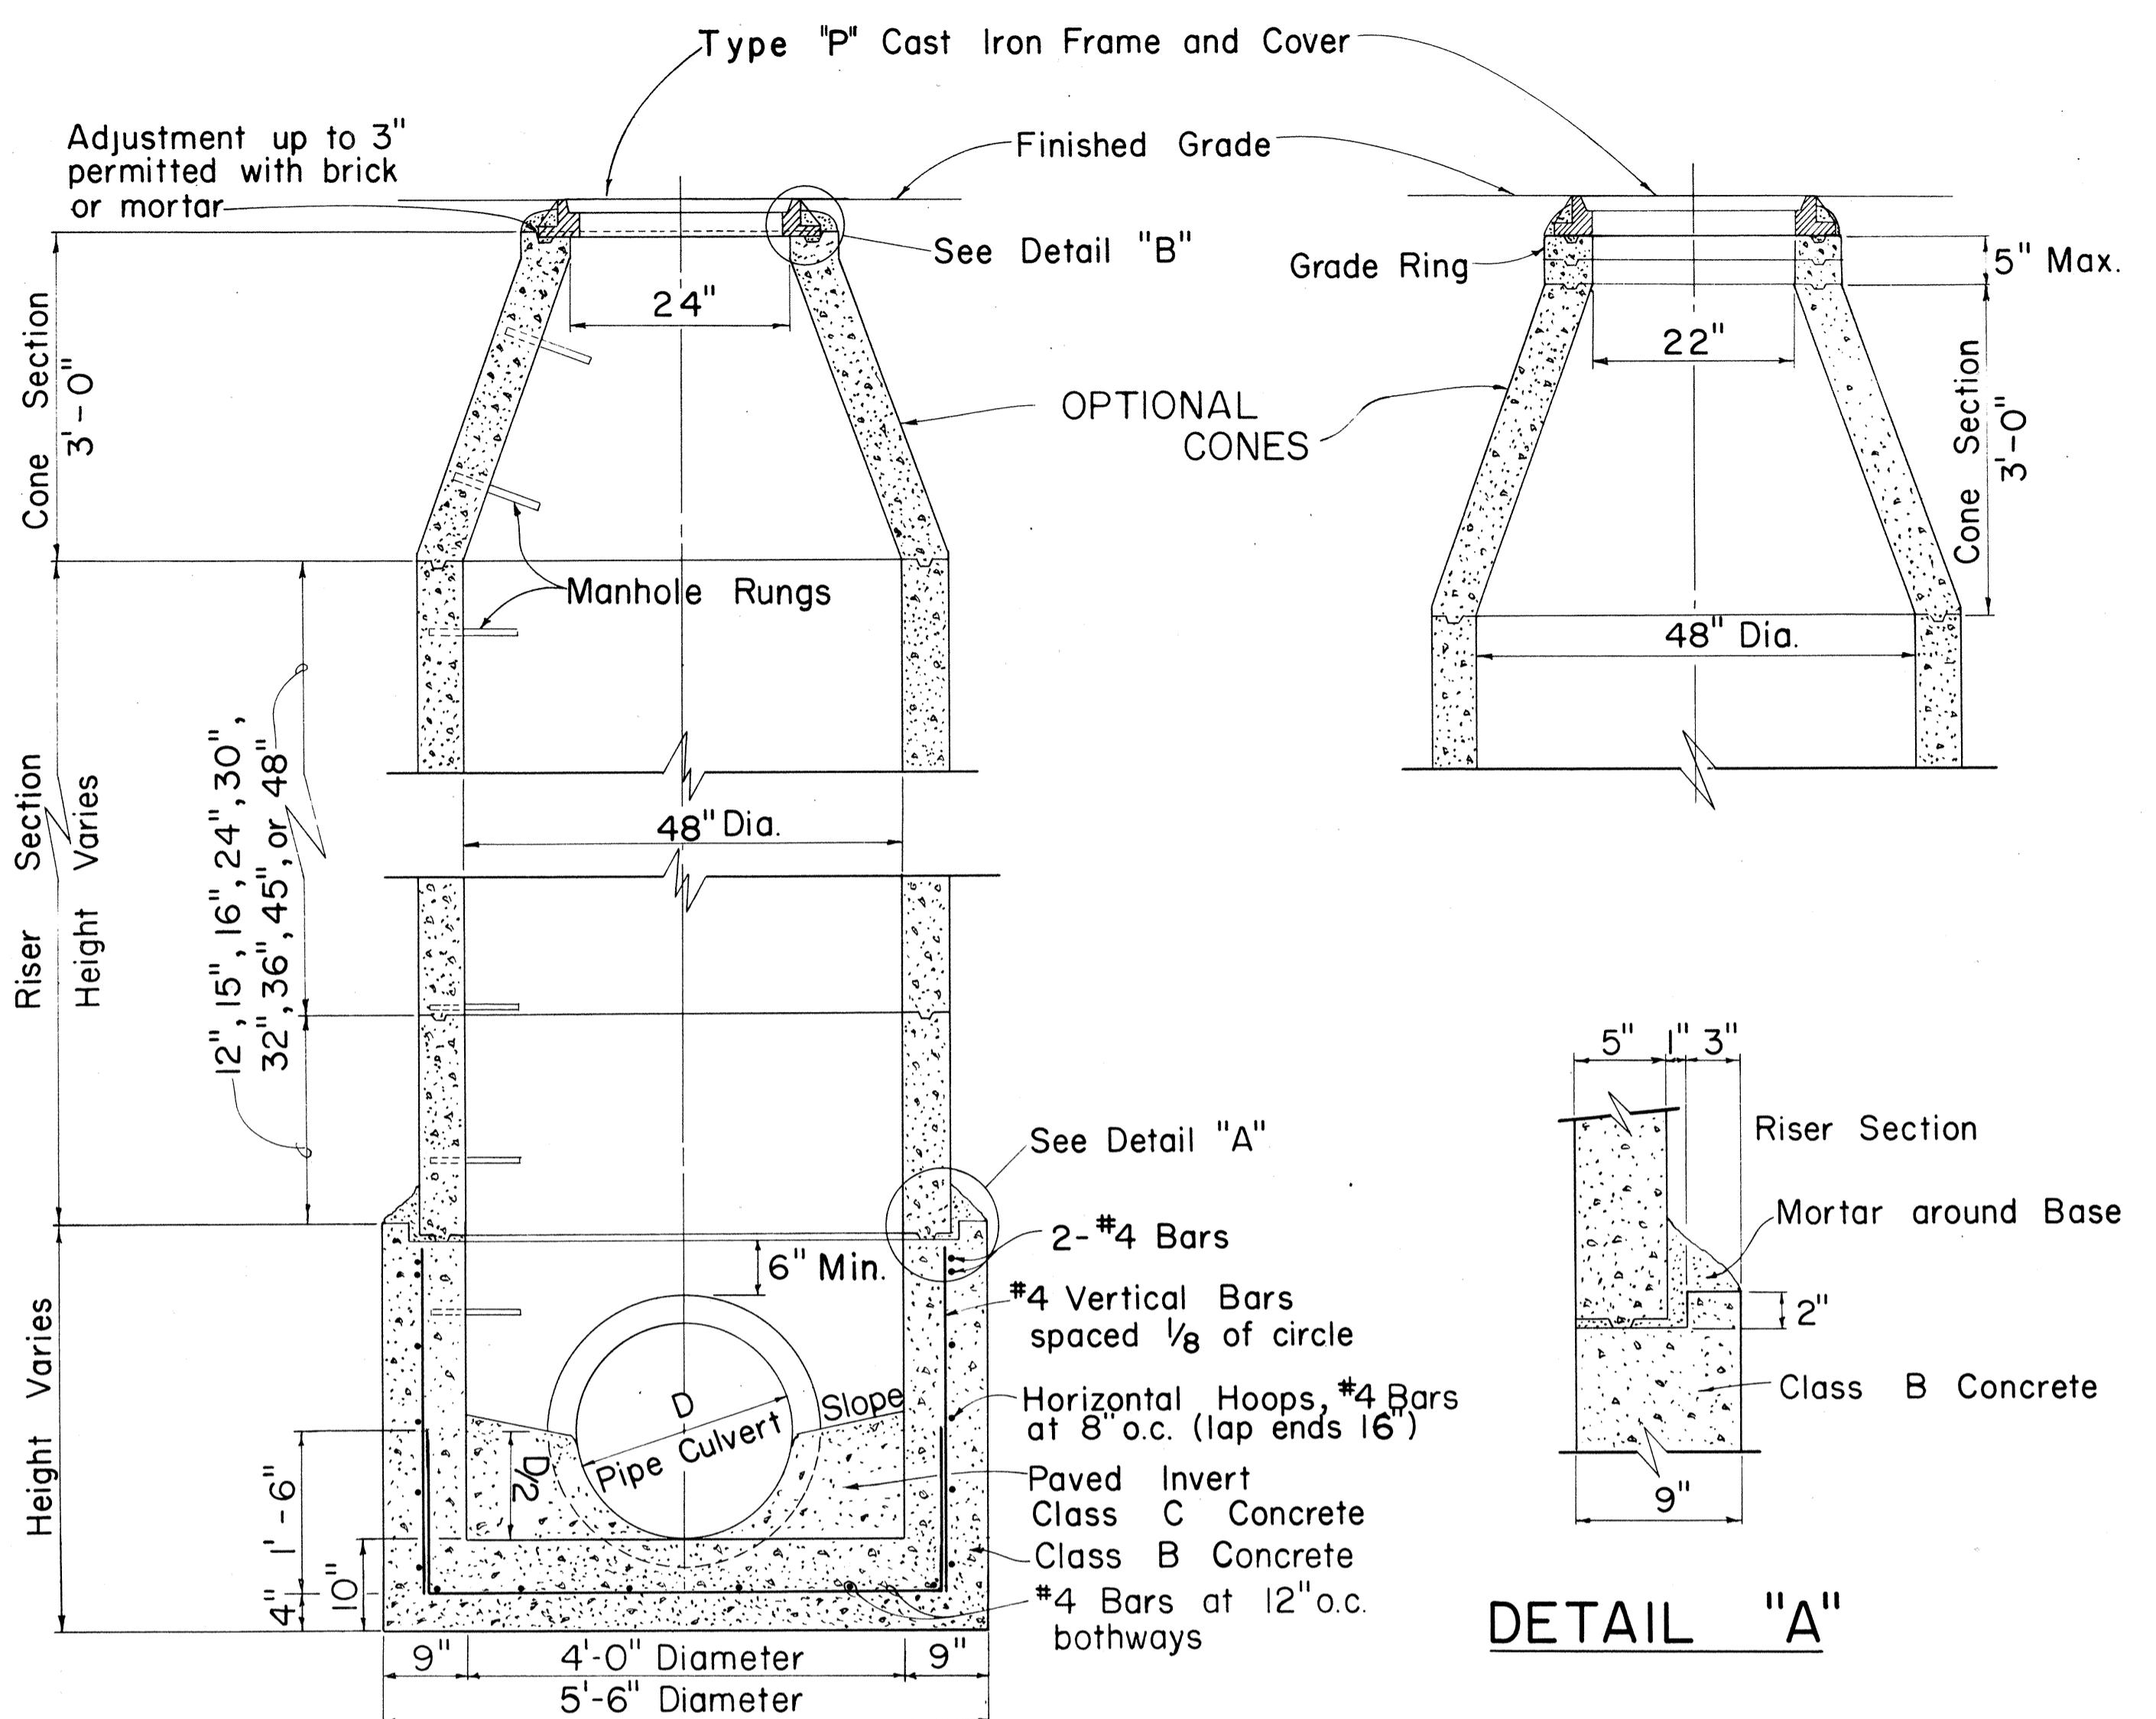


TYPICAL SECTIONS PRECAST CONCRETE MANHOLE

Not to Scale

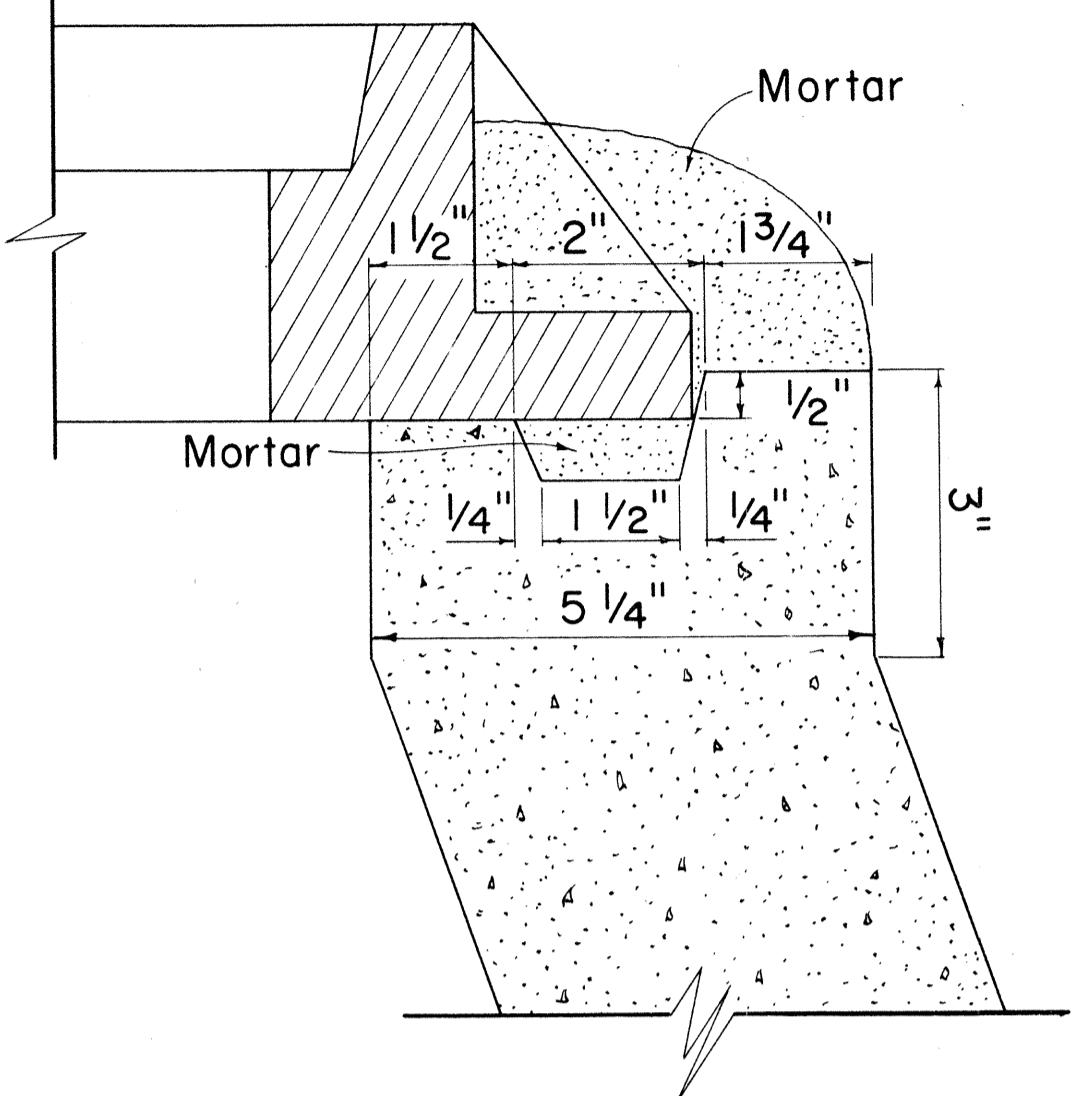


DETAIL "B"

Not to Scale

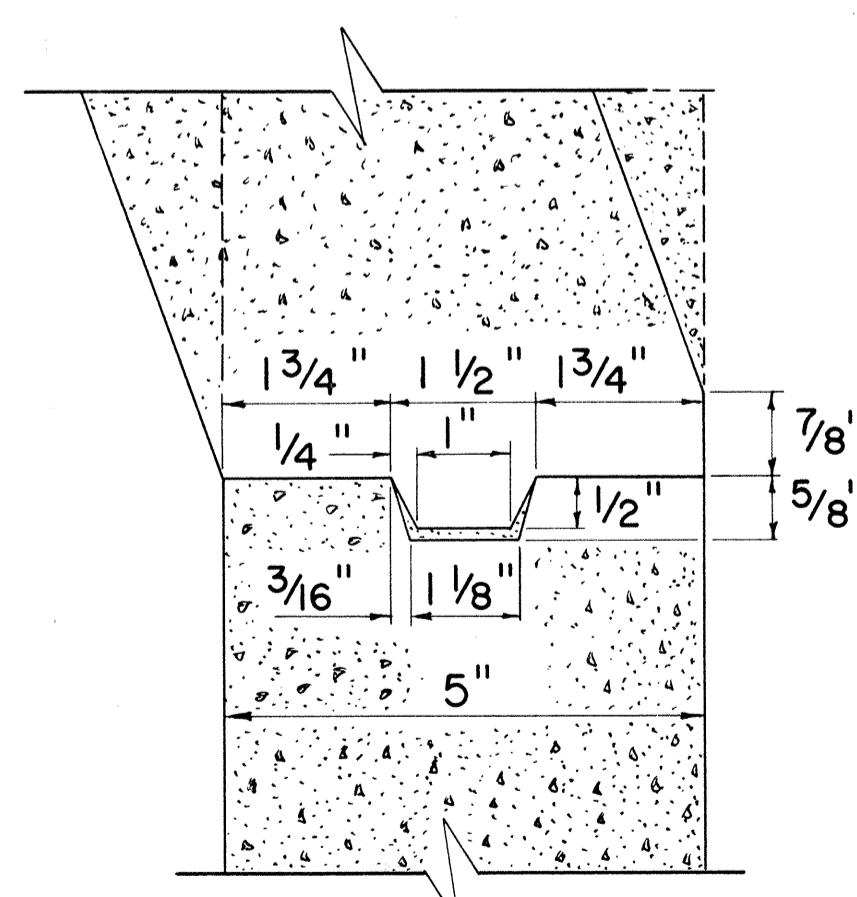

DETAIL FOR RISER JOINTS

Not to Scale

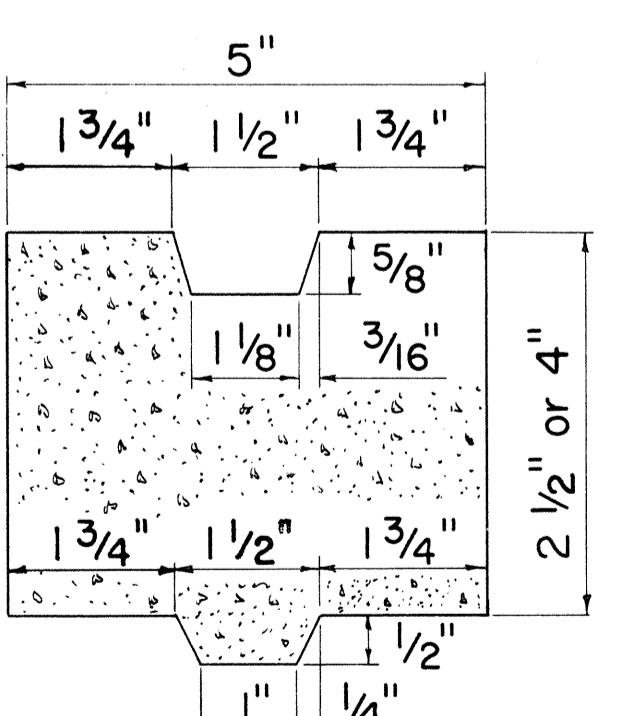

GRADE RING DETAIL

Not to Scale

GENERAL NOTES

- Manhole Rungs to be placed at 15" or 16" o.c. (Manhole Rungs incidental to Class B Concrete) For detail of M.H. rungs see sheet DH-6
- Select appropriate combination of risers and grade rings for required height.
- All joints to be grouted as set.
- The precast sections shall be constructed in accordance with the details shown on the plans and to the requirements of ASTM C 478
- Manufacturers may submit to the Engineer for approval, prior to manufacturing, designs other than those shown on this sheet.
- Reinforcing steel for precast sections shall be placed in accordance with the requirements of ASTM C 478
- All Class C Concrete to be incidental to Class B Concrete.






NO.	REVISION	APPROVED BY	DATE

APPROVAL RECOMMENDED:
G. Nakano
 HYDRAULIC DESIGN ENGINEER
 DATE: 2-2-71

APPROVED:
C. S. Reid
 ASSISTANT CHIEF, ENGINEERING
 DATE: 2-25-71

STATE OF HAWAII
 DEPARTMENT OF TRANSPORTATION
 HIGHWAYS DIVISION
STANDARD DETAILS
PRECAST CONCRETE
STORM DRAIN MANHOLES
 Not to Scale Date: Nov., 1970
 SHEET NO. 12 OF 17 SHEETS DH 5A

FED. ROAD DIST. NO.	STATE	FED. AID PROJ. NO.	FISCAL YEAR	SHEET NO.	TOTAL SHEETS
HAWAII	HAW.	I-H-I(73):15	1974	79	369

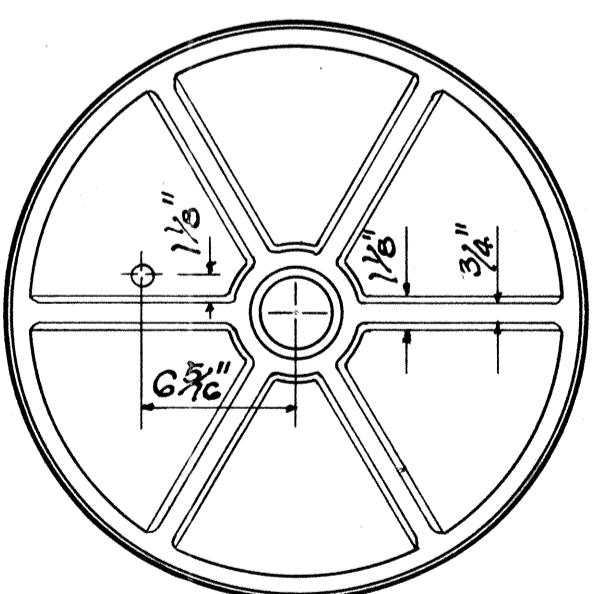
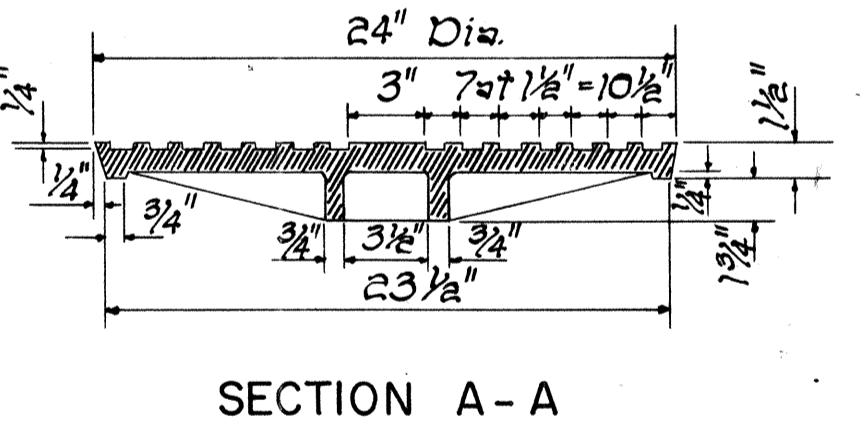
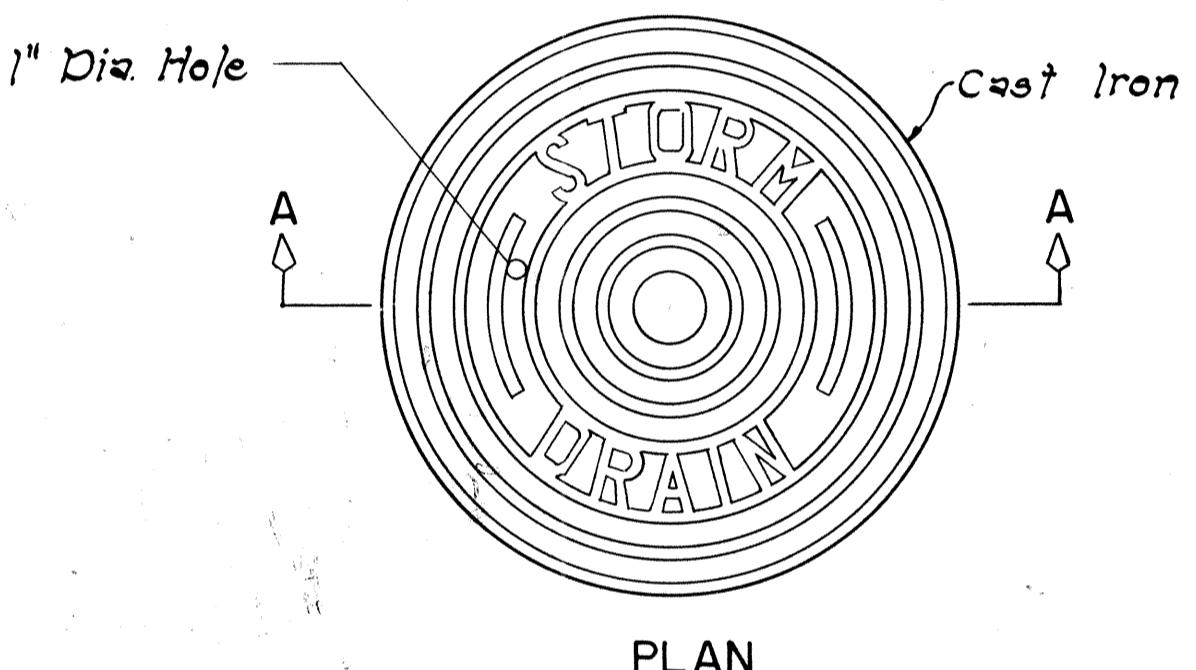
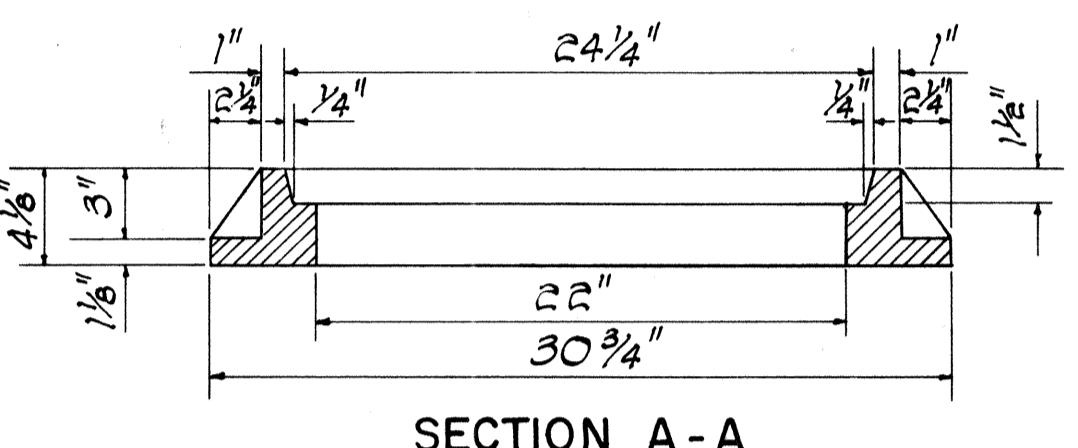
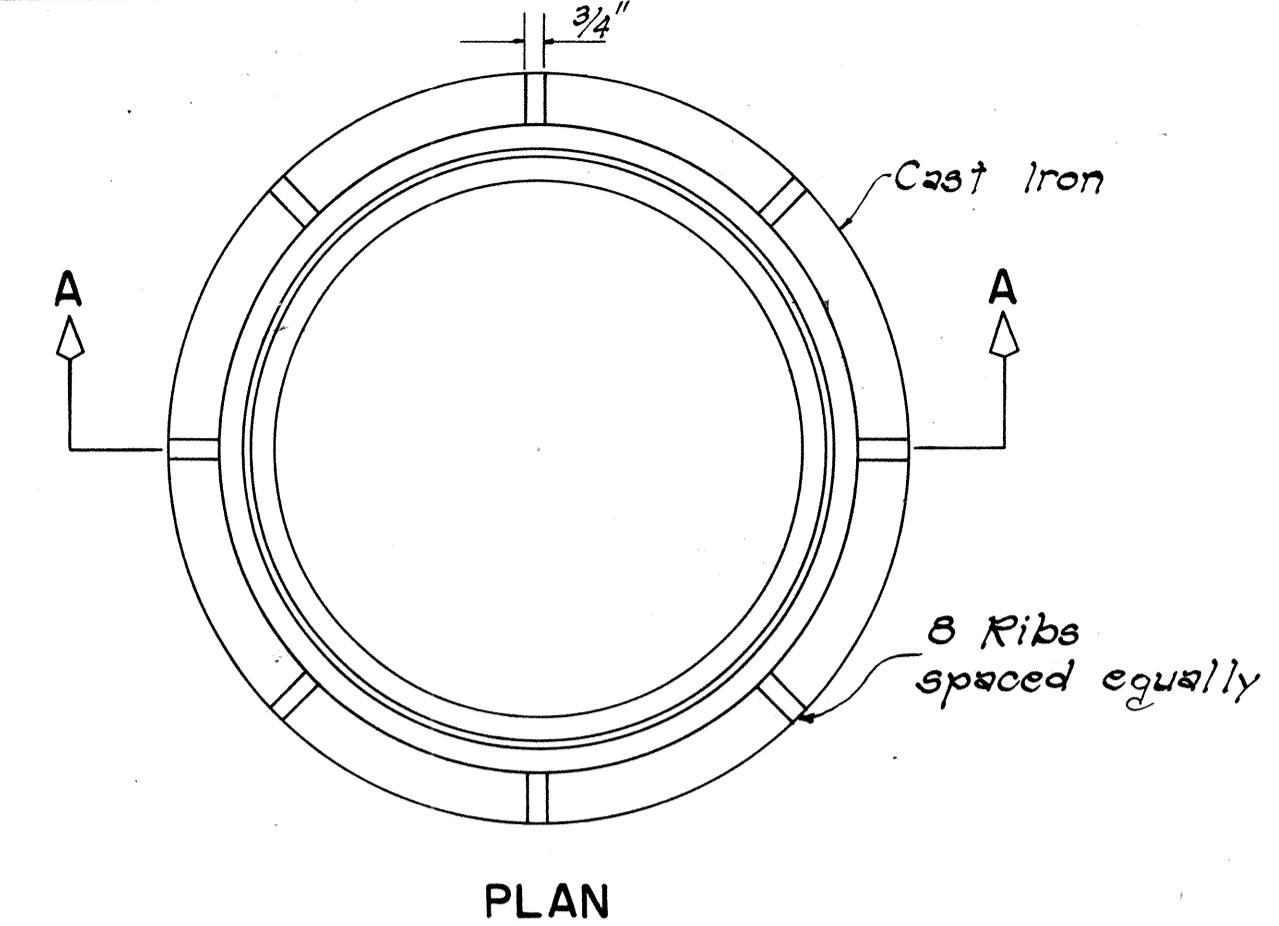


BOTTOM VIEW OF COVER

DETAILS OF TYPE "P"

CAST IRON FRAME AND COVER

SCALE: 1-1/2" = 1'-0"

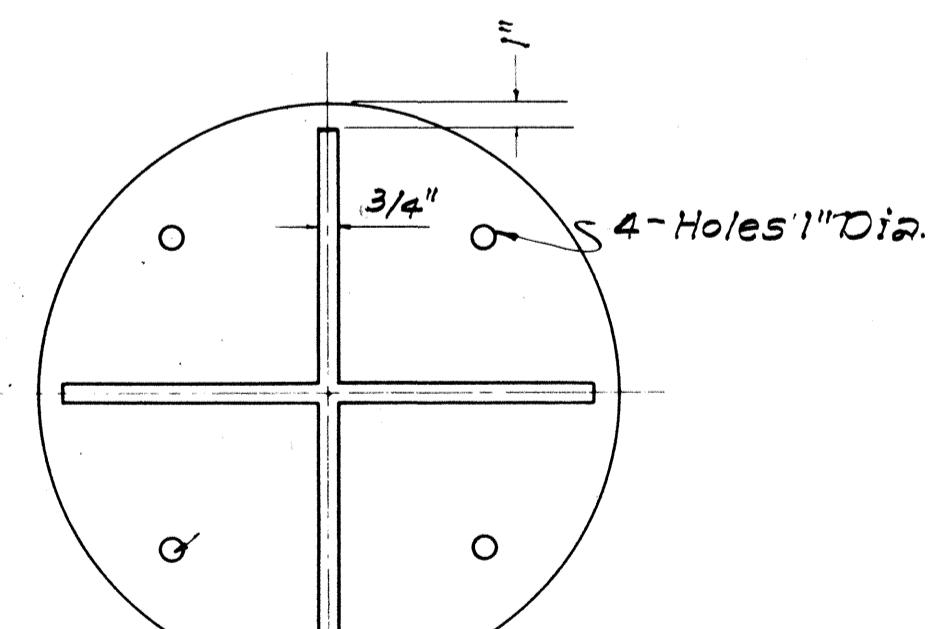
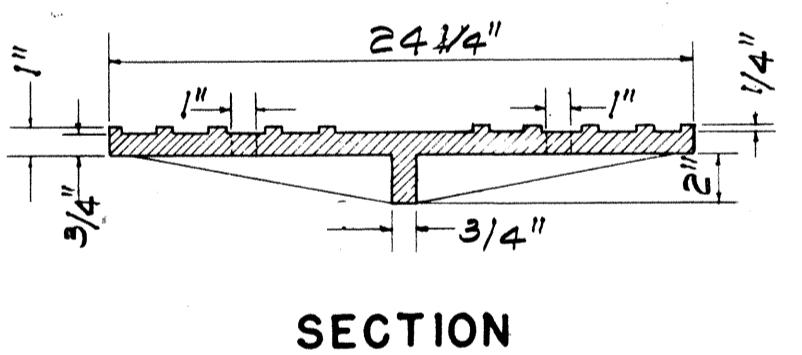
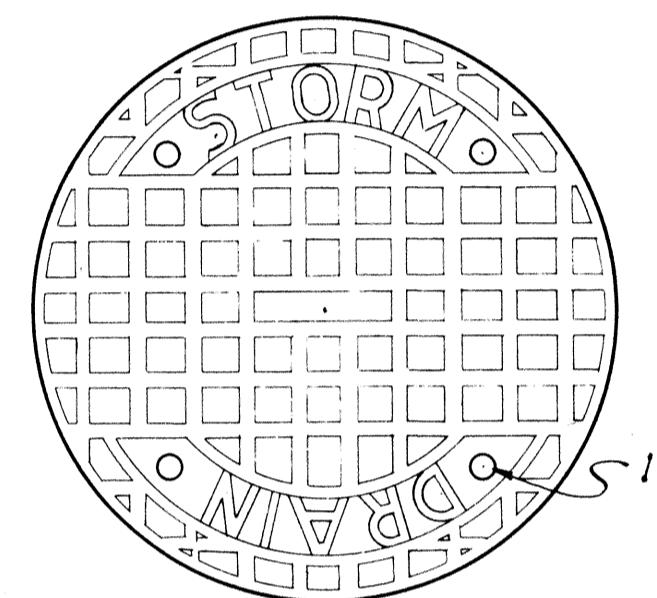
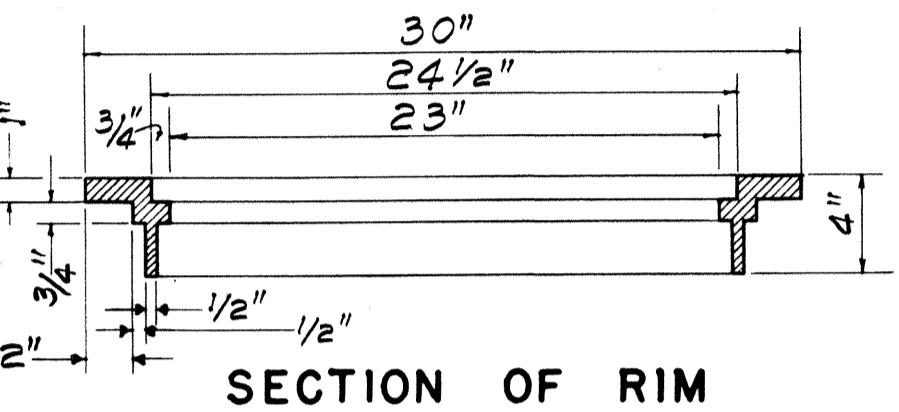
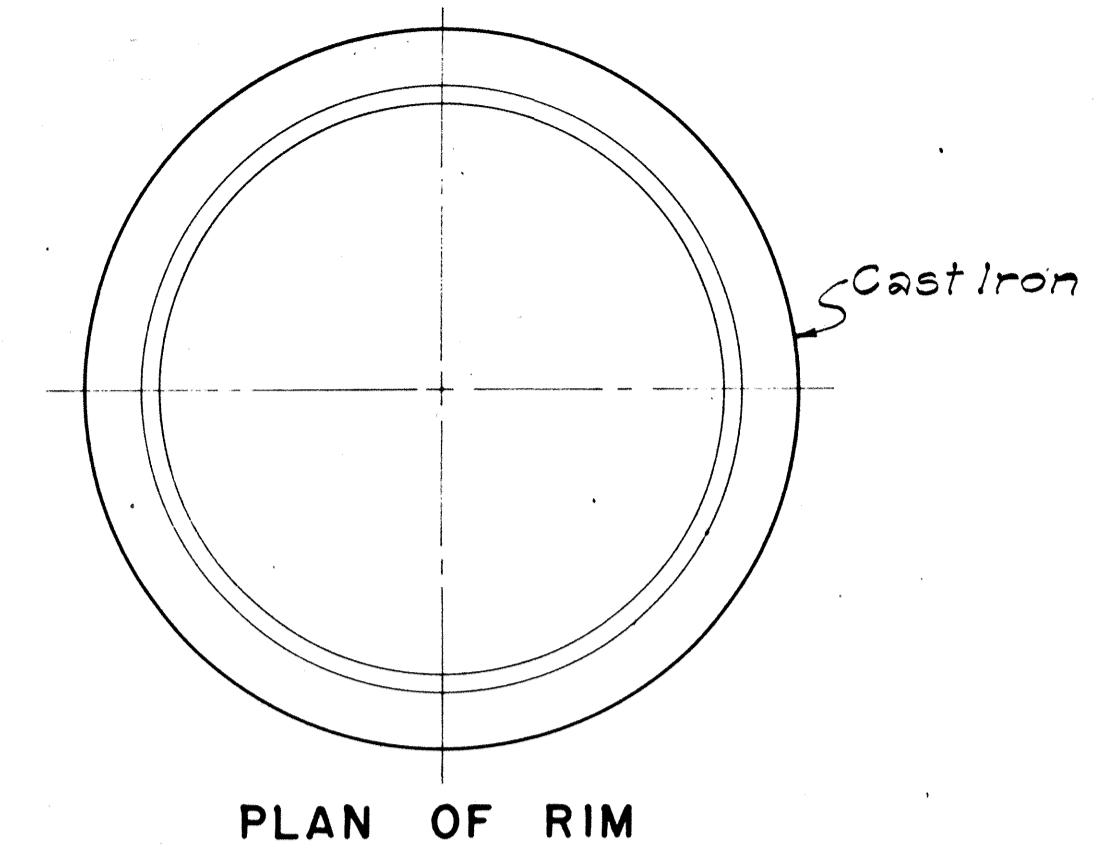


BOTTOM VIEW OF COVER

DETAILS OF TYPE "B"

CAST IRON FRAME AND COVER

SCALE: 1-1/2" = 1'-0"

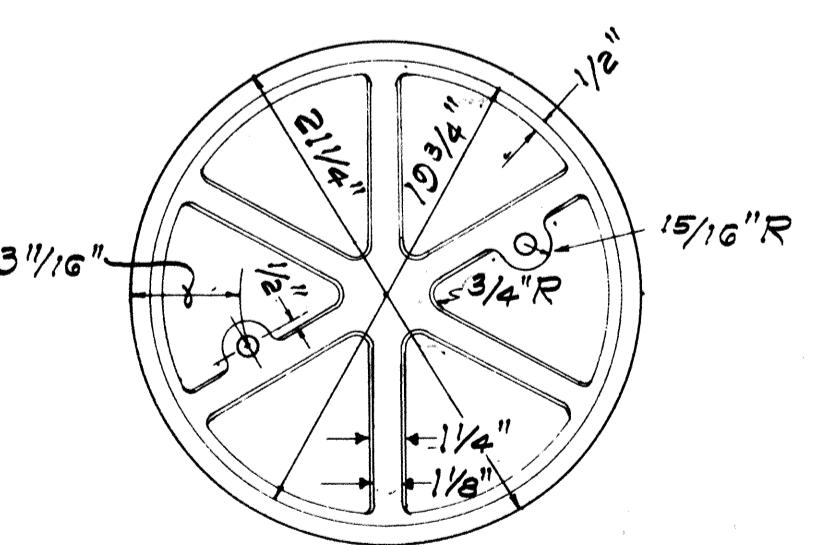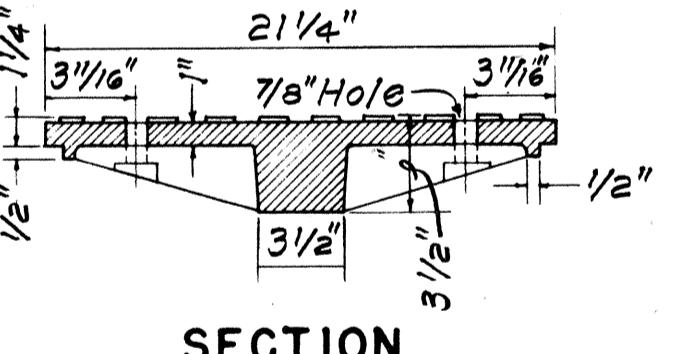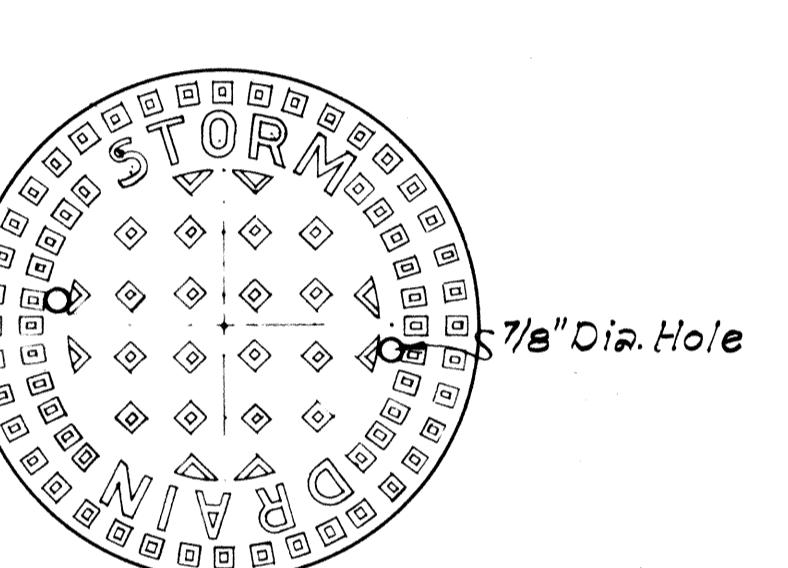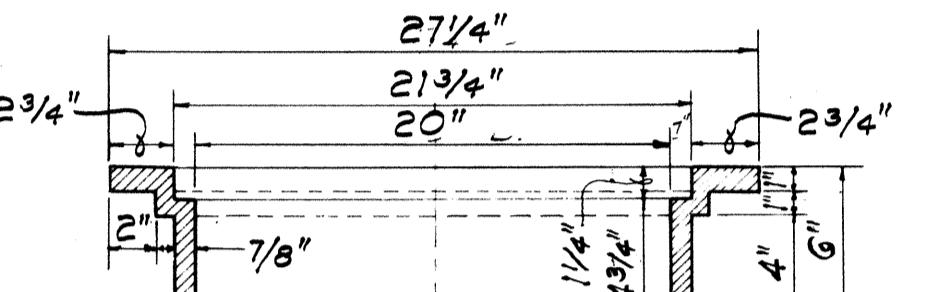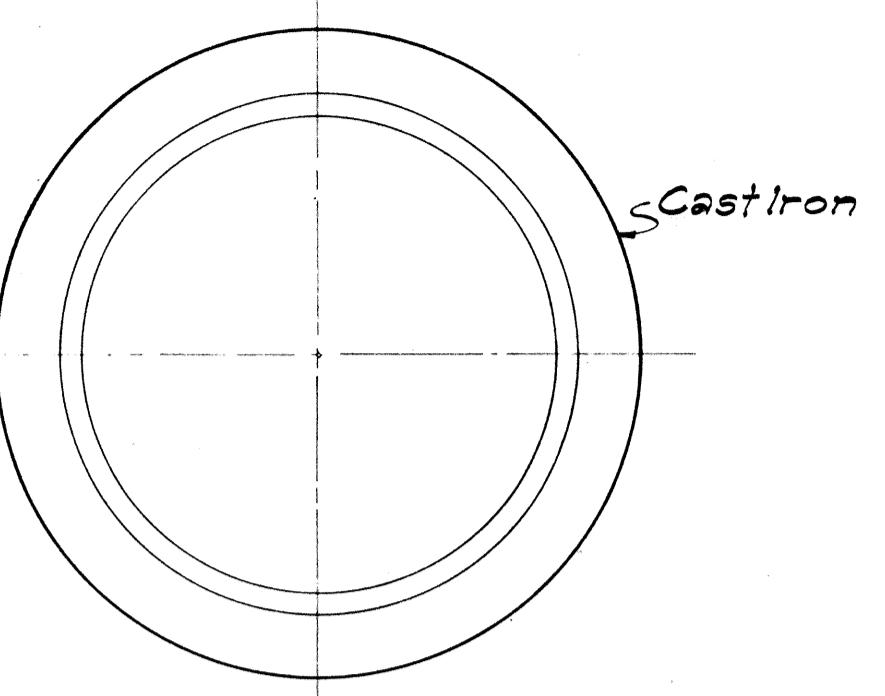


BOTTOM VIEW OF COVER

DETAILS OF TYPE "A"

CAST IRON FRAME AND COVER

SCALE: 1-1/2" = 1'-0"

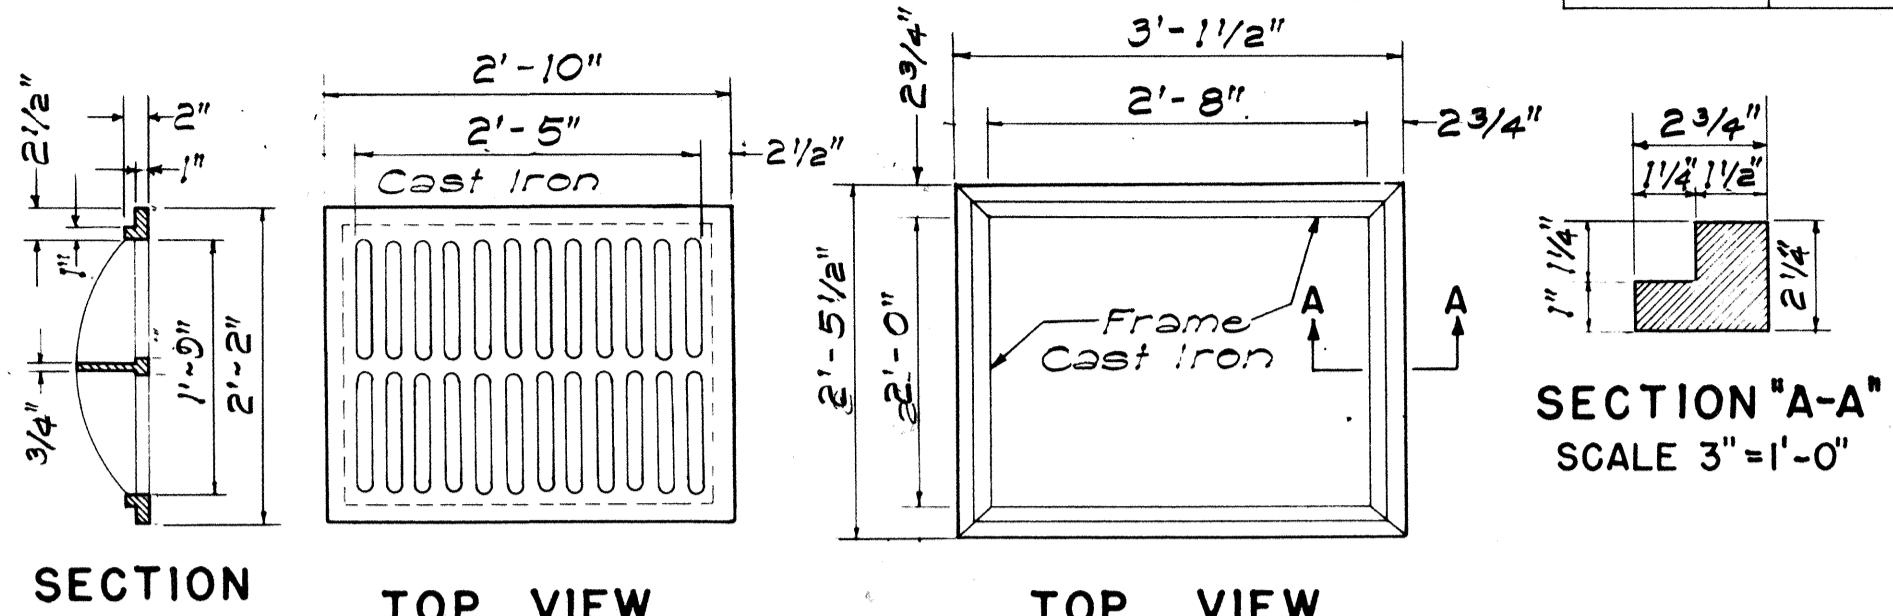


TYPE C C.I. FRAME AND GRATE

SCALE: 3/4" = 1'-0"

TOP VIEW

TOP VIEW

SECTION

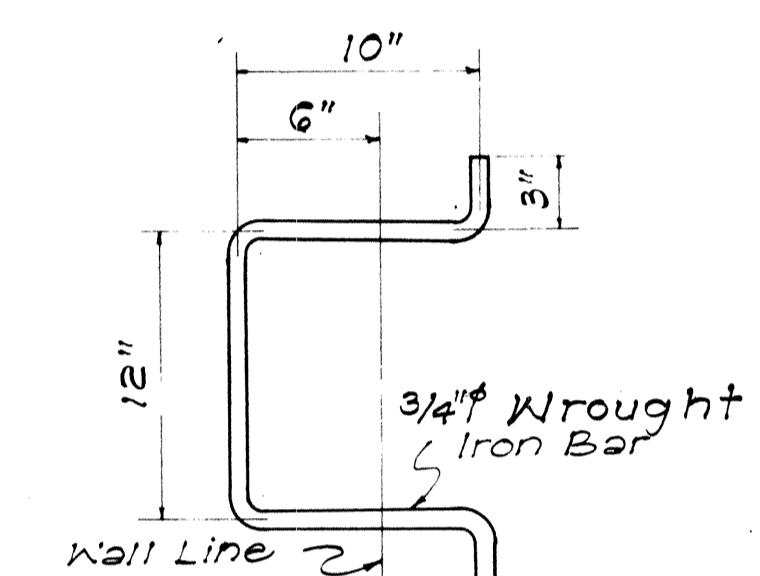

SCALE: 1-1/2" = 1'-0"

APPROVAL RECOMMENDED:
R. Takao
HYDRAULIC DESIGN ENGINEER

12-17-69
DATE


APPROVED:
R. Takao
ASSISTANT CHIEF, ENGINEERING

12-17-69
DATE


NO.	REVISION	APPROVED BY	DATE
I.	Detail of Type "P" Cast Iron Frame and Cover	H.T.	1-6-71

STATE OF HAWAII DEPARTMENT OF TRANSPORTATION HIGHWAYS DIVISION			
STANDARD DETAILS CATCH BASIN AND MANHOLE CASTINGS			
Scale: As Noted Date: July, 1969 SHEET NO 13 OF 17 SHEETS DH 6			

FED. ROAD DIST. NO.	STATE	FED. AID PROJ. NO.	FISCAL YEAR	SHET. NO.	TOTAL SHEETS
HAWAII	HAW.	I-H-I(73)15	1974	80	369

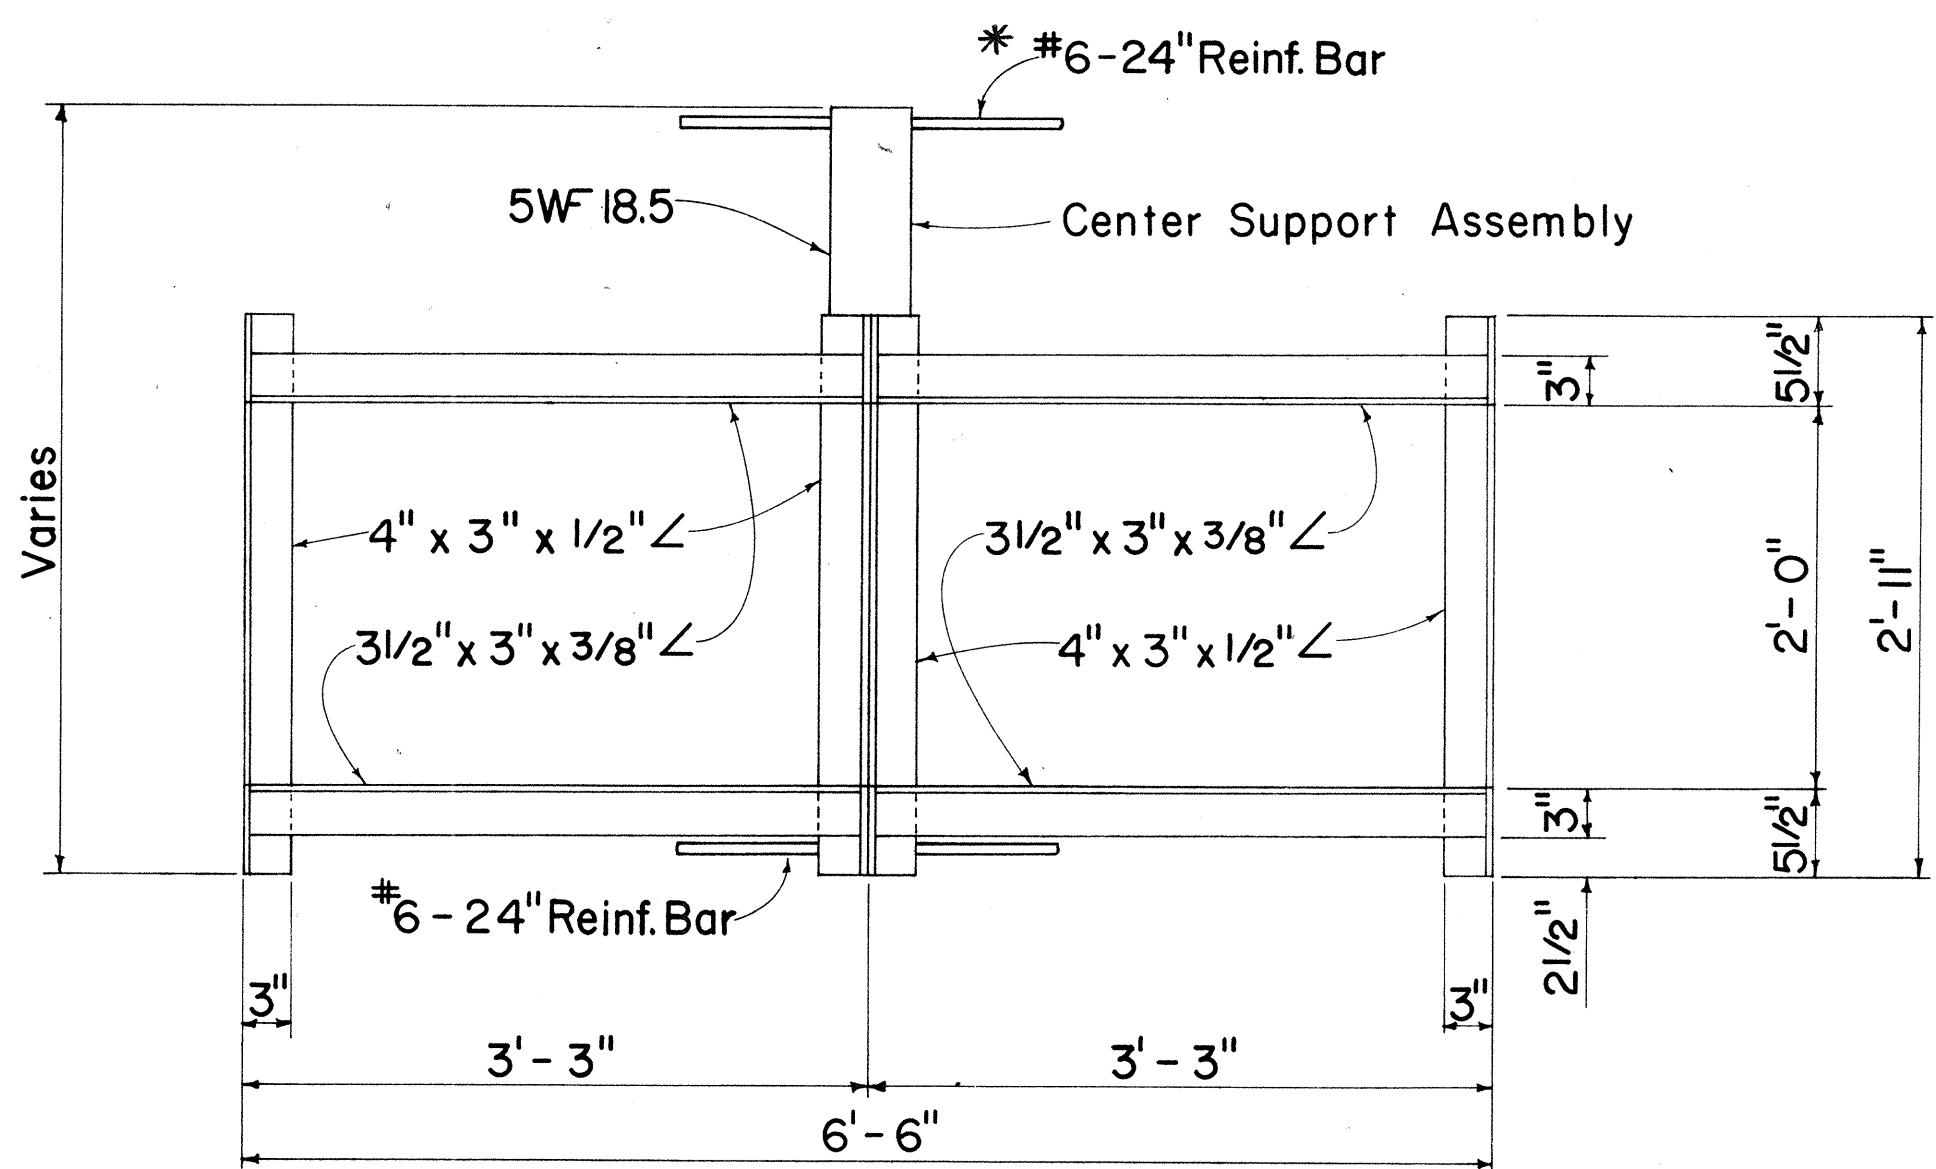


PLAN
(Two or More Grates)

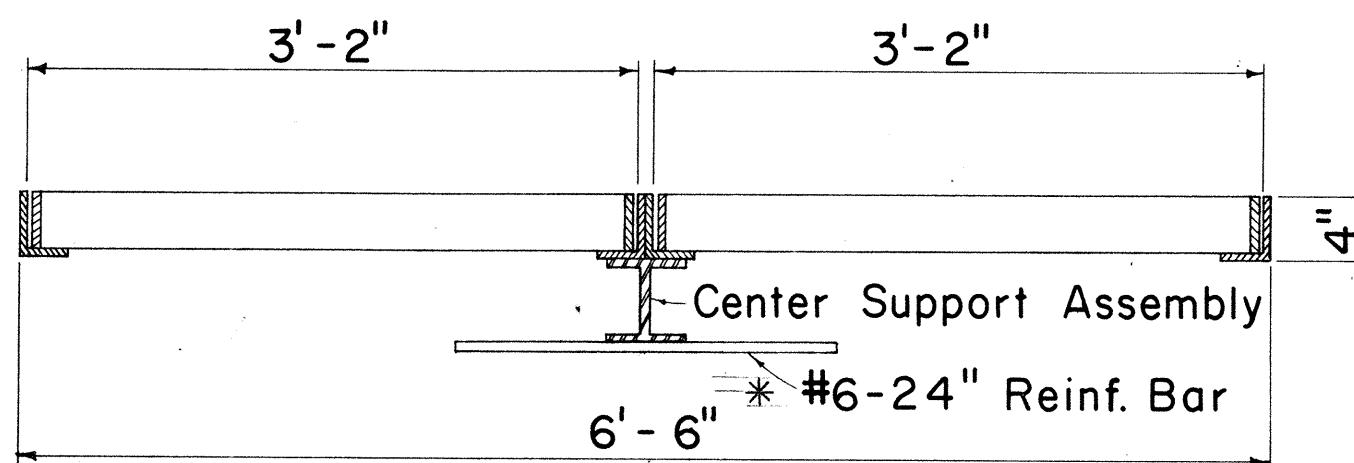


LONGITUDINAL SECTION
(Thru Frame & Grate)

FRAME DETAILS
Scale: 1" = 1'- 0"

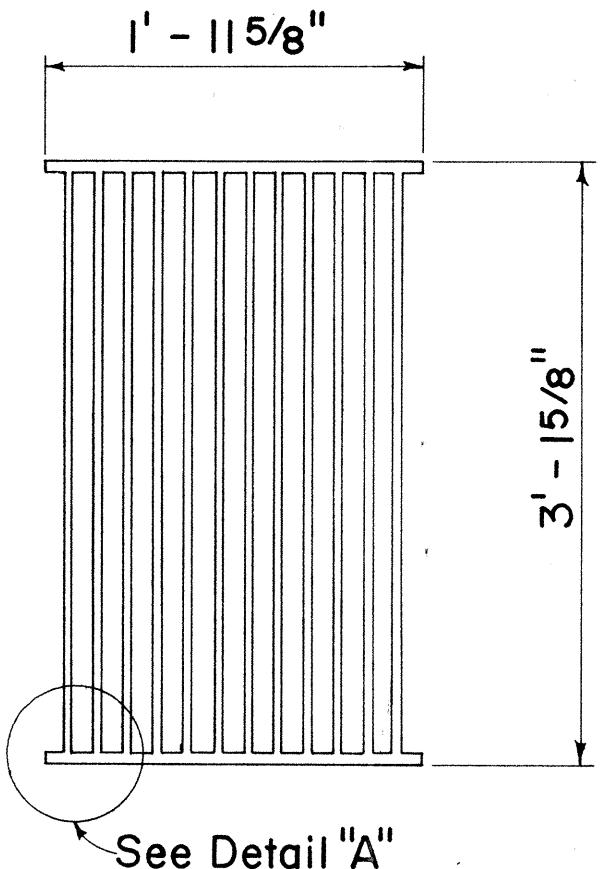


PLAN
Scale: 1" = 1'- 0"

ALTERNATIVE CAST MALLEABLE IRON
OR CAST STEEL GRATE
Scale: 3" = 1'- 0"

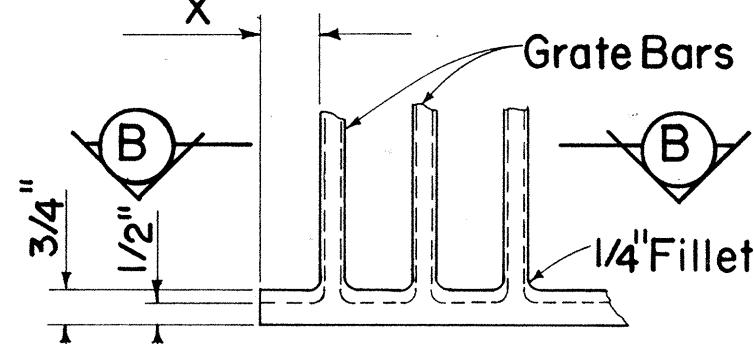


DETAIL "A"

Scale: 3" = 1'- 0"

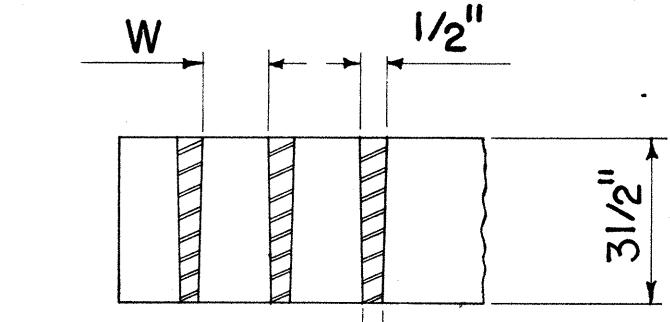


SECTION "B-B"

Scale: 3" = 1'- 0"

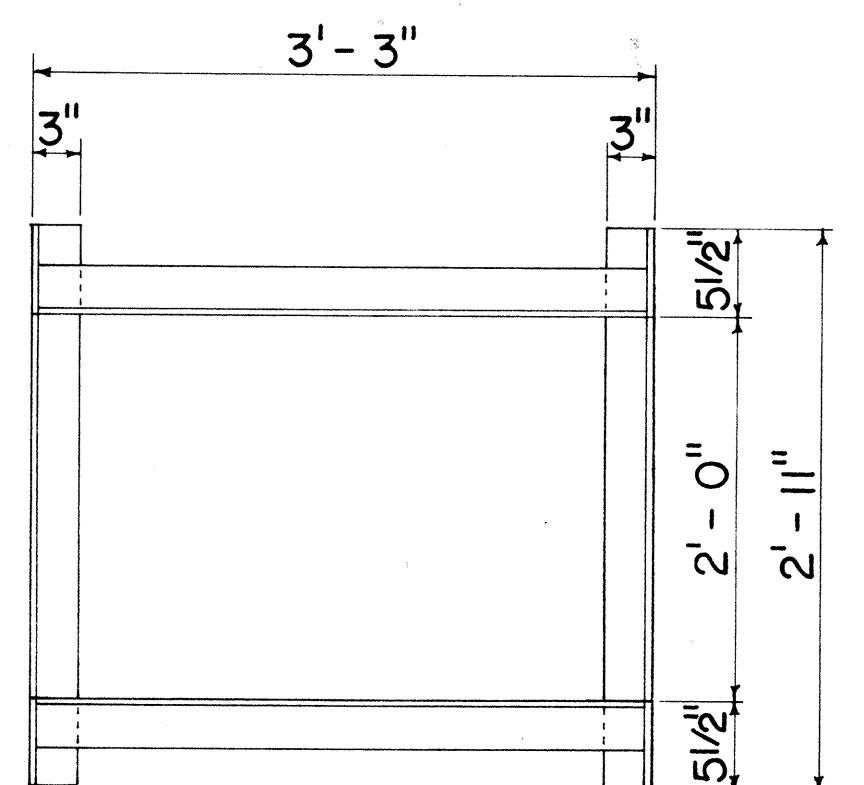


PLAN
(Single Grate)

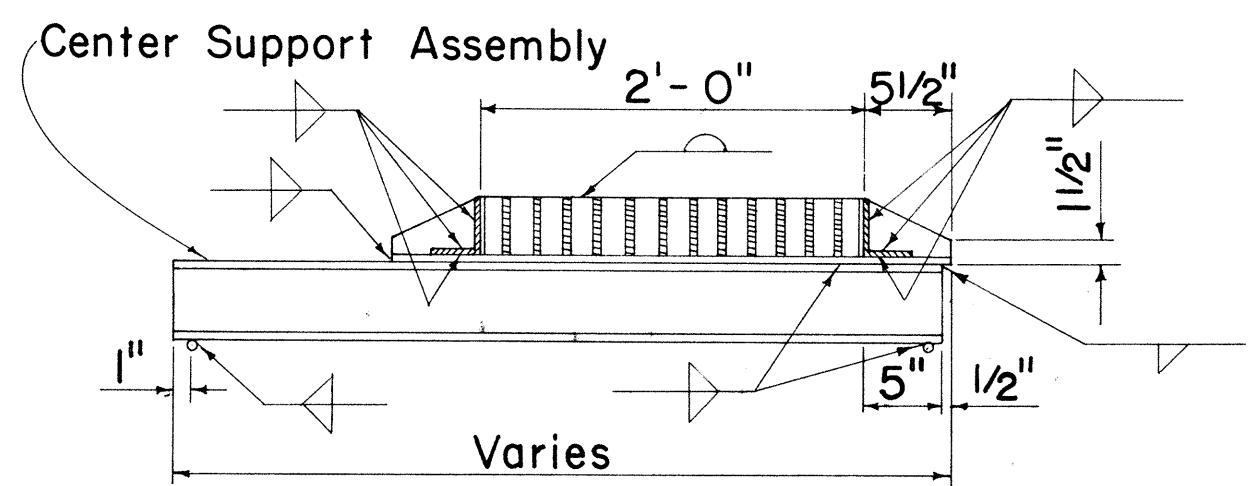


CROSS SECTION
(Thru Frame & Grate)

NOTE:


* BEND #6 REINF. BAR
SEE DETAIL SHEET 71

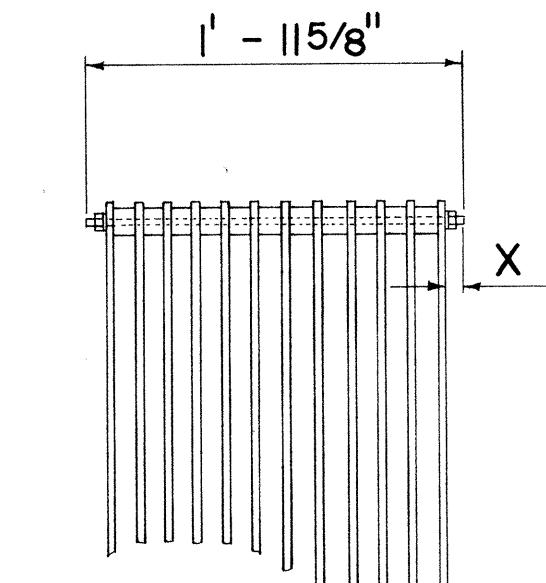


BOLTED END BLOCK
Scale: 1" = 1'- 0"

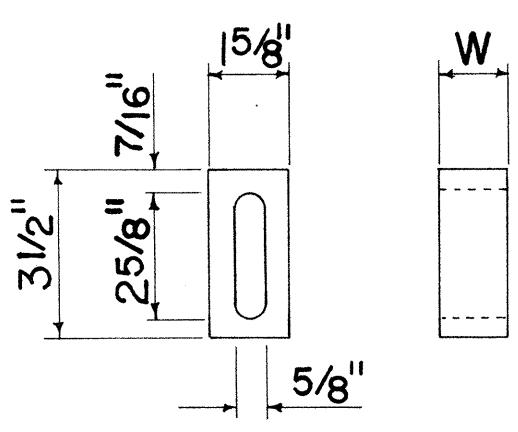

BAR SPACER
Scale: 3" = 1'- 0"


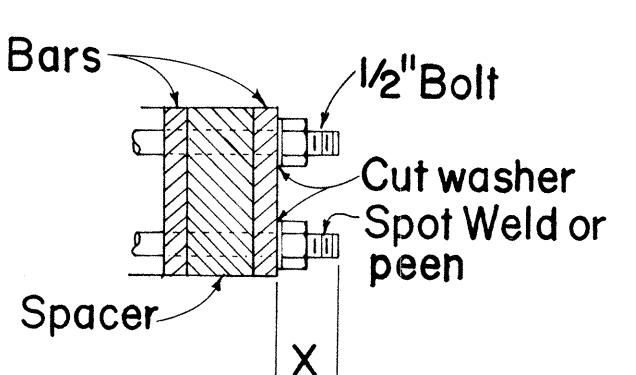


BOLTING DETAIL
Scale: 3" = 1'- 0"

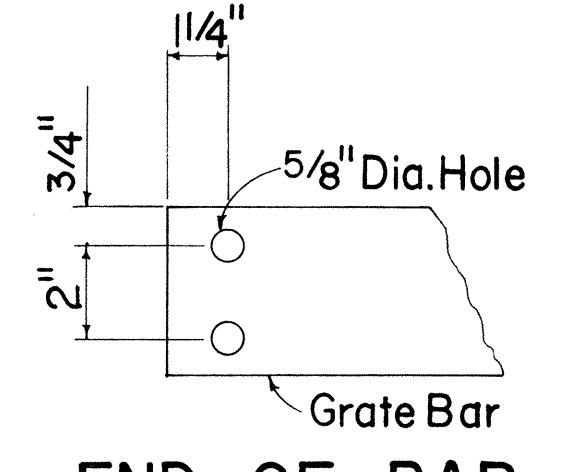

END OF BAR
Scale: 3" = 1'- 0"

ALTERNATIVE BOLTED GRATE

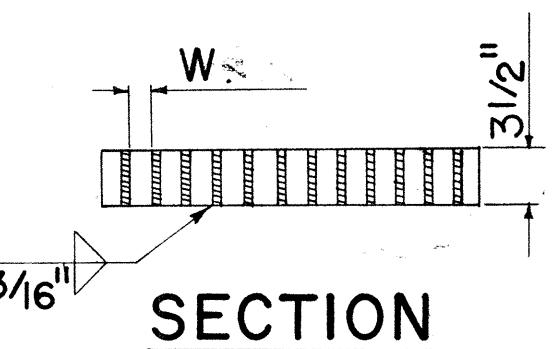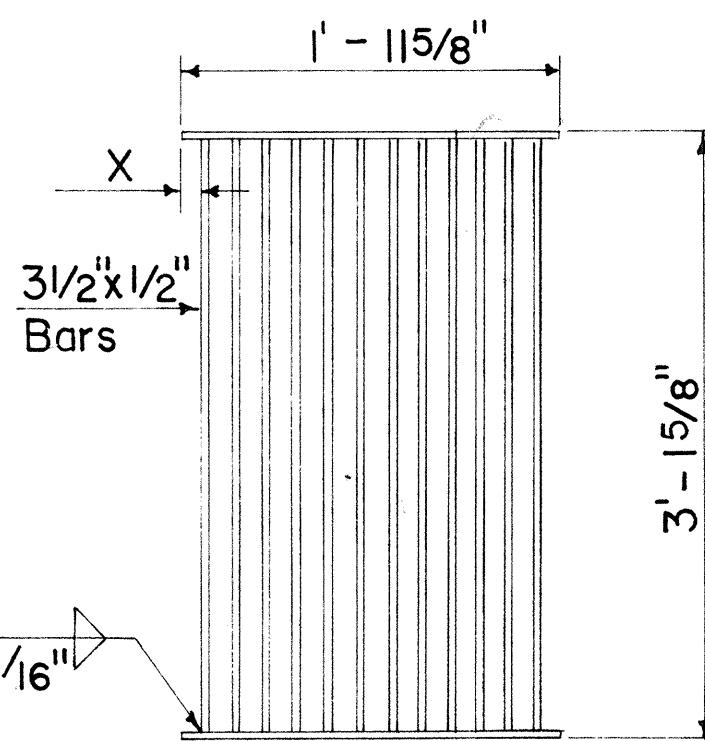


SECTION

PLAN


ALTERNATIVE WELDED GRATE

Scale: 1" = 1'- 0"

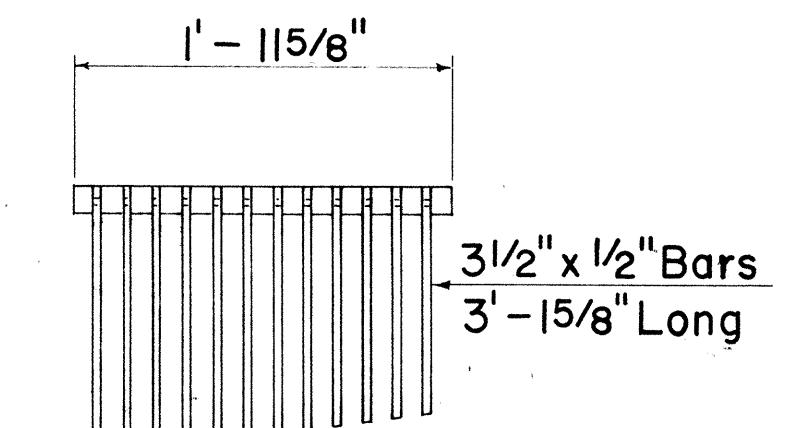

CAST END BLOCK


Scale: 1" = 1'- 0"

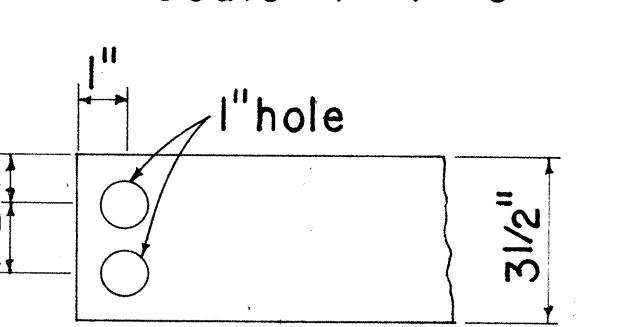

END OF BAR

Scale: 3" = 1'- 0"

ALTERNATIVE CAST MALLEABLE IRON
OR CAST STEEL END BLOCK GRATE

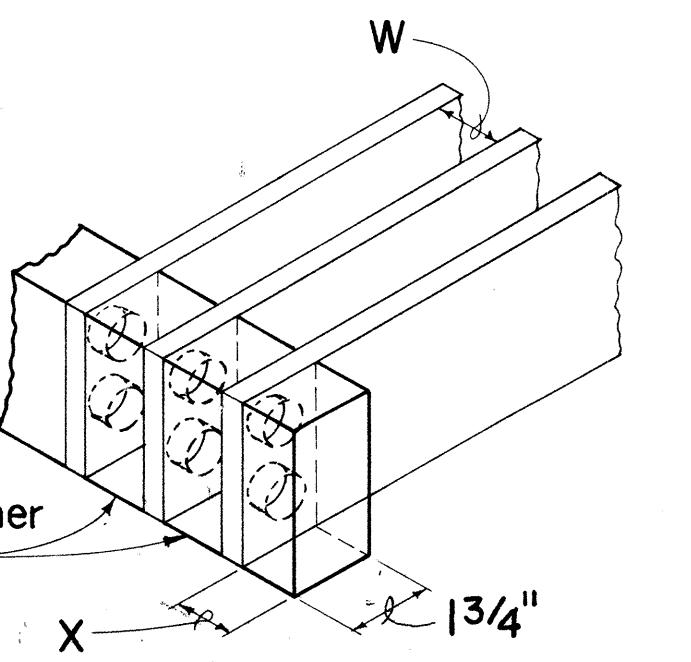

NO.	REVISION	APPROVED BY	DATE

GENERAL NOTES

- Contractor has the option of using cast malleable iron, cast steel, welded, bolted, cast malleable iron end block or cast steel end block grate.
- Grates and Frames shall be hot dip galvanized after fabrication, see specifications.
- All welds $\frac{3}{8}$ " unless otherwise noted.
- Center support assembly shall be used when two or more grates are specified. Incidental to Types A-9 or A-12 Frame and Grates.
- Refer to "Grate Bar Spacing Table" for Types A-9 and A-12 Grate dimensions.
- The various materials shall conform to the specifications of ASTM as listed in the following tabulation and the Std. Specifications.

Material ASTM Designation

Structural Steel A283, Grade D

Cast Steel A27, Grade 65-35

Malleable Iron Casting... A47, Gr. No. 35018

GRATE BAR SPACING TABLE




TYPE	NO. BARS	CLEAR BAR SPACING - W	X
A-9	9	2"	1 9/16"
A-12	12	1 3/8"	1 1/4"

NOTE:

- Type A-9 - Use in locations off the roadbed on all types of highways.
- Type A-12 - Use within the roadbed on all types of highways.


ADDITIONAL DRAWINGS
1. GRADE 100
2. GRADE 100
FED. ROAD DIST. NO.	STATE	FED. AID PROJ. NO.	FISCAL YEAR	SHEET NO.	TOTAL SHEETS
HAWAII	HAW.	I-HI-(73):15	1974	81	309

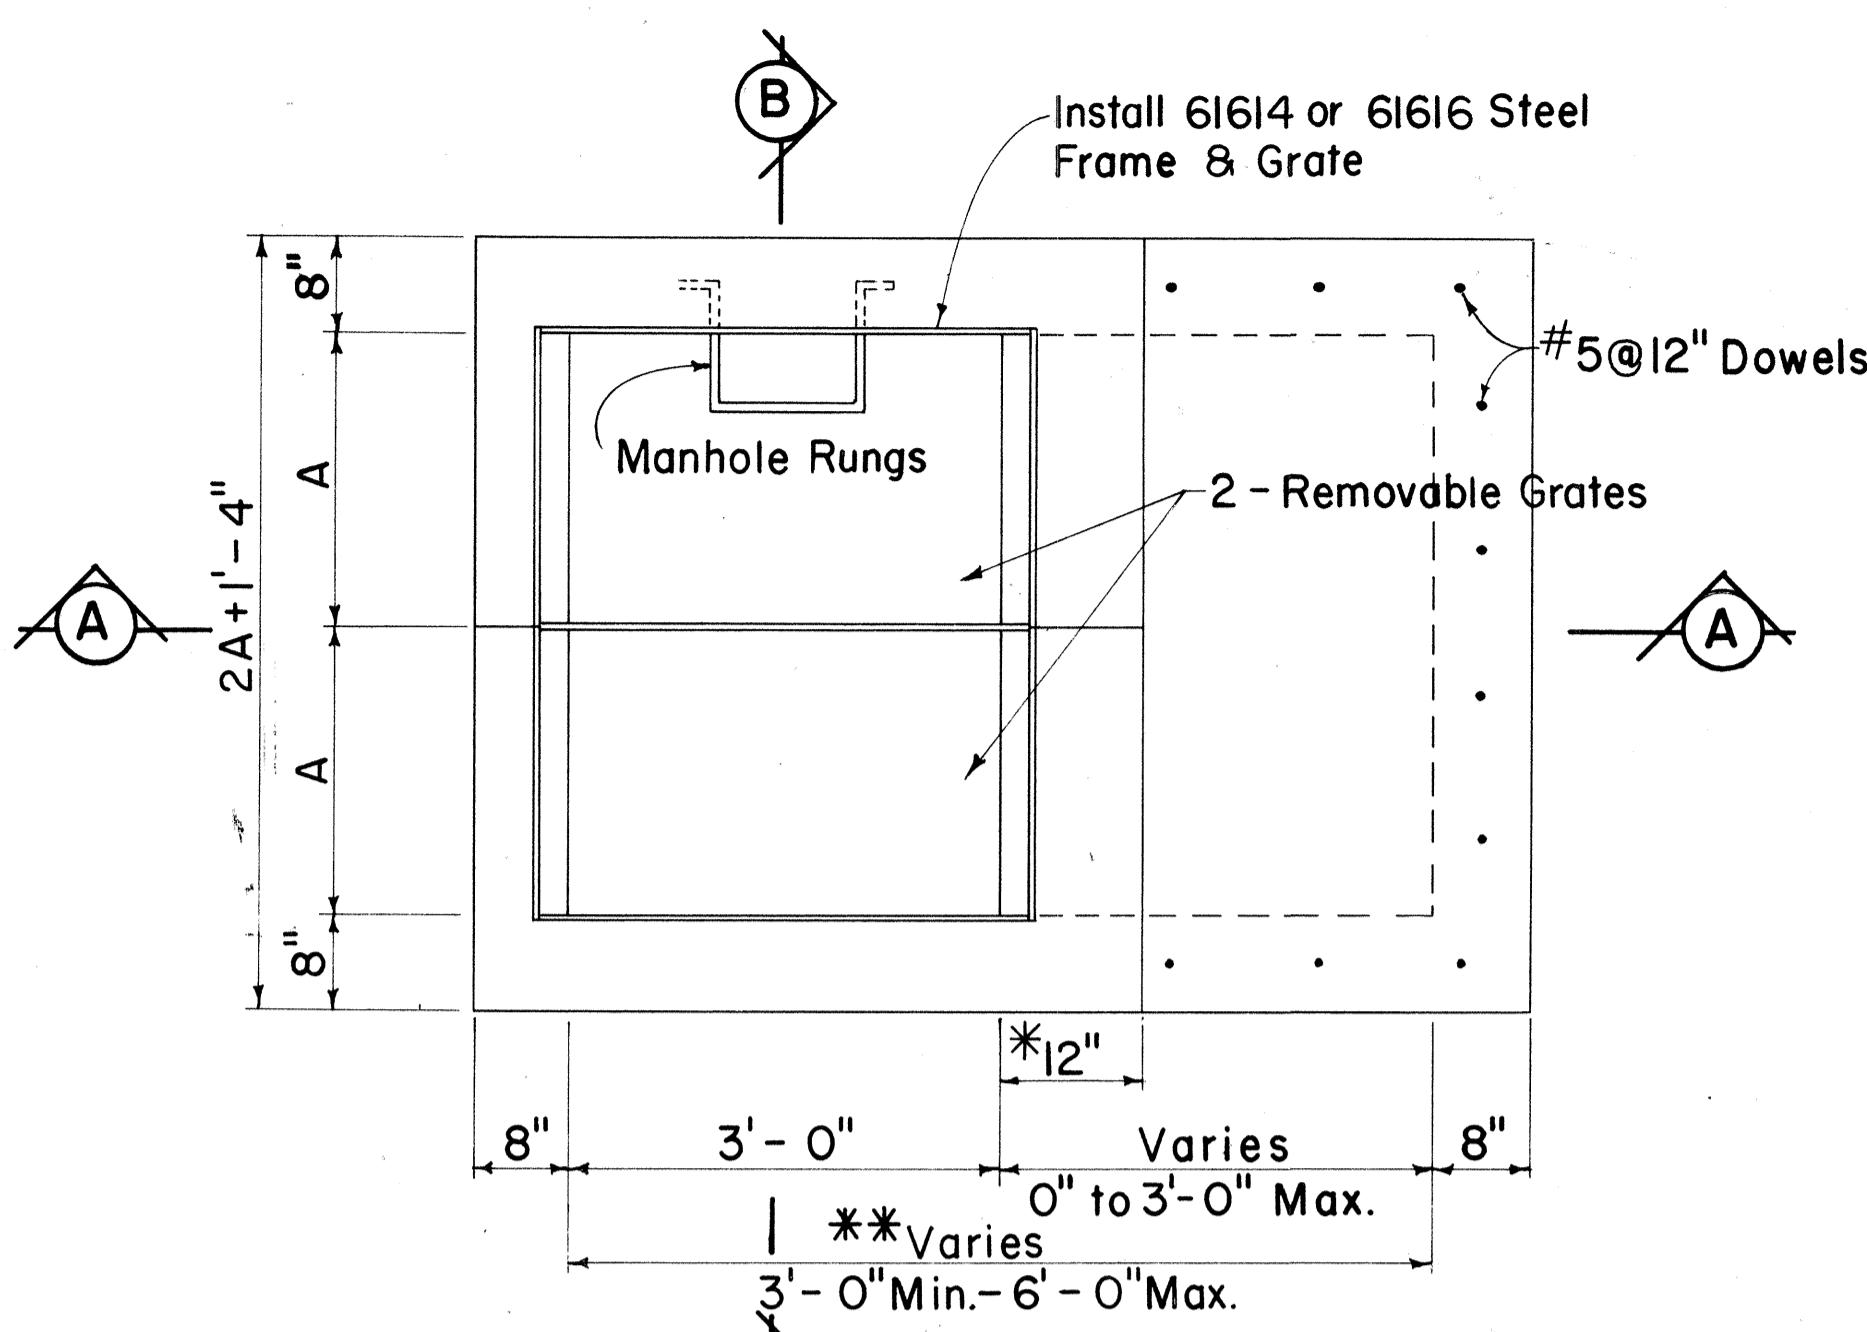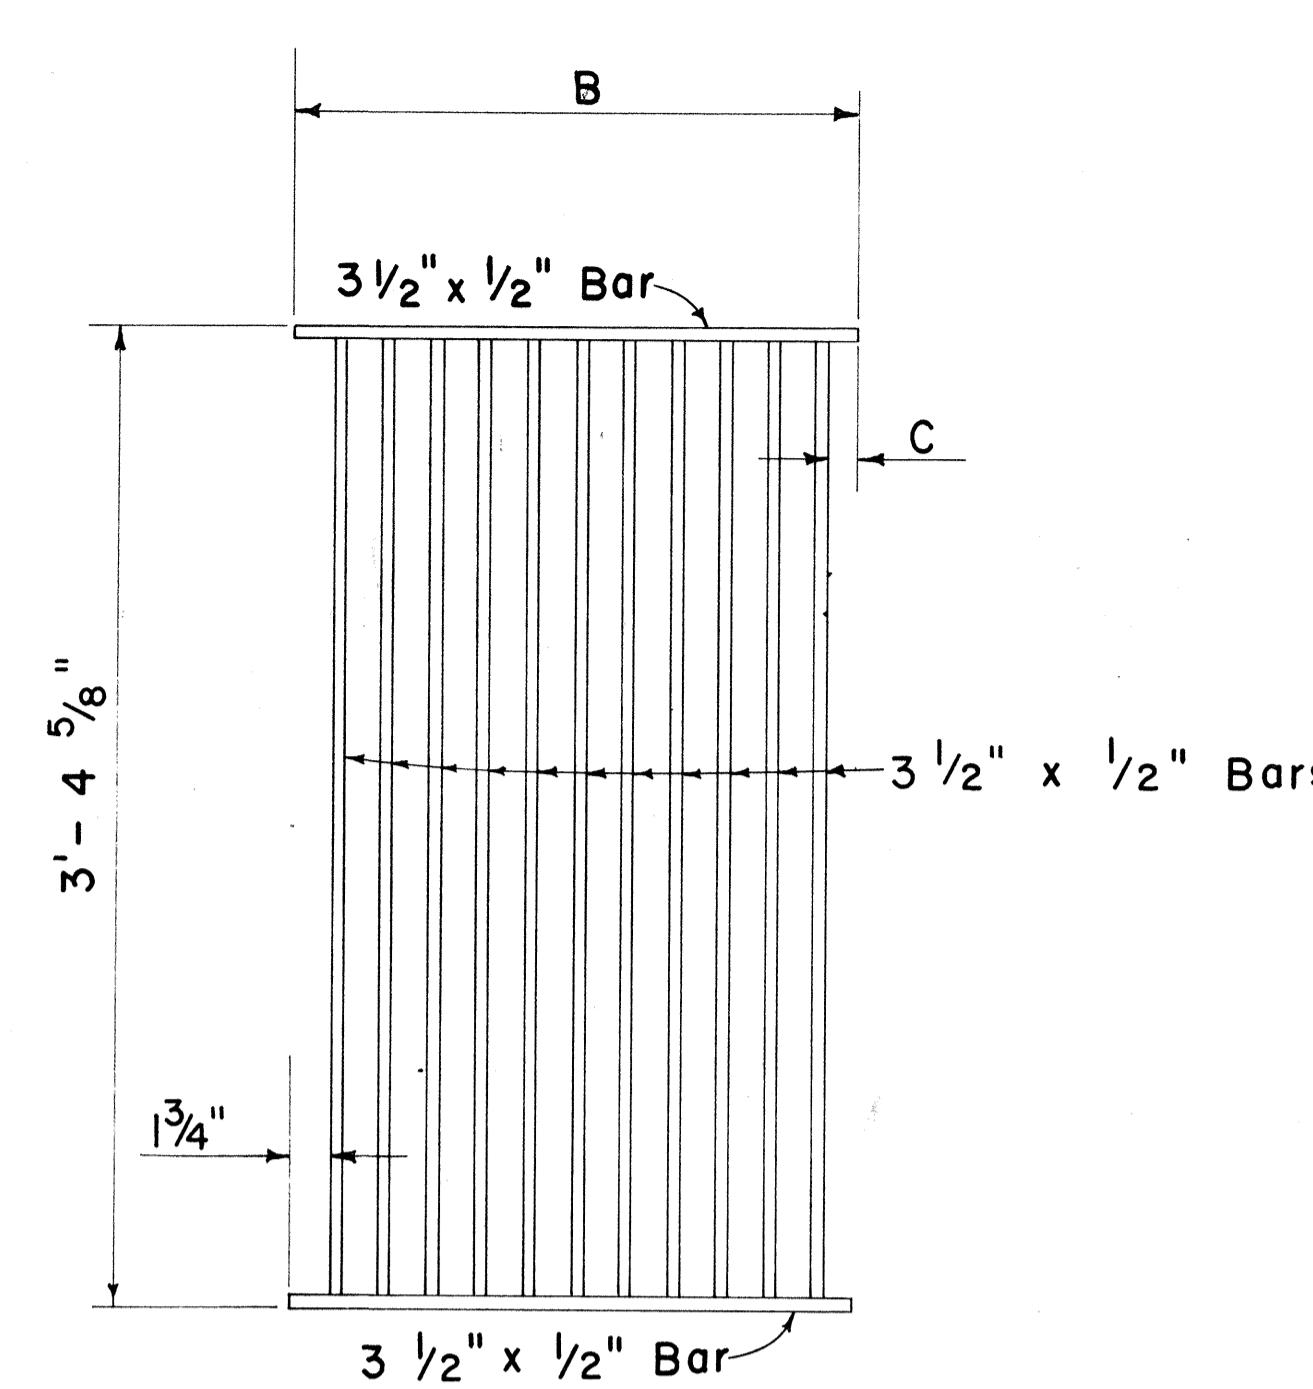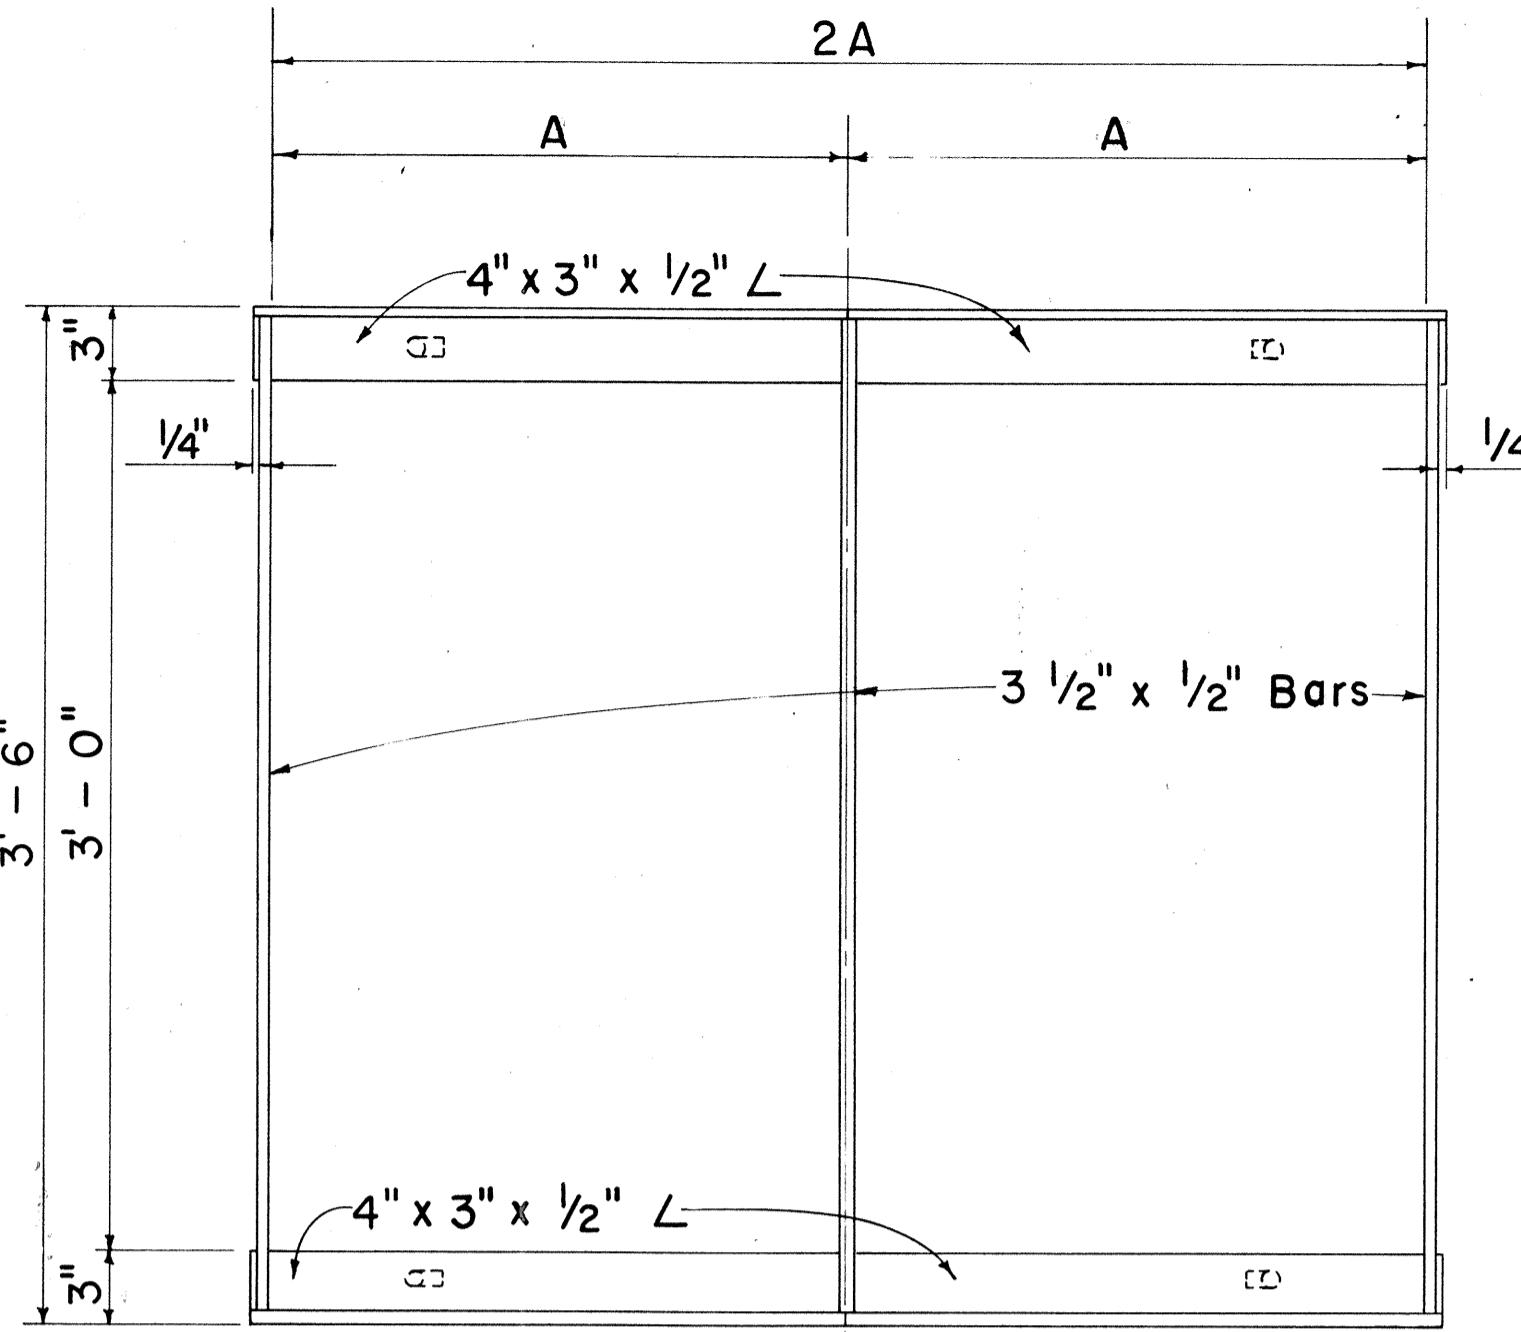


PLAN

PLAN
Scale: 1 1/2" = 1'-0"

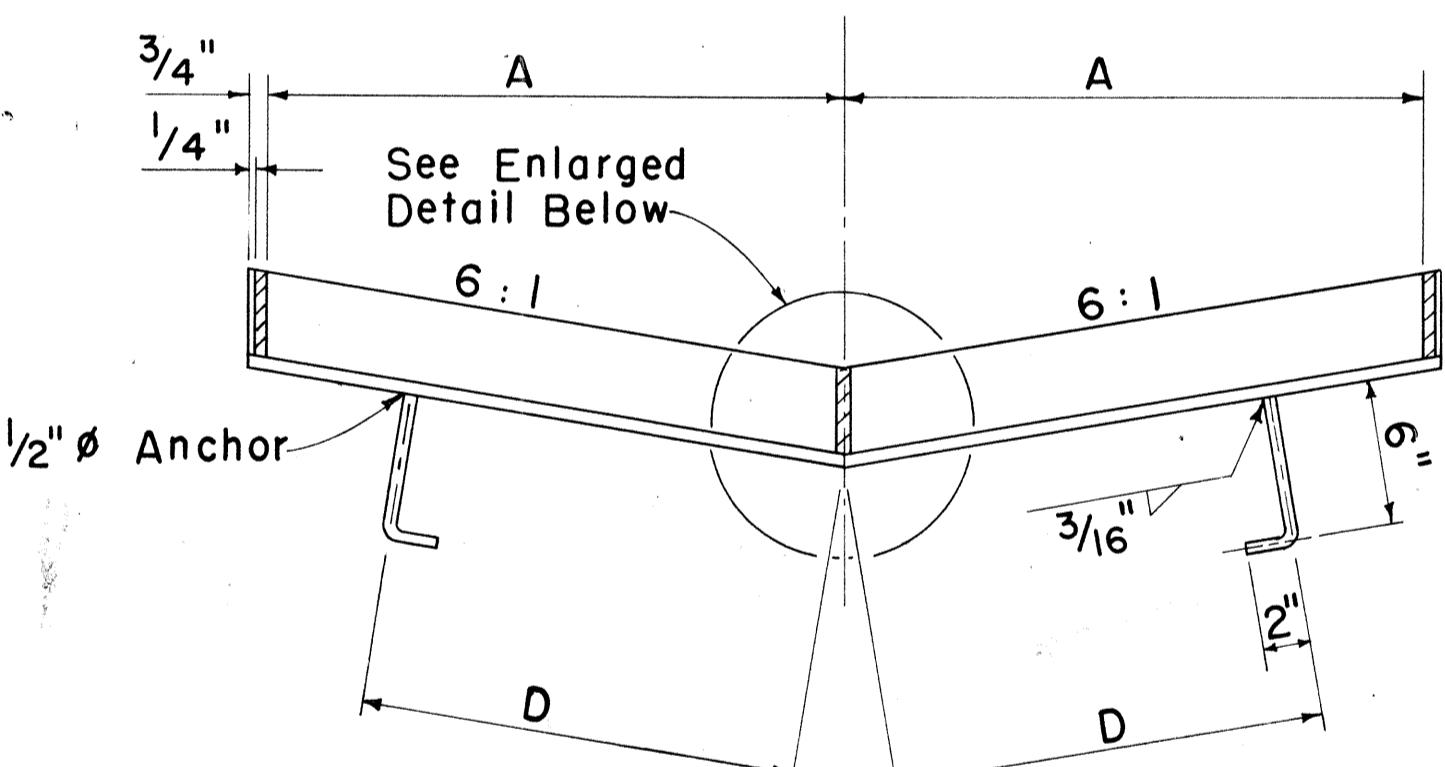


SECTION
Scale: 1 1/2" = 1'-0"

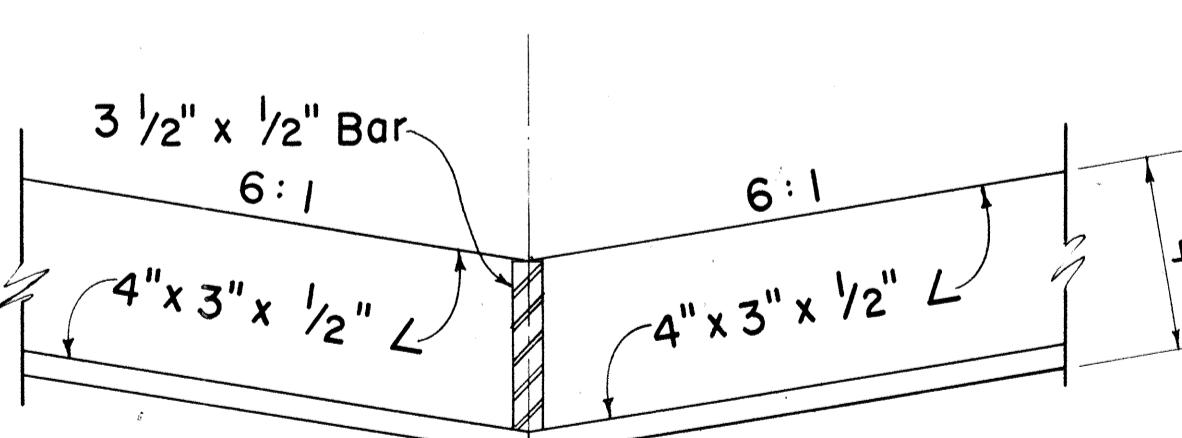


FRAME
Scale: 3" = 1'-0"

**DETAILS OF TYPE 61614 OR 61616
STEEL FRAME AND GRATE**


PLAN
Scale: 1 1/2" = 1'-0"

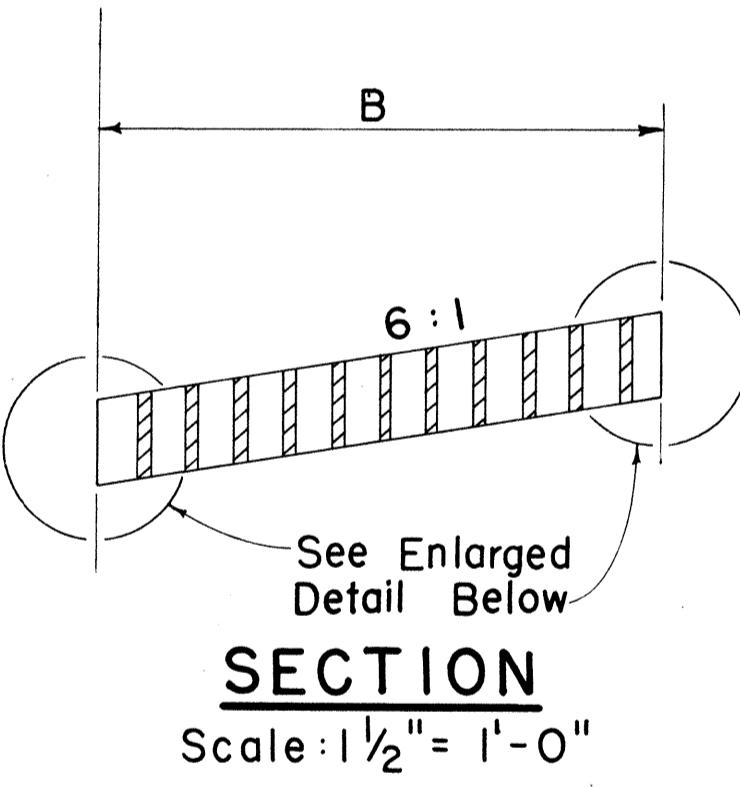


SECTION
Scale: 1 1/2" = 1'-0"

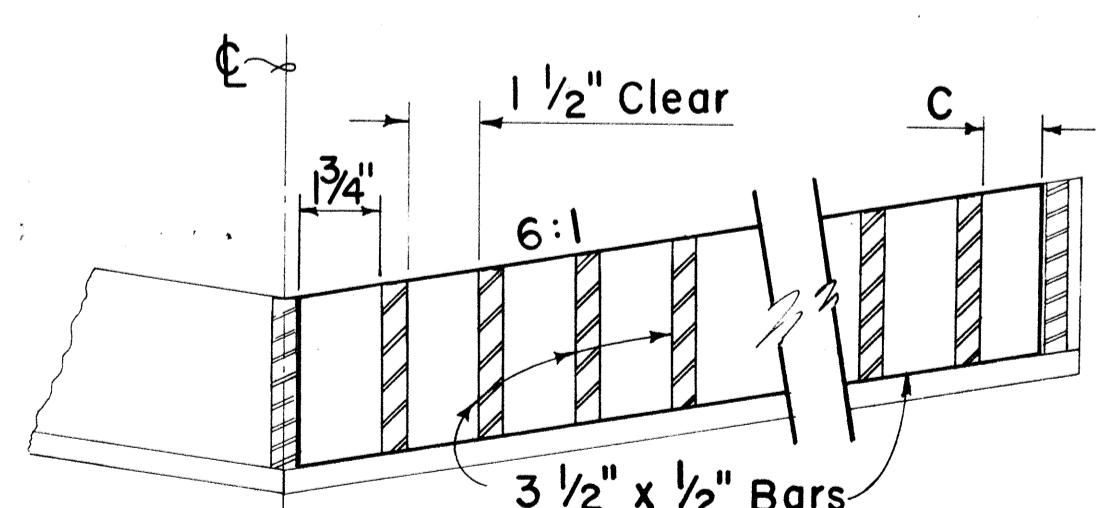

GRATE
Scale: 3" = 1'-0"

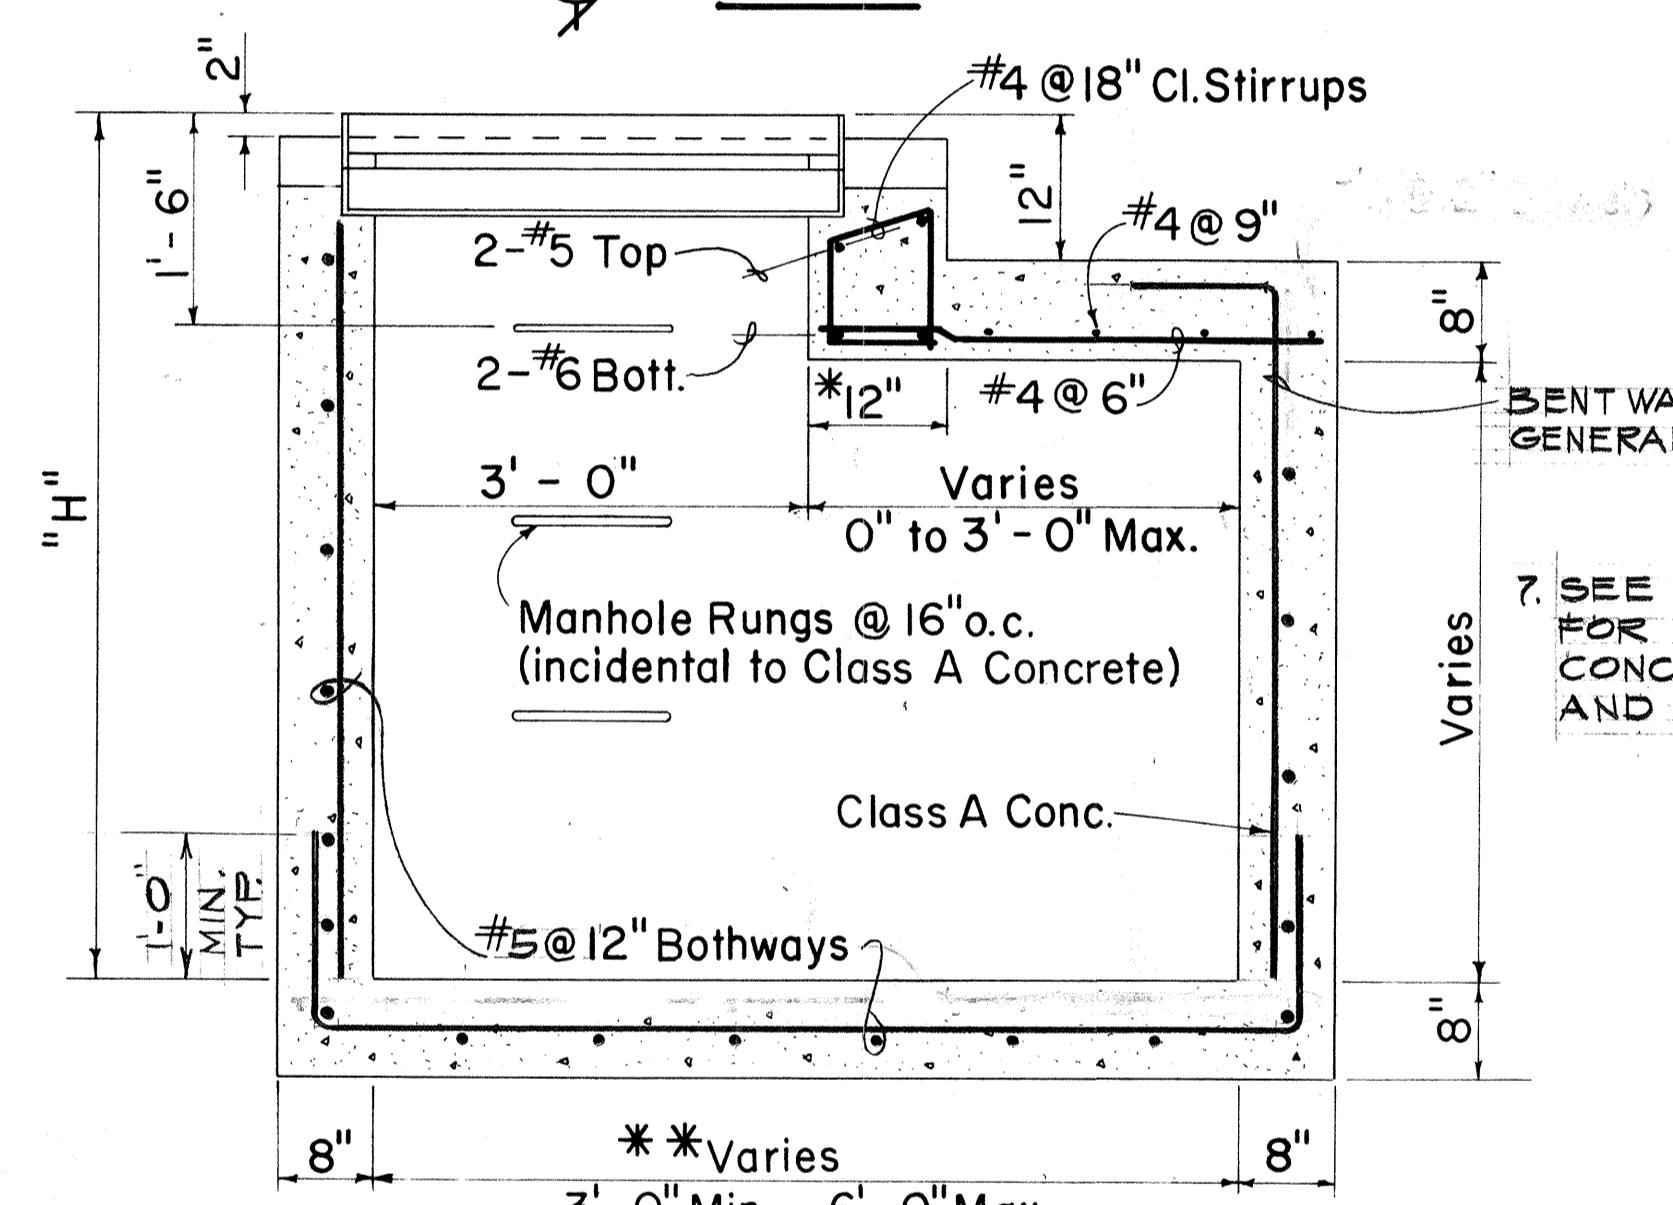

SECTION A-A

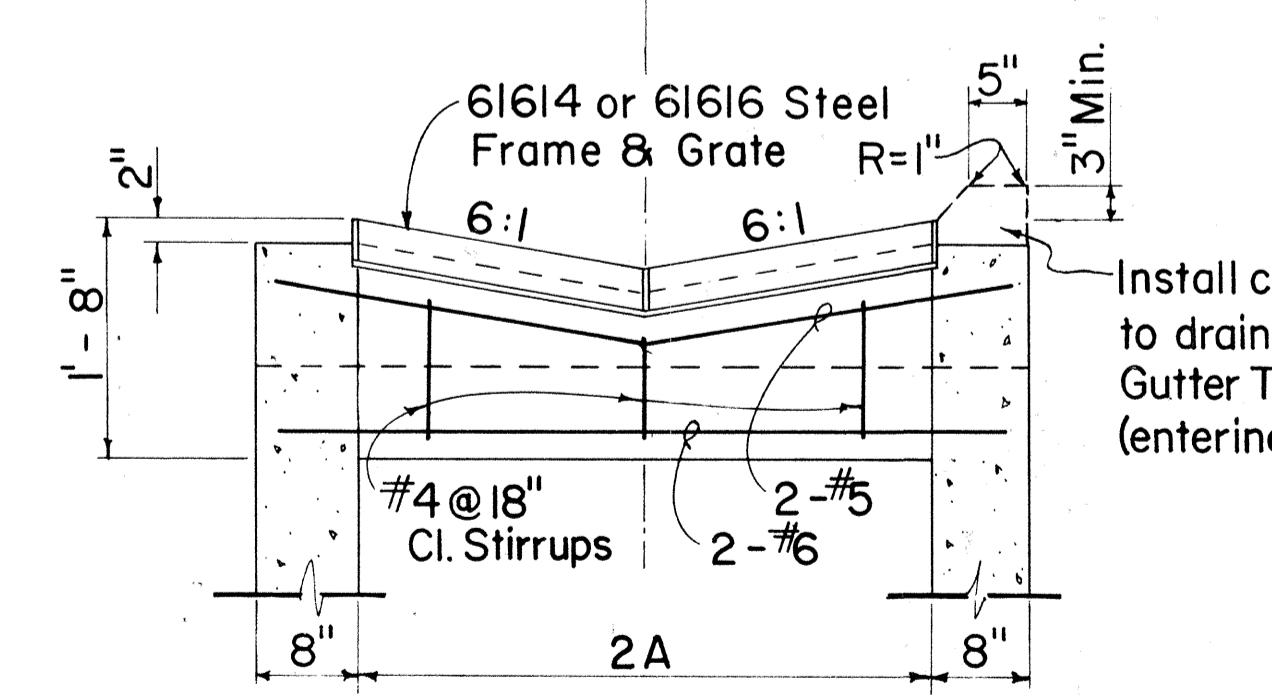

SECTION B-B



GENERAL NOTES

- Grates and Frames shall be hot dip galvanized after fabrication, see specifications.
- All welds $\frac{3}{8}$ " unless otherwise noted.
- Refer to "Spacing Table" for Types 61614 & 61616 Drop Intake and Frame & Grates dimensions.
- The Frame & Grate materials shall conform to the specifications of ASTM Designation Structural Steel A283, Grade D and the Standard Specifications.
- Culvert shall leave Drop Intake from any position and any direction indicated by plans or ordered by the Engineer. Culverts may both enter and leave Drop Intake so that Drop Intake will act as manhole.
- Manhole Rungs (16" o.c.) are required when "H" is greater than 4 feet 6 inches. Only one rung (12 inches from the bottom) is required if "H" is 4 feet 6 inches or less. Manhole Rungs may be placed at any location as ordered by the Engineer.

SPACING TABLE

TYPE	NO. BARS	A	B	C	D
61614	11	2'-0"	1'-1 1/2"	1 1/4"	1'-6"
61616	17	3'-0"	2'-1 1/8"	1 1/8"	2'-0"

NO.	REVISION	APPROVED BY	DATE
1	Curb for Top of Fill Gutters	H.P.	6-5-71

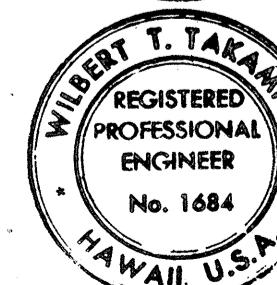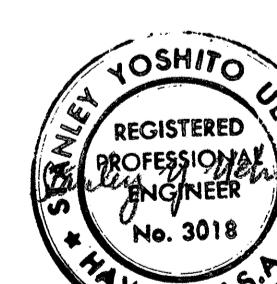

STATE OF HAWAII
DEPARTMENT OF TRANSPORTATION
HIGHWAYS DIVISION

TYPE 61614 & 61616
GRADED DROP INTAKES

DETAILS OF 61614 OR 61616 DROP INTAKE


Scale: 3/4" = 1'-0"

- * For Minimum size box of 3'-0", use 8" and eliminate reinforcing steel shown in the top portion.
- ** For Culverts larger than 30", the minimum dimension shall be D'.


Wilbert T. Takamiy
THIS WORK WAS PREPARED BY ME
OR UNDER MY SUPERVISION.

Scales: As Noted
Date: Feb. 1969
SHEET No. 15 OF 17 SHEETS DH 8


FED. ROAD DIST. NO.	STATE	FED. AID PROJ. NO.	FISCAL YEAR	SHEET NO.	TOTAL SHEETS
HAWAII	HAW.	I-HI-1(73)15	1974	82	369

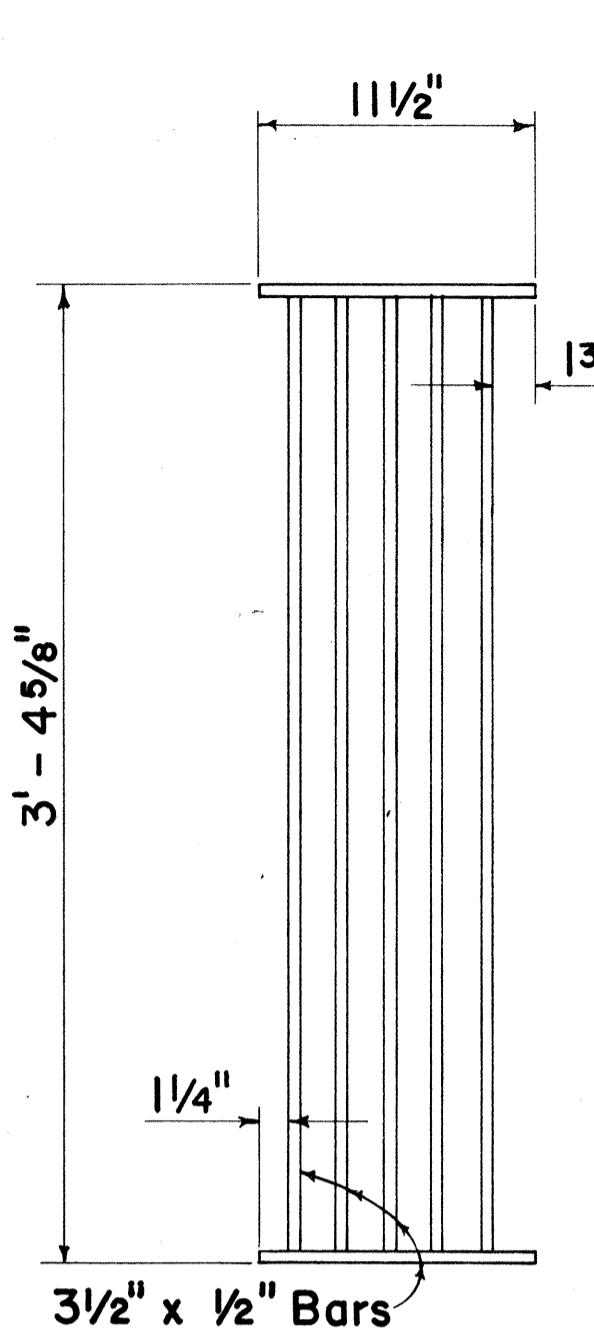


PLAN
Scale: 1 1/2" = 1'- 0"

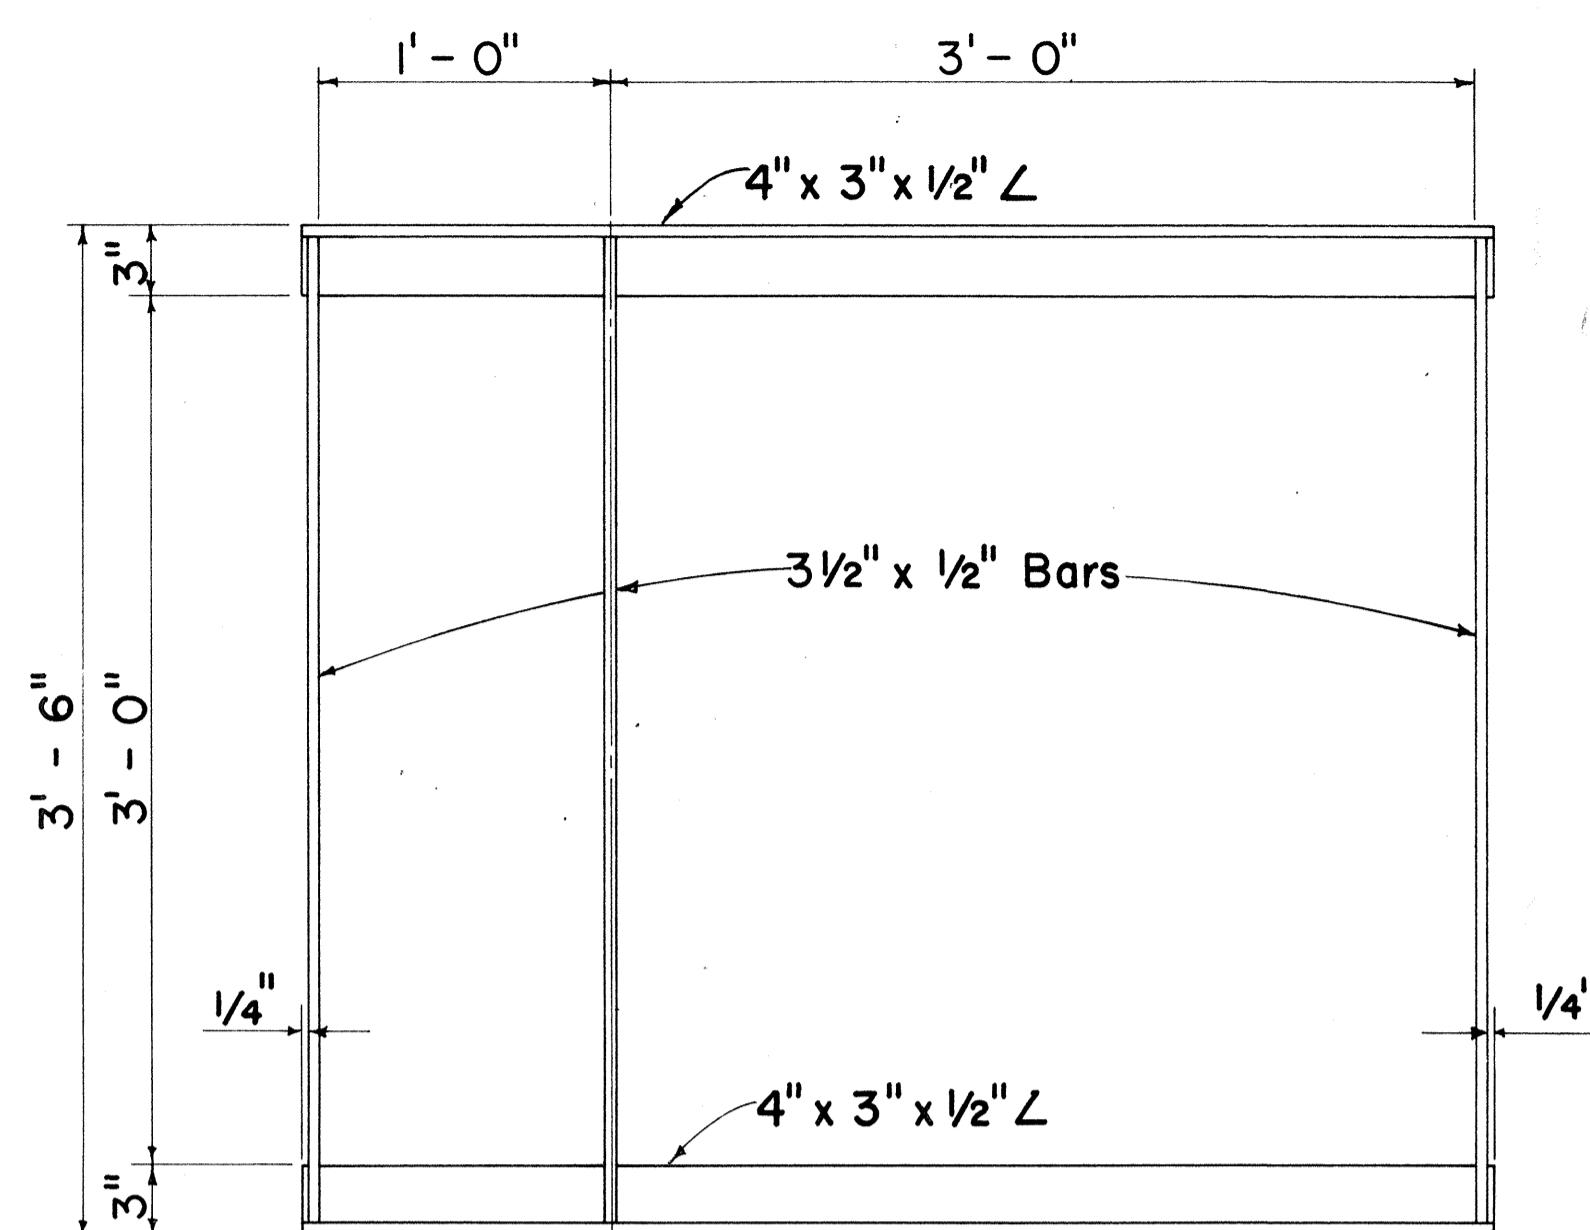


PLAN
Scale: 1 1/2" = 1'- 0"

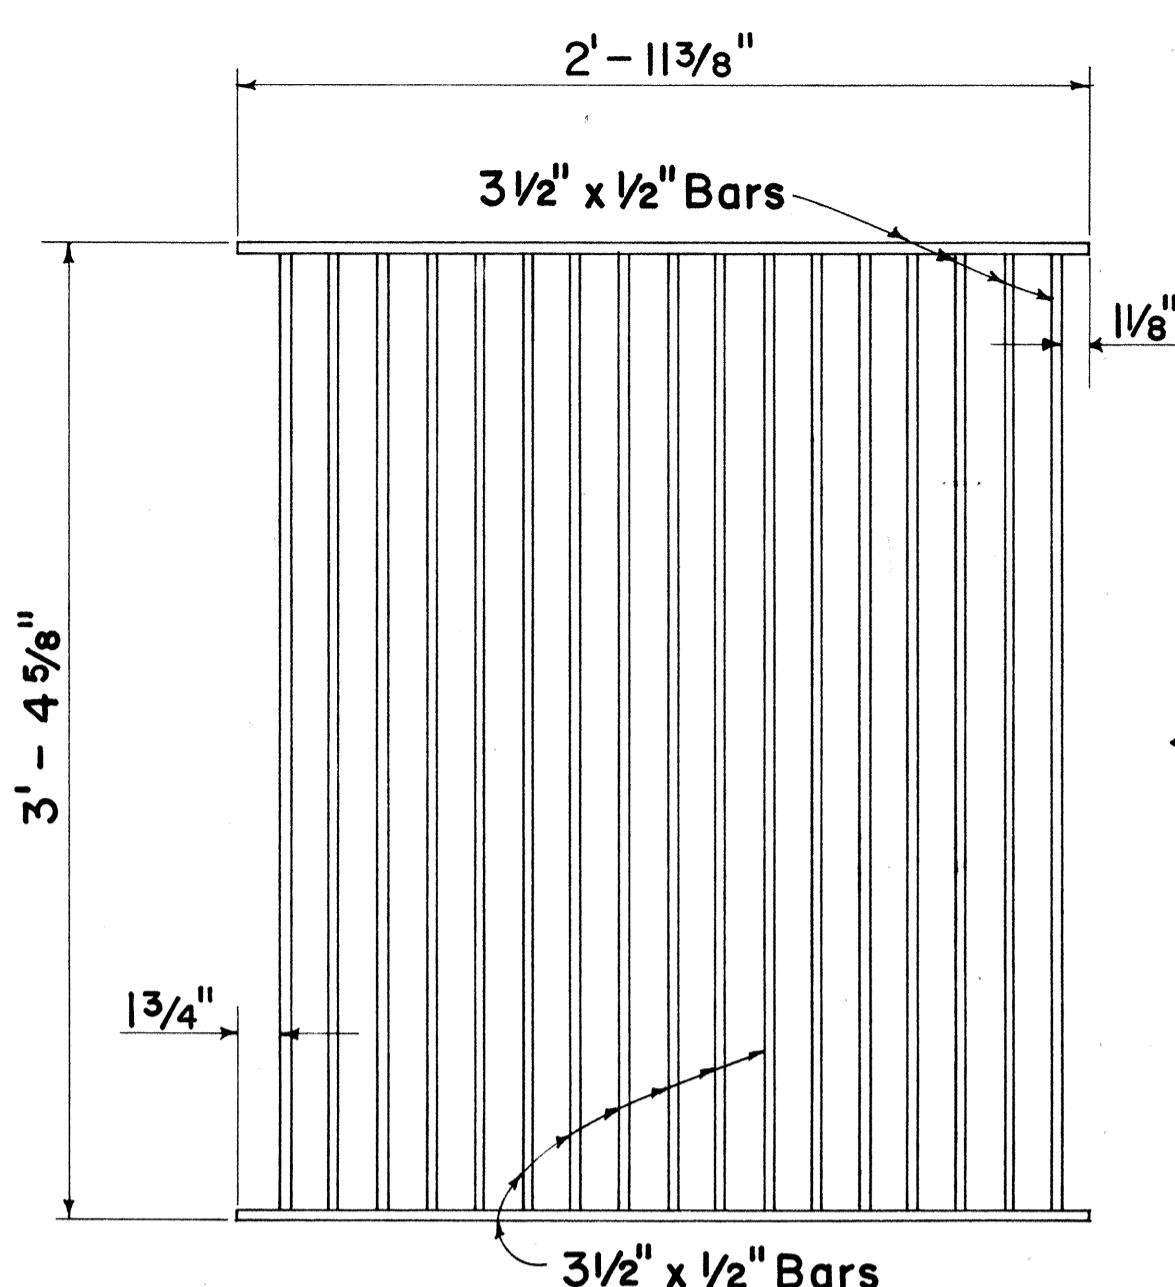


PLAN
Scale: 1 1/2" = 1'- 0"

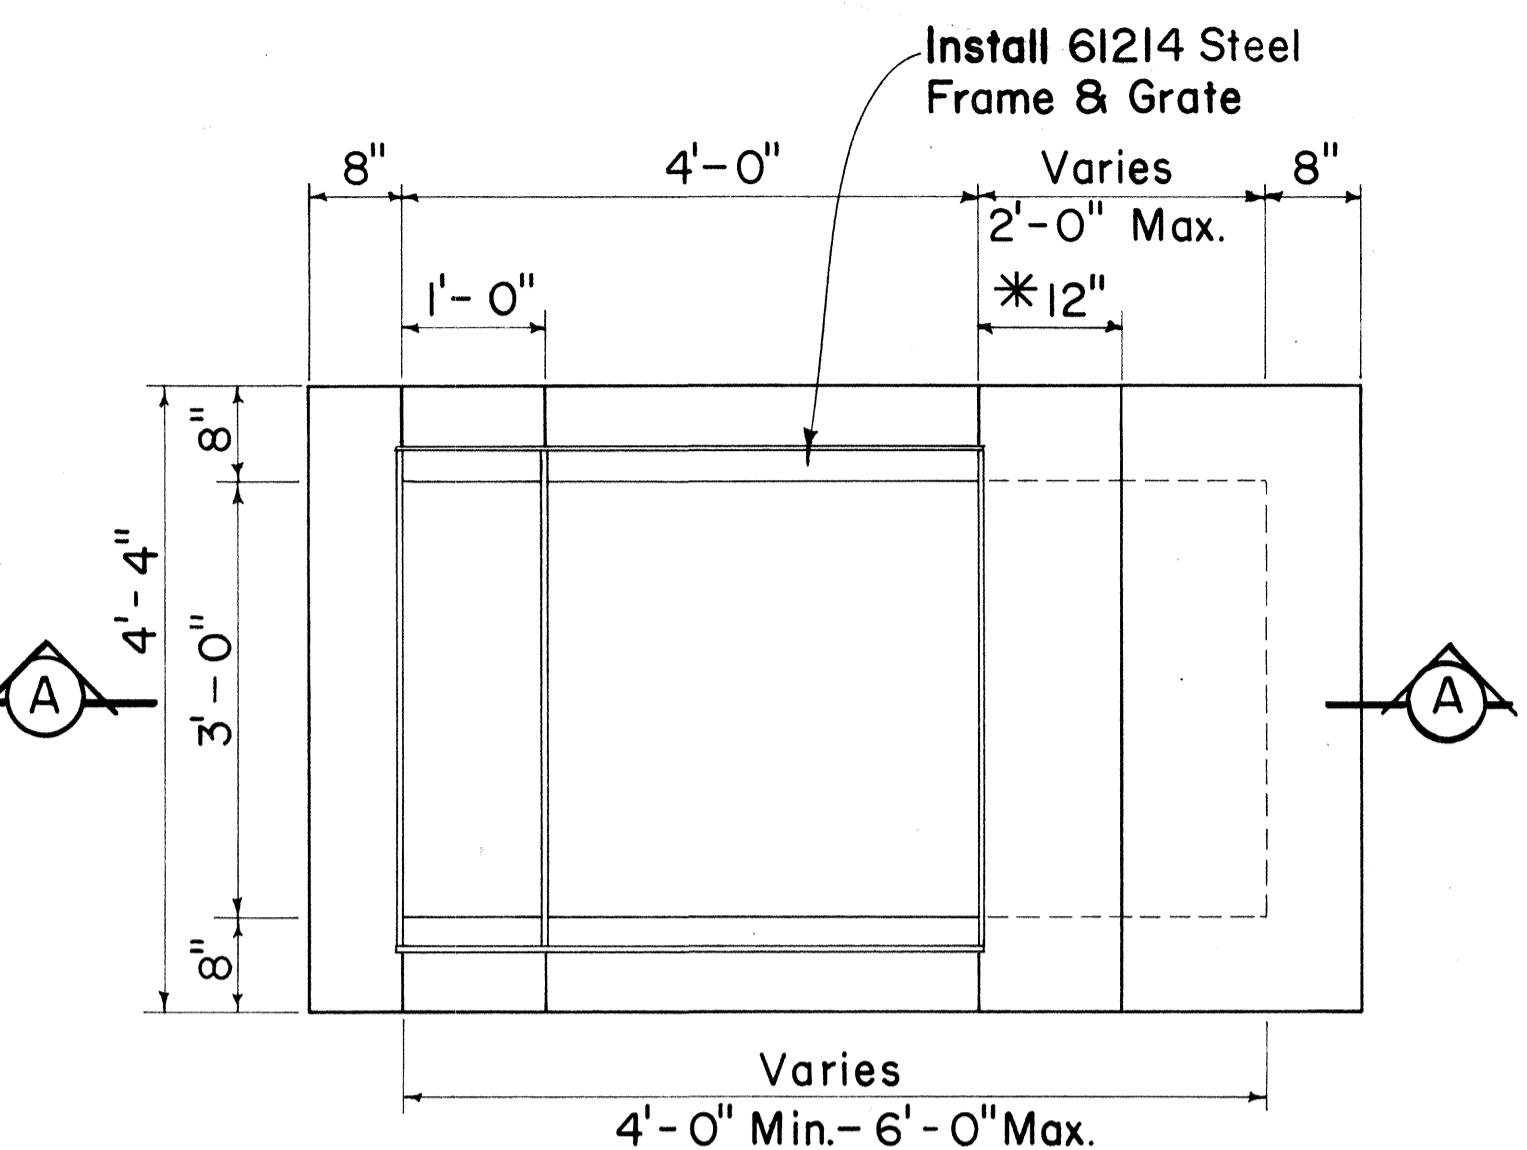


PLAN

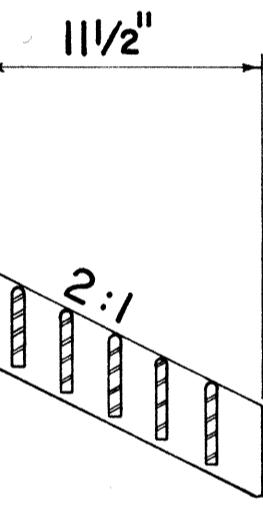


SECTION
Scale: 1 1/2" = 1'- 0"

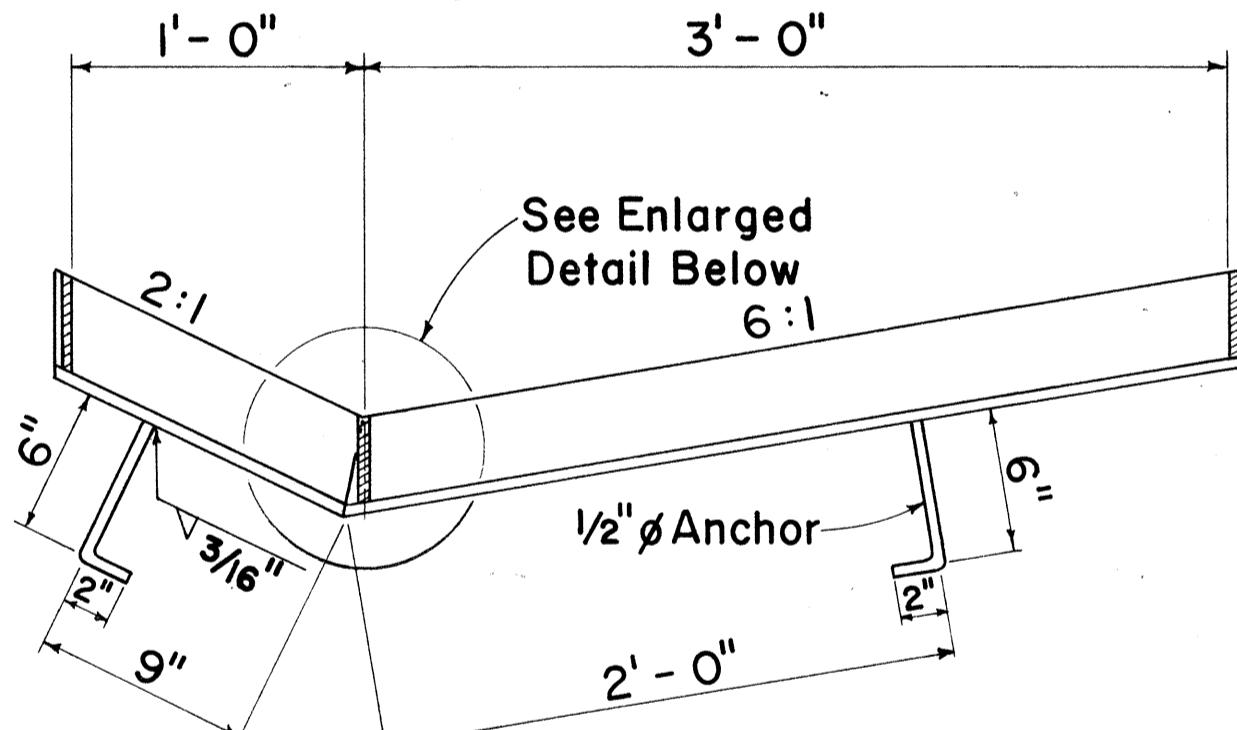


SECTION
Scale: 1 1/2" = 1'- 0"

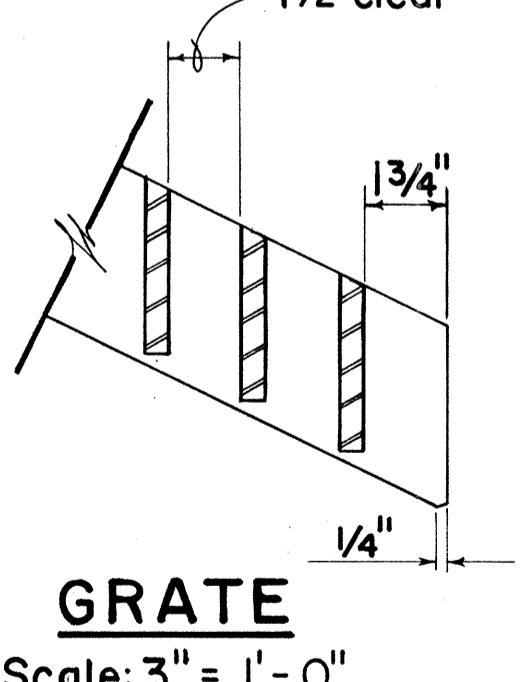

GRATE
Scale: 3" = 1'- 0"

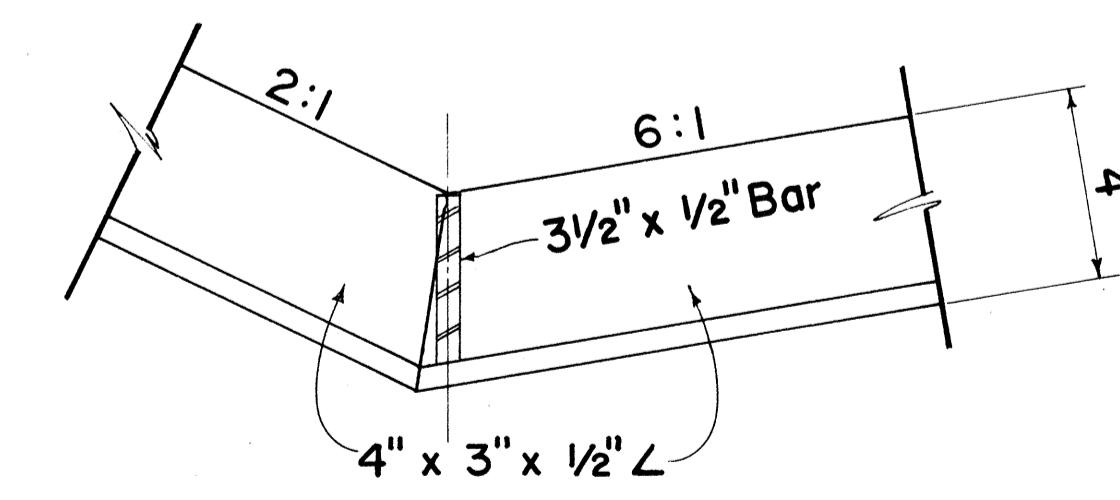

FRAME
Scale: 3" = 1'- 0"

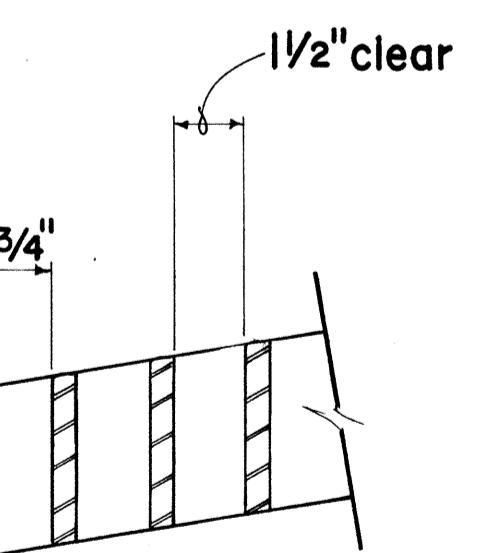


GRATE
Scale: 3" = 1'- 0"

DETAILS OF TYPE 6I214 STEEL FRAME AND GRATES

GENERAL NOTES

1. Grates and Frames shall be hot dip galvanized after fabrication, see specifications.
2. All welds $\frac{3}{8}$ " unless otherwise noted.
3. The Frame & Grate materials shall conform to the specifications of ASTM Designation Structural Steel A283, Grade D and the Standard Specifications.
4. Culvert shall leave Drop Intake from any position and any direction indicated by plans or ordered by the Engineer. Culverts may both enter and leave Drop Intake so that Drop Intake will act as manhole.
5. Manhole Rungs (16" o.c.) are required when "H" is greater than 4 feet 6 inches. Only one rung (12 inches from the bottom) is required if "H" is 4 feet 6 inches or less. The Manhole Rungs may be placed at any location as ordered by the Engineer.

6. SEE SHEET 71 FOR GENERAL CONCRETE NOTES AND DETAILS.

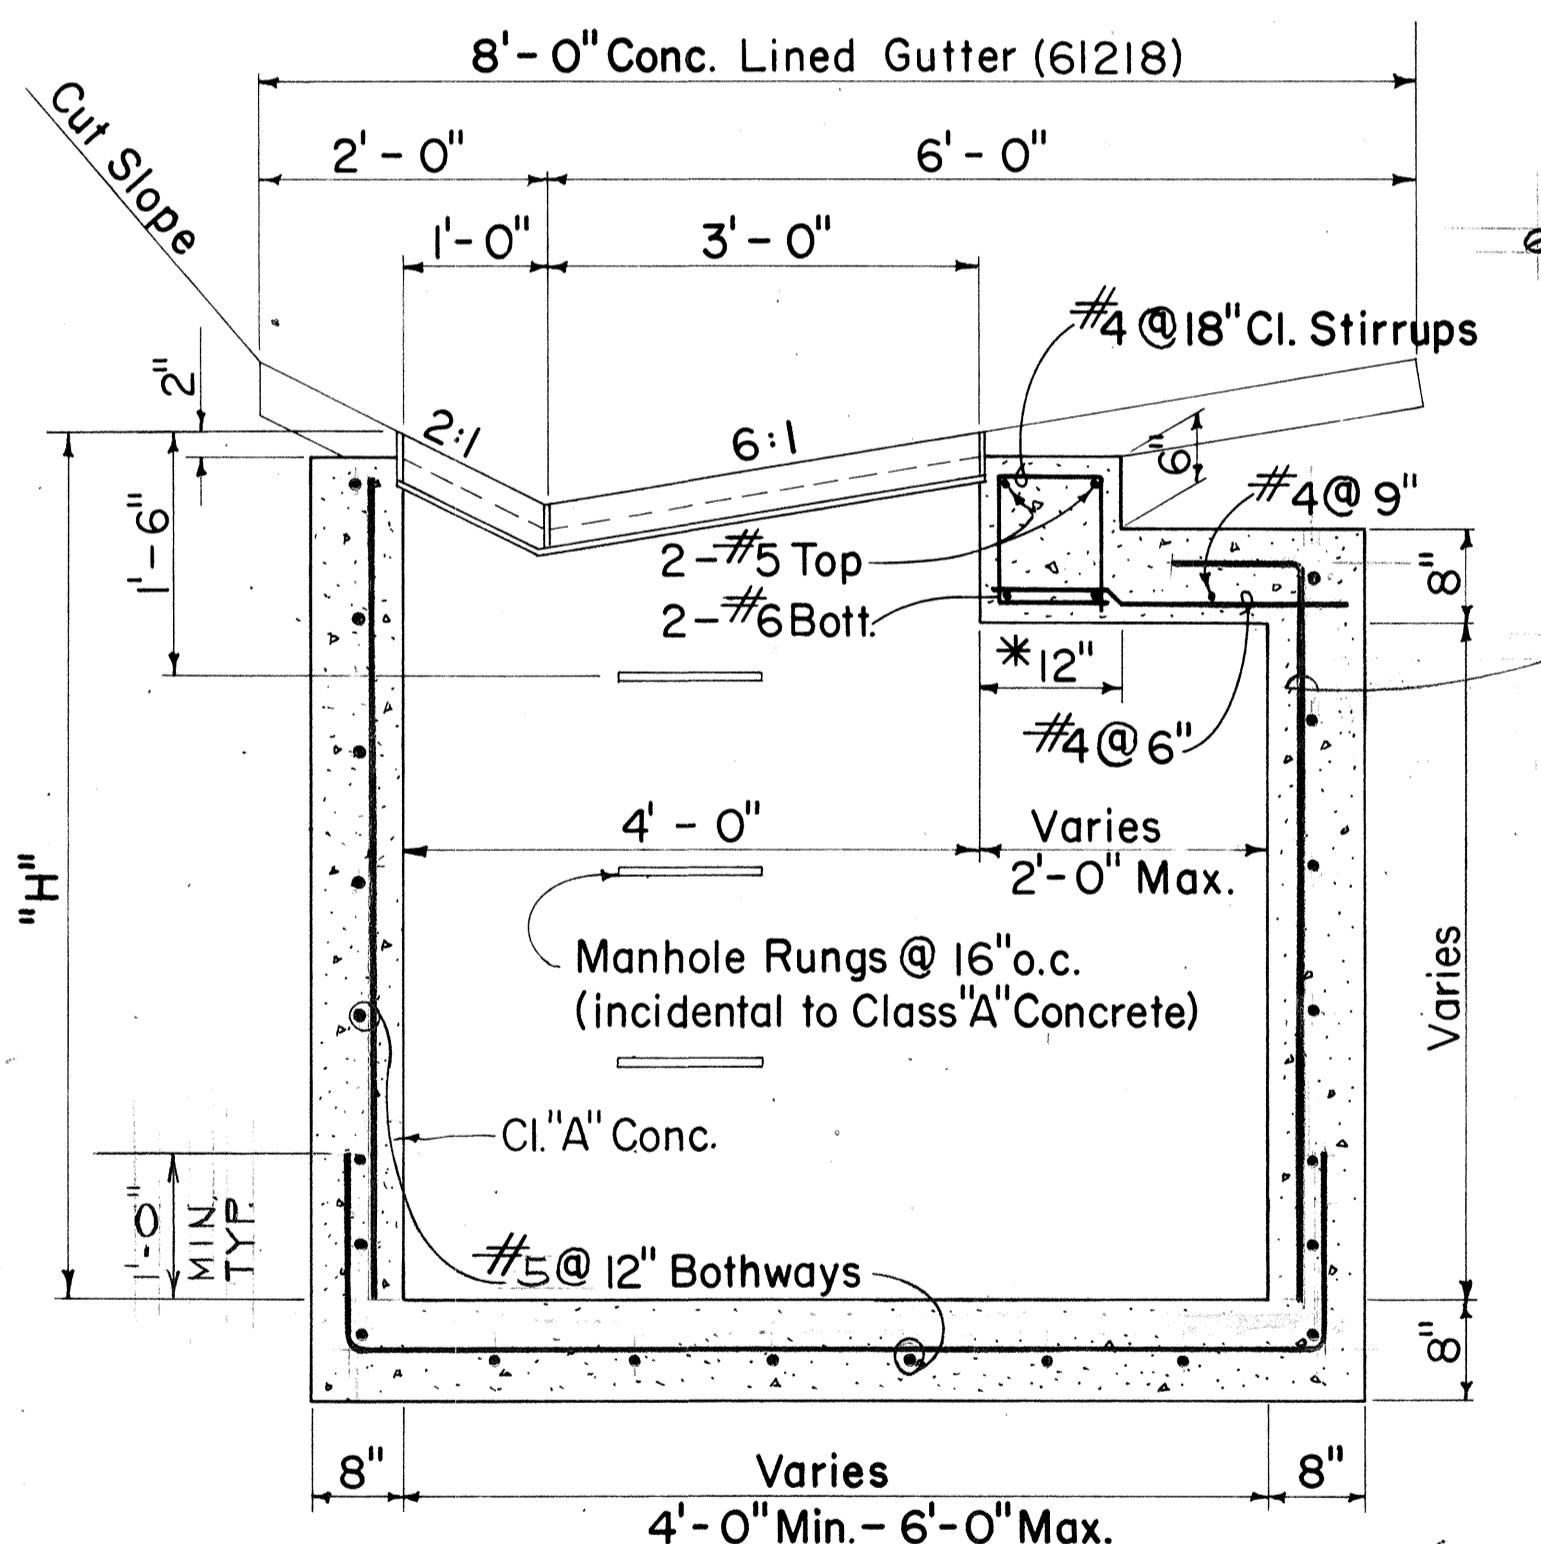

SECTION A - A

DETAIL OF 6I214 DROP INTAKE



Scale: 3/4" = 1'- 0"

*For Minimum size box of 4'-0" only, use 8" and eliminate reinforcing steel shown in top portion.

STATE OF HAWAII
DEPARTMENT OF TRANSPORTATION
HIGHWAYS DIVISION

TYPE 6I214 GRATED DROP INTAKE

Scales: As Noted Date: July 1969
SHEET No. 16 OF 17 SHEETS DH 9

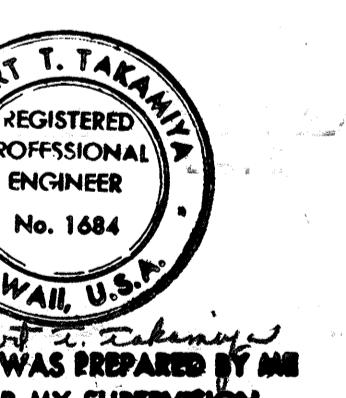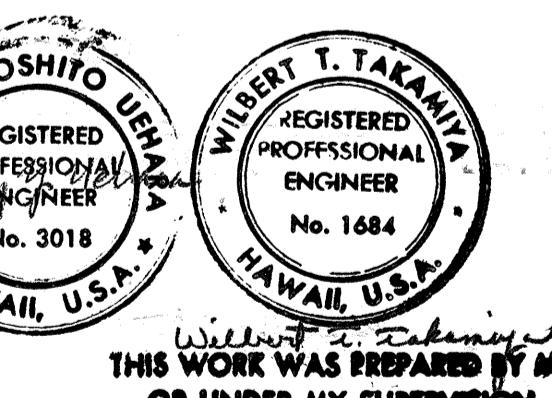


THIS WORK WAS PREPARED BY ME
OR UNDER MY SUPERVISION.


FED. ROAD DIST. NO.	STATE	FED. AID PROJ. NO.	FISCAL YEAR	HEET NO.	TOTAL SHEETS
HAWAII	HAW.	I-H-I(73):15	1974	83	369

GENERAL NOTES


- All concrete shall be Class "B" unless otherwise noted.
- Exposed edges of all drainage structures shall be chamfered one inch.
- Culvert shall enter and leave Drop Intake from any position and in the direction indicated by the plans or ordered by the Engineer. Manhole Rungs (16" o.c.) are req'd. when "H" is greater than 4" G". Only one rung (12 inches from the bottom) is required if "H" is 4" G" or less. Manhole Rungs maybe placed at any location as ordered by the Engineer.
- SEE SHEET 71 FOR GENERAL CONCRETE NOTES AND DETAILS.

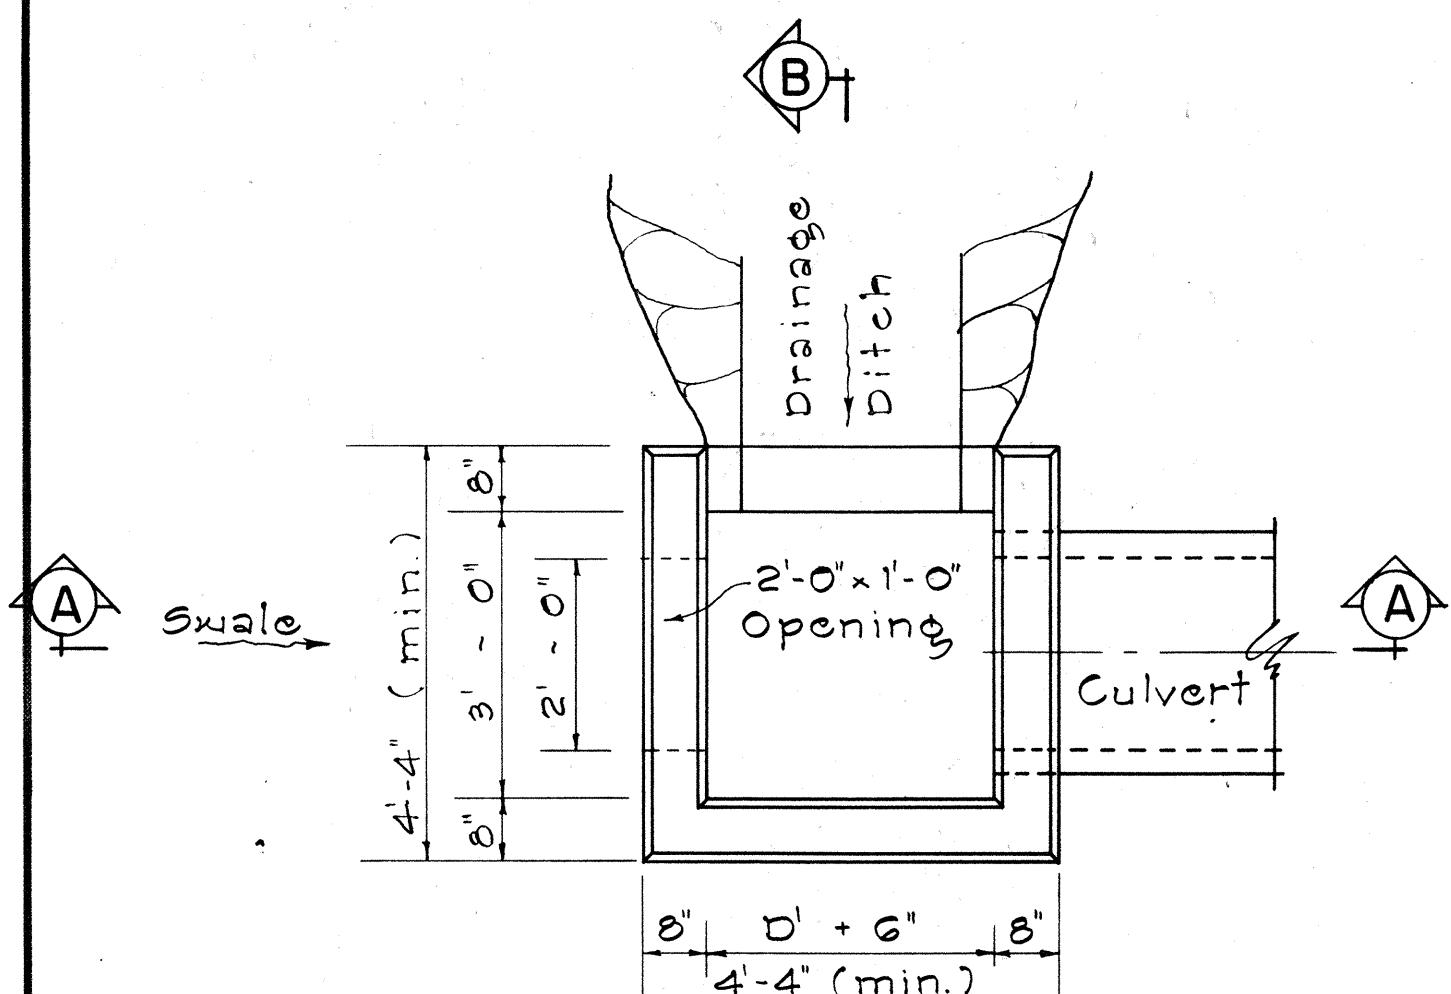


PLAN

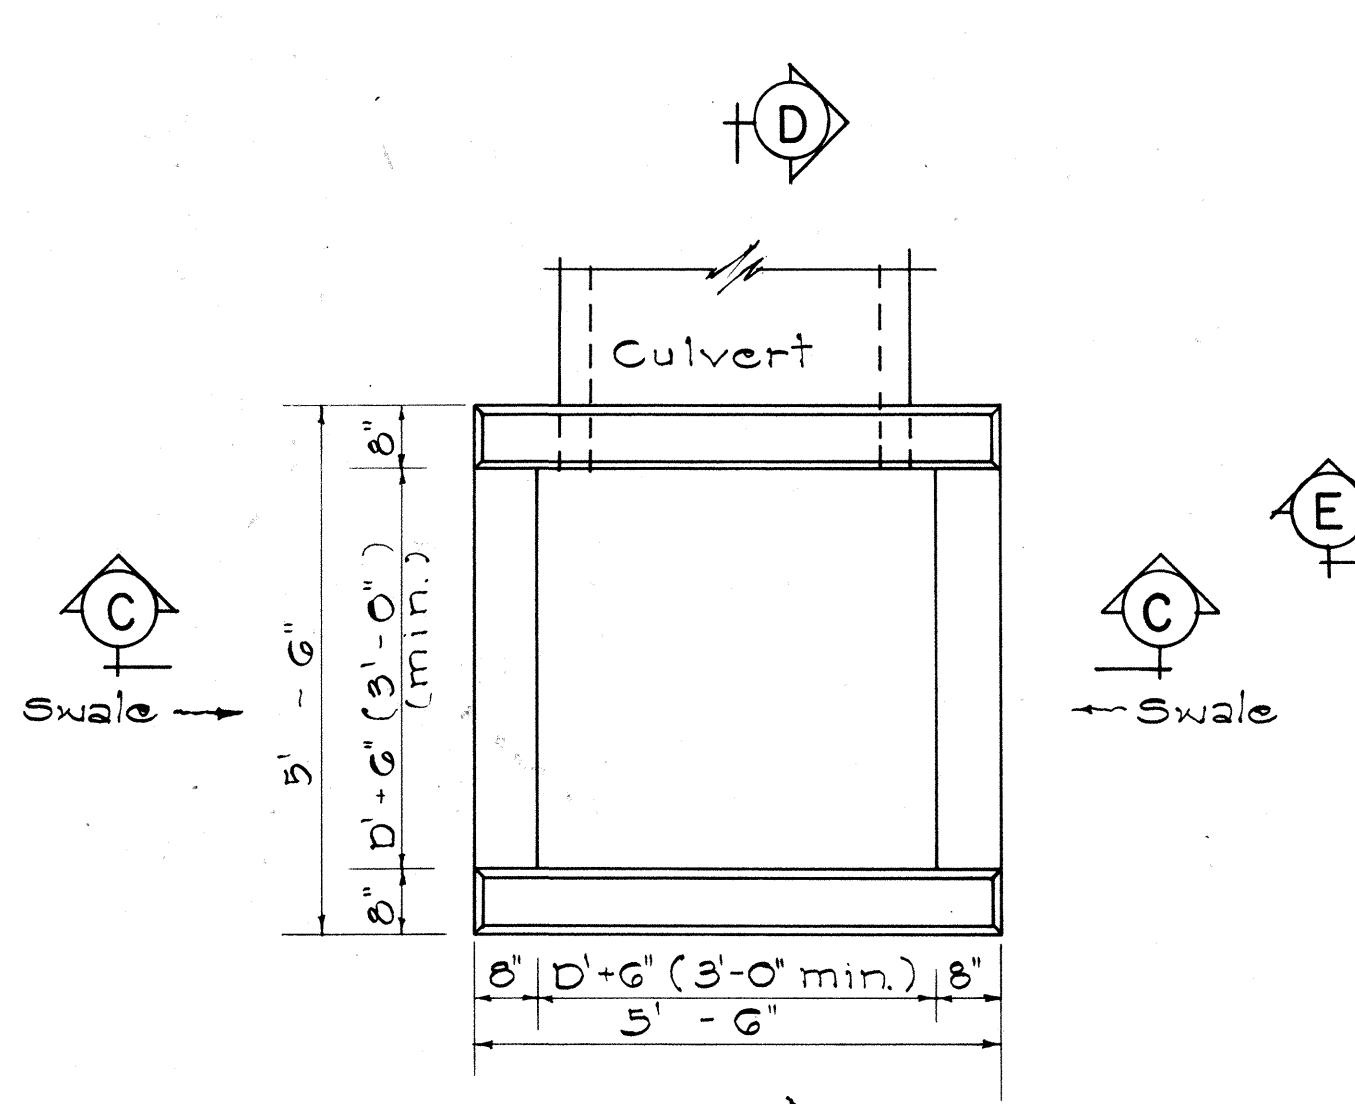


PLAN

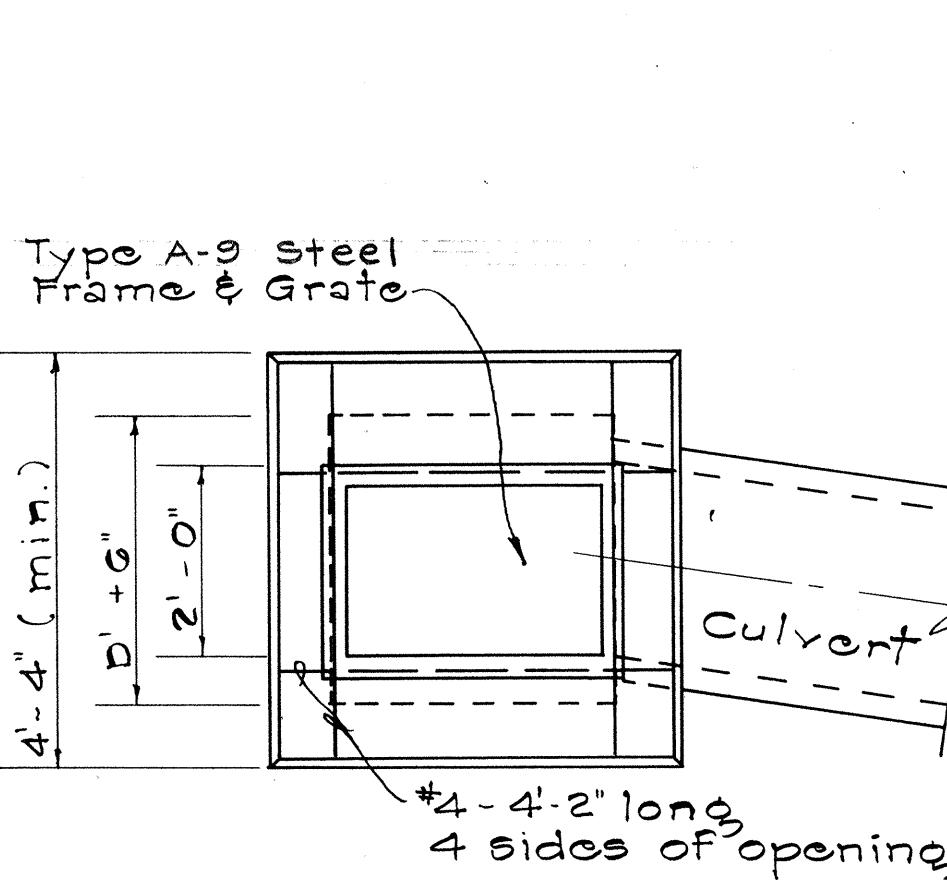


PLAN

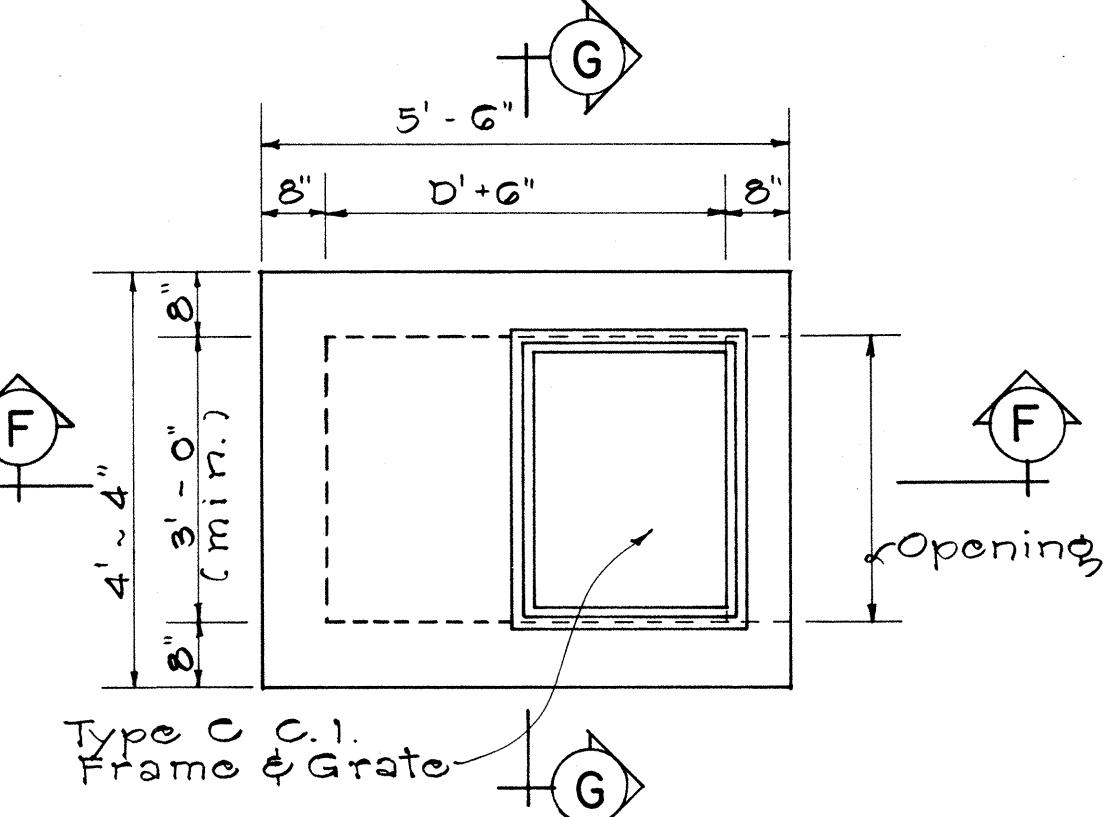


PLAN

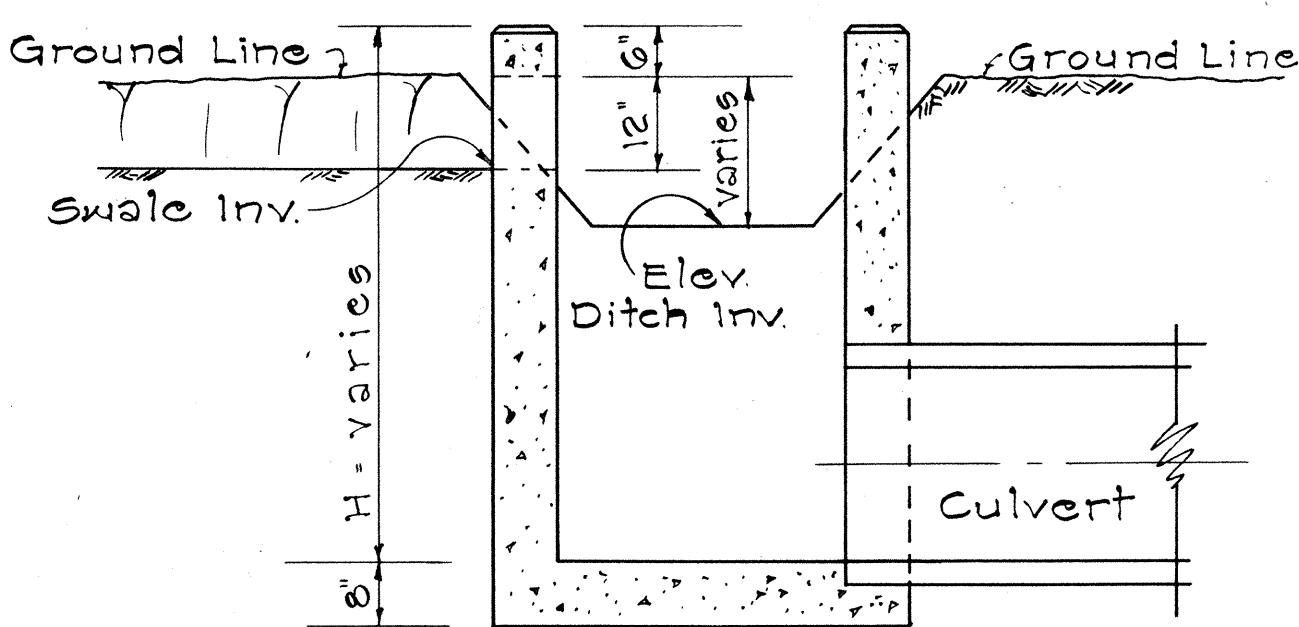


SECTION "A-A"

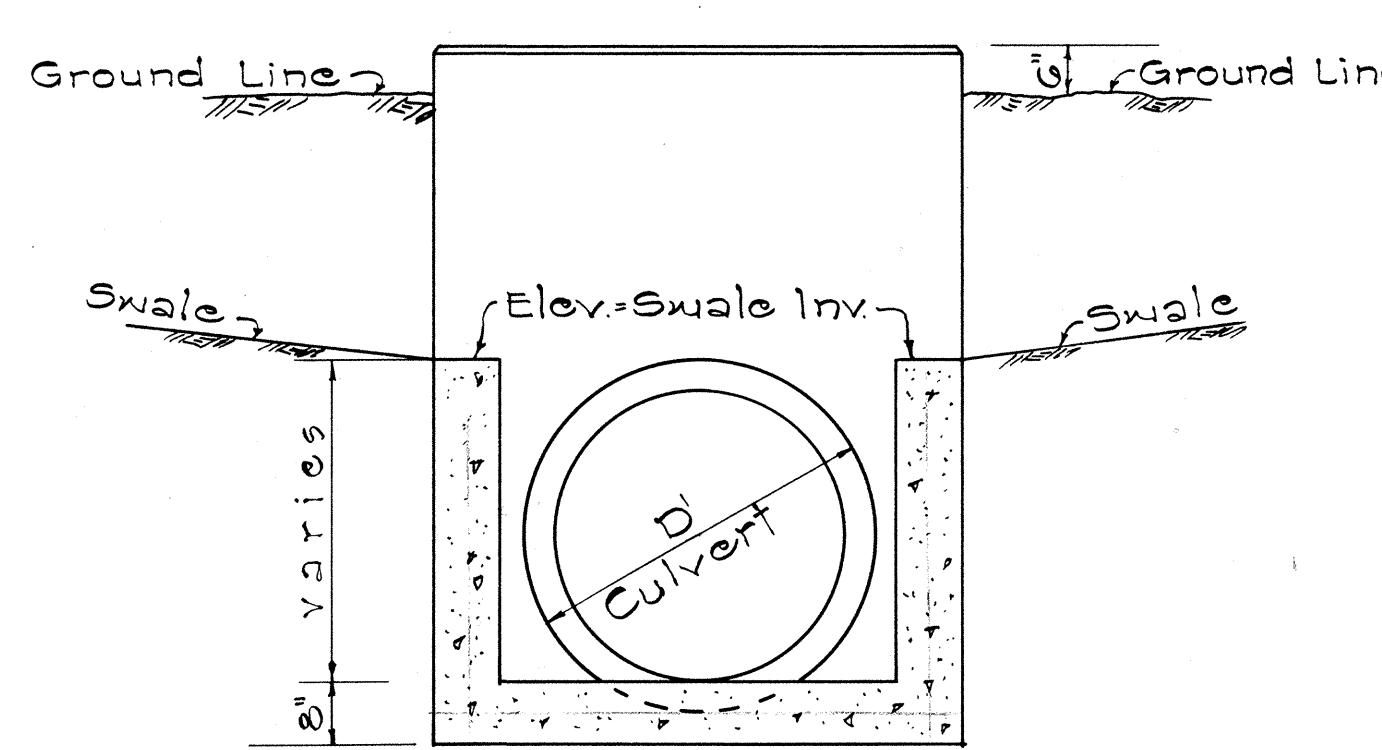


SECTION "C-C"

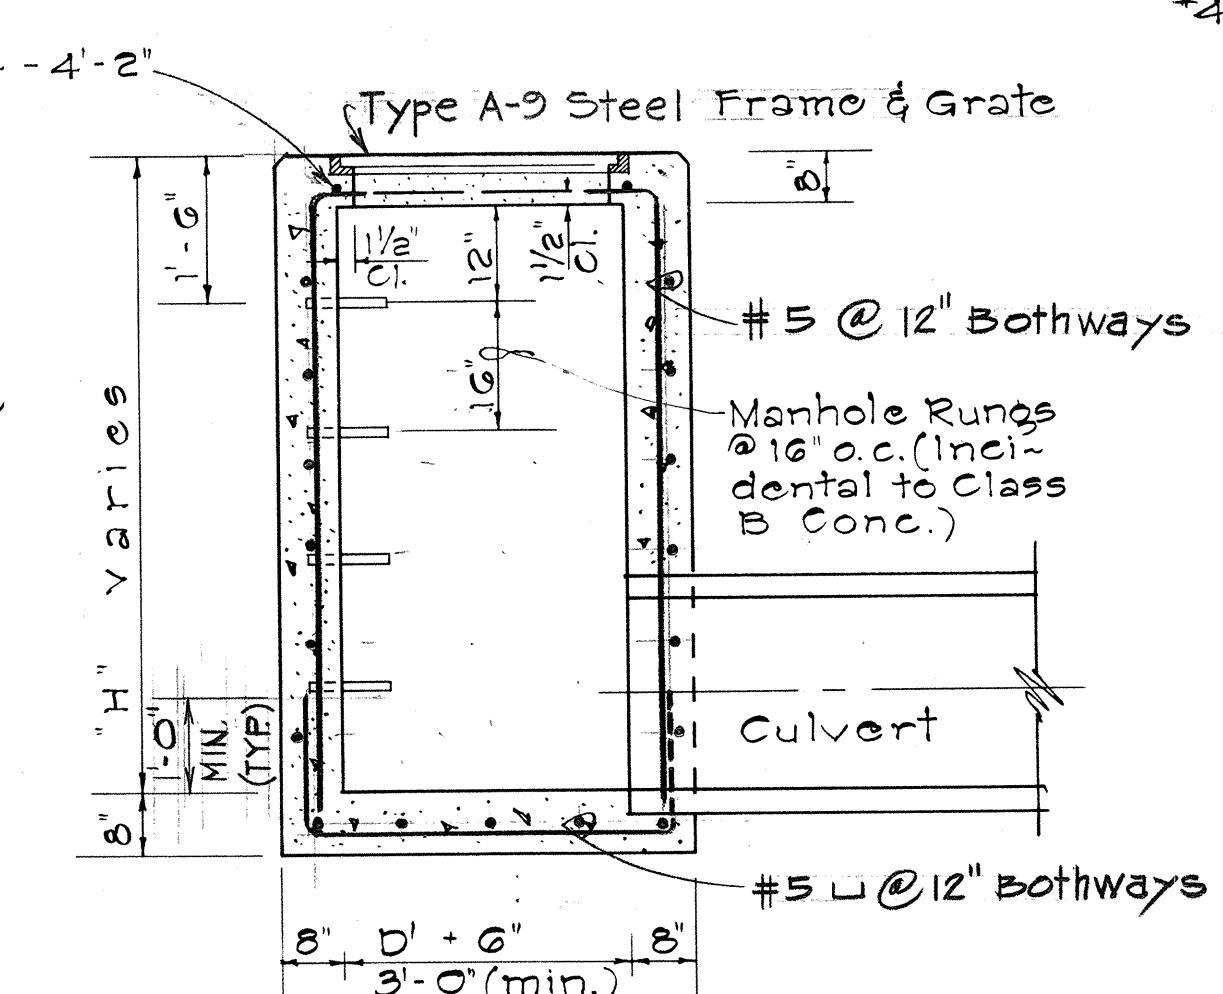


SECTION "E-E"

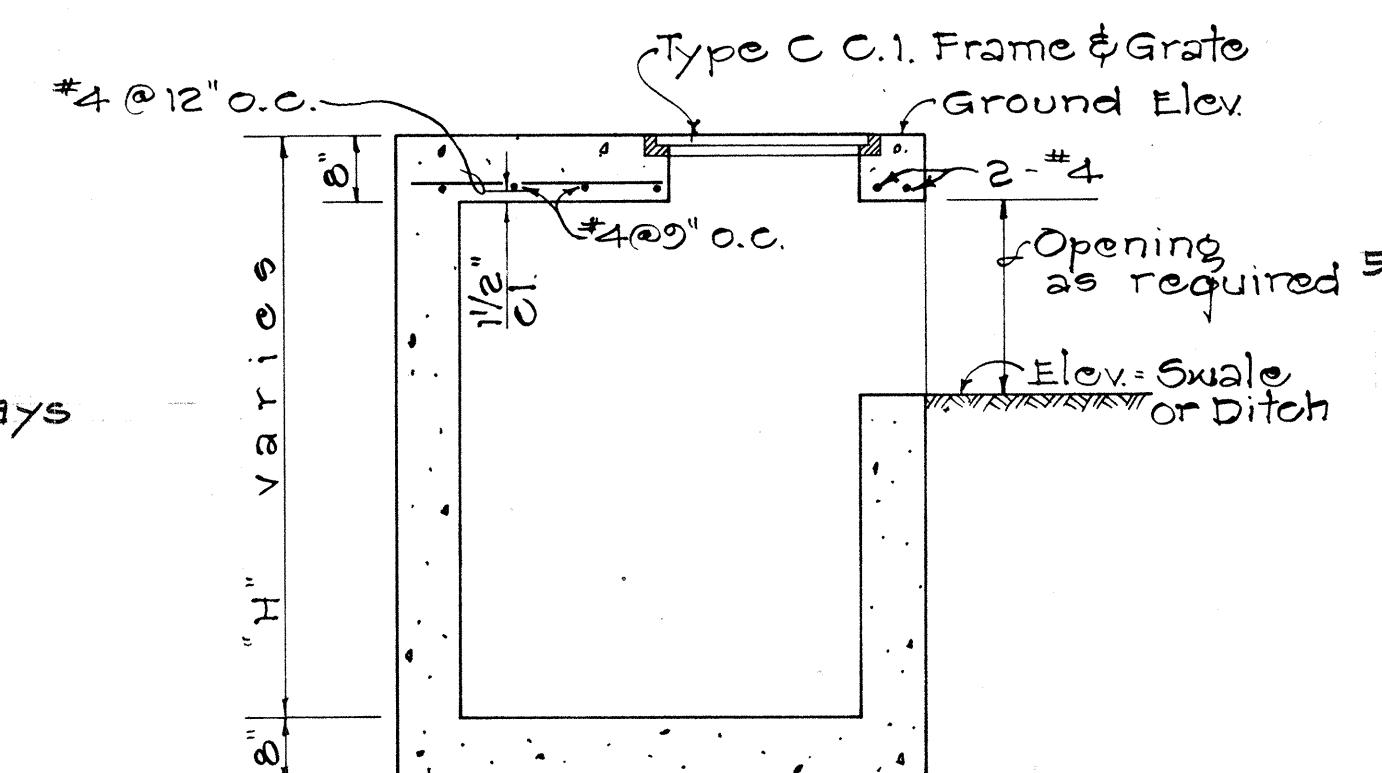

SECTION "F-F"

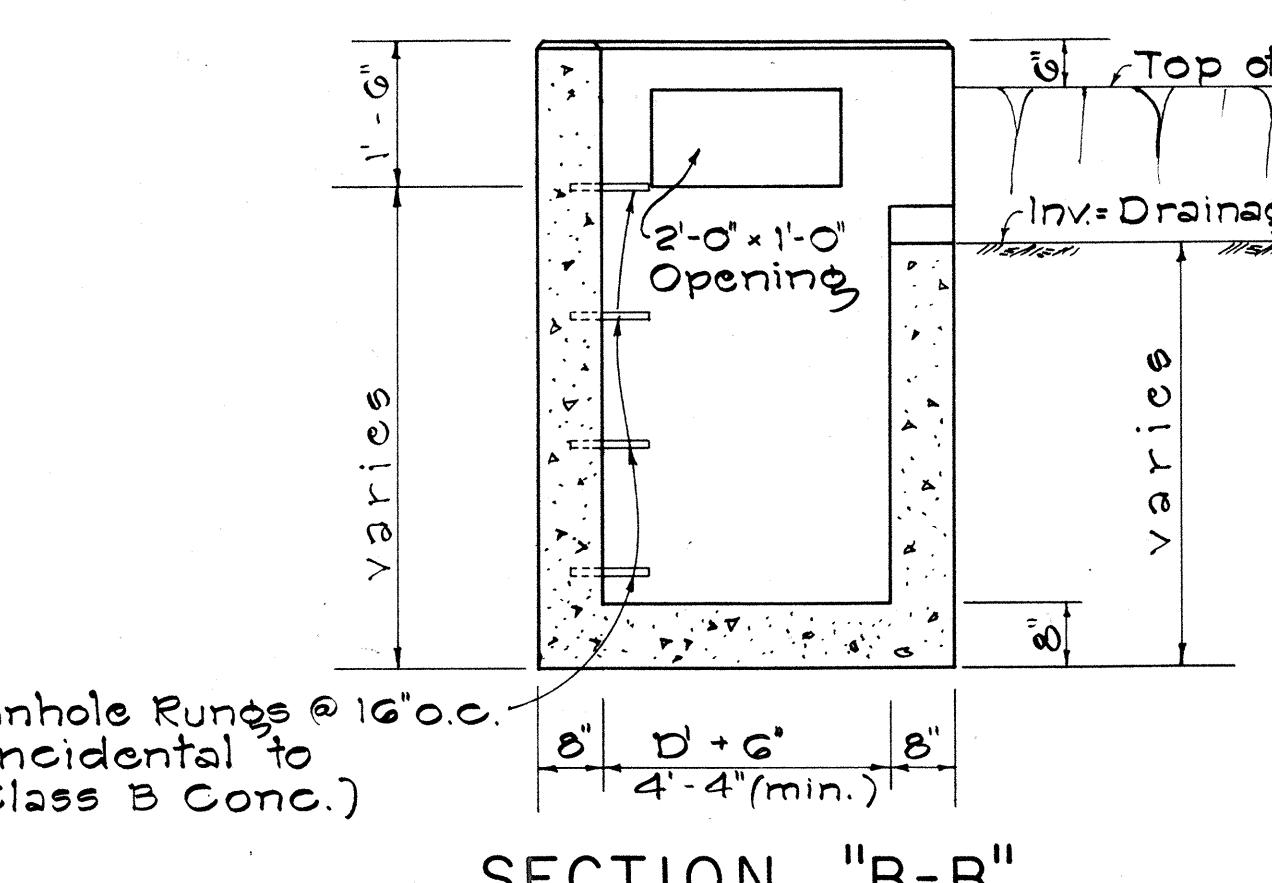

SECTION "B-B"

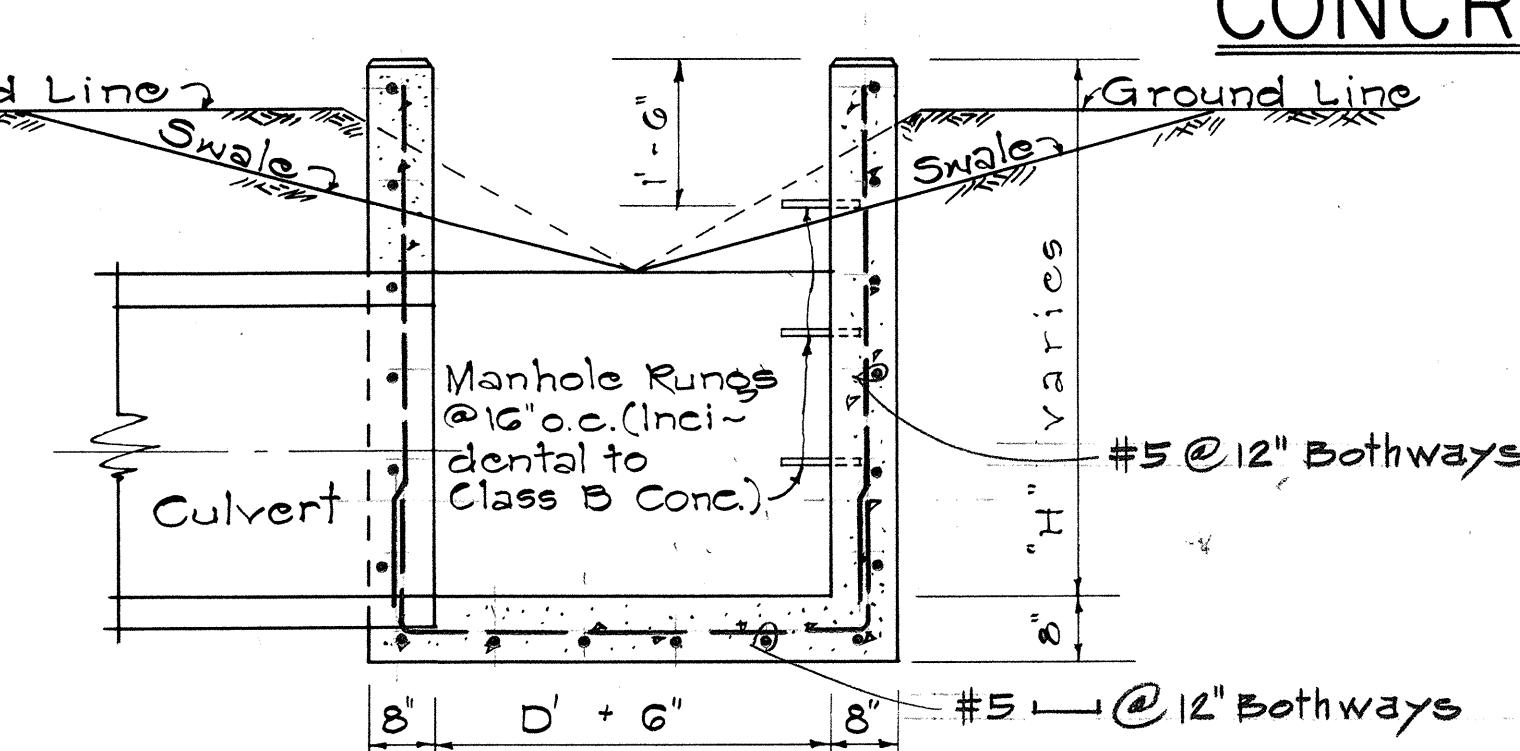

SECTION "D-D"

TYPE "A" CONCRETE DROP INTAKE

Scale: 1/2" = 1'-0"

TYPE "B" CONCRETE DROP INTAKE


Scale: 1/2" = 1'-0"

TYPE "C" GRATED CONCRETE DROP INTAKE

Scale: 1/2" = 1'-0"

TYPE "D" GRATED CONCRETE DROP INTAKE

Scale: 1/2" = 1'-0"

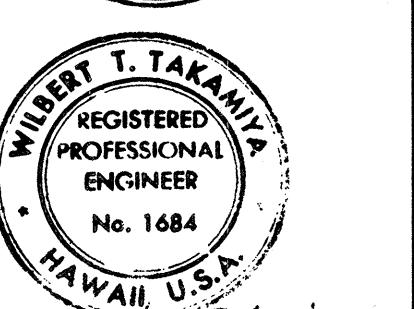

WILSON T. TAKAHASHI
THIS WORK WAS PREPARED BY ME
OR UNDER MY SUPERVISION.

NO.	REVISION	APPROVED BY	DATE

STATE OF HAWAII
DEPARTMENT OF TRANSPORTATION
HIGHWAYS DIVISION

TYPE "A", "B", "C", AND "D"
CONCRETE DROP INTAKE

Scale: As Noted
Date: July, 1969
SHEET No. 17 OF 17 SHEETS DH 19