


2-LAYER OF ROCK SCREENING
W/ POLYETHYLENE SHT BELOW
IN PLANTERS

FED. ROAD DIST. NO.	STATE	FED. AID PROJ. NO.	FISCAL YEAR	SHEET NO.	TOTAL SHEETS
HAWAII	HAW.	1-HI-1(73)15	1974	1	369

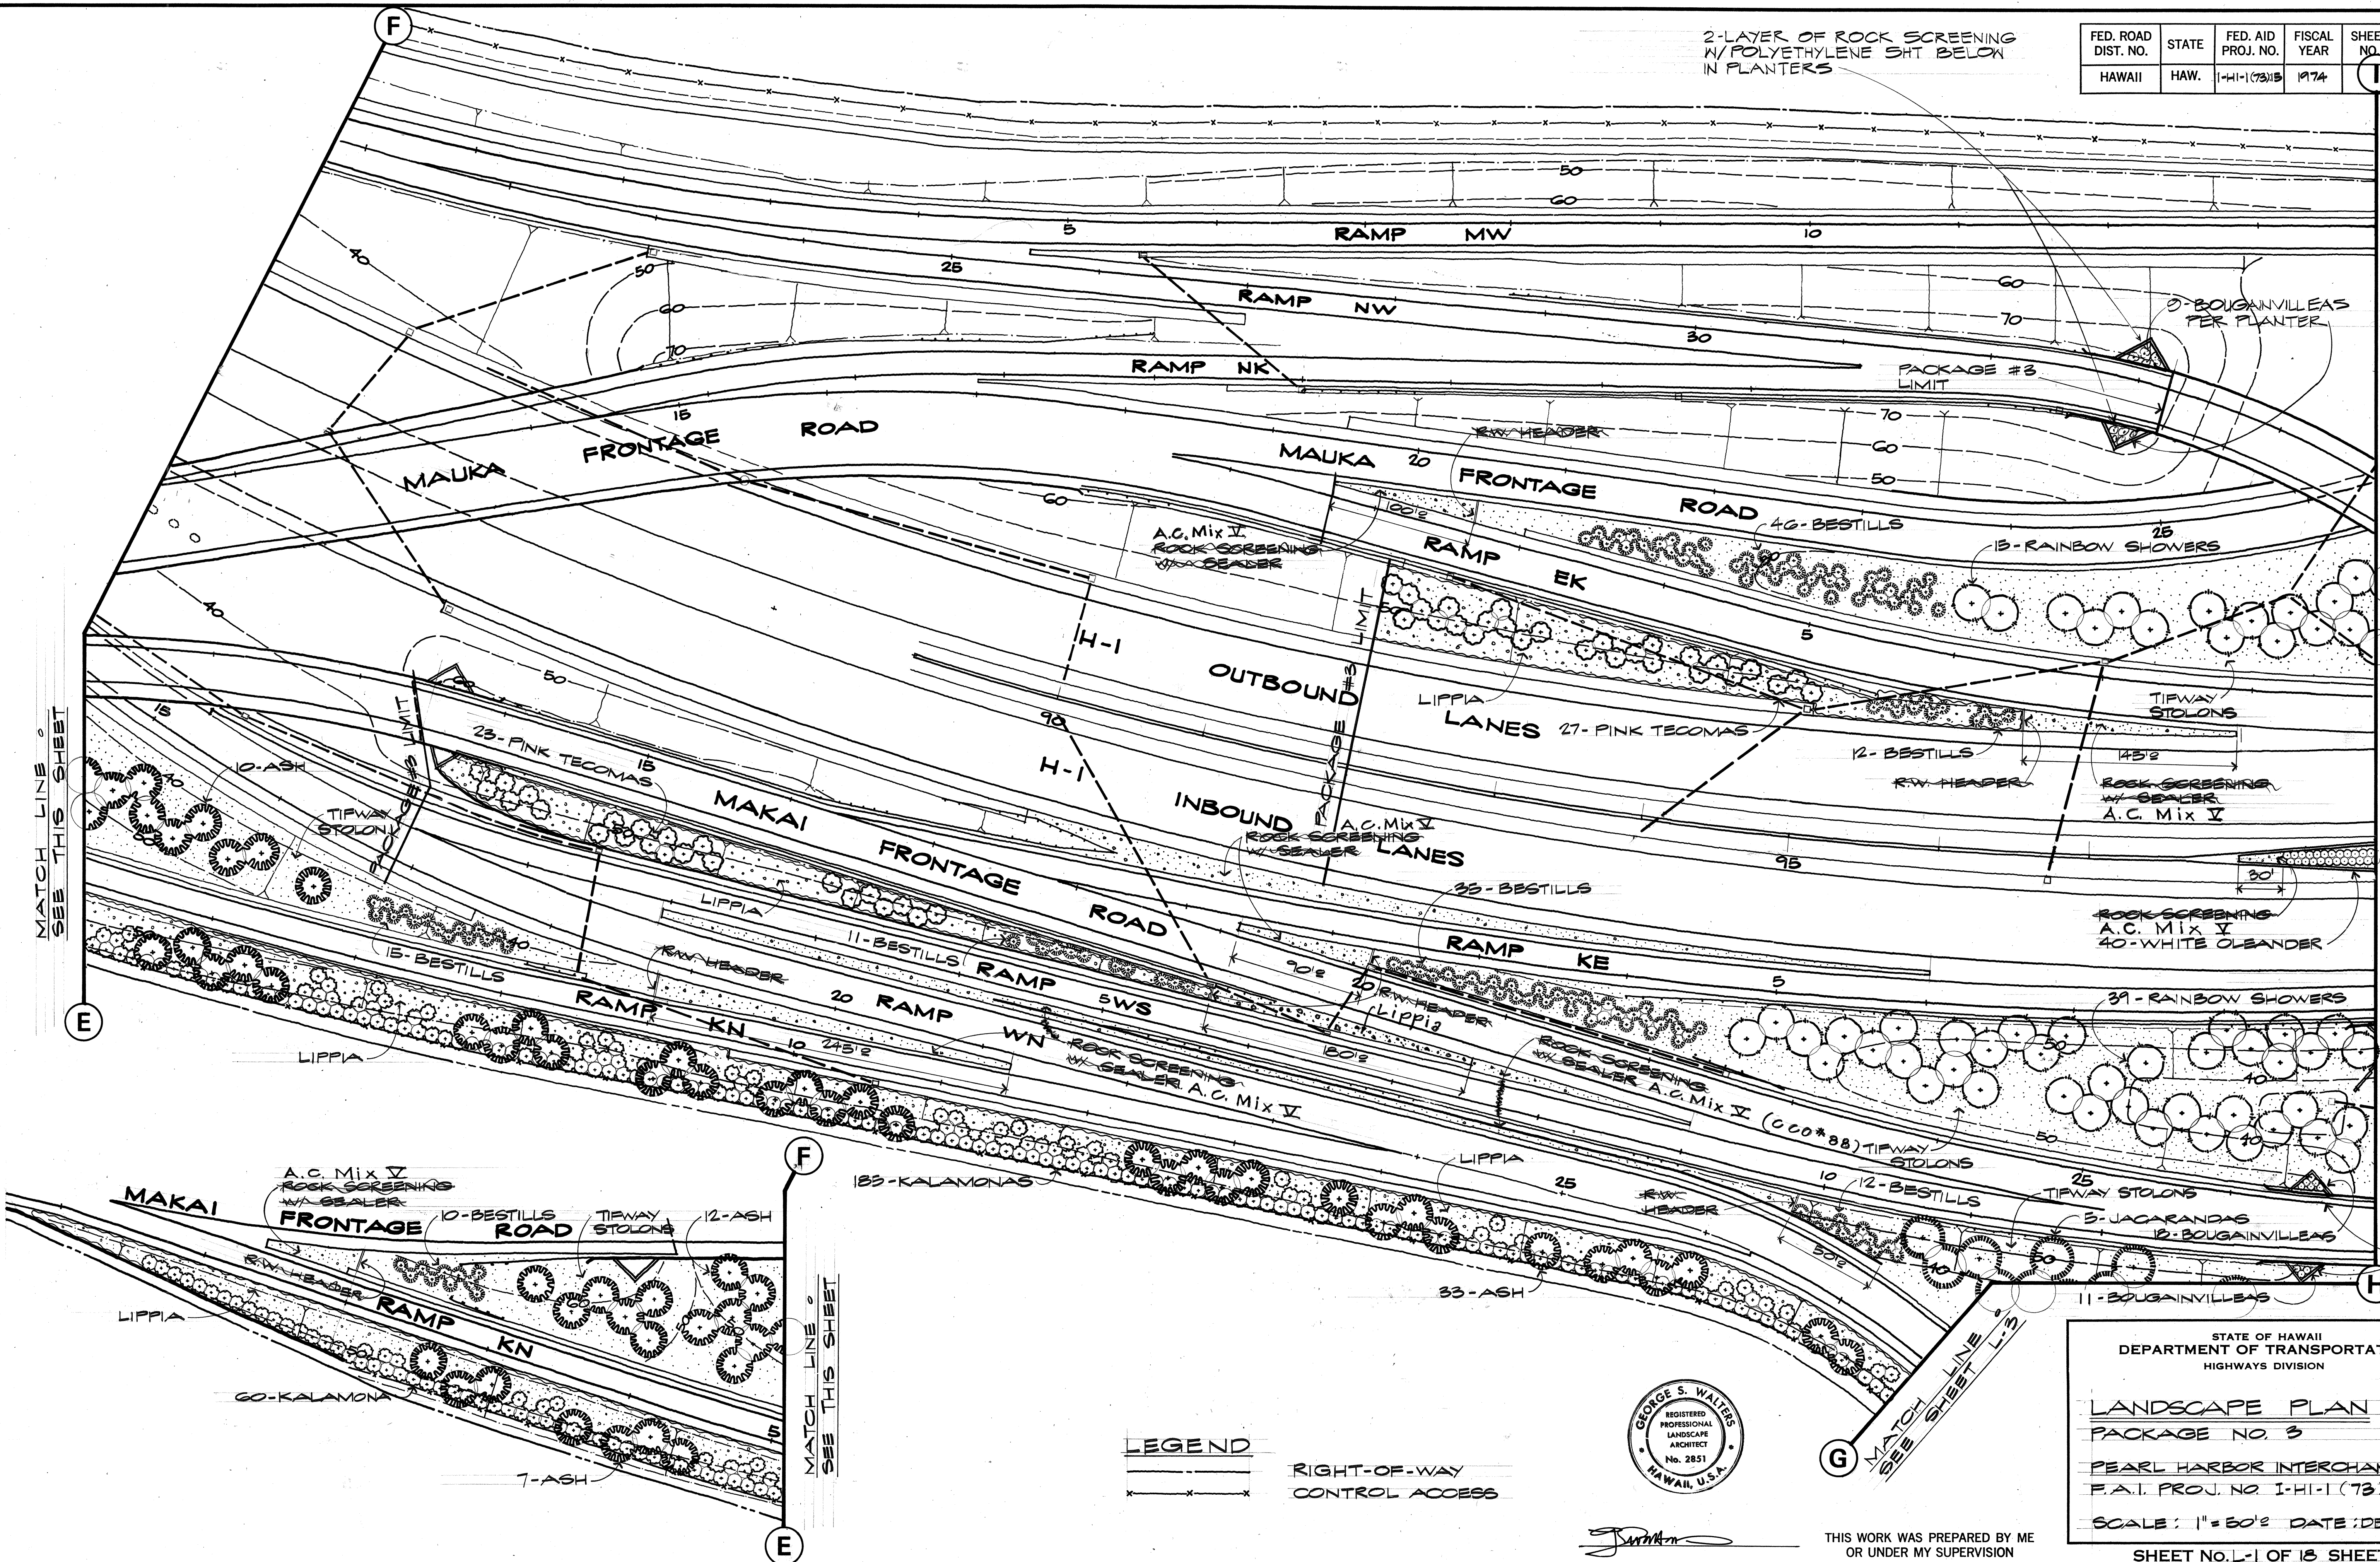

ORIGINAL PLAN	DATE
SURVEY PLOTTED BY	DATE
DRAWN BY	DATE
DESIGNED BY	DATE
QUANTITIES BY	DATE
CHECKED BY	DATE

LEGEND
--- RIGHT-OF-WAY
--- CONTROL ACCESS



STATE OF HAWAII
DEPARTMENT OF TRANSPORTATION
HIGHWAYS DIVISION

LANDSCAPE PLAN
PACKAGE NO. 3


PEARL HARBOR INTERCHANGE
F.A.I. PROJ. NO. 1-HI-1(73)15

SCALE: 1" = 30' DATE: DEC. 7, 1973

SHEET NO. L-1 OF 13 SHEETS


THIS WORK WAS PREPARED BY ME
OR UNDER MY SUPERVISION

FED. ROAD DIST. NO.	STATE	FED. AID PROJ. NO.	FISCAL YEAR	SHEET NO.	TOTAL SHEETS
HAWAII	HAW.	I-H-1(73)15	1974	136	369

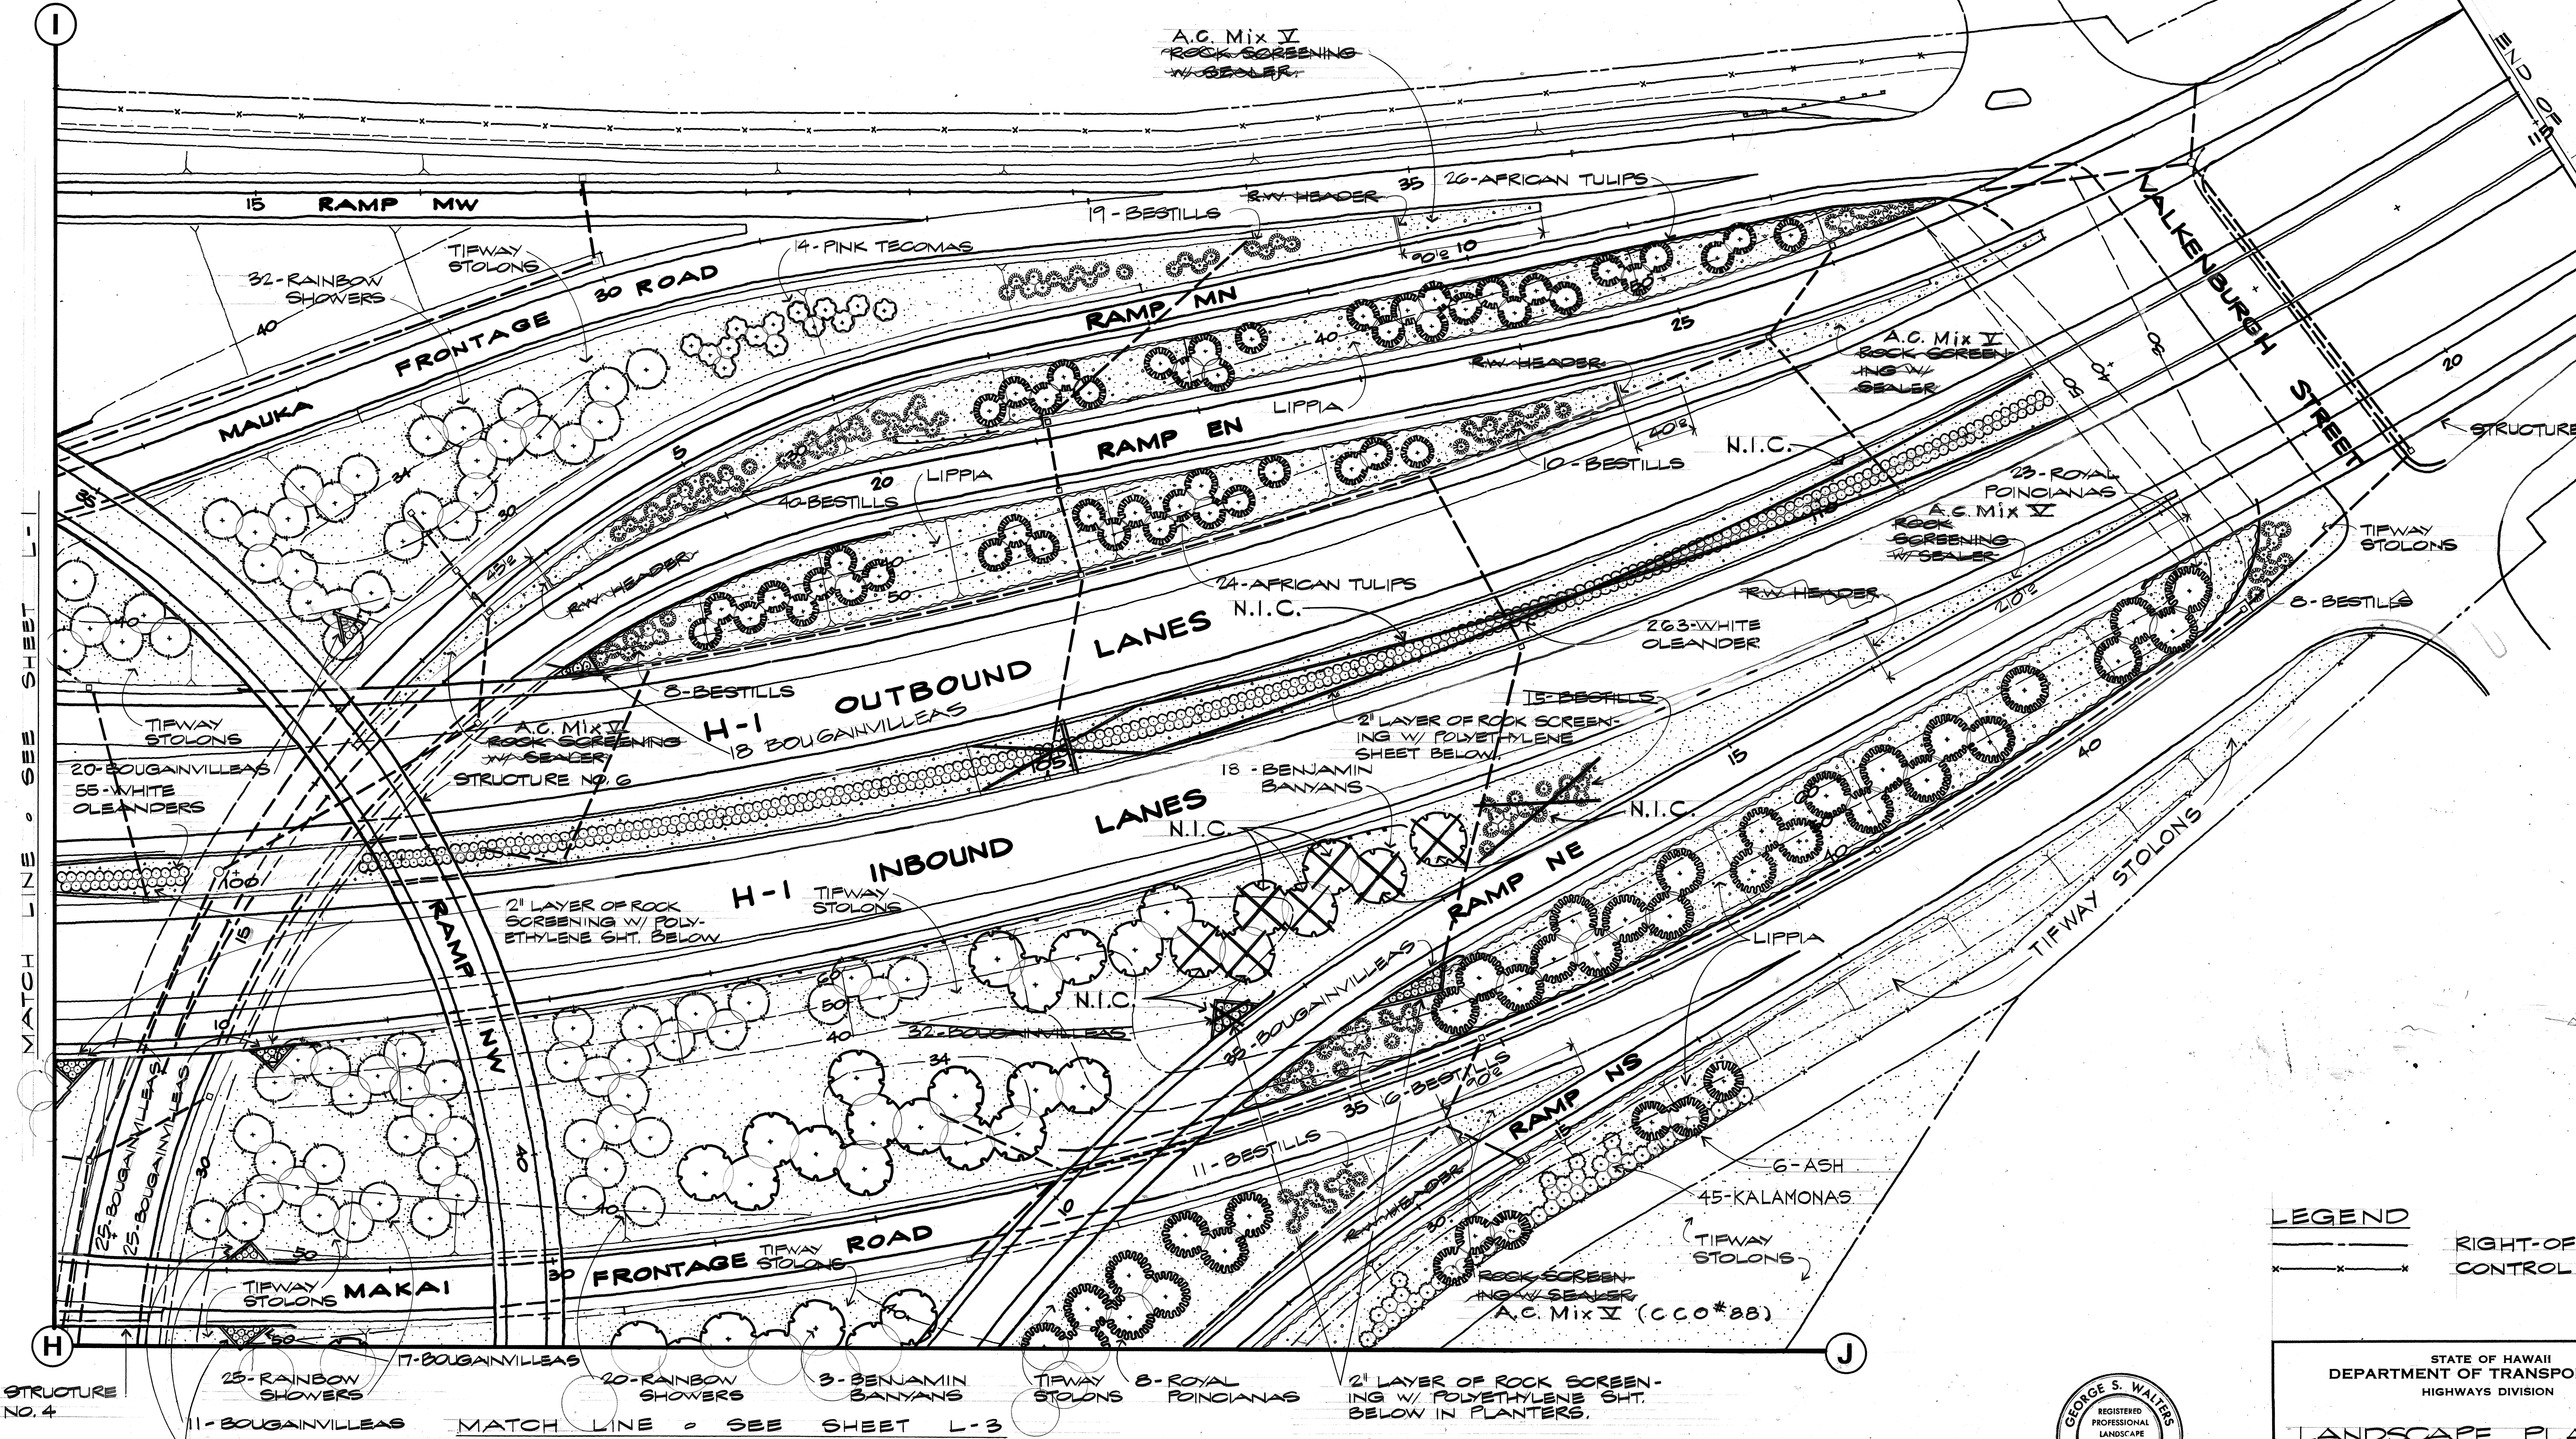

ORIGINAL PLAN	DATE
SURVEY PLOTTED BY	
DRAWN BY	
DESIGNED BY	
CHECKED BY	
NO.	

LEGEND
--- RIGHT-OF-WAY
--- CONTROL ACCESS

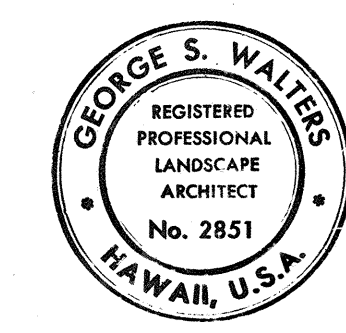

STATE OF HAWAII
DEPARTMENT OF TRANSPORTATION
HIGHWAYS DIVISION

LANDSCAPE PLAN
PACKAGE NO. 3

PEARL HARBOR INTERCHANGE
F.A.I. PROJ. NO. I-H-1 (73) 15


SCALE: 1"=50' DATE: DEC. 7, 1973

SHEET NO. L-2 OF 18 SHEETS

10/12/76	DELETED PLANTING MAKAI FR. DELETED PLANTINGS IN MEDIAN AND BETWEEN INBOUND LANES AND RAMP NE
4/26/74	ADDITIONAL BOUGAINVILLEA PLANTS
DATE	REVISION

THIS WORK WAS PREPARED BY ME OR UNDER MY SUPERVISION

FED. ROAD DIST. NO.	STATE	FED. AID PROJ. NO.	FISCAL YEAR	SHEET NO.	TOTAL SHEETS
HAWAII	HAW.	I-HI-1(73):15	1974	137	360

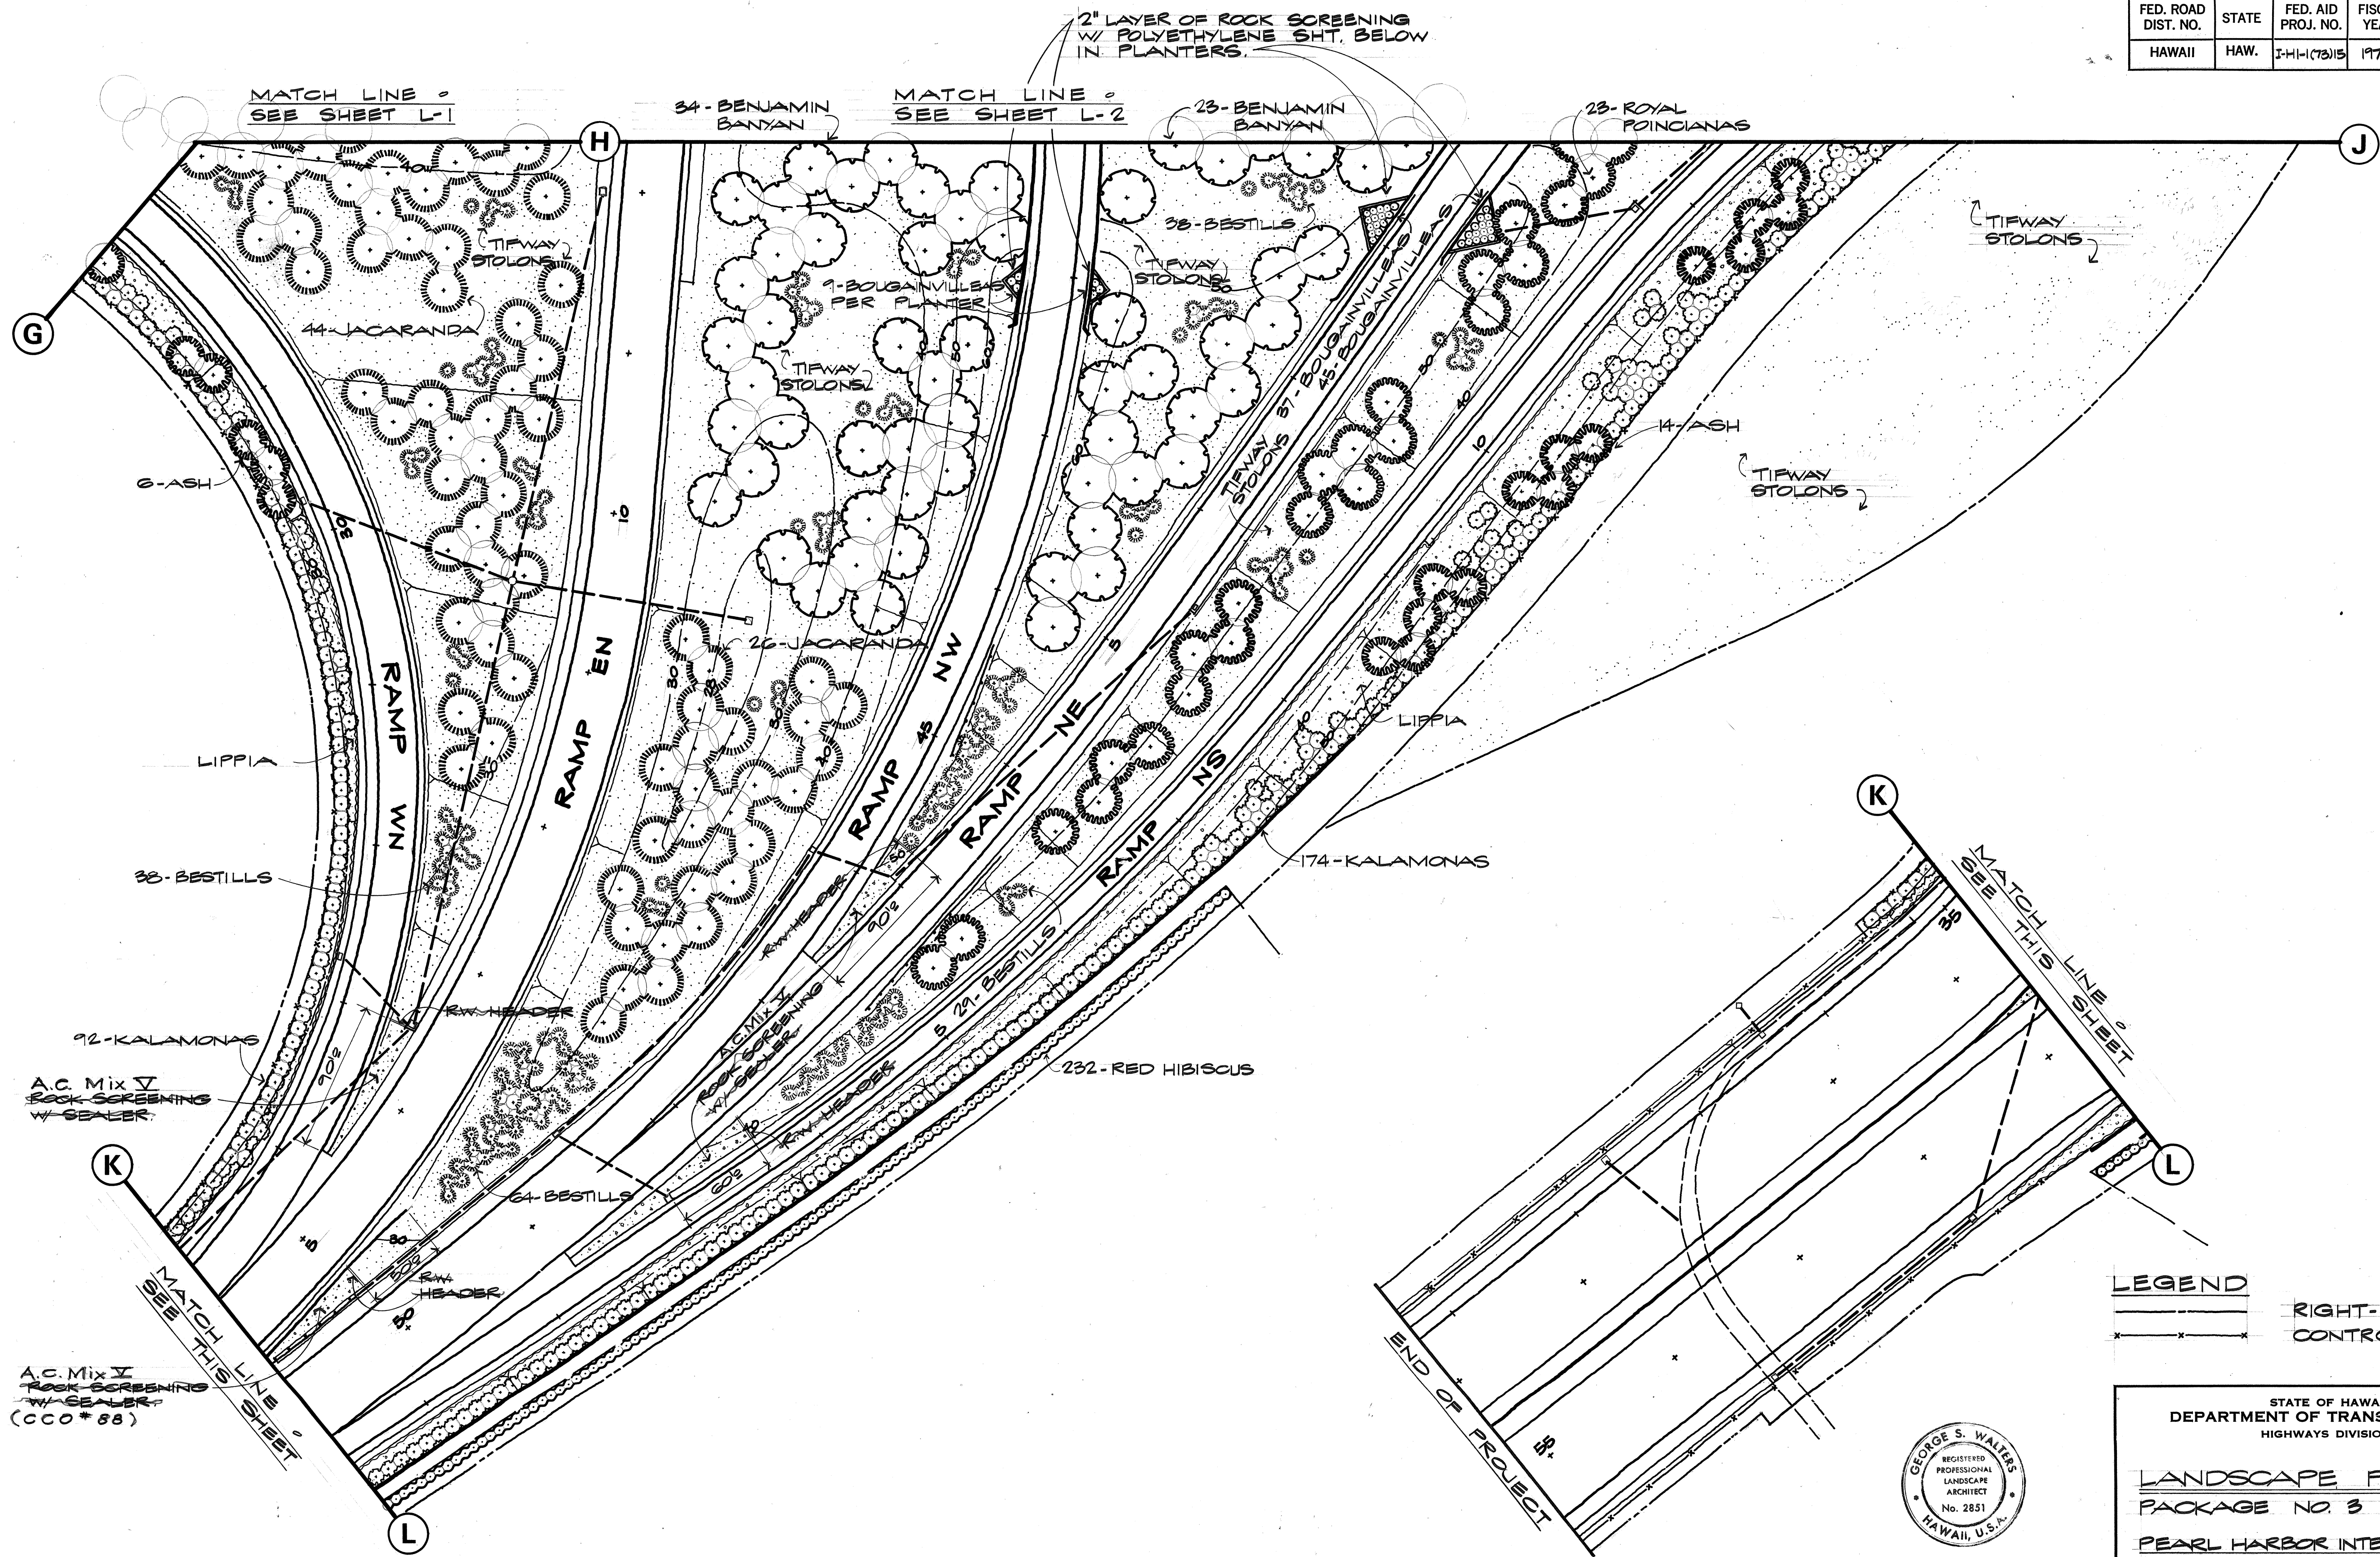

ORIGINAL PLAN	SURVEY PLOTTED BY	DATE
NOTE BOOK	DRAWN BY	
	TRACED BY	
	DESIGNED BY	
	QUANTITIES BY	
	CHECKED BY	
No.		

LEGEND

RIGHT-OF-WAY

CONTROL ACCESS



THIS WORK WAS PREPARED BY ME
OR UNDER MY SUPERVISION

STATE OF HAWAII
DEPARTMENT OF TRANSPORTATION
HIGHWAYS DIVISION



LANDSCAPE PLAN
PACKAGE NO. 3

PEARL HARBOR INTERCHANGE
F.A.I. PROJ. NO. I-HI-1 (73):15


SCALE: 1" = 50' DATE: DEC. 7, 1973

SHEET NO. L-3 OF 18 SHEETS

FED. ROAD DIST. NO.	STATE	FED. AID PROJ. NO.	FISCAL YEAR	SHEET NO.	TOTAL SHEETS
HAWAII	HAW.	I-HI-1(73)15	1974	138	369

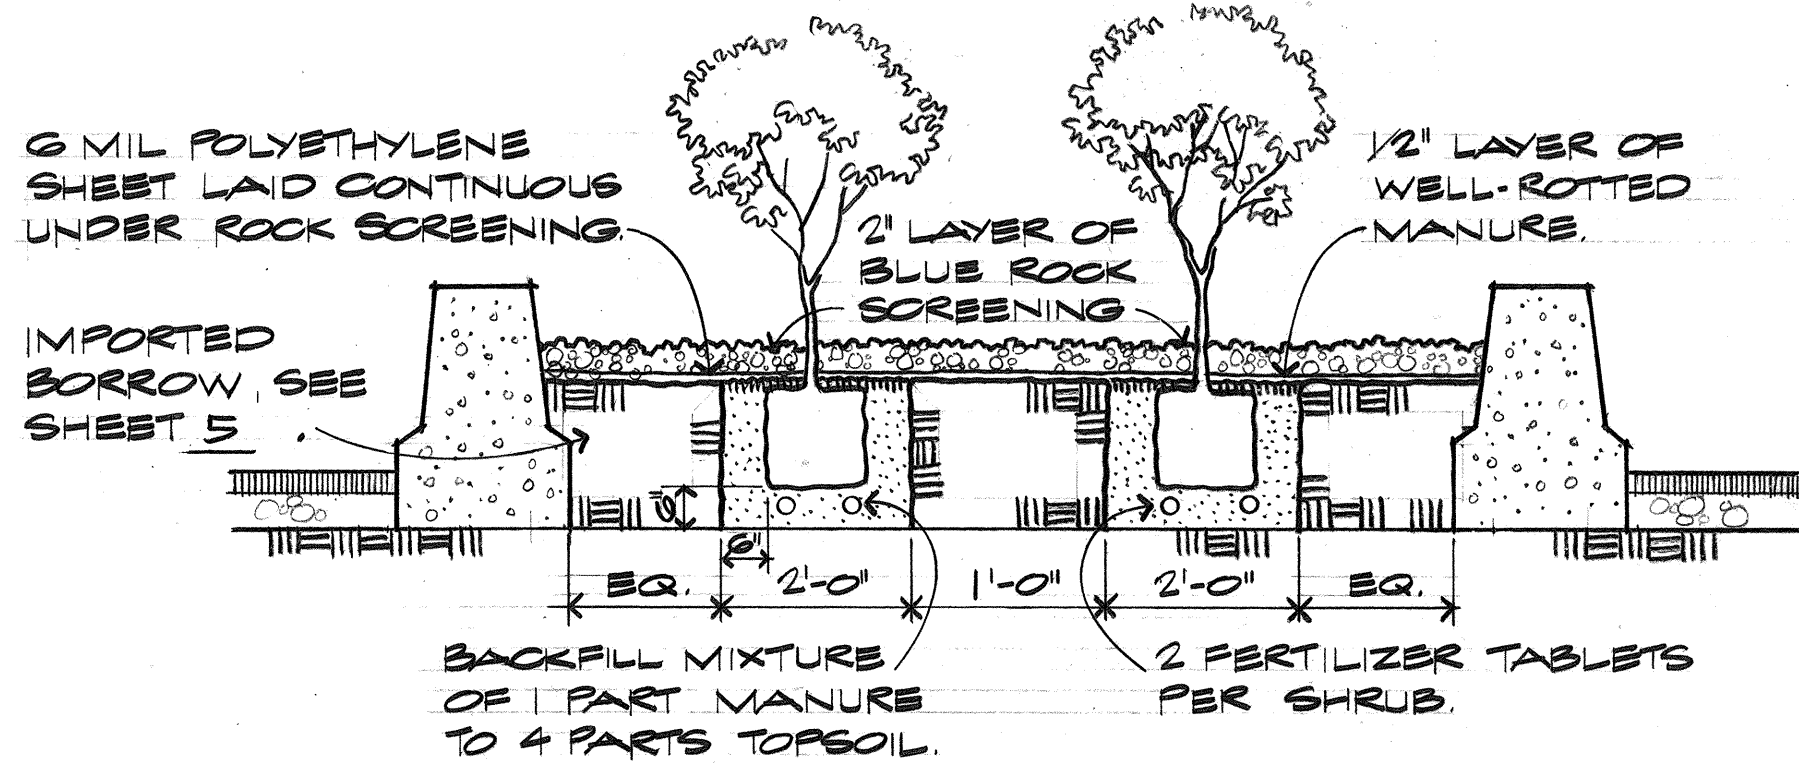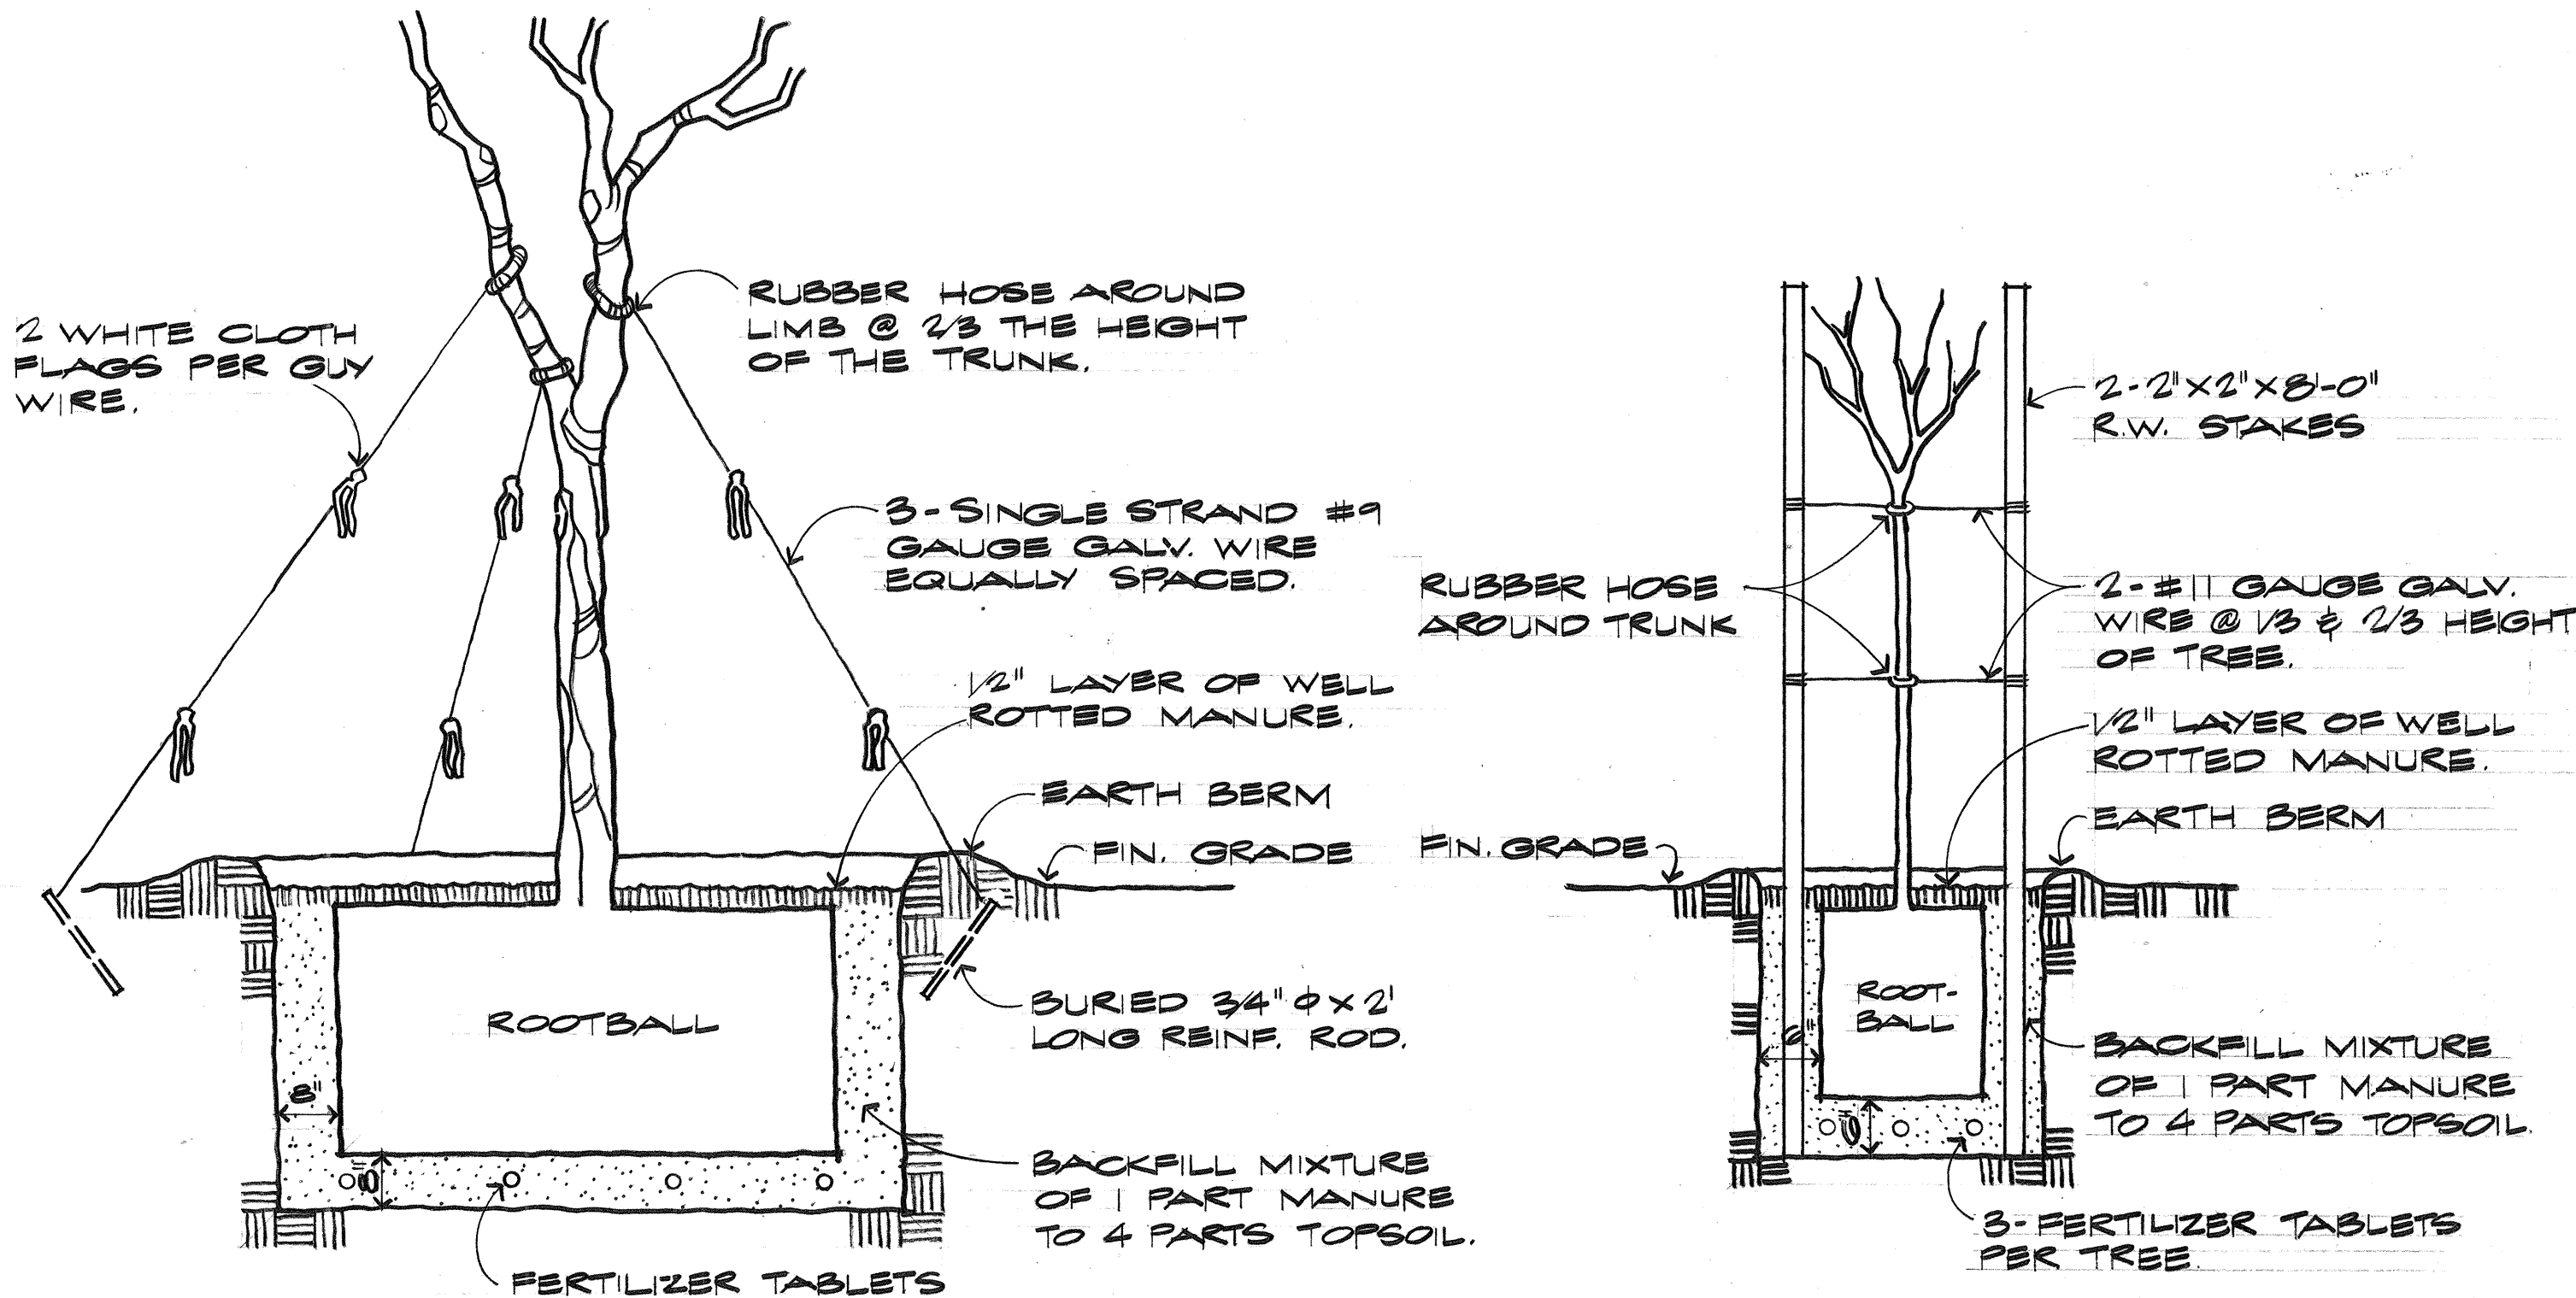

3 TYPICAL SHRUB PLANTING DETAIL IN PLANTER WALLS

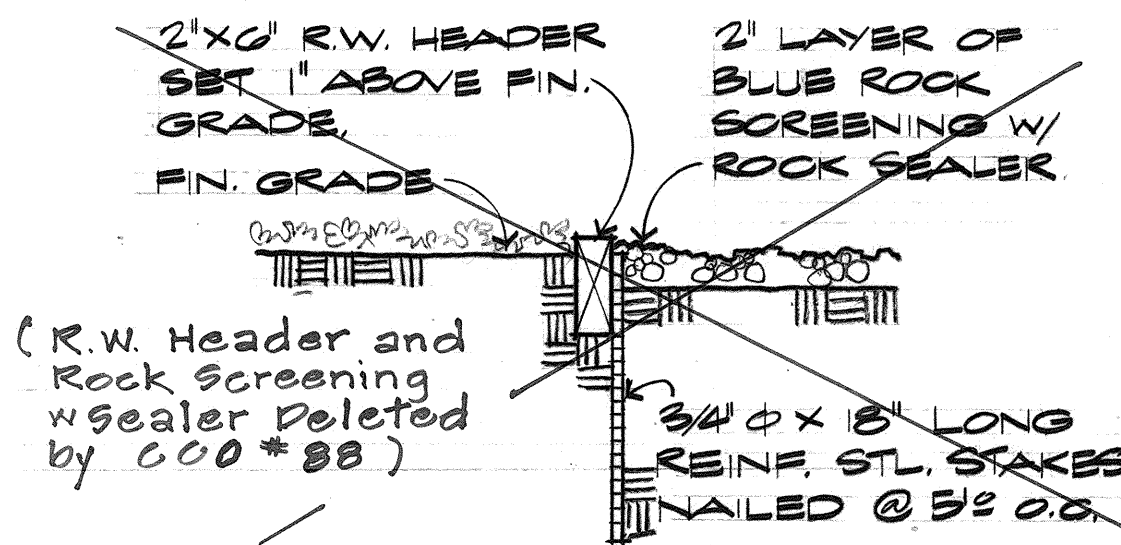


PLANT LIST				
	SYMBOL	QUANTITY	BOTANIC AND COMMON NAME	SIZE AND CONDITION
TREE		556 EACH	CASSIA GLAUCA (KALAMONA)	10 G.C., 6' HIGH, 3' SPD., 1 1/2" CAL.
		131 EACH	CASSIA JAVANICA X FISTULA (RAINBOW SHOWER)	25 G.C., 10' HIGH, 6' SPD., 4" CAL.
		54 EACH	DELONIX REGIA (ROYAL POINCIANA)	25 G.C., 10' HIGH, 5' SPD., 3" CAL.
		78 EACH	FICUS BENJAMINA (BENJAMIN BANYAN)	25 G.C., 12' HIGH, 6' SPD., 3" CAL.
		88 EACH	FRAXINUS UHDEI (ASH)	25 G.C., 12' HIGH, 6' SPD., 2 1/2" CAL.
		75 EACH	JACARANDA ACUTIFOLIA (JACARANDA)	25 G.C., 10' HIGH, 5' SPD., 4" CAL.
		50 EACH	SPATHODEA CAMPANULATA (AFRICAN TULIP)	25 G.C., 12' HIGH, 4' SPD., 3" CAL.
		64 EACH	TABEBUIA PENTAPHYLLA (PINK TECOMA)	25 G.C., 10' HIGH, 5' SPD., 3" CAL.
		303 EACH	THEVETIA NERIFOLIA (BESTILL)	10 G.C., 6' HIGH, 2' SPD., 1 1/2" CAL.
SHRUB		270 EACH	BOUGAINVILLEA SPECTABILIS VAR. MISS MANILA	5 G.C., 2' HIGH, 2' SPD. @ 3' O.C.
		232 EACH	HIBISCUS ROSA-SINENSIS (SINGLE RED HIBISCUS)	5 G.C., 3' HIGH, 2' SPD. @ 3' O.C.
		358 EACH	NERIUM OLEANDER (WHITE OLEANDER)	5 G.C., 3' HIGH, 2' SPD. @ 3' O.C. DOUBLE ROW, STAGGERED.
G.C.		±211,800 S.F.	LIPPIA REPENS (LIPPIA)	STOLONS, HYDROMULCHED
LAWN		±683,700 S.F.	CYNODON DACTYLON VAR. TIFTON 419 (TIFWAY)	STOLONS, HYDROMULCHED

NOTES TO CONTRACTOR:

1. PRIOR TO EXCAVATION, ALL TREE PLANTING LOCATIONS SHALL BE STAKED-OUT BY THE CONTRACTOR FOR APPROVAL BY THE ENGINEER.
2. MINIMUM CLEARANCE FROM EDGE OF PAVEMENT LINE SHALL BE 30 FEET FOR TREES AND 15 FEET FOR SHRUBS IN RELATIVELY FLAT TERRAIN. PLANTINGS MAY BE CLOSER THAN THE CLEARANCES MENTIONED ABOVE WHERE THERE ARE SLOPES, BARRIES, OR DEFLECTORS. DEVIATIONS FROM THIS REQUIREMENT SHALL BE APPROVED BY THE ENGINEER.
3. MINIMUM CLEARANCE FROM UNDERGROUND DRAINAGE, UTILITY STRUCTURES, AND WATER MAINS SHALL BE 8' FOR TREES (MEASURED TO TRUNK).
4. USE FERTILIZER TABLETS WITH A 20-10-5 ANALYSIS IN ALL PLANTING POCKETS AT THE FOLLOWING RATES:

5 G.C. STOCK	2 TABLETS
10 G.C. STOCK	3 TABLETS
25 G.C. STOCK	1 TABLET/ 1/2" OF CALIPER
5. ALL OUT AREAS TO BE HYDRO-MULCHED W/ TIFWAY AND LIPPIA STOLONS SHALL BE SCARIFIED TO A DEPTH OF ONE FOOT AND BACKFILLED W/ ONE FOOT OF IMPORTED TOPSOIL.

2. FILL SLOPES SHALL BE COVERED WITH A 6" LAYER OF TOPSOIL AND HYDRO-MULCHED WITH LIPPIA OR TIFWAY AS INDICATED ON THE PLANS AS THE WORK PROGRESSES, UNLESS OTHERWISE DIRECTED BY THE ENGINEER. IN NO CASE SHALL EXPOSED SURFACE BE GREATER THAN 15 FEET IN HEIGHT. NOTE THAT THE HYDRO-MULCHED EROSION CONTROL PLANTING WILL ALSO BE THE FINAL PLANTING.

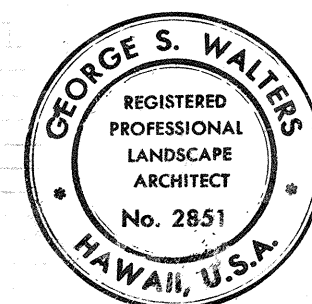

THIS WORK WAS PREPARED BY ME OR UNDER MY SUPERVISION

STATE OF HAWAII
DEPARTMENT OF TRANSPORTATION
HIGHWAYS DIVISION

LANDSCAPE DETAILS
PACKAGE NO. 3

PEARL HARBOR INTERCHANGE
F.A.I. PROJ. NO. I-HI-1 (73) 15

SCALE: NONE DATE: DEC. 7, 1973

SHEET NO. L-4 OF 18 SHEETS

C.O. 138R

ORIGINAL PLAN	DATE
SURVEY PLOTTED BY	
DRAWN BY	
TRACED BY	
NOTE BOOK DESIGNED BY	
QUANTITIES BY	
CHECKED BY	

10/12/76	REVISED KALAMONA, ASH, LIPPIA, TIFWAY, BESTILL, BANYAN AND OLEANDER QUANTITIES.
4/26/74	ADDITIONAL BOUGAINVILLEA PLANTS
DATE	REVISION