

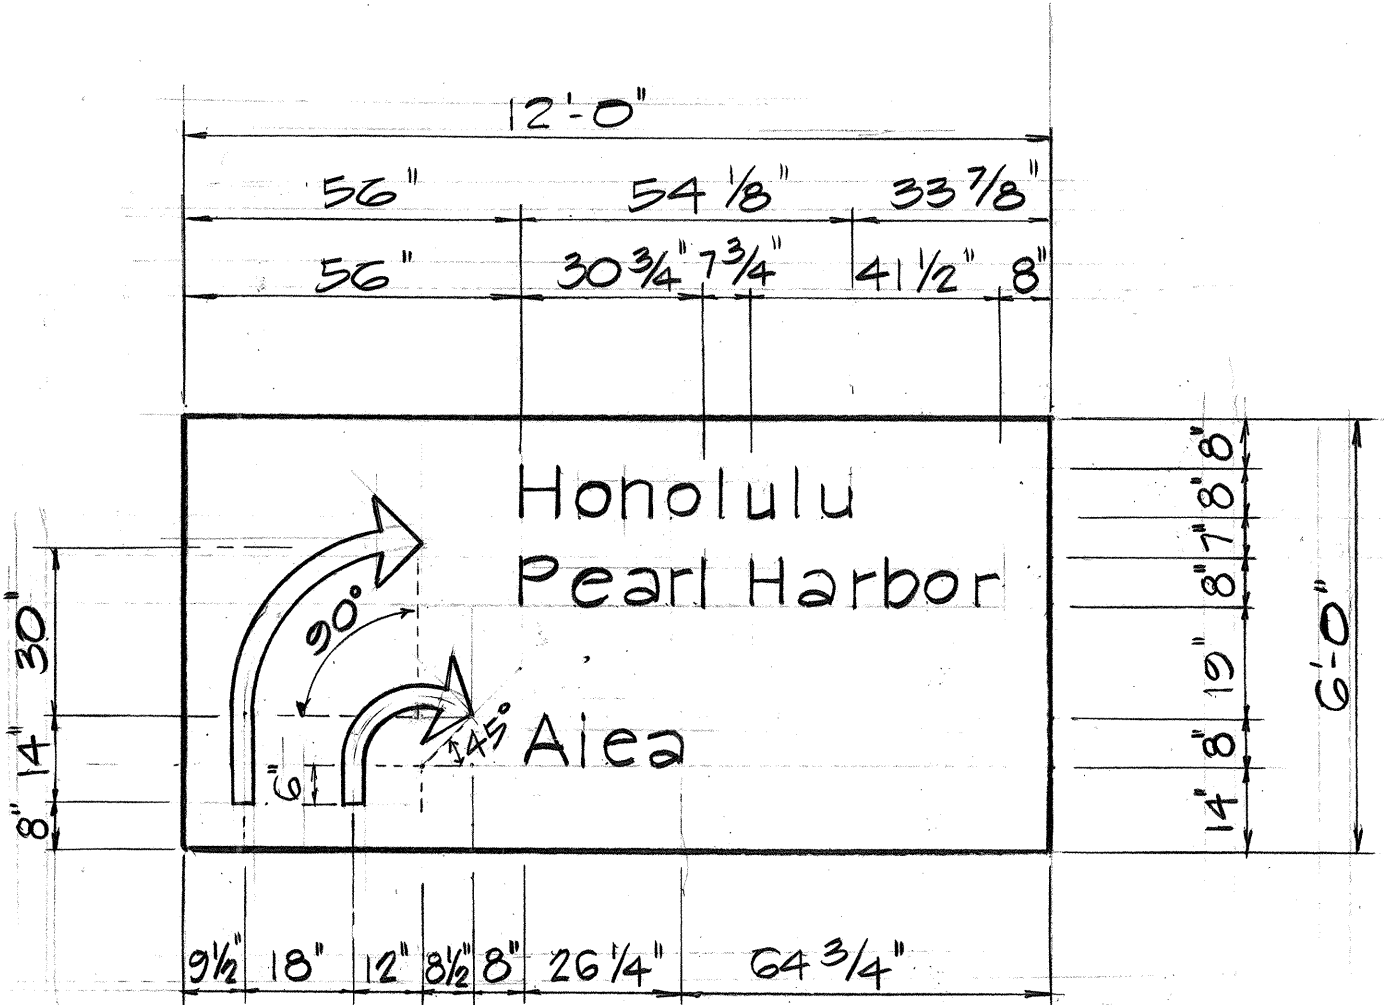


DATE	REVISION
5/10/76	ADDED LANE ON RAMP EN AND DETECTOR
5/10/76	ADDED TEMPORARY SIGN


FED. ROAD DIST. NO.	STATE	FED. AID PROJ. NO.	FISCAL YEAR	SHEET NO.	TOTAL SHEETS
HAWAII	HAW.	I-HI-1(73):15	1974	107	369

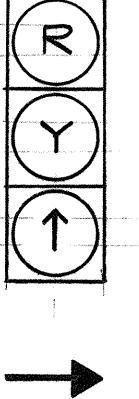

SIGN D-16
TEMPORARY DETOUR SIGN
PANEL LAYOUT

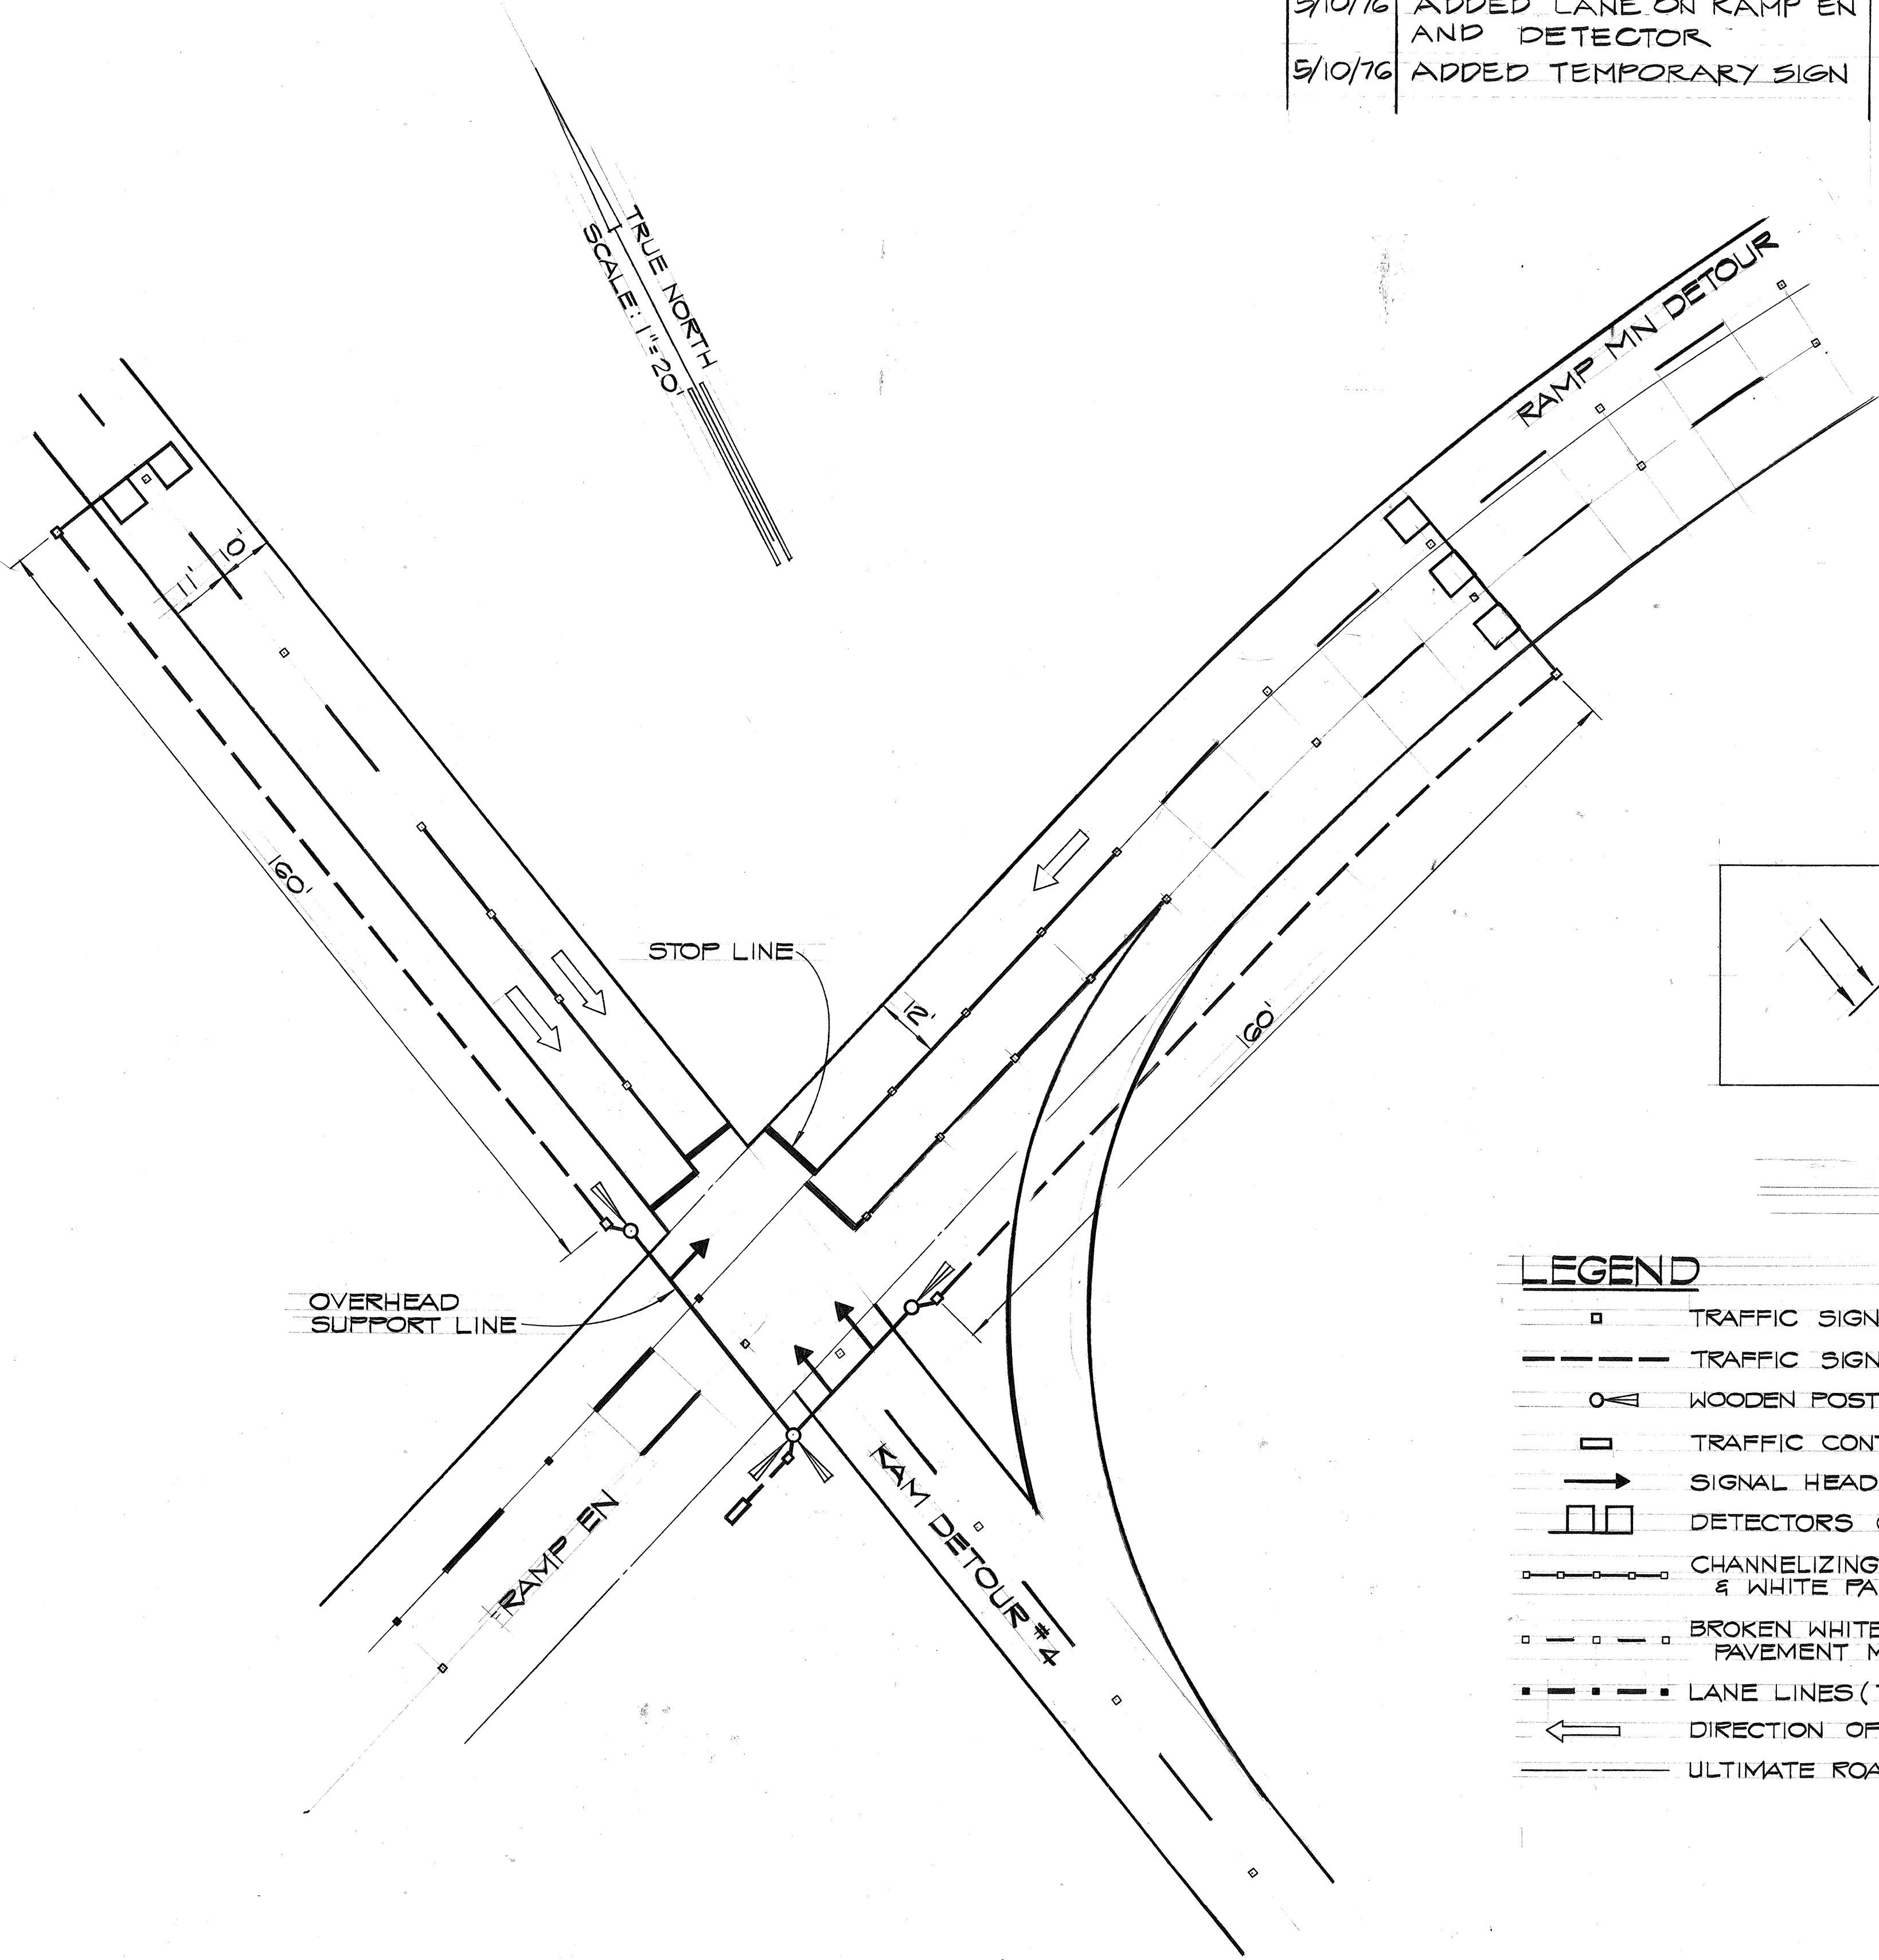

TRAFFIC SIGNAL HEAD
LENS ARRANGEMENT

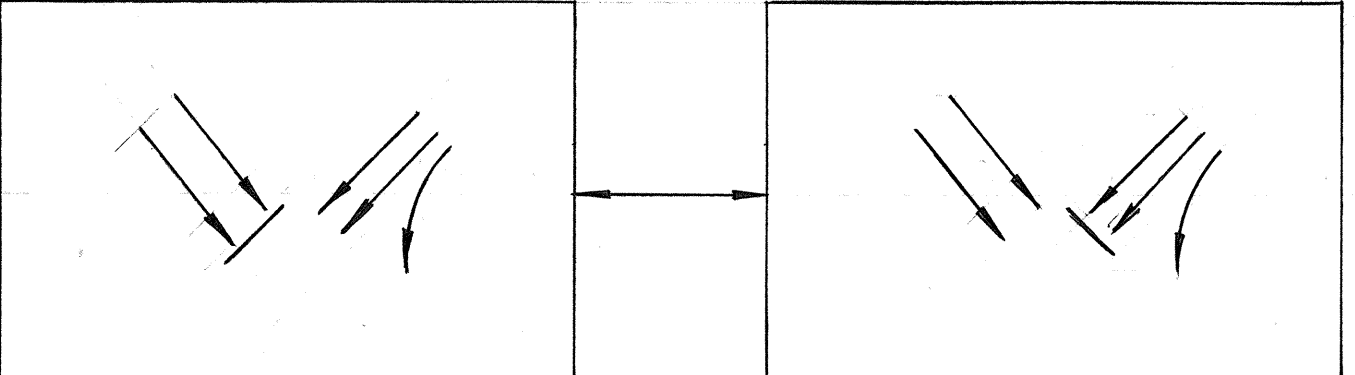


PHASE DIAGRAM

LEGEND

- TRAFFIC SIGNAL PULLBOX
- TRAFFIC SIGNAL CONDUIT (UNDERGROUND)
- WOODEN POST WITH GUY
- TRAFFIC CONTROLLER
- SIGNAL HEAD INDICATING DIRECTION
- DETECTORS 6' x 6'
- CHANNELIZING LINE (TYPE C PAVEMENT MARKERS & WHITE PAINTED STRIPES)
- BROKEN WHITE STRIPE WITH RAISED REFLECTORIZED PAVEMENT MARKERS
- LANE LINES (TYPE A & C PAVEMENT MARKERS)
- DIRECTION OF TRAVEL
- ULTIMATE ROADWAY

ORIGINAL	SURVEY PLOTTED BY	DATE
PLAN	DRAWN BY	
NOTE BOOK	DESIGNED BY	
QUANTITIES BY	CHECKED BY	
No.		

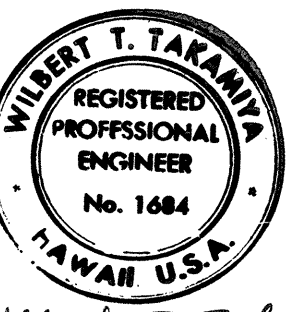

THIS WORK WAS PREPARED BY ME
OR UNDER MY SUPERVISION

STATE OF HAWAII
DEPARTMENT OF TRANSPORTATION
HIGHWAYS DIVISION
CCO #55
TRAFFIC DETOUR DETAILS
PEARL HARBOR INTERCHANGE
F.A.I. PROJ. NO. I-HI-1(73):15
SCALE: AS SHOWN DATE: DEC. 7, 1973
SHEET NO. 1 OF 1 SHEETS