


FED. ROAD DIST. NO.	STATE	FED. AID PROJ. NO.	FISCAL YEAR	SHEET NO.	TOTAL SHEETS
HAWAII	HAW.	I-HI-1(108)	1975	96	100

DATE	BY	FINAL SURVEY	NO. OF SHEETS	NO. OF SHEETS

DATE	BY	ORIGINAL SURVEY	NO. OF SHEETS	NO. OF SHEETS

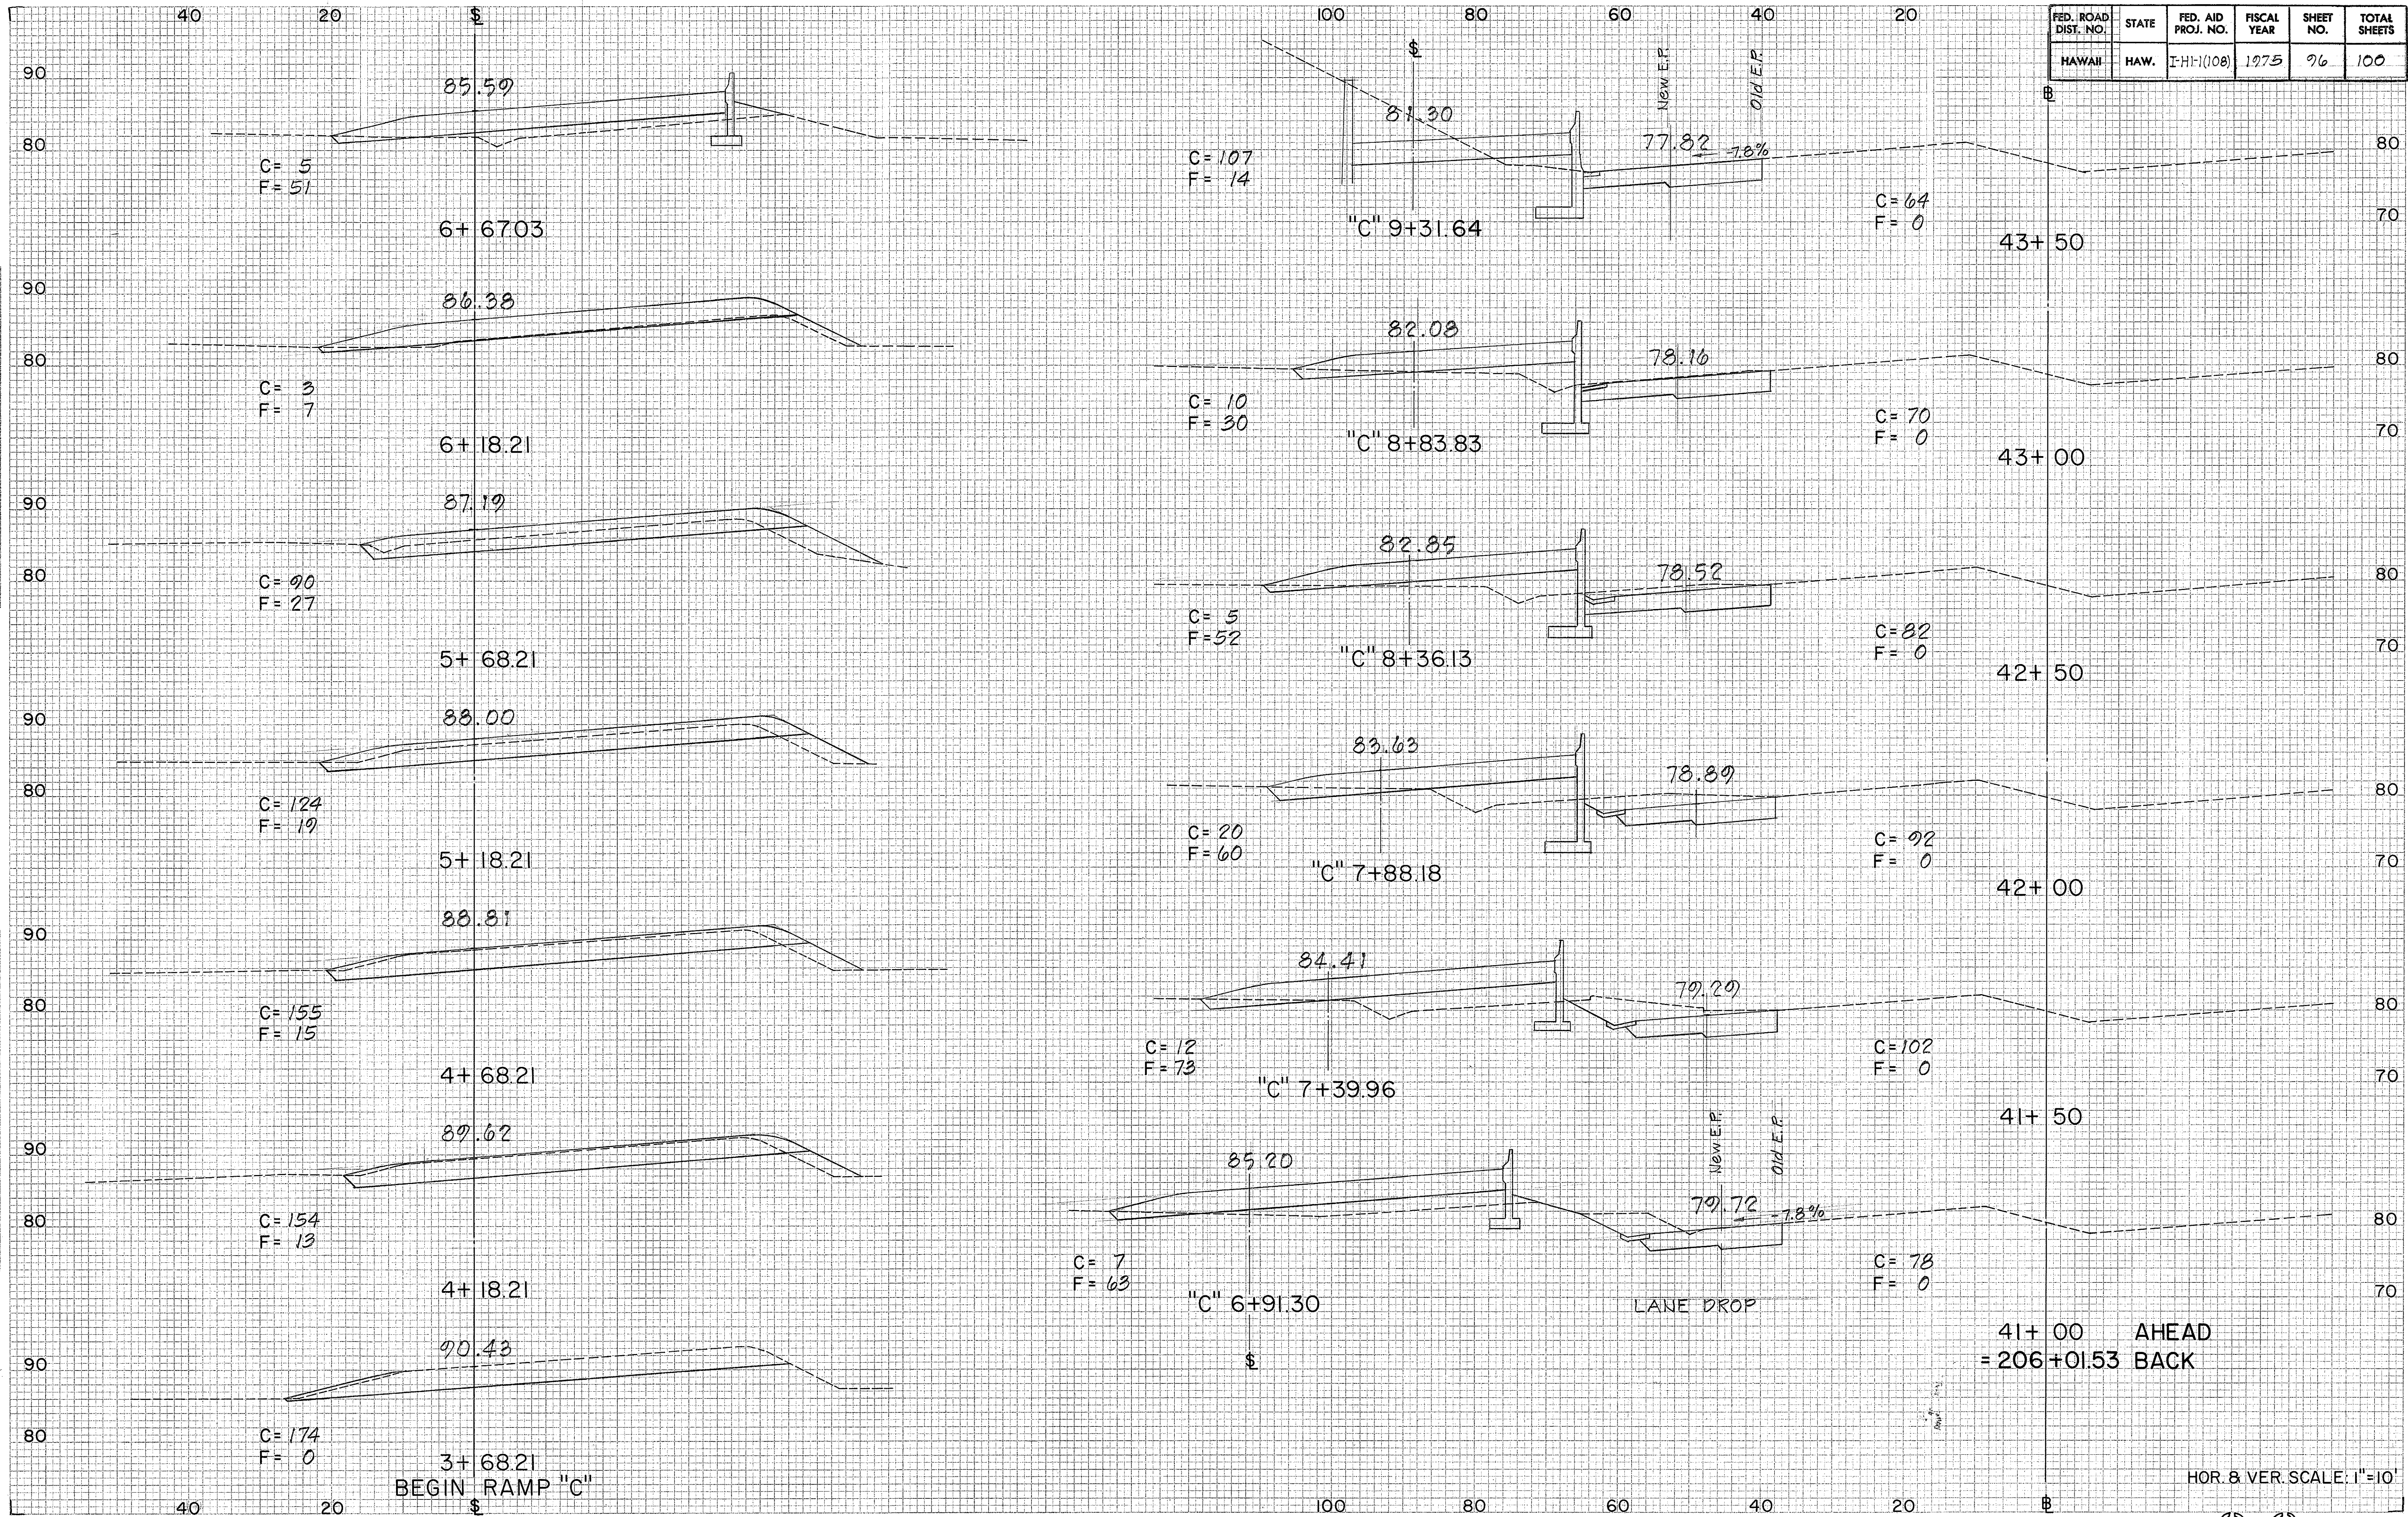


41+00 AHEAD
= 206+01.53 BACK

HOR. & VER. SCALE: 1"=10'

FED. ROAD DIST. NO.	STATE	FED. AID PROJ. NO.	FISCAL YEAR	SHEET NO.	TOTAL SHEETS
HAWAII	HAW.	I-HI-1(108)	1975	98	100

DATE	
BY	
SURVEYED	
NOTED	
TEMPLATE	
AREAS CHECKED	
NO.	


DATE	
BY	
SURVEYED	
NOTED	
TEMPLATE	
AREAS CHECKED	
NO.	

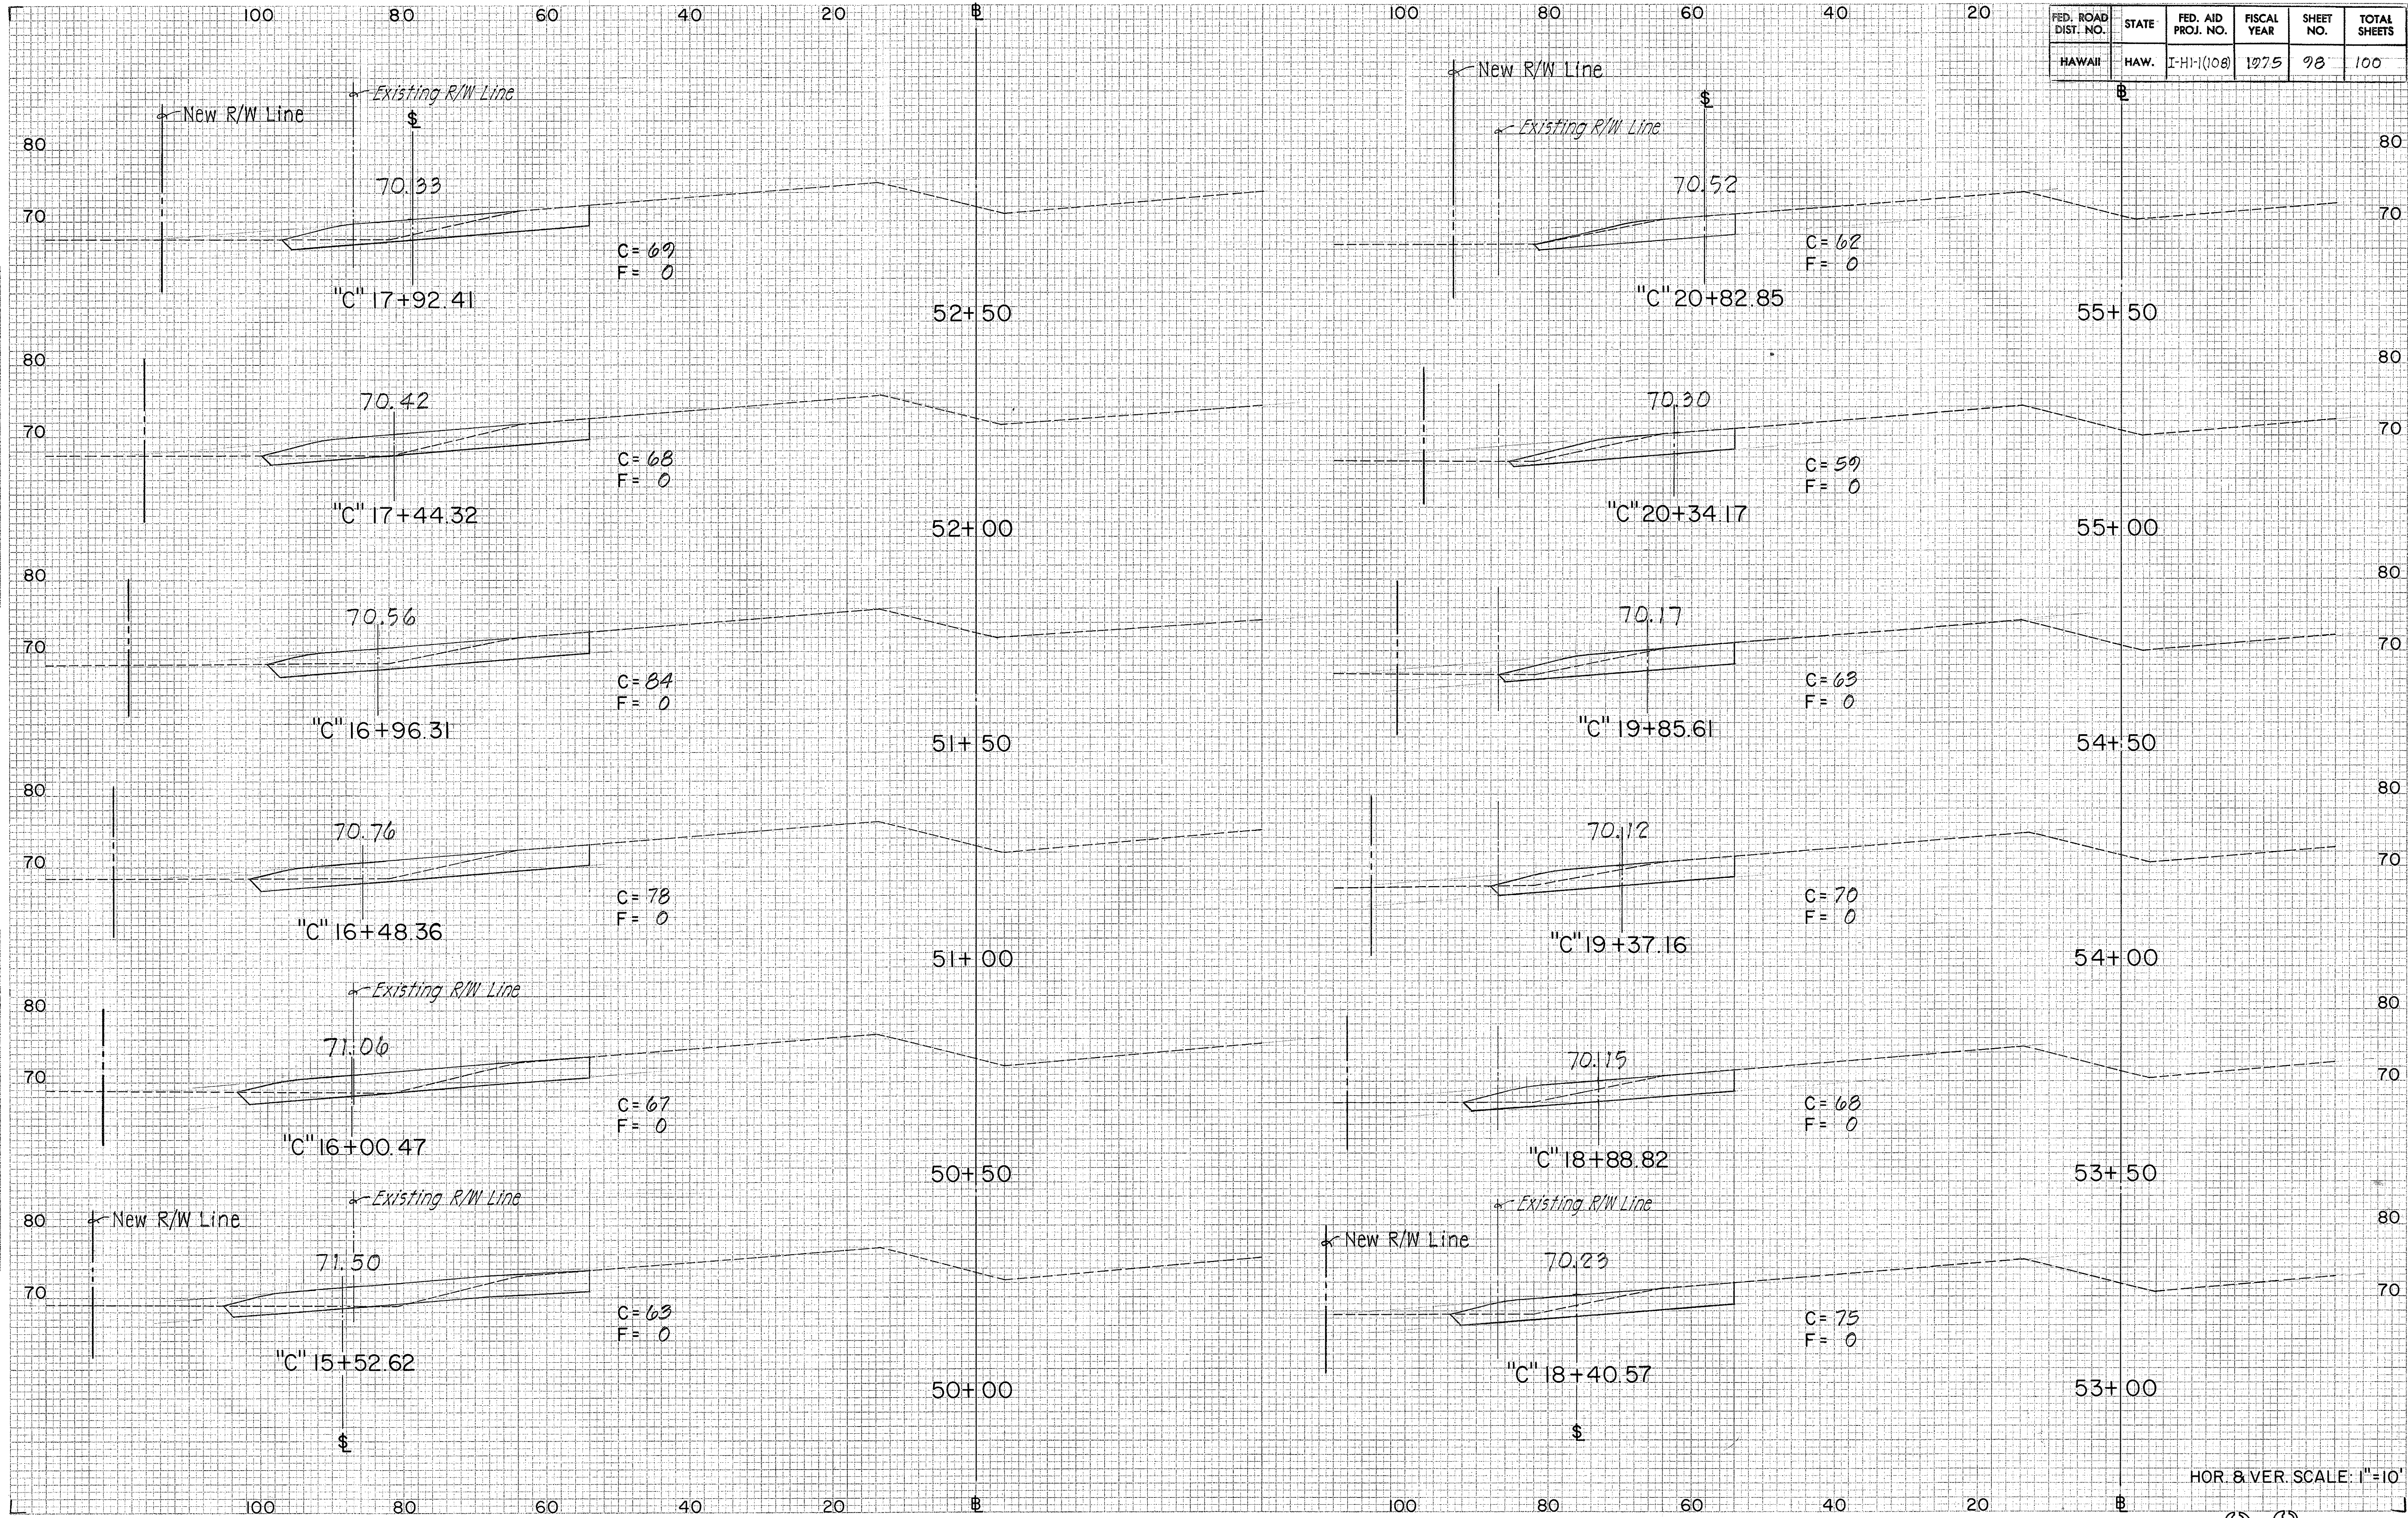

FED. ROAD DIST. NO.	STATE	FED. AID PROJ. NO.	FISCAL YEAR	SHEET NO.	TOTAL SHEETS
HAWAII	HAW.	IHI-1(108)	1975	99	100

FINAL SURVEY	DATE
NOTED	BY
NO.	AREAS CHECKED


ORIGINAL SURVEY	DATE
NOTED	BY
NO.	AREAS CHECKED

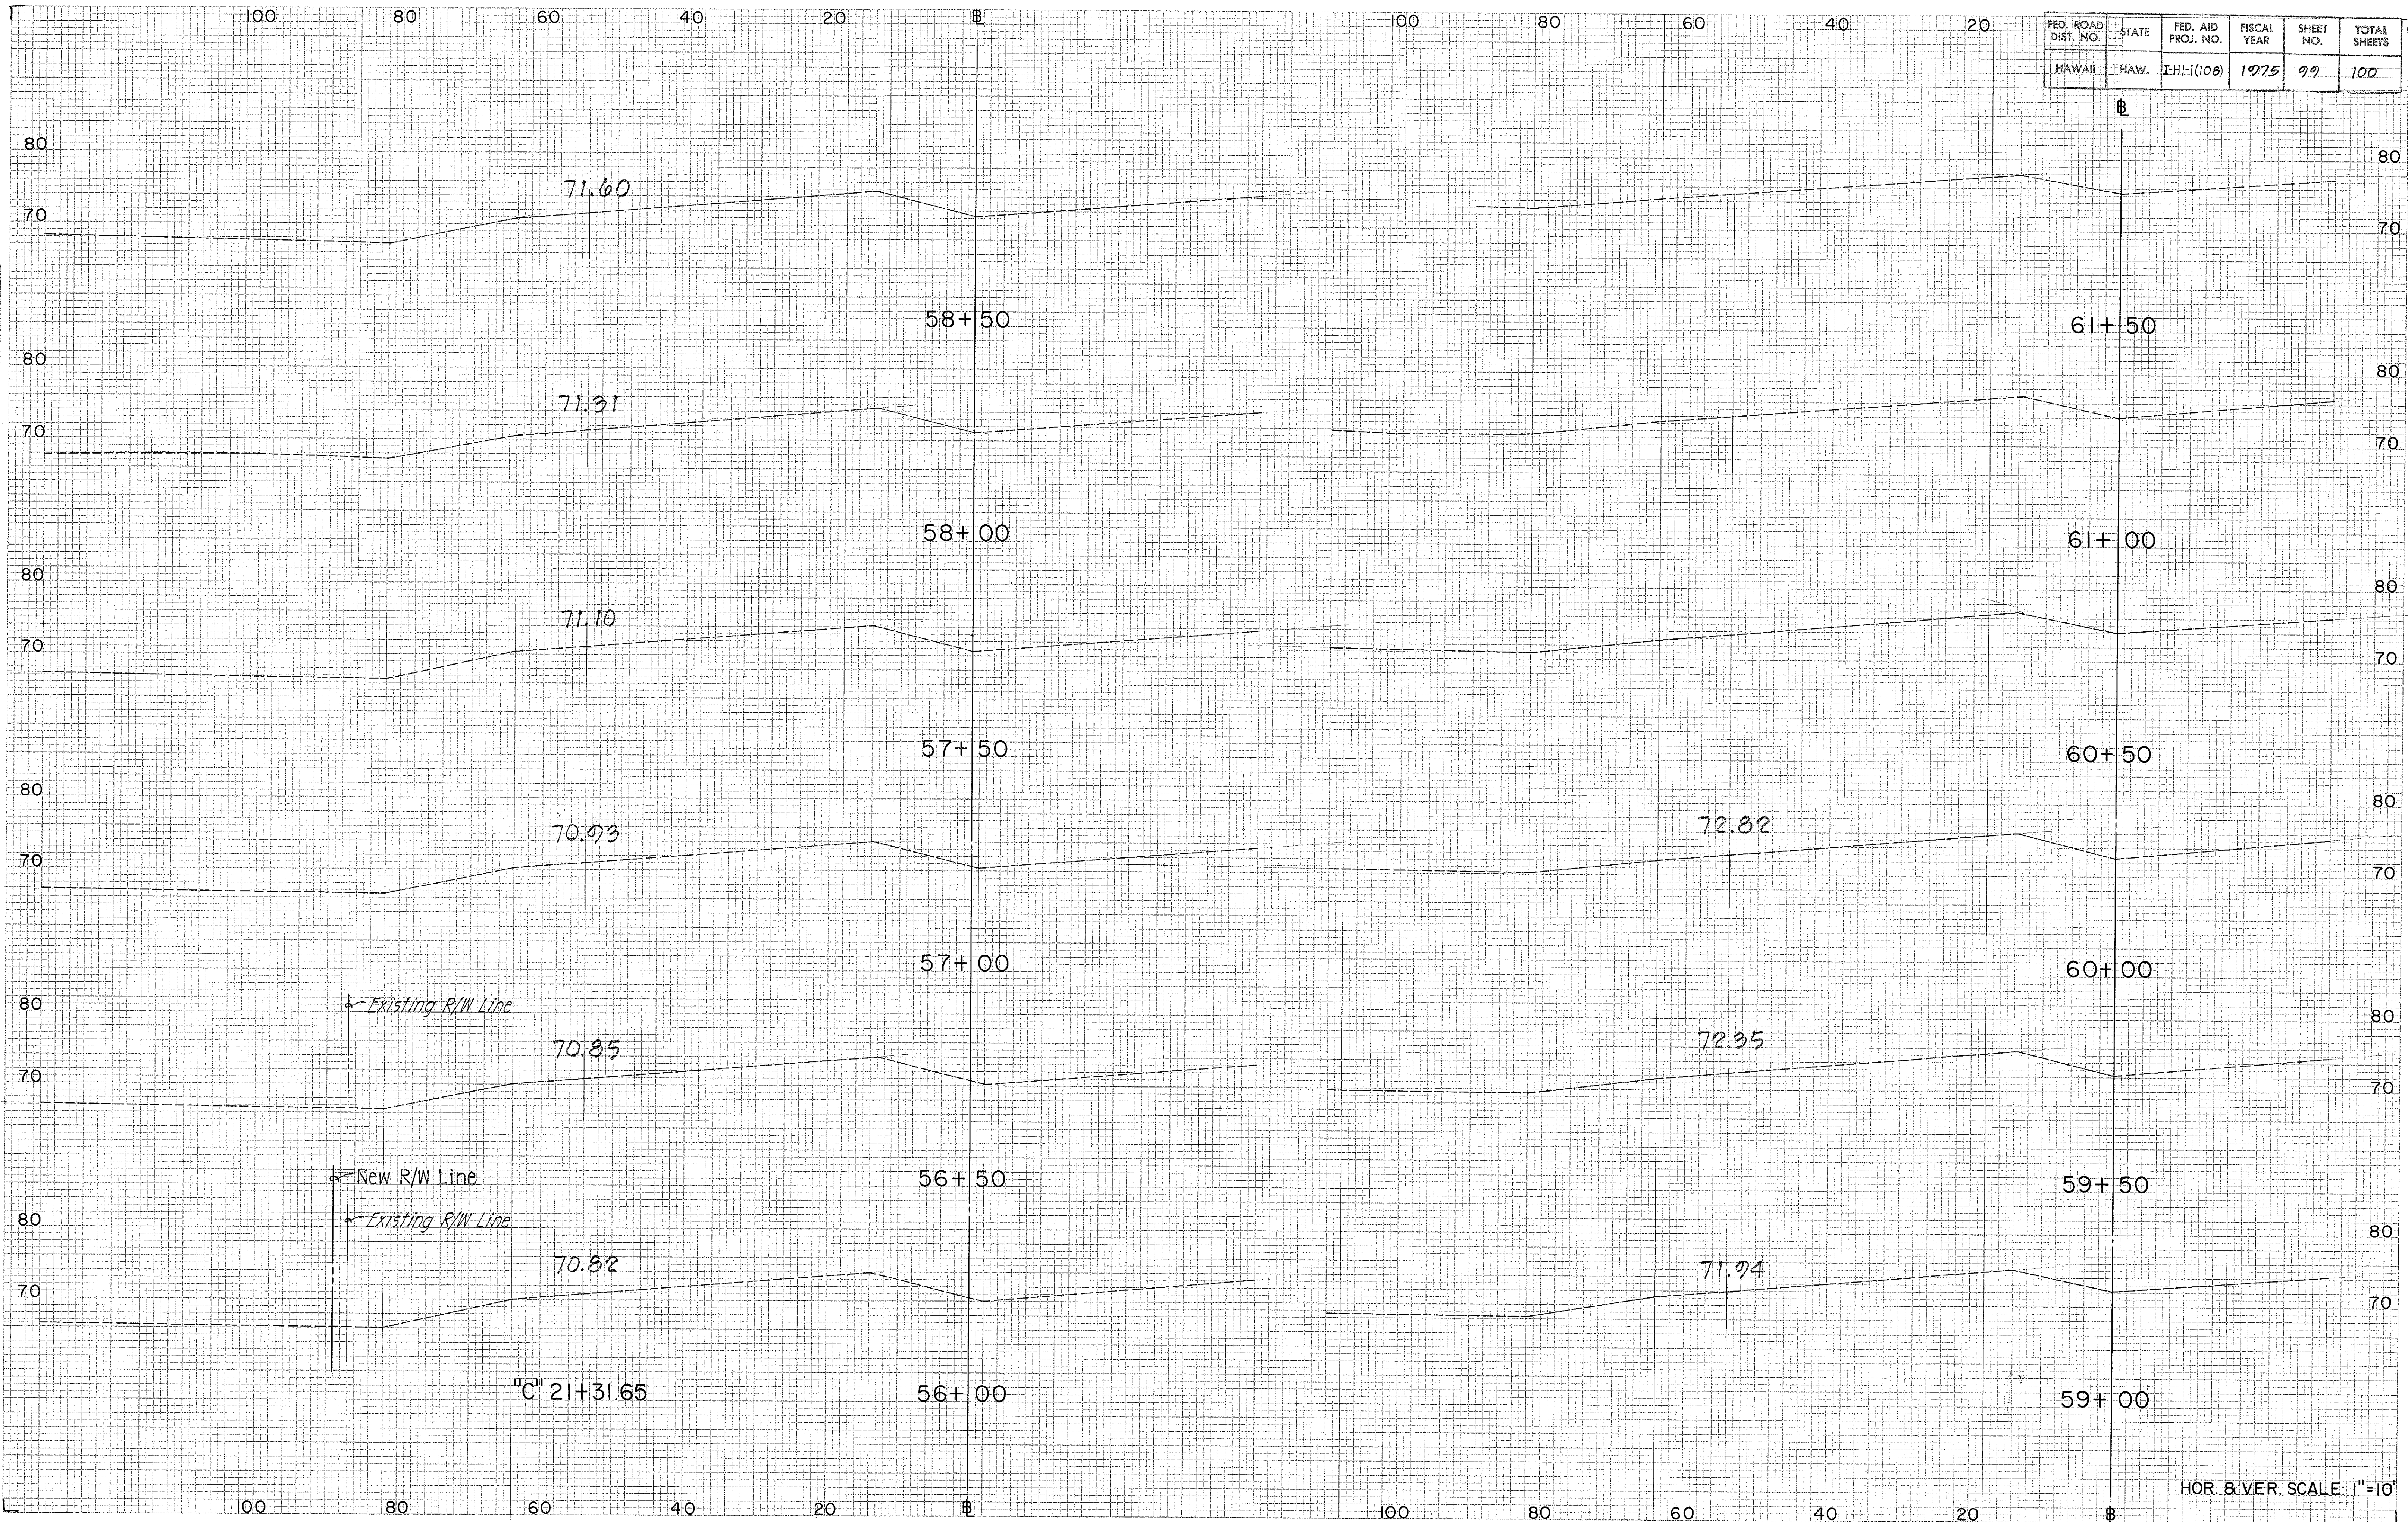

FED. ROAD DIST. NO.	STATE	FED. AID PROJ. NO.	FISCAL YEAR	SHEET NO.	TOTAL SHEETS
HAWAII	HAW.	I-HI-1(108)	1975	100	100

FINAL SURVEY	DATE
BY	
NOTED	
AREA	
NO.	

ORIGINAL SURVEY	DATE
BY	
NOTED	
AREA	
NO.	

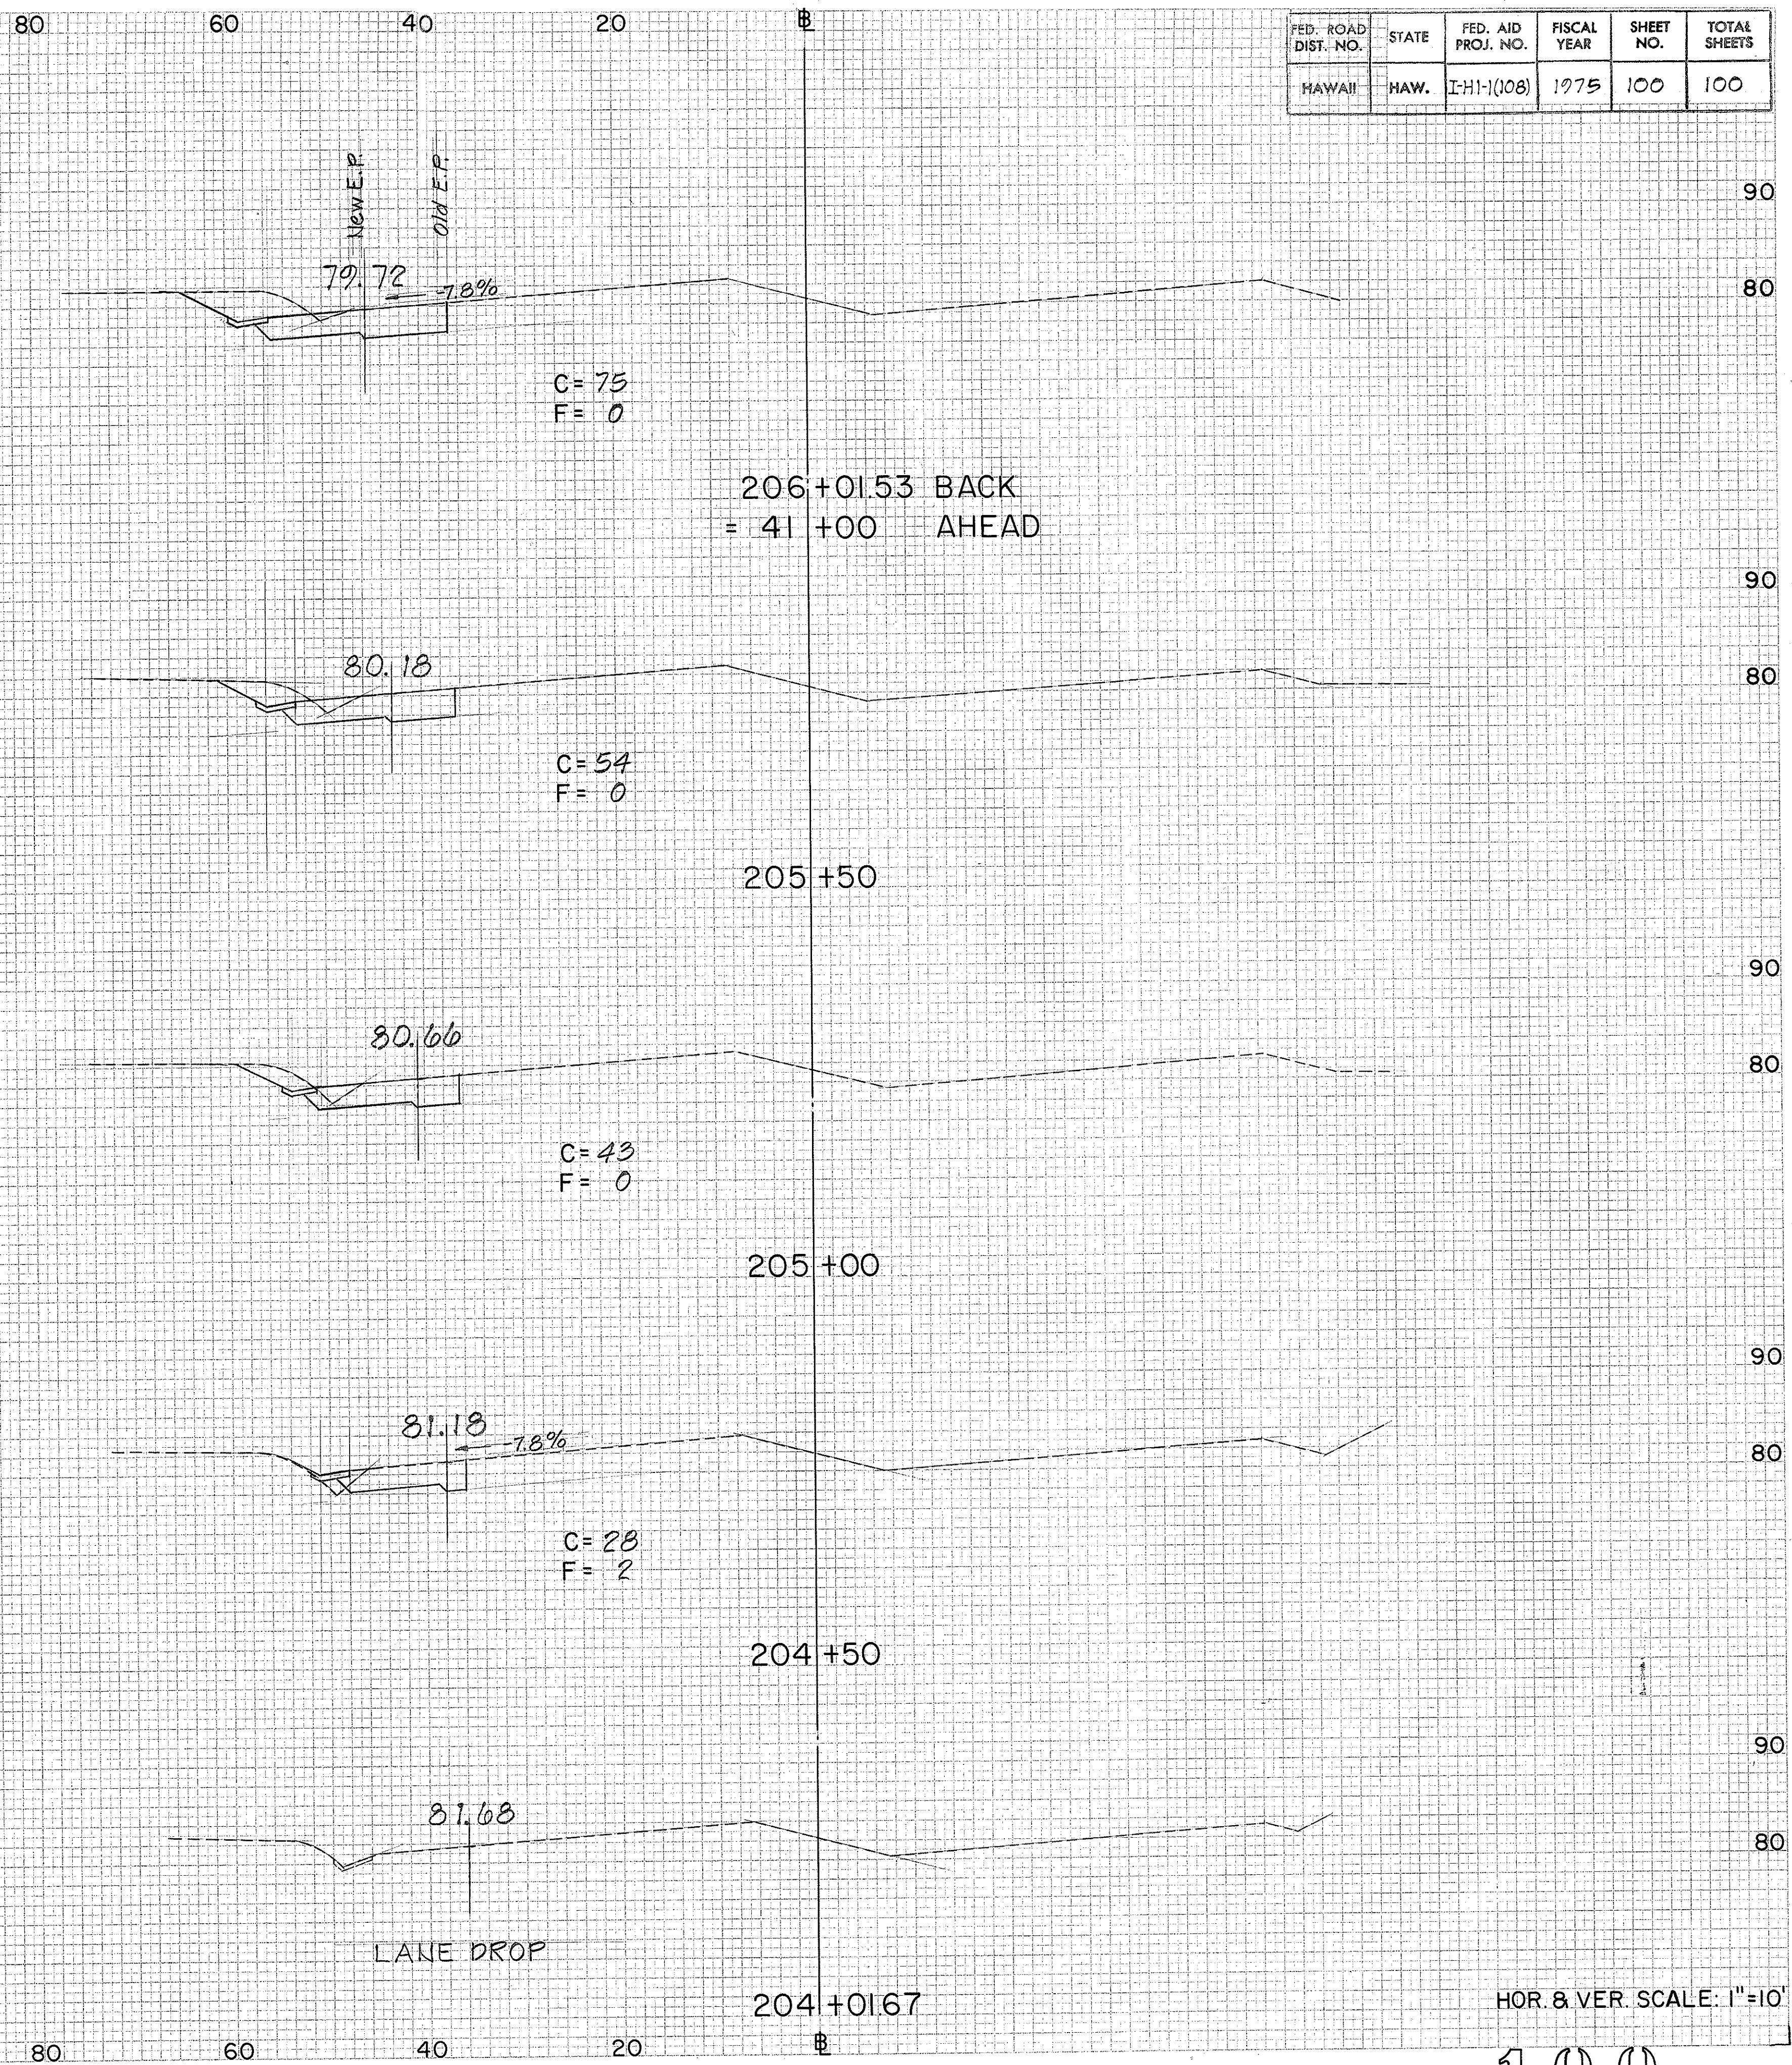

HOR. & VER. SCALE: 1"=10'

1 (1) (1)