



STATE OF HAWAII


DEPARTMENT OF TRANSPORTATION HIGHWAYS DIVISION

HONOLULU, HAWAII

"AS-BUILT"
PLANS FOR

SAFETY IMPROVEMENTS ALONG INTERSTATE ROUTE H-I PALAILAI TO KUNIA

FEDERAL AID INTERSTATE PROJECT No. I-HI-I(108)

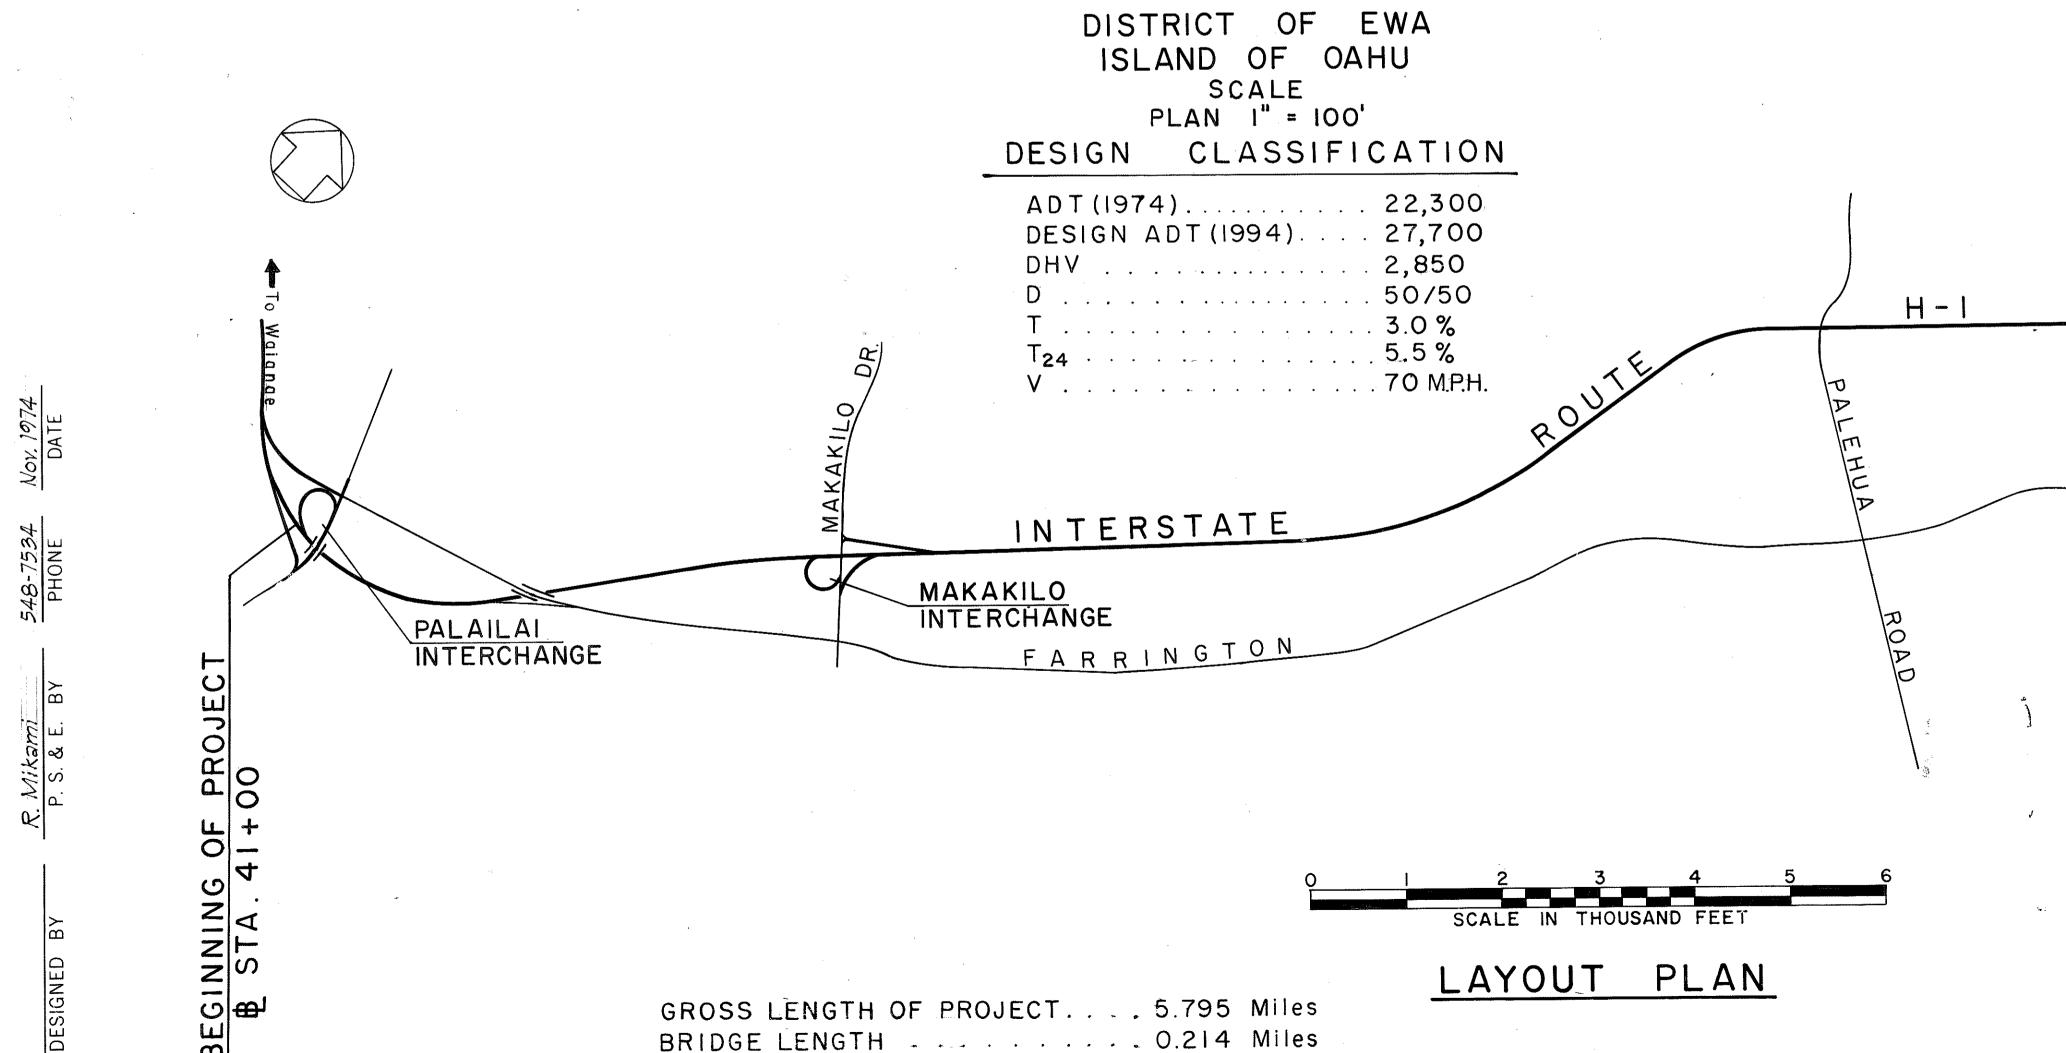


NET LENGTH OF PROJECT 5.581 Miles

Walkane
Walkan

STATE | FED. AID | FISCAL | SHEET | TOTAL | PROJ. NO. YEAR | NO. SHEETS

HAW. | I-H1-1(108) 1975

FED. ROAD DIST. NO.

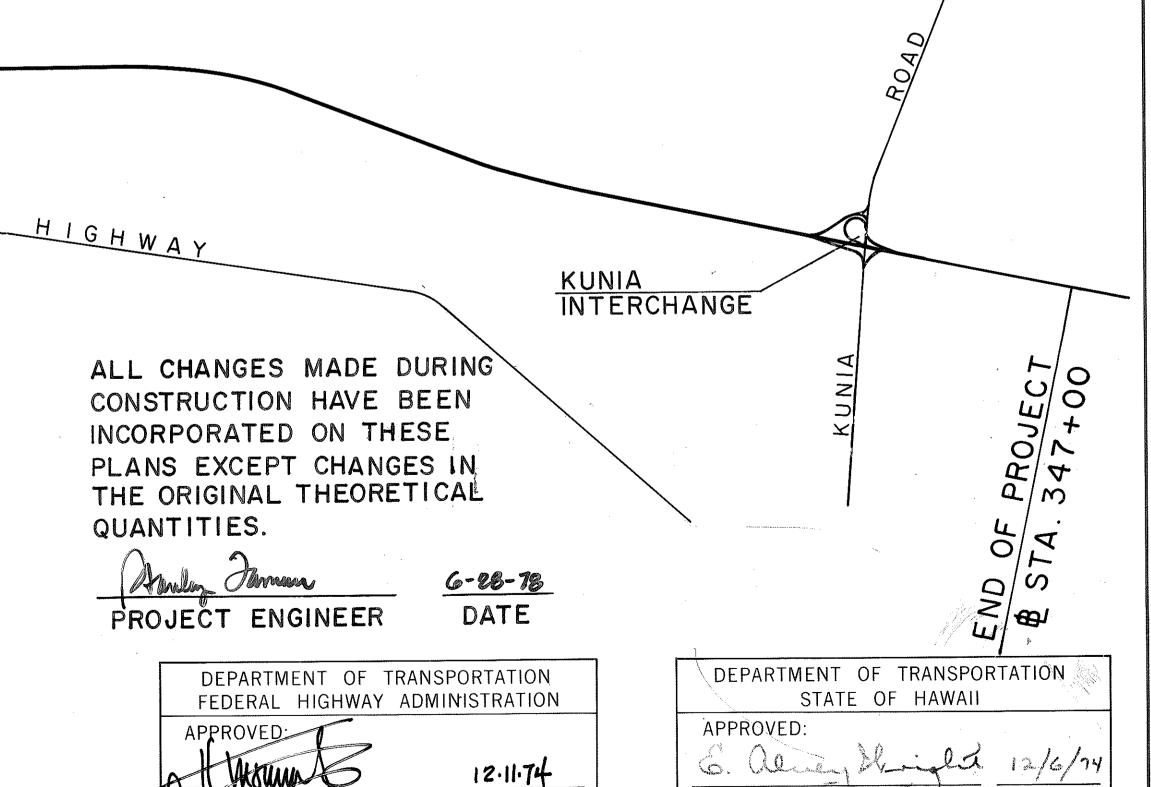

DIR. OF TRANSPORTATION DATE