



FED. ROAD DIST. NO.	STATE	FED. AID PROJ. NO.	FISCAL YEAR	SHEET NO.	TOTAL SHEETS
HAWAII	HAW.	I-HI-1(108)	1975	3	100

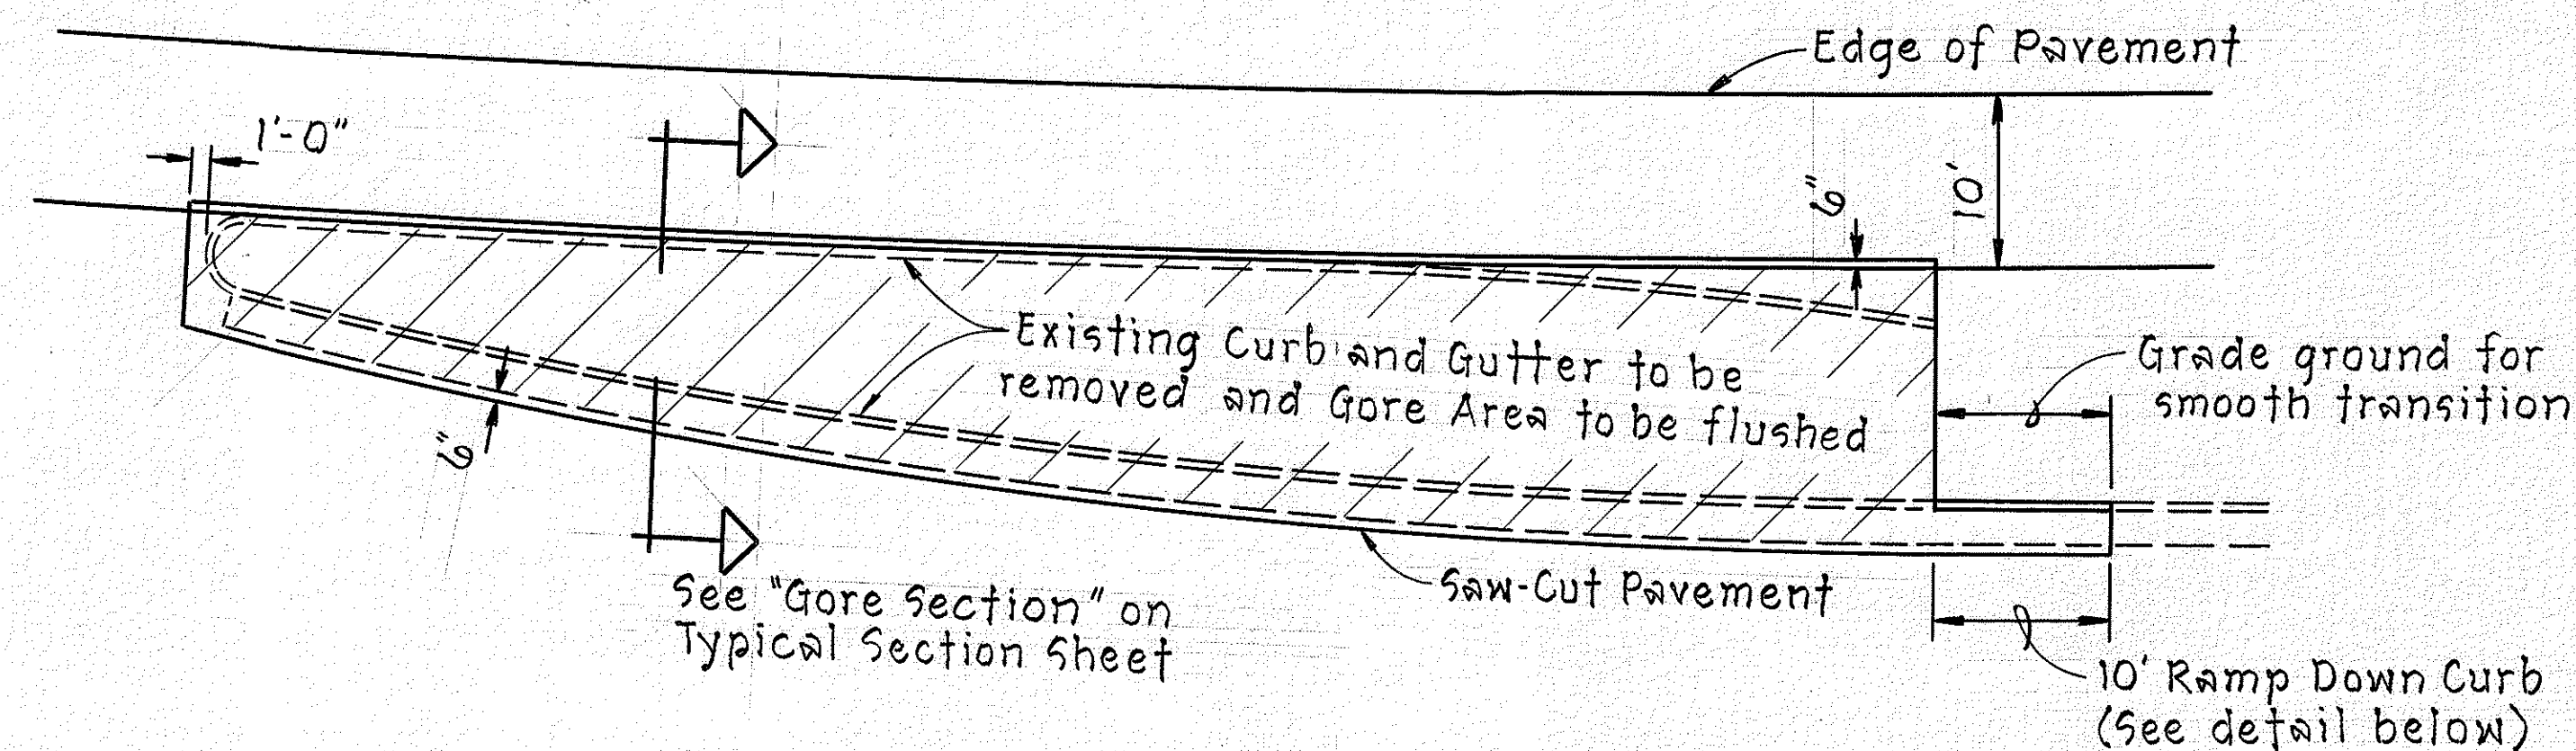

TYPICAL GORE TREATMENT


Scale: 1" = 10' - 0"

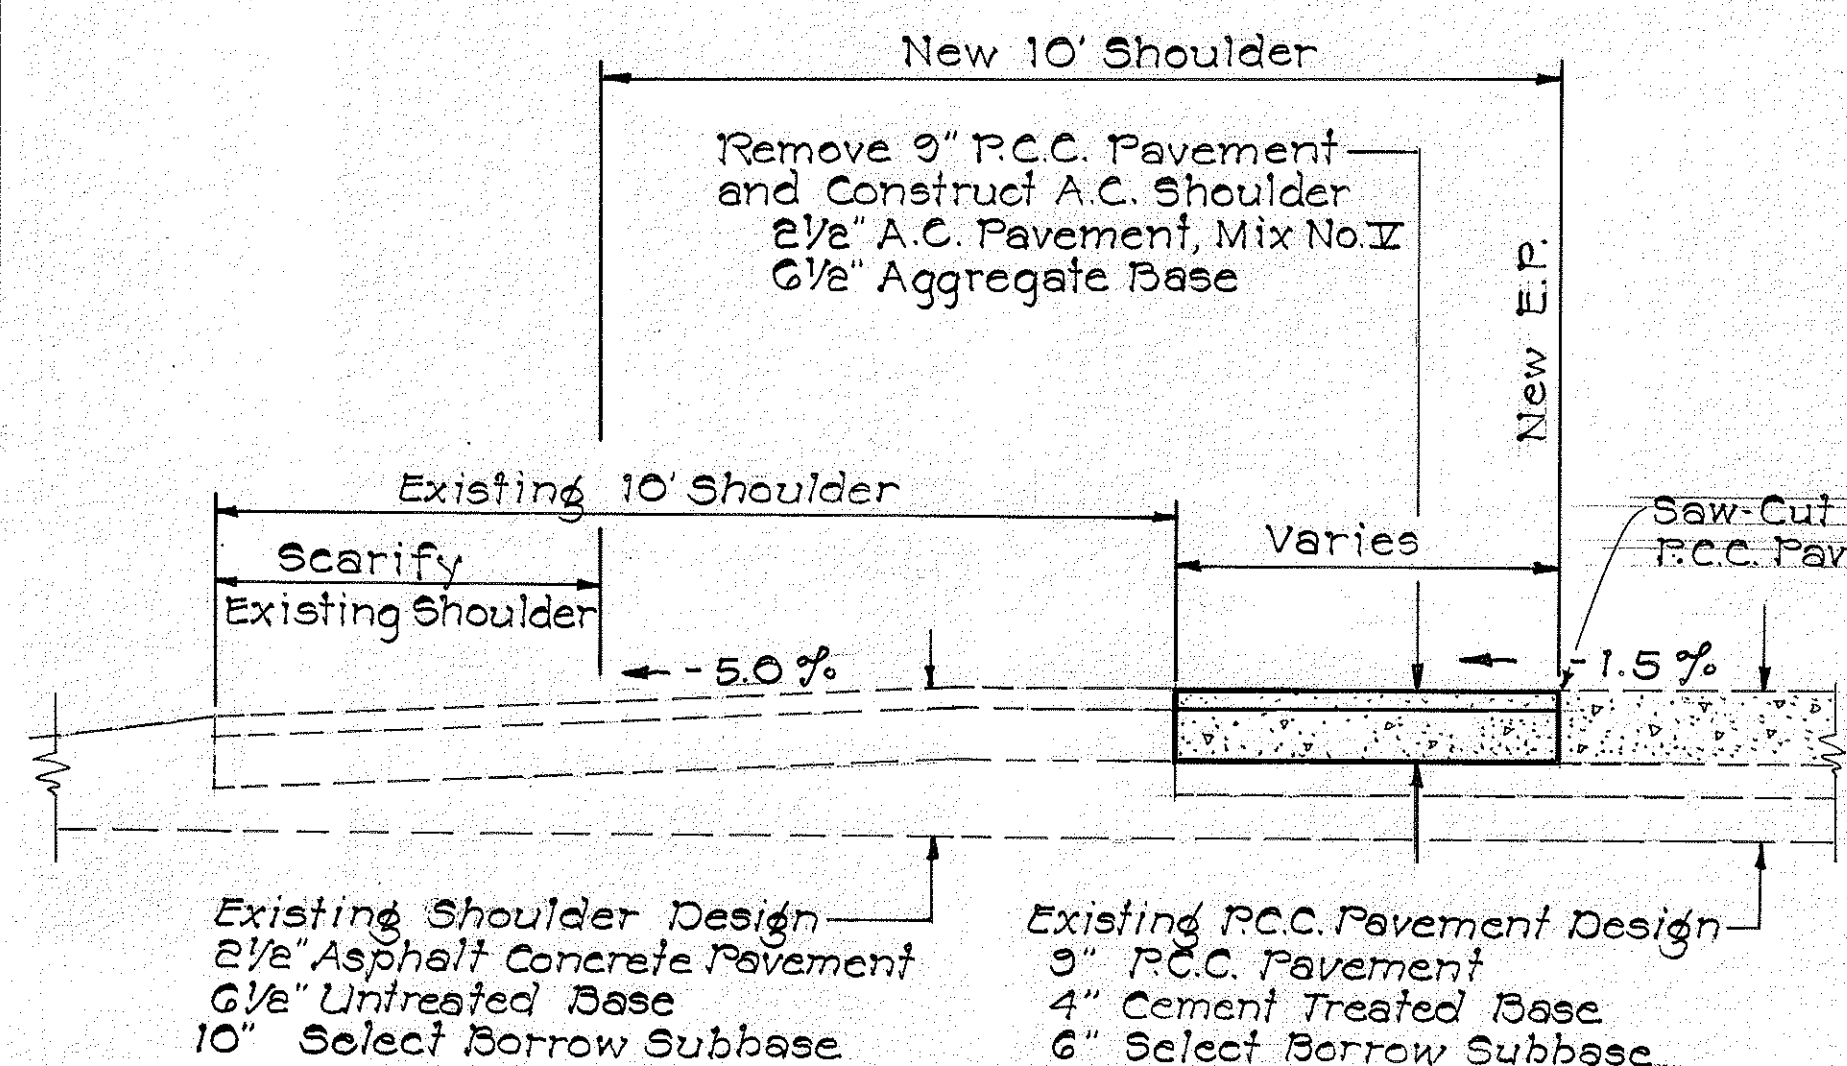


TYPICAL SHOULDER TREATMENT

STA. 68+00 TO STA. 83+00 LT.

Scale: 1/2" = 1' - 0"

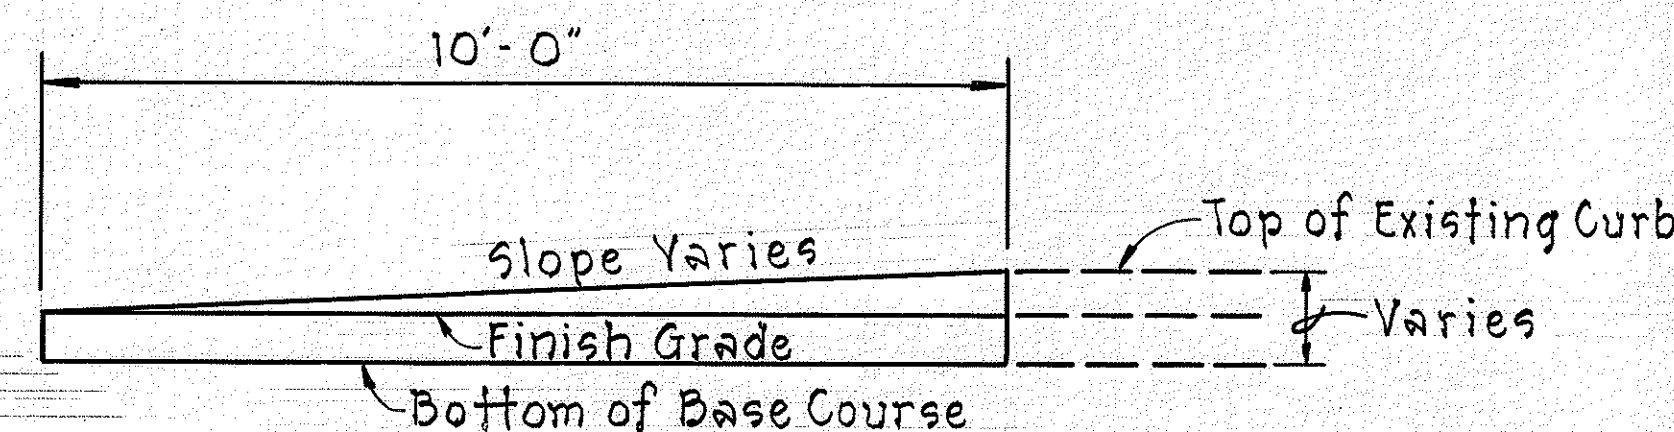


ELEVATION

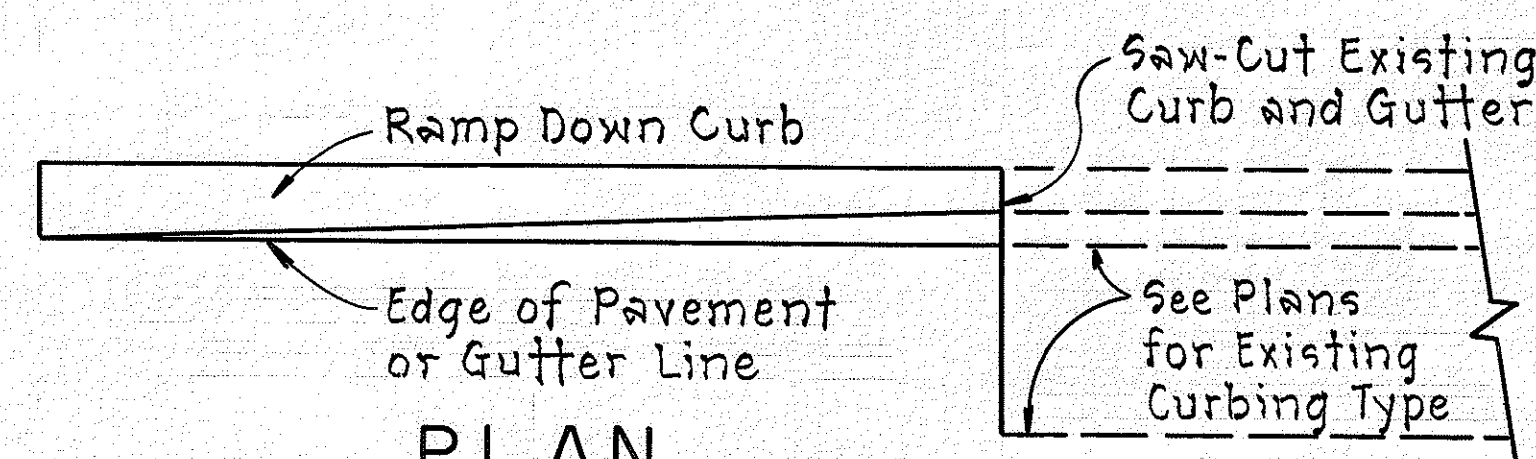

PLAN


RAMP DOWN CURB DETAILS

Scale: 1/2" = 1' - 0"

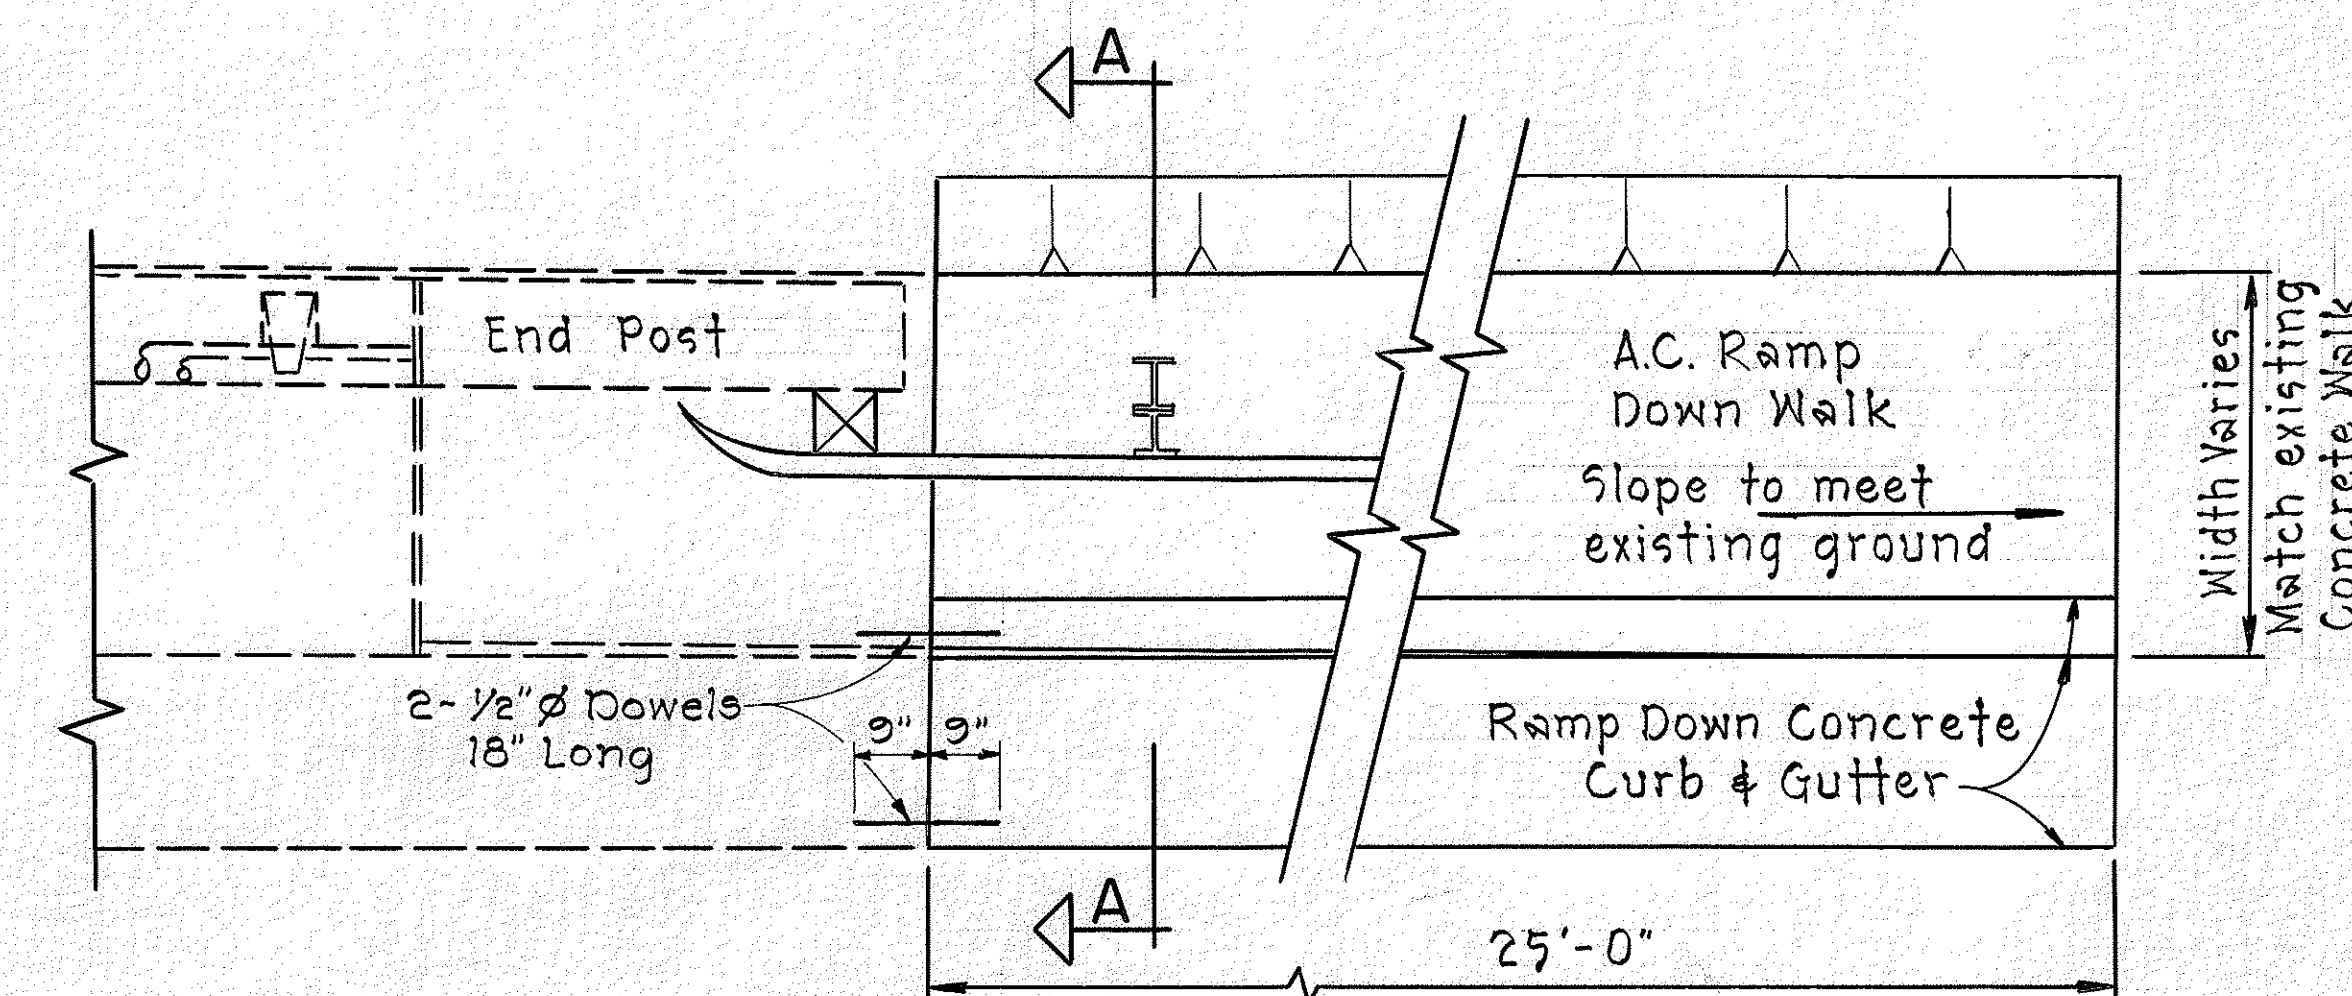


PLAN - RAMP DOWN WALK


Scale: 1/2" = 1' - 0"

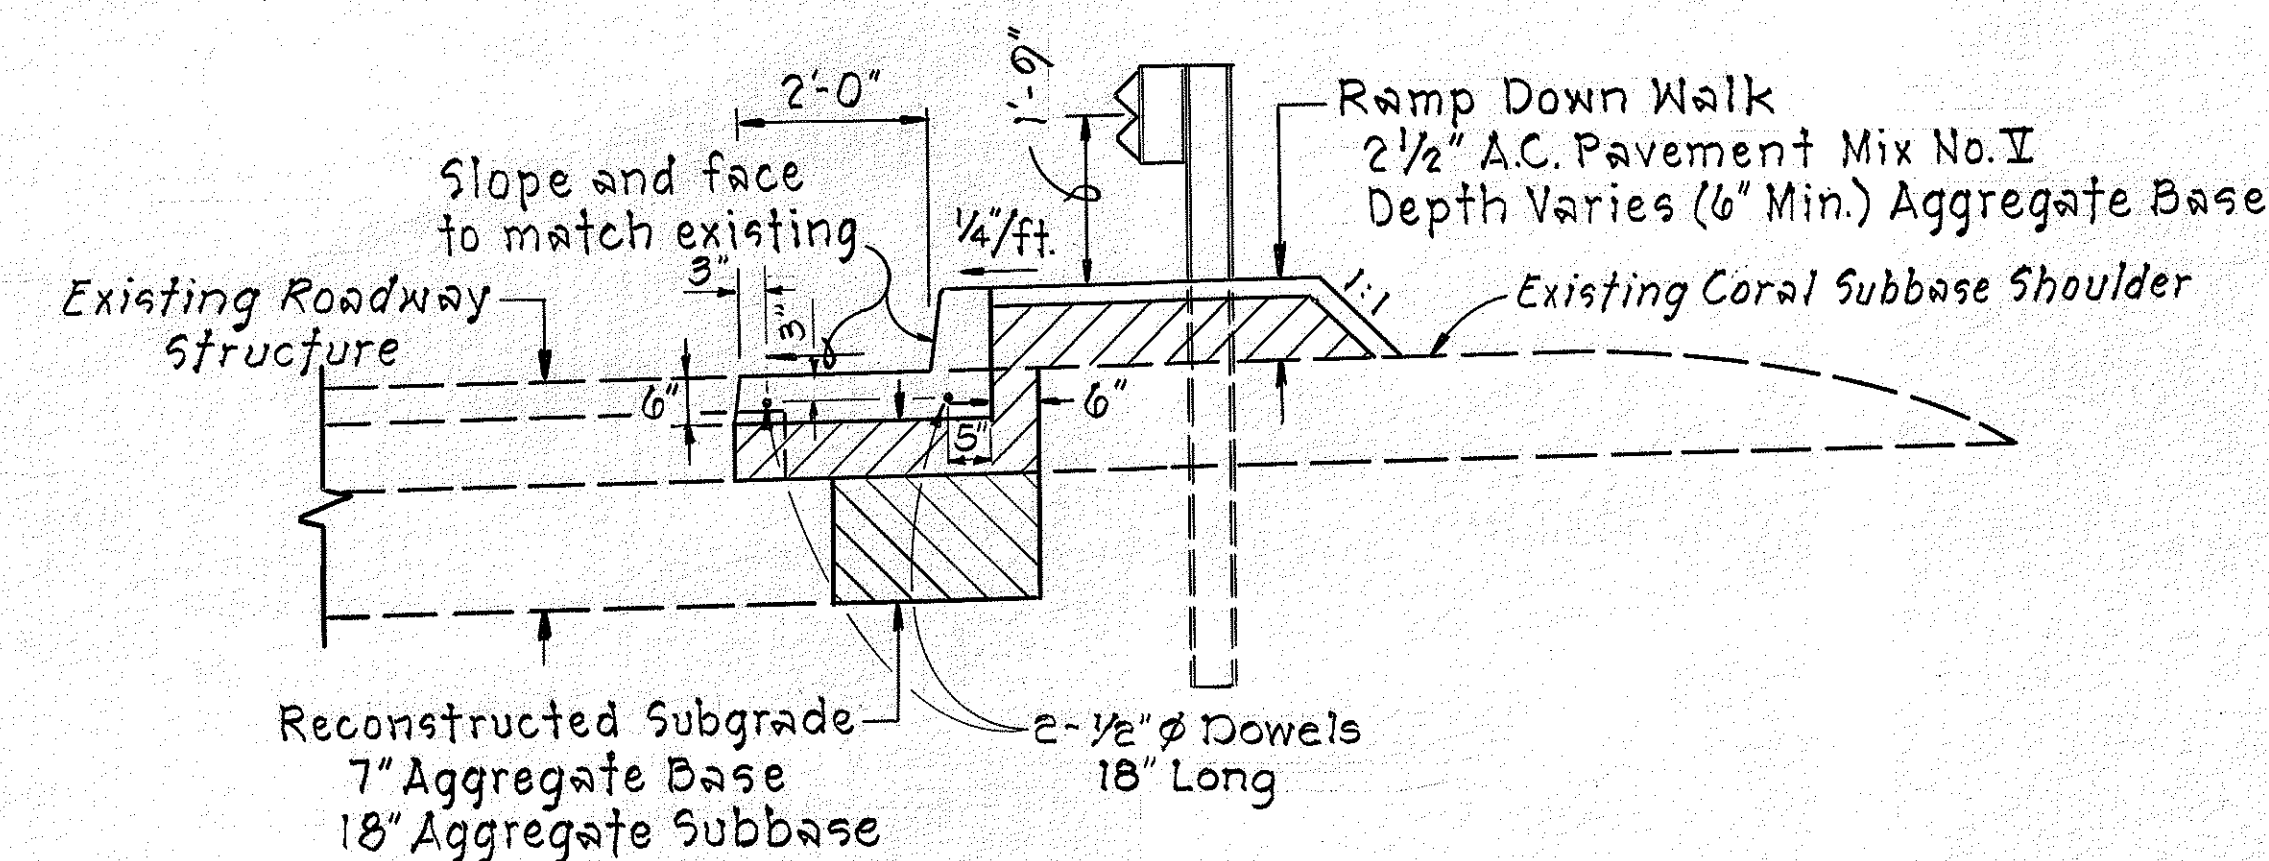

SECTION A-A

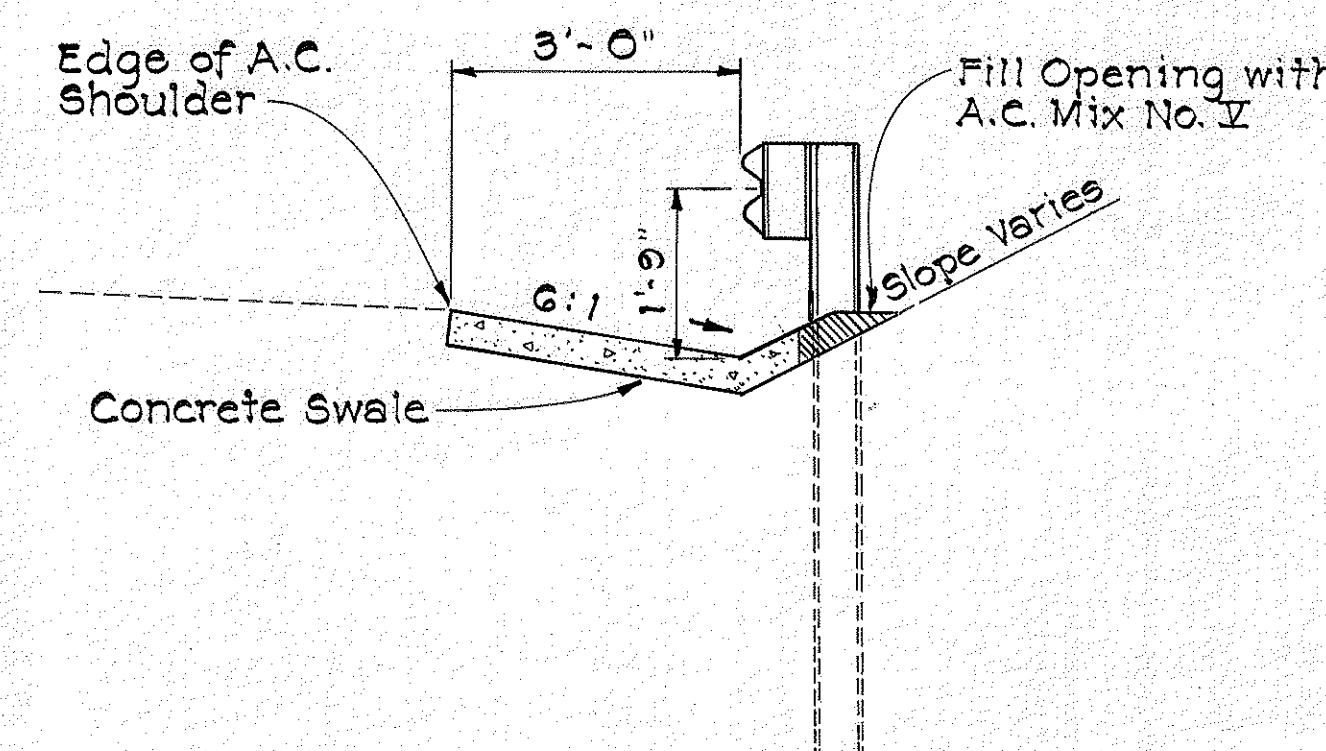


SECTION B - B

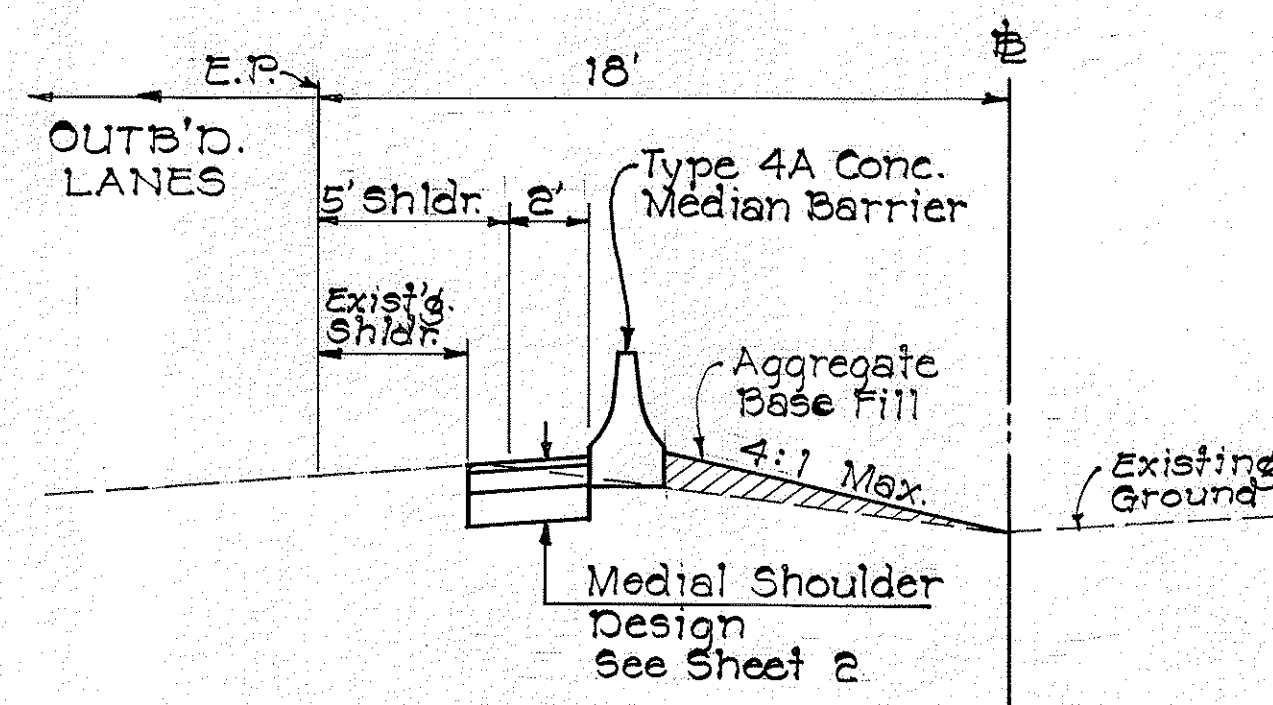

FILL SLOPE CONSTRUCTION DETAIL FOR TYPE 4H CONC. MEDIAN BARRIER

Scale: 1" = 5' - 0"

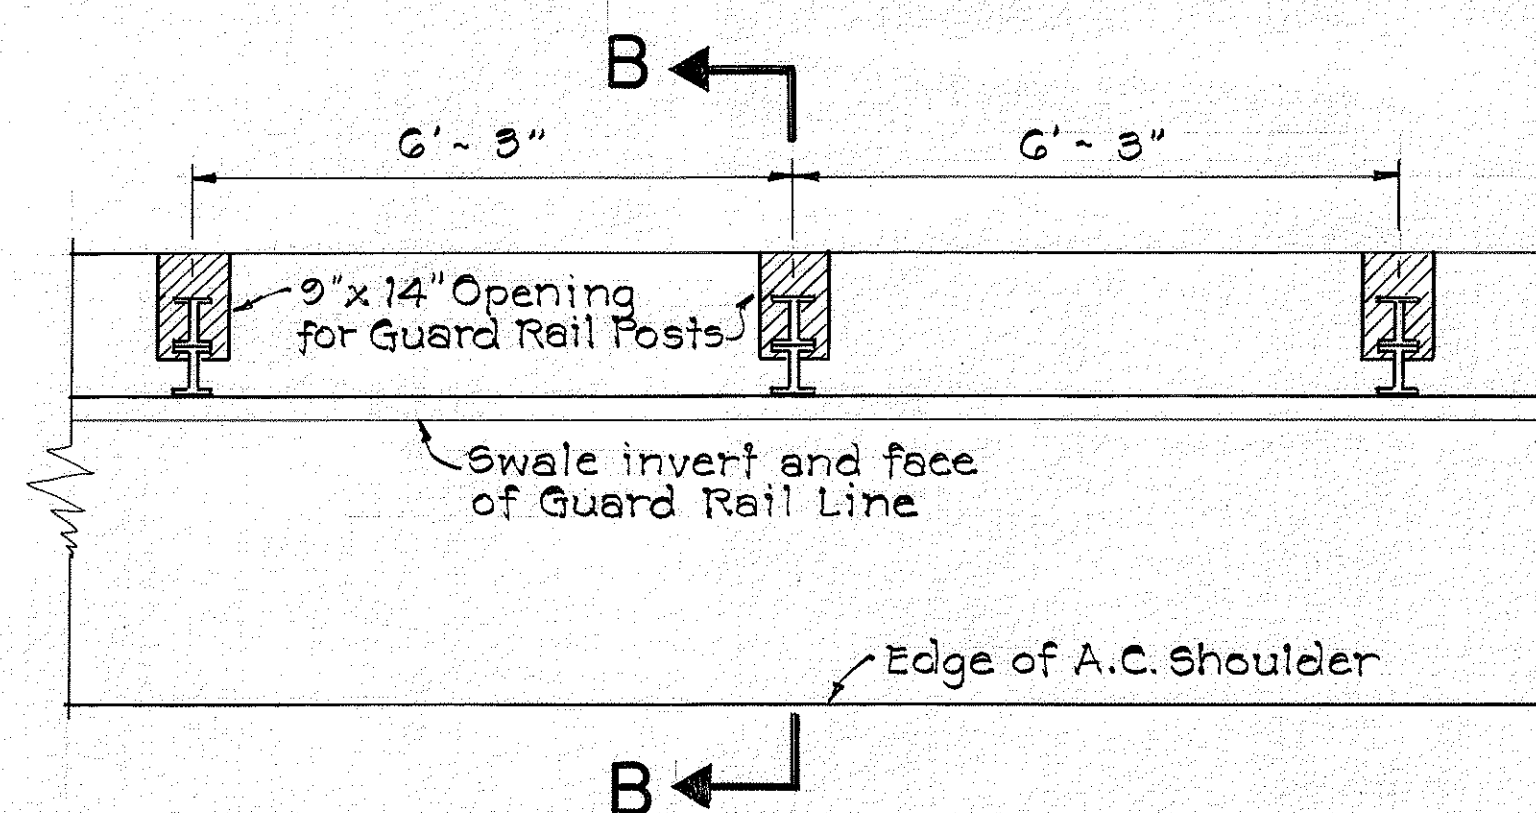

PLAN

GUARD RAIL POST IN CONCRETE SWALE

Scale: 1/2" = 1' - 0"

STATE OF HAWAII
DEPARTMENT OF TRANSPORTATION
HIGHWAYS DIVISION

TYPICAL DETAILS

F.A.I. PROJ. NO. I-HI-1(108)

Scale: As noted Date: Jan. 1974

SHEET No. 2 OF 2 SHEETS

DATE	*****
DESIGNED BY	
CHECKED BY	
NO.	