

FED. ROAD DIST. NO.	STATE	FED. AID PROJ. NO.	FISCAL YEAR	SHEET NO.	TOTAL SHEETS
HAWAII	HAW.	I-HI-K(18)16	1975	26	209


CURB & GUTTER SCHEDULE	Item No.				
	609	609	609	609	609
LOCATION	Curb Type 2D	Gutter Type 2S	Curb & Gutter Type 2DG	Curb & Gutter Type 2DGM	Curb Type 6
H-1 Station to Station ±	Lin. Ft.	Lin. Ft.	Lin. Ft.	Lin. Ft.	Lin. Ft.
132 + 21 - 116' to 151' Rt.					35
134 + 15 to 136 + 05 - 129' Rt.					190
135 + 90 to 136 + 50 - 129' Rt.		60			
136 + 35 to 140 + 75 - 129' Rt.					440
140 + 65 to 141 + 25 - 129' Rt.		60			
141 + 00 to 143 + 30 - 129' Rt.					230
169 + 10 to 169 + 30 - 130' Rt.					20
169 + 57 to 171 + 77 - 130' Rt.				220	
172 + 09 to 172 + 82 - 130' Rt.				73	
173 + 18 to 174 + 58 - 130' Rt.				140	
174 + 78 to 175 + 04 - 130' Rt.				26	
175 + 42 to 176 + 43 - 130' Rt.				101	
176 + 71 to 177 + 32 - 130' Rt.				61	
177 + 62 to 178 + 04 - 130' Rt.				42	
178 + 38 to 179 + 23 - 137' Rt.	85				
178 + 42 to 179 + 19 - 130' Rt.				77	
179 + 57 to 179 + 72 - 130' Rt.				15	
180 + 04 to 180 + 48 - 130' Rt.				44	
180 + 76 to 181 + 38 - 130' Rt.				62	
181 + 76 to 182 + 12 - 130' Rt.				36	
182 + 40 to 183 + 31 - 130' Rt.				91	
183 + 63 to 183 + 84 - 130' Rt.				21	
184 + 16 to 185 + 76 - 130' Rt.				160	
186 + 04 to 187 + 57 - 130' Rt.				153	
187 + 85 to 188 + 00 - 130' Rt.					15
192 + 00 to 192 + 15 - 130' Rt.					15
192 + 53 to 192 + 99 - 130' Rt.				46	
193 + 37 to 194 + 25 - 130' Rt.				88	
194 + 65 to 194 + 98 - 130' Rt.				33	
195 + 22 to 195 + 56 - 130' Rt.				34	
195 + 84 to 196 + 98 - 130' Rt.				114	
197 + 36 to 198 + 68 - 130' Rt.				132	
199 + 00 to 199 + 26 - 130' Rt.				26	
199 + 58 to 201 + 48 - 130' Rt.				190	
201 + 88 to 203 + 35 - 130' Rt.				147	
203 + 69 to 204 + 38 - 130' Rt.				69	
204 + 76 to 205 + 46 - 130' Rt.				70	
205 + 84 to 206 + 19 - 130' Rt.				35	
206 + 57 to 207 + 67 - 130' Rt.				110	
208 + 05 to 209 + 15				110	
Navy Maintenance Rd. Sht. 24		60	75		72
208 + 80 to 210 + 00					240
TOTALS	85	180	75	2526	1257

SIDEWALK & DRIVEWAY SCHEDULE	Item No.			
	608	608	608	610
LOCATION	4" Plain Concrete Sidewalk	4" Concrete Sidewalk	Bituminous Side Walk	6" Reinforced Concrete Driveway
H-1 Station to Station ±	Sq. Yd.	Sq. Yd.	Ton.	Sq. Yd.
141 + 00 to 142 + 60 - 129' Rt.				14
169 + 30 to 169 + 33 - 130' Rt.	2			
169 + 53 to 171 + 81 - 130' Rt.	127			26
172 + 05 to 172 + 86 - 130' Rt.	45			32
173 + 14 to 174 + 62 - 130' Rt.	82			37
174 + 74 to 175 + 08 - 130' Rt.	19			17
175 + 38 to 176 + 47 - 130' Rt.		61		38
176 + 67 to 177 + 36 - 130' Rt.	38			27
177 + 58 to 178 + 08 - 130' Rt.	28			30
178 + 38 to 179 + 23 - 130' Rt.	49			38
179 + 53 to 179 + 76 - 130' Rt.	13			38
180 + 00 to 180 + 52 - 130' Rt.	29			32
180 + 72 to 181 + 42 - 130' Rt.	39			26
181 + 72 to 182 + 16 - 130' Rt.	24			38
182 + 36 to 183 + 35 - 130' Rt.	55			26
183 + 59 to 183 + 88 - 130' Rt.	16			31
184 + 12 to 185 + 80 - 130' Rt.	93			31
186 + 00 to 186 + 70 - 130' Rt.	39			27
186 + 70 to 187 + 61 - 130' Rt.		51		27
187 + 81 to 187 + 90 - 130' Rt.	5			
192 + 15 to 192 + 19 - 130' Rt.	2			38
192 + 49 to 193 + 03 - 130' Rt.	30			38
193 + 33 to 194 + 29 - 130' Rt.	53			40
194 + 61 to 195 + 02 - 130' Rt.	23			21
195 + 18 to 195 + 60 - 130' Rt.	23			27
195 + 80 to 197 + 02 - 130' Rt.	68			38
197 + 32 to 198 + 72 - 130' Rt.	78			31
198 + 96 to 199 + 00 - 130' Rt.	2			
199 + 00 to 199 + 30 - 130' Rt.		17		31
199 + 54 to 201 + 47 - 130' Rt.		107		
201 + 47 to 201 + 52 - 130' Rt.	3			40
201 + 84 to 203 + 39 - 130' Rt.	36			34
201 + 87 - 139' Rt.	6			
202 + 30 - 139' Rt.	6			
203 + 65 to 204 + 42 - 130' Rt.	43			38
204 + 72 to 205 + 50 - 130' Rt.	43			37
205 + 80 to 206 + 23 - 130' Rt.	24			39
206 + 53 to 207 + 71 - 130' Rt.	66			38
208 + 01 to 209 + 15	63			
TOTALS	1322	236	14	1011±


Item No. 608.60
Bed Course Material for Sidewalk
Total = 180 Cu. Yd.

ADJUST MANHOLE	Item No.
	604
LOCATION	Adjust Manhole Frame & Cover
H-1 Station	Each
138 + 05 - 17' Rt.	1
138 + 25 - 20' Rt.	1
141 + 60 - 20' Rt.	1
147 + 20 - 18' Rt.	1
152 + 75 - 18' Rt.	1
154 + 70 - 20' Rt.	1
156 + 00 - 18' Rt.	1
159 + 25 - 20' Rt.	1
163 + 40 - 18' Rt.	1
168 + 70 - 25' Rt.	1
173 + 90 - 20' Rt.	1
190 + 40 - 18' Rt.	1
200 + 10 - 20' Rt.	1
200 + 40 - 125' Rt.	1
204 + 00 - 15' Rt.	1
TOTAL	15

FENCE SCHEDULE	Item No.	
	607	607
LOCATION	8' Chain-Link Fence w/10'x12' Posts	Relocate Chain-Link Gate
H-1 Station to Station	Lin. Ft.	Each
139 + 50 to 145 + 10 (150' Lt.)	560	
145 + 10 (150' Lt.) to 145 + 10 (208' Lt.)	55	
145 + 10 (205' Lt.) to 149 + 65	455	
150 + 25 to 171 + 75	2150	
Navy Maintenance Rd. Sht. 24		1
TOTALS	3220	1

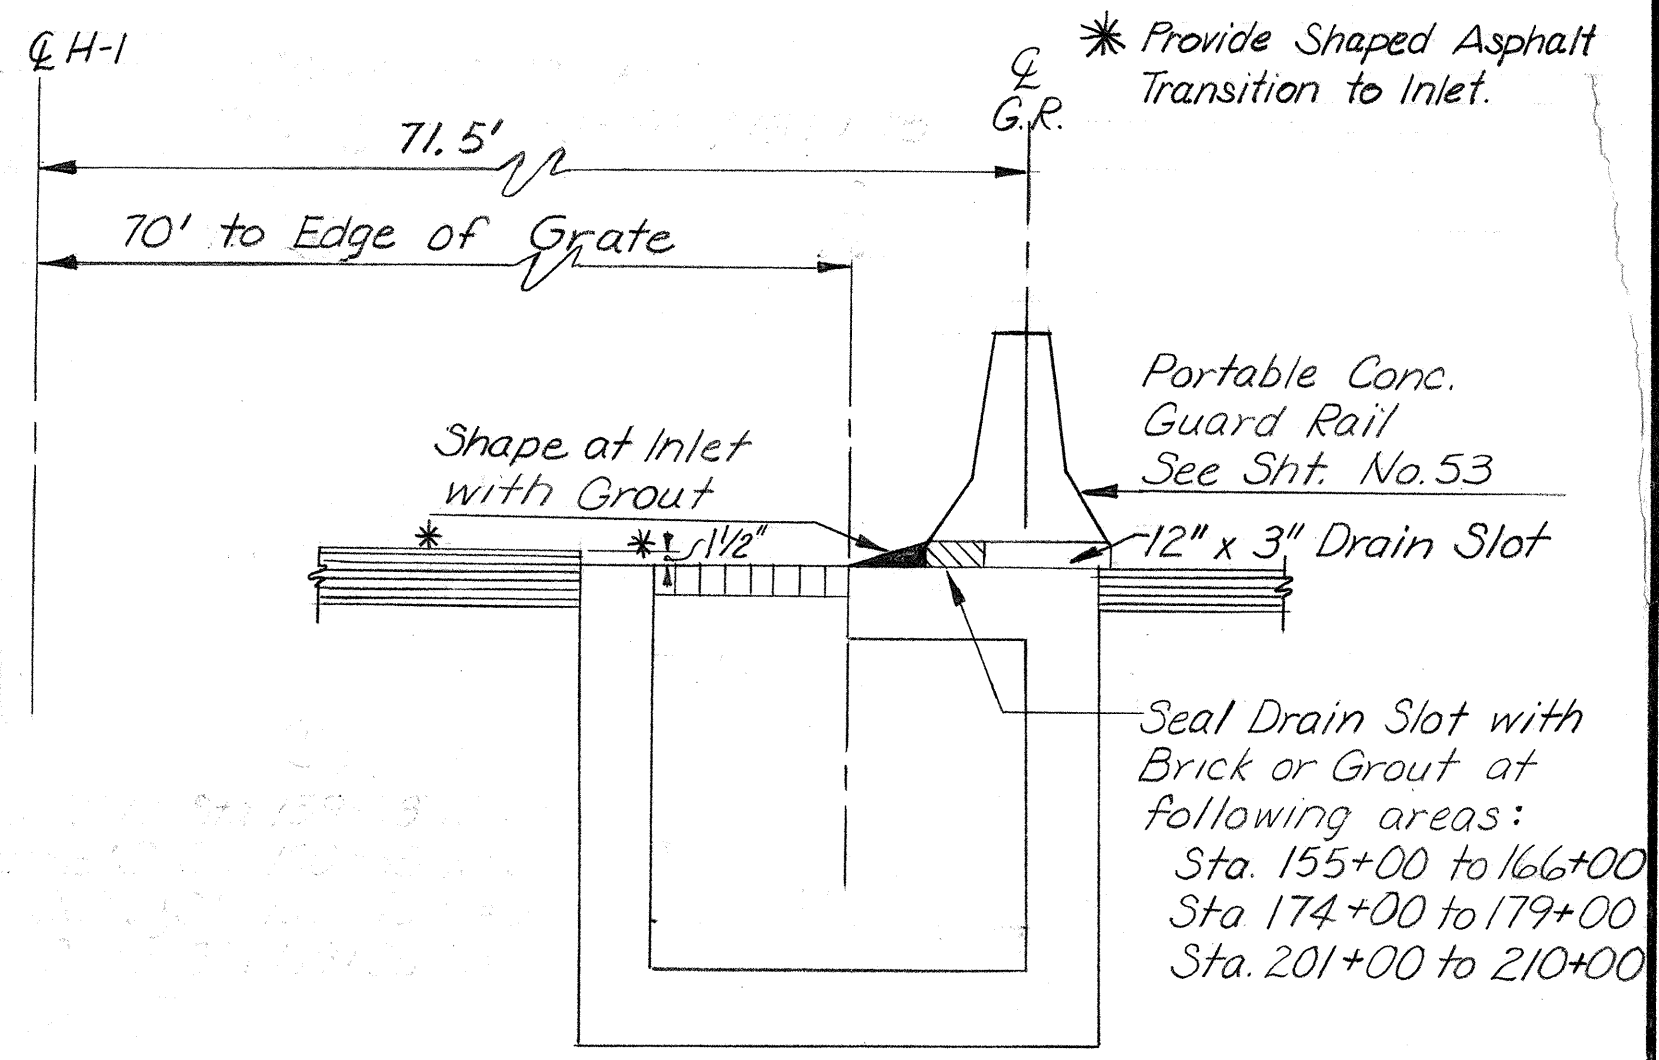


DOUBLE GRATE INLET
STA. 159 + 98
No Scale

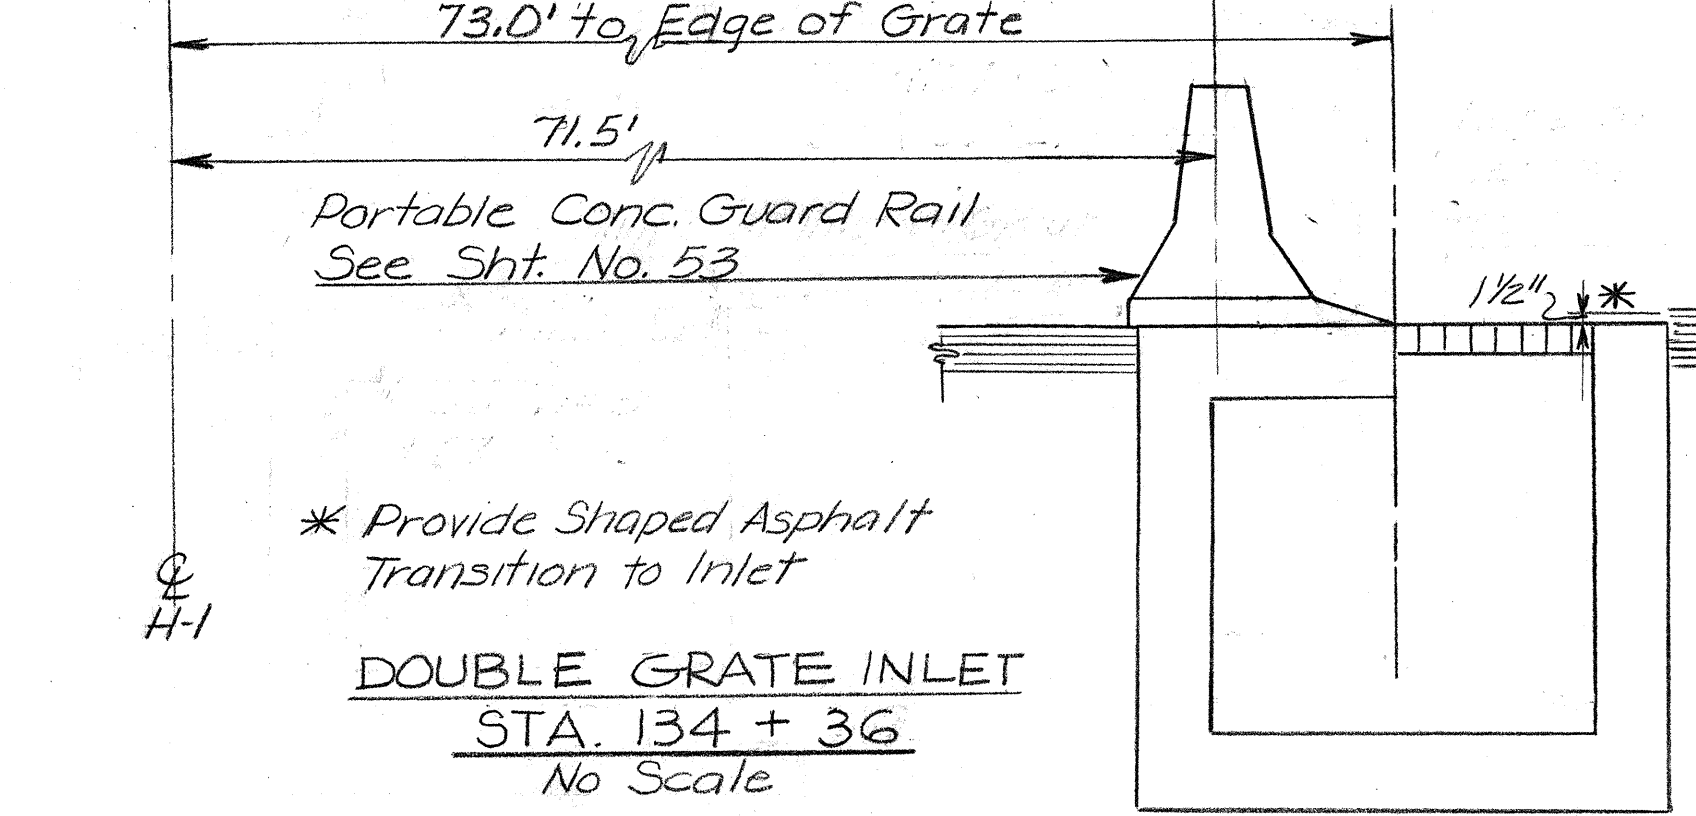


DOUBLE GRATE INLET
STA. 134 + 36
No Scale


- Notes
1. Bed Course Material shall be incidental to cost of various drainage items.
 2. The removal of existing inlet structures shall be included in Bid Item 202.11

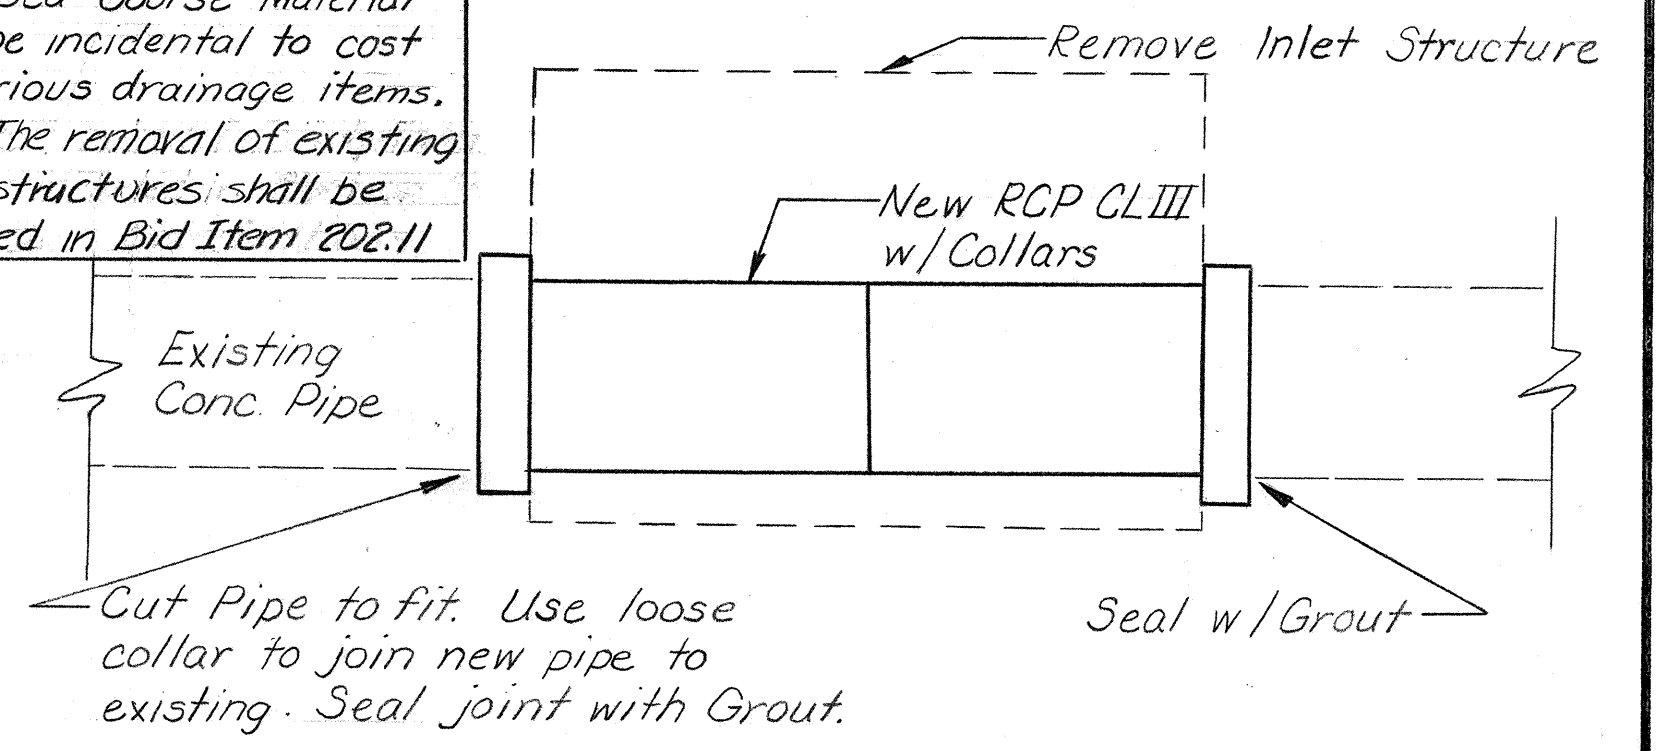

PIPE CONNECTION AT
REMOVED INLETS
No Scale

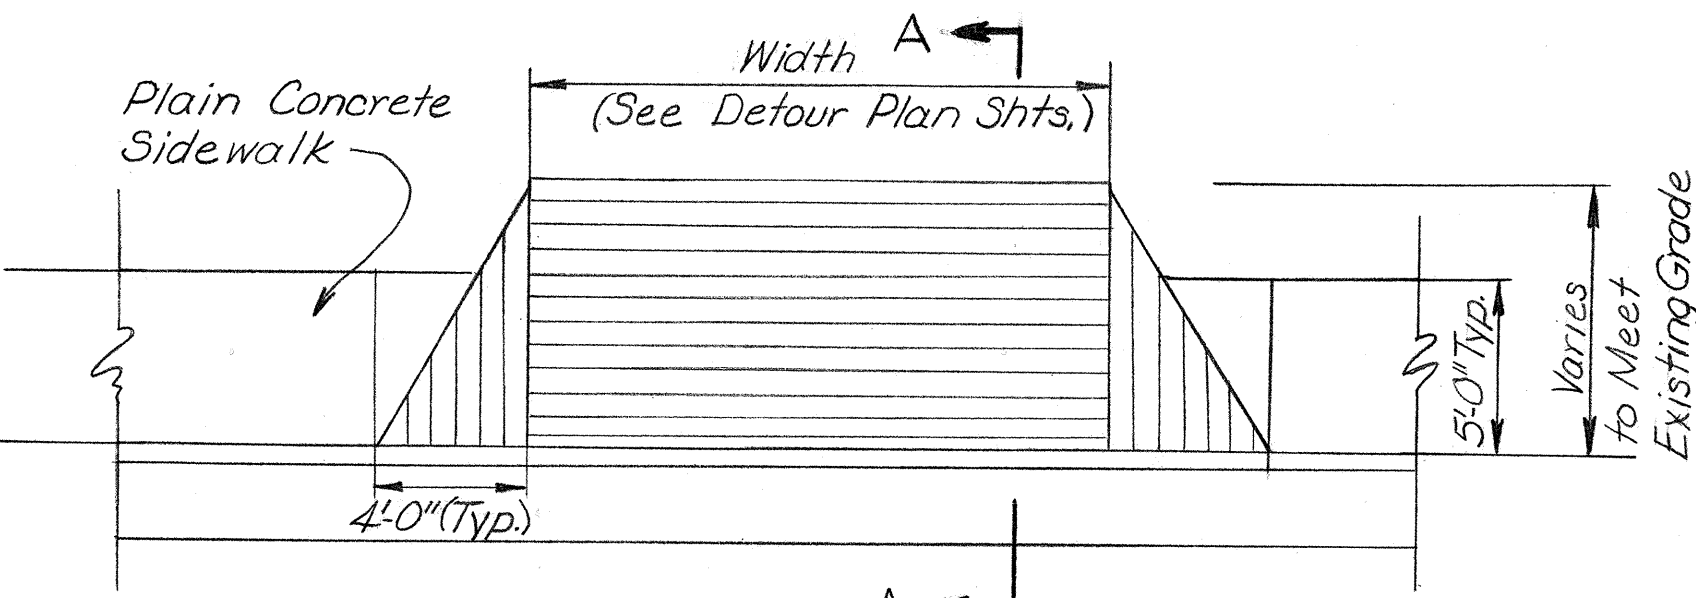


6" REINFORCED CONCRETE DROP DRIVEWAY
No Scale

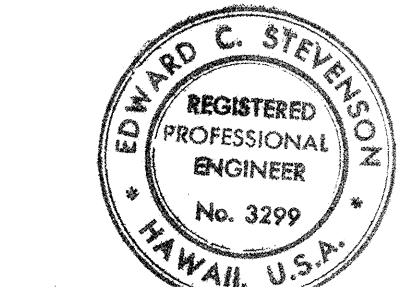

THIS WORK WAS PREPARED BY
ME OR UNDER MY SUPERVISION.
Edward C. Stevenson
Signature

* Slope and Length of
Driveway within easement
area shall be as
approved by the Engineer.

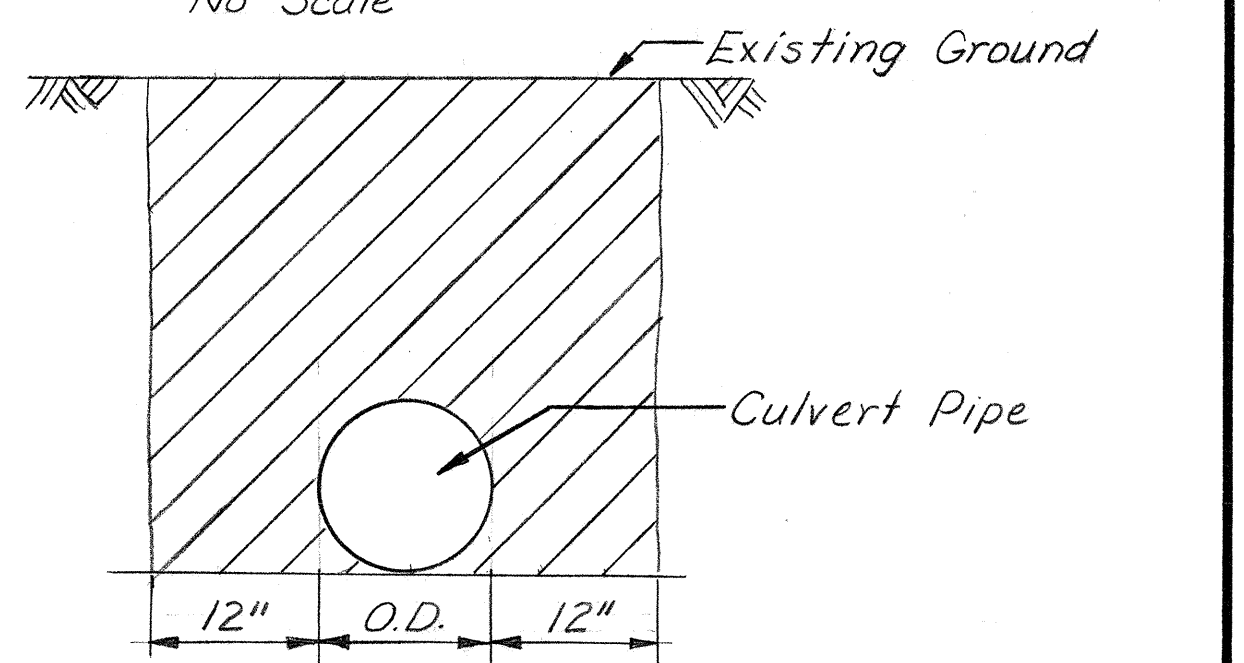

TRENCH EXCAVATION PAYMENT LIMIT
No Scale

DATE	1-30-75
ORIGINAL PLAN	Changed Double Grate Inlet Stations
DATE	
REVISIONS	

STATE OF HAWAII
DEPARTMENT OF TRANSPORTATION
HIGHWAYS DIVISION

DETOUR & DRAINAGE
DETAILS & SCHEDULES

AIRPORT INTERCHANGE
F.A.I. PROJ. NO. I-HI-K(18)16

SCALE: AS SHOWN DATE: JUNE 15, 1974

SHEET No. 15 OF 16 SHEETS

FED. ROAD DIST. NO.	STATE	FED. AID PROJ. NO.	FISCAL YEAR	SHEET NO.	TOTAL SHEETS
HAWAII	HAW.	I-HI-1 (118) 16	1975	27	209

ORIGINAL PLAN	SURVEY PLOTTED BY _____	DATE _____
	DRAWN BY _____	_____
	TRACED BY _____	_____
NOTE BOOK	QUANTITIES BY _____	_____
	CHECKED BY _____	_____
No. _____		



THIS WORK WAS PREPARED BY
ME OR UNDER MY SUPERVISION.
Edward C. Stevens
Signature

2-13-75	503.002 - Quantity Changes
2-13-75	603.7200 - Quantity Change
Date	Revision