



FED. ROAD DIST. NO.	STATE	FED. AID PROJ. NO.	FISCAL YEAR	SHEET NO.	TOTAL SHEETS
HAWAII	HAW.	I-HI-1(118)16	1975	24	209

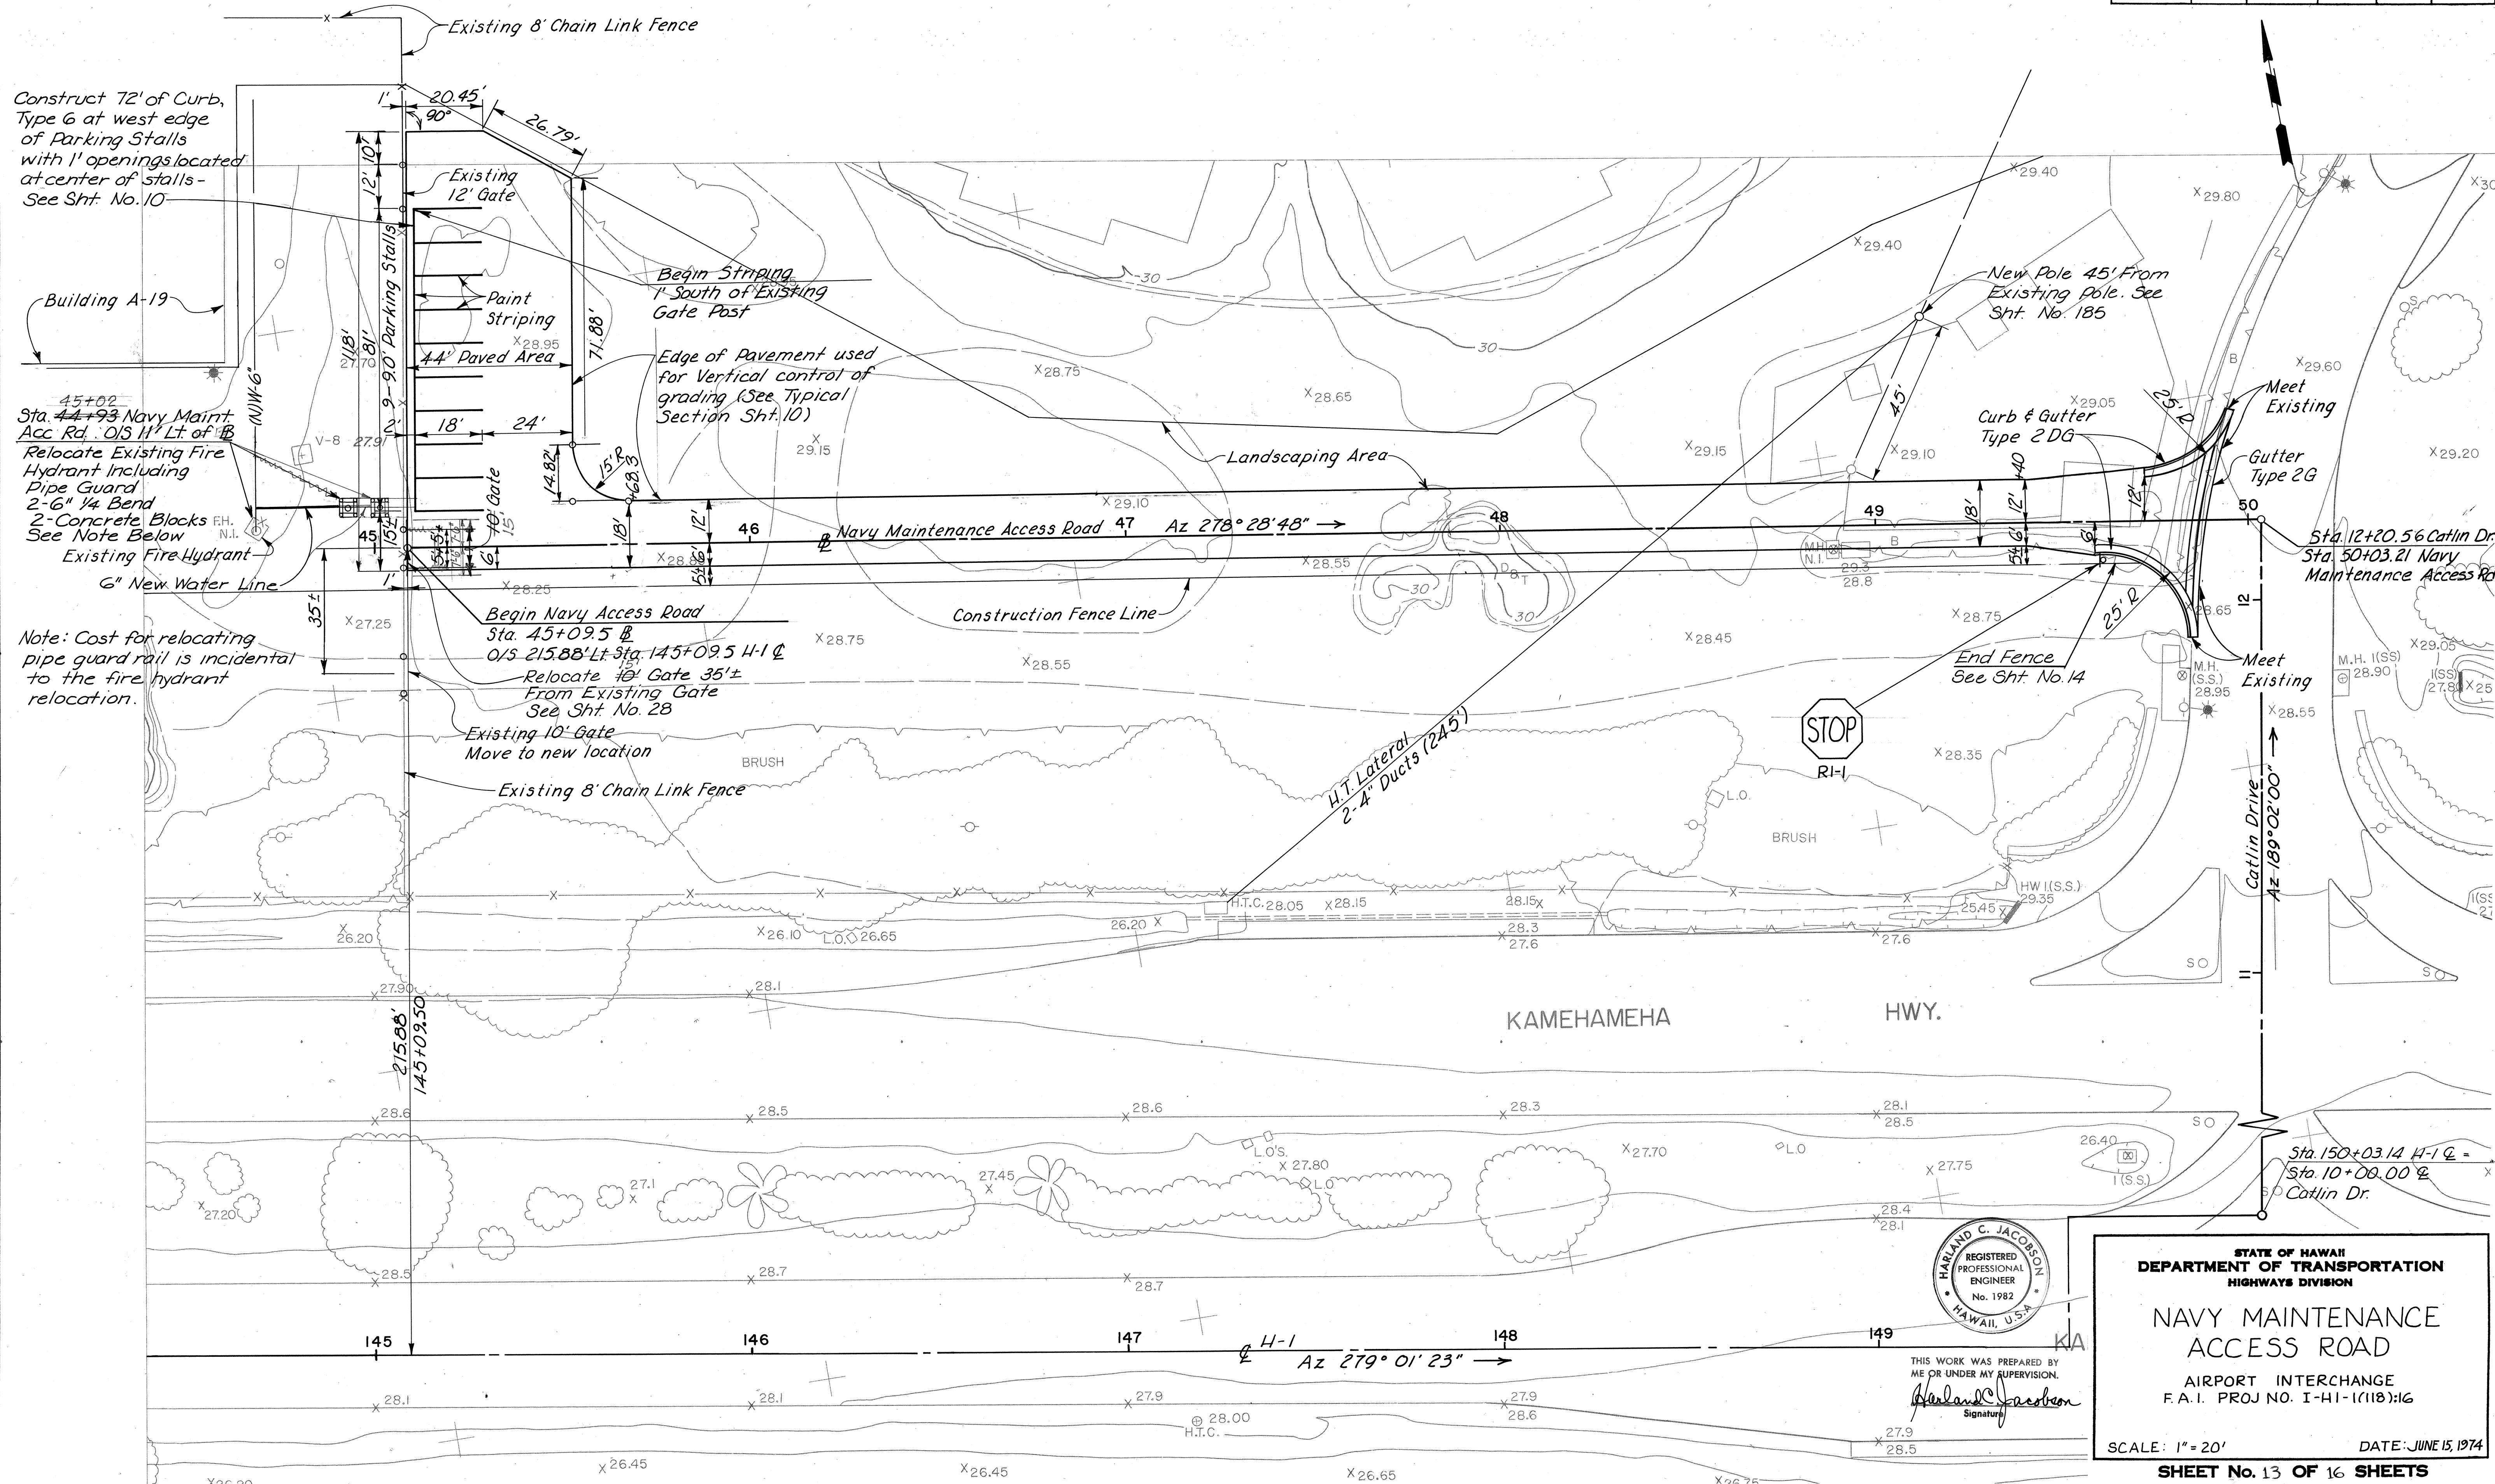

SURVEY PLOTTED BY	DATE
DRAWN BY	
DESIGNED BY	
QUANTITIES BY	
CHECKED BY	
ORIGINAL PLAN	
NOTE BOOK	
NO.	

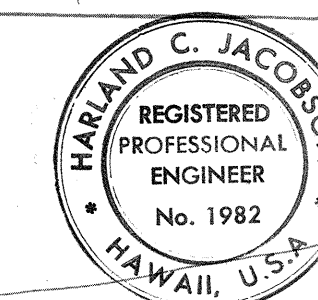

THIS WORK WAS PREPARED BY ME OR UNDER MY SUPERVISION.
 Signature: *Harland C. Jacobson*

STATE OF HAWAII
 DEPARTMENT OF TRANSPORTATION
 HIGHWAYS DIVISION

NAVY MAINTENANCE ACCESS ROAD

AIRPORT INTERCHANGE
 F.A.I. PROJ. NO. I-HI-1(118)16

SCALE: 1" = 20' DATE: JUNE 15, 1974
 SHEET No. 13 OF 16 SHEETS

