



FED. ROAD DIST. NO.	STATE	FED. AID PROJ. NO.	FISCAL YEAR	SHEET NO.	TOTAL SHEETS
HAWAII	HAW.	I-H1-1(09)13	1975	2	130

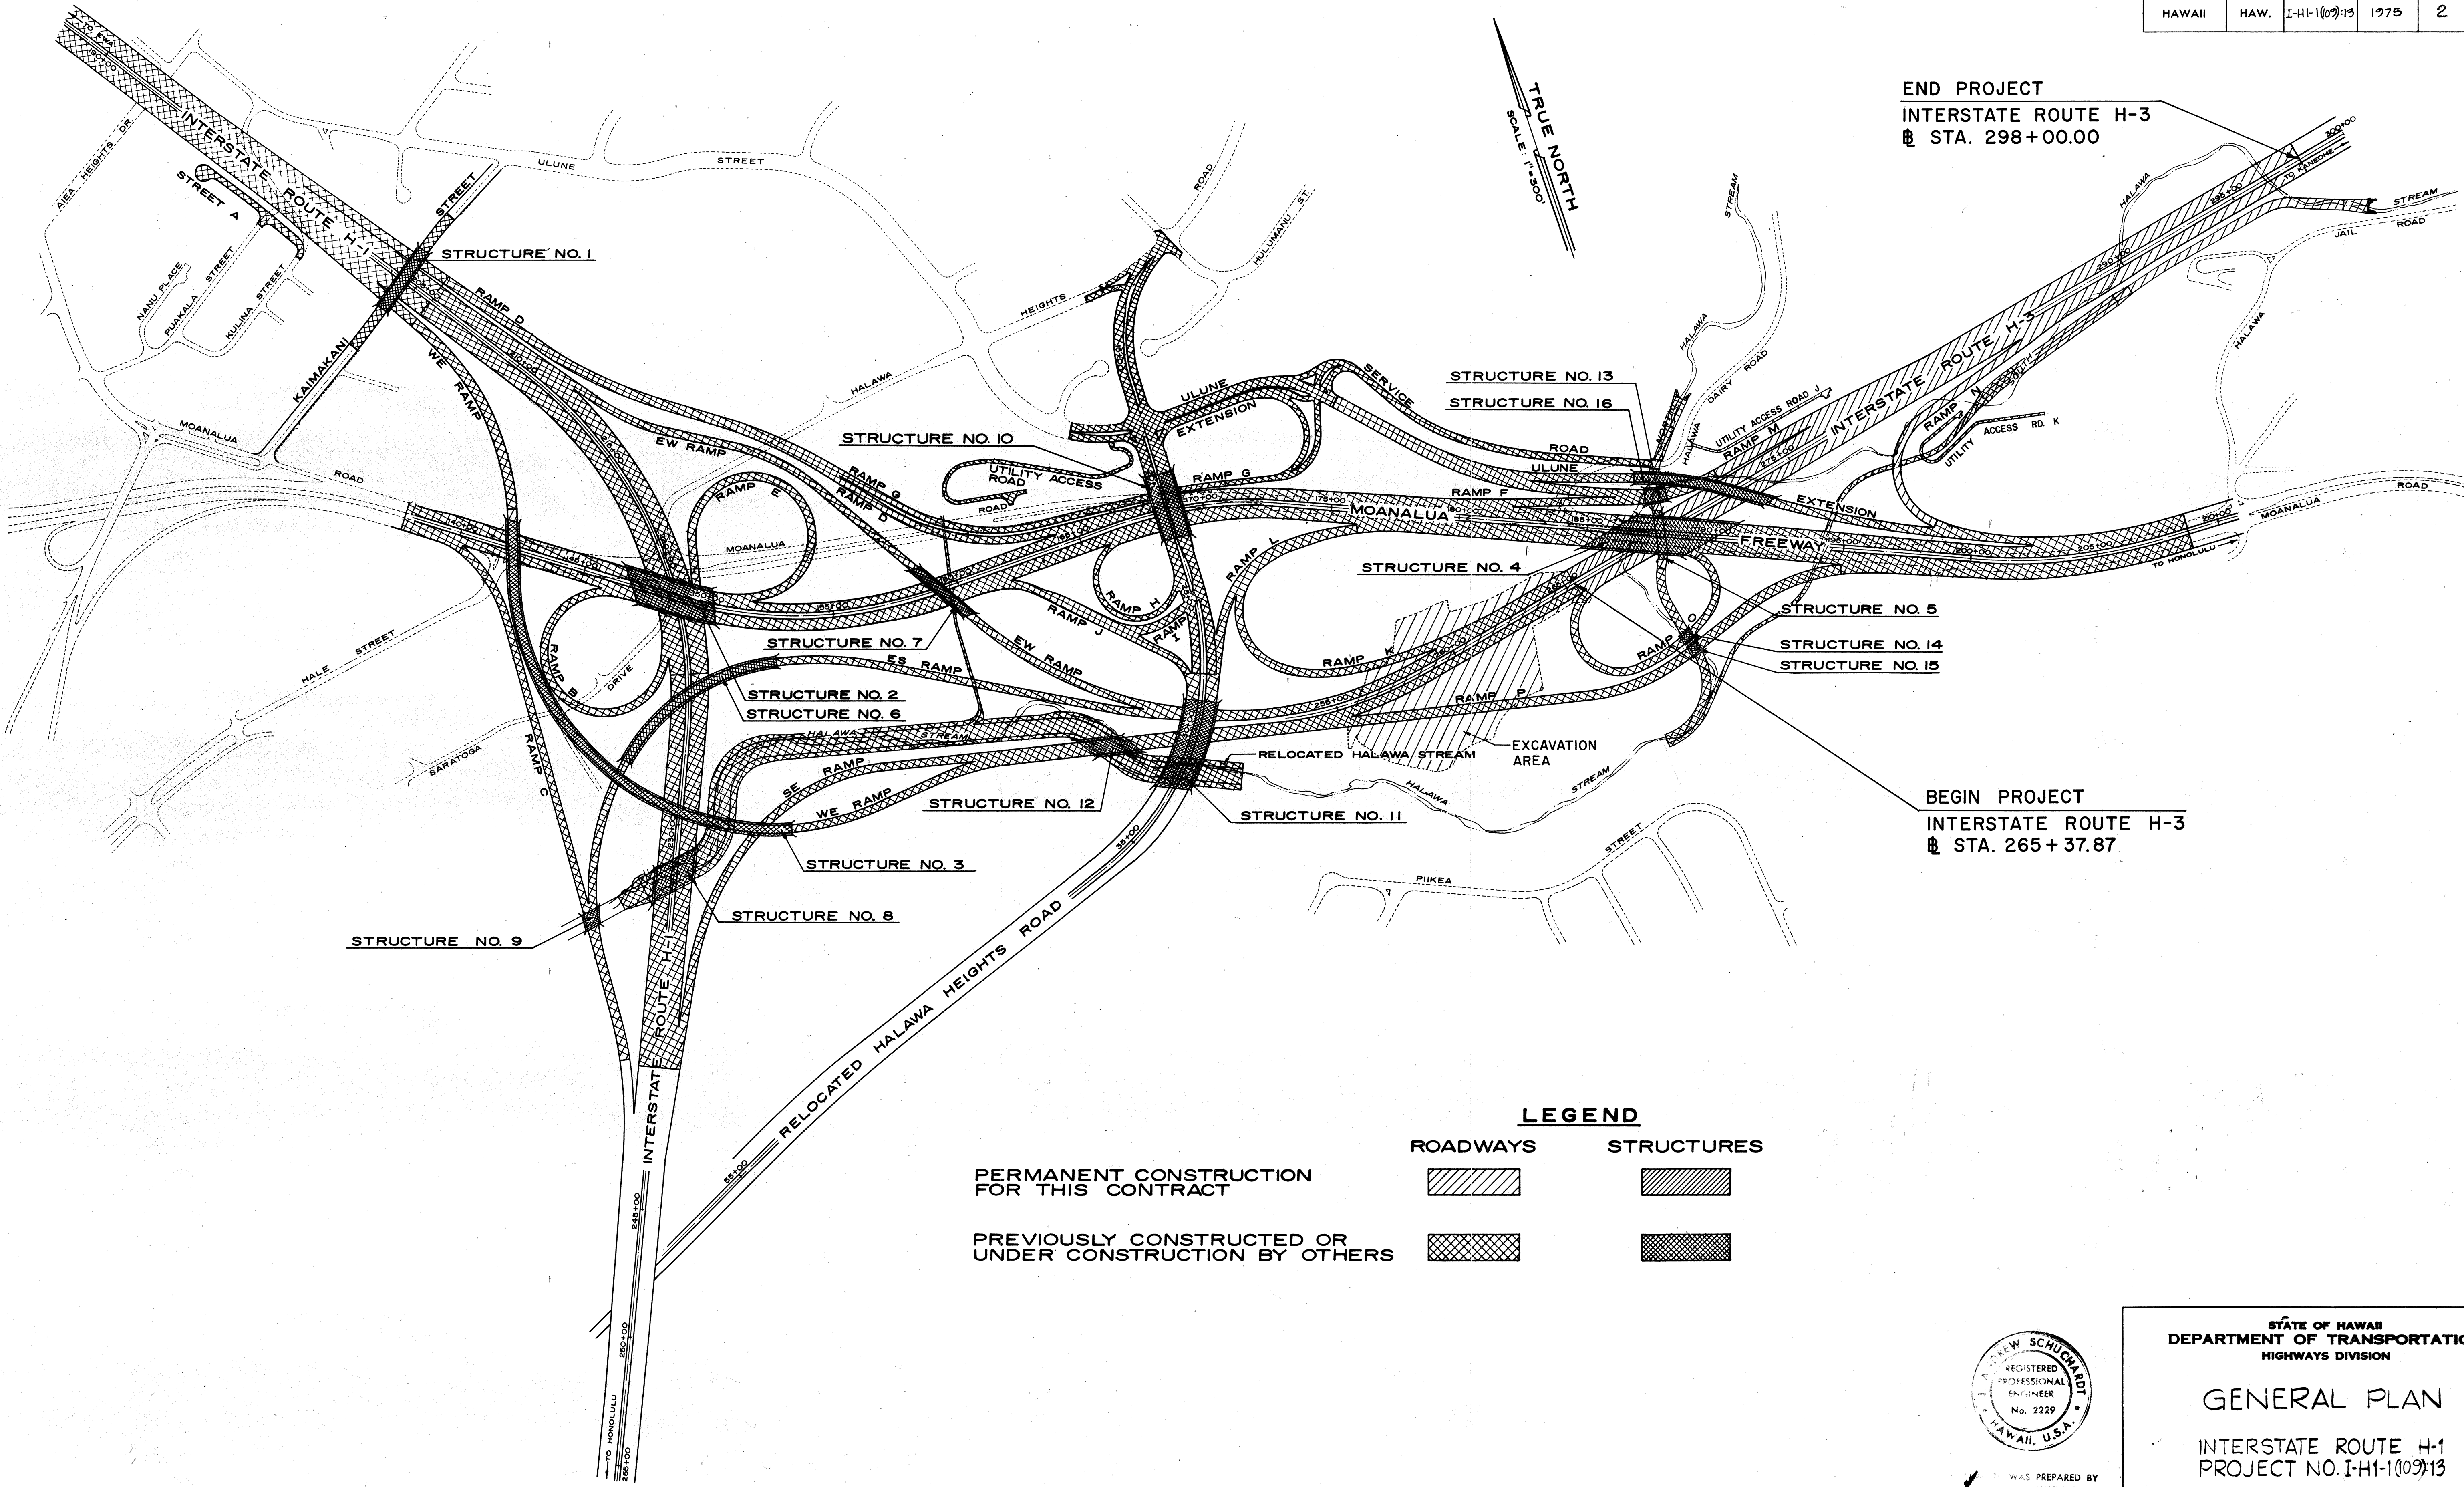

ORIGINAL PLAN	SURVEY PLATTED BY	DATE
NOTE BOOK	DRAWN BY	
	TRACED BY	
	QUANTITIES BY	
	CHECKED BY	

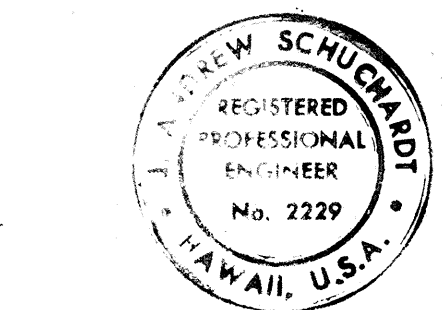

PREPARED BY
SUPERVISION
J. Andrew Schuchardt

STATE OF HAWAII
DEPARTMENT OF TRANSPORTATION
HIGHWAYS DIVISION

GENERAL PLAN

INTERSTATE ROUTE H-1
PROJECT NO. I-H1-1(09)13

SCALE: 1" = 300'

DATE: DEC. 29, 1972

SHEET No. 1 OF 1 SHEETS