

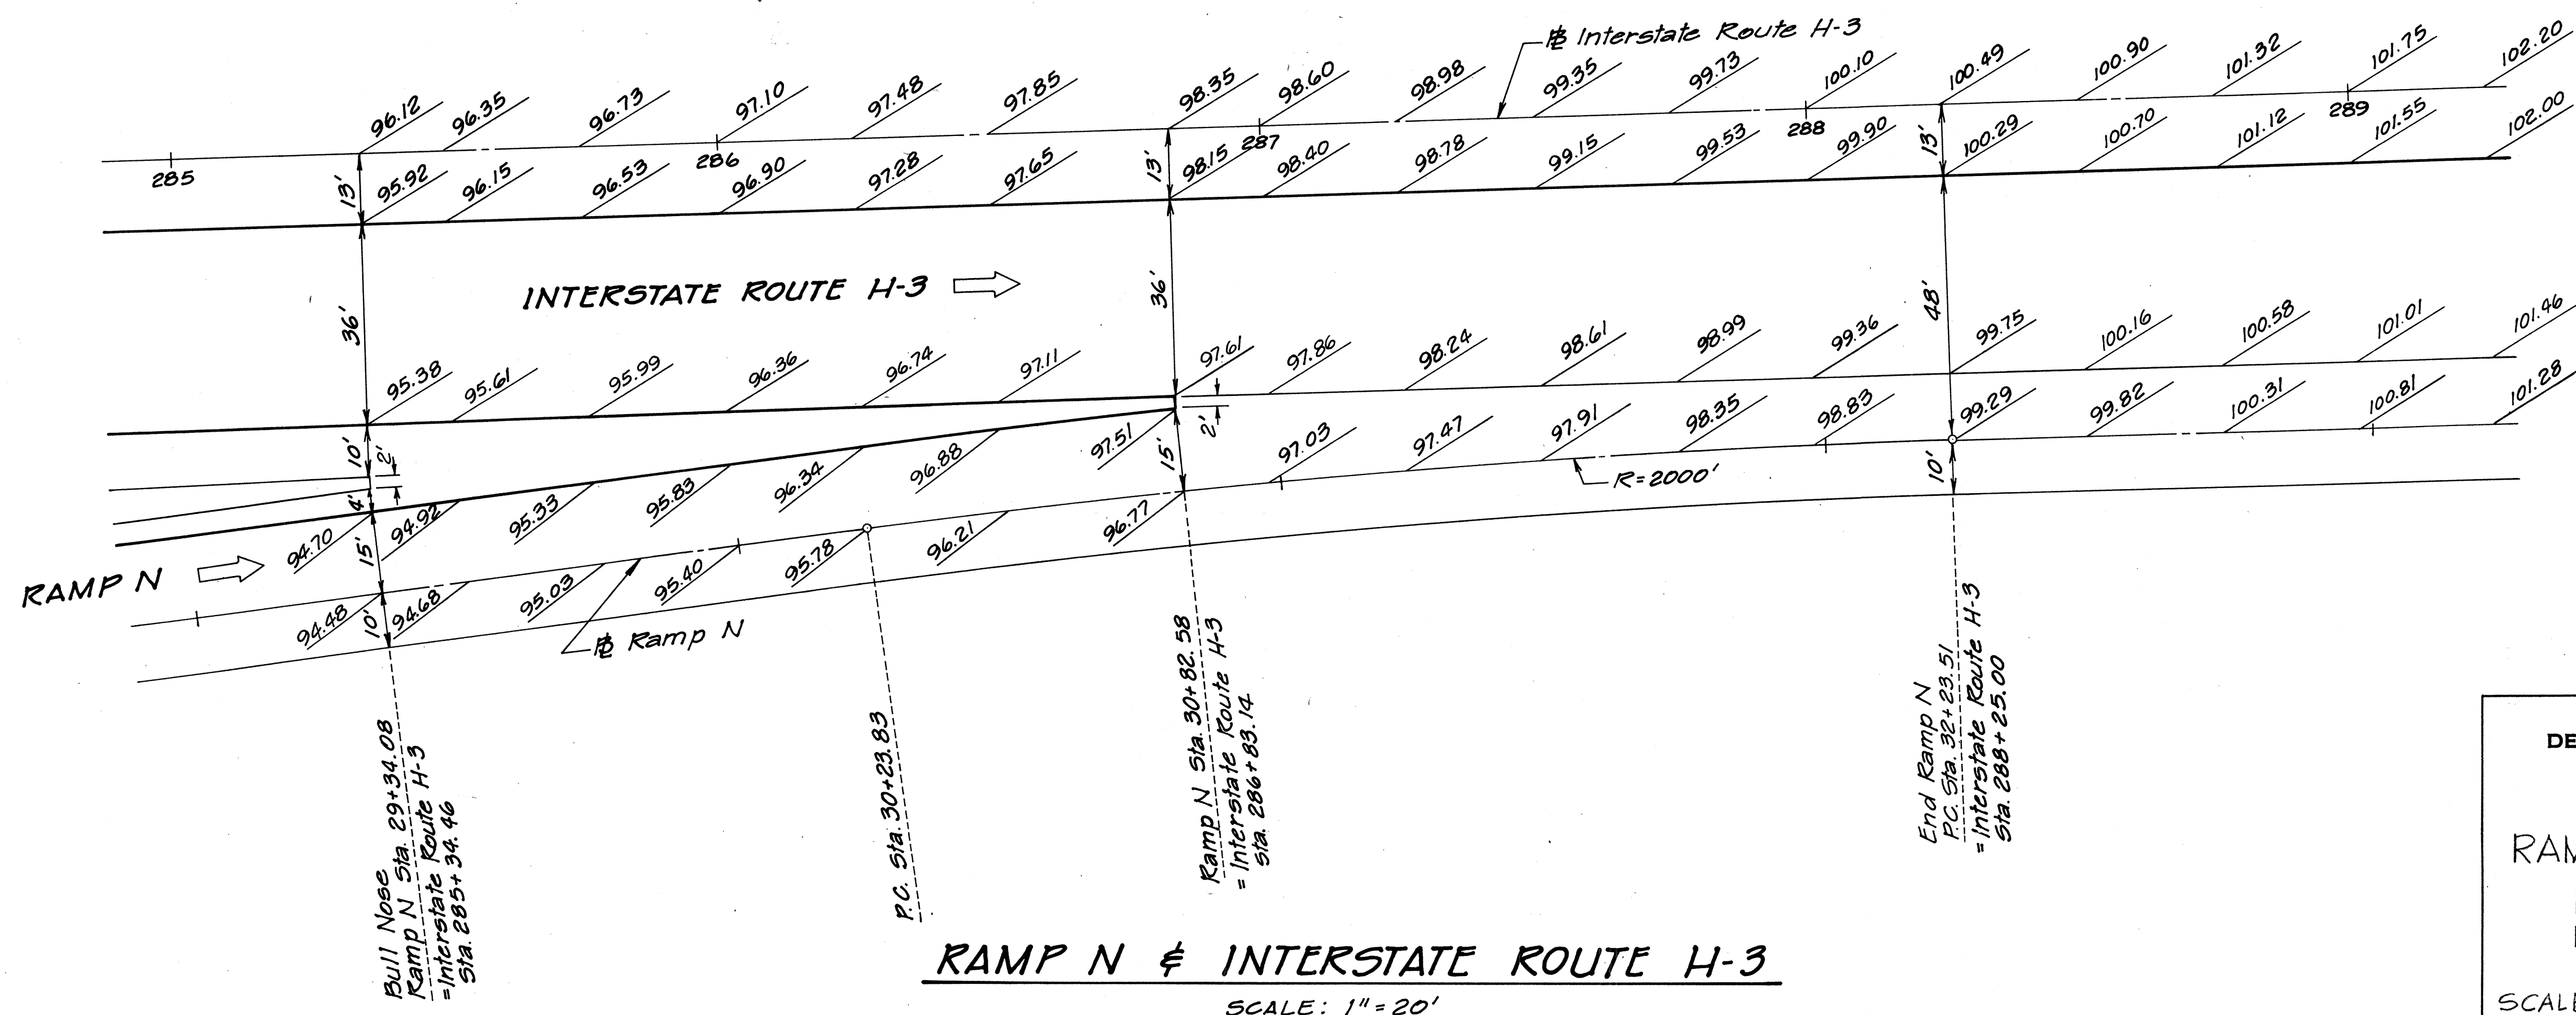



FED. ROAD DIST. NO.	STATE	FED. AID PROJ. NO.	FISCAL YEAR	SHEET NO.	TOTAL SHEETS
HAWAII	HAW.	I-HI-1(109):13	1975	11	130

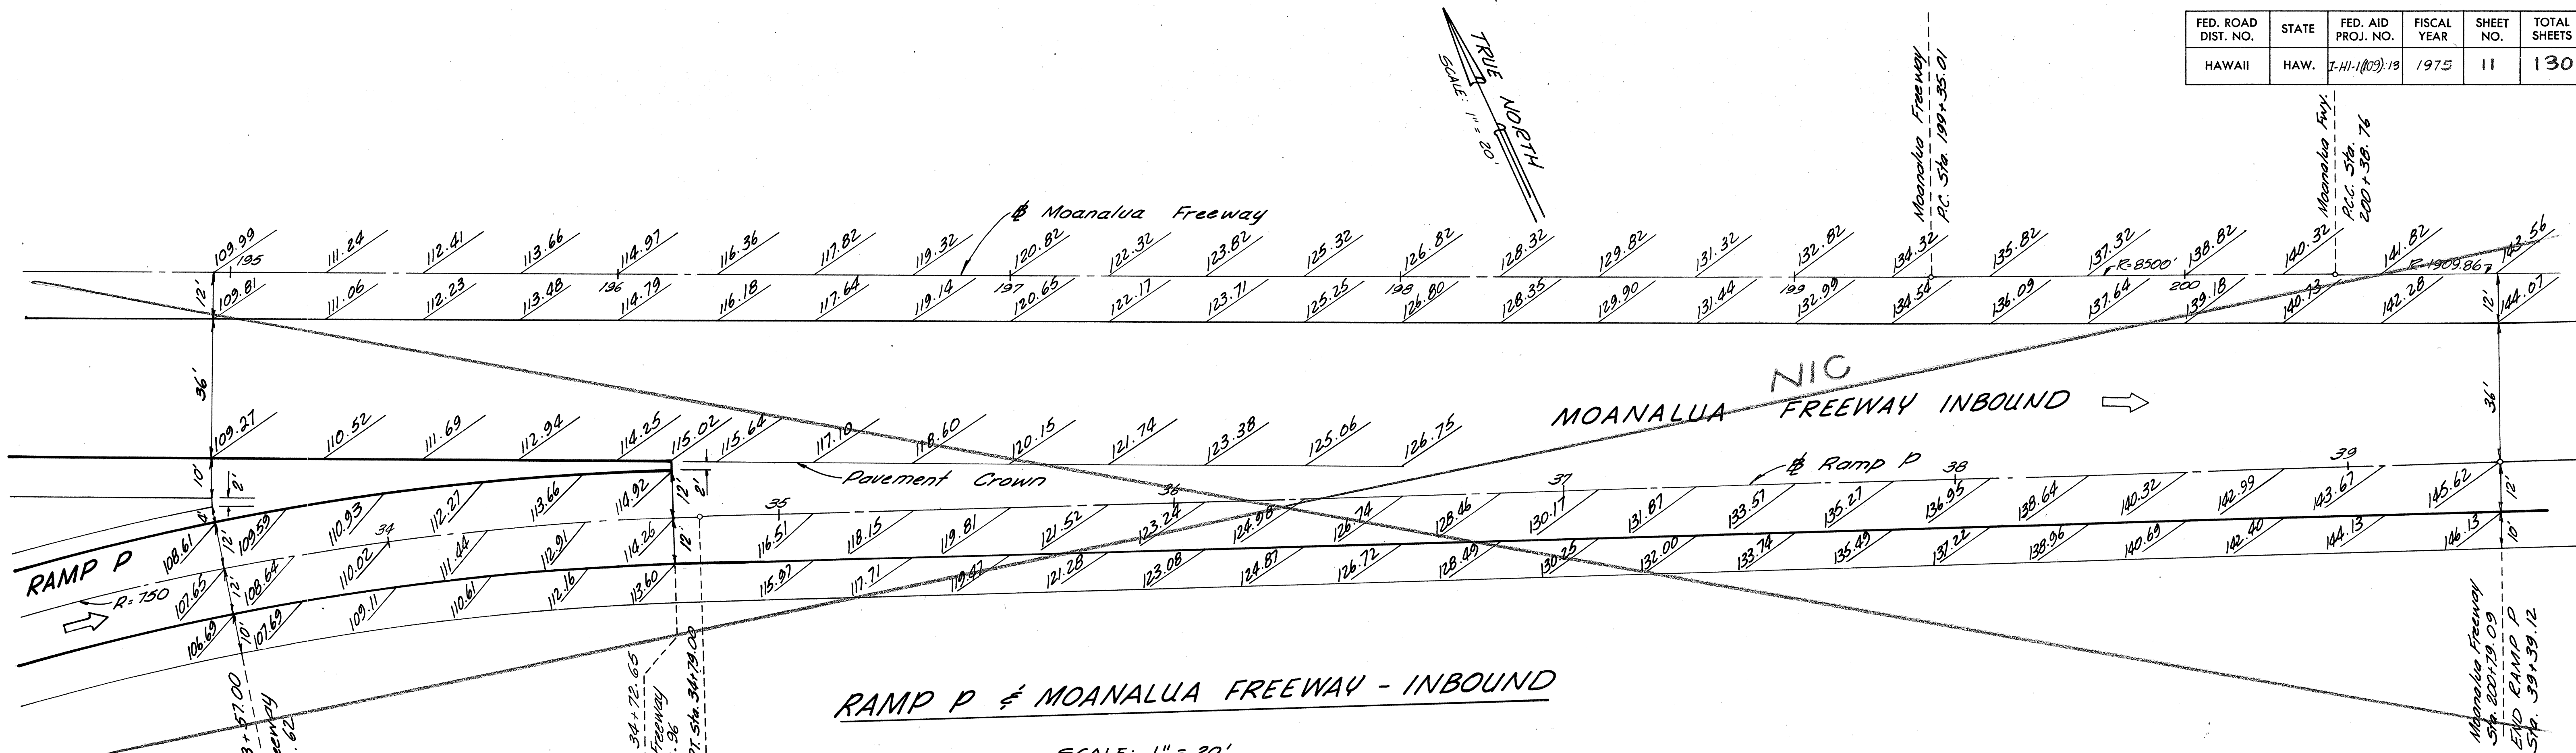

FED. ROAD DIST. NO.	STATE	FED. AID PROJ. NO.	FISCAL YEAR	SHEET NO.	TOTAL SHEETS
HAWAII	HAW.	I-H-1(109):13	1975	12	130

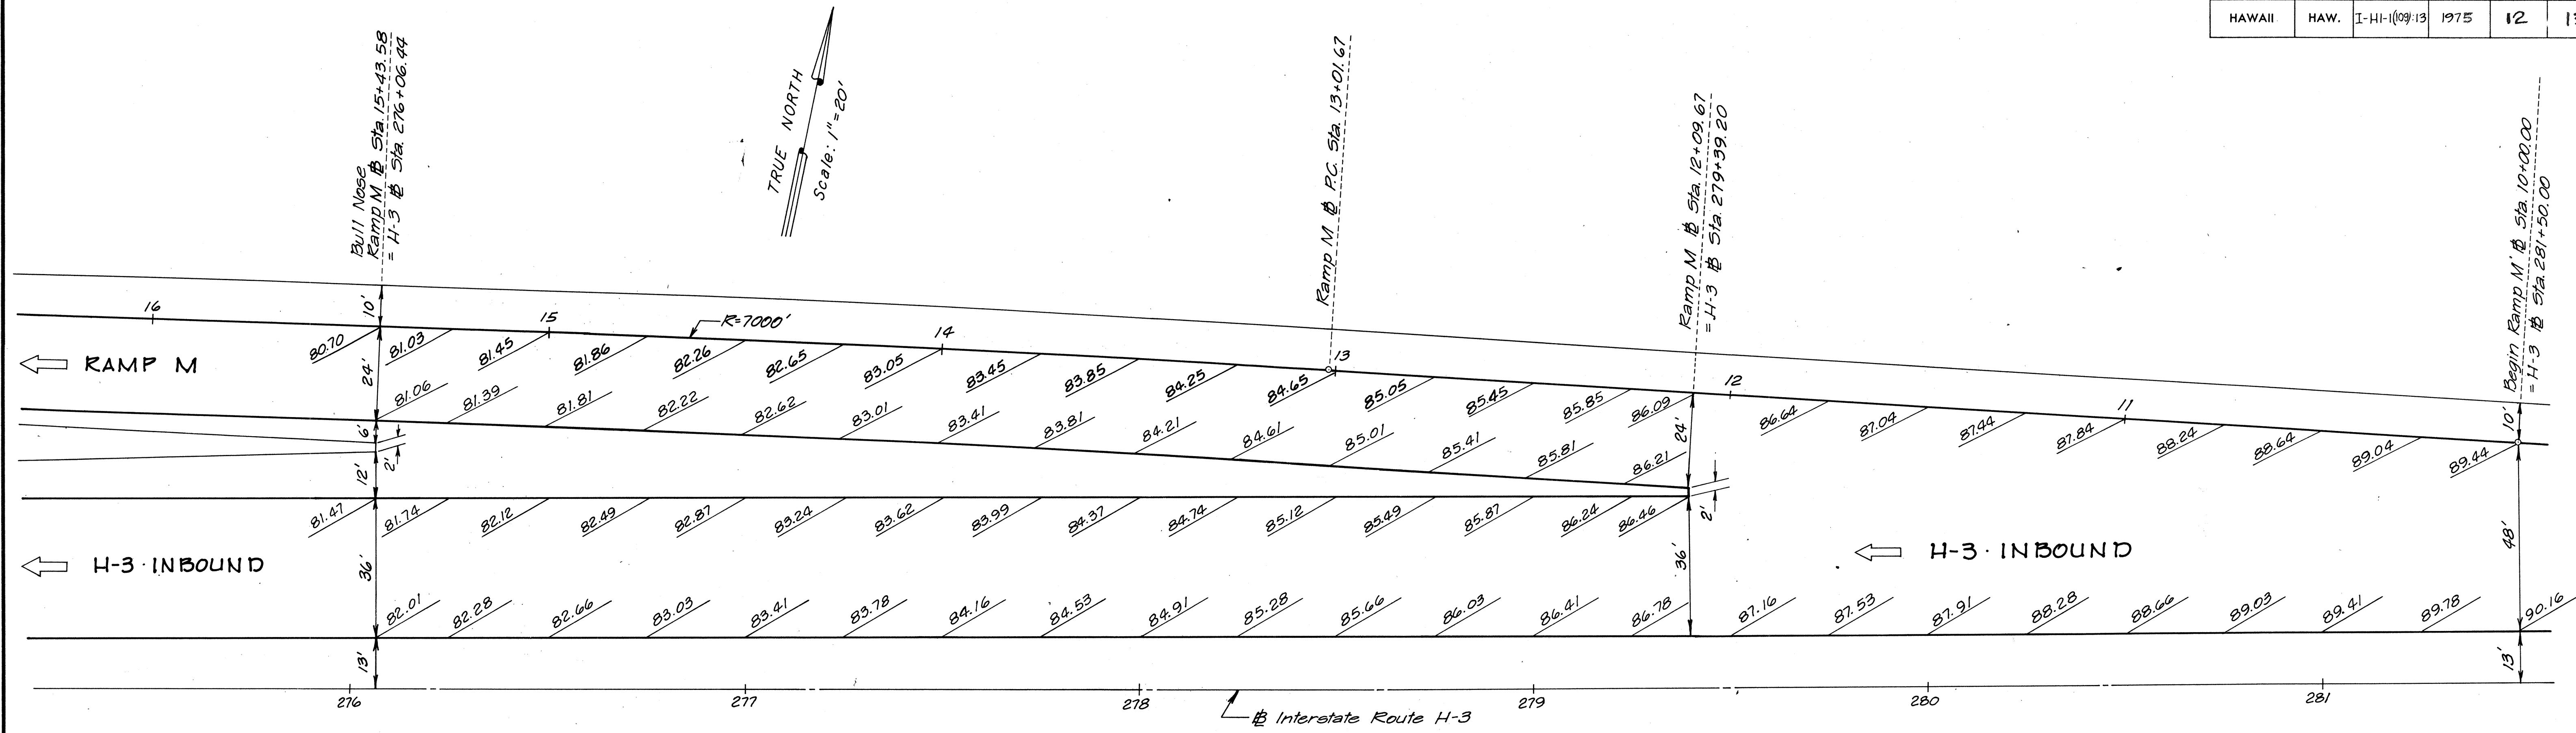


RAMP M & H-3 - INBOUND
Scale: 1" = 20'

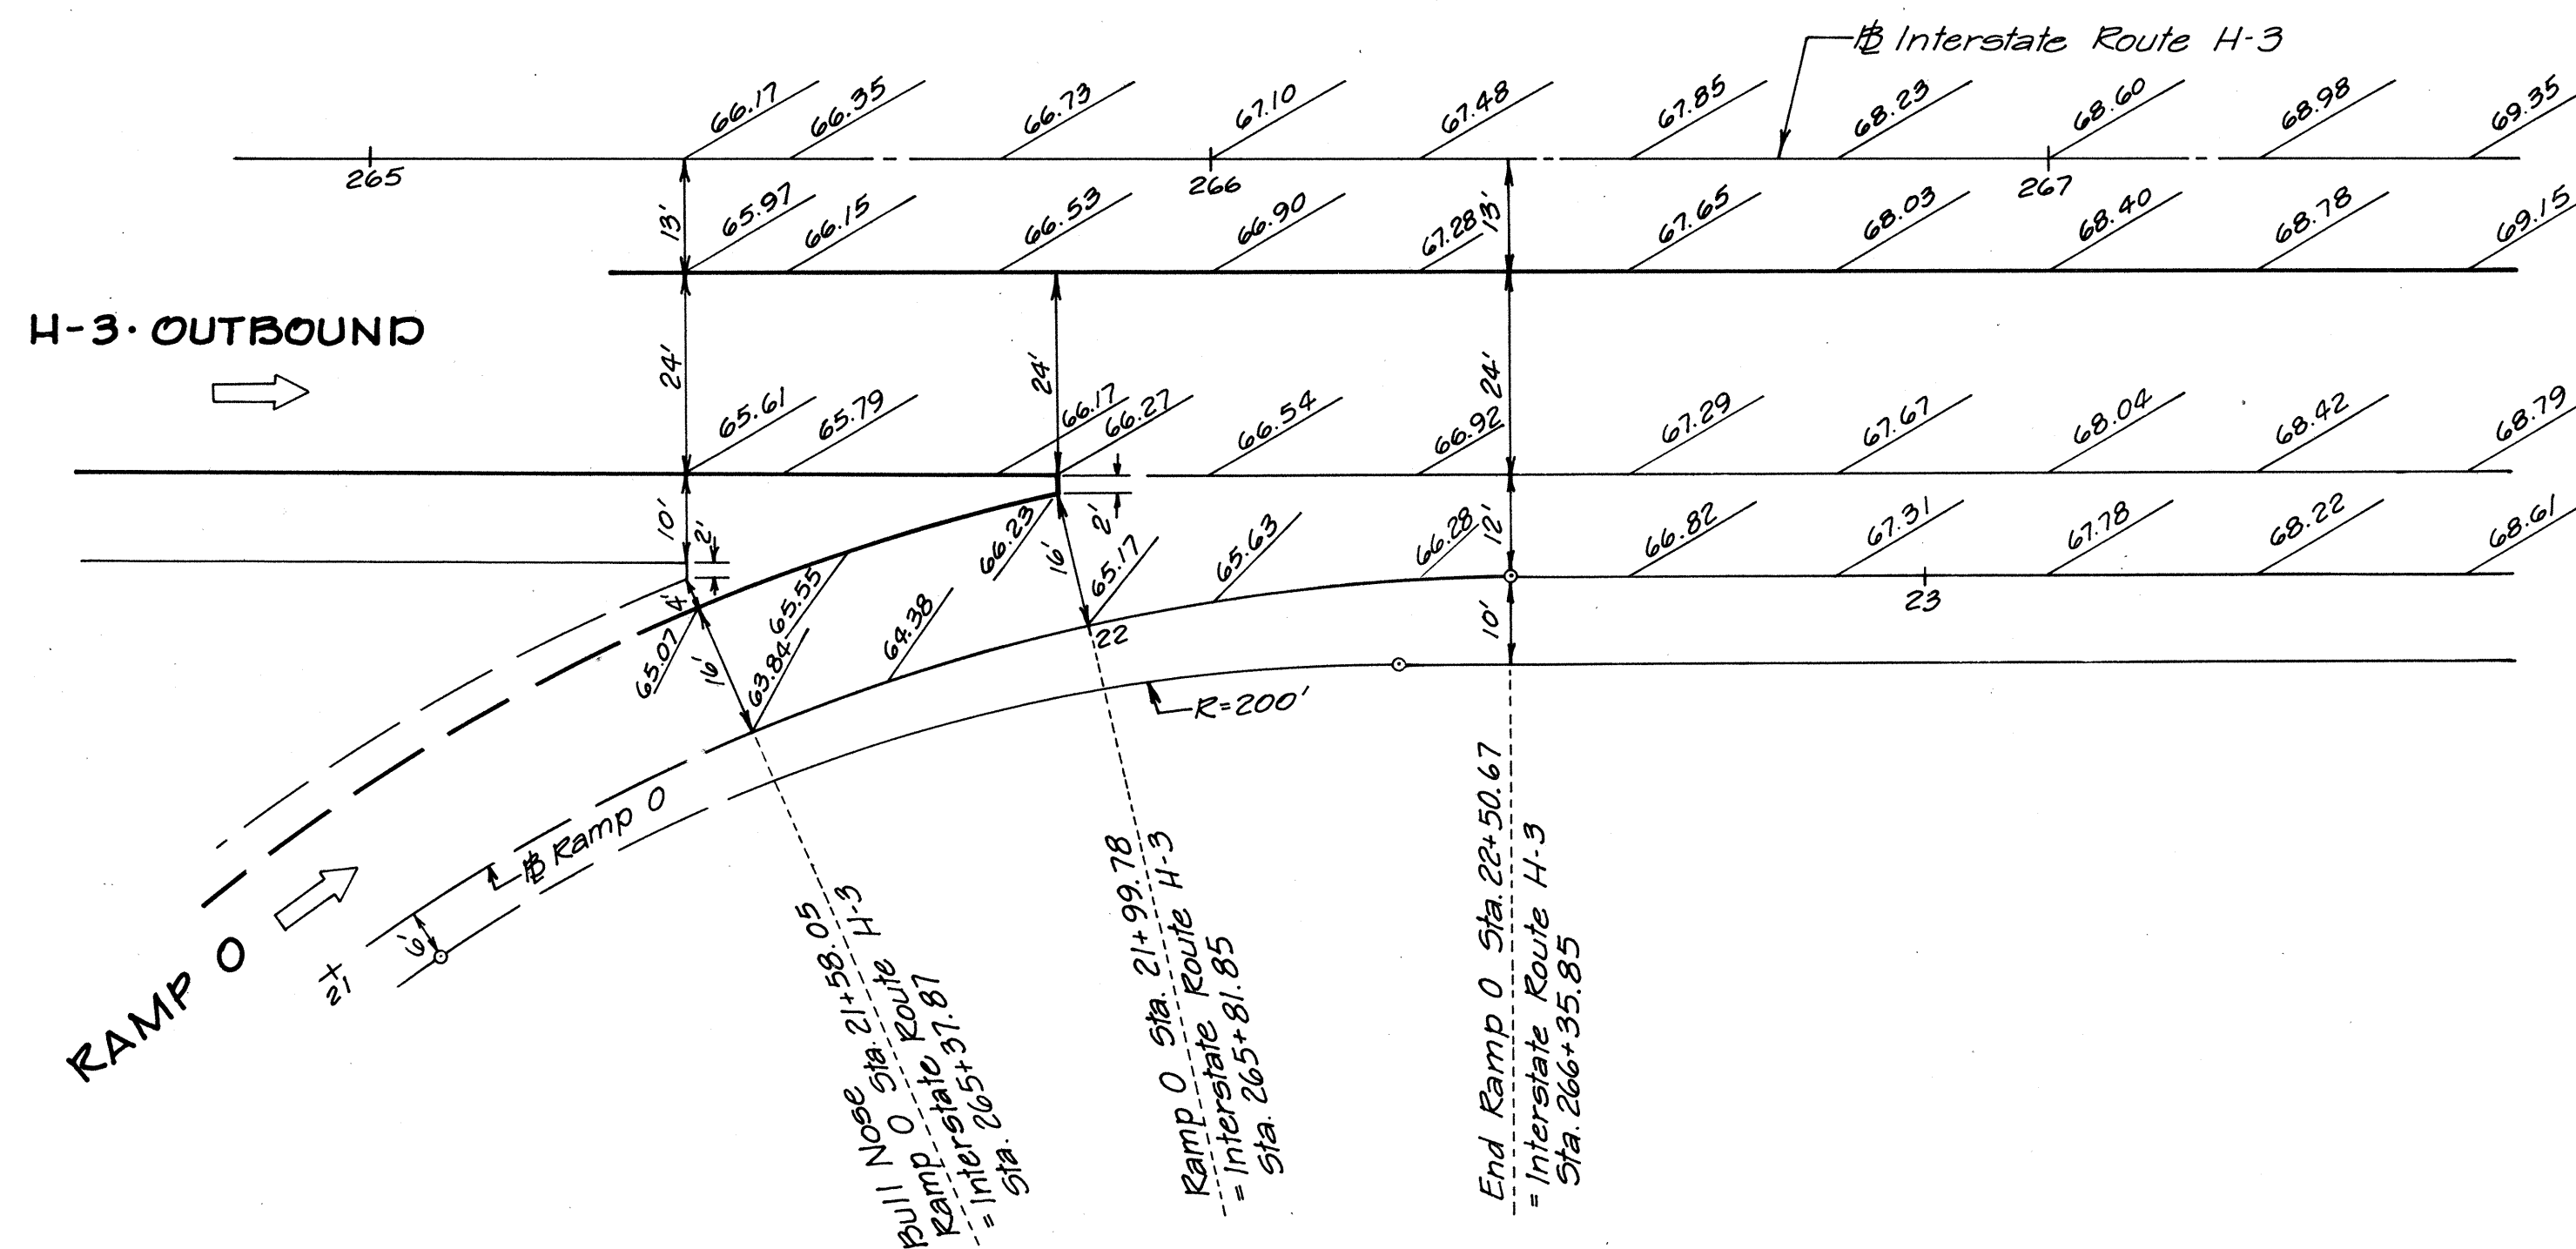

RAMP O & H-3 - OUTBOUND
Scale: 1" = 20'

ORIGINAL PLAN	SURVEY PLOTTED BY	DATE
NOTED BY	DRAWN BY	
CHECKED BY	DESIGNED BY	
	QUANTITIES BY	
	CHECKED BY	

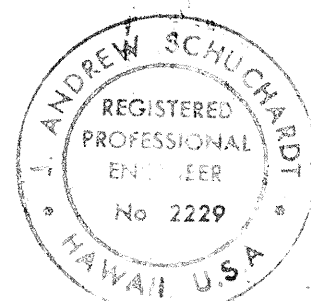

Note: See Sheet No. 1R

STATE OF HAWAII
DEPARTMENT OF TRANSPORTATION
HIGHWAYS DIVISION

RAMP TERMINAL DETAILS
INTERSTATE ROUTE H-1
PROJECT NO. I-H-1(109):13
SCALE: 1" = 20' DATE: DEC. 29, 1972
SHEET No. 2R OF 2R SHEETS