INDEX TO DRAWINGS	
SHEET NO.	DESCRIPTION
1	TITLE SHEET
2	GENERAL PLAN
3-4	TYPICAL SECTIONS
5-7	ALIGNMENT PLANS
8-10	PROFILES & SUPERELEVATION DIAGRAM
11-12	RAMP TERMINAL DETAILS
13-35	ROADWAY CONSTRUCTION PLANS & DETAILS
36-46 [*]	DRAINAGE PLANS & DETAILS
47-51	BORING LOCATION PLAN & BORING LOGS
52-73	SIGNING PLANS & DETAILS
74-84	HIGHWAY LIGHTING & ELECTRICAL
85-88	UTILITY PLANS & DETAILS
89-94**	SOUTH HALAWA STREAM CHANNEL
95	CROSS SECTION KEY SHEET
96-130	CROSS SECTIONS
* ADD43S-I	CATCH BASIN & MANHOLE CASTINGS
** ADD9IS-I	RETAINING WALL AT NORTH HALAWA
	STREAM

STATE OF HAWAII

DEPARTMENT OF TRANSPORTATION
HIGHWAYS DIVISION

HONOLULU, HAWAII
"AS BUILT"


PLANS FOR CONSTRUCTION OF A PORTION OF

INTERSTATE ROUTE H-I

HALAWA INTERCHANGE

SOUTH OF MOANALUA ROAD TOWARD RED HILL

FEDERAL AID INTERSTATE PROJECT NO. I-HI-I(109): 13

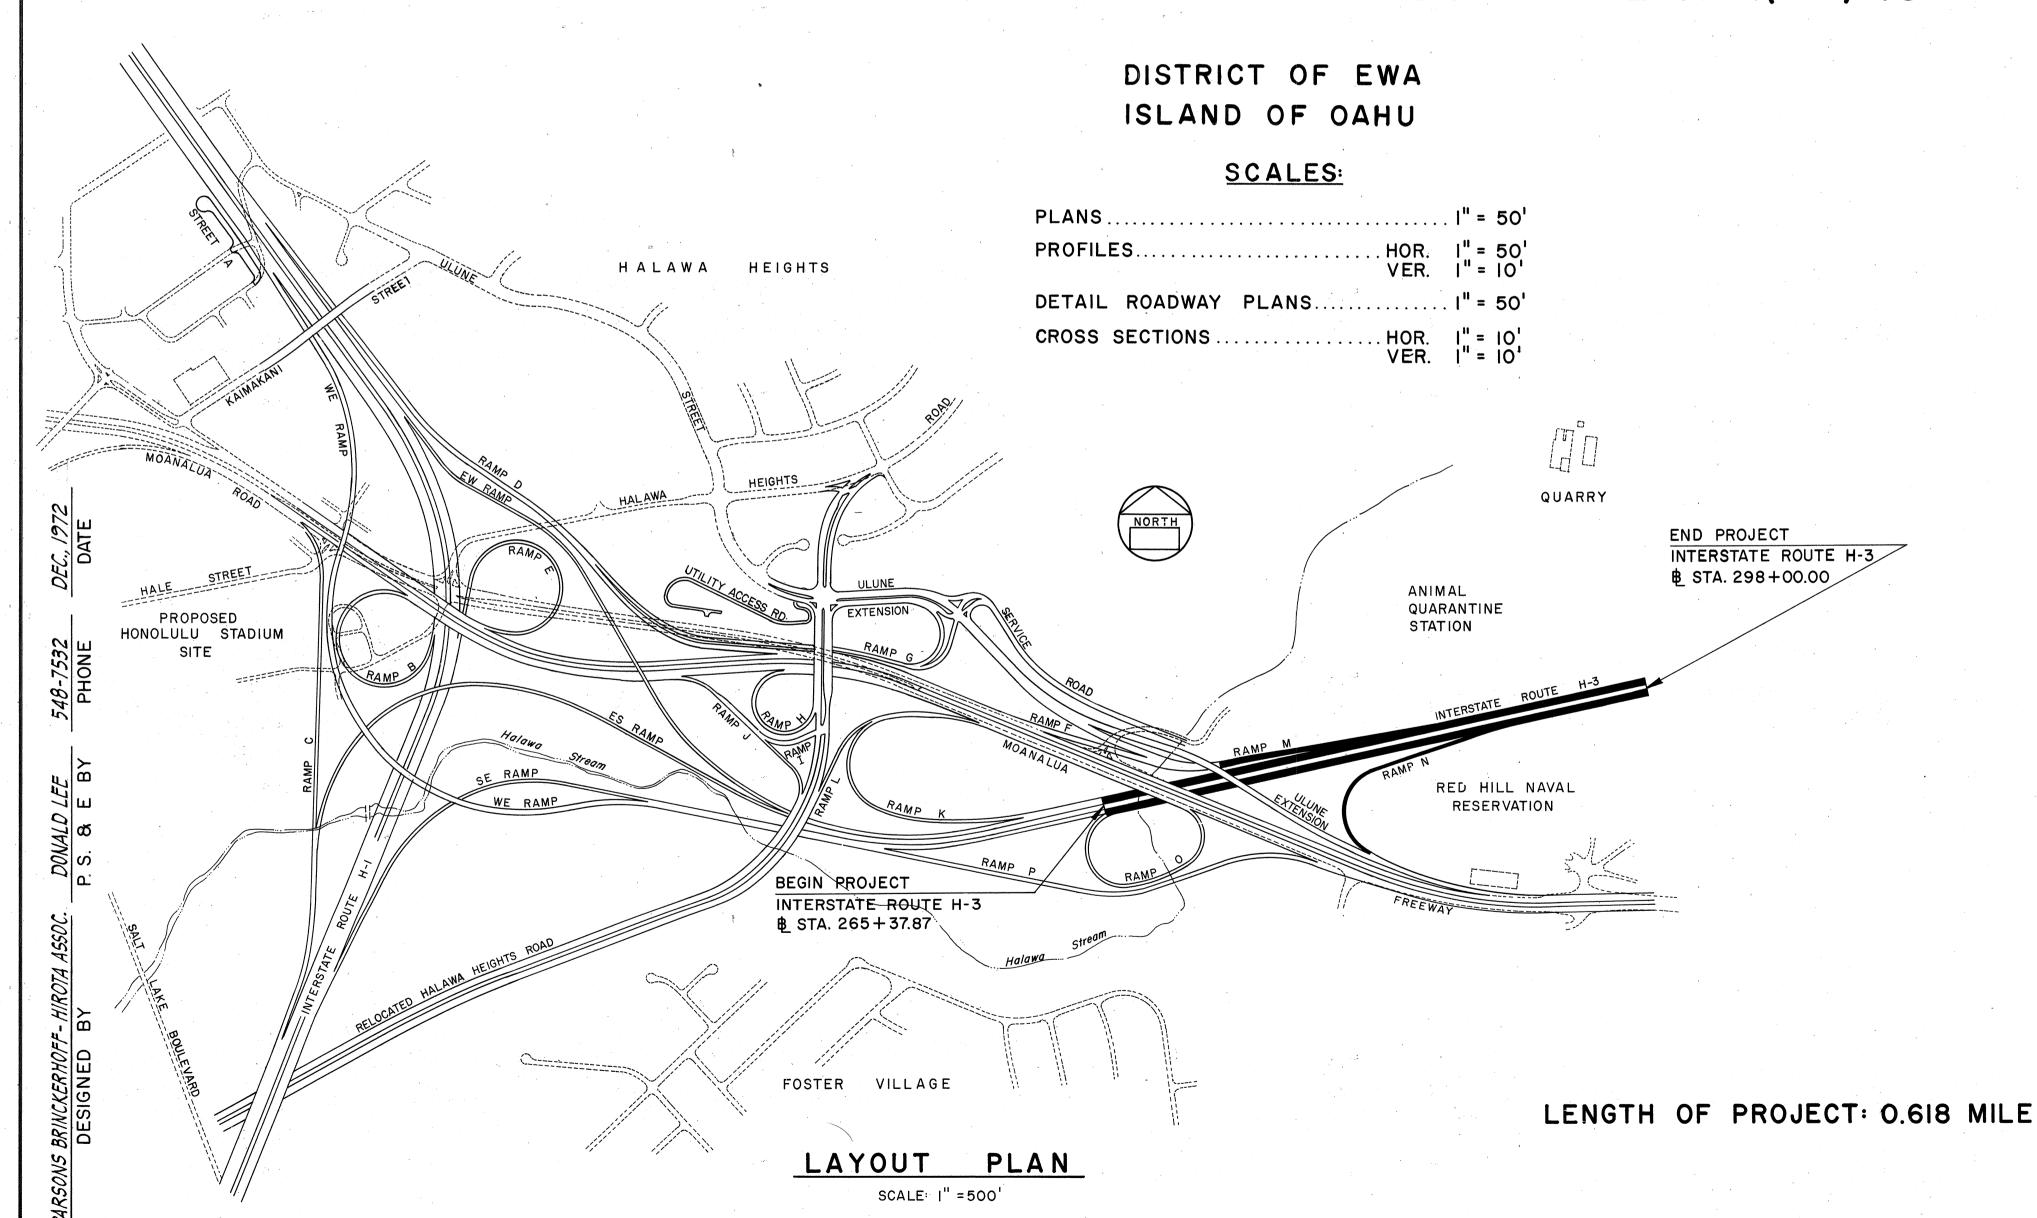

Waianae

Waimea

Waimea

Waimea

Wainalu

Haleiwa

Punaluu

Kaaawa

Wainahole

Kahaluu

Kaneohe

Kaneohe

Kaliua

Kaliua

Federal Aid Projects Previously Constructed or Under Construction

FED. ROAD STATE FED. AID FISCAL PROJ. NO. YEAR

HAW. I-H1-1(109):13 1975

VOTE

ALL CHANGES MADE DURING CONSTRUCTION HAVE BEEN INCORPORATED ON THESE PLANS IN RED EXCEPT CHANGES IN THE ORIGINAL THEORETICAL QUANTITIES. FOR ACTUAL QUANTITIES, REFER TO PROJECT LEDGER AND/OR COMPUTATION BOOK.

DESIGN CLASSIFICATION (H-3 STA. 290+00)

LOCATION OF PROJECT

PROJECT ENGINEER

June 25, 1976

DATE

DEPARTMENT OF TRANSPORTATION FEDERAL HIGHWAY ADMINISTRATION

DIVISION ENGINEER

1.20.75

DEPARTMENT OF TRANSPORTATION
STATE OF HAWAII

APPROVED:

6. Alvey Maright 12/27/2