


ORIGINAL PLAN	SURVEY PLOTTED BY _____ DATE _____
NOTE BOOK	DRAWN BY _____
	TRACED BY _____
	DESIGNED BY _____
	QUANTITIES BY _____
No. _____	CHECKED BY _____




2/6/76 Pave A.C. Mix III on shoulders
medians and gore areas. (GCC #16)


FED. ROAD DIST. NO.	STATE	FED. AID PROJ. NO.	FISCAL YEAR	SHEET NO.	TOTAL SHEETS
HAWAII	HAW.	I-HI-1(109)13	1975	4	130

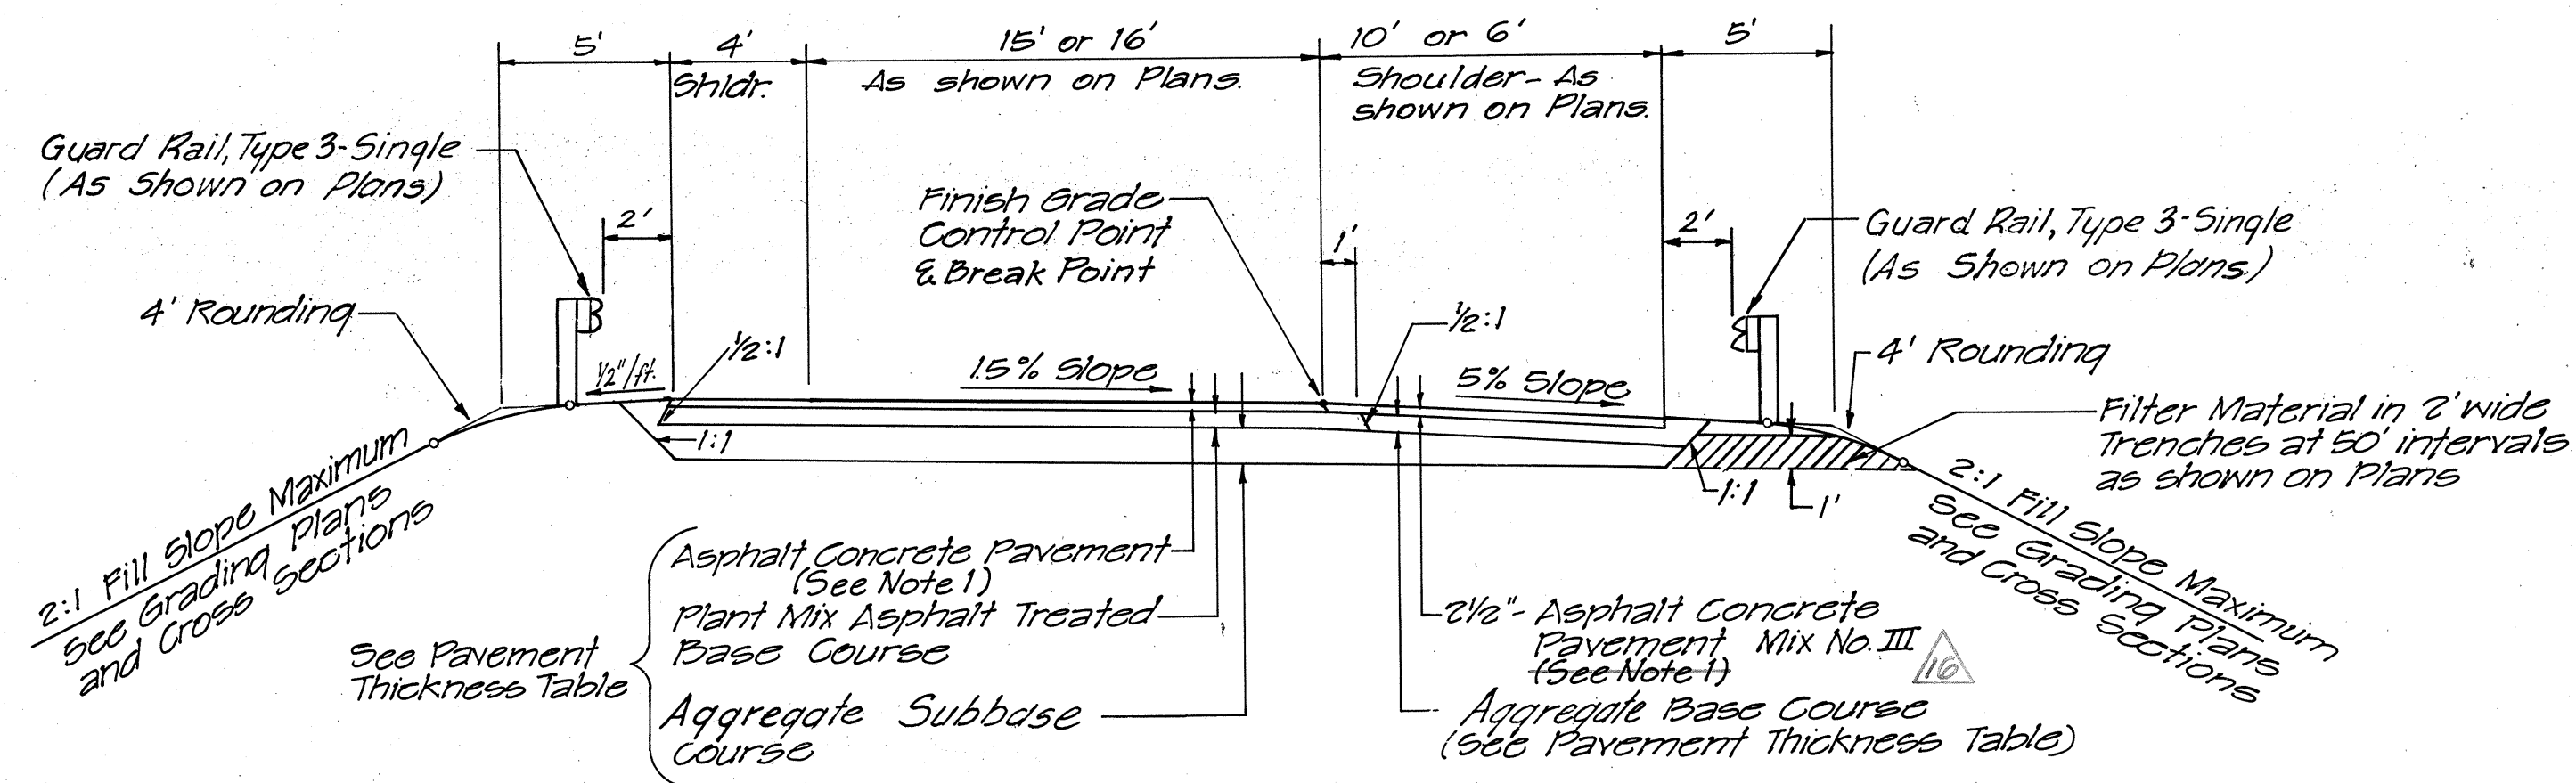

ONE LANE RAMP
NORMAL SECTION - RAMP N

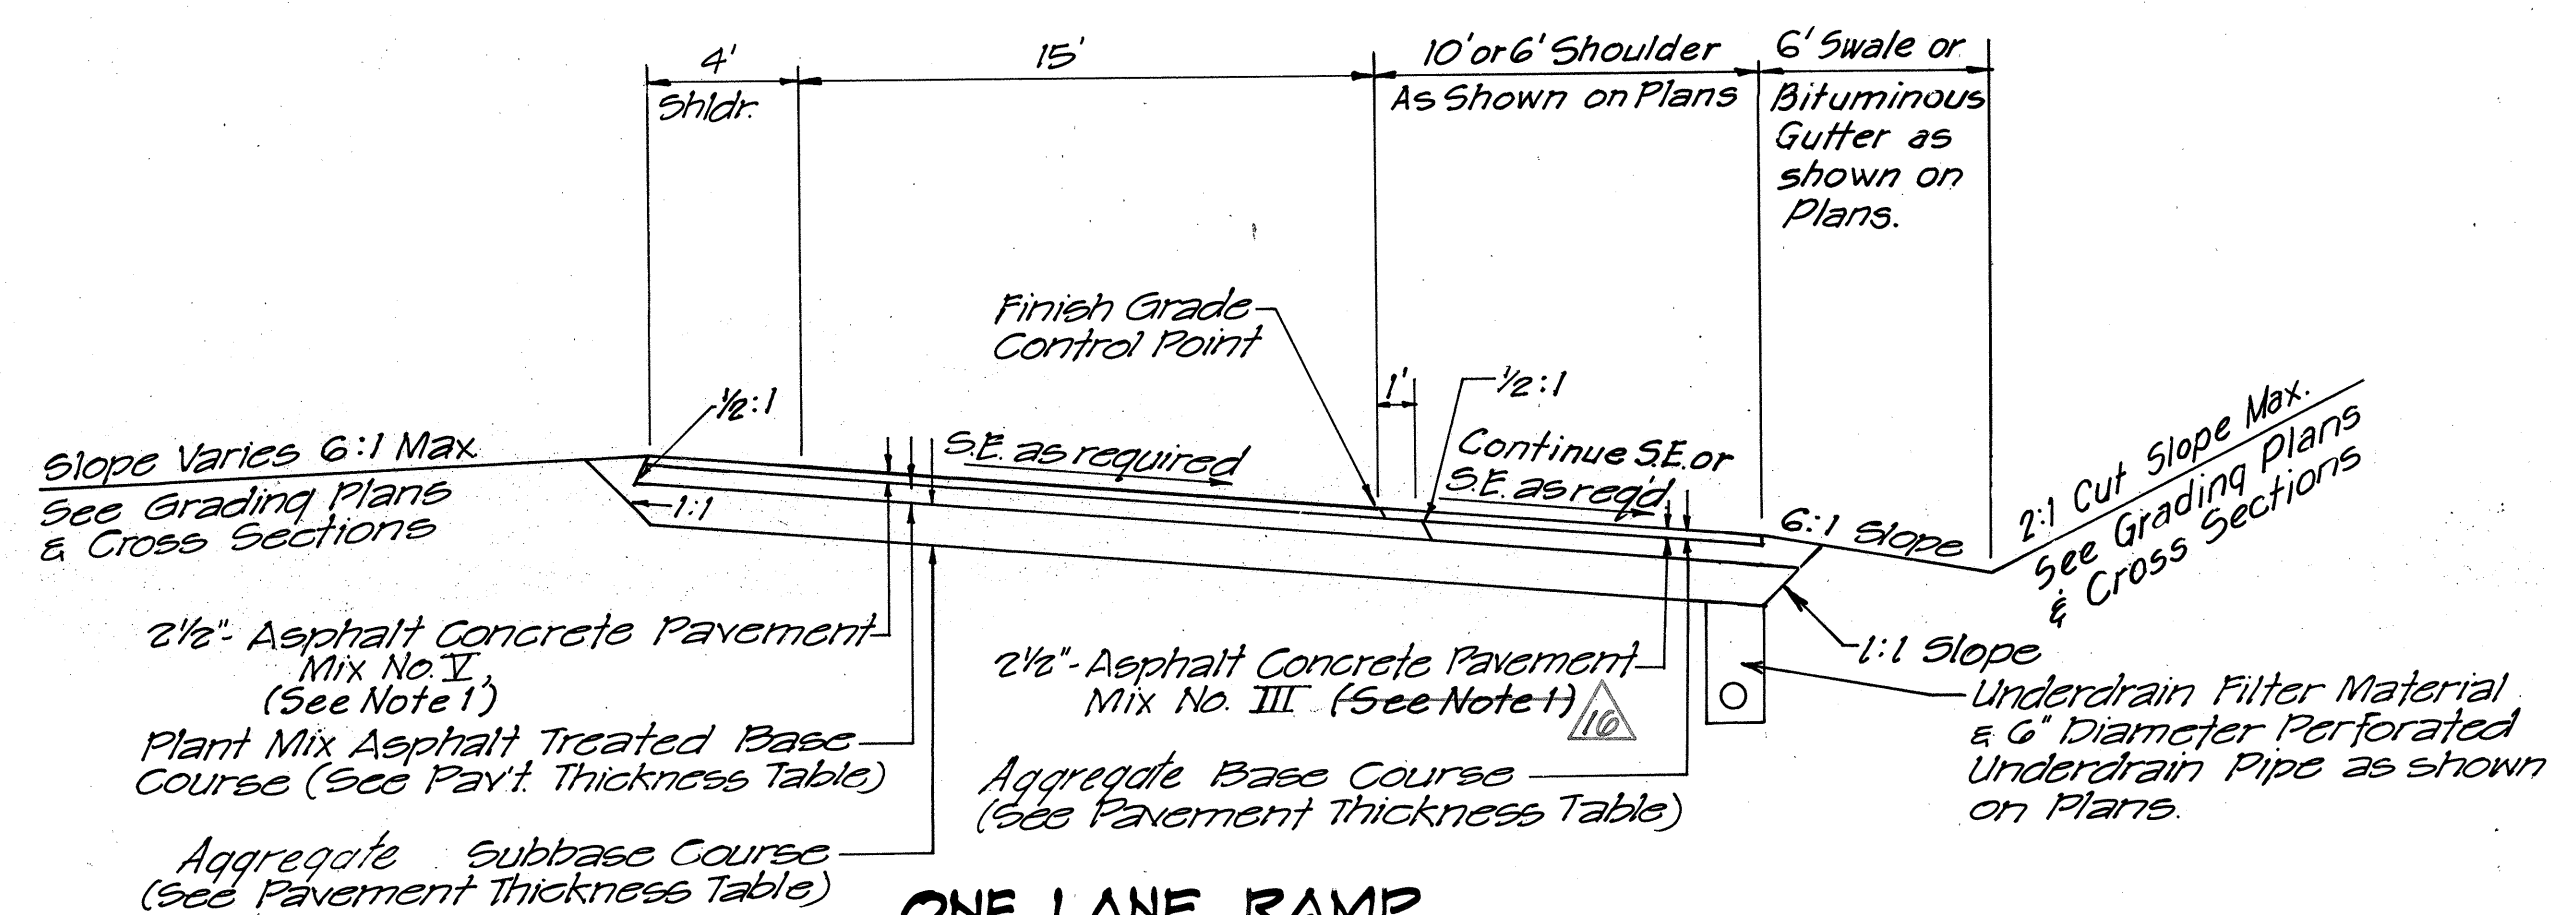


ONE LANE RAMP
SUPERELEVATED SECTION - RAMP N

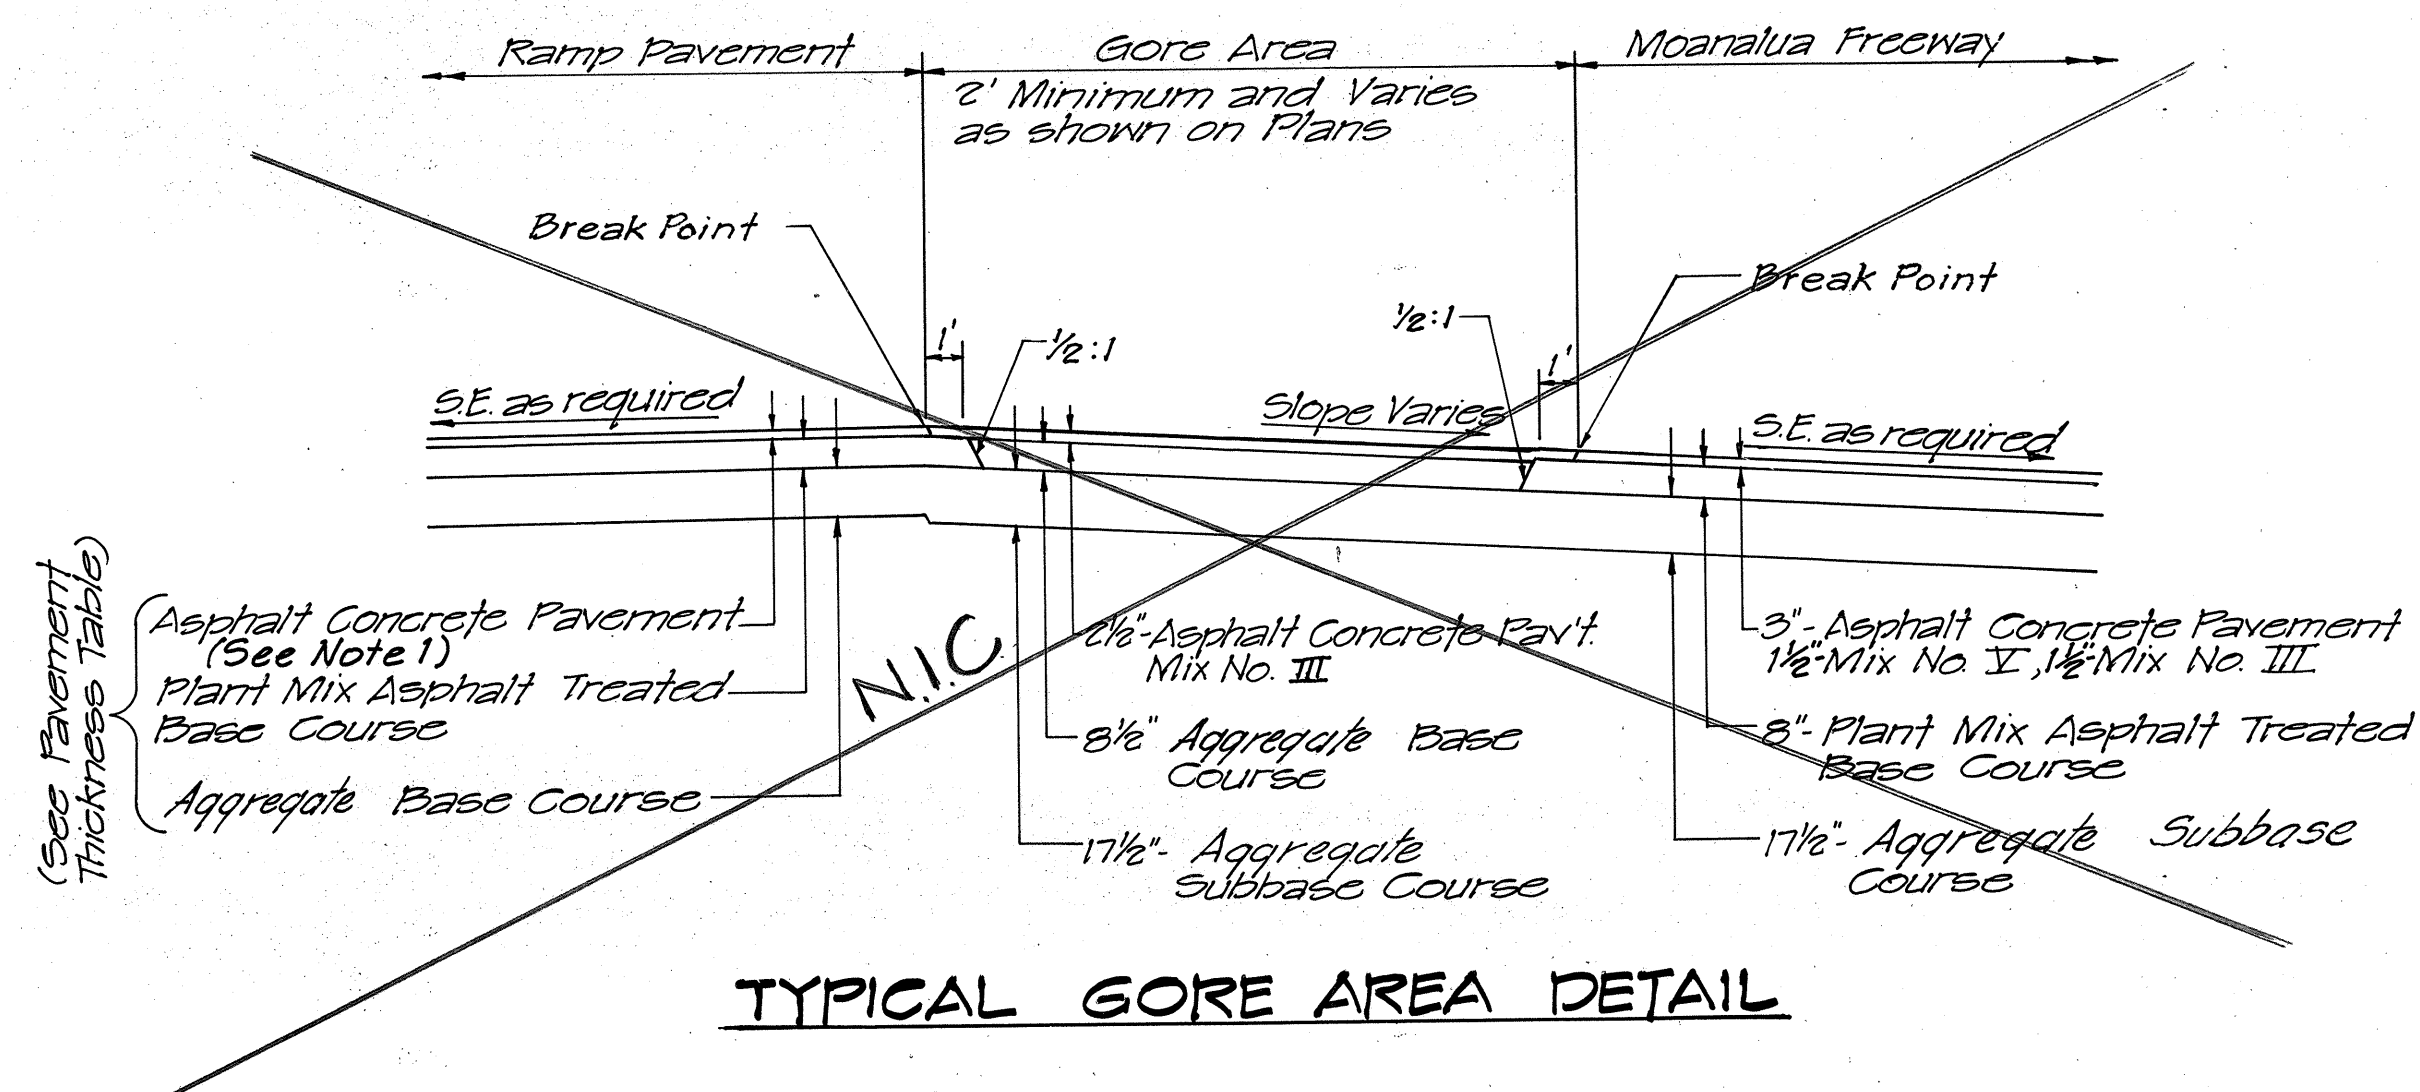


TYPICAL GORE AREA DETAIL


PAYEMENT THICKNESS TABLE								
MATERIALS	RAMP F	RAMP L	RAMP M	RAMP N	RAMP G	ULINE EXTENSION	RAMP O	RAMP P
Asphalt Concrete Pavement	2 1/2"	2 1/2"	2 1/2"	2 1/2"	2 1/2"	2 1/2"	2 1/2"	2 1/2"
Mix No. I	2 1/2"	2 1/2"	2 1/2"	2 1/2"	2 1/2"	2 1/2"	2 1/2"	2 1/2"
Mix No. III	2 1/2"	2 1/2"	2 1/2"	2 1/2"	2 1/2"	2 1/2"	2 1/2"	2 1/2"
Plant Mix Asphalt Treated Base Course	4 1/2"	5"	4 1/2"	4 1/2"	4 1/2"	4 1/2"	4 1/2"	4 1/2"
Aggregate Subbase Course	15 1/2"	11 1/2"	15 1/2"	16"	13 1/2"	13 1/2"	13 1/2"	13 1/2"
Aggregate Base Course (Shoulder)	4 1/2"	5"	4 1/2"	4 1/2"	4 1/2"	4 1/2"	4 1/2"	4 1/2"

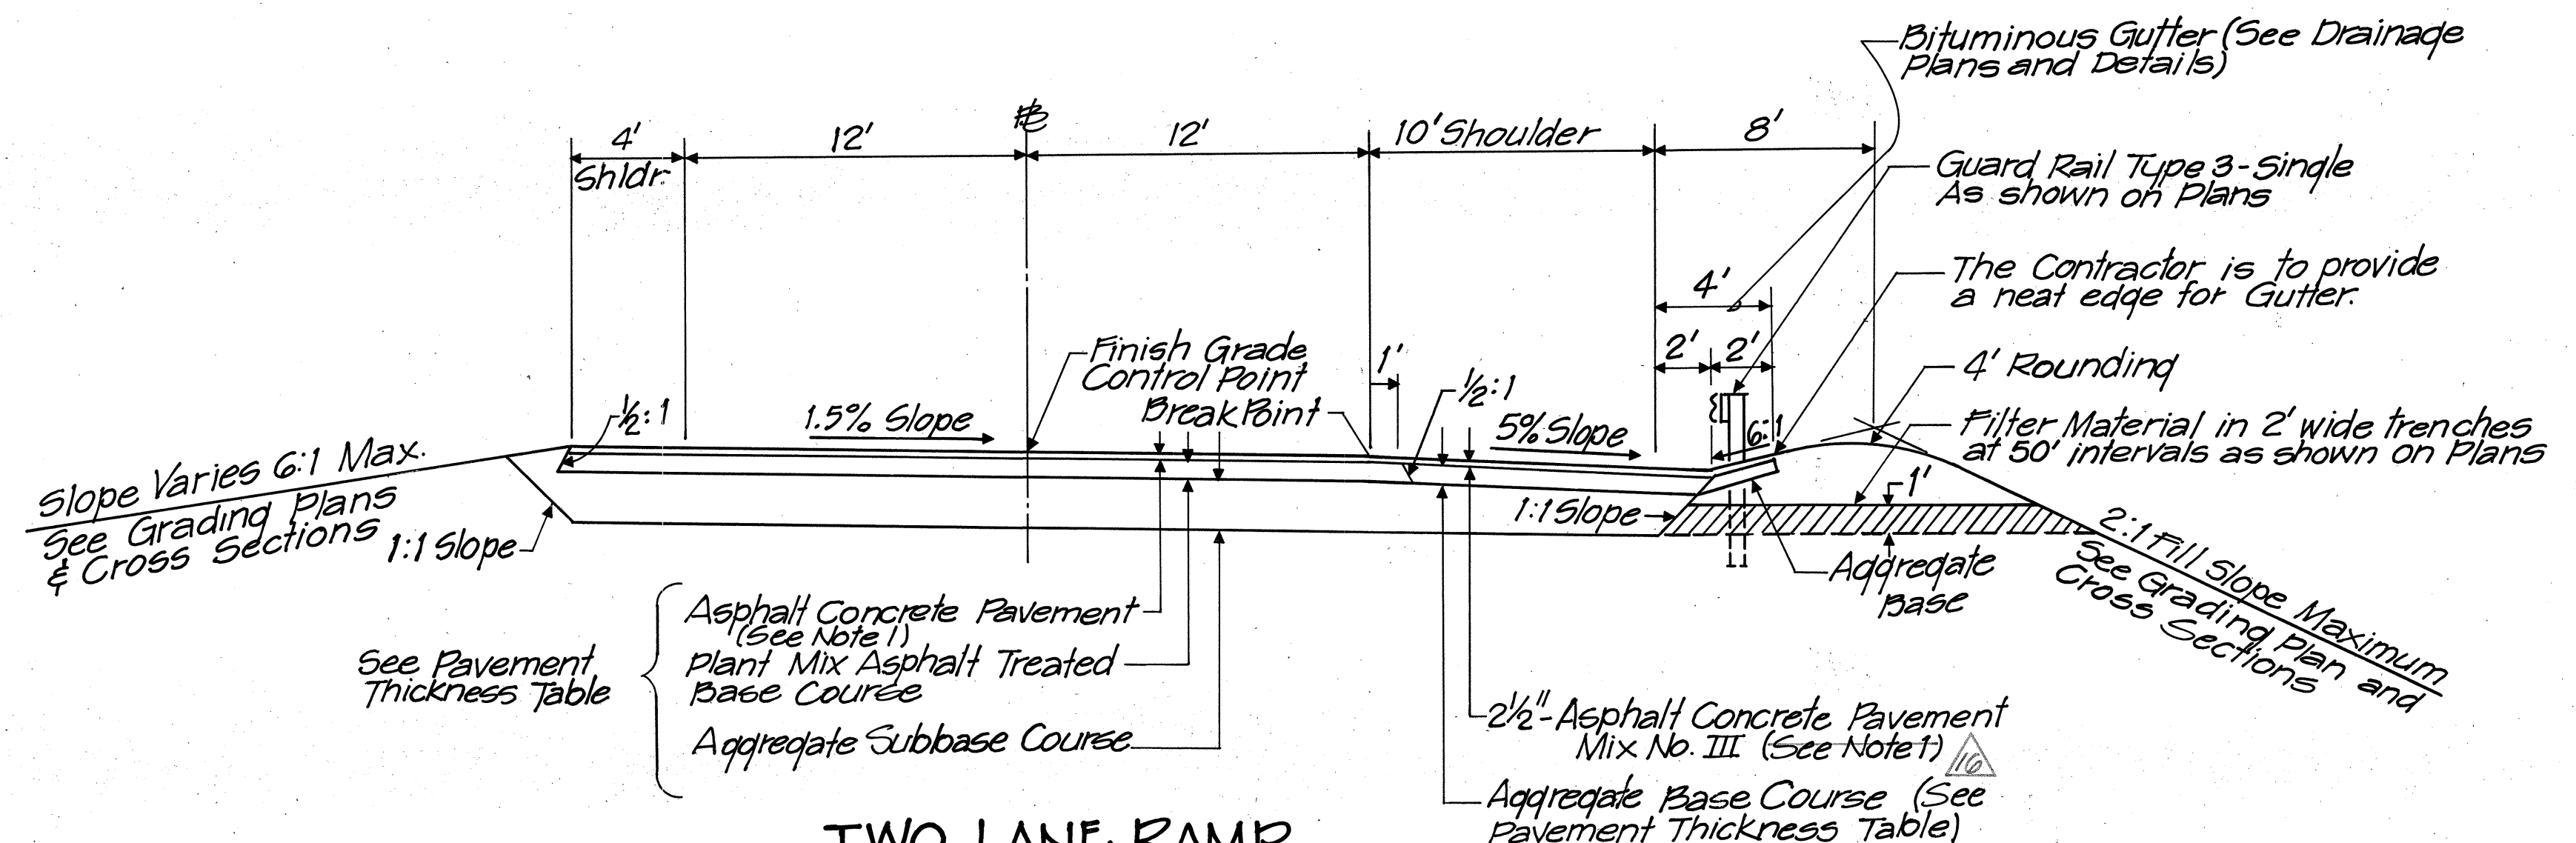

TWO LANE RAMP
NORMAL SECTION - RAMP M

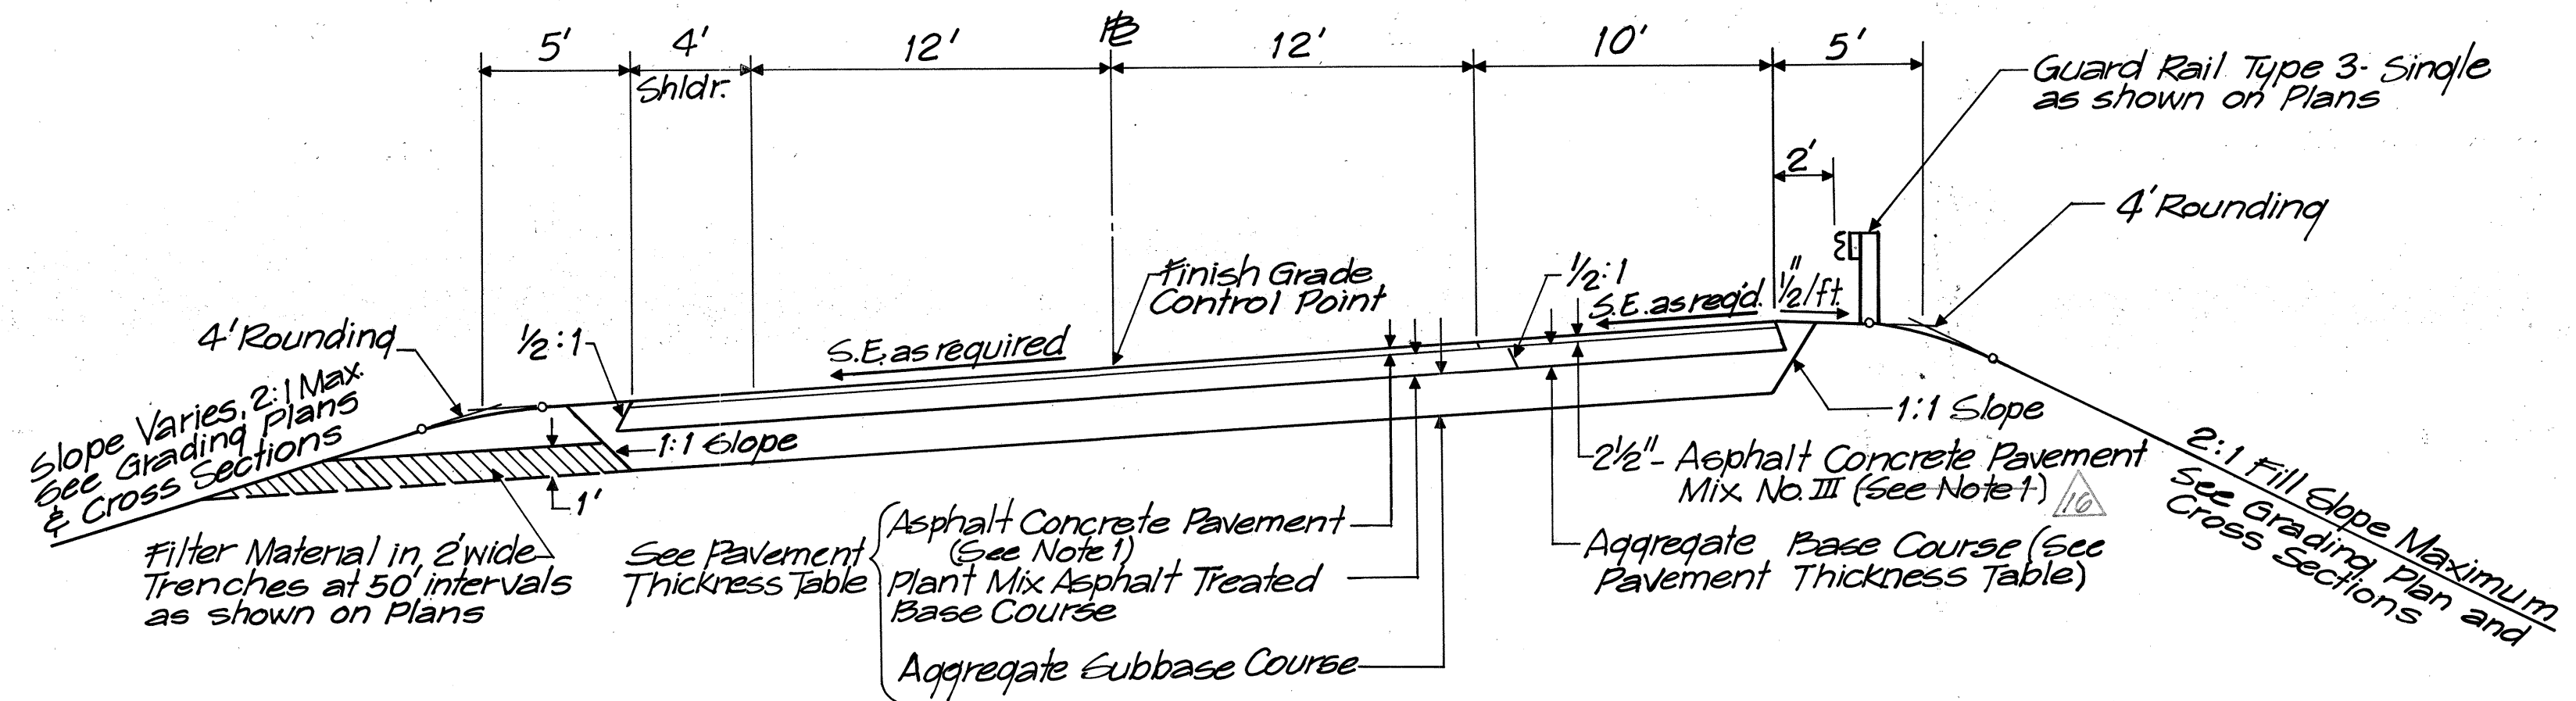

TWO LANE RAMP
SUPERELEVATED SECTION - RAMP M

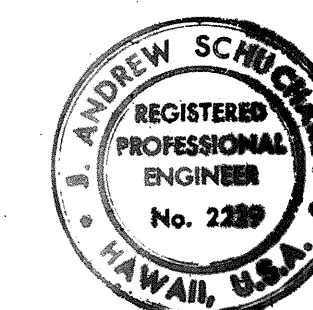

THIS WORK WAS PREPARED BY
ME OR UNDER MY SUPERVISION
J. Andrew Schuchardt

STATE OF HAWAII
DEPARTMENT OF TRANSPORTATION
HIGHWAYS DIVISION

TYPICAL SECTIONS

INTERSTATE ROUTE H-1
PROJECT NO. I-HI-1(109)13

SCALE: 1"=5'

DATE: DEC. 29, 1972

SHEET No. 2F OF 2F SHEETS

DATE	DESIGNED BY	CHECKED BY
NOV. 1972	J. ANDREW SCHUCHART	J. ANDREW SCHUCHART
ORIGINAL PLAN	NOTE BOOK	NO.