


FED. ROAD DIST. NO.	STATE	FED. AID PROJ. NO.	FISCAL YEAR	SHEET NO.	TOTAL SHEETS
HAWAII	HAW.	1-11-1 (7) 14	1974	55	61

SCALE: VERT. 1"=10
HORIZ. 1"=20


FINAL SURVEY	DATE	
	BY	
	SURVEYED	
	NOTED	
NOTE BOOK	NO.	
	AREAS	
	CHECKED	
	AREAS	

ORIGINAL SURVEY	DATE	
	BY	
	SURVEYED	
	NOTED	
NOTE BOOK	NO.	
	AREAS	
	CHECKED	
	AREAS	

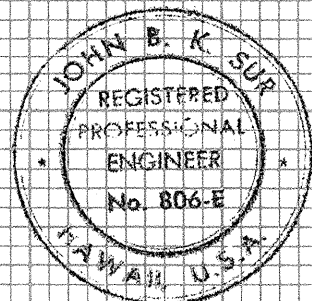


THIS WORK WAS PREPARED BY
ME OR UNDER MY SUPERVISION.

John B. K. Sup

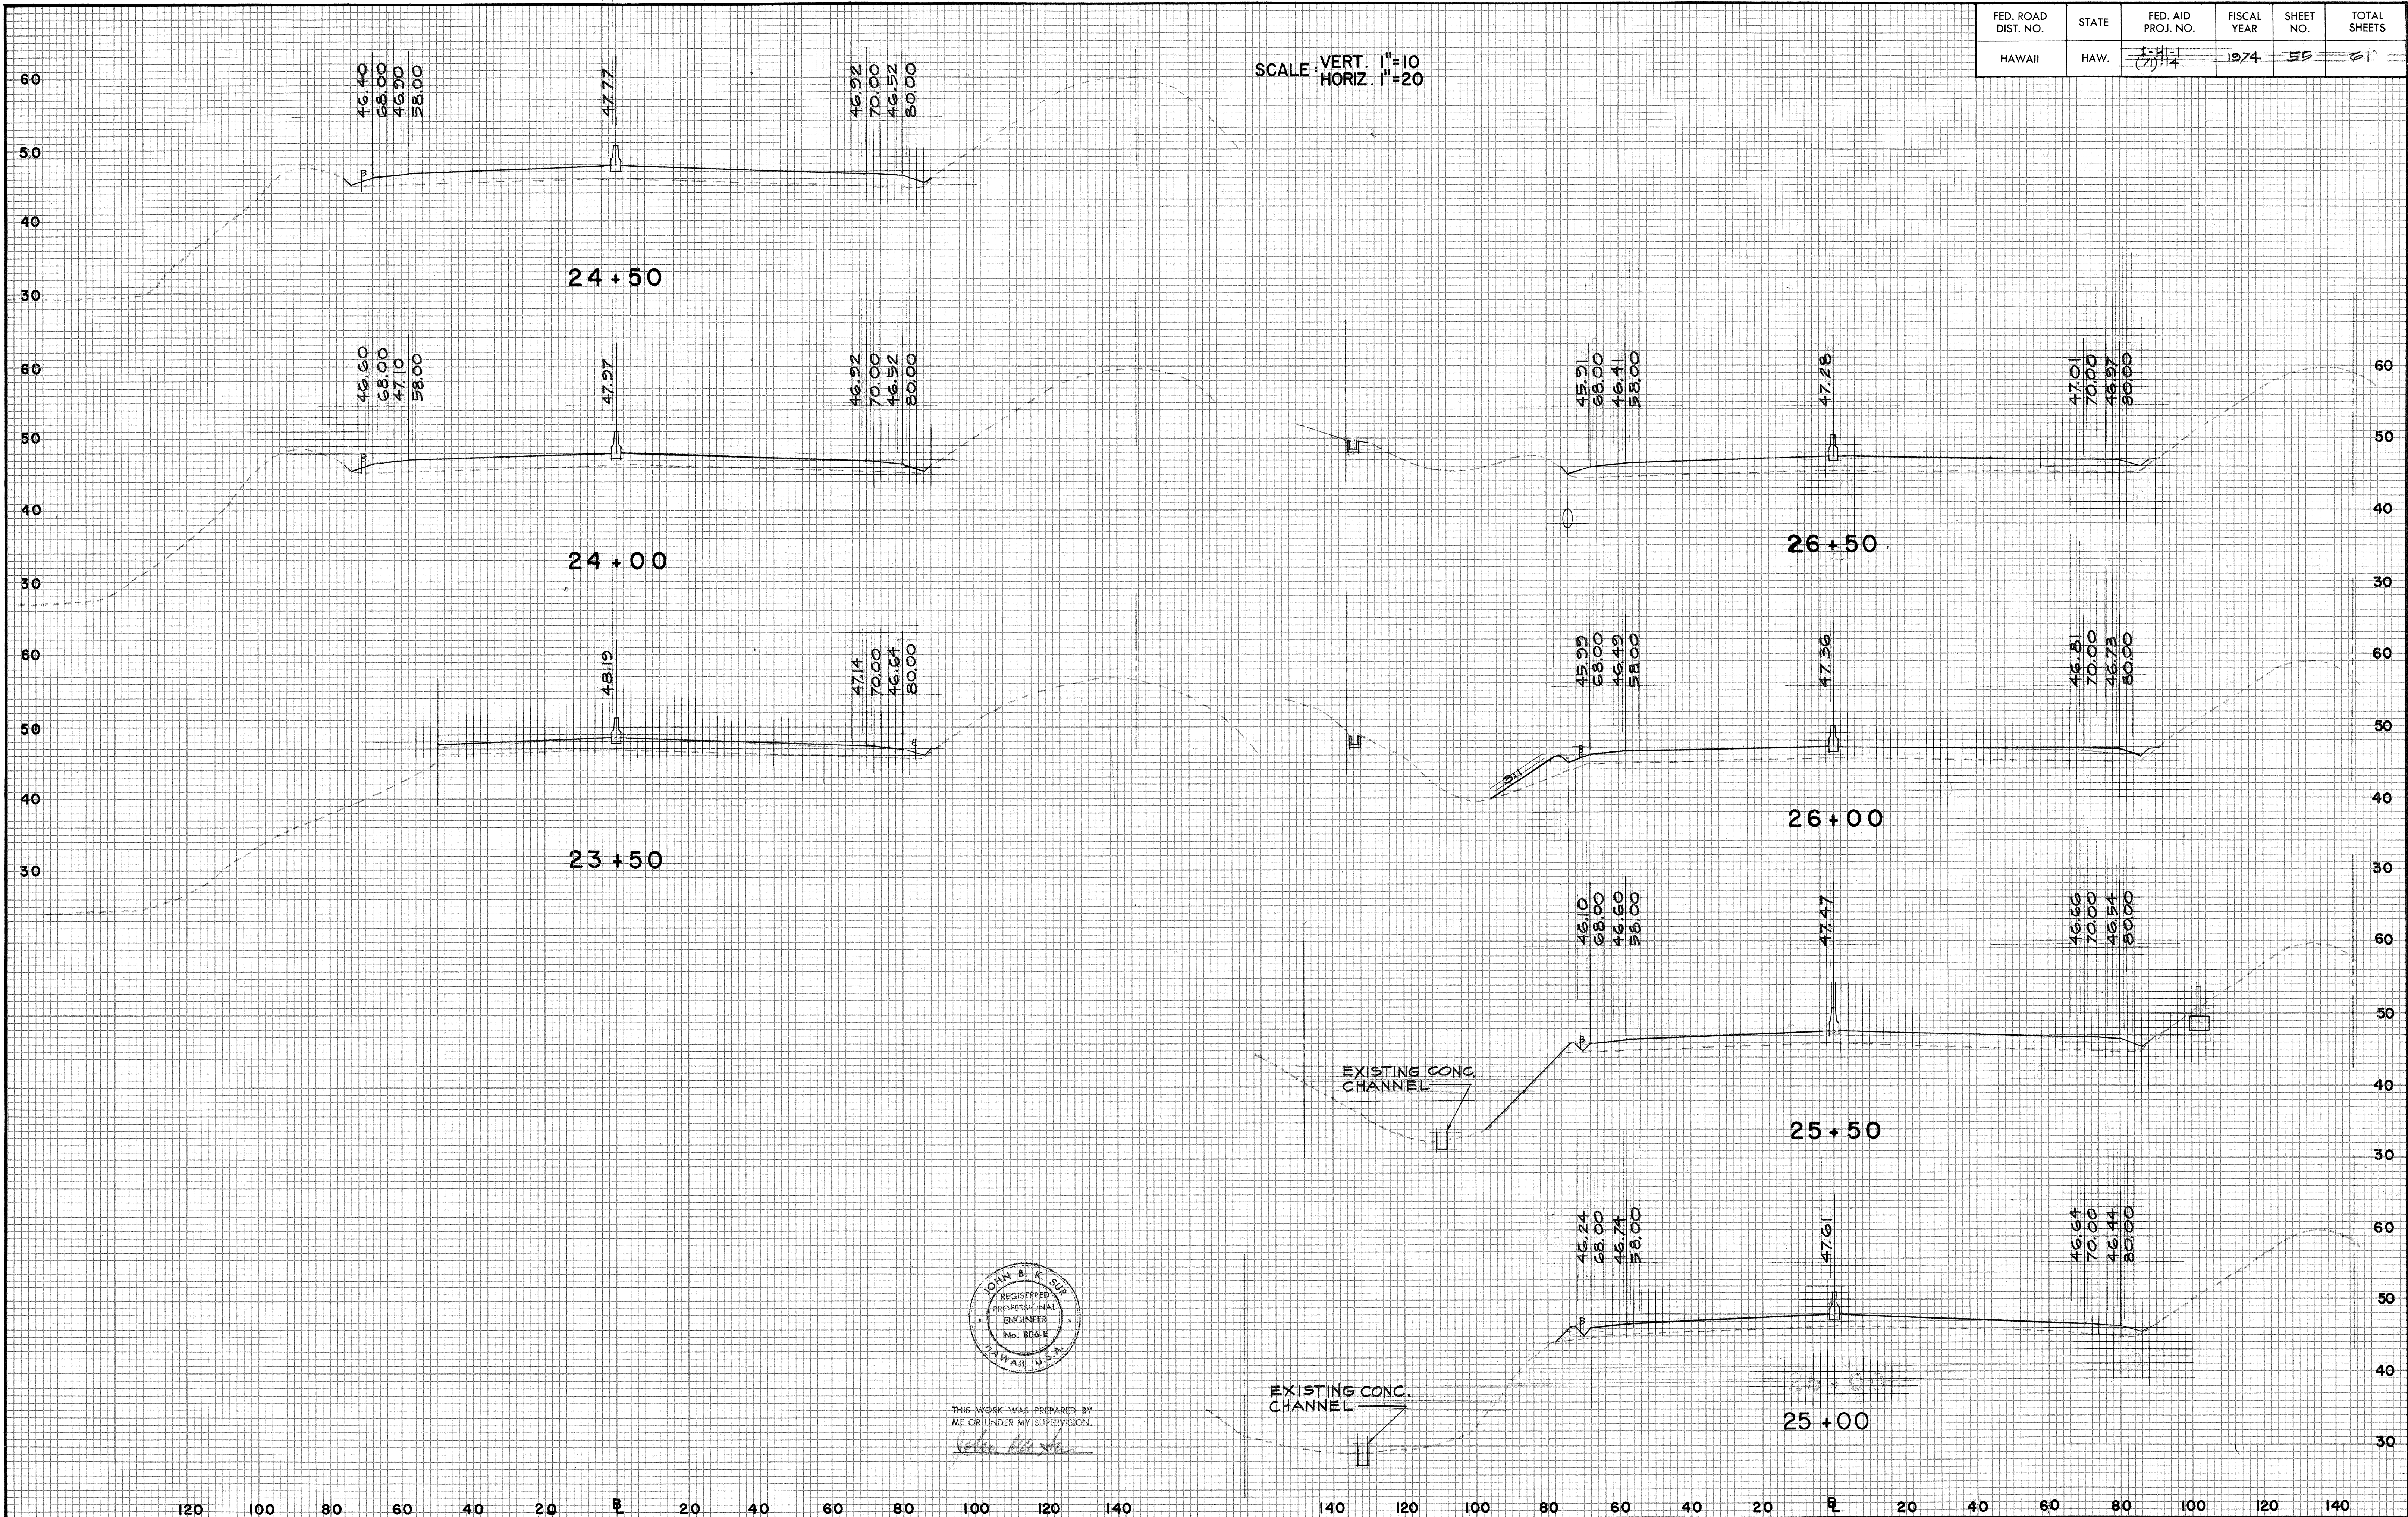


FINAL SURVEY	SURVEYED _____	BY _____	DATE _____
NOTE BOOK	PLOTTED _____		
NO.	TEMPLATE _____		
	AREAS _____		
	AREAS CHECKED _____		

ORIGINAL						
SURVEY	SURVEYED _____		BY _____			DATE _____
	PLOTTED _____					
NOTE BOOK	TEMPLATE _____					
	AREAS _____					
NO.	AREAS CHECKED _____					

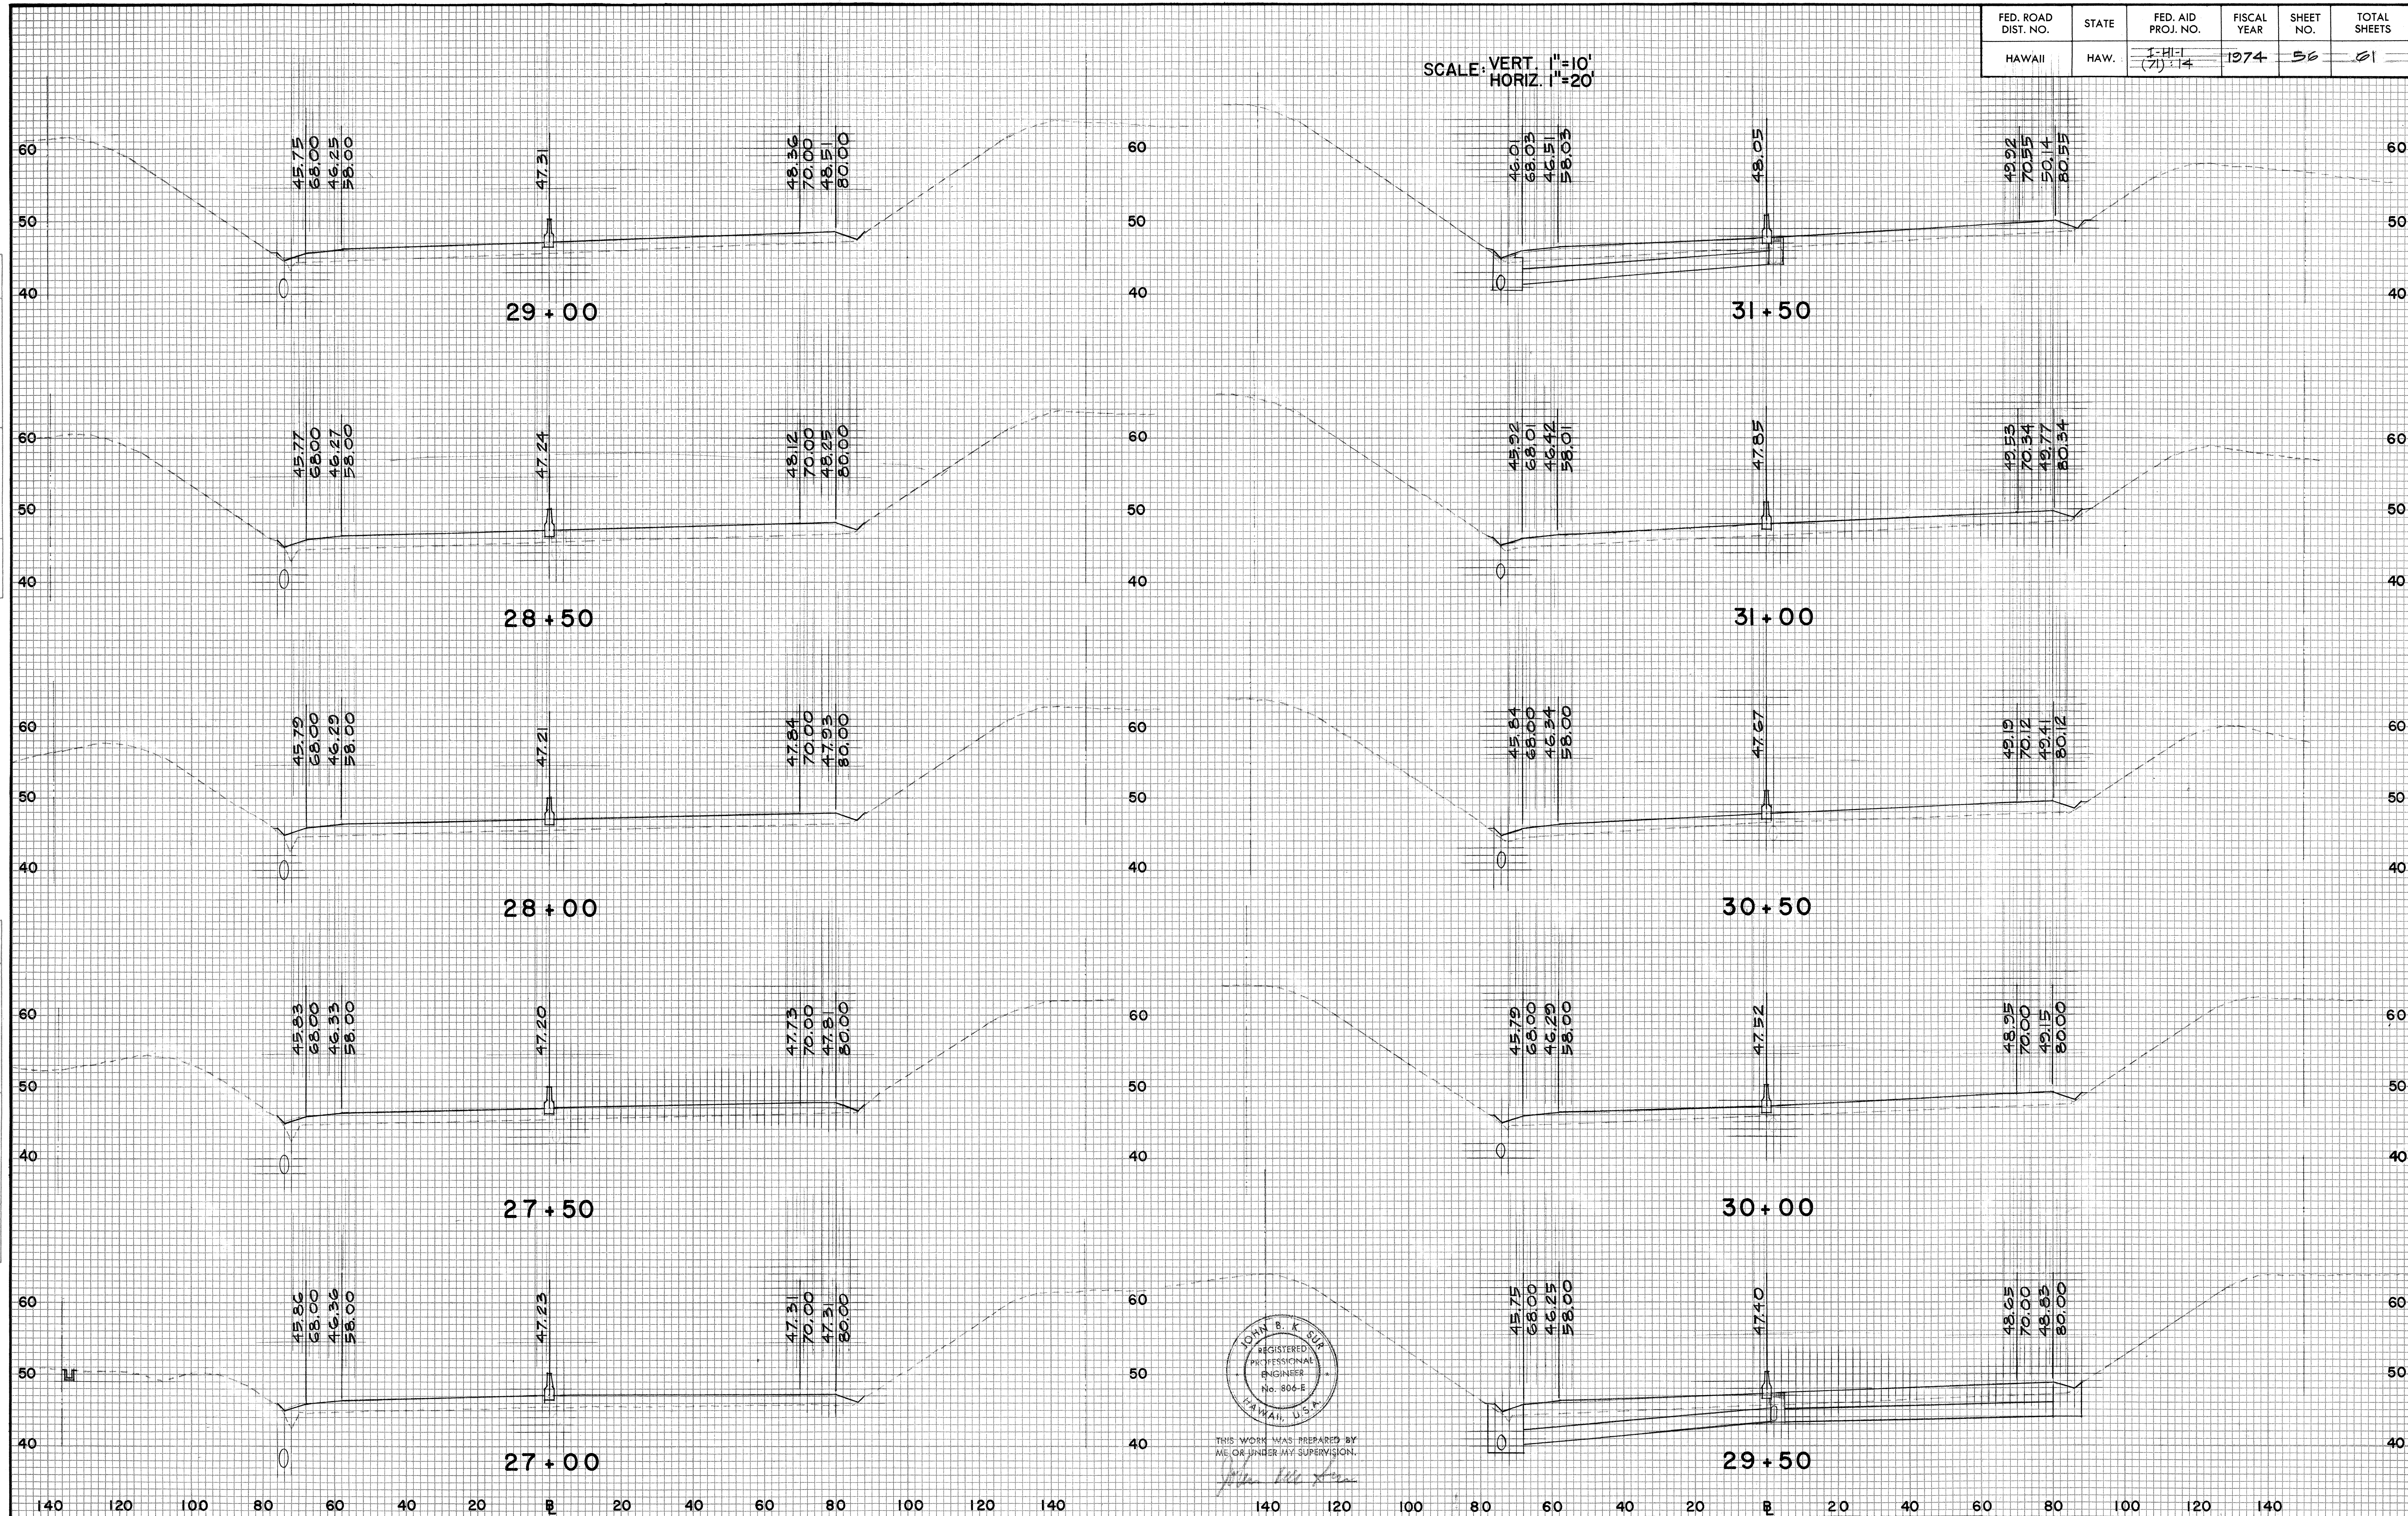

FINAL SURVEY NOTE BOOK NO.	SURVEYED _____	BY _____	DATE _____
	PLOTTED _____		
	TEMPLATE _____		
	AREAS CHECKED _____		

ORIGINAL SURVEY	SURVEYED	BY	DATE
NOTE BOOK	PLOTTED		
	TEMPLATE		
	AREAS		
NO.	AREAS CHECKED		

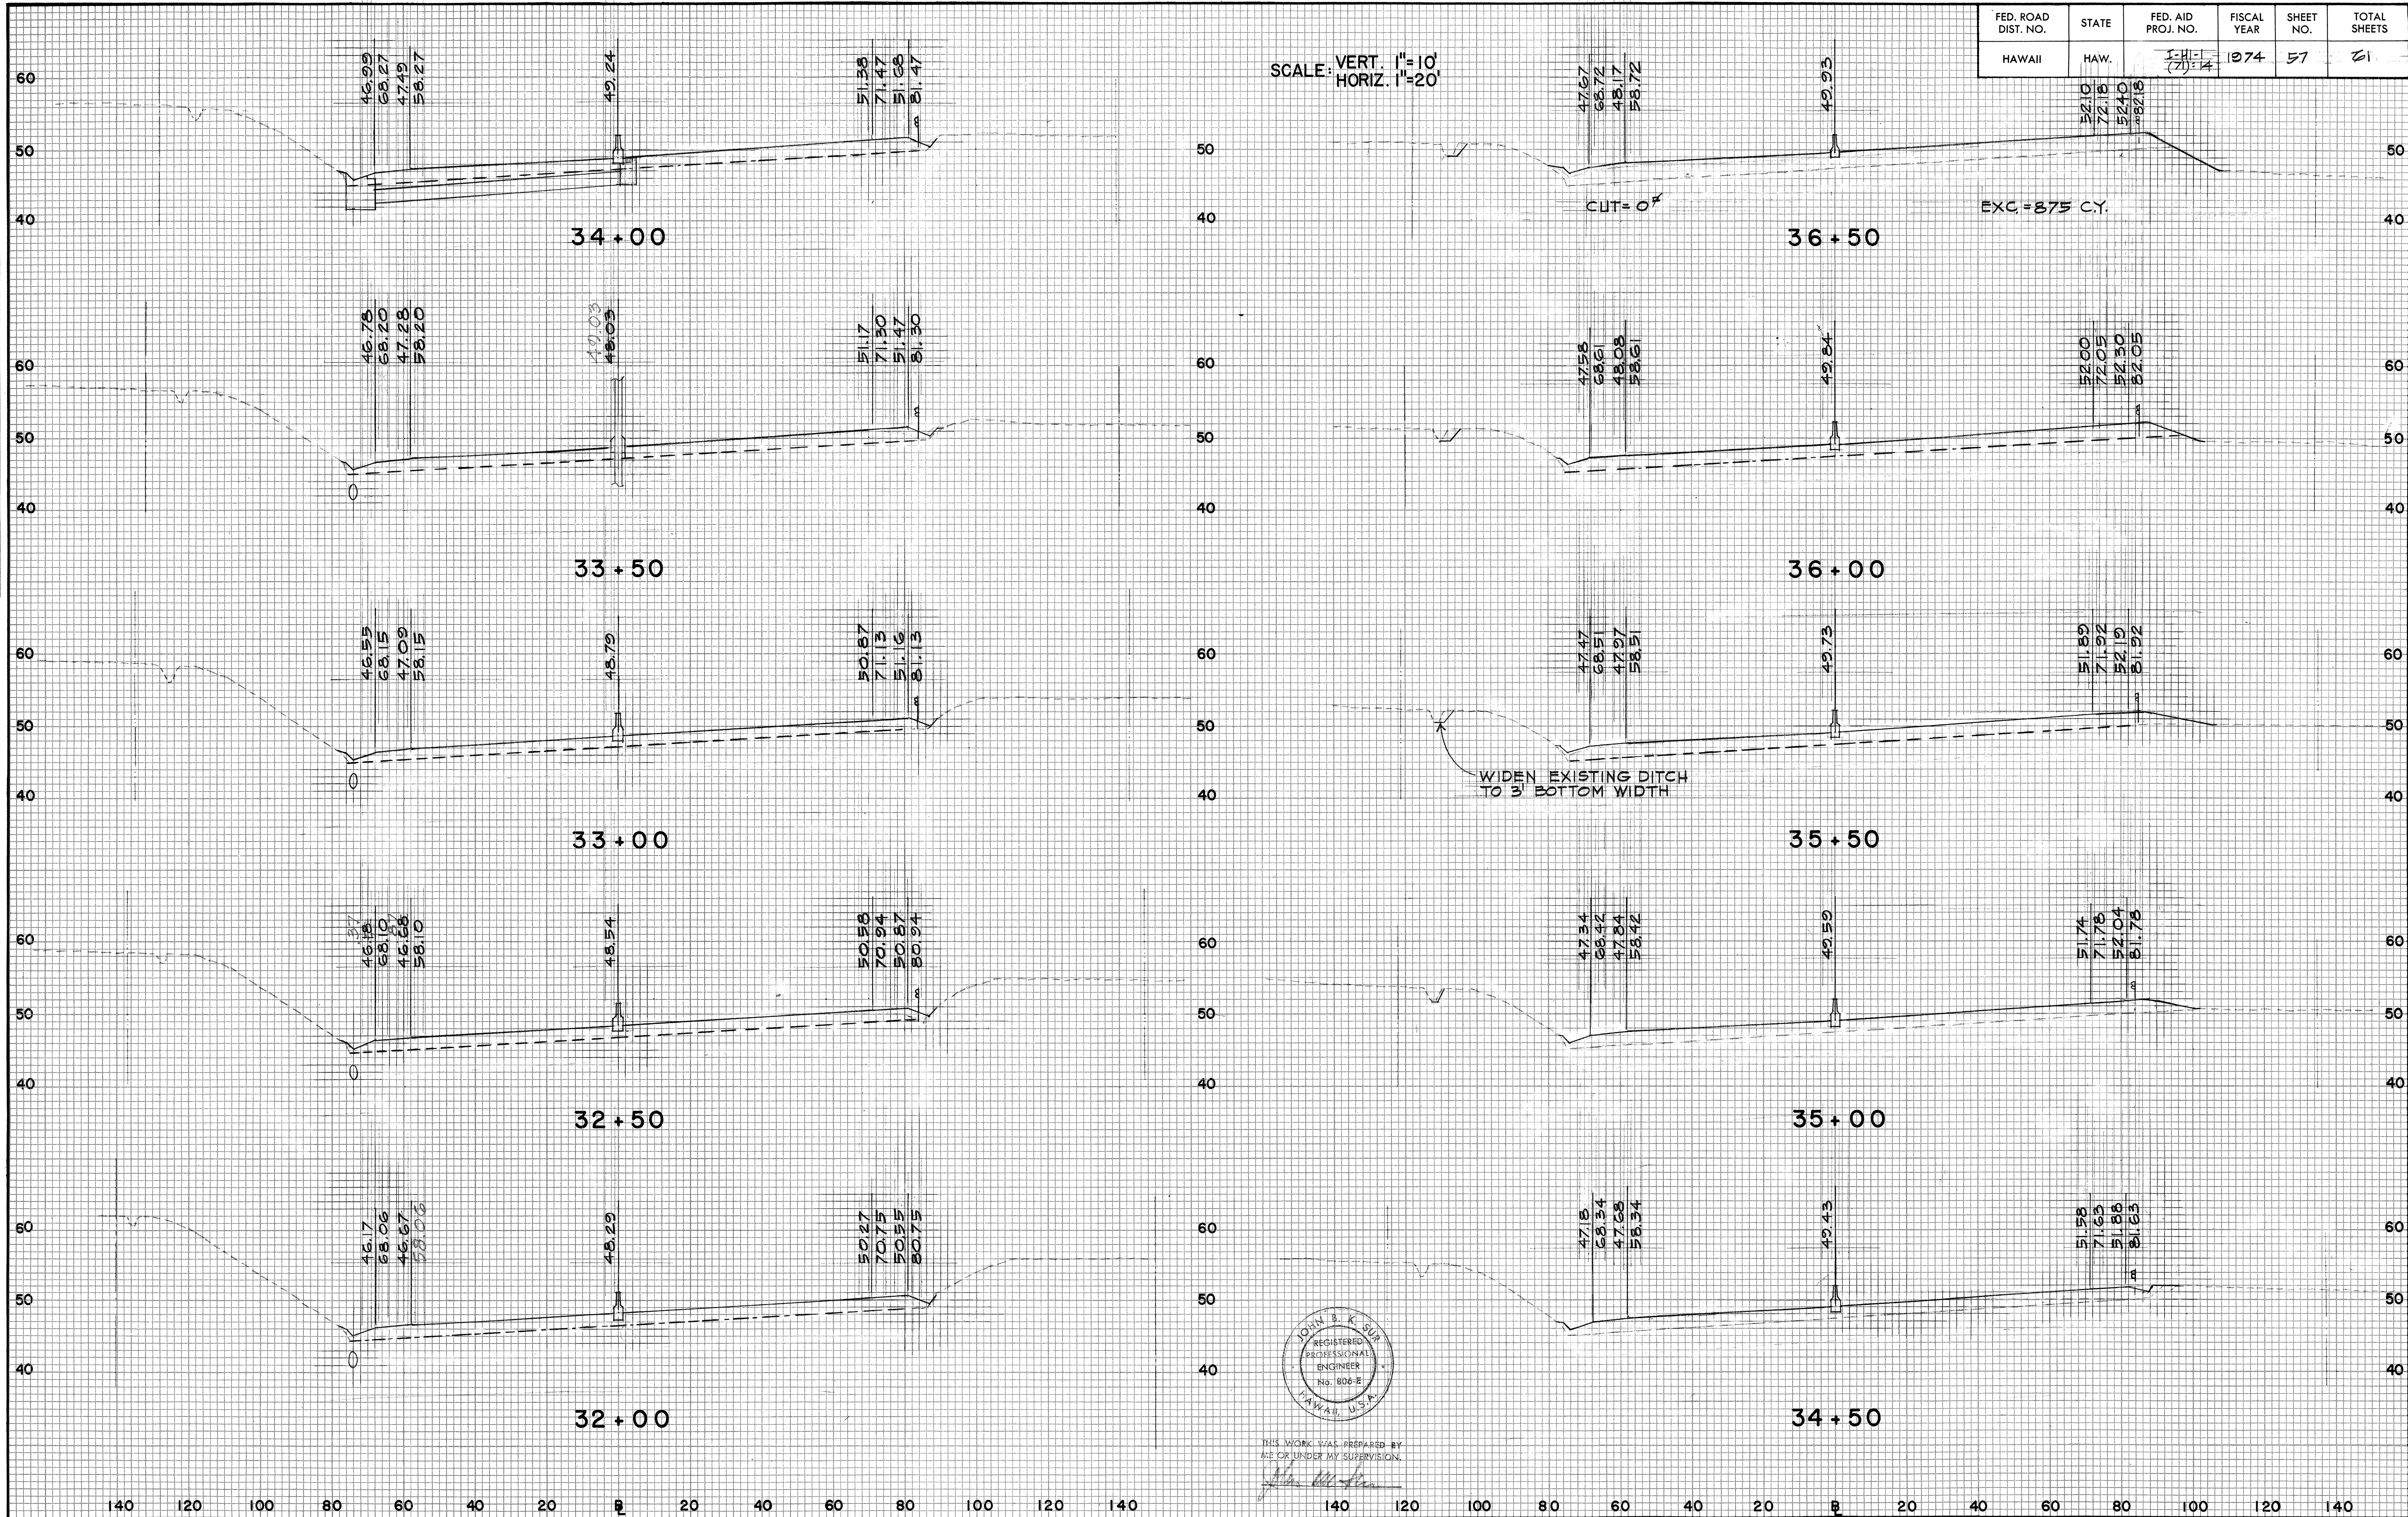

ORIGINAL		BY	DATE
SURVEY	SURVEYED		
	PLOTTED		
	TEMPLATE		
	AREAS		
	AREAS CHECKED		
NO.			



A hand-drawn graph on millimeter paper. The y-axis has labels 51.62, 72.94, 51.92, and 80.94. The x-axis has a label 2353.8. A curve is plotted, starting at a high y-value, decreasing to a minimum, and then increasing. A dashed line connects two points on the curve.



FED. ROAD DIST. NO.	STATE	FED. AID PROJ. NO.	FISCAL YEAR	SHEET NO.	TOTAL SHEETS
HAWAII	HAW.	1-11-1 (7) 14	1974	59	61

DATE	BY
SURVEYED	PLOTTED
NOTE BOOK	TEMPLATE
AREAS	CHECKED
NO.	

DATE	BY
SURVEYED	PLOTTED
NOTE BOOK	TEMPLATE
AREAS	CHECKED
NO.	

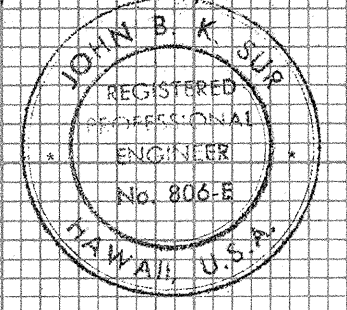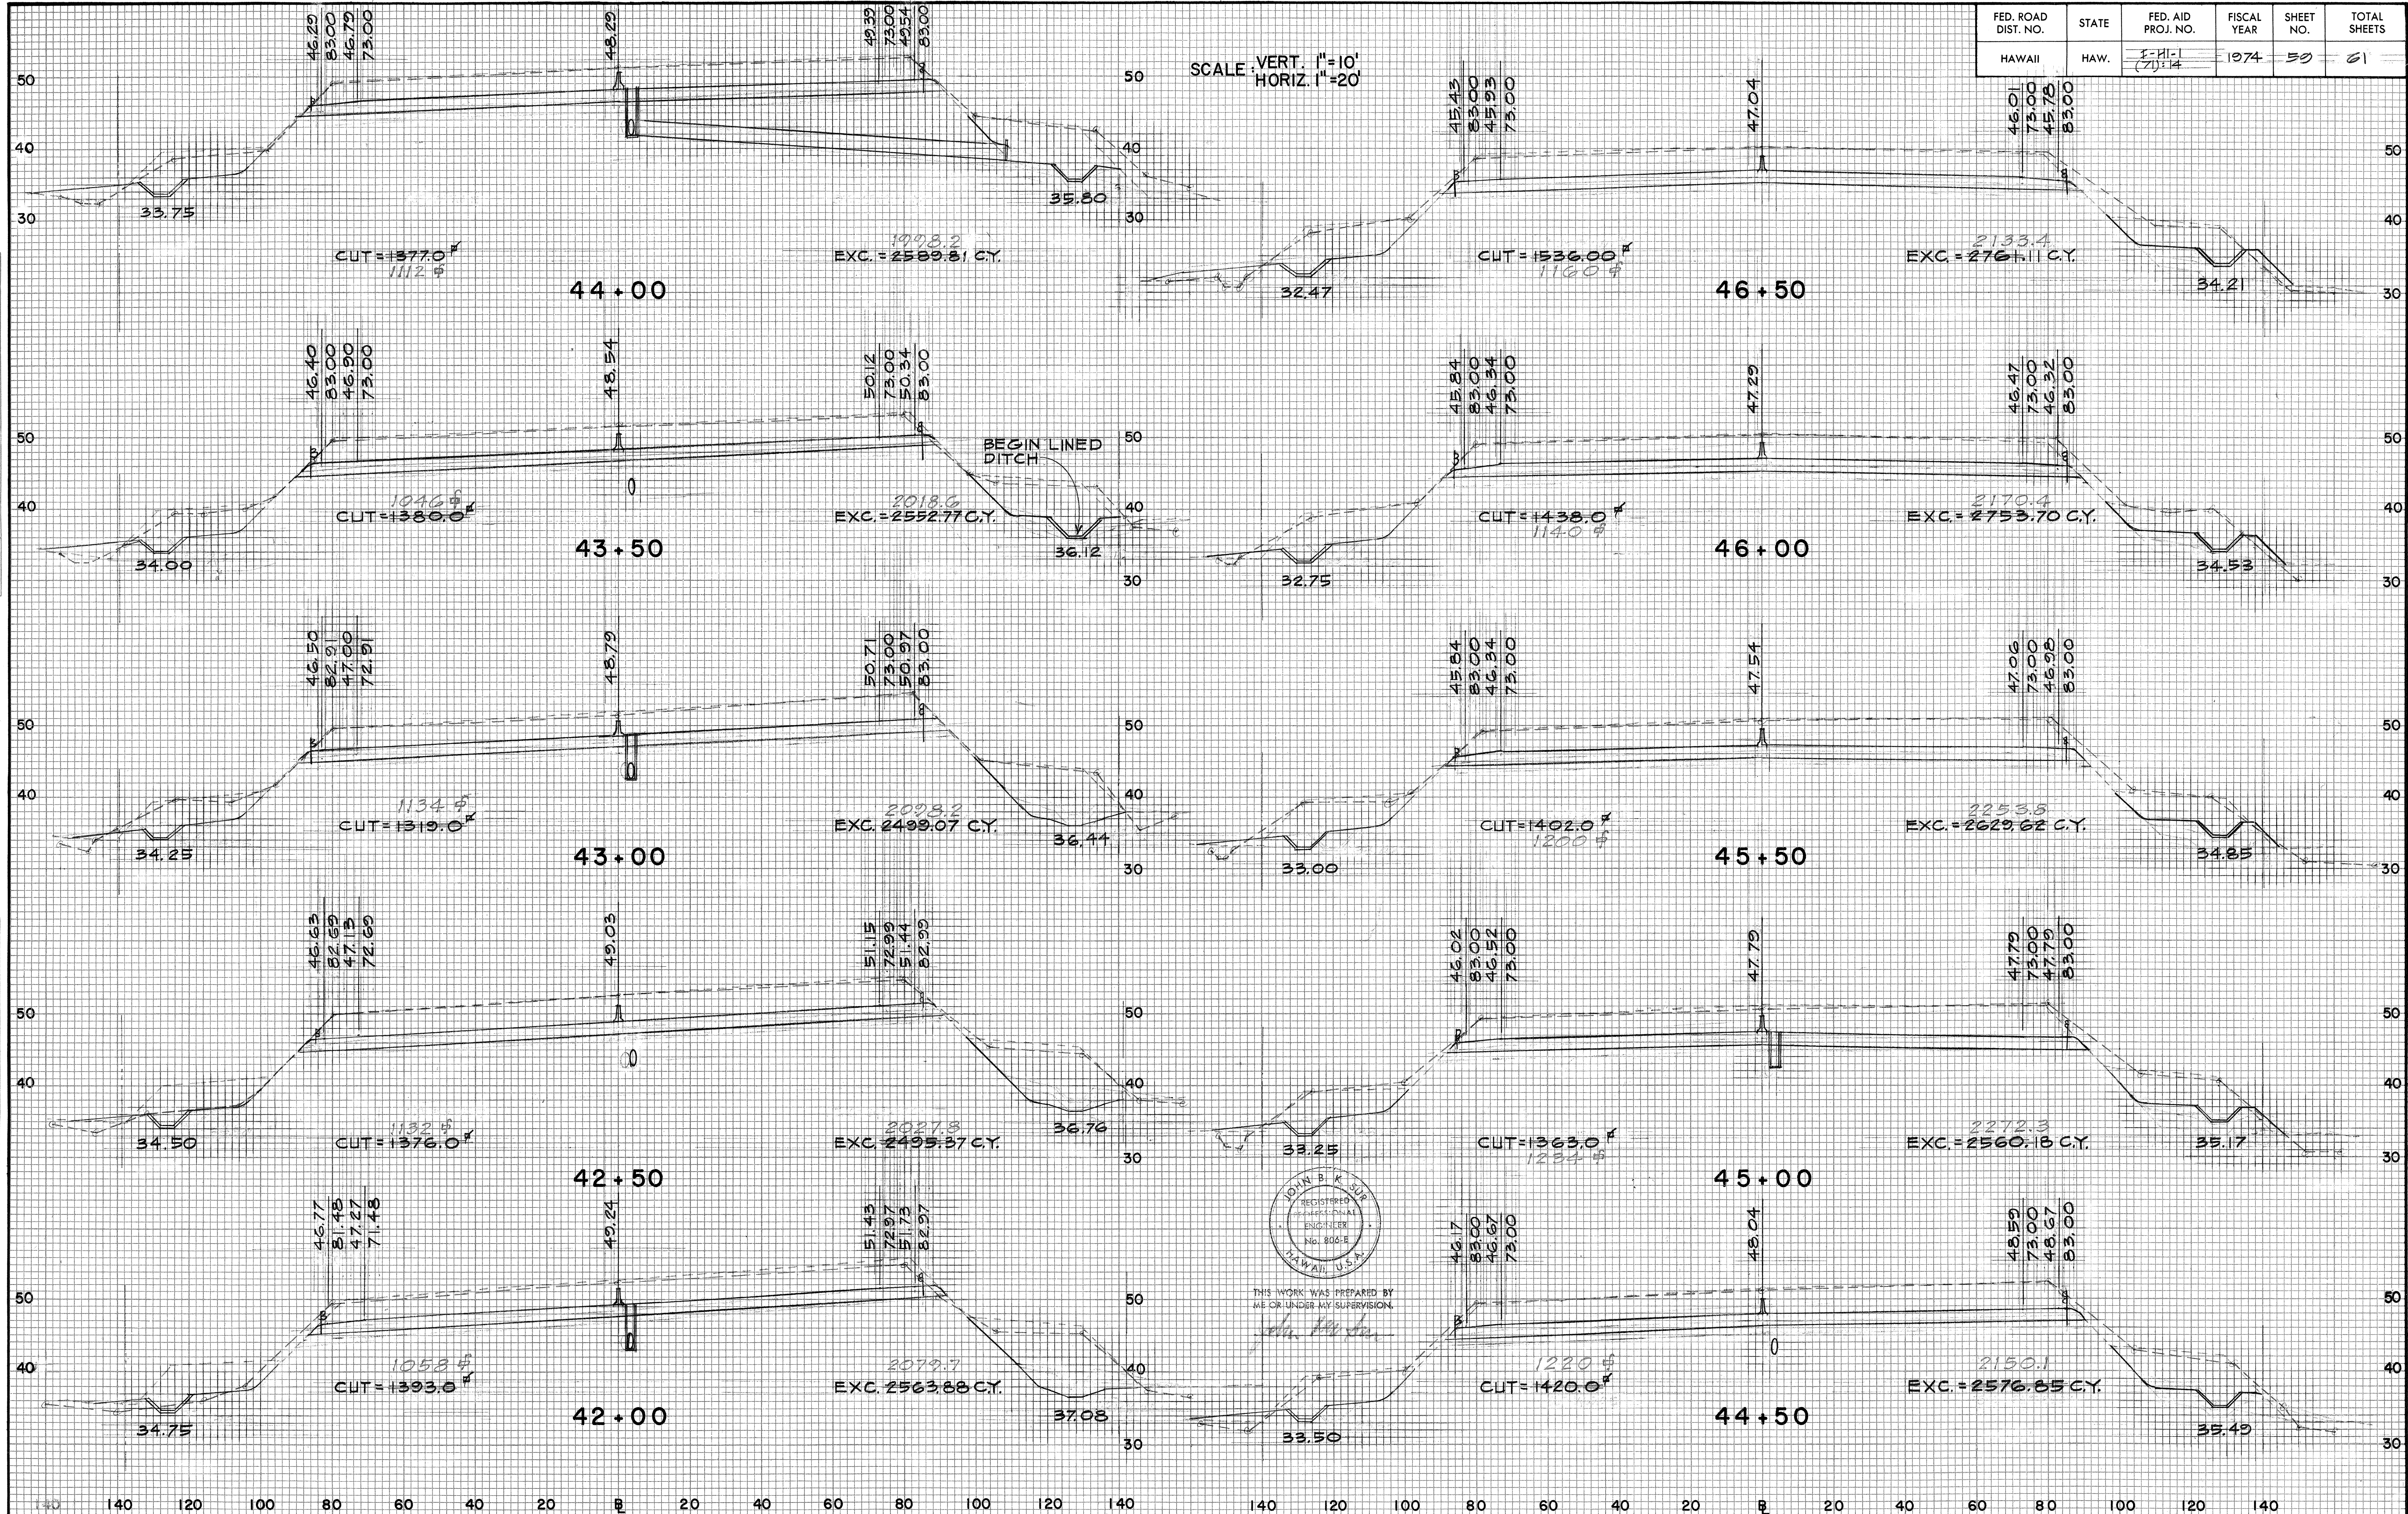


THIS WORK WAS PREPARED BY
ME OR UNDER MY SUPERVISION.
John B. K. Sir

FINAL SURVEY	DATE	
	BY	
	SURVEYED	
	NOTED	
	AREAS CHECKED	

ORIGINAL SURVEY	DATE	
	BY	
	SURVEYED	
	NOTED	
	AREAS CHECKED	

FED. ROAD DIST. NO.	STATE	FED. AID PROJ. NO.	FISCAL YEAR	SHEET NO.	TOTAL SHEETS
HAWAII	HAW.	5-HI-1 (21) 14	1974	60	61

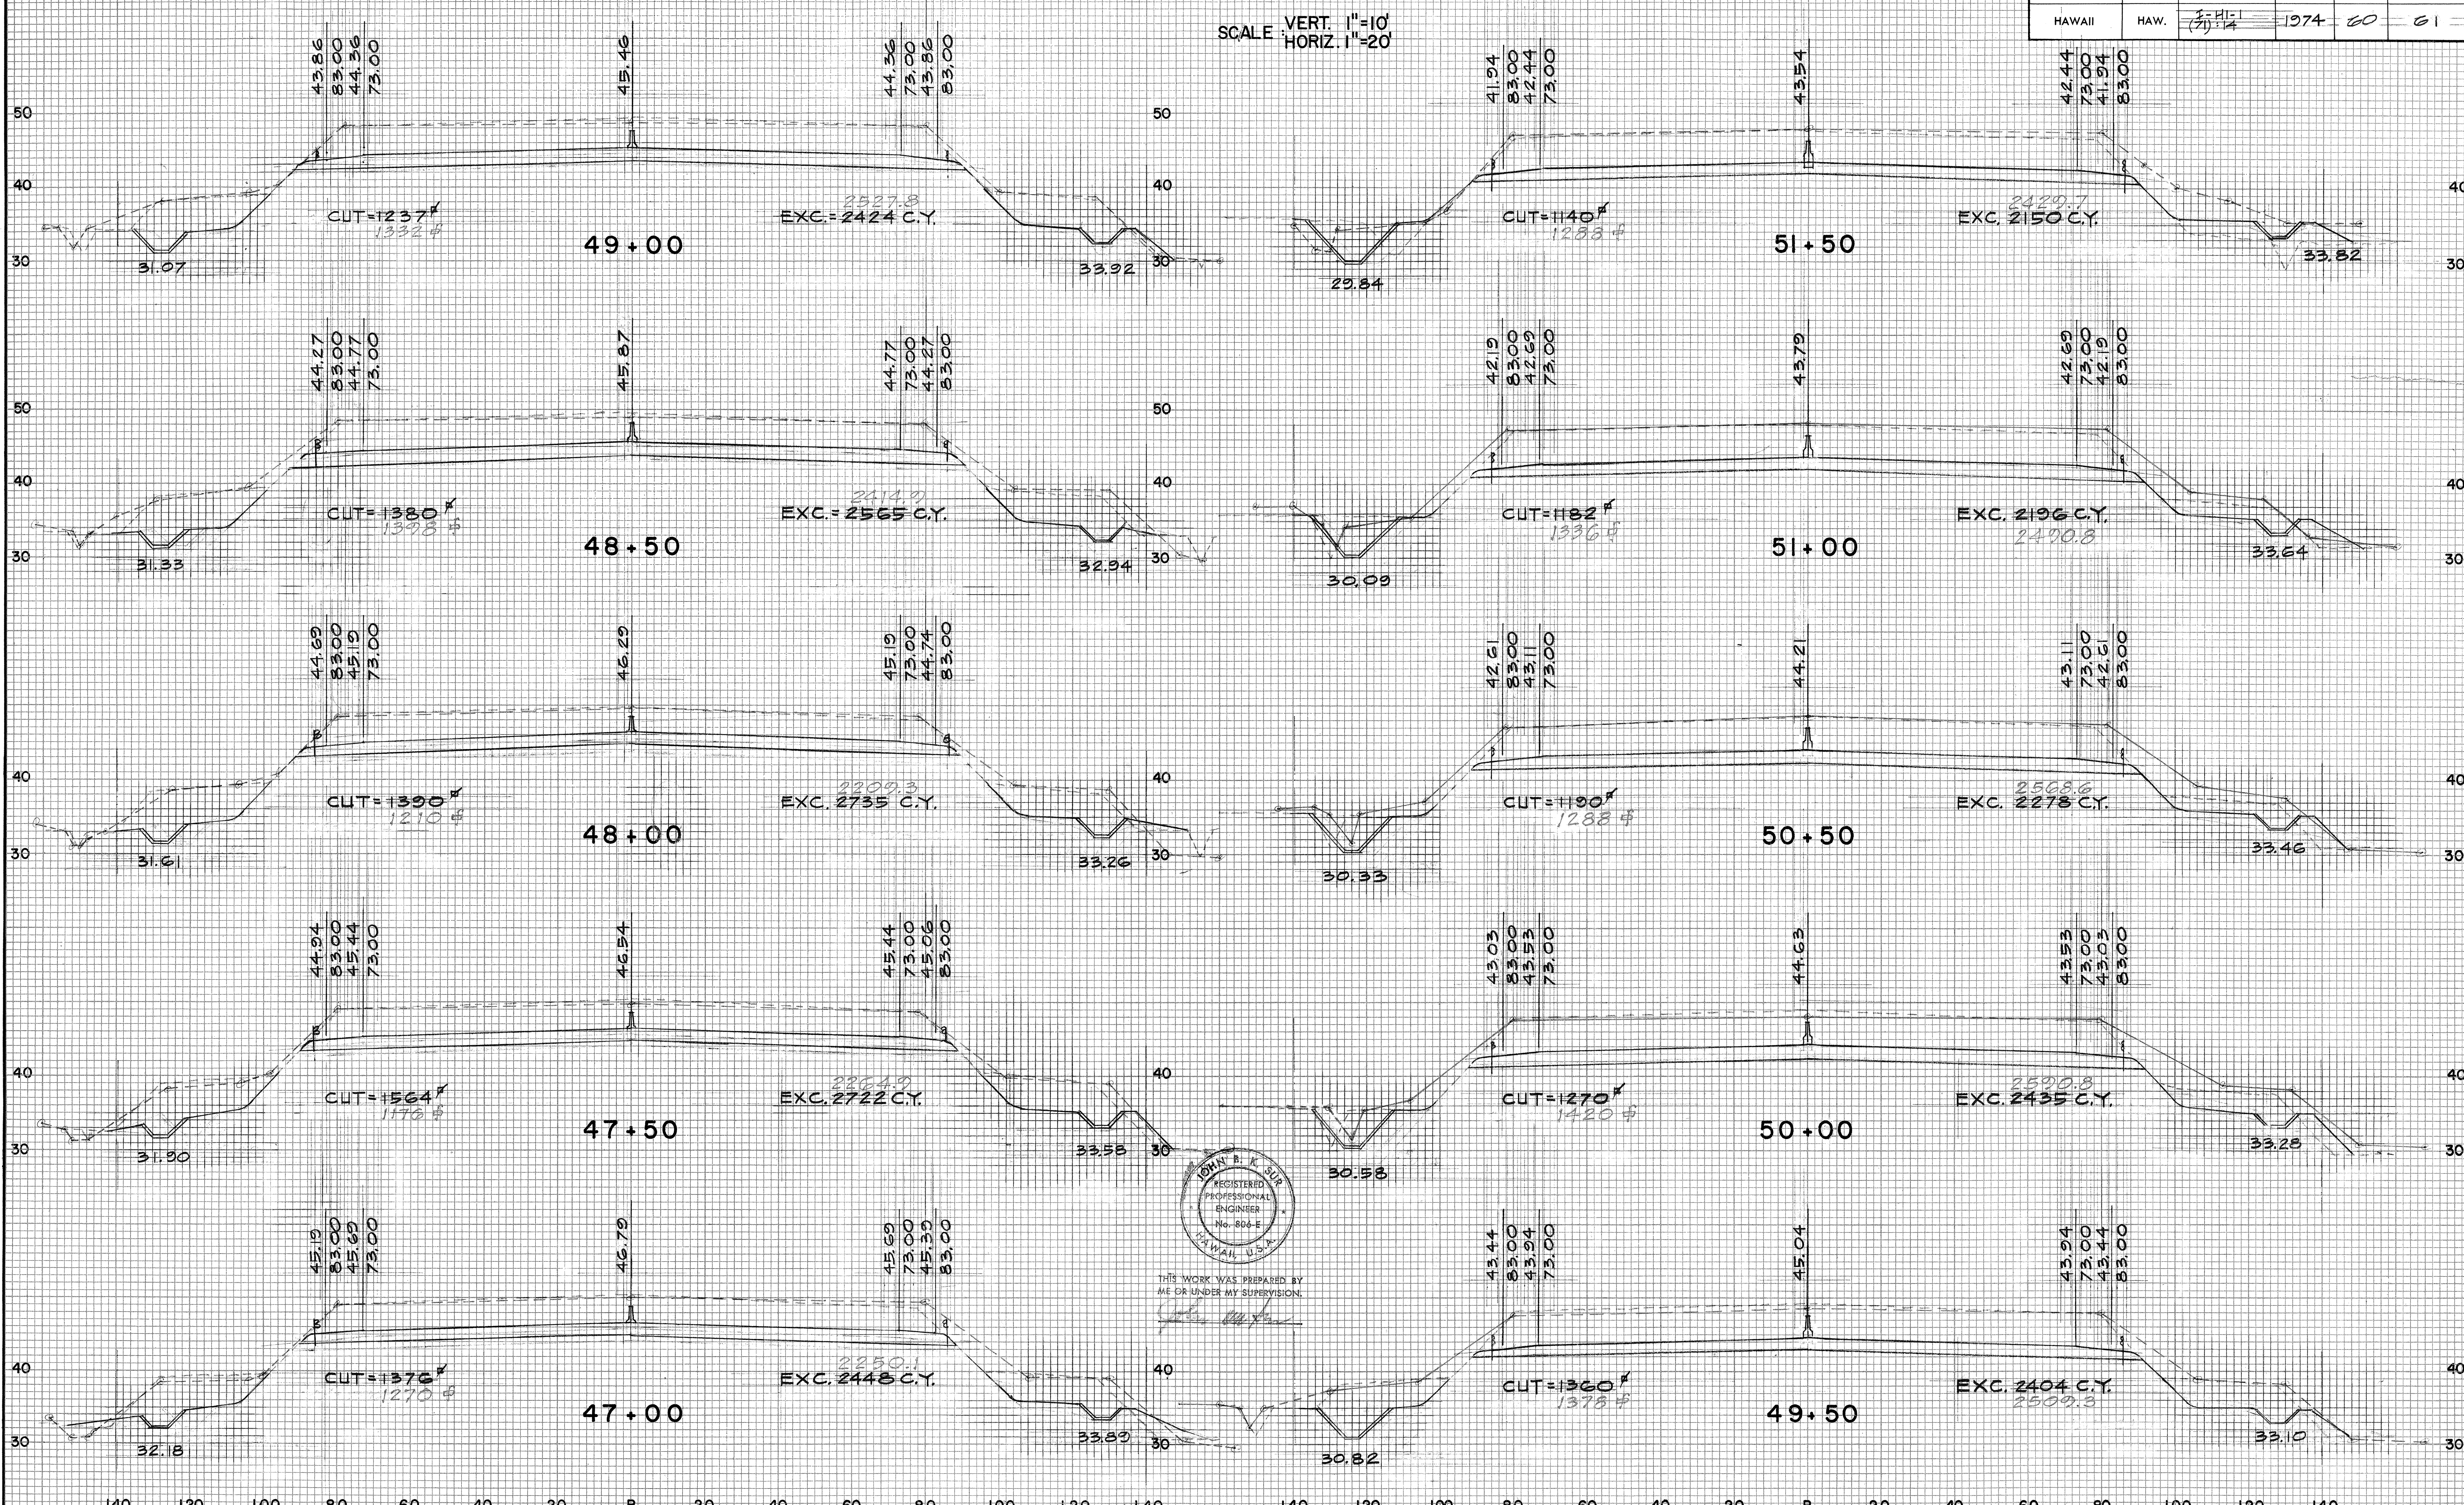

FED. ROAD DIST. NO.	STATE	FED. AID PROJ. NO.	FISCAL YEAR	SHEET NO.	TOTAL SHEETS
HAWAII	HAW.	1-HI-1 (7) : 14	1974	61	61

SCALE: VERT. 1"=10'
HORIZ. 1"=20'

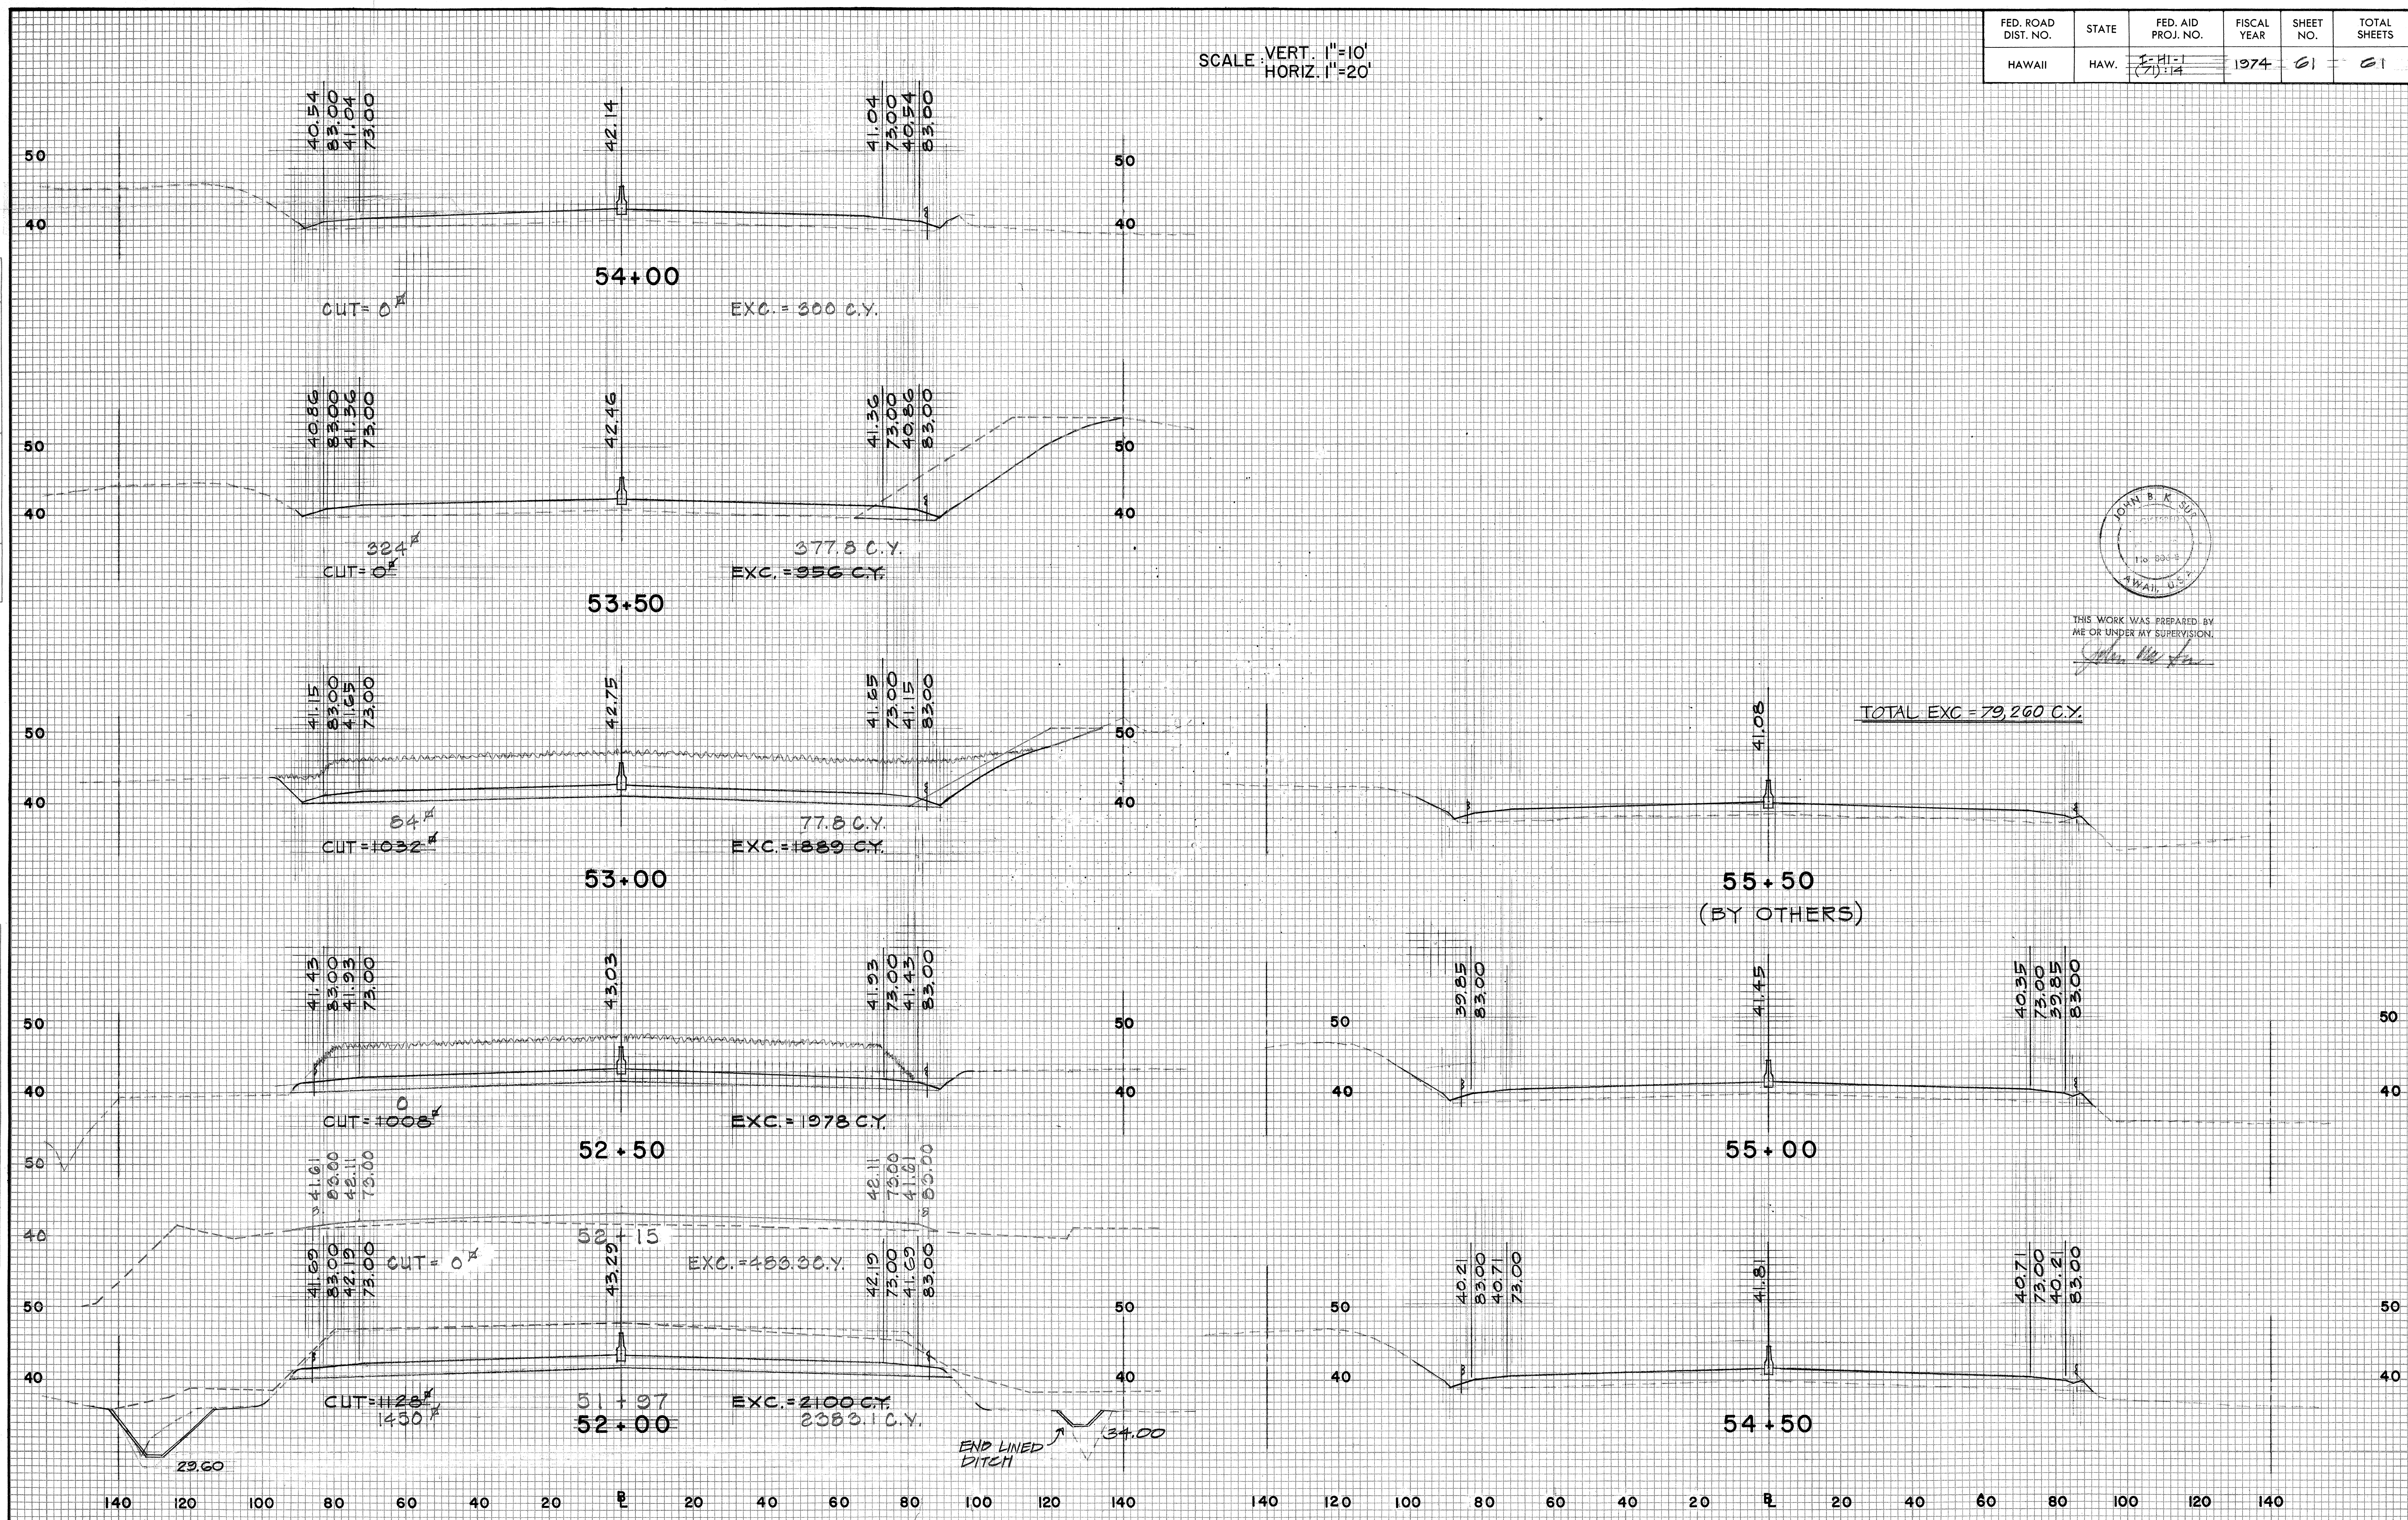


PLATE 3 - CROSS SECTION, F.A.S.
CLEARPRINT PAPER CO., S. F. CAL.

NO. 1000H-3

SHEET No. 7 OF 7 SHEETS

6